

Item No. 05 09/16/10 (2010 SS) Mr. Wright page 3

STANDARD DRAWINGS:

601-CWGS-02	CURVED W-BEAM GUARDRAIL SYSTEM
601-CWGS-04	CURVED W-BEAM GUARDRAIL SYSTEM
601-MTGR-01	THRIE BEAM GUARDRAIL DETAILS
601-TBGC-01	THRIE-BEAM GUARDRAIL COMPONENTS
601-TMTT-01	THRIE BEAM GUARDRAIL TO THRIE BEAM GUARDRAIL TRANSITION, TTT
601-TTGB-01	GUARDRAIL TRANSITION TYPE TGB
601-TTGB-03	GUARDRAIL TRANSITION TYPE TGB
601-TTGB-04	GUARDRAIL TRANSITION TYPE TGB
601-TTGB-05	GUARDRAIL TRANSITION TYPE TGB
601-TTGP-01	GUARDRAIL TRANSITION TYPE GP
601-TTGP-02	GUARDRAIL TRANSITION TYPE GP
601-TTGT-01	GUARDRAIL TRANSITION, TGT
601-TTMS-01	DOUBLE FACED THRIE BEAM GUARDRAIL TRANSITION TO GRET TYPE MS
601-TTVH-01	GUARDRAIL TRANSITION TYPE VH
601-TTVH-02	GUARDRAIL TRANSITION TYPE VH
601-TWGB-03	GUARDRAIL TRANSITION TYPE WGB
601-TWGT-01	W-BEAM GUARDRAIL TO THRIE BEAM GUARDRAIL TRANSITION, WGT
601-WBGA-01	W-BEAM GUARDRAIL ASSEMBLIES
601-WBGA-02	W-BEAM GUARDRAIL ASSEMBLIES
601-WBGA-06	WR-BEAM GUARDRAIL
706-TBRC-01	RETROFIT THRIE BEAM BRIDGE RAILING TR
706-TBRC-02	RETROFIT THRIE BEAM BRIDGE RAILING TR COMPONENTS
706-TBRF-01	RETROFIT THRIE BEAM BRIDGE RAILING TR COMPONENTS
706-TTBC-01	CONCRETE BRIDGE RAILING TRANSITION TBC
706-TTBP-01	CONCRETE BRIDGE RAILING TRANSITION, TPF-1
706-TTBO-03	CONCRETE BRIDGE RAILING TRANSITION, TPF-2
706-TTBP-05	CONCRETE BRIDGE RAILING TRANSITION, TPS-1
706-TTBP-07	CONCRETE BRIDGE RAILING TRANSITION, TPS-2
706-TTBT-01	CONCRETE BRIDGE RAILING TRANSITION TYPE TBT
706-TTTX-01	CONCRETE BRIDGE RAILING TRANSITION, TTX
706-TWBC-01	CONCRETE BRIDGE RAILING TRANSITION TYPE WBC
706-TTCA-01	1 1/4" DIAMETER HOLES PLACEMENT FOR TERMINAL CONNECTOR ATTACHMENT

RECURRING PLAN DETAILS:

706-B-140d (3 SHEETS)	BRIDGE RAILING TYPE TS-1 & GUARDRAIL TRANSITION TYPE TGS-1
-----------------------	---

Item No. 06 09/16/10 (2010 SS) Mr. Walker page 42

906.02(a)4	Asphalt Rubber Sealant
906.02(a)54	Polychloroprene Joint Membrane and Adhesive

Item No. 07 09/16/10 (2010 SS) Mr. Walker page 45

RECURRING SPECIAL PROVISION:

401-R-XXX	JOINT ADHESIVE AND INFORMATIONAL CORES
-----------	--

ADDENDUM 1

cc: Committee Members (11)
FHWA (1)
ICA (1)

SPECIFICATION REVISIONS (09/09/10 REVISED PROPOSAL SHEET)
REVISION TO THE STANDARD DRAWINGS AND RECURRING PLAN DETAILS

PROPOSAL TO STANDARDS COMMITTEE

PROBLEM(S) ENCOUNTERED: FHWA Memorandum from David A. Nicol, P.E. dated May 17, 2010 provides guidance to all state DOTs on the height of generic guardrail G4 (1S). Recent research on standard 27 inch guardrail shows that it does not meet NCHRP Report 350 Test Level 3(TL-3) criteria. This requires a revision of current policy with regard to new guardrail installation height. The FHWA guidance requires that transportation agencies should ensure the minimum height of newly-installed generic G4 (1S) W-beam guardrail is at least 27 ¾ inches to the top of the rail.

PROPOSED SOLUTION: Revise applicable INDOT Standard Drawings to show the installation height from 27 inches to 27 ¾ inches to the top of the rail. The proposed change will result into ¾ inch reduced embedment length of the guardrail post which is insignificant and will not impact the strength of the post as the INDOT guardrail posts are 7 feet long compared to 6 feet required for NCHRP 350 TL-3. Also INDOT already has Approved guardrail end treatments that can be used for the 27 ¾ inches height.

APPLICABLE STANDARD SPECIFICATIONS: N/A

APPLICABLE STANDARD DRAWINGS:

LIST OF PROPOSED REVISIONS TO STANDARD DRAWINGS.

601-CWGS-02	601-CWGS-04	601-MTGR-01
601-TBGC-01	601-TMTT-01	601-TTGB-01
601-TTGB-03	601-TTGB-04	601-TTGB-05
601-TTGP-01	601-TTGP-02	601-TTGT-01
601-TTMS-01	601-TTVH-01	601-TTVH-02
601-TWGB-03	601-TWGT-01	601-WBGA-01
601-WBGA-02	601-WBGA-06	706-TBRC-01
706-TBRC-02	706-TBRF-01	706-TTBC-01
706-TTBP-01	706-TTBP-03	706-TTBP-05
706-TTBP-07	706-TTBT-01	706-TTTX-01
706-TWBC-01		

LIST OF PROPOSED NEW STANDARD DRAWINGS:

706-TTCA-01

SPECIFICATION REVISIONS

REVISION TO THE STANDARD DRAWINGS AND RECURRING PLAN DETAILS
(CONTINUED)

APPLICABLE DESIGN MANUAL SECTION: N/A

APPLICABLE SECTION OF GIFE: N/A

APPLICABLE RECURRING SPECIAL PROVISIONS: N/A

APPLICABLE RECURRING PLAN DETAILS: 706-B-140d

Submitted By: John Wright

Title: Highway Design and Technical Support Director


Organization: INDOT

Phone Number: 317-232-5147


Date: 07/26/2010

APPLICABLE SUB-COMMITTEE ENDORSEMENT? Reviewed by Tony Uremovich (Design resources), Changes discussed with and endorsed by Ken Leuderalbert and Rick Drumm (FHWA).

REVISION TO THE STANDARD DRAWINGS AND RECURRING PLAN DETAILS
 REVISION TO 601-CWGS-02 CURVED W-BEAM GUARDRAIL SYSTEM

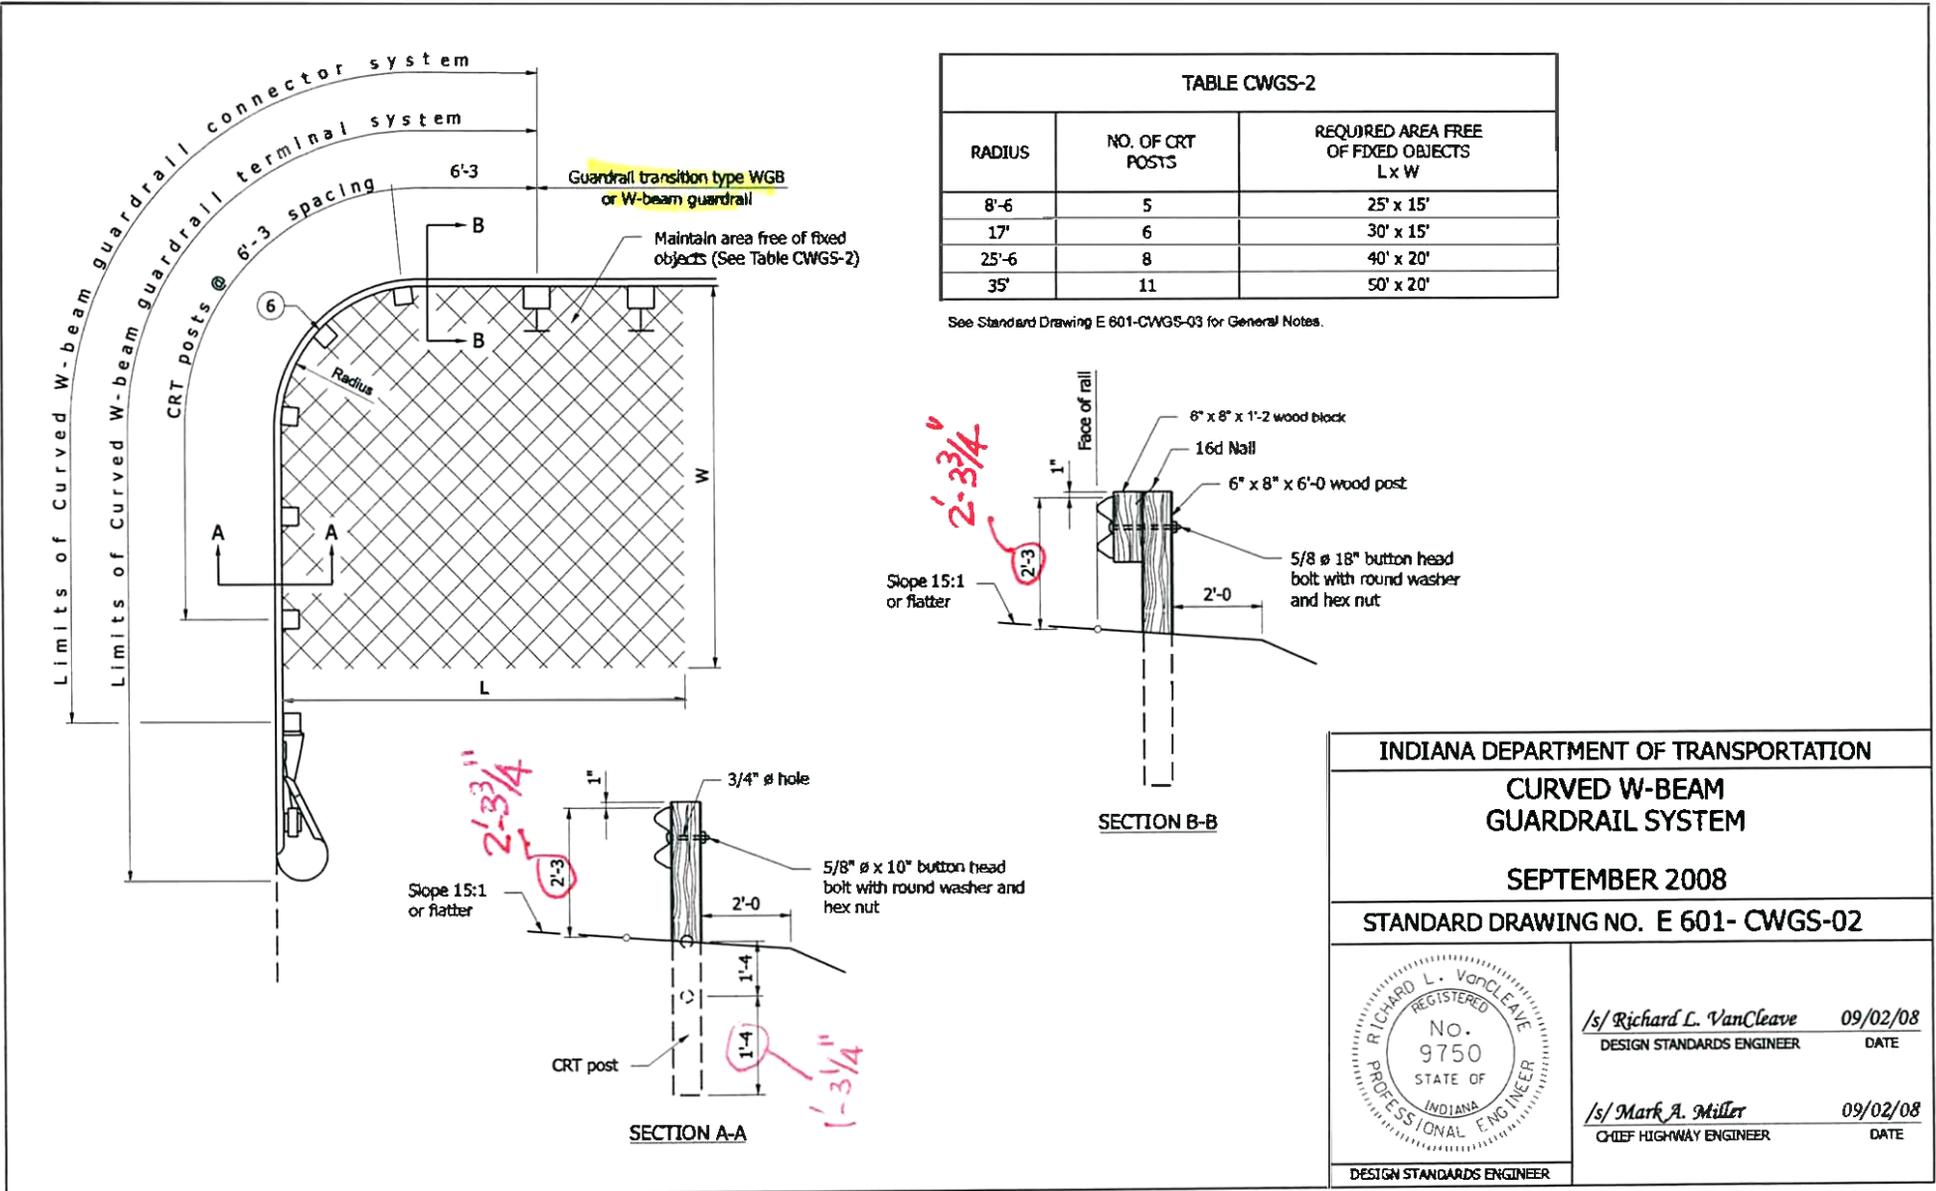


REVISION TO THE STANDARD DRAWINGS AND RECURRING PLAN DETAILS
 REVISION TO 601-CWGS-04 CURVED W-BEAM GUARDRAIL SYSTEM

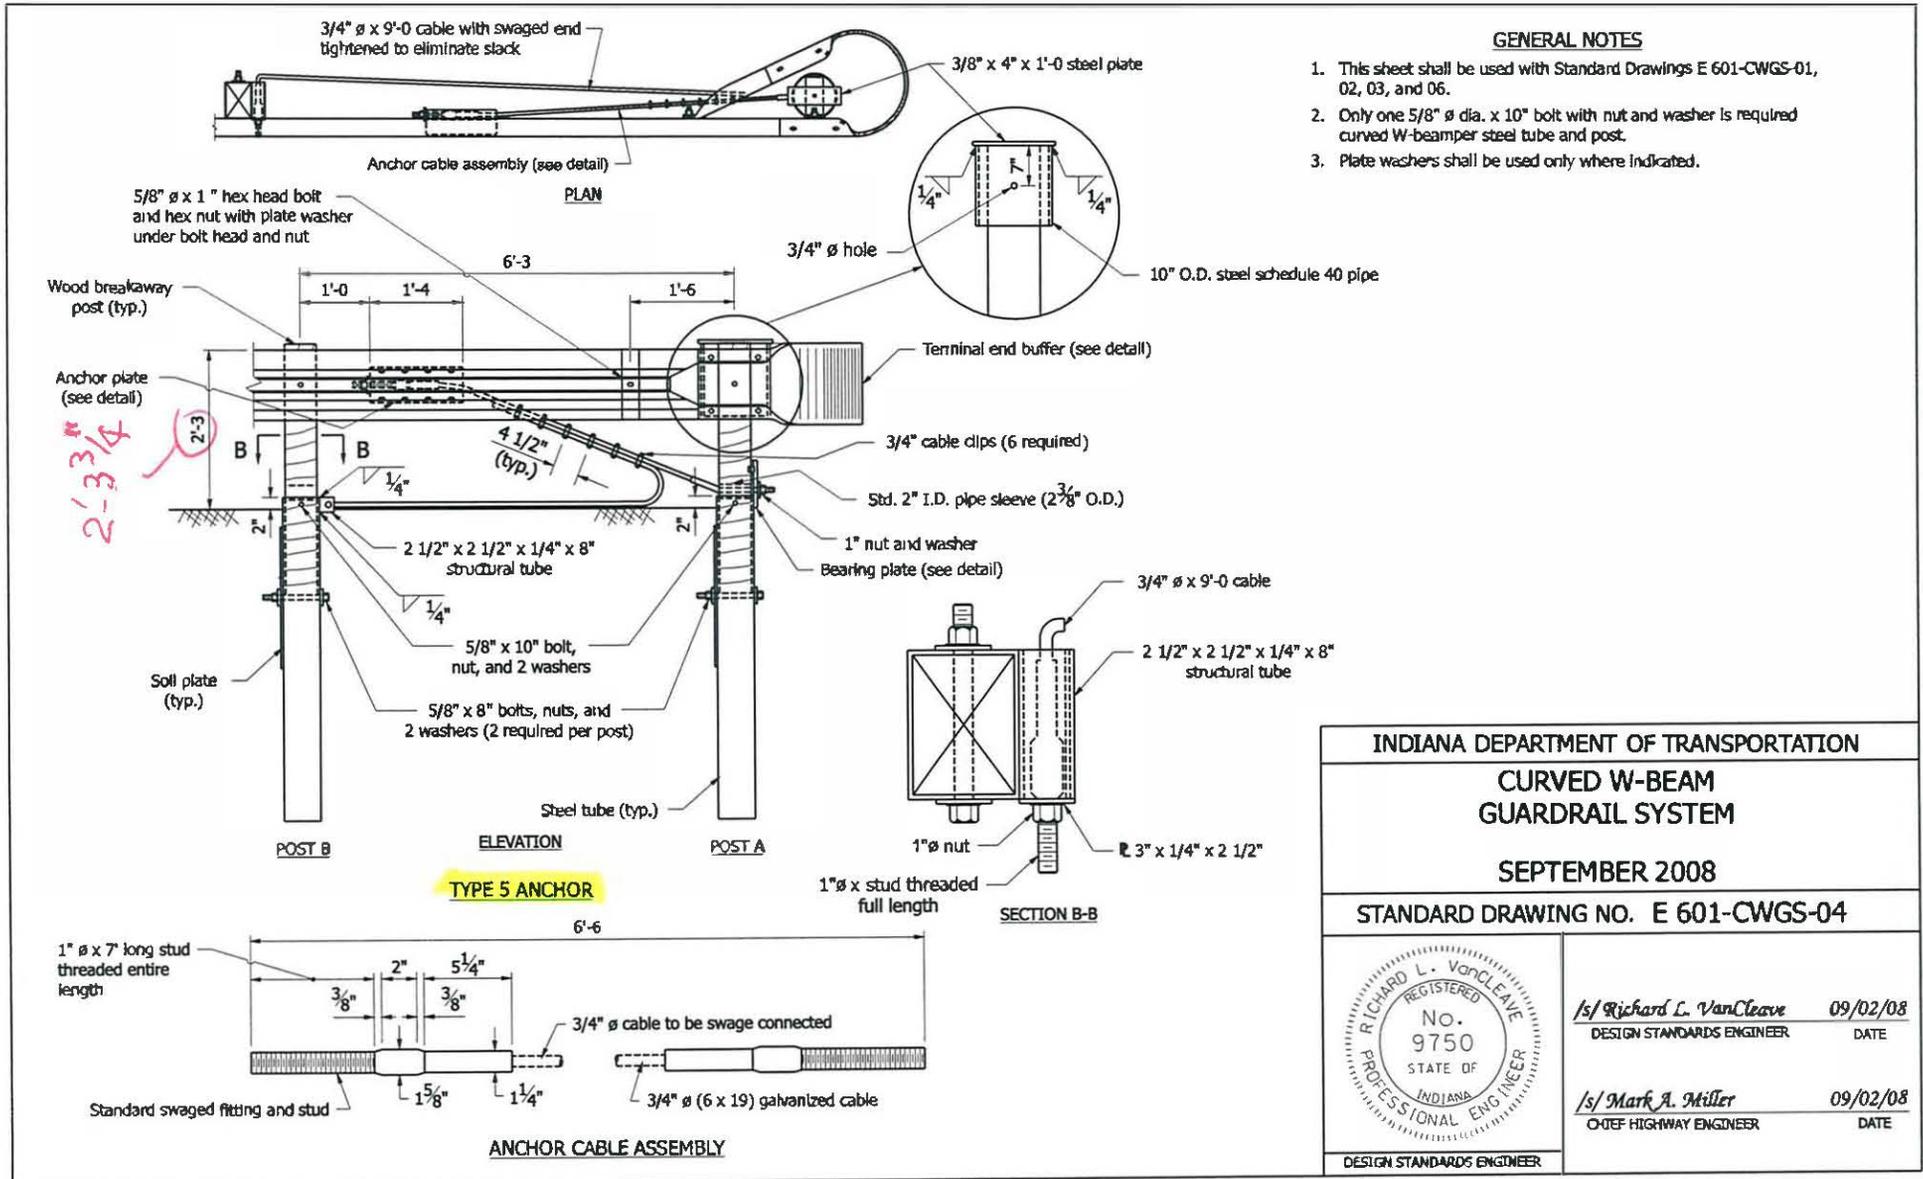


INDIANA DEPARTMENT OF TRANSPORTATION	
CURVED W-BEAM GUARDRAIL SYSTEM	
SEPTEMBER 2008	
STANDARD DRAWING NO. E 601-CWGS-04	
	<i>/s/ Richard L. VanCleave</i> 09/02/08 DESIGN STANDARDS ENGINEER DATE
	<i>/s/ Mark A. Miller</i> 09/02/08 CHIEF HIGHWAY ENGINEER DATE
DESIGN STANDARDS ENGINEER	

REVISION TO THE STANDARD DRAWINGS AND RECURRING PLAN DETAILS
 REVISION TO 601-MTGR-01 THRIE BEAM GUARDRAIL DETAILS

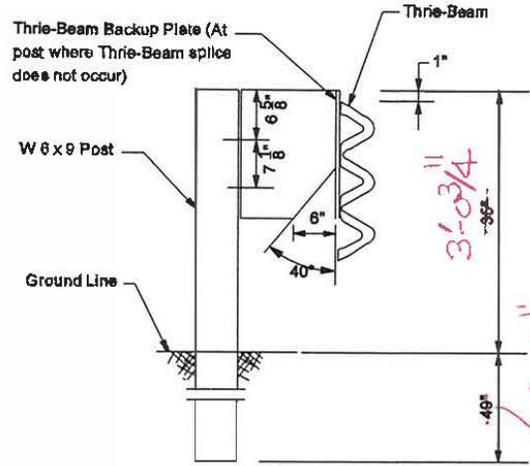

THRIE BEAM GUARDRAIL

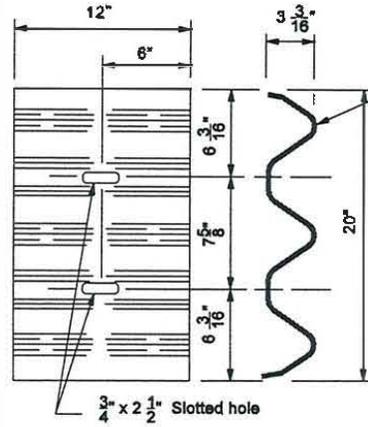


Cross section dimensions shall conform to those shown on Standard Drawing E 601-TGBC-01.


THRIE BEAM GUARDRAIL BACK-UP PLATE
 AT LOCATIONS WITHOUT SPLICE

Notes:

1. For Thrie Beam rail section details, see Standard Drawing E 601-TBGC-01.
2. For W 6x9 post hole pattern details, see Standard Drawings E 601-TTGB-03 and E 601-TTGB-04.
3. Typical post spacing for Thrie Beam Guardrail and Double Faced Thrie Beam Guardrail is 6' - 3".
4. Only the blockout material shown may be used.

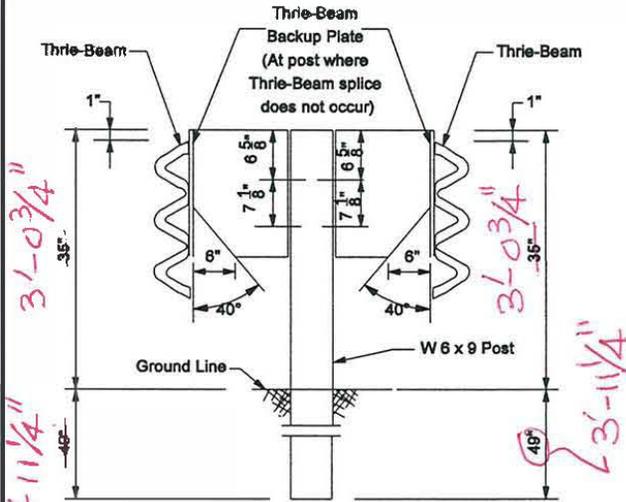


DOUBLE FACED THRIE BEAM GUARDRAIL

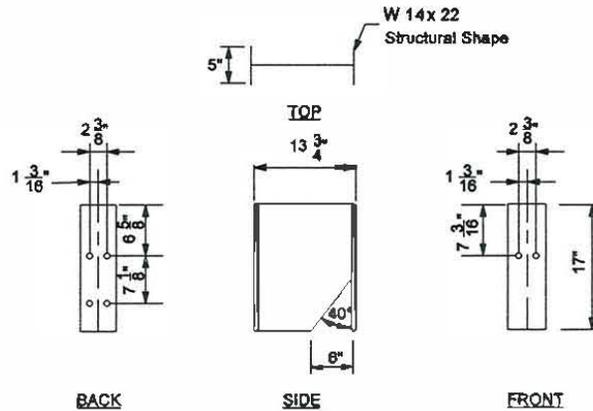

THRIE BEAM GUARDRAIL BLOCKOUT
 (STEEL ONLY)

INDIANA DEPARTMENT OF TRANSPORTATION	
THRIE BEAM GUARDRAIL DETAILS	
MARCH 2005	
STANDARD DRAWING NO. E 601-MTGR-01	
	/s/ Richard L. VanCleave 3-01-05 DESIGN STANDARDS ENGINEER DATE
	/s/ Richard K. Smutzer 3-01-05 CHIEF HIGHWAY ENGINEER DATE
DESIGN STANDARDS ENGINEER	

REVISION TO THE STANDARD DRAWINGS AND RECURRING PLAN DETAILS
 REVISION TO 601-TBGC-01 THRIE-BEAM GUARDRAIL COMPONENTS

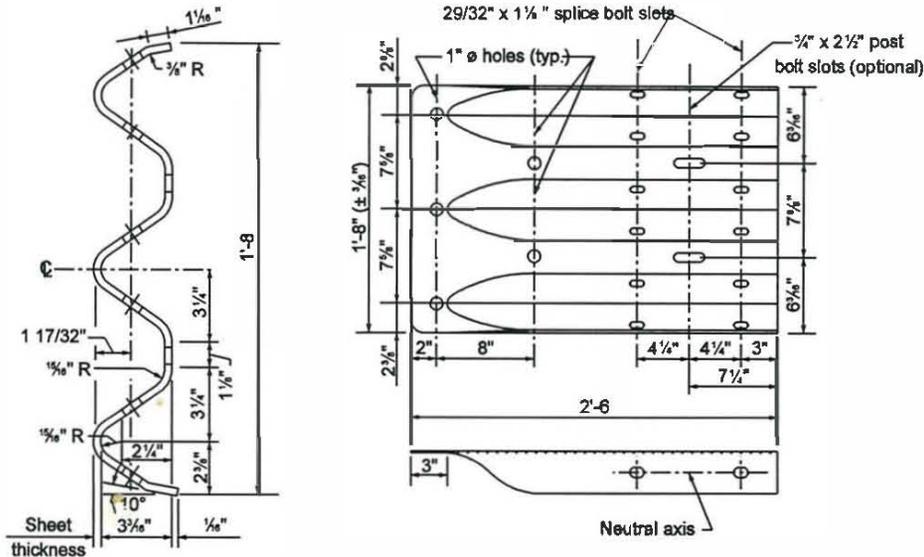


NOTES:

1. This drawing shall be used where thrie-beam guardrail is specified. This drawing shall also be used if a thrie-beam guardrail system requires the use of standard W-beam guardrail components.

THRIE BEAM RAIL SECTION


**THRIE BEAM
 TERMINAL CONNECTOR**

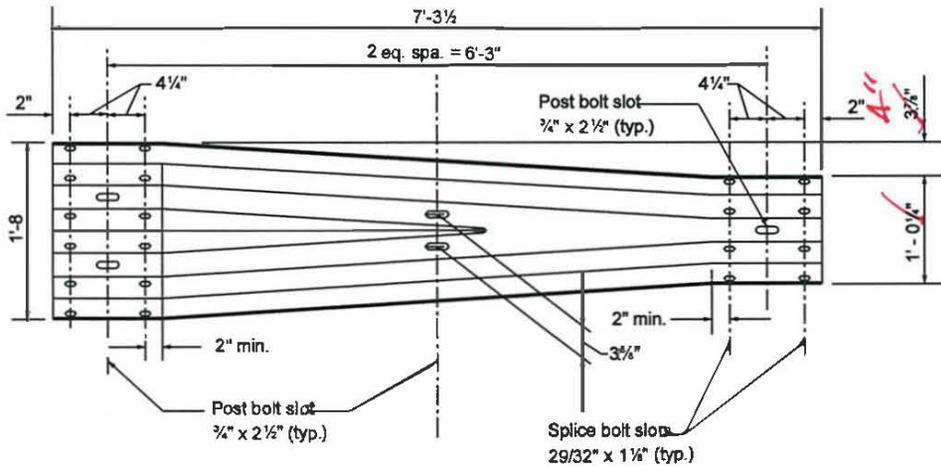


W-THRIE BEAM TRANSITION SECTION

INDIANA DEPARTMENT OF TRANSPORTATION	
THRIE-BEAM GUARDRAIL COMPONENTS	
MARCH 2003	
STANDARD DRAWING NO. E 601-TBGC-01	
	<i>/s/ Richard L. VanCleave</i> 3-03-03 DESIGN STANDARDS ENGINEER DATE
	<i>/s/ Richard K. Smutzer</i> 3-03-03 CHIEF HIGHWAY ENGINEER DATE
DESIGN STANDARDS ENGINEER	


REVISION TO THE STANDARD DRAWINGS AND RECURRING PLAN DETAILS
 REVISION TO 601-TTGB-01 GUARDRAIL TRANSITION TYPE TGB

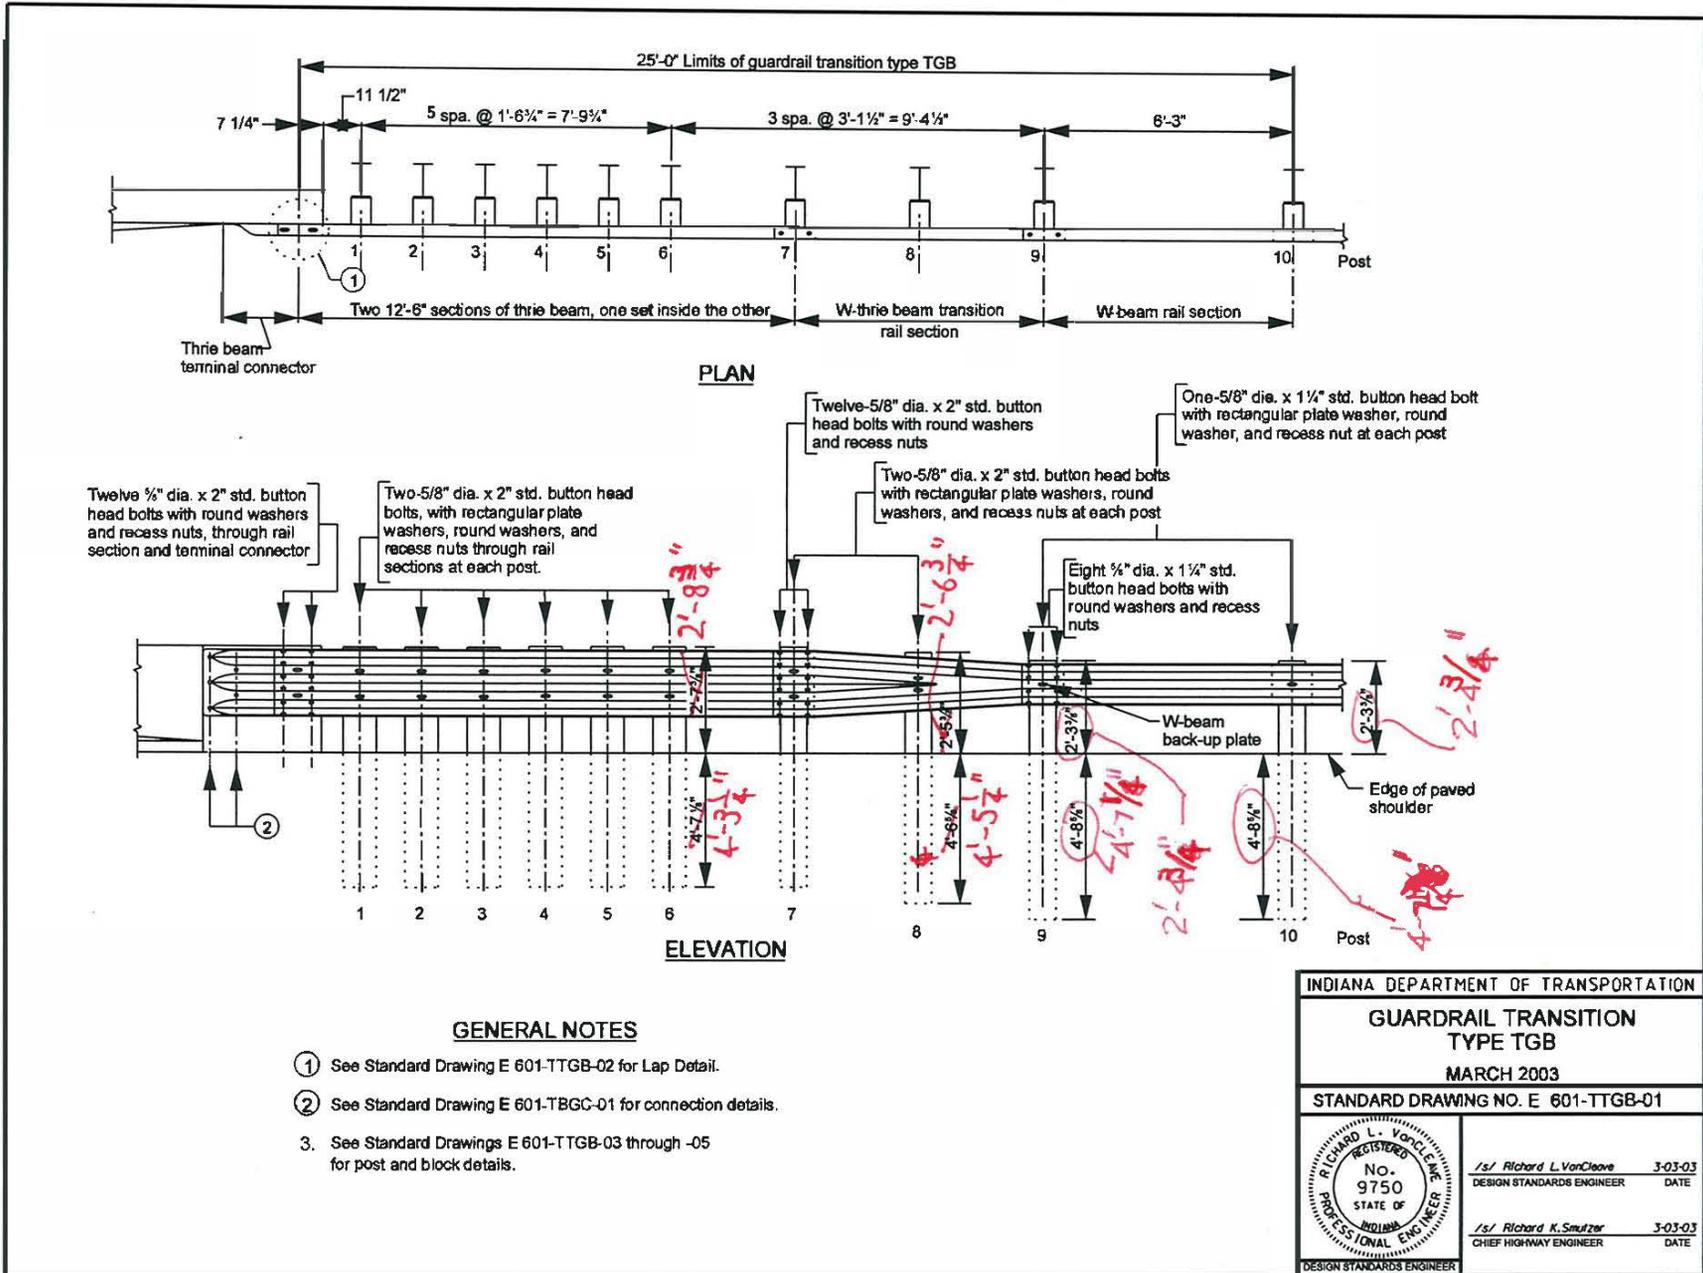

REVISION TO THE STANDARD DRAWINGS AND RECURRING PLAN DETAILS
 REVISION TO 601-TTGB-03 GUARDRAIL TRANSITION TYPE TGB

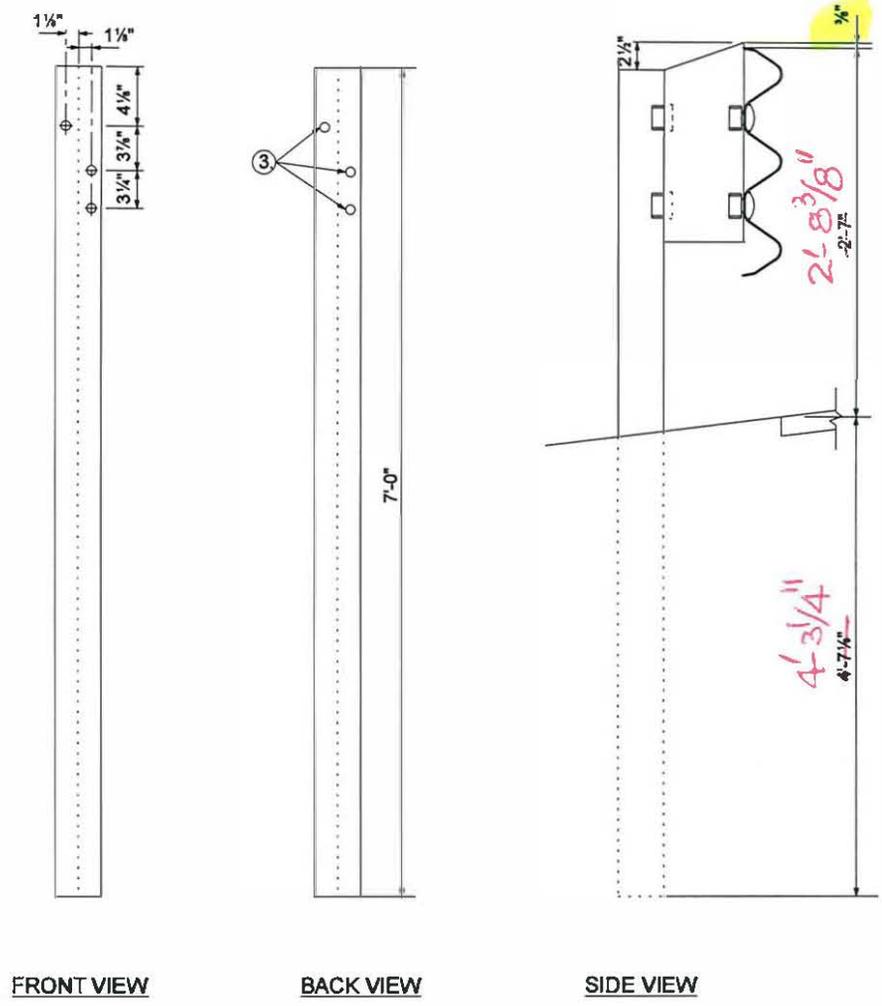


W6 x 9 POST DETAILS

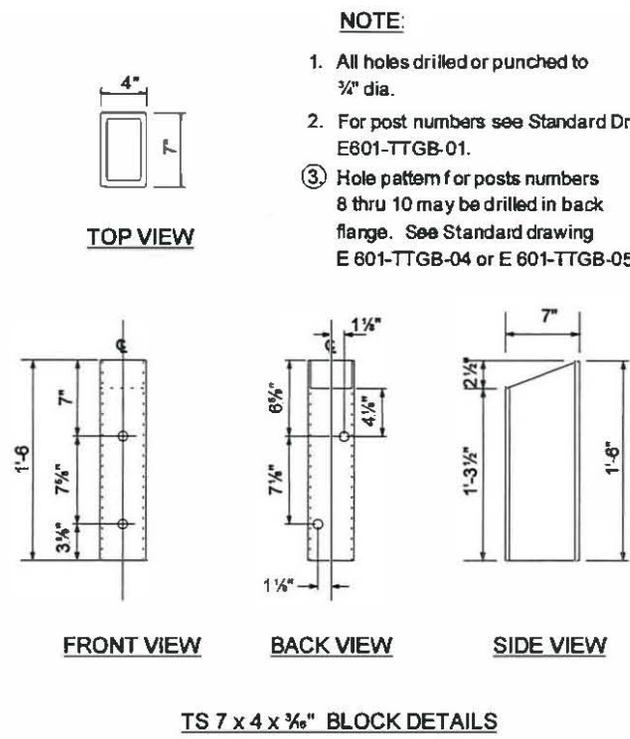


POSTS 1 THRU 7

INDIANA DEPARTMENT OF TRANSPORTATION	
GUARDRAIL TRANSITION TYPE TGB	
MARCH 2004	
STANDARD DRAWING NO. E 601-TTGB-03	
	/s/ Richard L. VanCleave 3-01-04 DESIGN STANDARDS ENGINEER DATE
	/s/ Richard K. Smutzer 3-01-04 CHIEF HIGHWAY ENGINEER DATE
DESIGN STANDARDS ENGINEER	


REVISION TO THE STANDARD DRAWINGS AND RECURRING PLAN DETAILS
 REVISION TO 601-TTGB-04 GUARDRAIL TRANSITION TYPE TGB

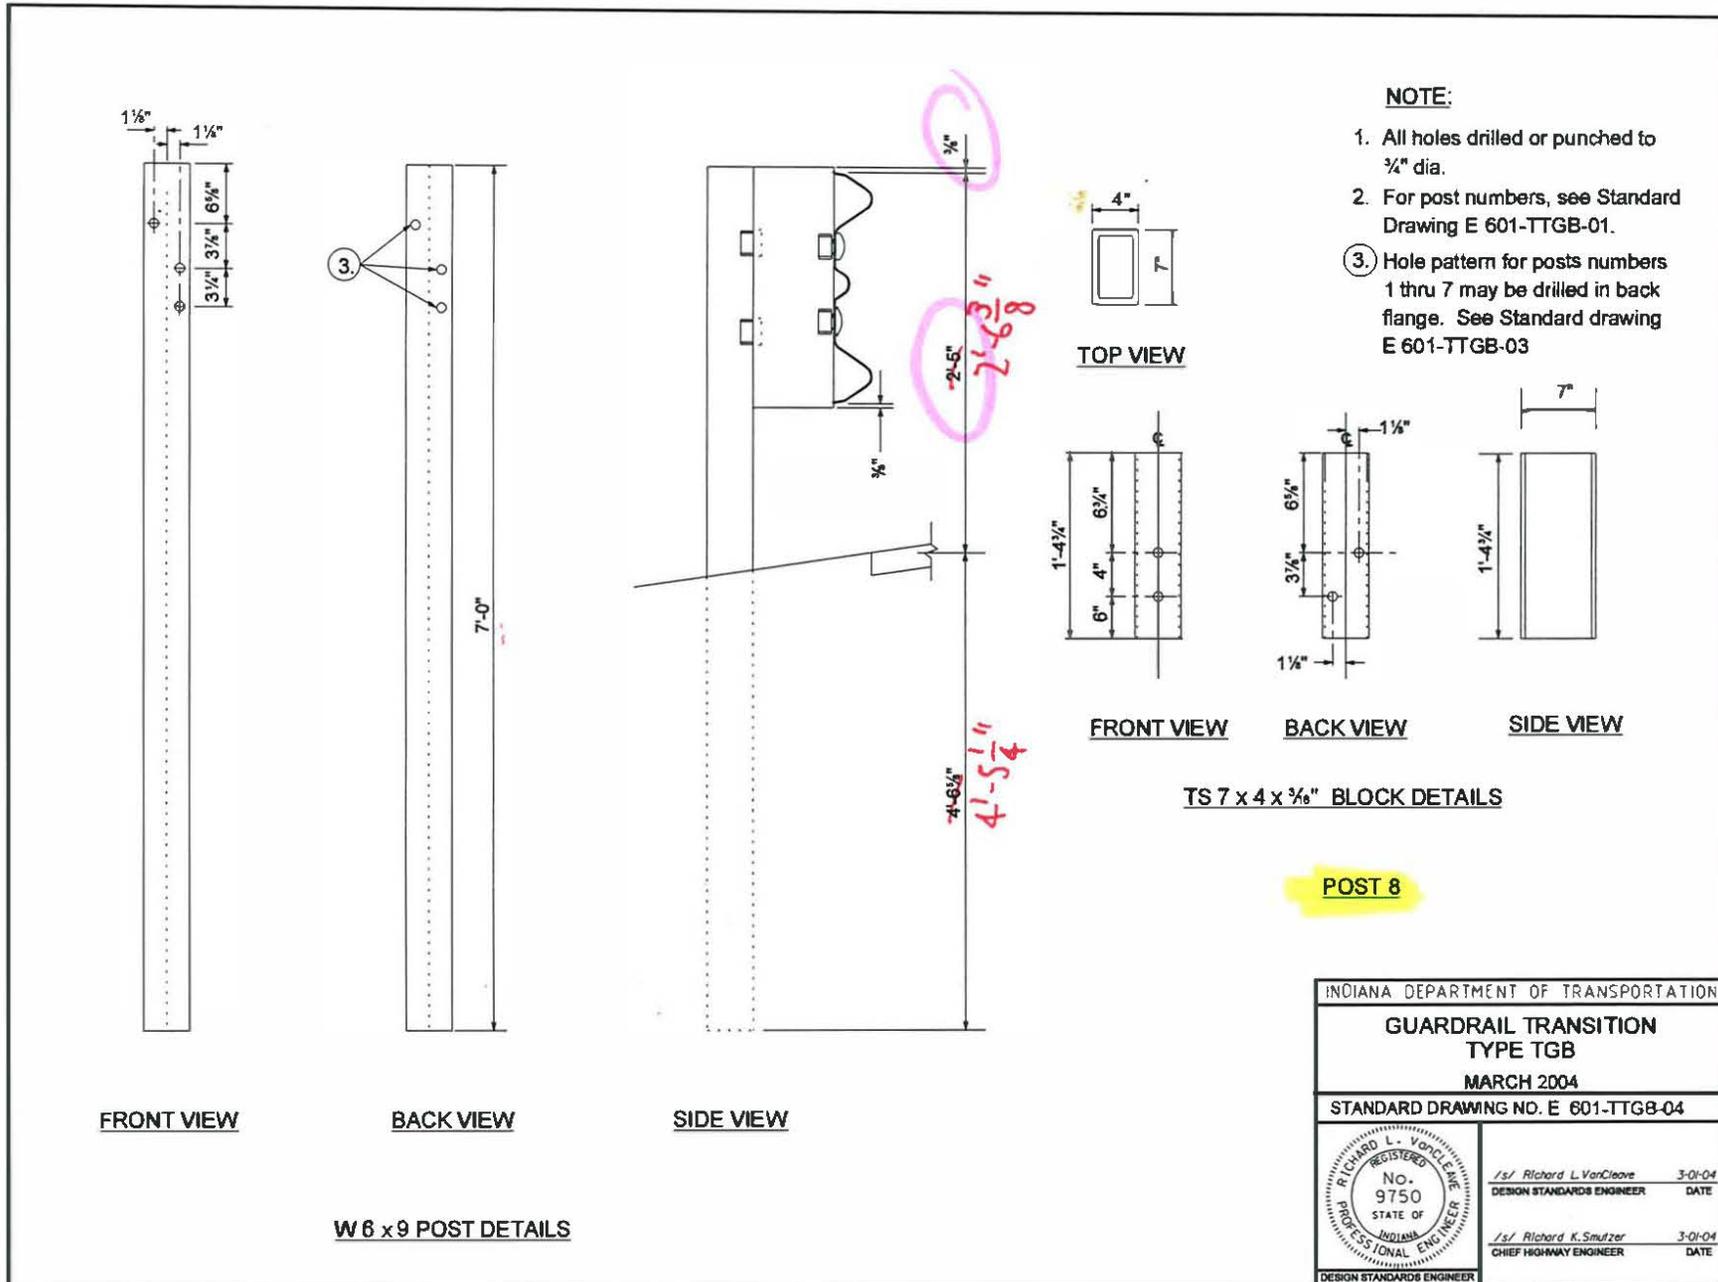

REVISION TO THE STANDARD DRAWINGS AND RECURRING PLAN DETAILS
 REVISION TO 601-TTGB-05 GUARDRAIL TRANSITION TYPE TGB

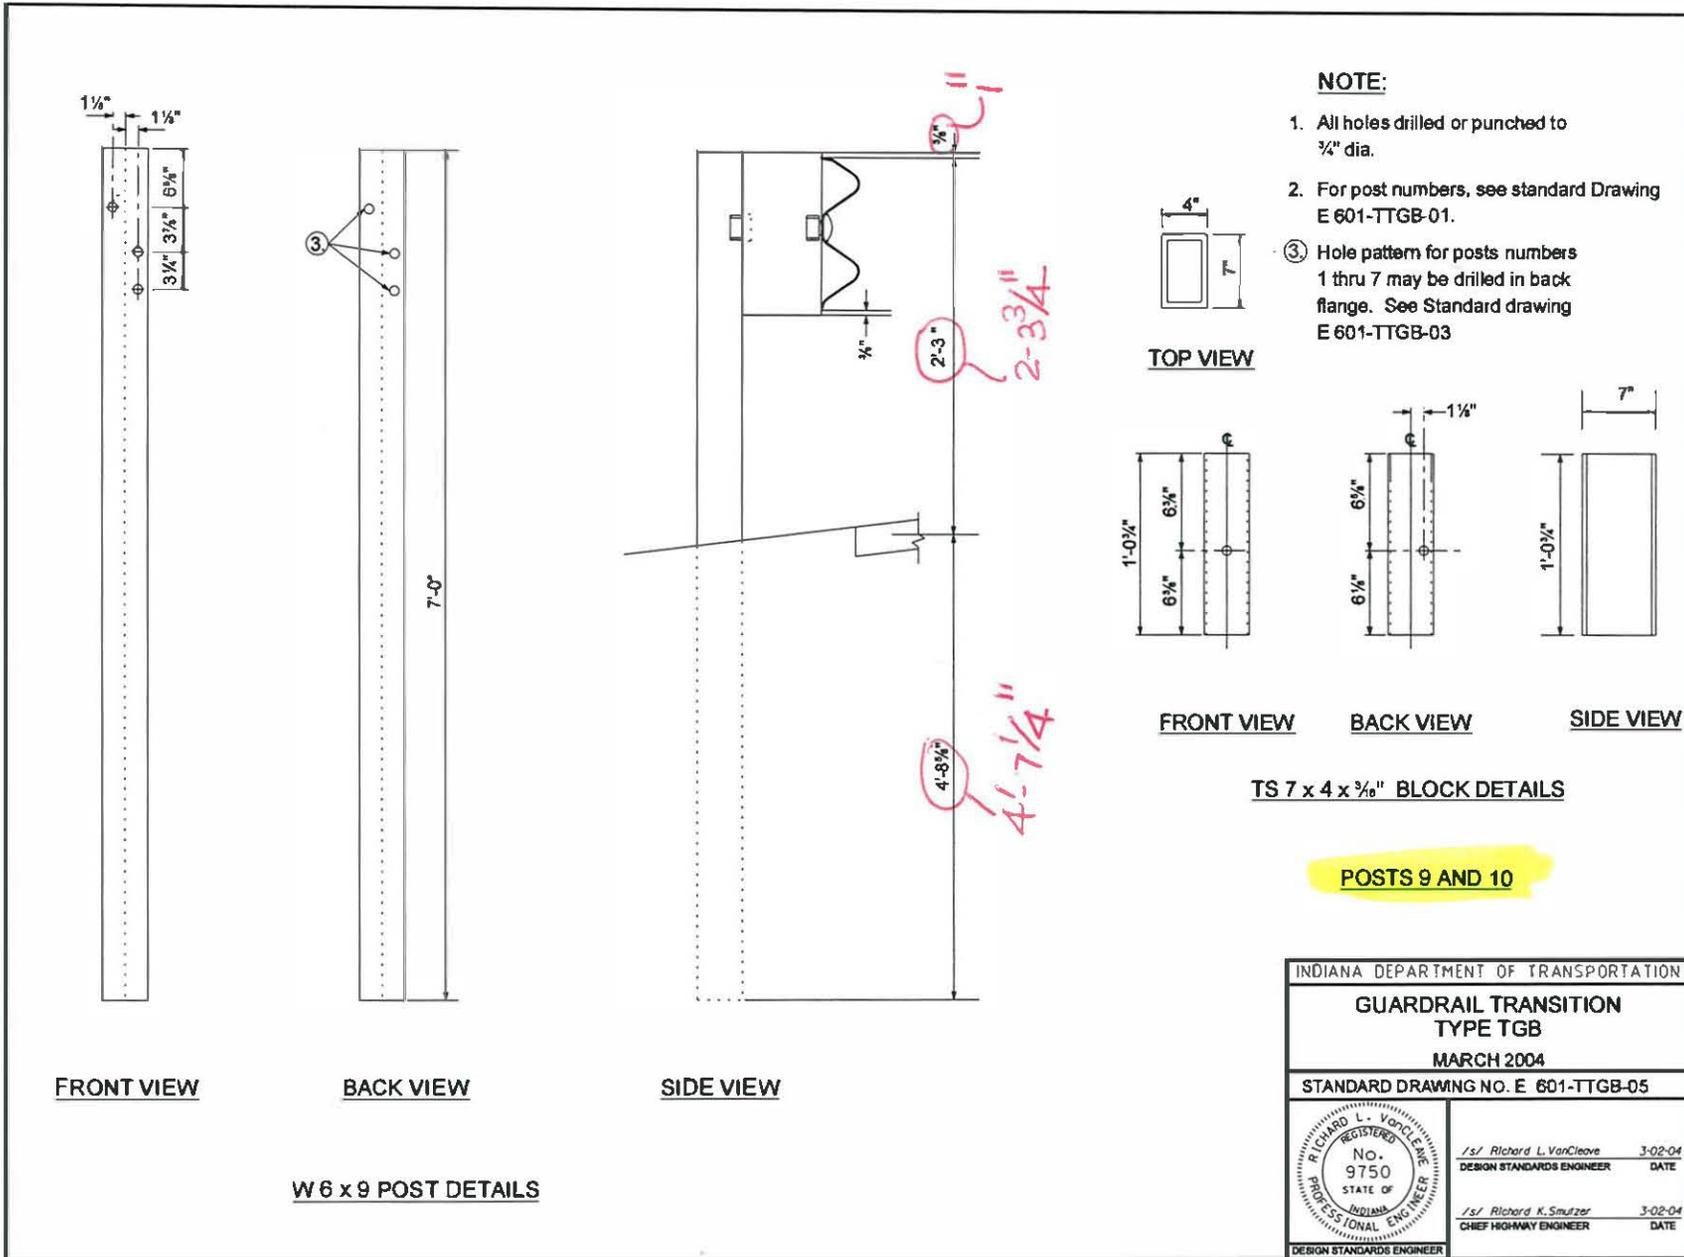


REVISION TO THE STANDARD DRAWINGS AND RECURRING PLAN DETAILS
 REVISION TO 601-TTGP-01 GUARDRAIL TRANSITION TYPE GP

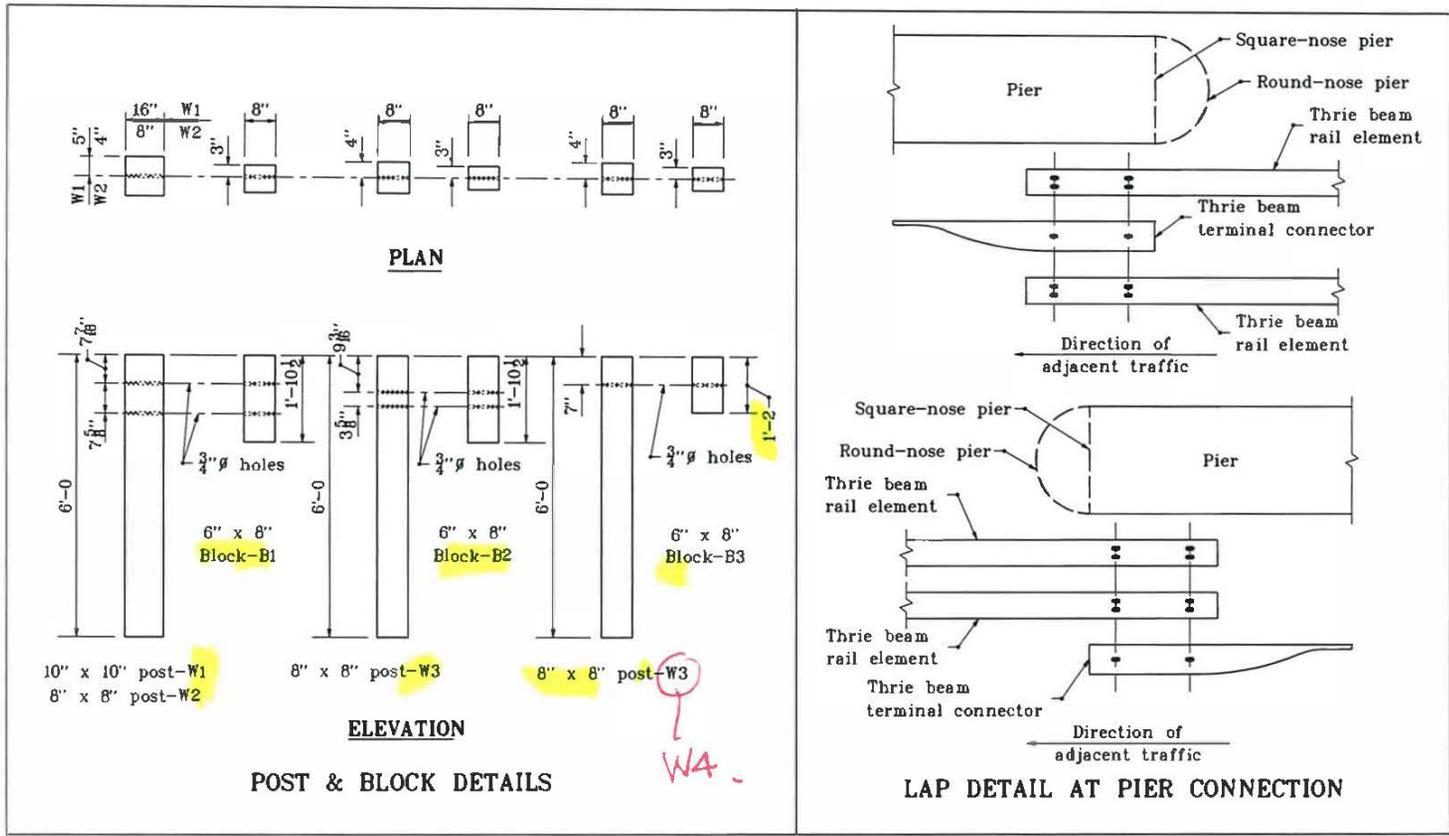

INDIANA DEPARTMENT OF TRANSPORTATION	
GUARDRAIL TRANSITION TYPE GP	
APRIL 1995	
STANDARD DRAWING NO. E 601-TTGP-01	
DETAILS PLACED IN THIS FORMAT	11-15-99
	
/s/ Anthony L. Uremovich	11-15-99
DESIGN STANDARDS ENGINEER	DATE
/s/ Pirooz Zandi	11-15-99
CHIEF HIGHWAY ENGINEER	DATE
DESIGN STANDARDS ENGINEER	ORIGINALLY APPROVED 4-03-95

REVISION TO THE STANDARD DRAWINGS AND RECURRING PLAN DETAILS
 REVISION TO 601-TTGP-02 GUARDRAIL TRANSITION TYPE GP

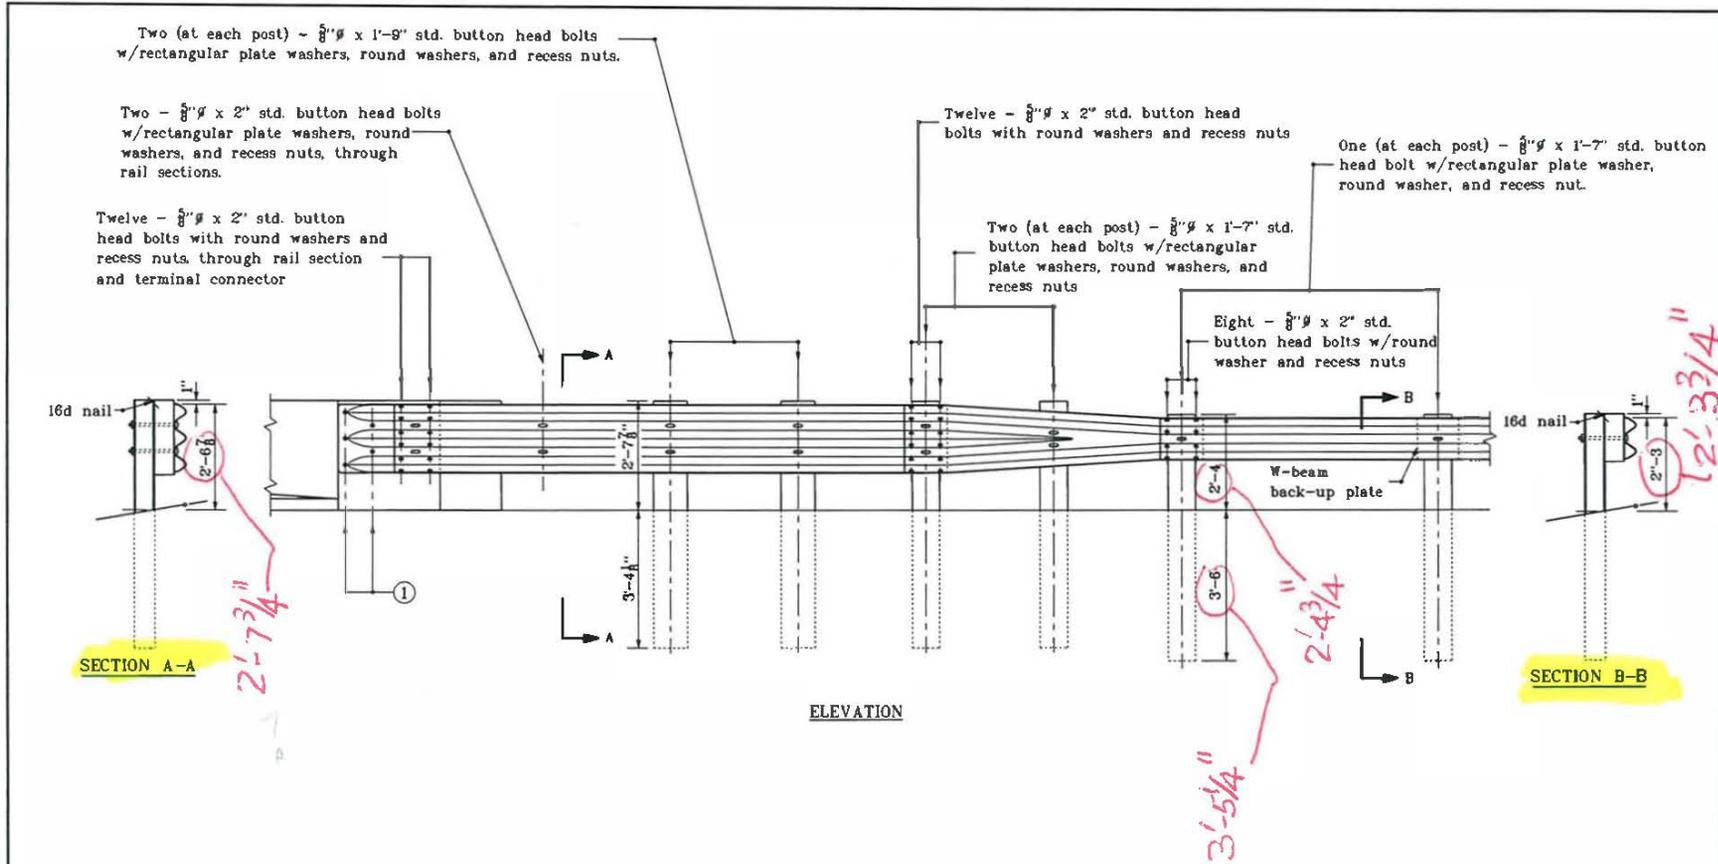


NOTES

- ① See pier connection details for connection of terminal connector. See Standard Drawing E 601-TTGP-01 (use proper end detail).

INDIANA DEPARTMENT OF TRANSPORTATION	
GUARDRAIL TRANSITION TYPE GP	
APRIL 1996	
STANDARD DRAWING NO. E 601-TTGP-02	
DETAILS PLACED IN THIS FORMAT 11-15-99	
	/s/ Anthony L. Uremovich 11-15-99 DESIGN STANDARDS ENGINEER DATE
	/s/ Firooz Zandi 11-15-99 CHIEF HIGHWAY ENGINEER DATE
	ORIGINALLY APPROVED 4-01-96

REVISION TO THE STANDARD DRAWINGS AND RECURRING PLAN DETAILS
 REVISION TO 601-TTGT-01 GUARDRAIL TRANSITION, TGT

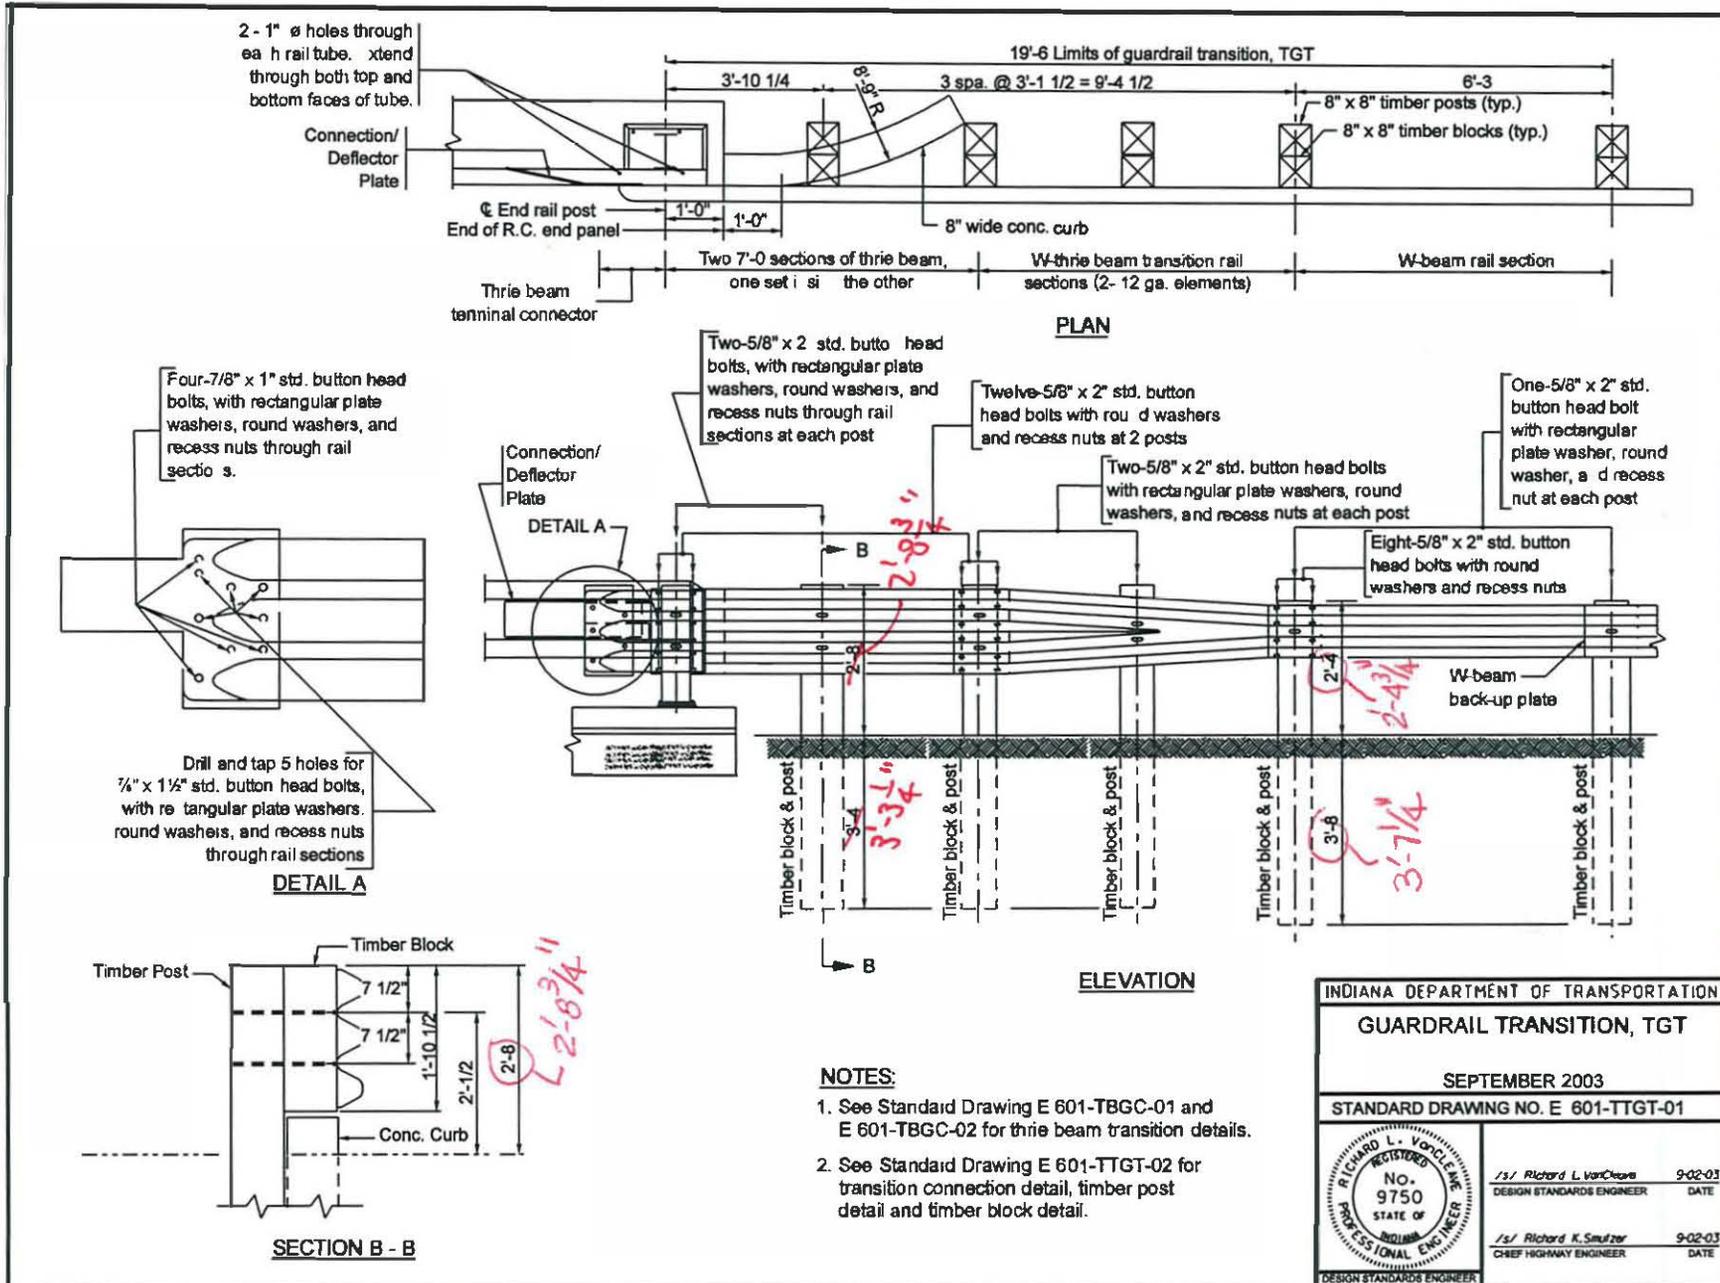


- NOTES:**
1. See Standard Drawing E 601-TBGC-01 and E 601-TBGC-02 for thrie beam transition details.
 2. See Standard Drawing E 601-TTGT-02 for transition connection detail, timber post detail and timber block detail.

INDIANA DEPARTMENT OF TRANSPORTATION	
GUARDRAIL TRANSITION, TGT	
SEPTEMBER 2003	
STANDARD DRAWING NO. E 601-TTGT-01	
	/s/ Richard L. Vance DESIGN STANDARDS ENGINEER 9-02-03 DATE
	/s/ Richard K. Smutzer CHIEF HIGHWAY ENGINEER 9-02-03 DATE

REVISION TO THE STANDARD DRAWINGS AND RECURRING PLAN DETAILS


REVISION TO 601-TTMS-01 DOUBLE FACED THRIE BEAM GUARDRAIL TRANSITION TO GRET TYPE MS

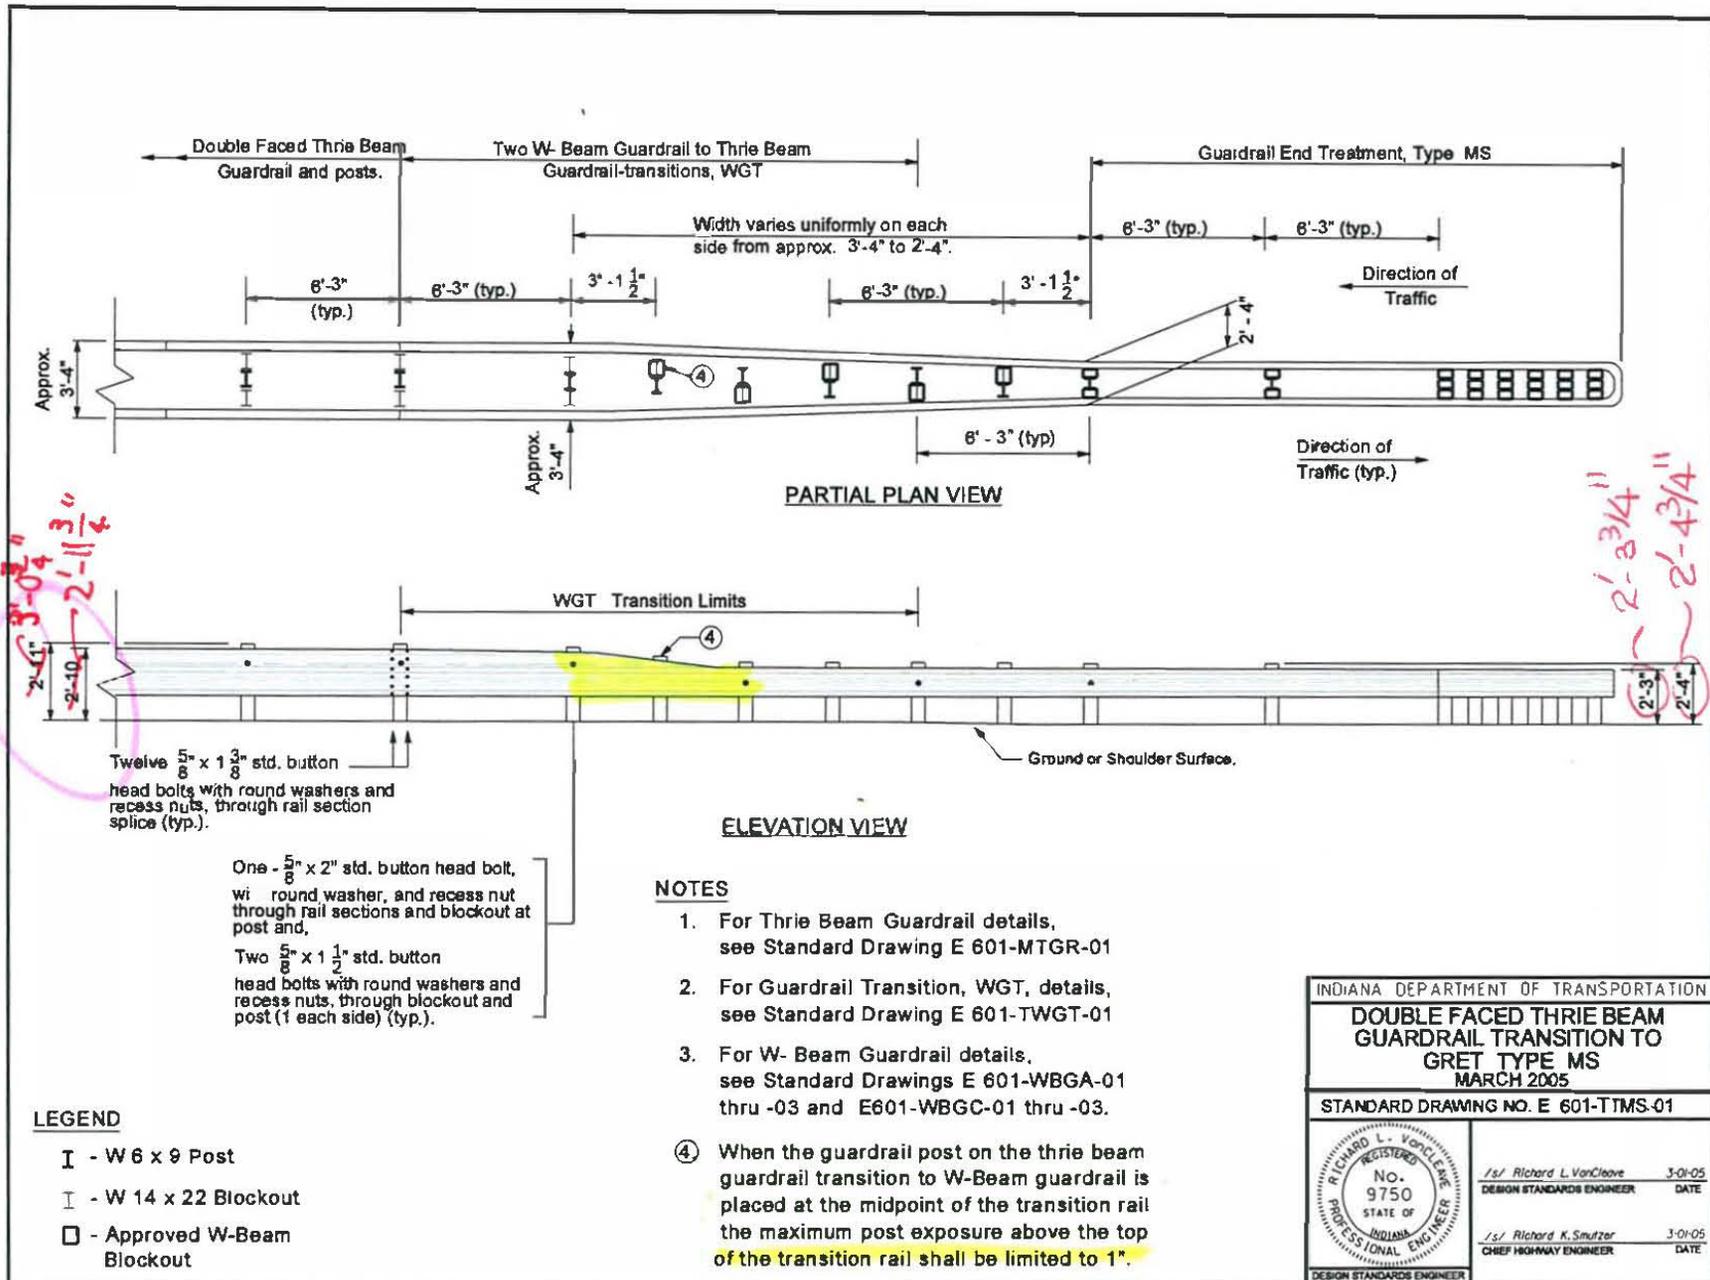

REVISION TO THE STANDARD DRAWINGS AND RECURRING PLAN DETAILS
 REVISION TO 601-TTVH-01 GUARDRAIL TRANSITION TYPE VH

NOTES


1. This transition shall be used where new W-beam guardrail is being attached to existing rub-railed W-beam guardrail. This transition shall also be used where a new lower height guardrail end treatment is being attached to existing rub-railed type guardrail.
2. These details are for the height adjustment of existing rub-railed type guardrail.
3. If rub-rail is not spliced at post, the channel shall be cut and repositioned behind the flange.
4. If rub-rail is spliced at post, the splice material shall be removed and the channel shall be repositioned behind the flange.

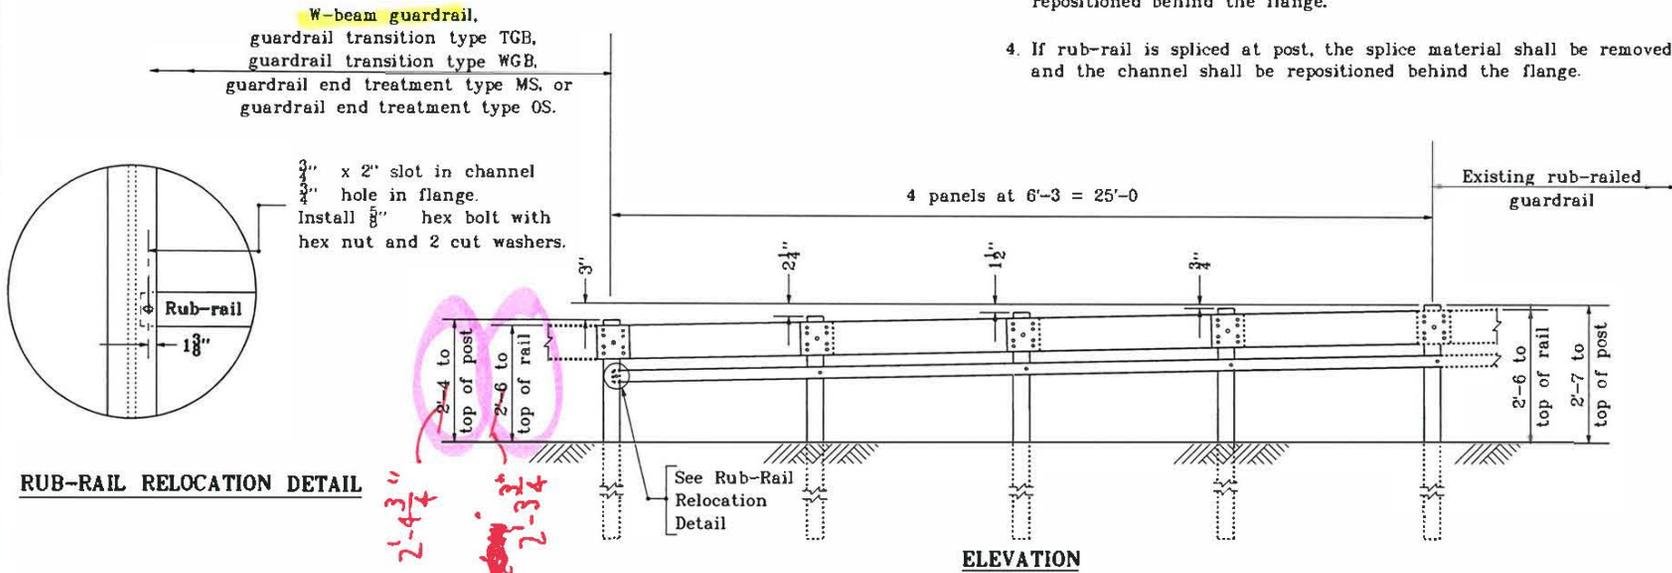

GUARDRAIL TRANSITION TYPE VH AT 6'-3" POST SPACING

INDIANA DEPARTMENT OF TRANSPORTATION	
GUARDRAIL TRANSITION TYPE VH	
APRIL 1995	
STANDARD DRAWING NO. E 601-TTVH-01	
	DETAILS PLACED IN THIS FORMAT 11-15-99 /s/ Anthony L. Uremovich 11-15-99 <small>DESIGN STANDARDS ENGINEER DATE</small>
<small>DESIGN STANDARDS ENGINEER</small>	/s/ Firooz Zandi 11-15-99 <small>CHIEF HIGHWAY ENGINEER DATE</small> <small>ORIGINALLY APPROVED 4-03-95</small>

REVISION TO THE STANDARD DRAWINGS AND RECURRING PLAN DETAILS
 REVISION TO 601-TTVH-02 GUARDRAIL TRANSITION TYPE VH

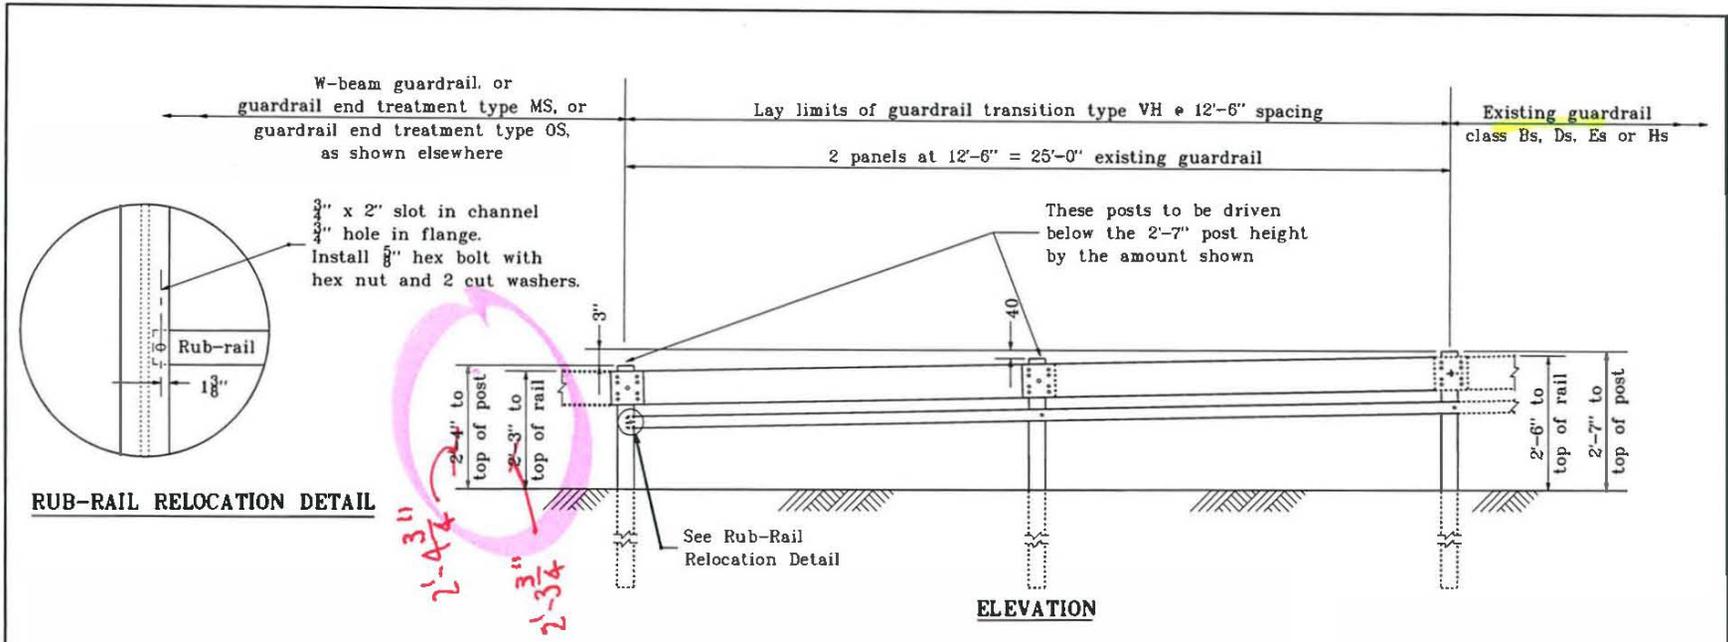

RUB-RAIL RELOCATION DETAIL


GUARDRAIL TRANSITION TYPE VH AT 12'-6" POST SPACING

GENERAL NOTES


1. The details on this sheet are for the height adjustment of existing rub-rail type guardrail.
2. Guardrail transition type VH at 12'-6" post spacing shall be used where new W-beam guardrail is being attached to existing rub-rail type W-beam guardrail at 12'-6" post spacing. This transition shall also be used where a new lower height guardrail end treatment is being attached to existing 12'-6" spaced rub-rail type guardrail.
3. If rub-rail is not spliced at post, the channel shall be cut and repositioned behind the flange.
4. If rub-rail is spliced at post, the splice material shall be removed and the channel shall be repositioned behind the flange.

INDIANA DEPARTMENT OF TRANSPORTATION	
GUARDRAIL TRANSITION TYPE VH	
APRIL 1995	
STANDARD DRAWING NO. E 601-TTVH-02	
DETAILS PLACED IN THIS FORMAT 11-15-99	
	/s/ Anthony L. Uremovich 11-15-89 DESIGN STANDARDS ENGINEER DATE
	/s/ Firooz Zandi 11-15-89 CHIEF HIGHWAY ENGINEER DATE
	DESIGN STANDARDS ENGINEER ORIGINALLY APPROVED 4-03-95

REVISION TO THE STANDARD DRAWINGS AND RECURRING PLAN DETAILS
 REVISION TO 601-TWGB-03 GUARDRAIL TRANSITION TYPE WGB

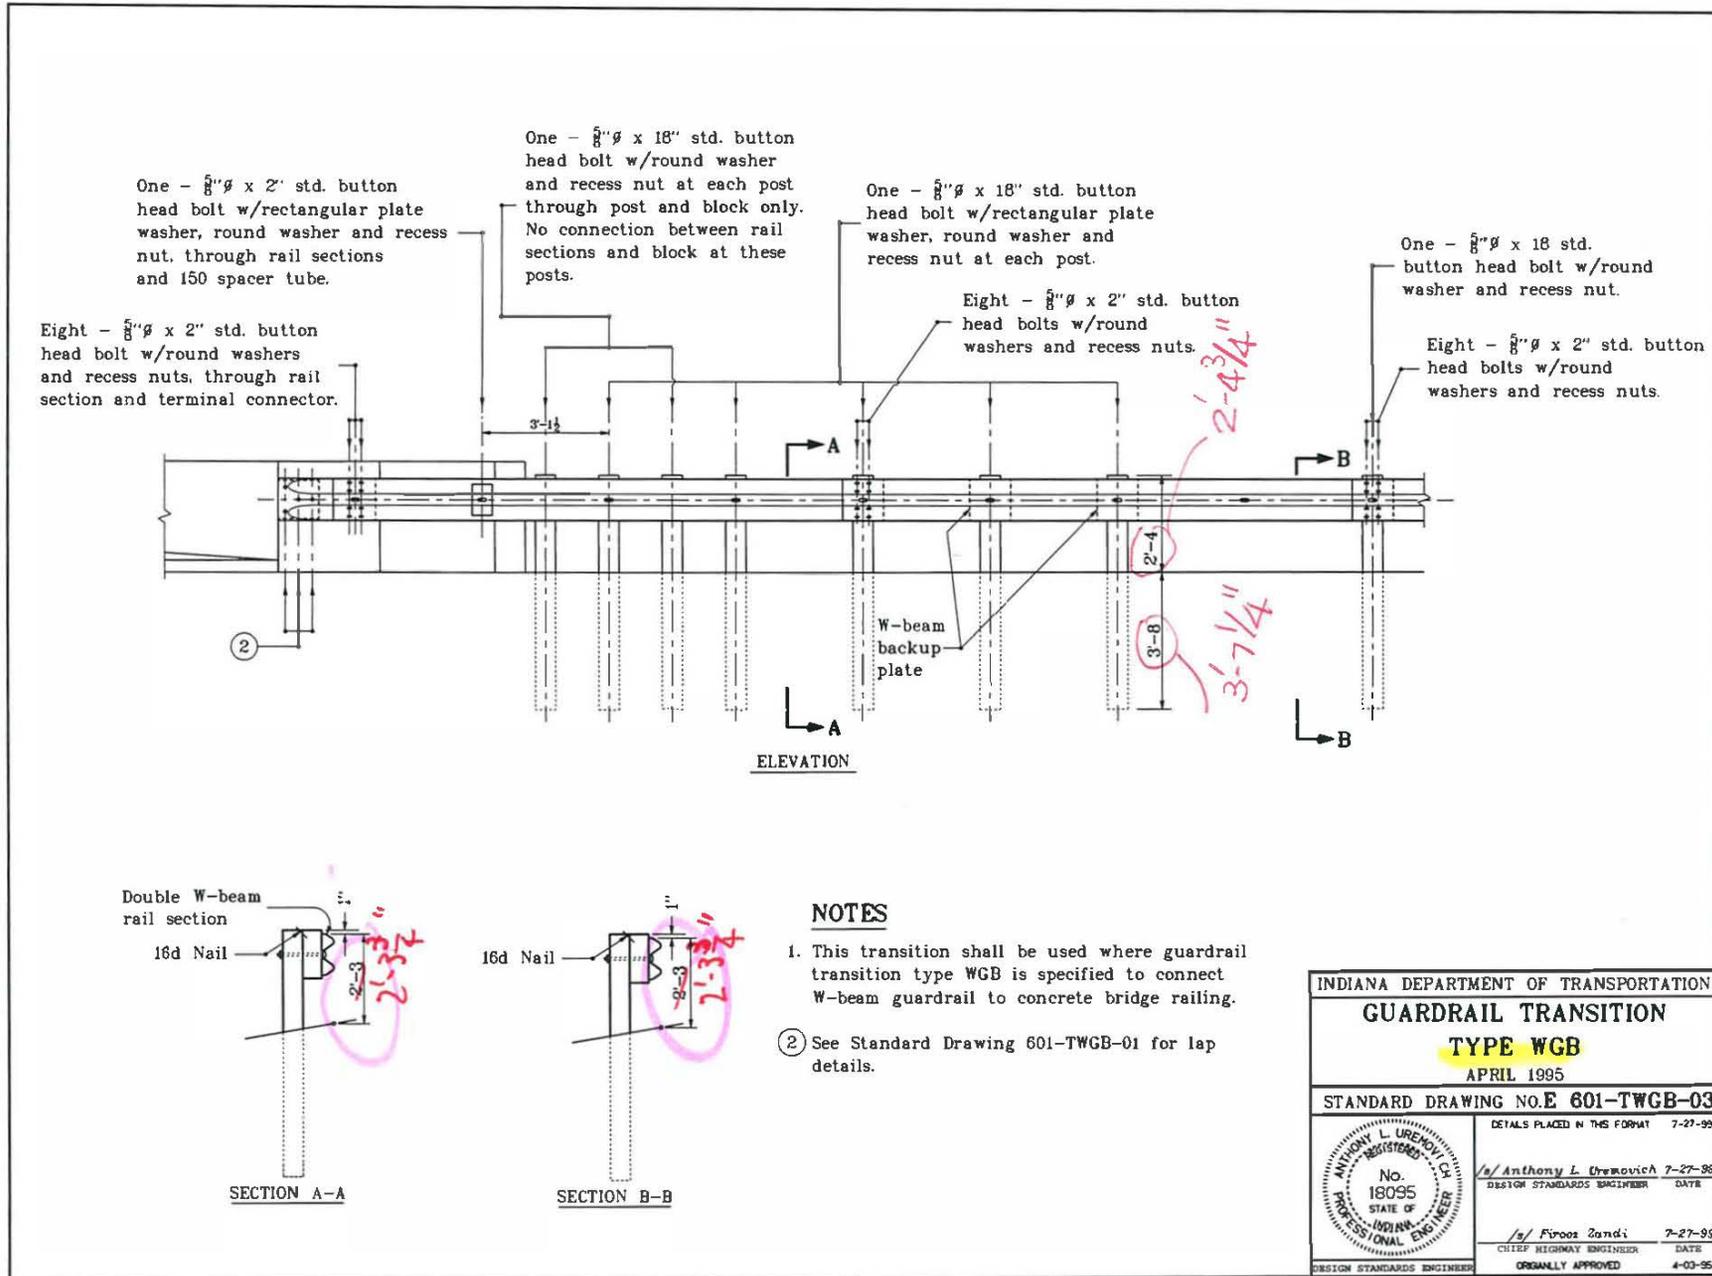

REVISION TO THE STANDARD DRAWINGS AND RECURRING PLAN DETAILS
 REVISION TO 601-TWGT-01 W-BEAM GUARDRAIL TO THRIE BEAM GUARDRAIL TRANSITION, WGT

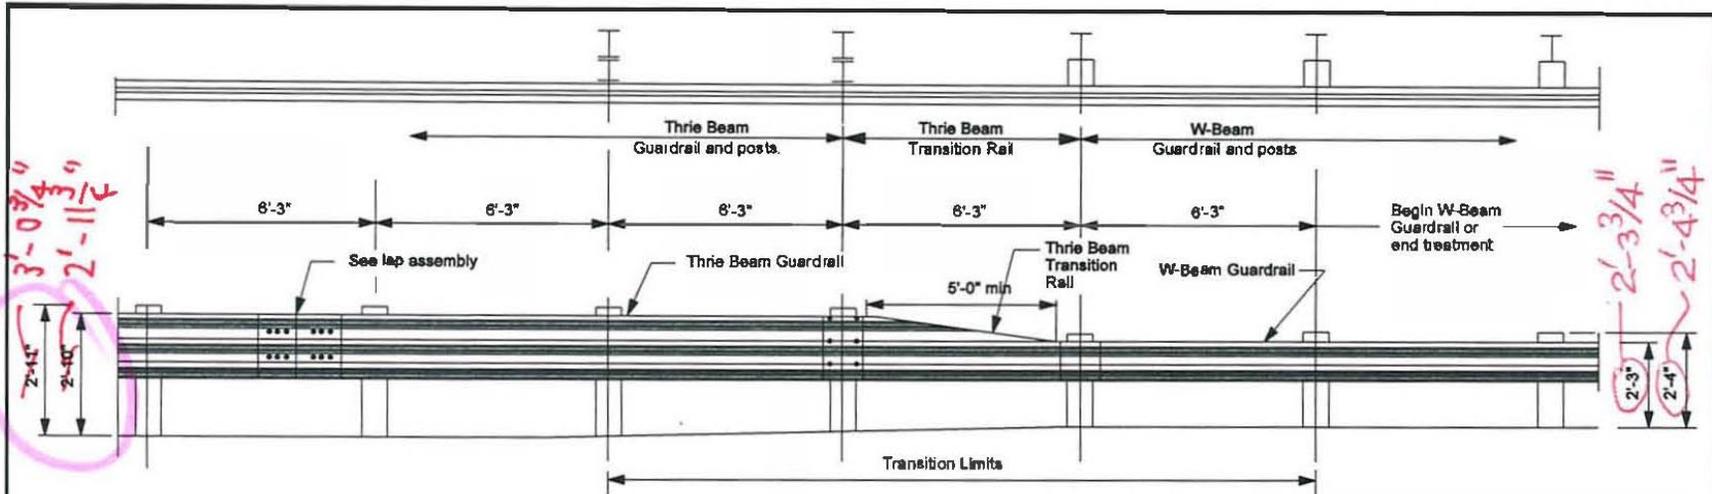



THRIE BEAM TO W-BEAM GUARDRAIL TRANSITION

LEGEND:

- W 6 x 9 Post
- W 14 x 22 Blockout
- Approved W-Beam Blockout.


Notes:

1. For Thrie Beam Guardrail details, see Standard Drawing E 601-MTGR-01.
2. For W-Beam rail details, see Standard Drawing E 601-WBGC-01
3. For W-Beam Guardrail assembly details, see Standard Drawings E 601-WBGA-01 thru -03.
4. Slope on Thrie Beam Transition shall be reversed when thrie beam to W-beam guardrail relative orientation is opposite to that shown hereon.

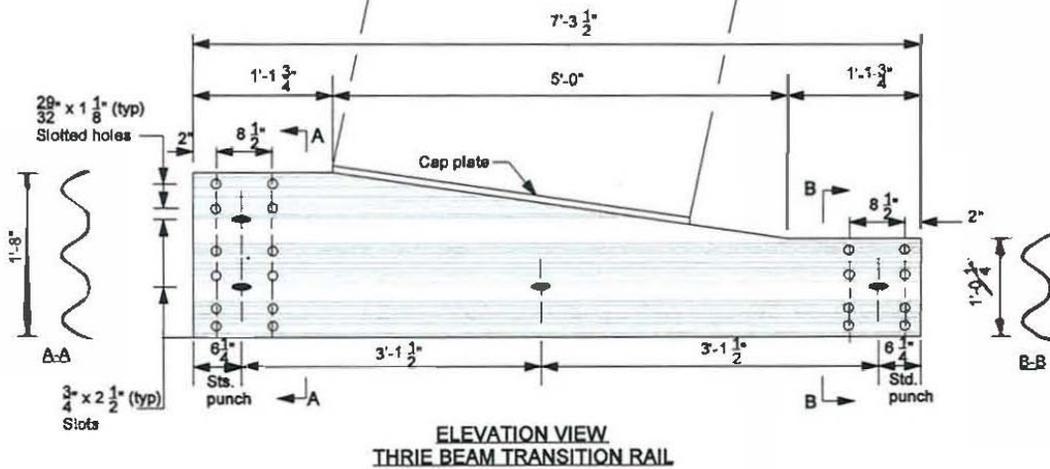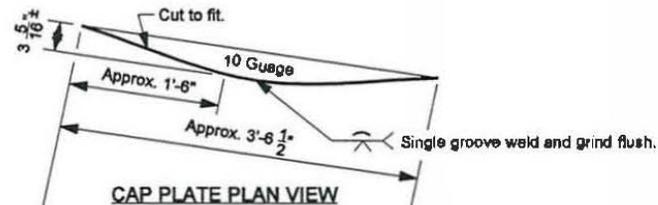


INDIANA DEPARTMENT OF TRANSPORTATION	
W-BEAM GUARDRAIL TO THRIE BEAM GUARDRAIL TRANSITION, WGT	
MARCH 2005	
STANDARD DRAWING NO. E 601-TWGT-01	
	/s/ Richard L. VanCleave 3-01-05 DESIGN STANDARDS ENGINEER DATE
	/s/ Richard K. Smutzer 3-01-05 CHIEF HIGHWAY ENGINEER DATE
DESIGN STANDARDS ENGINEER	

REVISION TO THE STANDARD DRAWINGS AND RECURRING PLAN DETAILS
 REVISION TO 601-WBGA-01 W-BEAM GUARDRAIL ASSEMBLIES

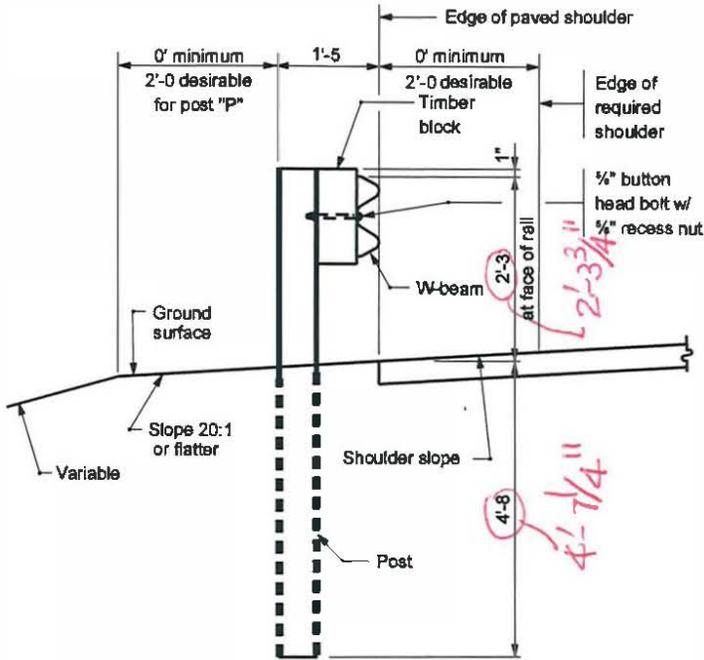


TYPICAL W-BEAM INSTALLATION

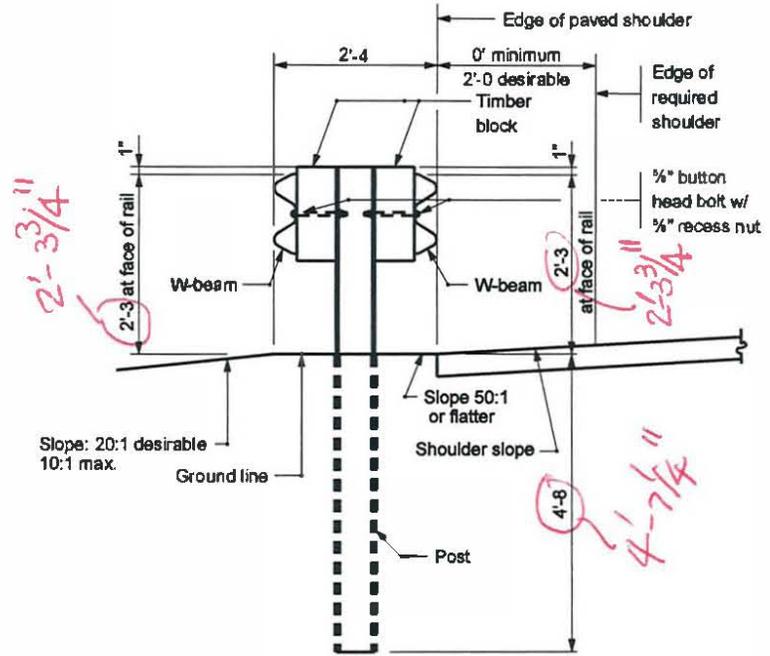


TYPICAL DOUBLE FACED W-BEAM INSTALLATION

INDIANA DEPARTMENT OF TRANSPORTATION	
W-BEAM GUARDRAIL ASSEMBLIES	
MARCH 2004	
STANDARD DRAWING NO. E 601-WBGA-01	
	<i>/s/ Richard L. VanCleave</i> 3-01-04 DESIGN STANDARDS ENGINEER DATE
	<i>/s/ Richard K. Smutzer</i> 3-01-04 CHIEF HIGHWAY ENGINEER DATE
DESIGN STANDARDS ENGINEER	

REVISION TO THE STANDARD DRAWINGS AND RECURRING PLAN DETAILS
 REVISION TO 601-WBGA-02 W-BEAM GUARDRAIL ASSEMBLIES

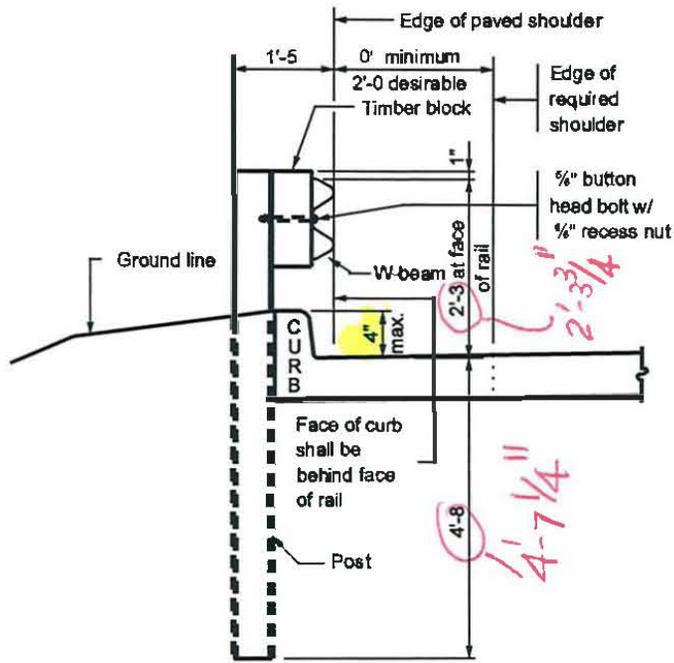


TYPICAL W-BEAM INSTALLATION AT CURB

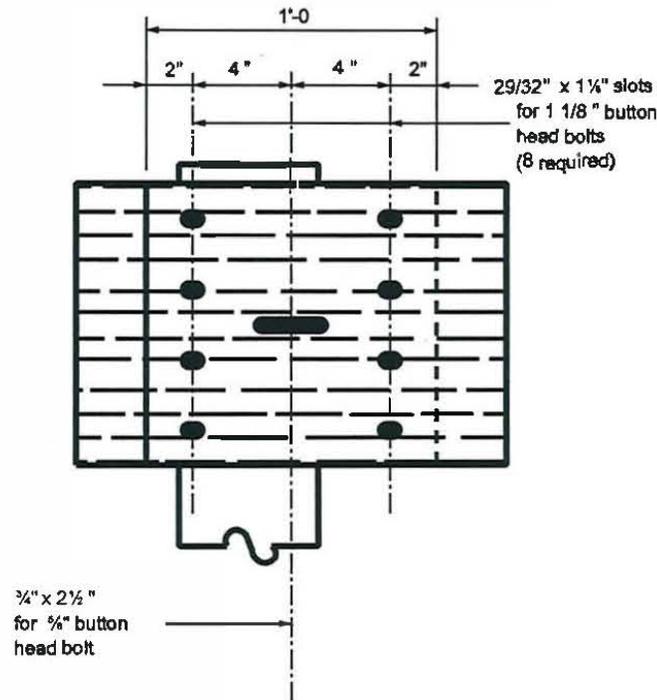

STEEL W-BEAM SPLICE DETAIL



INDIANA DEPARTMENT OF TRANSPORTATION	
W-BEAM GUARDRAIL ASSEMBLIES	
SEPTEMBER 2002	
STANDARD DRAWING NO. E 801-WBGA-02	
	<i>/s/ Richard L. VarCleave</i> 9-03-02 <small>DESIGN STANDARDS ENGINEER DATE</small>
	<i>/s/ Richard K. Smutzer</i> 9-03-02 <small>CHIEF HIGHWAY ENGINEER DATE</small>
<small>DESIGN STANDARDS ENGINEER</small>	

REVISION TO THE STANDARD DRAWINGS AND RECURRING PLAN DETAILS
 REVISION TO 601-WBGA-06 WR-BEAM GUARDRAIL

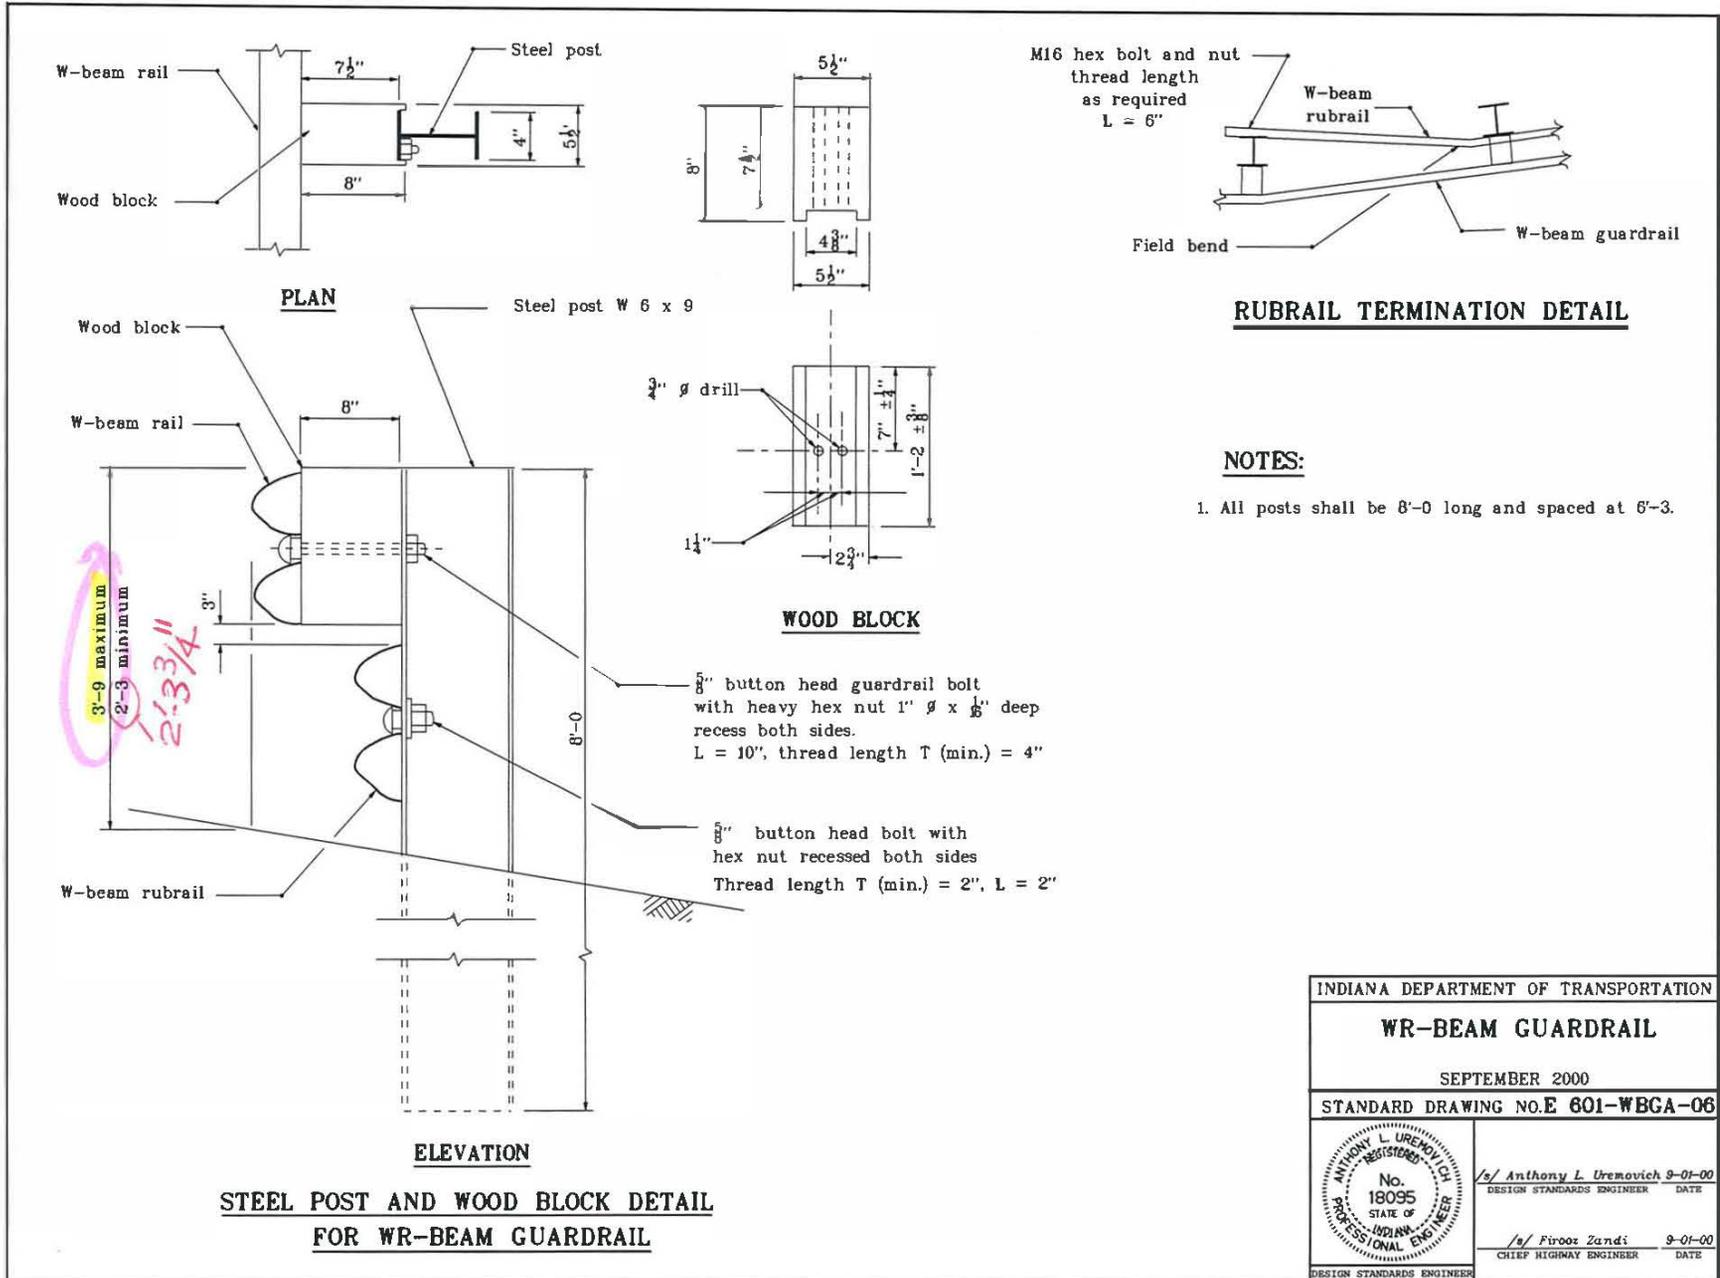

INDIANA DEPARTMENT OF TRANSPORTATION	
WR-BEAM GUARDRAIL	
SEPTEMBER 2000	
STANDARD DRAWING NO.E 601-WBGA-06	
	/s/ Anthony L. Uremovich 9-01-00 DESIGN STANDARDS ENGINEER DATE
	/s/ Firooz Zandi 9-01-00 CHIEF HIGHWAY ENGINEER DATE

REVISION TO THE STANDARD DRAWINGS AND RECURRING PLAN DETAILS
 REVISION TO 706-TBRC-01 RETROFIT THRIE BEAM BRIDGE RAILING TR

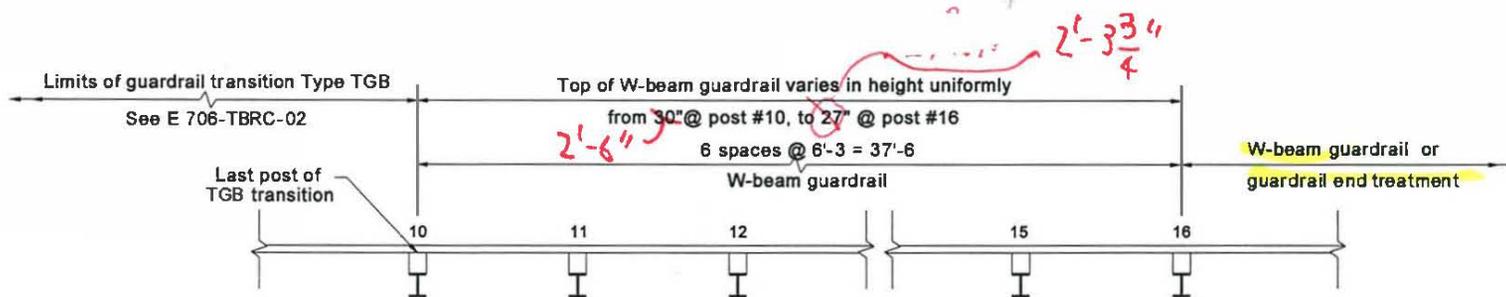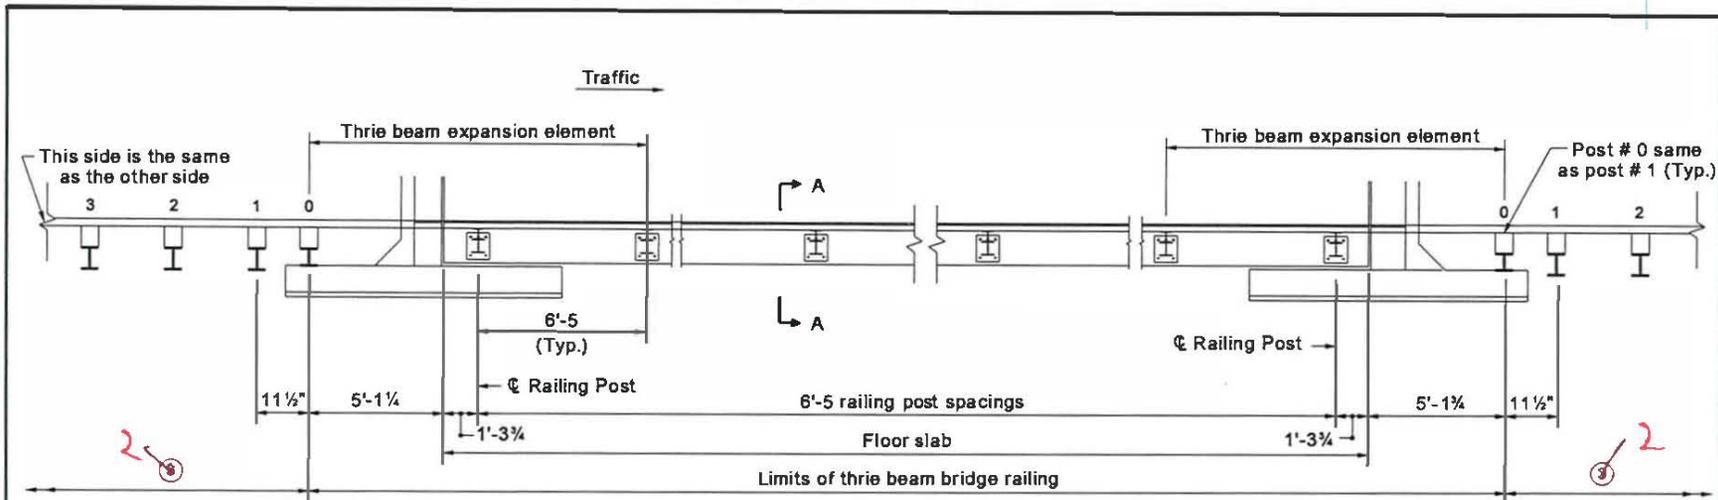


NOTES:

- Details shown on these Standard Drawings shall be used only to replace existing aluminum bridge rail with no modifications to the bridge deck.
1. 2. See Standard Drawings E 706-TBRC-02 and 03, E 706-TBRF-01 and -02, and E 706-TBRE-01 for thrie beam bridge railing components of curb mounted or deck mounted railings.
 2. 3. See Standard Drawing E 706-TBRC-02, Note 4. 25'-0" Limits of guardrail transition Type TGB, modified to include post # 0 and to exclude thrie beam terminal connector.
 3. 4. See Standard Drawings E 706-TBRC-02 and TBRF-01 for Section A-A.

BRIDGE RAIL/GUARDRAIL HEIGHT TRANSITION

INDIANA DEPARTMENT OF TRANSPORTATION	
RETROFIT THRIE BEAM BRIDGE RAILING TR	
SEPTEMBER 2006	
STANDARD DRAWING NO. E 706-TBRC-01	
	<i>J./s/ Richard L. VanCleave</i> 9-01-06 DESIGN STANDARDS ENGINEER DATE
	<i>J./s/ Richard K. Smutzer</i> 9-01-06 CHIEF HIGHWAY ENGINEER DATE
DESIGN STANDARDS ENGINEER	

REVISION TO THE STANDARD DRAWINGS AND RECURRING PLAN DETAILS
 REVISION TO 706-TBRC-02 RETROFIT THRIE BEAM BRIDGE RAILING TR COMPONENTS

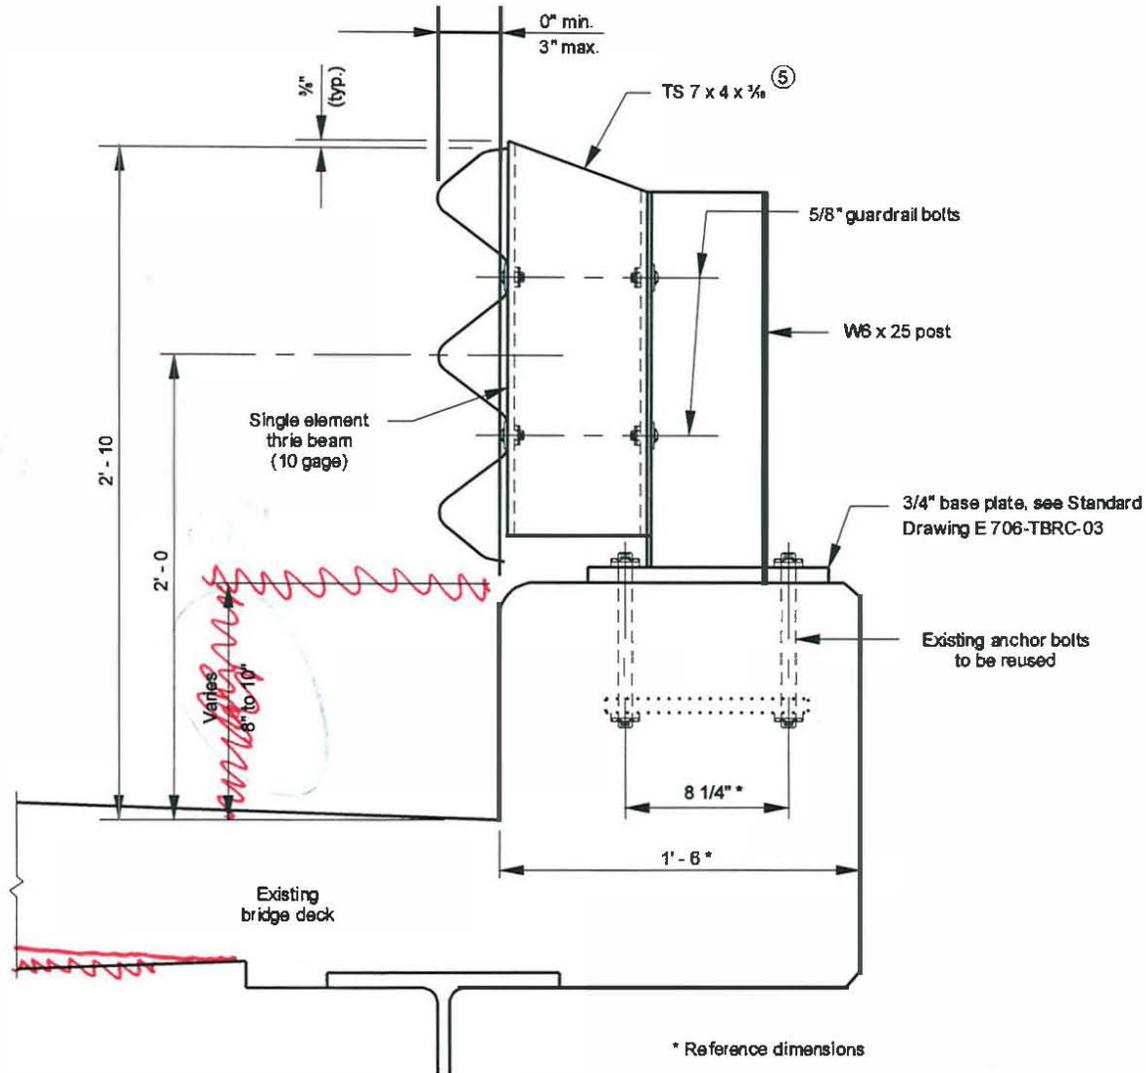


NOTES:

1. See Standard Drawing E-706-TBRC-01 for plan view.
2. See Standard Drawing E 601-TBGC-01 for thrie beam section.
3. See Standard Drawings E 601-TTGB-01, -03, -04 and -05 for type TGB guardrail transition details.
4. Height of type TGB transition post above ground: Posts 1 through 7: 2'-10 3/8
 Posts 8: 2'-8 3/8
 Posts 9 & 10: 2'-6 3/8
 Posts 11 through 16: height varies uniformly.
- ⑤ See Standard Drawing E 706-TBRC-03 for post and blockout details.
6. See Standard Drawing E 706-TBRF-01 for deck mounted bridge railing.


**SECTION A-A
 CURB MOUNTED**

INDIANA DEPARTMENT OF TRANSPORTATION	
RETROFIT THRIE BEAM BRIDGE RAILING TR COMPONENTS	
MARCH 2005	
STANDARD DRAWING NO. E 706-TBRC-02	
	/s/ Richard L. VanCleave 3-01-05 <small>DESIGN STANDARDS ENGINEER DATE</small>
	/s/ Richard K. Smutzer 3-01-05 <small>CHIEF HIGHWAY ENGINEER DATE</small>
<small>DESIGN STANDARDS ENGINEER</small>	

REVISION TO THE STANDARD DRAWINGS AND RECURRING PLAN DETAILS
 REVISION TO 706-TBRF-01 RETROFIT THRIE BEAM BRIDGE RAILING TR COMPONENTS

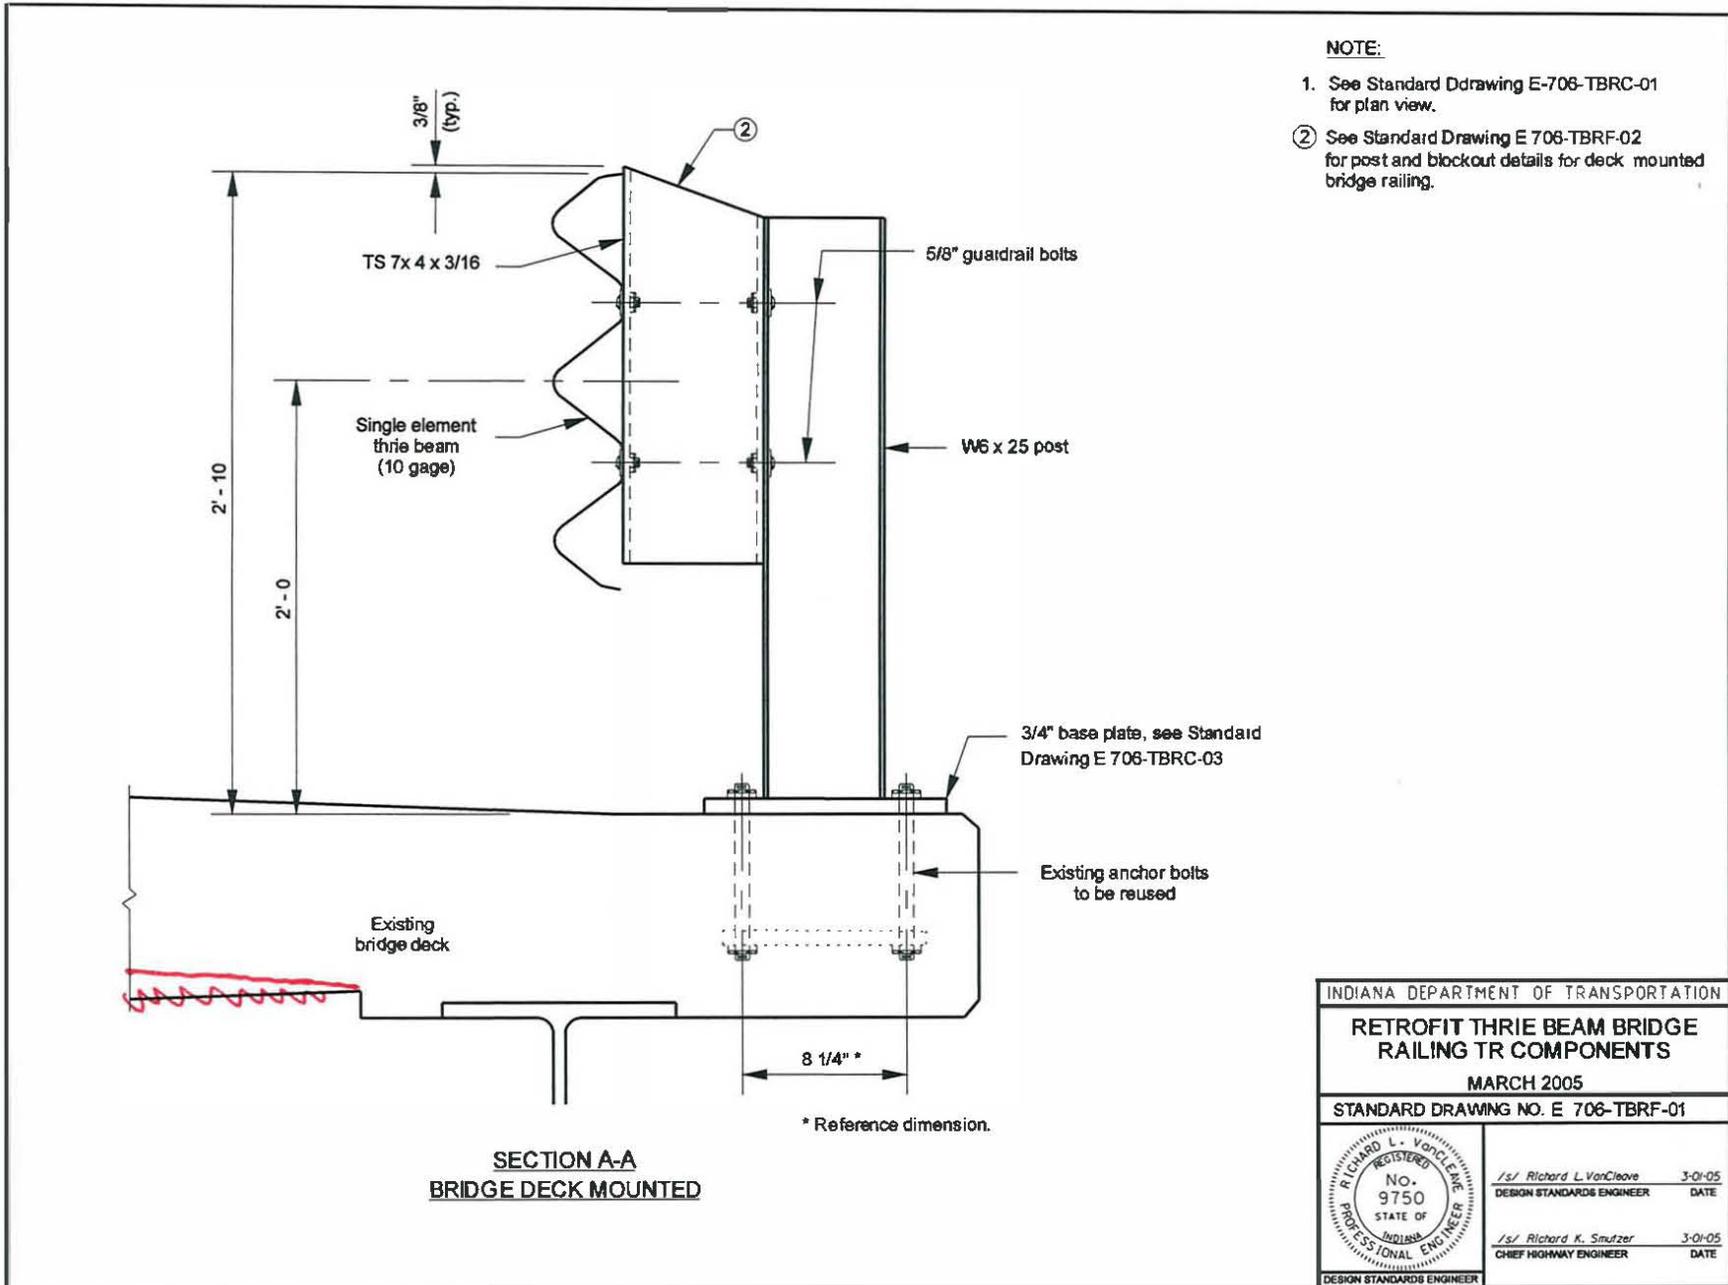

REVISION TO THE STANDARD DRAWINGS AND RECURRING PLAN DETAILS
 REVISION TO 706-TTBC-01 CONCRETE BRIDGE RAILING TRANSITION TBC

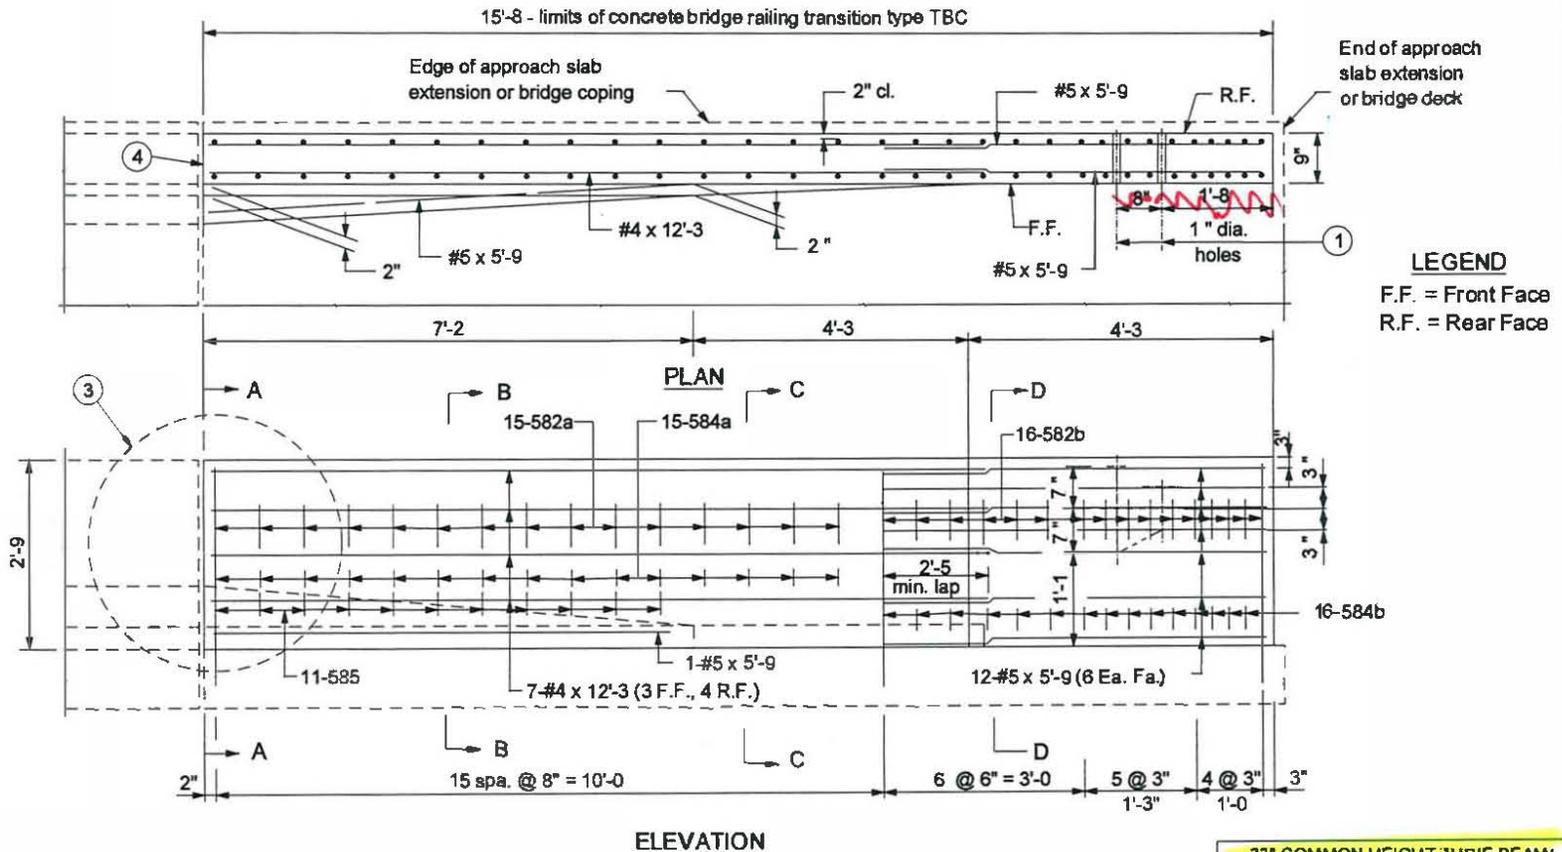

33" COMMON HEIGHT THREE BEAM/
 CONCRETE BRIDGE RAILING TRANSITION

NOTES:


- ① See Standard Drawing E 706-CBRT-02 for details of guardrail transition type TGB attachment.
2. See Standard Drawing E 706-TTBC-02 for Sections A-A, B-B, C-C and D-D and Drawing E 706-TTBC-03 for reinforcement and bill of materials.
3. See Standard Drawing E 706-TASE-05 for General Notes.

4. *(See E 706-TTBC-01 for the note)*

INDIANA DEPARTMENT OF TRANSPORTATION	
CONCRETE BRIDGE RAILING TRANSITION TBC	
MARCH 2004	
STANDARD DRAWING NO. E 706-TTBC-01	
	/s/ Richard L. VanCleave 3-01-04 DESIGN STANDARDS ENGINEER DATE
	/s/ Richard K. Smutzer 3-01-04 CHIEF HIGHWAY ENGINEER DATE
DESIGN STANDARDS ENGINEER	

REVISION TO THE STANDARD DRAWINGS AND RECURRING PLAN DETAILS
 REVISION TO 706-TTBP-01 CONCRETE BRIDGE RAILING TRANSITION, TPF-1

POSS GEN NOTE?

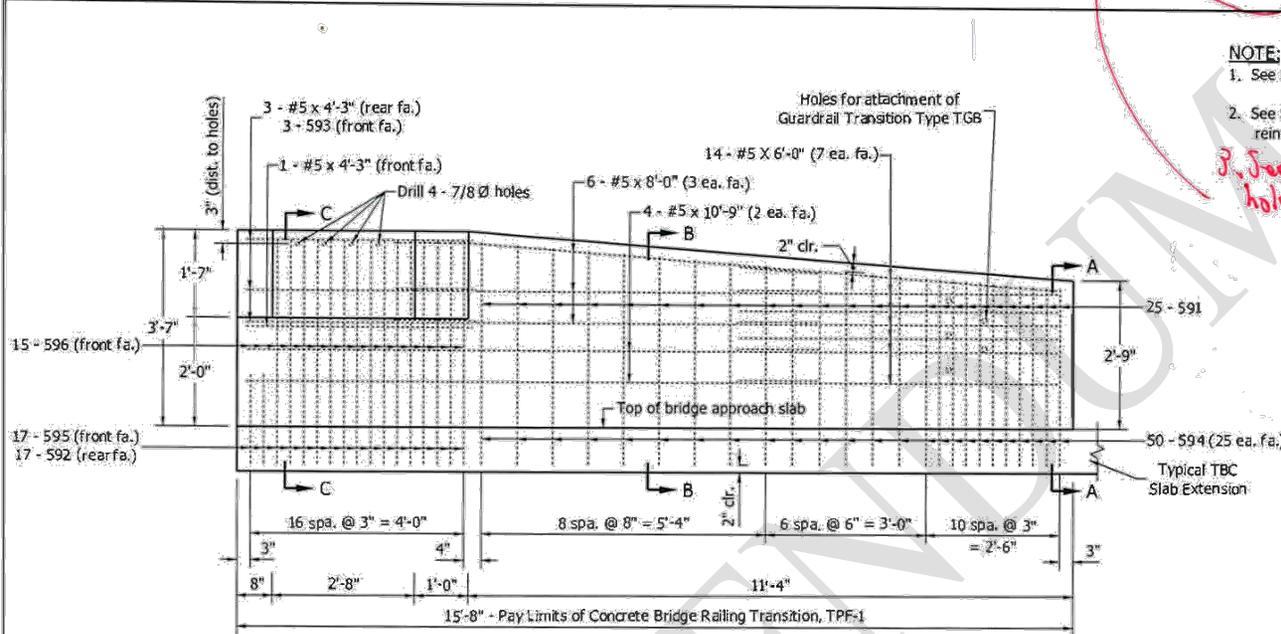


- NOTE:**
1. See Standard Drawing E 706-TTBP-09 for general notes.
 2. See Standard Drawing E 706-TTBP-02 for sections and reinforcing-bar diagrams.

3. See Standard Drawing E 601-TTCA-01 for holes placement for terminal course for attachment

**BILL OF MATERIALS, TPF-1
 EPOXY-COATED REINFORCING STEEL**

Mark / Size	No. of Bars	Total Length	Weight
591 x 5'-4"	25	133'-4"	
592 x 4'-8"	17	79'-4"	
593 x 4'-3"	3	12'-9"	
594 x 3'-7"	50	179'-2"	
595 x 3'-1"	17	52'-5"	
596 x 3'-0"	15	43'-0"	
#5 x 10'-9"	4	43'-0"	
#5 x 8'-0"	6	48'-0"	
#5 x 6'-0"	14	84'-0"	
#5 x 4'-3"	4	17'-0"	
Total Epoxy-Coated Reinforcing Steel		694'-2"	724 lb
MISCELLANEOUS			
Concrete, Class C			1.5 cys
Surface Seal			121 sft

ELEVATION

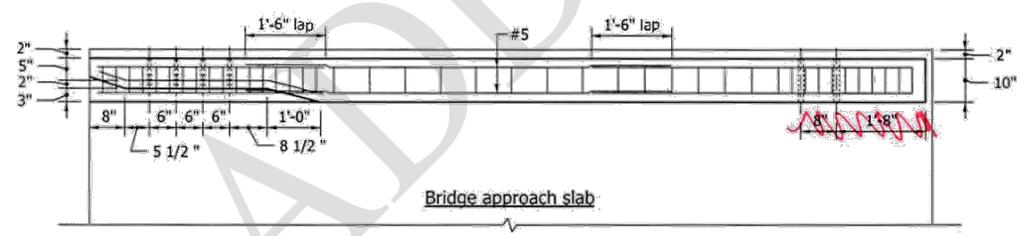

PLAN

INDIANA DEPARTMENT OF TRANSPORTATION

CONCRETE BRIDGE RAILING TRANSITION, TPF-1


SEPTEMBER 2009

STANDARD DRAWING NO. E 706-TTBP-01


	<i>/s/ Richard L. VanCleave</i> 09/01/09 DESIGN STANDARDS ENGINEER DATE
	<i>/s/ Mark A. Miller</i> 09/01/09 CHIEF HIGHWAY ENGINEER DATE

DESIGN STANDARDS ENGINEER

REVISION TO THE STANDARD DRAWINGS AND RECURRING PLAN DETAILS
 REVISION TO 706-TTBO-03 CONCRETE BRIDGE RAILING TRANSITION, TPF-2

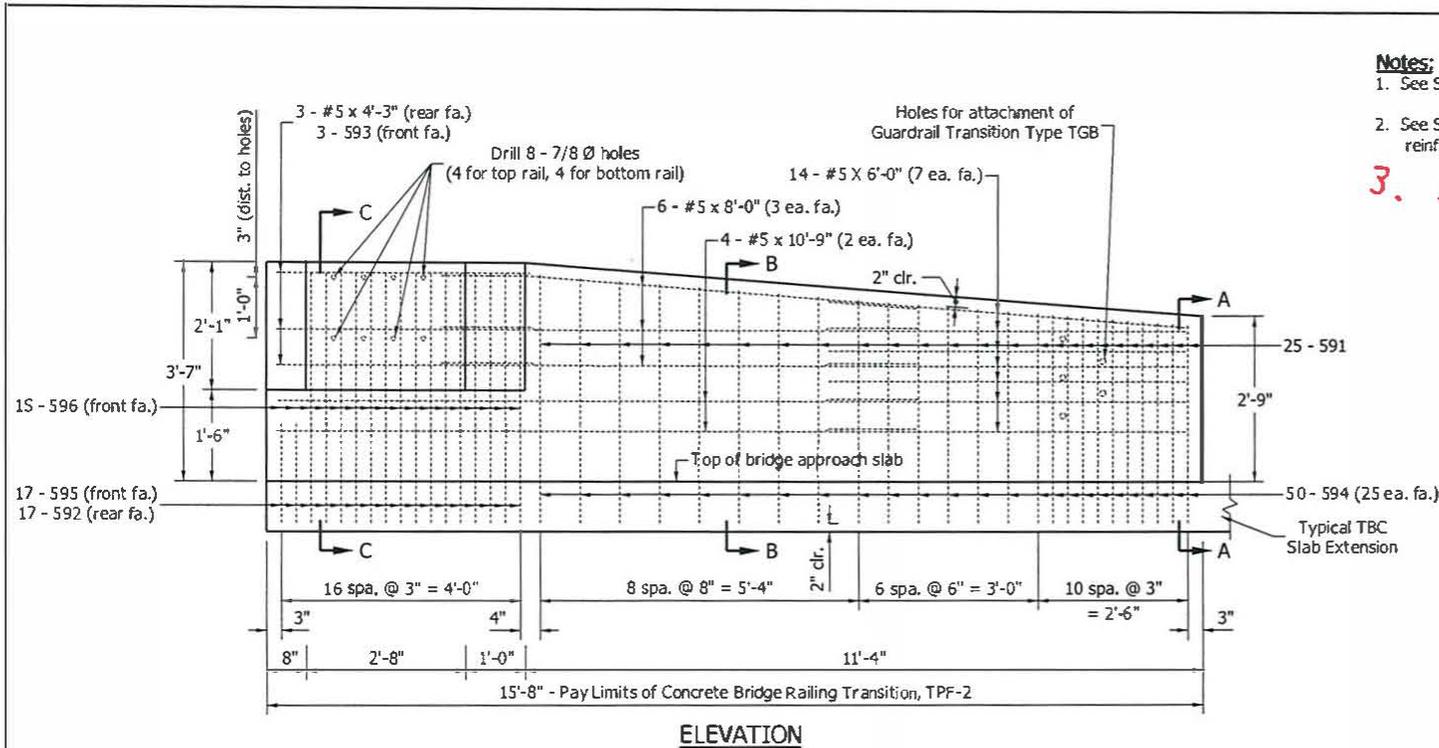

ELEVATION

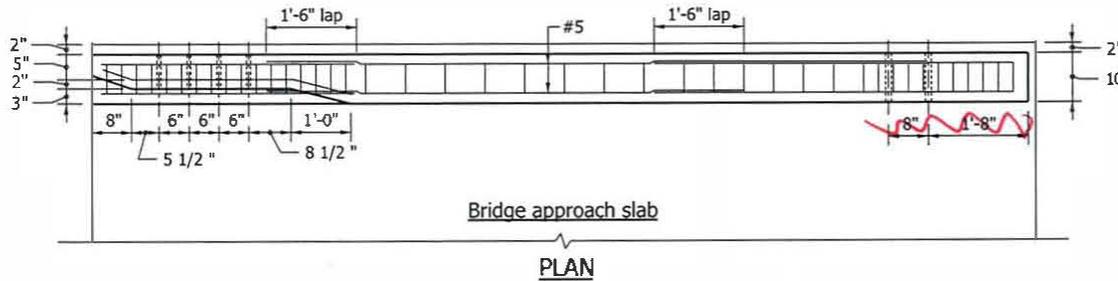

PLAN

Notes:

1. See Standard Drawing E 706-TTBP-09 for general notes.
2. See Standard Drawing E 706-TTBP-04 for sections and reinforcing-bar diagrams.

3. — (See E 706-TTBP-01 For the note)

BILL OF MATERIALS, TPF-2 EPOXY-COATED REINFORCING STEEL			
Mark / Size	No. of Bars	Total Length	Weight
591 x 5'-4"	25	133'-4"	
592 x 4'-8"	17	79'-4"	
593 x 4'-3"	3	12'-9"	
594 x 3'-7"	50	179'-2"	
595 x 2'-7"	17	43'-11"	
596 x 3'-0"	15	43'-0"	
#5 x 10'-9"	4	43'-0"	
#5 x 8'-0"	6	48'-0"	
#5 x 6'-0"	14	84'-0"	
#5 x 4'-3"	3	12'-9"	
Total Epoxy-Coated Reinforcing Steel		679'-3"	711lb
MISCELLANEOUS			
Concrete, Class C			1.5 cys
Surface Seal			121 sft

INDIANA DEPARTMENT OF TRANSPORTATION


CONCRETE BRIDGE RAILING
TRANSITION, TPF-2

SEPTEMBER 2009


STANDARD DRAWING NO. E 706-TTBP-03

	/s/ Richard L. VanCleave	09/01/09
	DESIGN STANDARDS ENGINEER	DATE
	/s/ Mark A. Miller	09/01/09
DESIGN STANDARDS ENGINEER	CHIEF HIGHWAY ENGINEER	DATE

REVISION TO THE STANDARD DRAWINGS AND RECURRING PLAN DETAILS
 REVISION TO 706-TTBP-05 CONCRETE BRIDGE RAILING TRANSITION, TPS-1

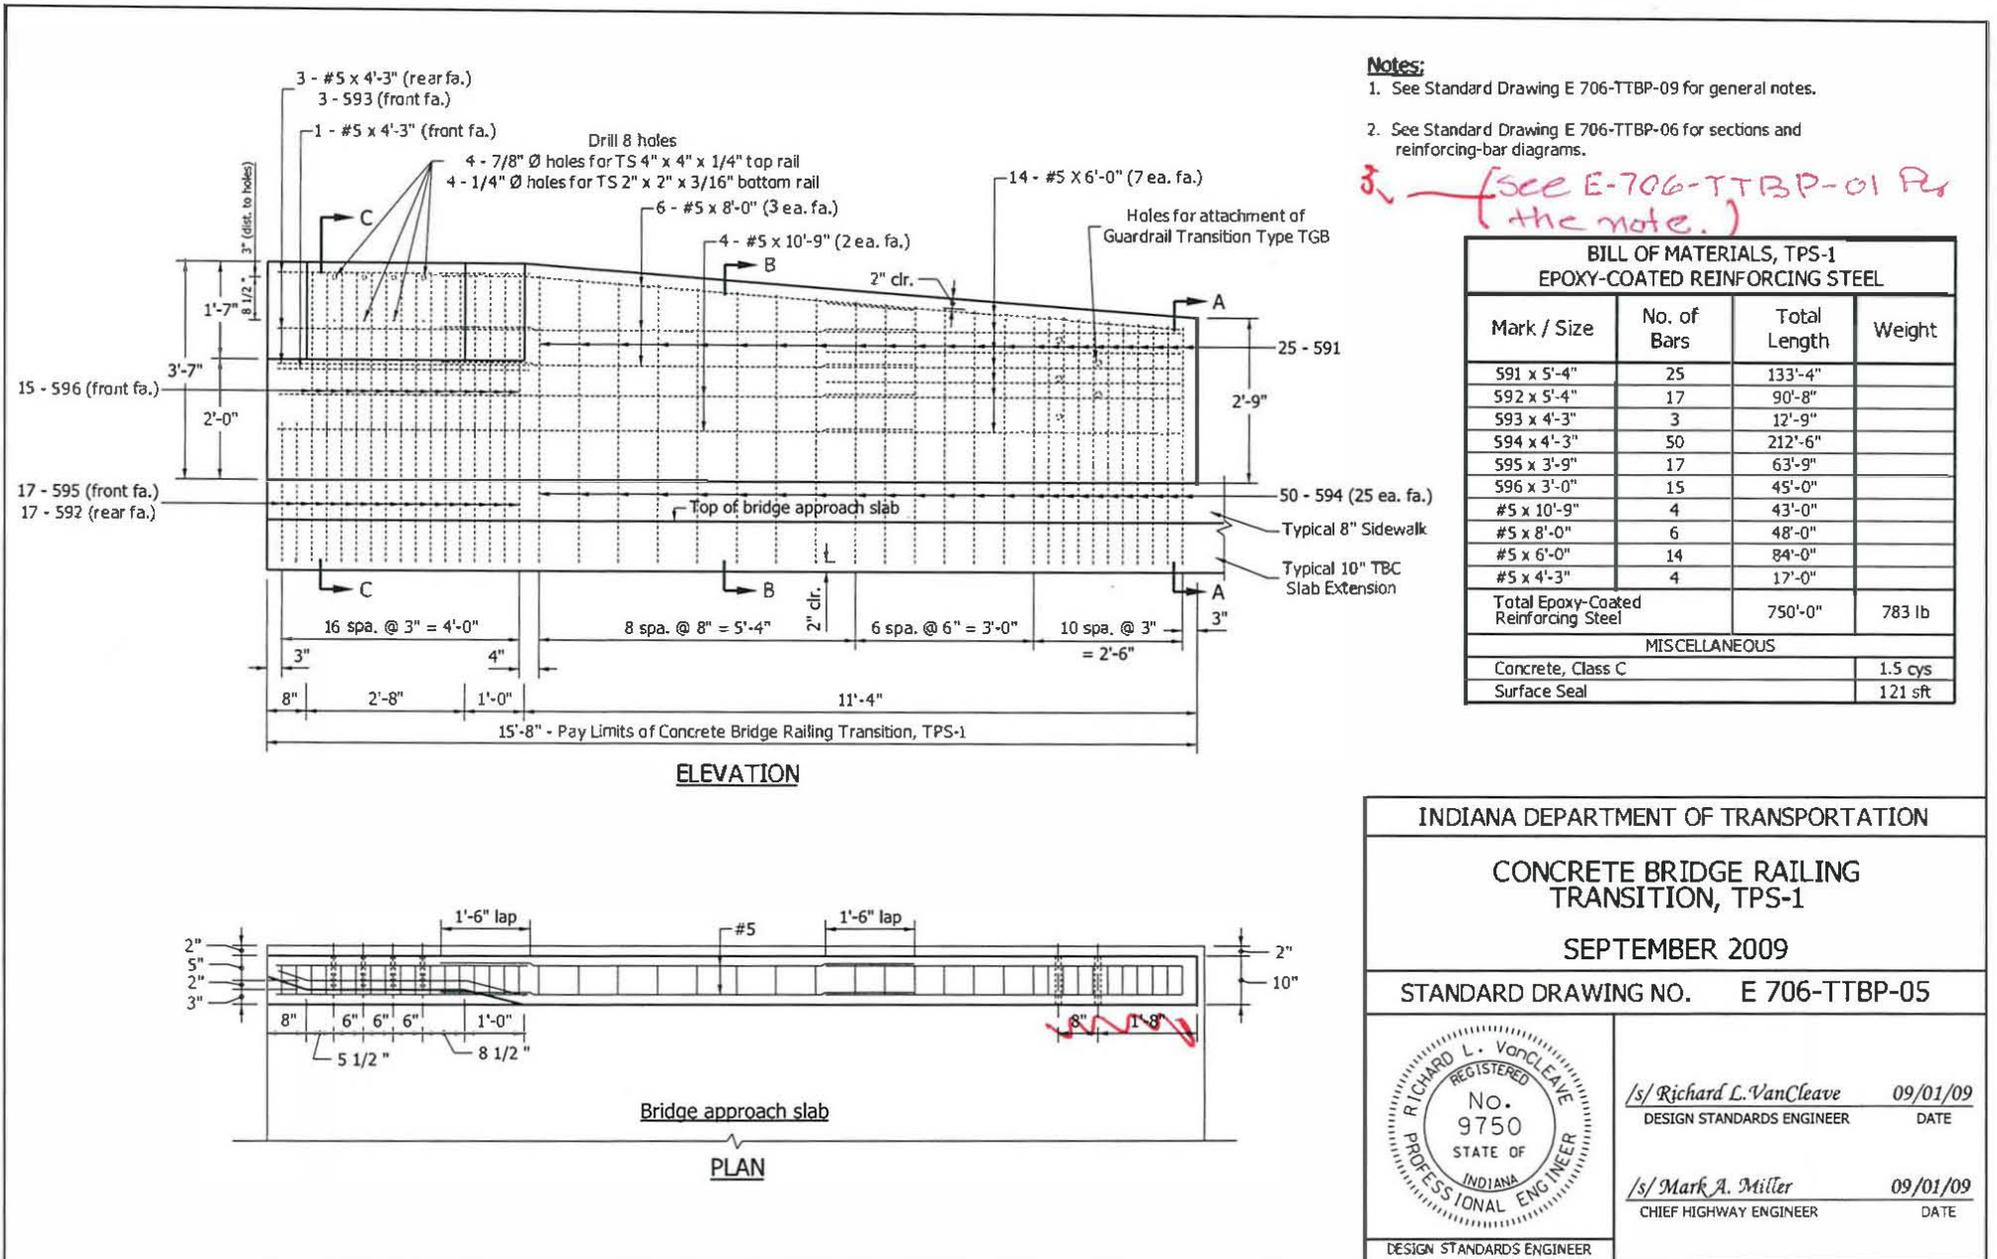

REVISION TO THE STANDARD DRAWINGS AND RECURRING PLAN DETAILS
 REVISION TO 706-TTBP-07 CONCRETE BRIDGE RAILING TRANSITION, TPS-2

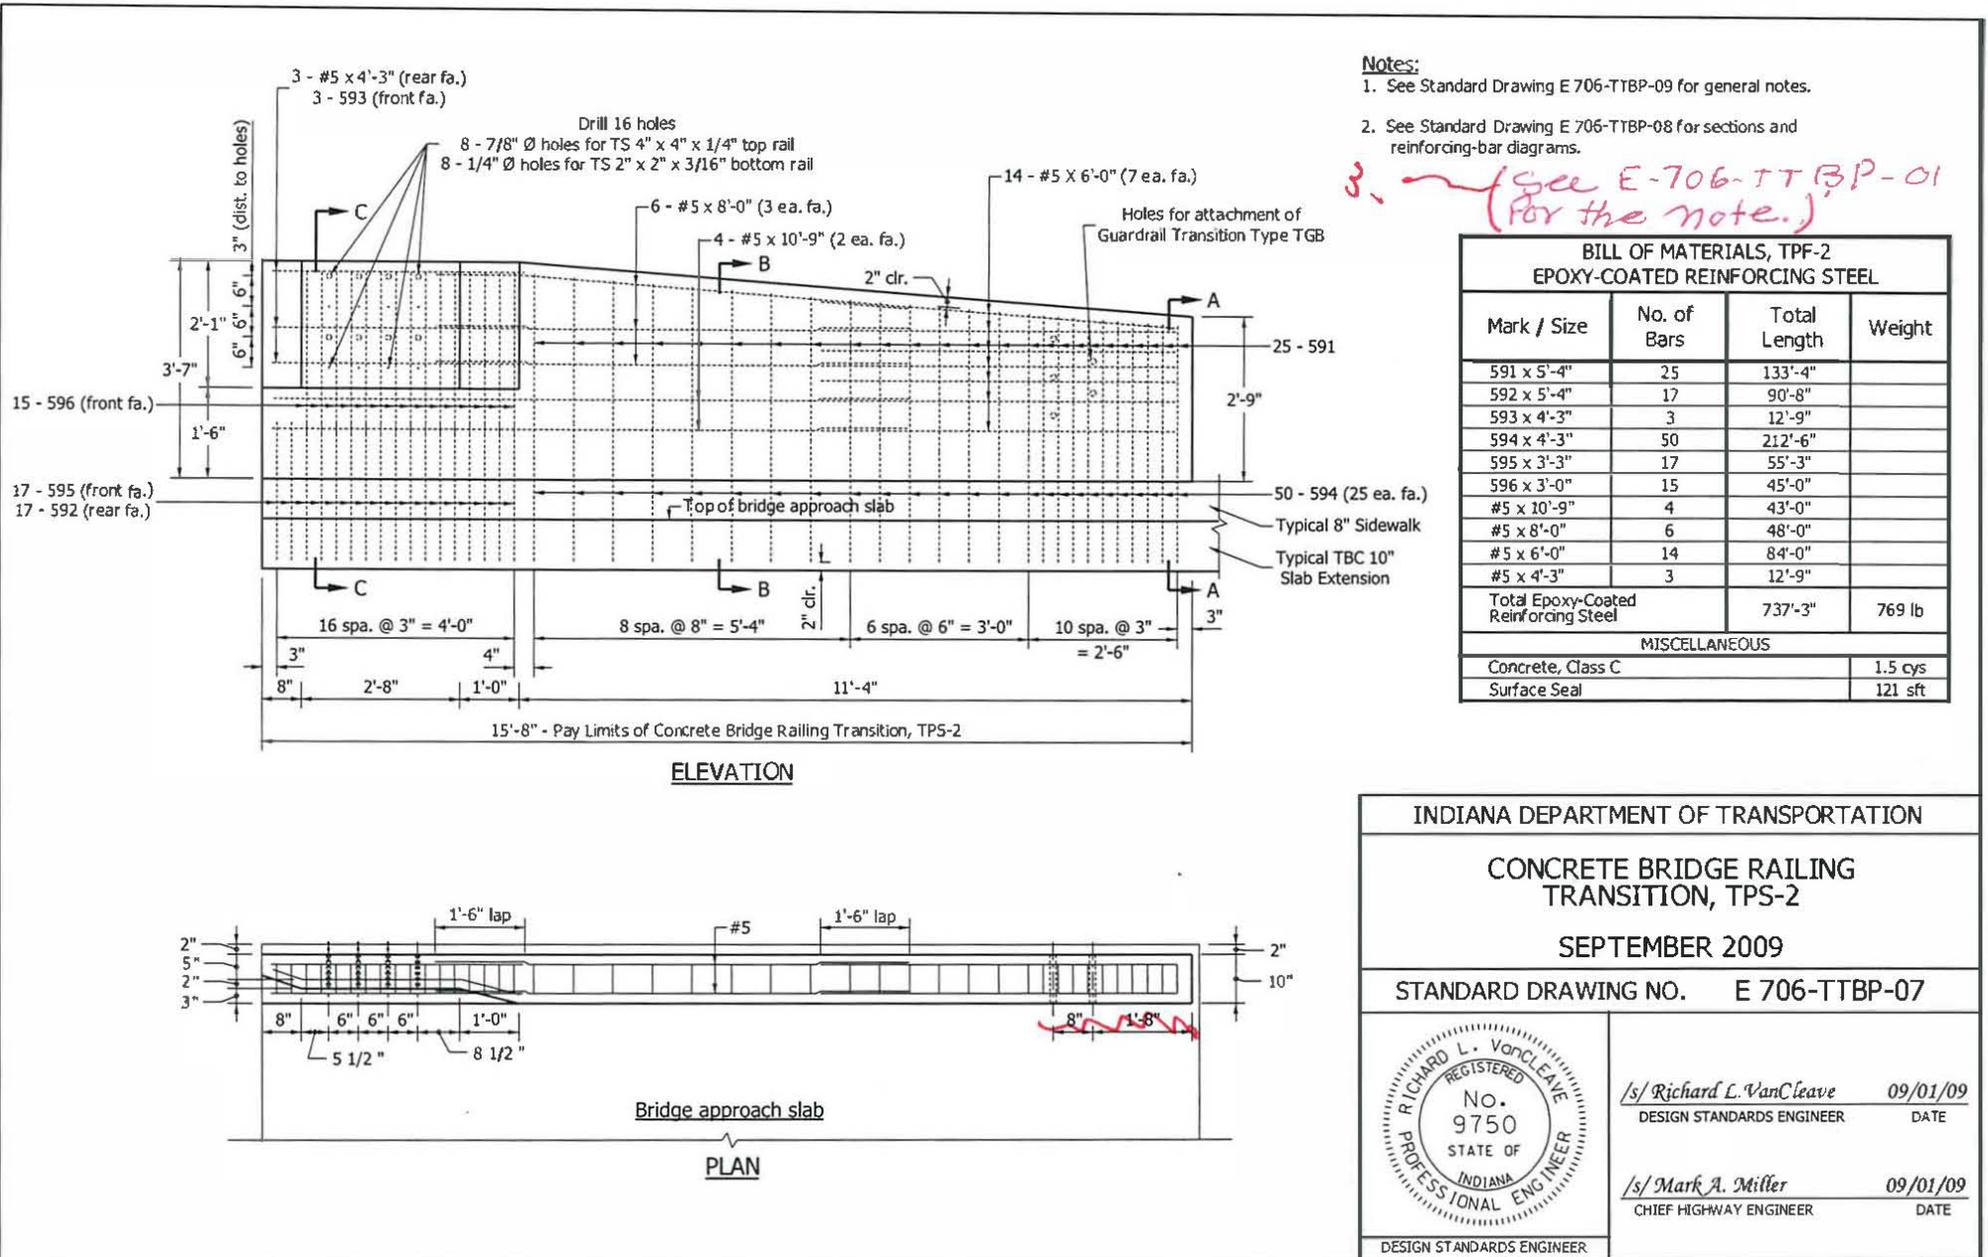


REVISION TO THE STANDARD DRAWINGS AND RECURRING PLAN DETAILS
 REVISION TO 706-TTBT-01 CONCRETE BRIDGE RAILING TRANSITION TYPE TBT

NOTES:


1. See Standard Drawing E 706-TTBT-02 for sections.
2. See Standard Drawing E 706-TASE-05 for General Notes.

LEGEND:
 F.F. = Front Face
 R.F. = Rear Face

See E-706-TTBT-01 for the note

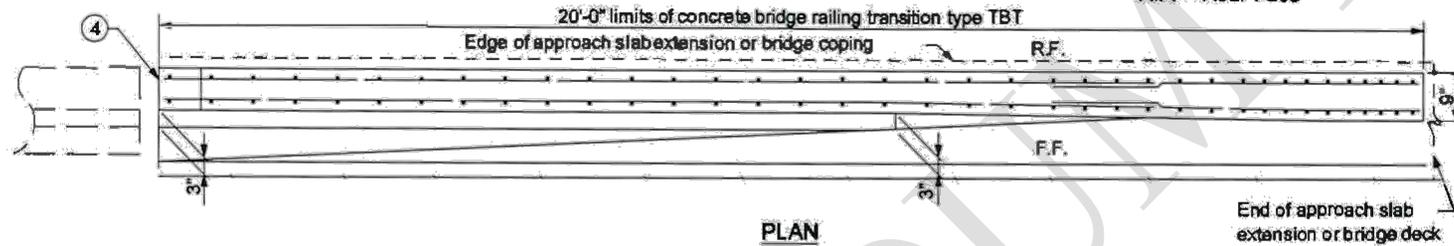

PLAN



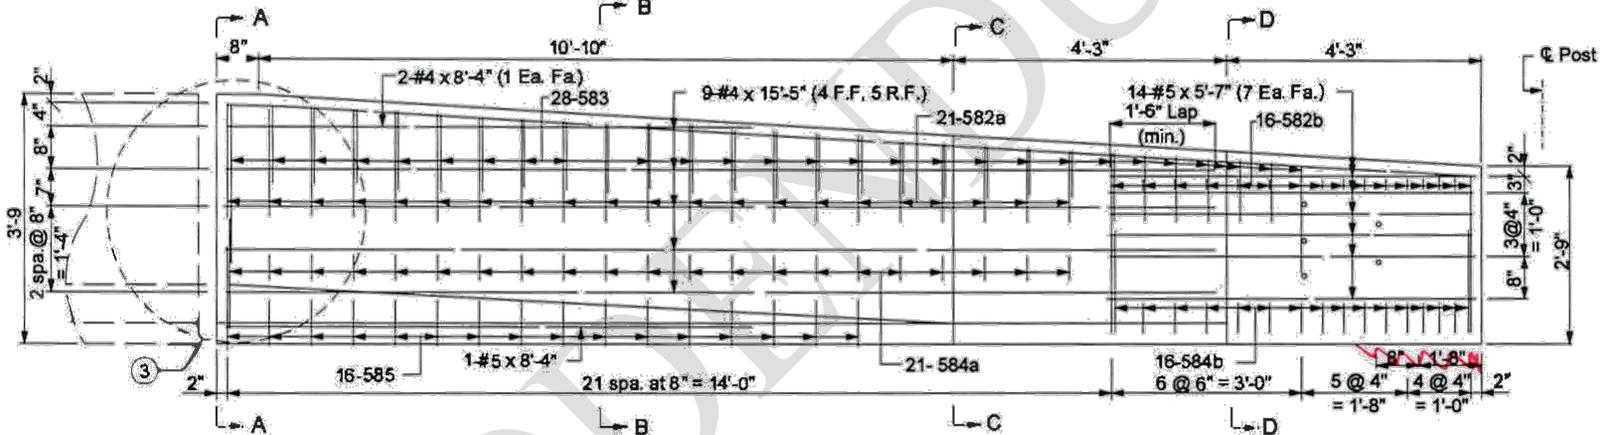


ELEVATION

45" TRUCK HEIGHT THRIE BEAM/
 CONCRETE BRIDGE RAILING TRANSITION

INDIANA DEPARTMENT OF TRANSPORTATION	
CONCRETE BRIDGE RAILING TRANSITION TYPE TBT	
SEPTEMBER 2006	
STANDARD DRAWING NO. E 706-TTBT-01	
	<i>/s/ Richard L. VanCleave</i> 9-01-06 DESIGN STANDARDS ENGINEER DATE
	<i>/s/ Richard A. Smutzer</i> 9-01-06 CHIEF HIGHWAY ENGINEER DATE

REVISION TO THE STANDARD DRAWINGS AND RECURRING PLAN DETAILS
 REVISION TO 706-TTXX-01 CONCRETE BRIDGE RAILING TRANSITION, TTX

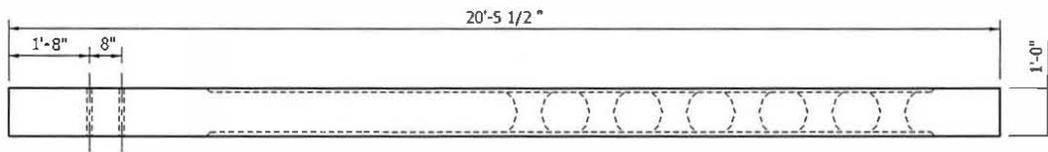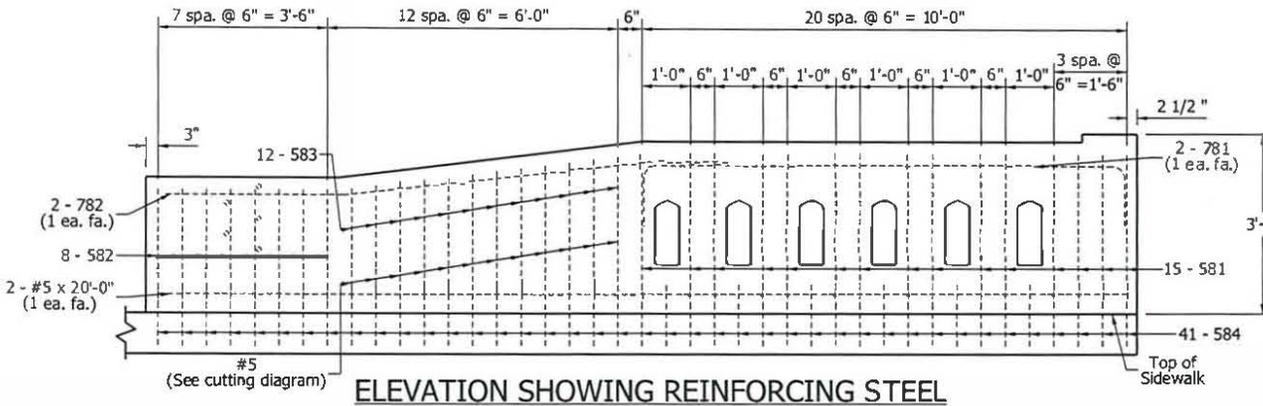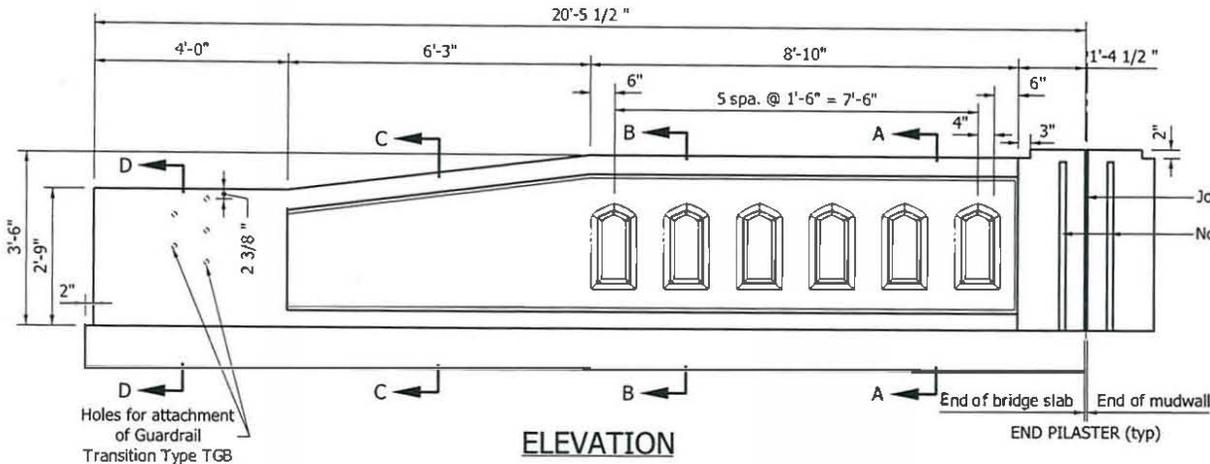

Notes:

1. See Standard Drawing E 706-TTBP-09 for general notes.
2. See Standard Drawing E 706-TTXX-02 for sections reinforcing-bar diagrams, and cutting diagrams.
3. The quantities listed in the Bill of Materials are for one transition.

4. (see E-706-TTBP for the note)

BILL OF MATERIALS, TX			
EPOXY-COATED REINFORCING STEEL			
Mark / Size	No. of Bars	Total Length	Weight
781 x 12'-4"	2	24'-8"	
782 x 11'-9"	2	23'-6"	
Total #7		48'-4"	99lb
581 x 8'-6"	15	127'-6"	
582 x 7'-0"	8	56'-0"	
583 x 3'-8"	12	44'-0"	
584 x 3'-0"	41	123'-0"	
#5 x 20'-0"	2	40'-0"	
#5 x 5'-0"	6	30'-0"	
Total #5		420'-6"	439 lb
Total Epoxy-Coated Reinforcing Steel			538lb
MISCELLANEOUS			
Concrete, Class C			2.0 cys
Surface Seal			149 sft

INDIANA DEPARTMENT OF TRANSPORTATION


CONCRETE BRIDGE RAILING
 TRANSITION, TTX

SEPTEMBER 2009

STANDARD DRAWING NO. E 706-TTXX-01

	/s/ Richard L. VanCleave	09/01/09
	DESIGN STANDARDS ENGINEER	DATE
	/s/ Mark A. Miller	09/01/09
DESIGN STANDARDS ENGINEER	CHIEF HIGHWAY ENGINEER	DATE

REVISION TO THE STANDARD DRAWINGS AND RECURRING PLAN DETAILS
 REVISION TO 706-TWBC-01 CONCRETE BRIDGE RAILING TRANSITION TYPE WBC

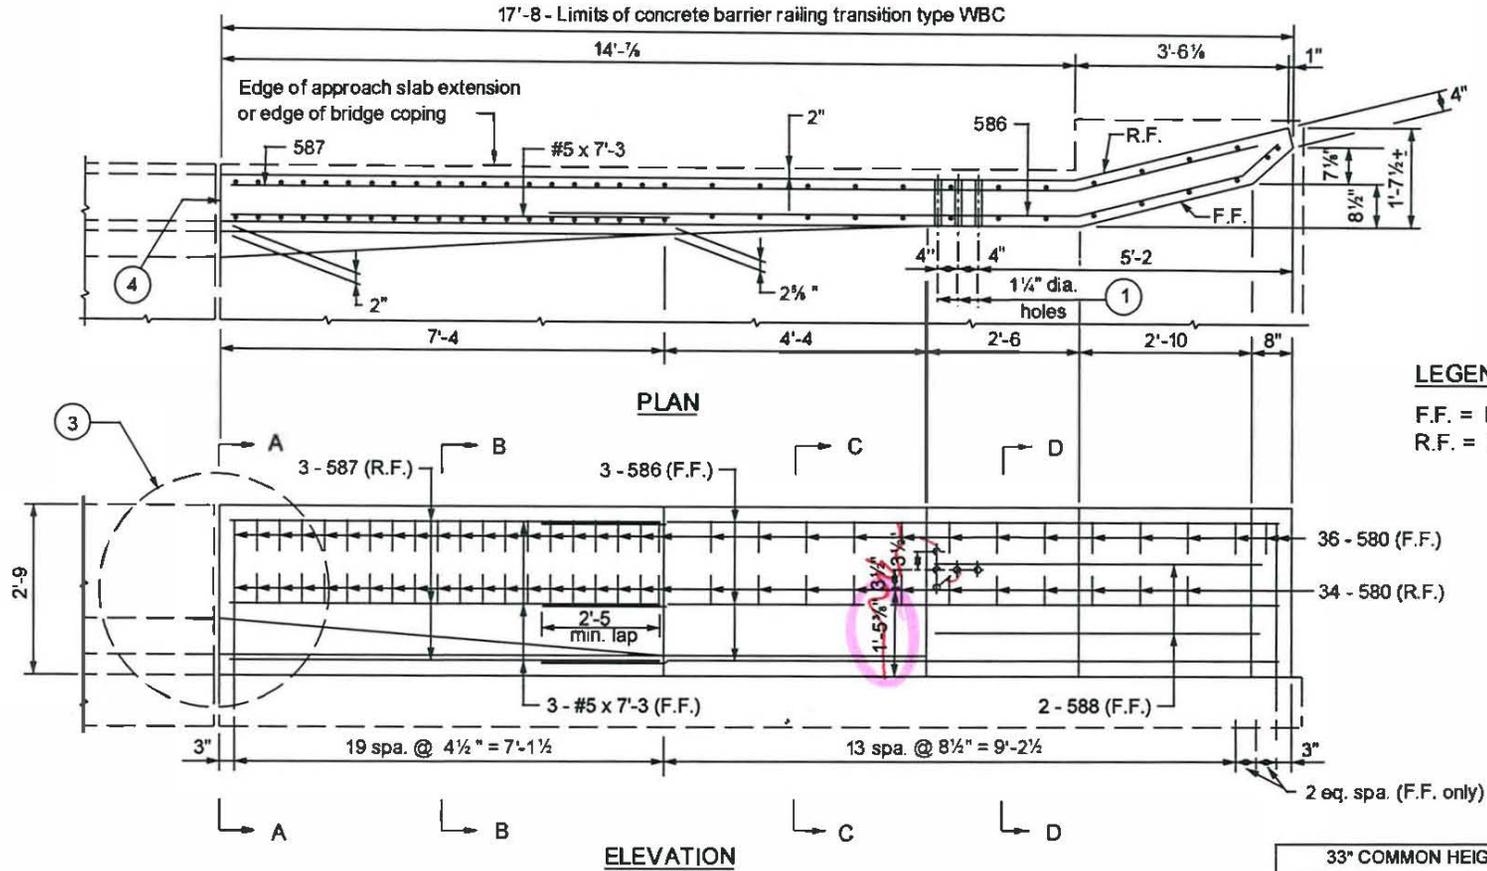

LEGEND :
 F.F. = Front Face
 R.F. = Rear Face

33" COMMON HEIGHT W-BEAM/
 CONCRETE BRIDGE RAILING TRANSITION

NOTES :


- ① See Standard Drawing E 706-CBRT-03 for details of guardrail transition type WGB attachment.
2. See Standard Drawing E 706-TWBC-02 for Section A-A, B-B, C-C and D-D and Drawing E 706-TWBC-03 for reinforcement and bill of materials.
3. See Standard Drawing E 706-TASE-05 for General Notes.

INDIANA DEPARTMENT OF TRANSPORTATION

CONCRETE BRIDGE RAILING
 TRANSITION TYPE WBC

MARCH 2003

STANDARD DRAWING NO. E 706-TWBC-01

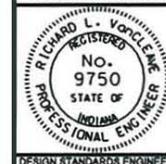


/s/ Richard L. VanCleave 3-03-03
 DESIGN STANDARDS ENGINEER DATE

/s/ Richard K. Smutzer 3-03-03
 CHIEF HIGHWAY ENGINEER DATE

REVISION TO THE STANDARD DRAWINGS AND RECURRING PLAN DETAILS


PROPOSED NEW DRAWING 706-TTCA-01 1 1/4" DIAMETER HOLES PLACEMENT FOR TERMINAL CONNECTOR ATTACHMENT (DRAFT)

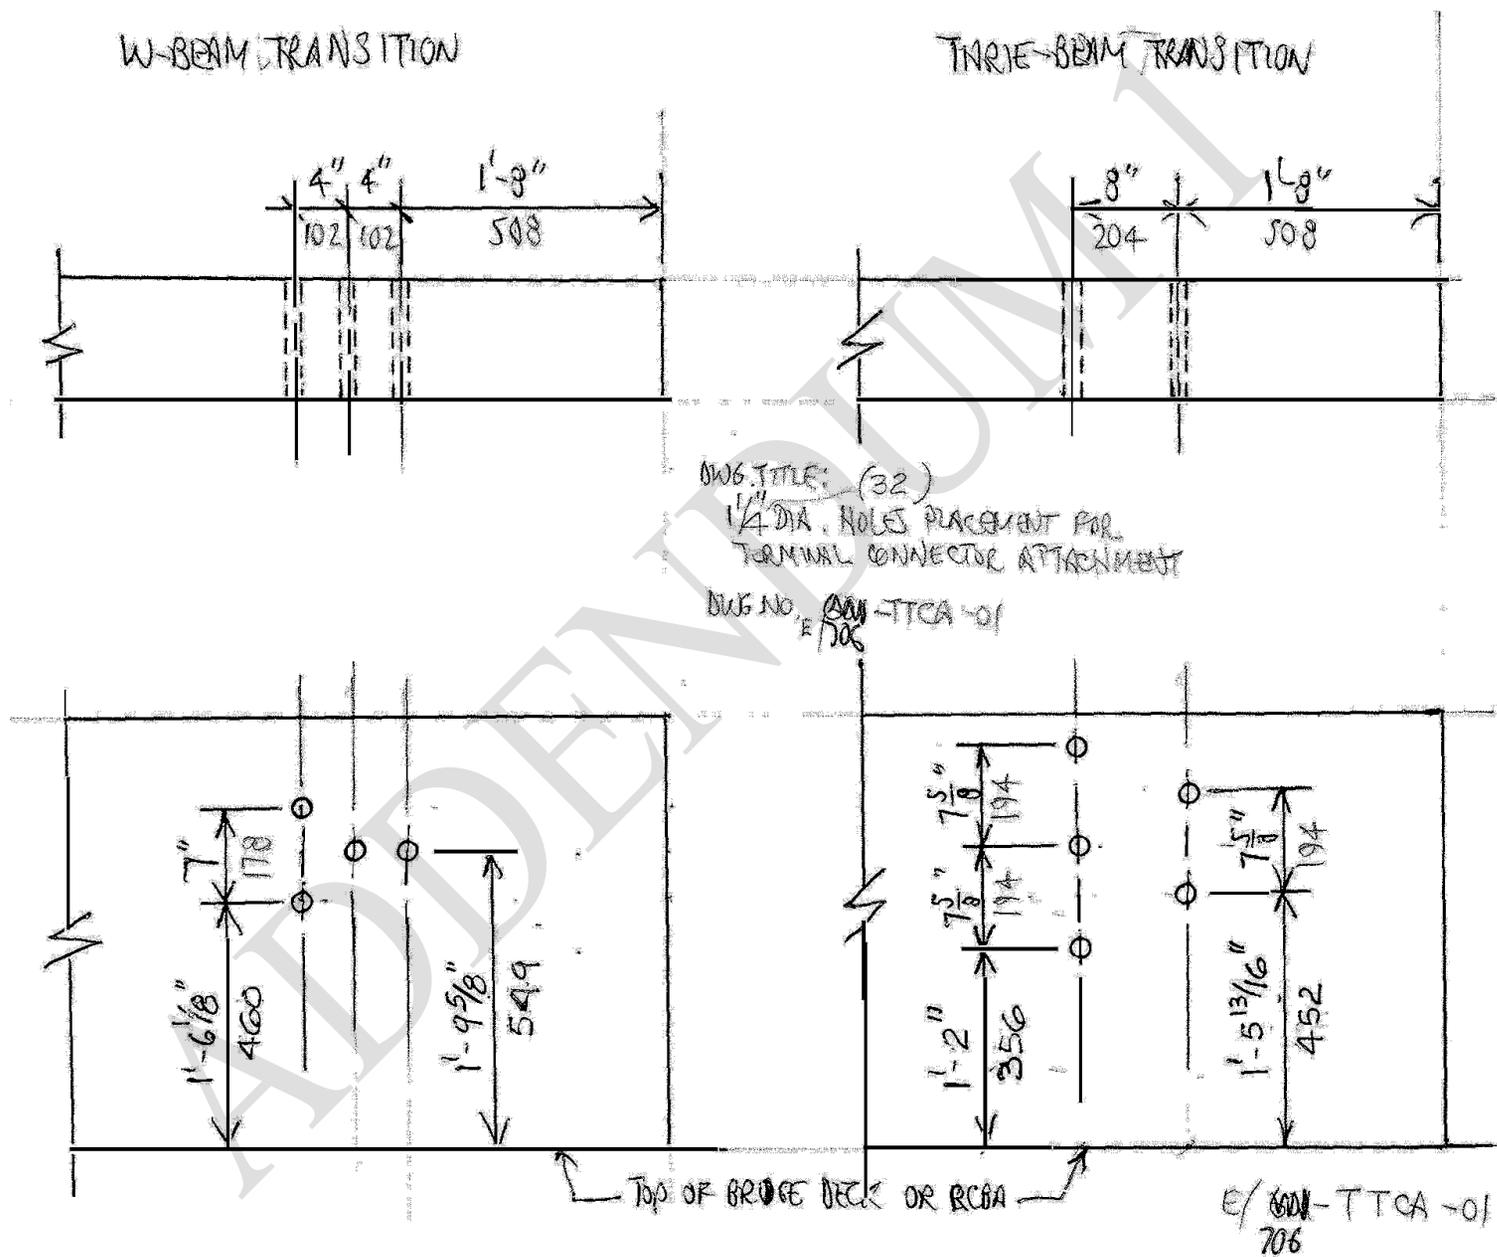


REVISION TO THE STANDARD DRAWINGS AND RECURRING PLAN DETAILS

REVISION TO RECURRING PLAN DETAILS 706-B-140d BRIDGE RAILING TYPE TS-1 & GUARDRAIL TRANSITION TYPE TGS-1 (PAGE 1 OF 3)

E 706-B-140d 1 of 3

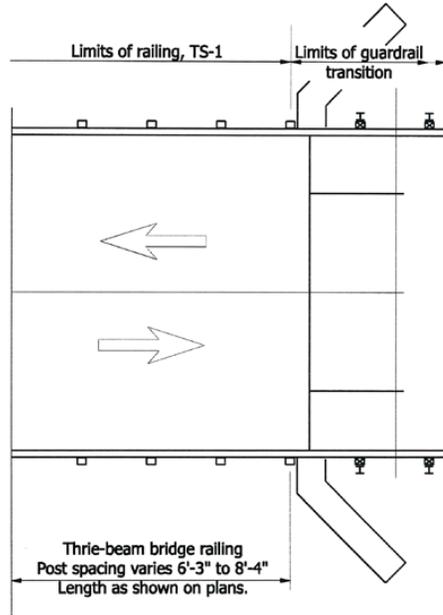


PLAN VIEW

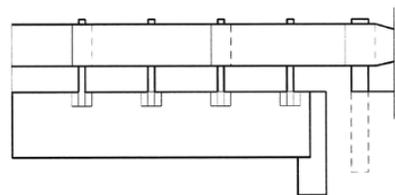

ELEVATION VIEW

NOTES:

- 1 See Standard Drawings E 601-TBGC-01 and -02 for thrie beam rail section.

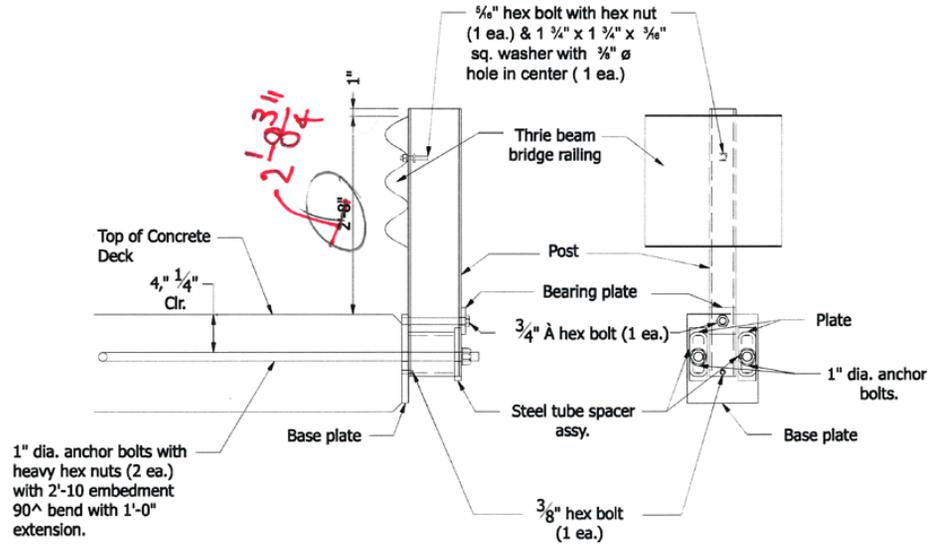

THRIE-BEAM BRIDGE RAILING ASSEMBLY DETAILS

INDIANA DEPARTMENT OF TRANSPORTATION
 RAILING, TS-1


7-25-05

REVISION TO THE STANDARD DRAWINGS AND RECURRING PLAN DETAILS


REVISION TO RECURRING PLAN DETAILS 706-B-140d BRIDGE RAILING TYPE TS-1 & GUARDRAIL TRANSITION TYPE TGS-1 (PAGE 2 OF 3)

NOTES:



- ① Post length may vary. If the 1" ϕ anchor bolts in the deck must be lowered to accommodate the deck reinforcing steel, the steel base plate shall be lowered and the post length increased.

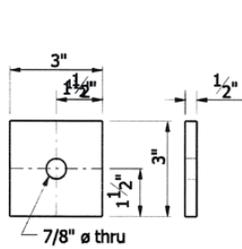


BEARING PLATE

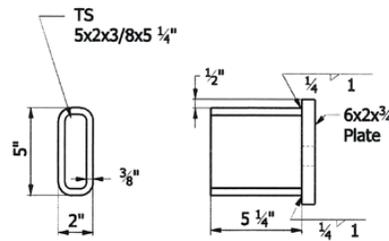

STEEL TUBE SPACER ASSEMBLY

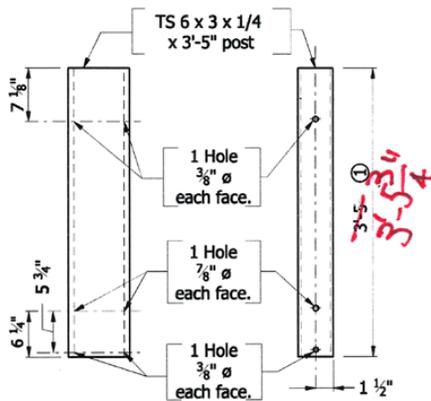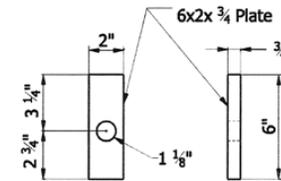

SECTION REAR VIEW
BRIDGE STEEL POST DETAIL

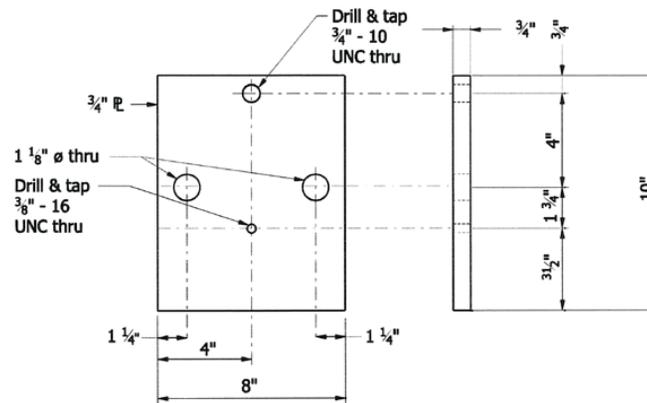

BASE PLATE


INDIANA DEPARTMENT OF TRANSPORTATION
 RAILING, TS-1

E 706-B-140d 2 of 3

7-25-05

REVISION TO THE STANDARD DRAWINGS AND RECURRING PLAN DETAILS

REVISION TO RECURRING PLAN DETAILS 706-B-140d BRIDGE RAILING TYPE TS-1 & GUARDRAIL TRANSITION TYPE TGS-1 (PAGE 3 OF 3)

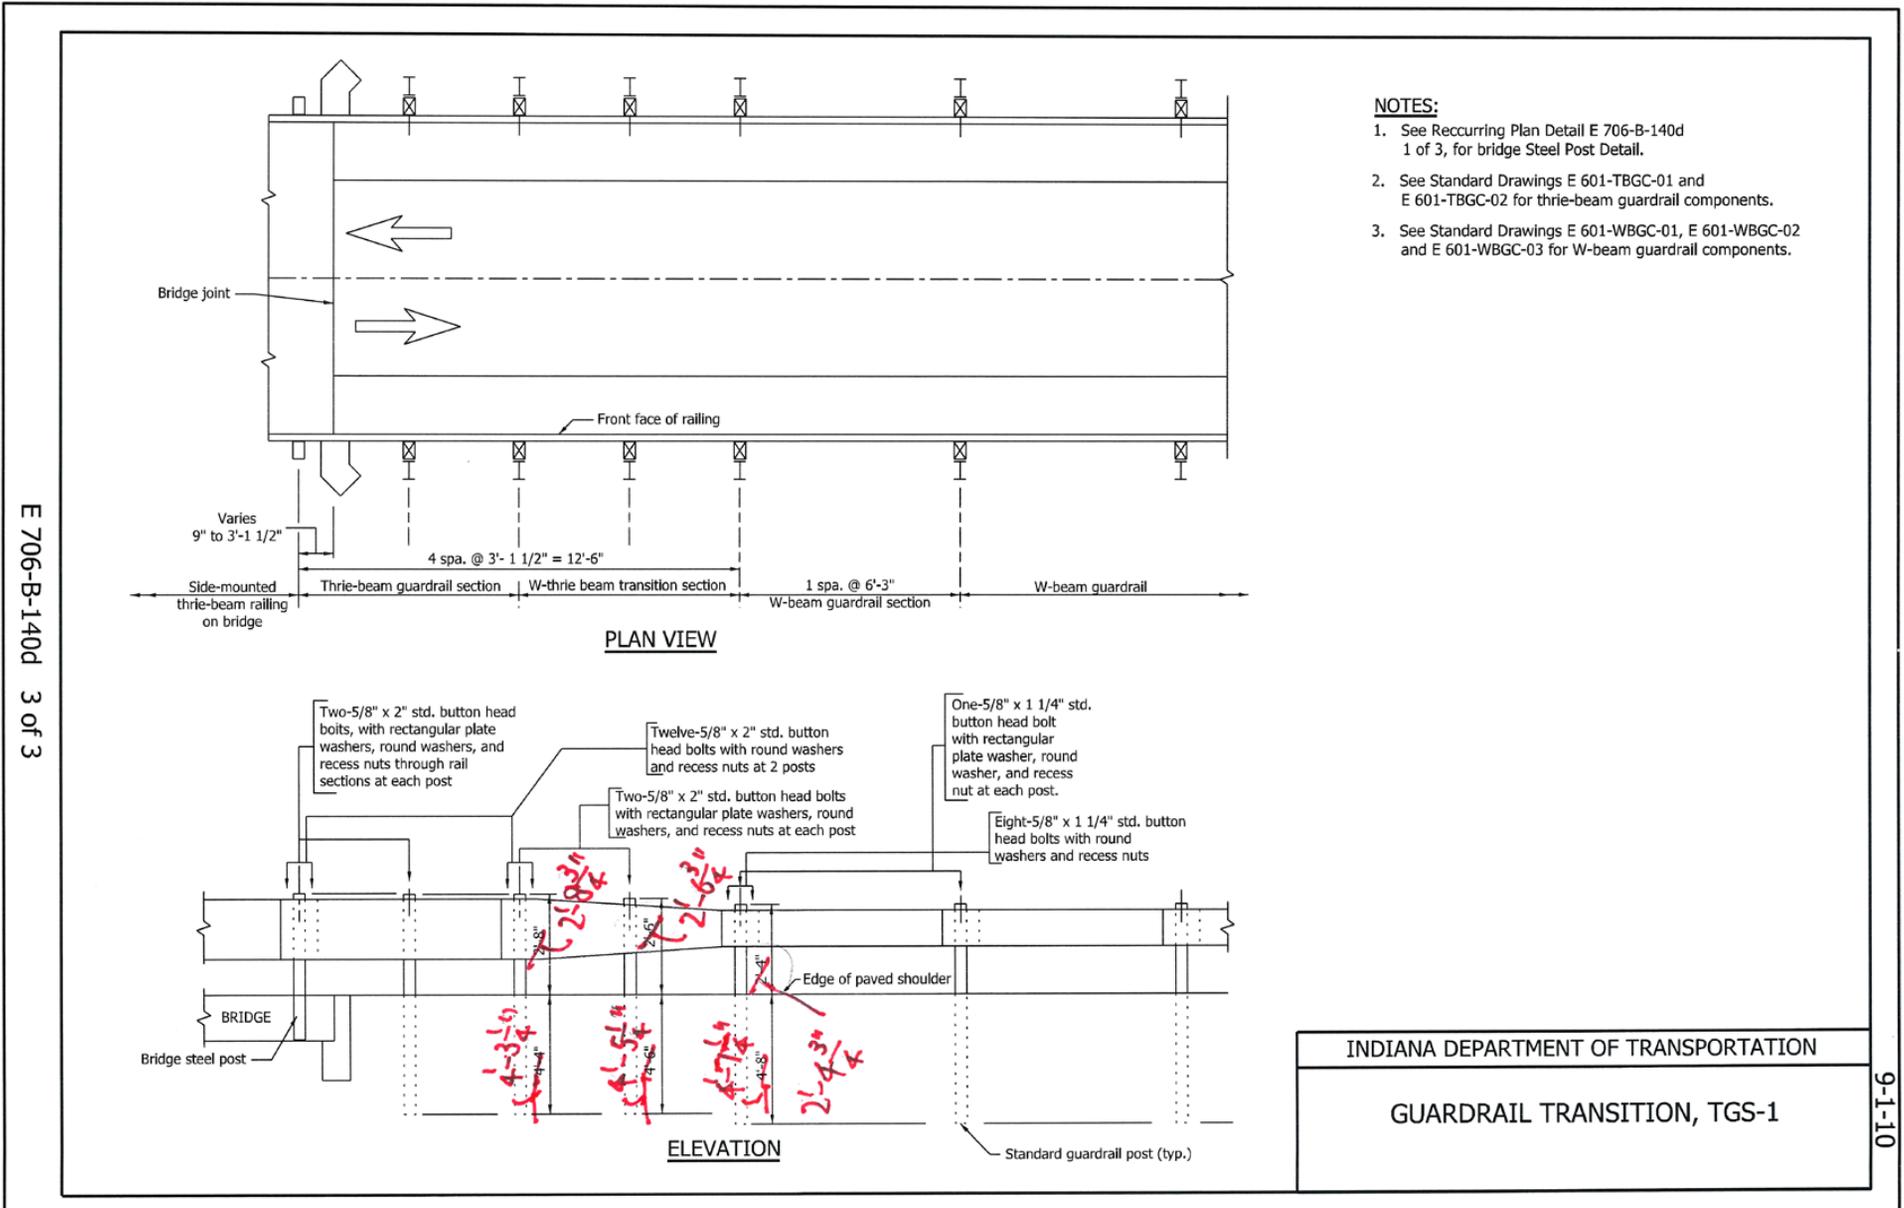

THIS PAGE LEFT INTENTIONALLY BLANK

ADDENDUM 1

COMMENTS AND ACTION

REVISION TO THE STANDARD DRAWINGS AS LISTED ON A PROPOSAL SHEET
 REVISION TO RECURRING PLAN DETAILS 706-B-140d BRIDGE RAILING TYPE TS-1 &
 GUARDRAIL TRANSITION TYPE TGS-1

Motion: Second: Ayes: Nays:	Action: <input type="checkbox"/> Passed as Submitted <input type="checkbox"/> Passed as Revised <input type="checkbox"/> Withdrawn
Standard Specifications Sections affected: NONE Recurring Plan Details affected: 706-B-140d Standard Sheets affected: AS LISTED ON PROPOSAL SHEET Design Manual Sections affected: None GIFE Sections cross-references: NONE	<input type="checkbox"/> 20__ Standard Specifications Book <input type="checkbox"/> Create RSP (No.____) Effective ____ Letting RSP Sunset Date: ____ <input type="checkbox"/> Revise RSP (No.____) Effective ____ Letting RSP Sunset Date: ____ <input type="checkbox"/> Standard Drawing Effective ____ <input type="checkbox"/> Create RPD (No. ____) Effective ____ Letting <input type="checkbox"/> Technical Advisory GIFE Update Req'd.? Y __ N __ By ____ Addition or ____ Revision Frequency Manual Update Req'd? Y __ N __ By ____ Addition or ____ Revision Received FHWA Approval? ____

SPECIFICATION REVISIONS
REVISION TO THE STANDARD SPECIFICATIONS

PROPOSAL TO STANDARDS COMMITTEE

PROBLEM(S) ENCOUNTERED: Section 906.02(a)1 requires that Hot Poured Joint Sealants (Type II) be tested by Materials Management and pre-approved if passing tests are obtained. Section 906.02(a)4 requires that Asphalt Rubber Sealants (Type I) be accepted by a Type A Certification. PG binders are selected for low temperature performance in our climate at -22C. Type II sealants are tested at -29C and Type I sealants are tested at -18C. There is no specification or design guidance on which materials are to be used and Materials Management would prefer to pre-test these materials and not allow Type I sealants that do not span our low temperature requirements.

PROPOSED SOLUTION: A revision to 906.02 is required to delete the section allowing Asphalt Rubber Sealants (Type I).

APPLICABLE STANDARD SPECIFICATIONS: 906.02

APPLICABLE STANDARD DRAWINGS: None

APPLICABLE DESIGN MANUAL SECTION: None

APPLICABLE SECTION OF GIFE: Section 13

APPLICABLE RECURRING SPECIAL PROVISIONS: None

Submitted By: Ron Walker

Title: Manager, Office of Materials Management

Organization: INDOT

Phone Number: 317-610-7251x204

Date: September 1, 2010

APPLICABLE SUB-COMMITTEE ENDORSEMENT?

Revisions recommended by the Office of Materials Management and the Pavement Preservation Committee.

REVISION TO THE STANDARD SPECIFICATIONS

SECTION 906 - JOINT MATERIALS

REVISION TO 906.02(a)4 ASPHALT RUBBER SEALANT

REVISION TO 906.02(a)5 POLYCHLOROPRENE JOINT MEMBRANE AND ADHESIVE

The Standards Specifications are revised as follows:

SECTION 906, BEGIN LINE 78, DELETE AND INSERT AS FOLLOWS:

4. Asphalt Rubber Sealant

a. Requirements

~~The asphalt rubber sealant shall be a single component asphalt sealant that contains a minimum of 18% recycled rubber by weight of asphaltic components. Seventy percent of the rubber shall be ground reclaimed rubber. The asphalt rubber sealant shall be in accordance with ASTM D 6690, type I.~~

b. Packaging

~~The asphalt rubber sealant shall be delivered in the manufacturer's original sealed packaging. Each container shall be marked legibly with the manufacturer's name, name of material, the batch or lot number, the expiration date, the recommended pouring temperature, and the safe heating temperature.~~

c. Installation

~~The rubber asphalt sealant shall be installed in accordance with manufacturer's recommendations. The backer rod shall be in accordance with manufacturer's specifications and 906.02(b) if a backer rod is required.~~

d. Certification

~~The Contractor shall supply a type A certification in accordance with 916 for each batch or lot of material furnished.~~

54. Polychloroprene Joint Membrane and Adhesive

Polychloroprene joint membrane shall be general purpose, heavy duty polychloroprene sheeting with nylon fabric reinforcement. The sheeting shall be in accordance with the following:

COMMENTS AND ACTION

REVISION TO 906.02(a)4 ASPHALT RUBBER SEALANT
 REVISION TO 906.02(a)5 POLYCHLOROPRENE JOINT MEMBRANE AND ADHESIVE

Motion: Second: Ayes: Nays:	Action: <input type="checkbox"/> Passed as Submitted <input type="checkbox"/> Passed as Revised <input type="checkbox"/> Withdrawn
Standard Specifications Sections affected:	<input type="checkbox"/> 20__ Standard Specifications Book
408.05 pg 270; 507.03 pg 337; 507.04 pg 338; 906 pg 785, 786.	<input type="checkbox"/> Create RSP (No. ___) Effective ___ Letting
Recurring Special Provision affected:	RSP Sunset Date: ___
408-R-564 SEALING CRACKS AND JOINTS	<input type="checkbox"/> Revise RSP (No. ___) Effective ___ Letting
Standard Sheets affected:	RSP Sunset Date: ___
NONE	
Design Manual Sections affected:	Standard Drawing Effective ___
None	<input type="checkbox"/> Create RPD (No. ___) Effective ___ Letting
GIFE Sections cross-references:	<input type="checkbox"/> Technical Advisory
SECTION 13	GIFE Update Req'd.? Y ___ N ___
	By ___ Addition or ___ Revision
	Frequency Manual Update Req'd? Y ___ N ___
	By ___ Addition or ___ Revision
	Received FHWA Approval? ___

SPECIFICATION REVISIONS
REVISION TO THE STANDARD SPECIFICATIONS

PROPOSAL TO STANDARDS COMMITTEE

PROBLEM(S) ENCOUNTERED: Longitudinal joint performance has been a problem with HMA pavements by allowing water to penetrate the joint and eventually cause stripping of the underlying HMA layers, and deterioration of the joint. Also, low density of the HMA adjacent to the joint may allow water to penetrate this area resulting in the same problems. Sealing the joint to prevent this water intrusion and requiring a minimum density within a designated distance from the joint would improve the joint performance.

PROPOSED SOLUTION: A Special Provision to require a joint adhesive and obtain informational cores for determination of the joint density is required as follows:

1. A joint adhesive material would be required for longitudinal joints constructed in the top course of dense graded intermediate mixtures and all surface mixture courses. This would include joints within the traveled way as well as between the traveled way and an auxiliary lane, traveled way and a paved shoulder, and an auxiliary lane and a paved shoulder.

2. Two additional informational cores would be obtained at the same station as the density acceptance cores. The center of 1 core shall be located 6 in. from the left edge of the course being laced and the center of the other core shall be located 6 in. from the right edge of the course being placed. These cores will not be used to determine the density pay factor.

APPLICABLE STANDARD SPECIFICATIONS: 401

APPLICABLE STANDARD DRAWINGS: None

APPLICABLE DESIGN MANUAL SECTION: None

APPLICABLE SECTION OF GIFE:Section 13

APPLICABLE RECURRING SPECIAL PROVISIONS:None

Submitted By: Ron Walker

Title: Manager, Office of Materials Management

Organization: INDOT

Phone Number: 317-610-7251x204

Date: September 1, 2010

APPLICABLE SUB-COMMITTEE ENDORSEMENT?

Revisions recommended by the INDOT/APAI Longitudinal Joint Density Committee.

REVISION TO THE SPECIAL PROVISION

PROPOSED RECURRING SPECIAL PROVISION 401-R-XXX JOINT ADHESIVE AND INFORMATIONAL CORES

401-R-XXX JOINT ADHESIVE AND INFORMATIONAL CORES

(Adopted XX-XX-XX)

SECTION 401, AFTER LINE 8, INSERT AS FOLLOWS:

Joint adhesive is a hot applied asphalt material that is used to seal the construction joint formed between the adjacent HMA pavement courses.

SECTION 401, AFTER LINE 31, INSERT AS FOLLOWS:

Joint adhesive shall meet the following material requirements.

Test	Method	Test Results
Softening Point, °F (°C)	AASHTO T 51	170 (77) minimum
Ductility @ 77 °F (25 °C) (5 cm/min)	AASHTO T 51	> 30
Ductility @ 39 °F (4 °C) (5 cm/min)	AASHTO T 51	> 30
Apparent Viscosity, cp, @ 400 °F (230°C)	ASTM D 2669	4,000 – 10,000
Asphalt Compatibility	AASHTO M 301	Pass
Cone Penetration, mm	AASHTO M 301	60.0 – 100.0
Flow, mm	AASHTO M 301	< 5
Resilience @ 77 °F (25 °C), %	AASHTO M 301	> 30
Tensile Adhesion @ 77 °F (25 °C)	AASHTO M 301	> 500
Flexibility @ 0 °F (-18 °C)	ASTM D 3111	Pass
Flash Point, °F (°C)	AASHTO T 48	> 410 (210)

The adhesive will be accepted by type A certification in accordance with 916 for each batch or lot of material furnished.

SECTION 401, AFTER LINE 342, INSERT AS FOLLOWS:

Joint adhesive shall be applied to longitudinal joints constructed in the top course of dense graded intermediate mixtures and all surface mixture courses. This includes joints within the traveled way as well as between any of the following: traveled way and an auxiliary lane, traveled way and a paved shoulder, and auxiliary lane and a paved shoulder.

The material shall be heated in a jacketed, double boiler melting kettle. The kettle shall have an attached pressure feed wand system with applicator shoe.

The joint adhesive shall be applied to the face of the previously constructed edge at the joint using a wand applicator. Prior to application of the joint adhesive, the joint face shall be dry and free of loose material and foreign objects. The adhesive shall be applied on the joint face 1/8 in. (3 mm) thick at the temperature recommended by the manufacturer. Excess joint adhesive shall not be allowed to pool on the top of the previously constructed pavement course or the pavement to be overlaid. The application of the adhesive shall be made within the same day, but at least 15 min prior to construction of the longitudinal joint.

REVISION TO THE SPECIAL PROVISION

PROPOSED RECURRING SPECIAL PROVISION 401-R-XXX JOINT ADHESIVE AND
INFORMATIONAL CORES (CONTINUED)

SECTION 401, BEGIN LINE 362, DELETE AND INSERT AS FOLLOWS:

Density acceptance by cores will be based on samples obtained from ~~two~~ 2 random locations selected by the Engineer within each subplot in accordance with ITM 802. One core shall be cut at each random location in accordance with ITM 580. The transverse core location will be located so that the edge of the core will be no closer than ~~3~~ 12 in. (75 300 mm) from a ~~confined edge or 6 in. (150 mm) from a non-confined~~ the edge of the course being placed. The maximum specific gravity will be determined from the samples obtained in 401.09.

In addition, 2 informational cores shall be obtained at the same station as the density acceptance cores. The center of 1 core shall be located 6 in. (150 mm) from the left edge of the course being placed and the center of the other core shall be located 6 in. (150 mm) from the right edge of the course being placed. These informational cores will not be used in the density pay factor determination.

SECTION 401, AFTER LINE 667, INSERT AS FOLLOWS:

Joint adhesive will be measured by the linear foot in accordance with 109.01(a).

SECTION 401, AFTER LINE 681, INSERT AS FOLLOWS:

Joint adhesive will be paid for by the linear foot, complete in place.

SECTION 401, AFTER LINE 685, INSERT AS FOLLOWS:

Joint AdhesiveLFT

COMMENTS AND ACTION

RECURRING SPECIAL PROVISION 401-R-XXX JOINT ADHESIVE AND INFORMATIONAL CORES

Motion: Second: Ayes: Nays:	Action: <input type="checkbox"/> Passed as Submitted <input type="checkbox"/> Passed as Revised <input type="checkbox"/> Withdrawn
Standard Specifications Sections affected:	<input type="checkbox"/> 20 Standard Specifications Book
SECTION 401	<input type="checkbox"/> Create RSP (No. ___) Effective ___ Letting RSP Sunset Date: ___
Recurring Special Provision affected:	NONE
Standard Sheets affected:	<input type="checkbox"/> Revise RSP (No. ___) Effective ___ Letting RSP Sunset Date: ___
NONE	Design Manual Sections affected:
None	Standard Drawing Effective ___ <input type="checkbox"/> Create RPD (No. ___) Effective ___ Letting <input type="checkbox"/> Technical Advisory
GIFE Sections cross-references:	GIFE Update Req'd.? Y ___ N ___ By ___ Addition or ___ Revision
SECTION 13	Frequency Manual Update Req'd? Y ___ N ___ By ___ Addition or ___ Revision
	Received FHWA Approval? ___