

SPECIFICATIONS, SPECIAL PROVISIONS AND STANDARD DRAWINGS  
REVISION TO STANDARD DRAWINGS

PROPOSAL TO STANDARDS COMMITTEE

PROBLEM(S) ENOUNTERED: In review of the bridge railing transition Standards inconsistances were found in presentation and minnor errors and omissions were present.

PROPOSED SOLUTION: The bridge railing Standards have been revised so that the Standards are consistent in detailing and overall presentation.

APPLICABLE STANDARD SPECIFICATIONS: none

APPLICABLE STANDARD DRAWINGS:

<u>Current Standard Drawing</u>	<u>Transition</u>	<u>Proposed Drawing Designation</u>
706-CBRT-01 thru 04		same
706-TPBT-01 thru 09	TF-2	706-TTTF-01 thru 04
706-TTBC-01 thru 03	FC	706-TTFC-01 thru 03
706-TTBP-01 thru 09	PF-1, PF-2, PS-1, PS-2	706-TTPP-01 thru 08
706-TTBT-01 thru 03	FT	706-TTFT-01 thru 03
706-TTTX-01 thru 04	TX	same
706-TWBC-01 thru 03	W-Beam	706-TWFC-01 thru 03
706-TWBC-04		to delete

APPLICABLE DESIGN MANUAL SECTION: None

APPLICABLE SECTION OF GIFE: None

APPLICABLE RECURRING SPECIAL PROVISIONS: None

PAY ITEMS AFFECTED: None

Mr. Strain (contd.)  
Date: 03/15/12

SPECIFICATIONS, SPECIAL PROVISIONS AND STANDARD DRAWINGS

REVISION TO STANDARD DRAWINGS

Submitted By: Randy Strain

Title: INDOT Bridge Standard and Policy Engineer

Organization: INDOT

Phone Number: 232-3339

Date: Feb 14, 2012


APPLICABLE SUB-COMMITTEE ENDORSEMENT: none

REVISION TO STANDARD DRAWINGS


EXISTING 706-CBRT-01 BRIDGE RAILING TRANSITION WBC OR TBC DETAILS AT END BENT (WITH MARKUPS)

B7TS-01 Does not exist

① Type WBC or TBC  
 concrete bridge railing transition  
 concrete bridge railing type FC

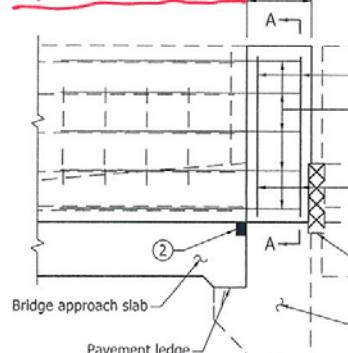

PART ELEVATION

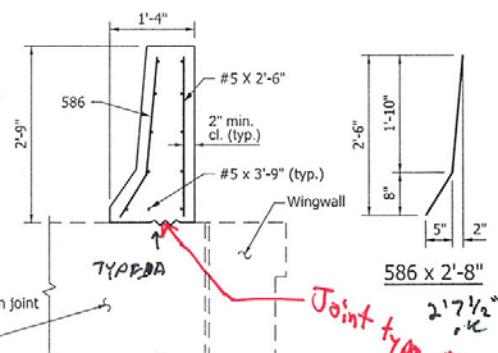

609-BRJT-01


NOTES:

- ① See Standard Drawings E 706-TWBC-01 through -03 for concrete bridge railing transition type WBC details. See Standard Drawing E 706-TTBC-01A-02 for concrete bridge railing transition type TBC details. ~~209-TTBC-01 through -03~~
- ② See Standard Drawing E 724-B7TS-01 for type M joint details.
- ③ This shall be part of the concrete bridge railing, but shall be poured with the concrete bridge-rail transition. The minimum length shall be equal to the width of the mudwall. See Standard Drawing E 706-BCBR-01 for bridge railing type FC dimensions.

Welded with type BA



① Type WBC or TBC  
 concrete bridge railing transition

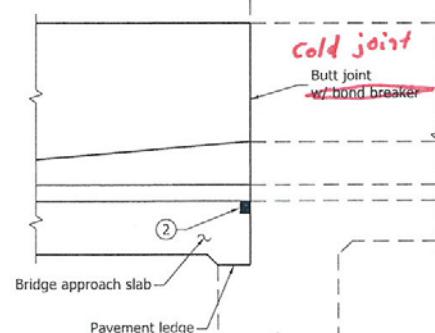

DETAIL AT INTEGRAL END BENT


cold joint  
 Butt joint  
 w/ bond breaker  
 bond breaker  
 nut peeler.  
 Butt joint  
 only?

INDIANA DEPARTMENT OF TRANSPORTATION

BRIDGE RAILING TRANSITION WBC  
 OR TBC DETAILS AT END BENT

SEPTEMBER 2011

STANDARD DRAWING NO. E 706-CBRT-01

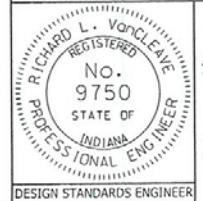

/s/ Richard L. VanCleave 09/01/11  
 DESIGN STANDARDS ENGINEER DATE


/s/ Mark A. Miller 09/01/11  
 CHIEF HIGHWAY ENGINEER DATE

REVISION TO STANDARD DRAWINGS

EXISTING 706-CBRT-02 BRIDGE RAILING TRANSITION WBC ATTACHMENT OF GUARDRAIL (WITH MARKUPS)

*we have enough shear force/capacity  
here to pull a large vessel*

*But the material is wrong!*

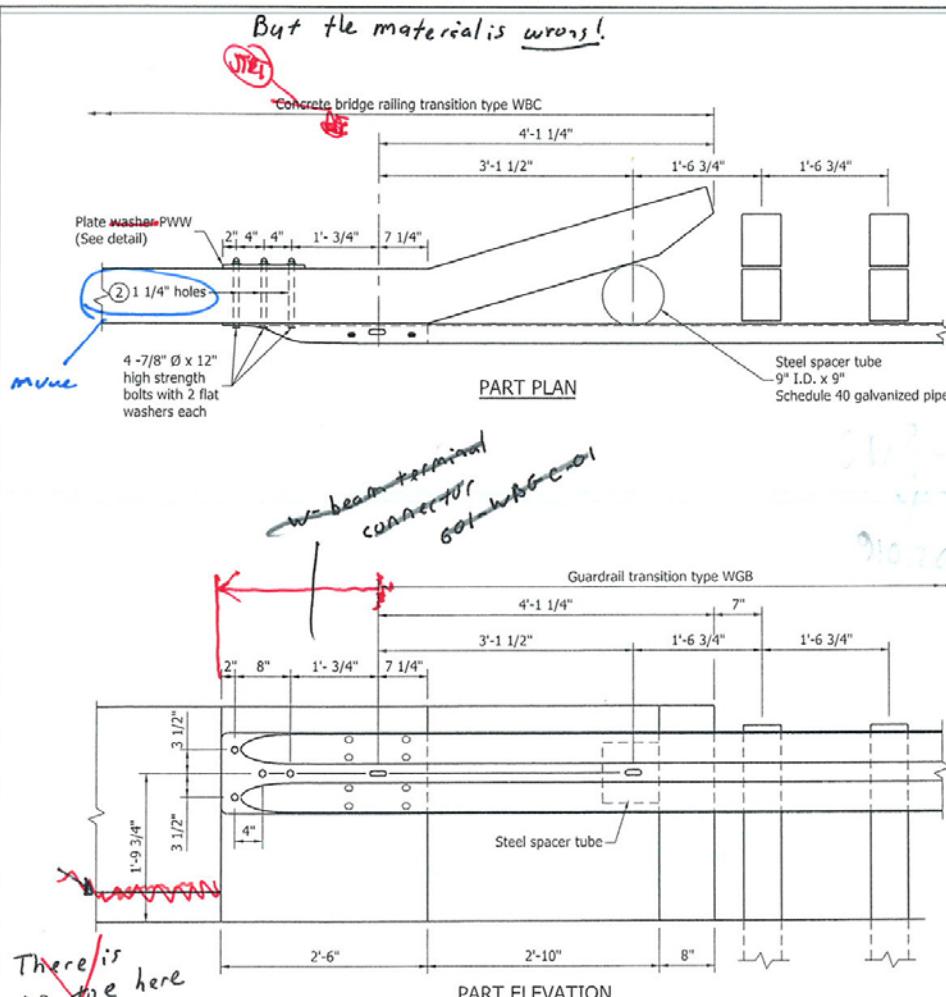

NOTES:

1. See Standard Drawing E 704-TWBC-01 for bridge railing transition type WBC. See Standard Drawings E 601-TWGB-01 through -03 for guardrail transition type WGB.

2. These holes required for the connection of the guardrail transition type WGB to the end of the concrete bridge railing transition type WBC shall be preformed.

*Preferred*

*Rewrite*

*bolts & plate should be galvanized*

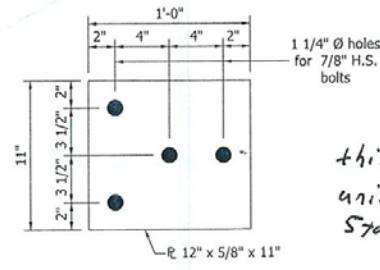



PLATE WASHER-PWW

INDIANA DEPARTMENT OF TRANSPORTATION

BRIDGE RAILING TRANSITION WBC  
ATTACHMENT OF GUARDRAIL

SEPTEMBER 2011

STANDARD DRAWING NO. E 706-CBRT-02

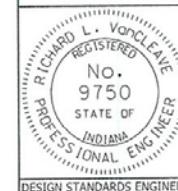

/s/ Richard L. VanCleave 09/01/11  
DESIGN STANDARDS ENGINEER DATE


/s/ Mark A. Miller 09/01/11  
CHIEF HIGHWAY ENGINEER DATE

REVISION TO STANDARD DRAWINGS


EXISTING 706-CBRT-03 BRIDGE RAILING TRANSITION TBT DETAILS AT END BENT (WITH MARKUPS)

*recommend order to chase*

① Type TBT  
 concrete bridge railing transition

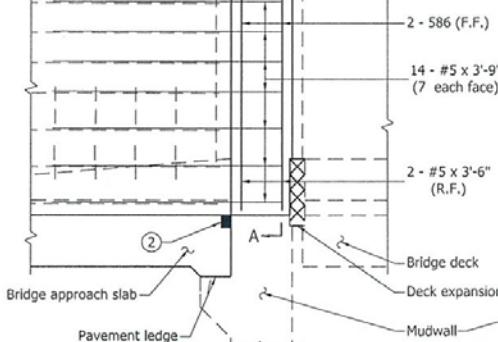

PART ELEVATION

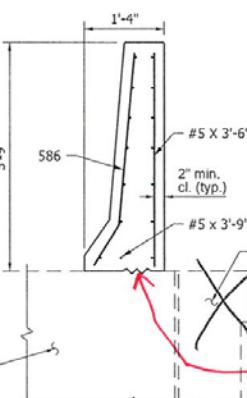

SECTION A-A


609-BR51-01

NOTES:

① See Standard Drawings E 706-TTBT-01 through -03 for concrete bridge railing transition type TBT details.  
 ② See Standard Drawing E 724-BTS-01 for type FT joint details.  
 ③ This shall be part of the concrete bridge railing, but shall be poured with the concrete bridge-rail transition. The minimum length shall be equal to the width of the mudwall. See Standard Drawing E 706-BCBR-02 for bridge railing type FT dimensions.

Joint type I-A

① Type TBT  
 concrete bridge railing transition

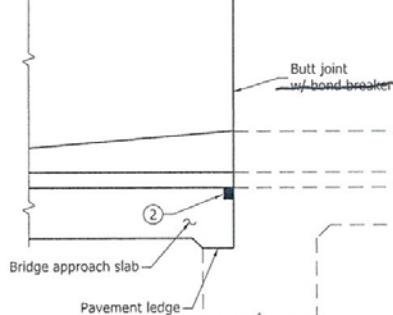


DETAIL AT INTEGRAL END BENT

INDIANA DEPARTMENT OF TRANSPORTATION

BRIDGE RAILING TRANSITION TBT  
 DETAILS AT END BENT

SEPTEMBER 2011

STANDARD DRAWING NO. E 706-CBRT-03

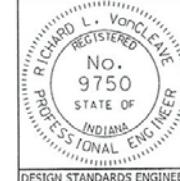

/s/ Richard L. VanCleave 09/01/11  
 DESIGN STANDARDS ENGINEER DATE


/s/ Mark A. Miller 09/01/11  
 CHIEF HIGHWAY ENGINEER DATE

DESIGN STANDARDS ENGINEER

REVISION TO STANDARD DRAWINGS

EXISTING 706-CBRT-04 BRIDGE RAILING TRANSITION TBC OR TBT ATTACHMENT OF GUARDRAIL (WITH MARKUPS)


706-CBRT-02

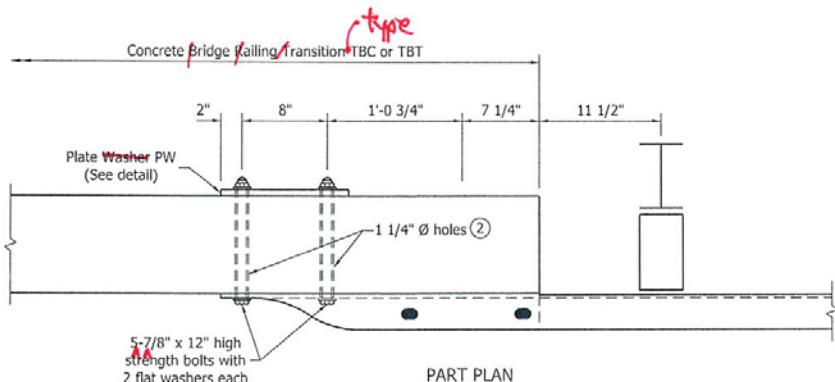

NOTES:

1. See Standard Drawing E 706-TTBC-01 for bridge railing transition type TBC. See Standard Drawing E 706-TTBT-01 for bridge railing transition type TBT. See Standard Drawing E 601-TTGB-01 for guardrail transition type TGB.
2. These holes, required for the connection of the guardrail transition type TBC or TBT to the end of the concrete bridge railing transition TGB, shall be preformed.

*Preformed through -03*  
*through -05*  
*type TBC or TBT*

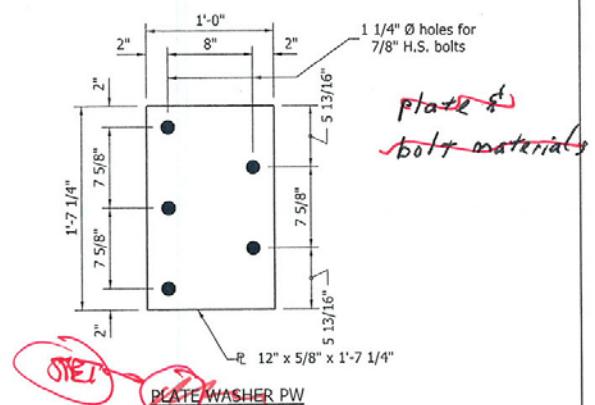


INDIANA DEPARTMENT OF TRANSPORTATION

BRIDGE RAILING TRANSITION TBC OR  
 TBT ATTACHMENT OF GUARDRAIL

SEPTEMBER 2011

STANDARD DRAWING NO. E 706-CBRT-04

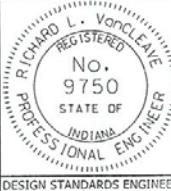

/s/ Richard L. VanCleave 09/01/11  
 DESIGN STANDARDS ENGINEER DATE

/s/ Mark A. Miller 09/01/11  
 CHIEF HIGHWAY ENGINEER DATE

THRIE-BEAM OR Comp


Shows Thrie Beam Terminal connector

T GBT To T BRT

REVISION TO STANDARD DRAWINGS


706-CBRT-01 BRIDGE RAILING TRANSITION WFC OR TFC DETAILS AT END BENT (DRAFT)

① Concrete bridge railing transition, Bridge railing type FC  
 type WFC or TFC

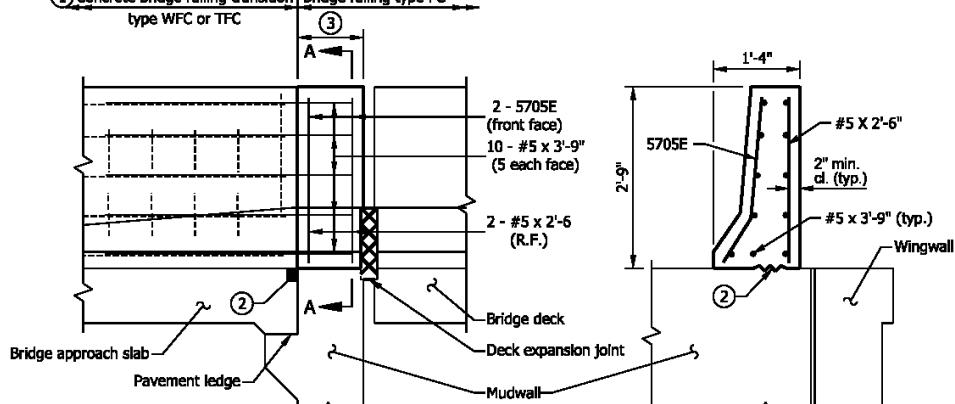

PART ELEVATION

SECTION A-A

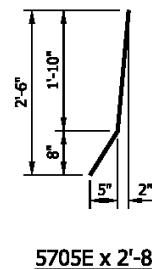


5705E x 2'-8"

NOTES

- ① See Standard Drawings E 706-TWFC-01 through -03 for concrete bridge railing transition type WFC. See Standard Drawings E 706-TTFC-01 through -03 for concrete bridge railing transition type TFC.
- ② See Standard Drawing E 609-BRJT-01 for joint type I-A.
- ③ This shall be part of the concrete bridge railing, but it shall be poured with the concrete bridge-railing transition. The minimum length shall be equal to the width of the mudwall. See Standard Drawing E 706-GRSF-01 for bridge railing type FC dimensions.
4. See Standard Drawing E 703-BRST-01 for reinforcing-bar bending details and notes.

① Concrete bridge railing transition, Bridge railing type FC  
 type WFC or TFC

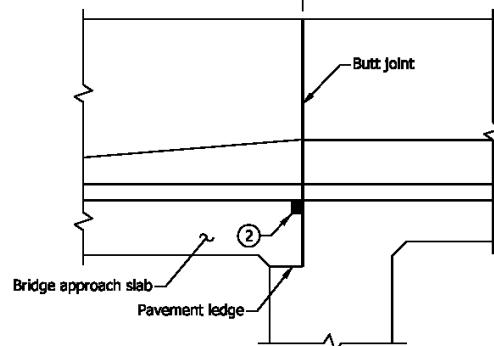

DETAIL AT INTEGRAL END BENT

INDIANA DEPARTMENT OF TRANSPORTATION

BRIDGE RAILING TRANSITION WFC  
 OR TFC DETAILS AT END BENT

SEPTEMBER 2011

STANDARD DRAWING NO. E 706-CBRT-01



DESIGN STANDARDS ENGINEER DATE

CHIEF HIGHWAY ENGINEER DATE

DESIGN STANDARDS ENGINEER


REVISION TO STANDARD DRAWINGS

706-CBRT-02 BRIDGE RAILING TRANSITION WFC ATTACHMENT OF GUARDRAIL (DRAFT)

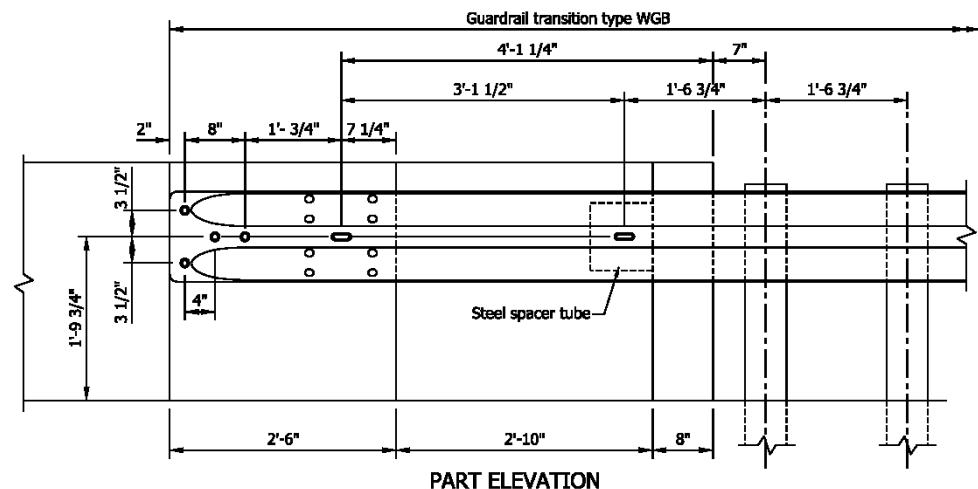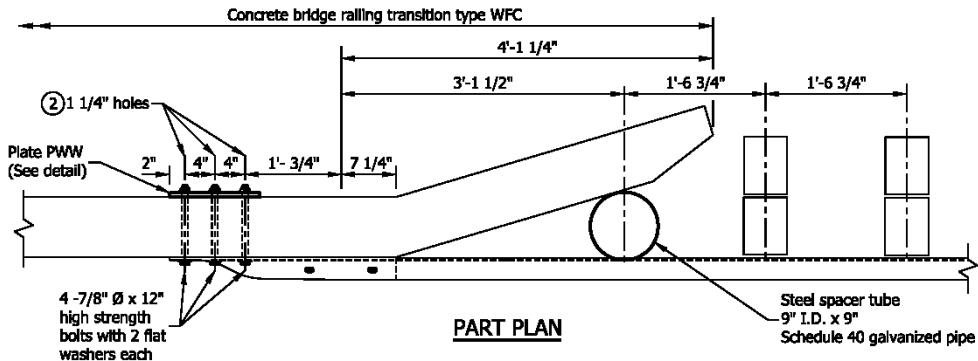

**NOTES**


1. See Standard Drawing E 706-TWFC-01 through -03 for concrete bridge railing transition type WFC. See Standard Drawings E 601-TWGB-01 through -03 for guardrail transition type WGB.
- 2) Preformed holes, for connection of the guardrail transition type WGB to the end of the concrete bridge railing transition type WFC.

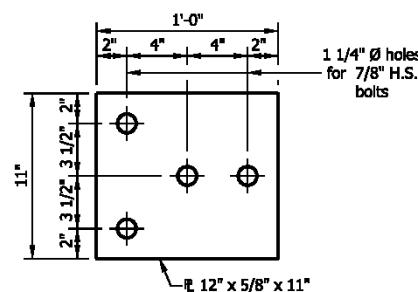

INDIANA DEPARTMENT OF TRANSPORTATION	
BRIDGE RAILING TRANSITION WFC ATTACHMENT OF GUARDRAIL	
SEPTEMBER 2011	
STANDARD DRAWING NO.	E 706-CBRT-02
DESIGN STANDARDS ENGINEER	DATE
CHIEF HIGHWAY ENGINEER	DATE
DESIGN STANDARDS ENGINEER	


REVISION TO STANDARD DRAWINGS

706-CBRT-03 BRIDGE RAILING TRANSITION TFT DETAILS AT END BENT (DRAFT)

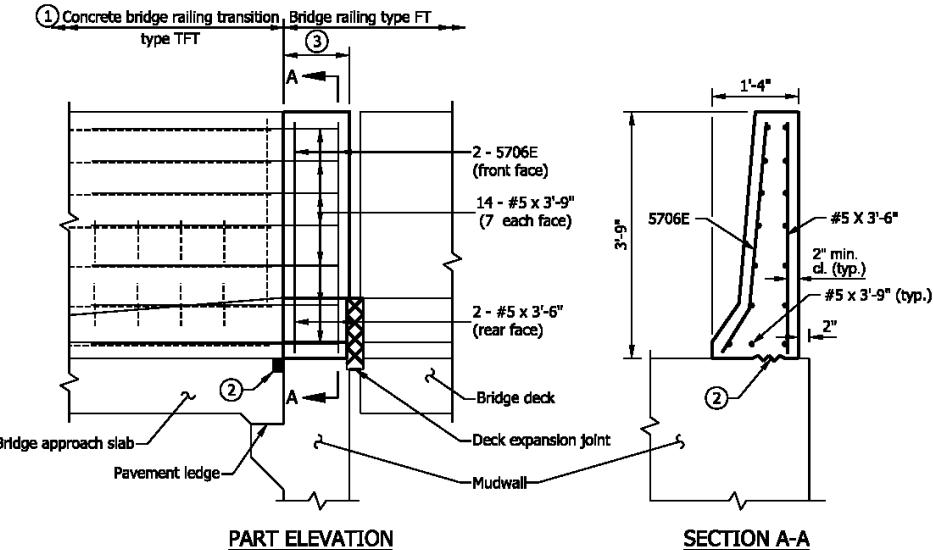

NOTES


- ① See Standard Drawings E 706-TTFT-01 through -03 for concrete bridge railing transition type TFT details.
- ② See Standard Drawing E 609-BRJT-01 for joint type I-A.
- ③ This shall be part of the concrete bridge railing, but it shall be poured with the concrete bridge-railing transition. The minimum length shall be equal to the width of the mudwall. See Standard Drawing E 706-BRSF-02 for bridge railing type FT dimensions.
4. See Standard Drawing E 703-BRST-01 for reinforcing-bar bending diagrams and notes.

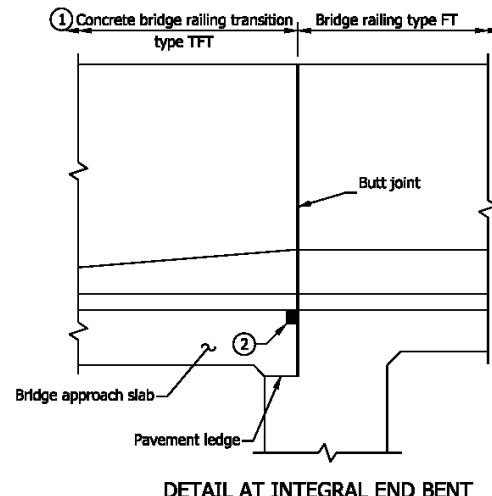

INDIANA DEPARTMENT OF TRANSPORTATION	
BRIDGE RAILING TRANSITION TFT DETAILS AT END BENT	
SEPTEMBER 2011	
STANDARD DRAWING NO. E 706-CBRT-03	
DESIGN STANDARDS ENGINEER	DATE
CHIEF HIGHWAY ENGINEER	DATE
DESIGN STANDARDS ENGINEER	


REVISION TO STANDARD DRAWINGS

706-CBRT-04 BRIDGE RAILING TRANSITION TFC OR TFT ATTACHMENT OF GUARDRAIL (DRAFT)

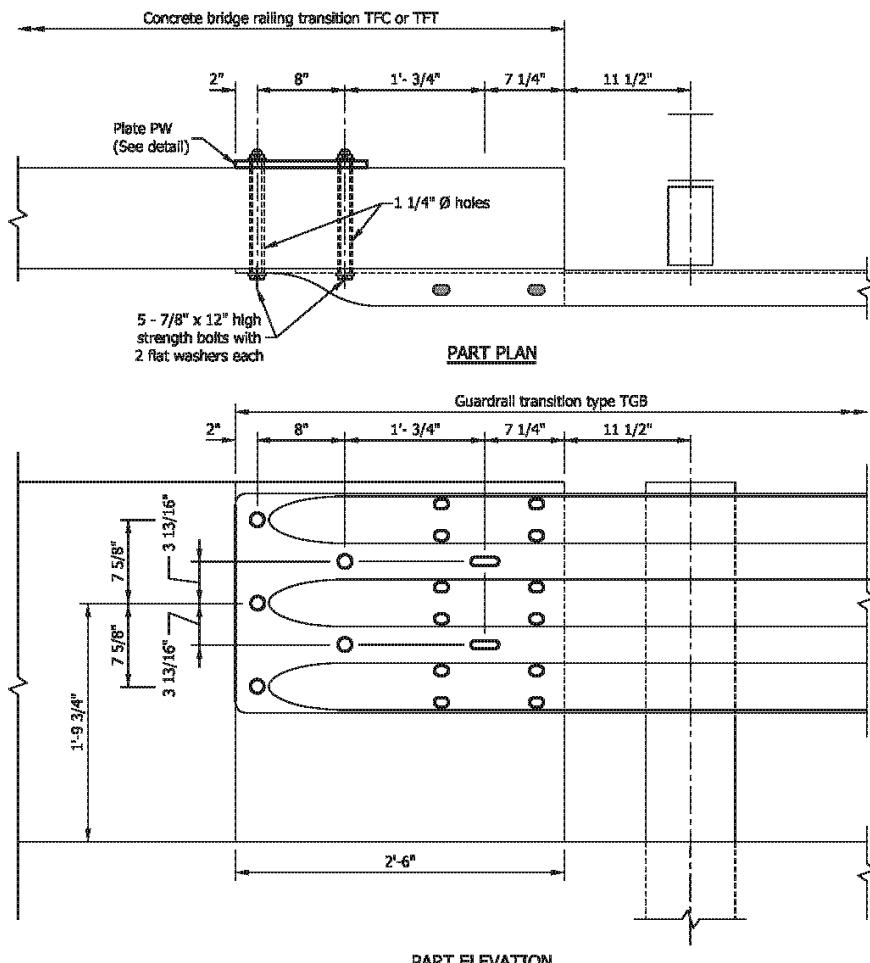

**NOTES**

1. See Standard Drawings E 706-TTFC-01 through -03 for concrete bridge railing transition type TFC. See Standard Drawings E 706-TTFT-01 through -03 for concrete bridge railing transition type TFT. See Standard Drawings E 601-TTGB-01 through -05 for guardrail transition type TGB.
2. Preformed holes, for connection of the guardrail transition type TGB to the end of the concrete bridge railing transition type TFC or TFT.

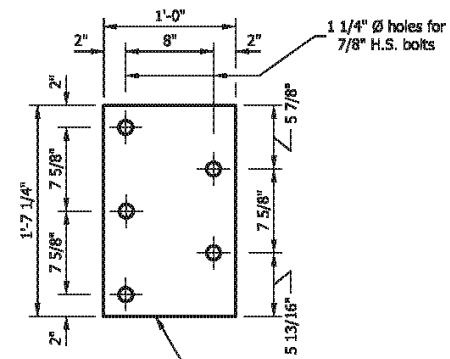

INDIANA DEPARTMENT OF TRANSPORTATION

BRIDGE RAILING TRANSITION TFC OR  
TFT ATTACHMENT OF GUARDRAIL

SEPTEMBER 2011

STANDARD DRAWING NO. E 706-CBRT-04


DESIGN STANDARDS ENGINEER DATE

CHIEF HIGHWAY ENGINEER DATE

DESIGN STANDARDS ENGINEER

REVISION TO STANDARD DRAWINGS

EXISTING 706-TPBT-01 BRIDGE RAILING TRANSITION TPBT ELEVATION (WITH MARKUPS)

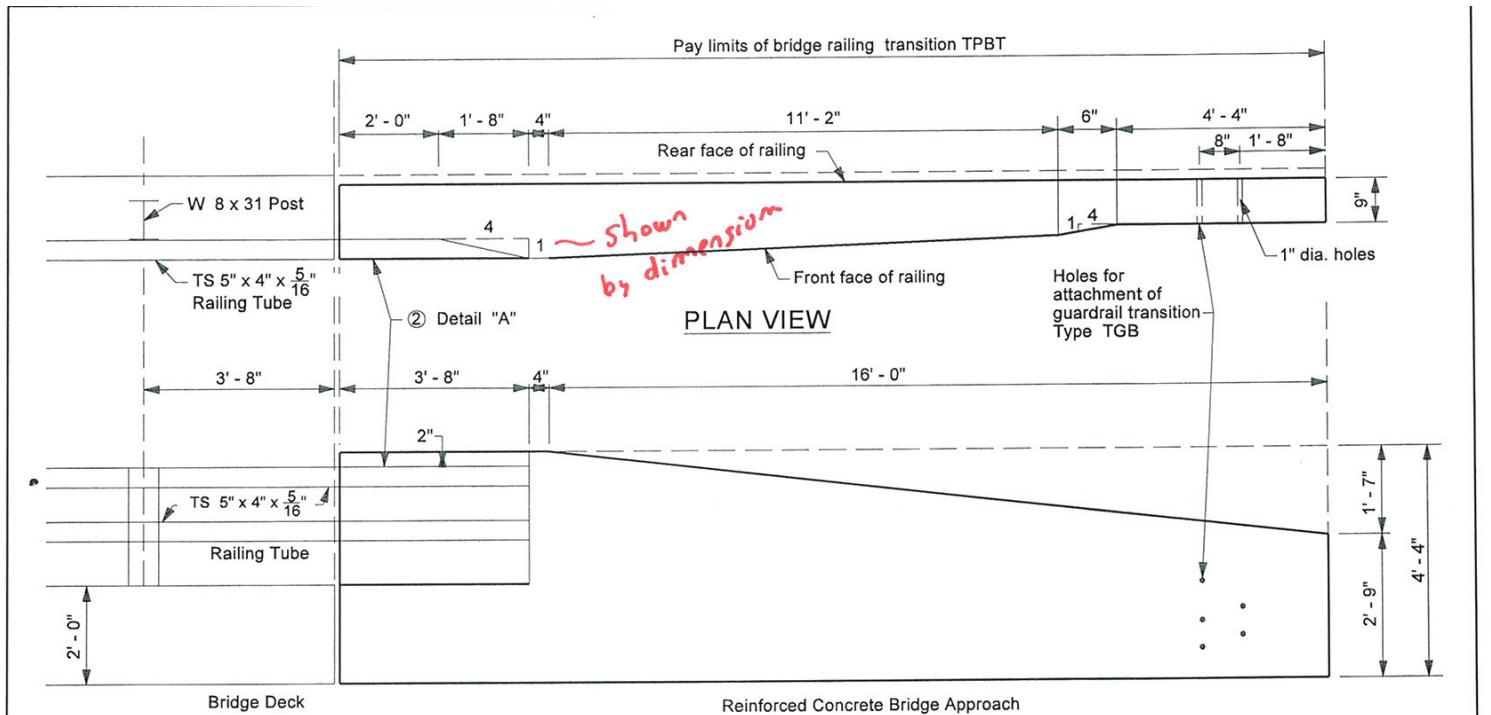

ELEVATION VIEW

NOTES:

1. See Standard Drawing E 709-TPBT-09 for reinforcing bar bending details.
- 2) See Standard Drawing E 706-TPBT-03 for Detail "A".
3. See Standard Drawing E 706-CBRT-02 for attachment of guardrail transition Type TGB.

Notes: 1) TTF-02 & 03 for sections  
 2) TTF-09 for bar diag  
 3) Holes for GR Trans CBRT-09  
 4) RcBA - TBAE-02  
 5) holes - BRTF-01


Sheet 1 of 4 combined.  
 Notes revised.

INDIANA DEPARTMENT OF TRANSPORTATION	
BRIDGE RAILING TRANSITION	
TPBT ELEVATION	
SEPTEMBER 2005	
STANDARD DRAWING NO. E 706-TPBT-01	
<small>RECEIVED                      RICHARD L. VANCE                      REGISTERED NO. 9750                      STATE OF INDIANA                      PROFESSIONAL ENGINEER</small>	<small>1/s/ Richard L. VanCleave 9-01-05                      DESIGN STANDARDS ENGINEER</small>
<small>RECEIVED                      RICHARD K. SMUTZER                      REGISTERED NO. 9750                      STATE OF INDIANA                      PROFESSIONAL ENGINEER</small>	<small>1/s/ Richard K. Smutzer 9-01-05                      CHIEF HIGHWAY ENGINEER</small>

Concrete  
 Bridge Raili  
 Transition  
 TTF-2

REVISION TO STANDARD DRAWINGS

EXISTING 706-TPBT-02 BRIDGE RAILING TRANSITION TPBT (PROPOSED TO DELETE)

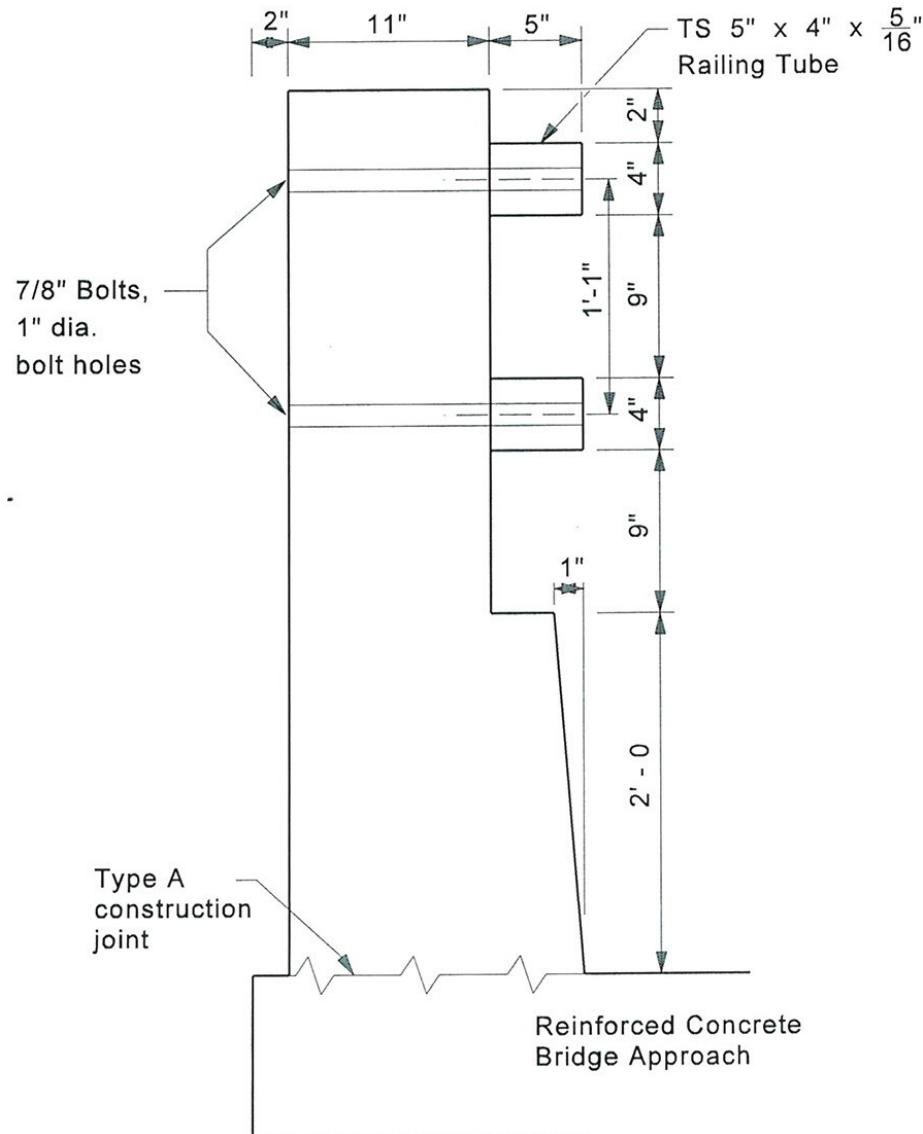


NOTES:

1. Reinforcing steel not shown for clarity.
2. Bolts shall be  $\frac{7}{8}$ " diameter 1'-6" long  
Round heads.


*holes shown on sheet/  
bolts shown in bridge Std.*

*Sheet deleted.*

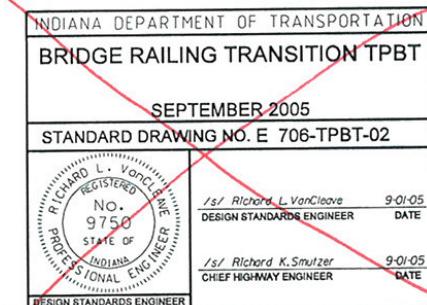

REVISION TO STANDARD DRAWINGS

EXISTING 706-TPBT-03 BRIDGE RAILING TRANSITION TPBT DETAIL "A" (PROPOSED TO DELETE)

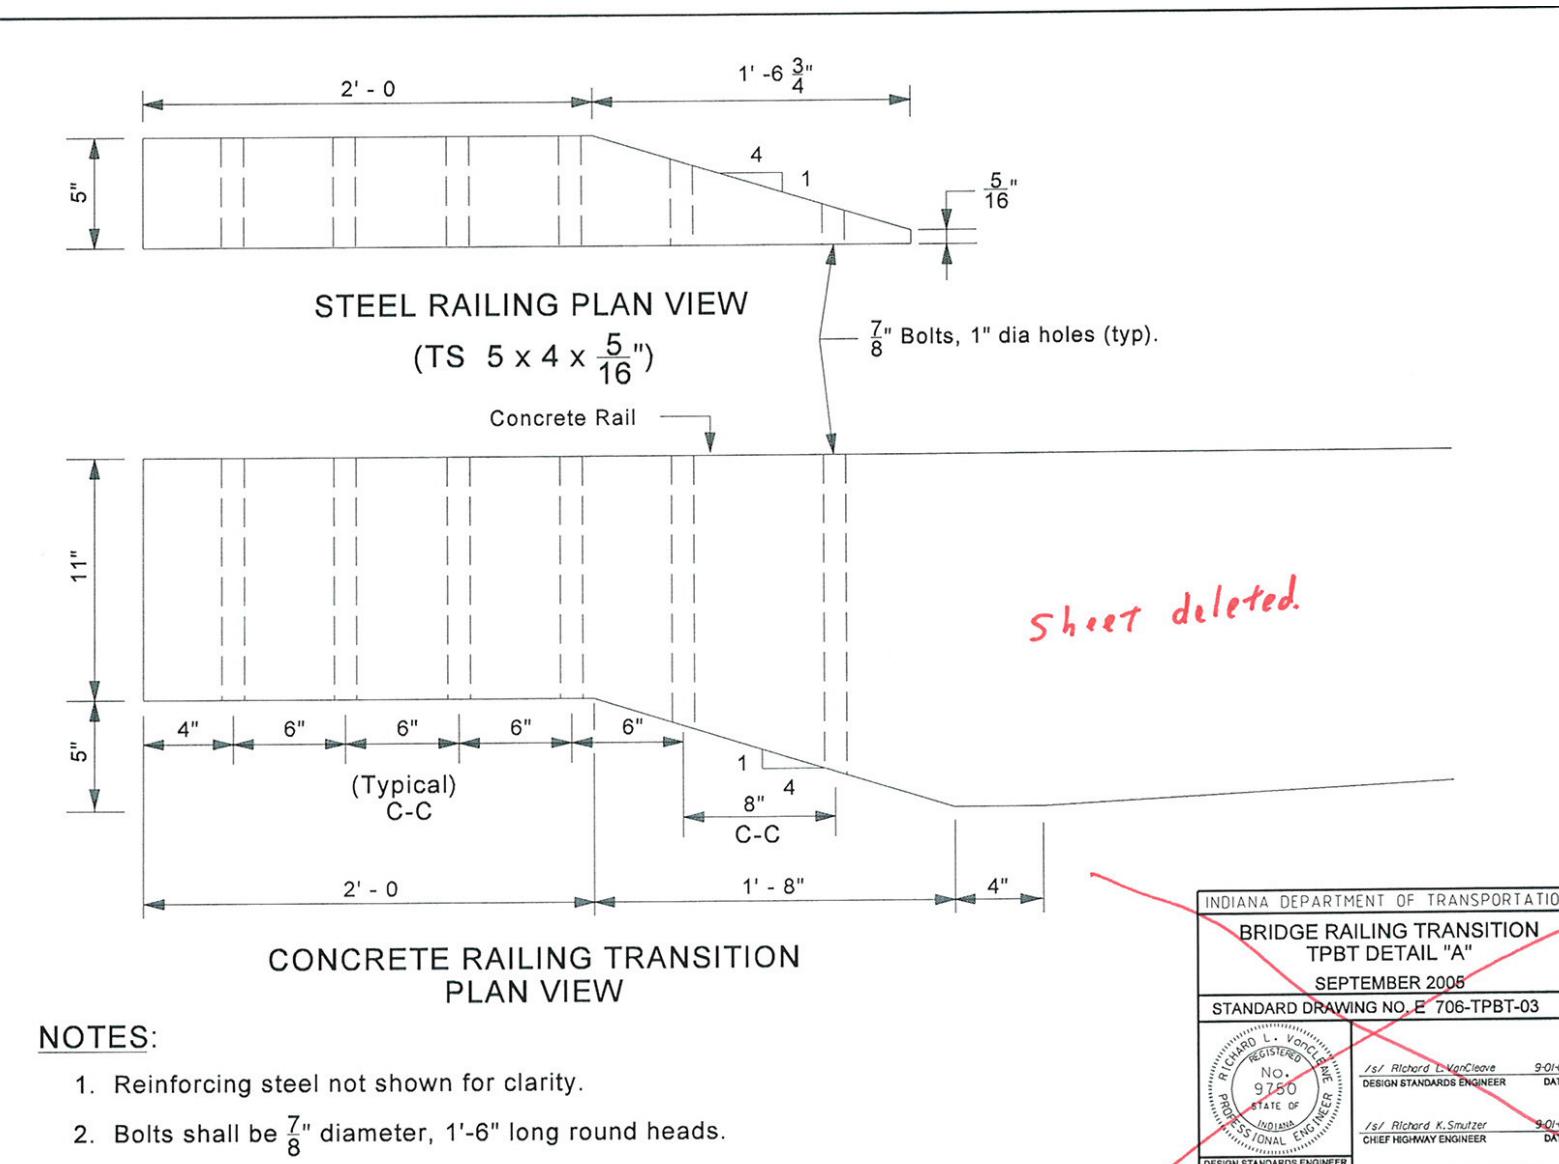


NOTES:


1. Reinforcing steel not shown for clarity.
2. Bolts shall be  $\frac{7}{8}$ " diameter, 1'-6" long round heads.

REVISION TO STANDARD DRAWINGS

EXISTING 706-TPBT-04 BRIDGE RAILING TRANSITION TPBT (FOR TF-2) REINFORCEMENT ELEVATION (WITH MARKUPS)

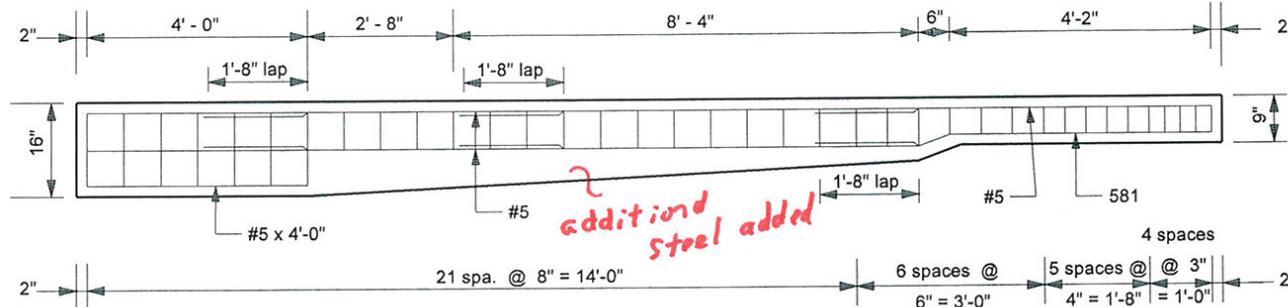

PLAN VIEW

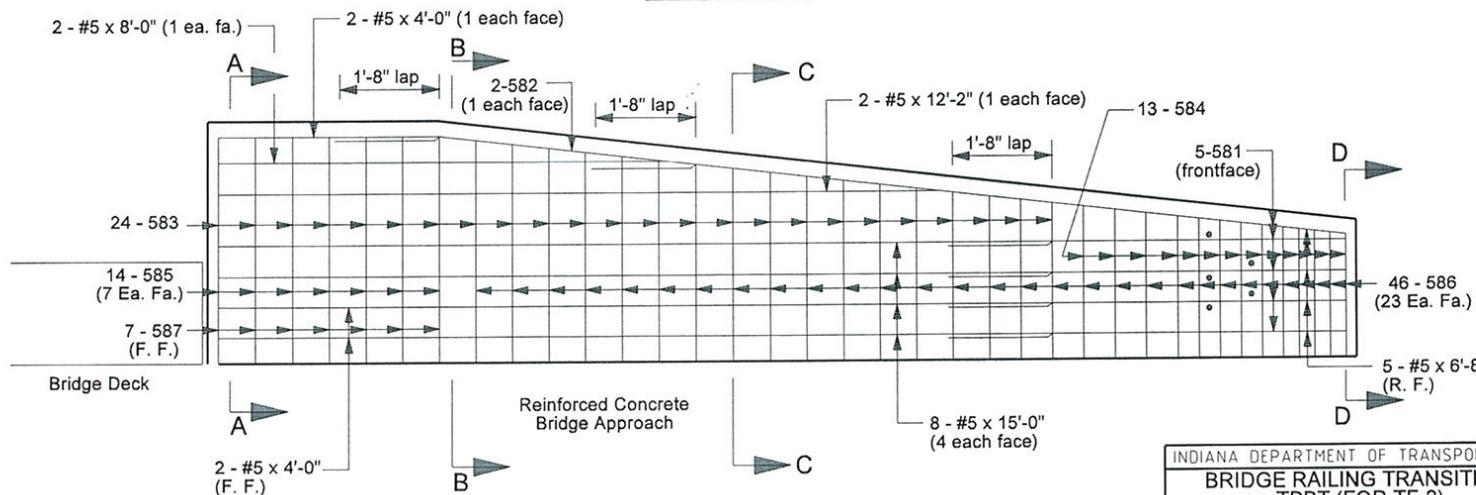

ELEVATION VIEW


Sheet combined with

TT TF-01

INDIANA DEPARTMENT OF TRANSPORTATION	
BRIDGE RAILING TRANSITION	
TPBT (FOR TF-2)	
REINFORCEMENT ELEVATION	
SEPTEMBER 2005	
STANDARD DRAWING NO. E 706-TPBT-04	
RICHARD L. VANCLEVE REGISTERED PROFESSIONAL ENGINEER NO. 9750 STATE OF INDIANA DATE	
/s/ Richard L. Vancleave 9-01-05 DESIGN STANDARDS ENGINEER	
/s/ Richard K. Smulzer 9-01-05 CHIEF HIGHWAY ENGINEER	
DESIGN STANDARDS ENGINEER	

REVISION TO STANDARD DRAWINGS


EXISTING 706-TPBT-05 BRIDGE RAILING TRANSITION TPBT SECTION A-A WITH REINFORCEMENT (PROPOSED TO DELETE)

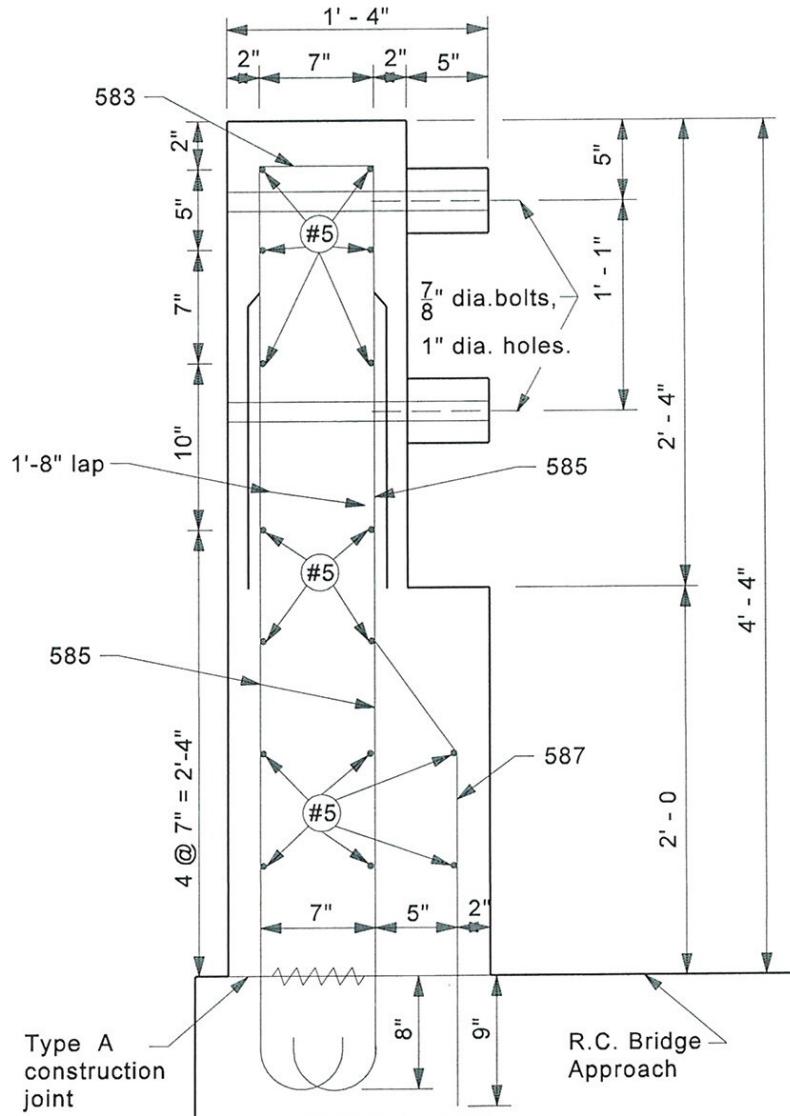

INDIANA DEPARTMENT OF TRANSPORTATION	
BRIDGE RAILING TRANSITION	
TPBT SECTION A-A WITH	
REINFORCEMENT	
SEPTEMBER 2005	
STANDARD DRAWING NO. E 706-TPBT-05	
	/s/ Richard L. Vancleave 9-01-05 DESIGN STANDARDS ENGINEER
	/s/ Richard K. Smulzer 9-01-05 CHIEF HIGHWAY ENGINEER

REVISION TO STANDARD DRAWINGS


EXISTING 706-TPBT-06 BRIDGE RAILING TRANSITION TPBT SECTION B-B (WITH MARKUPS)

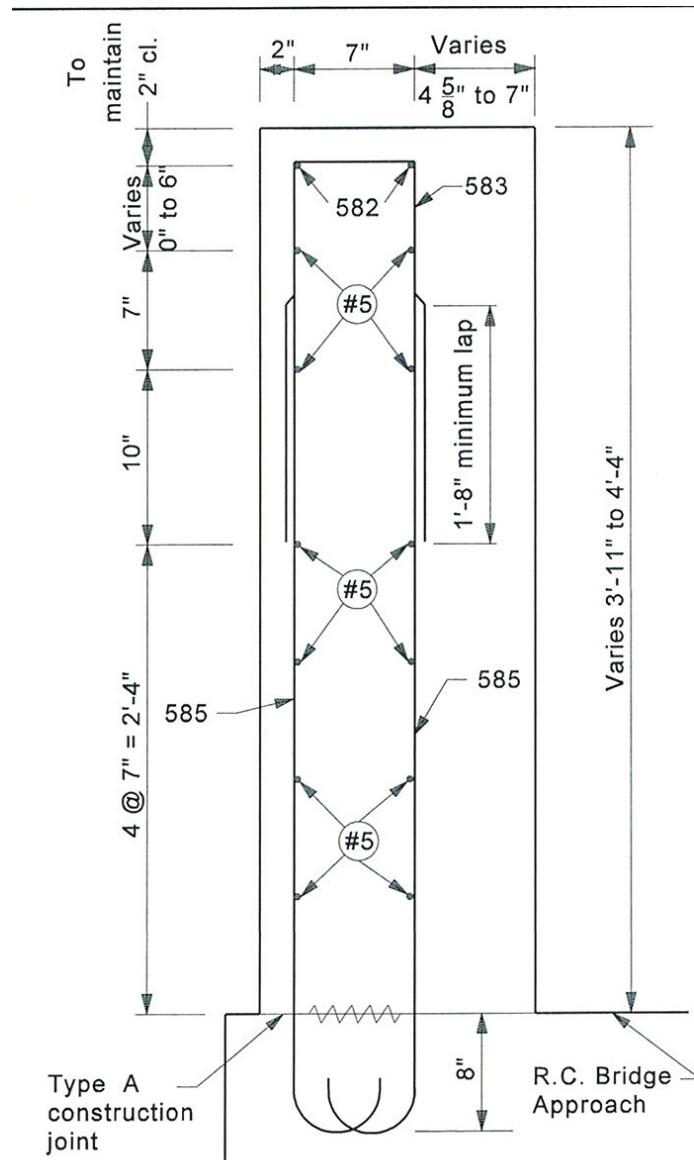

NOTES:


1. See Standard Drawing E 706-TPBT-04 for Section B-B location.
2. See Standard Drawing E 706-TPBT-09 and E 703-BRST-01 for reinforcing steel details.

*Sections combined.  
706-TPBT-02 & 03*

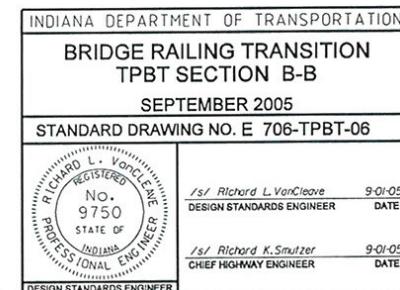

REVISION TO STANDARD DRAWINGS


EXISTING 706-TPBT-07 BRIDGE RAILING TRANSITION TPBT SECTION C-C (WITH MARKUPS)

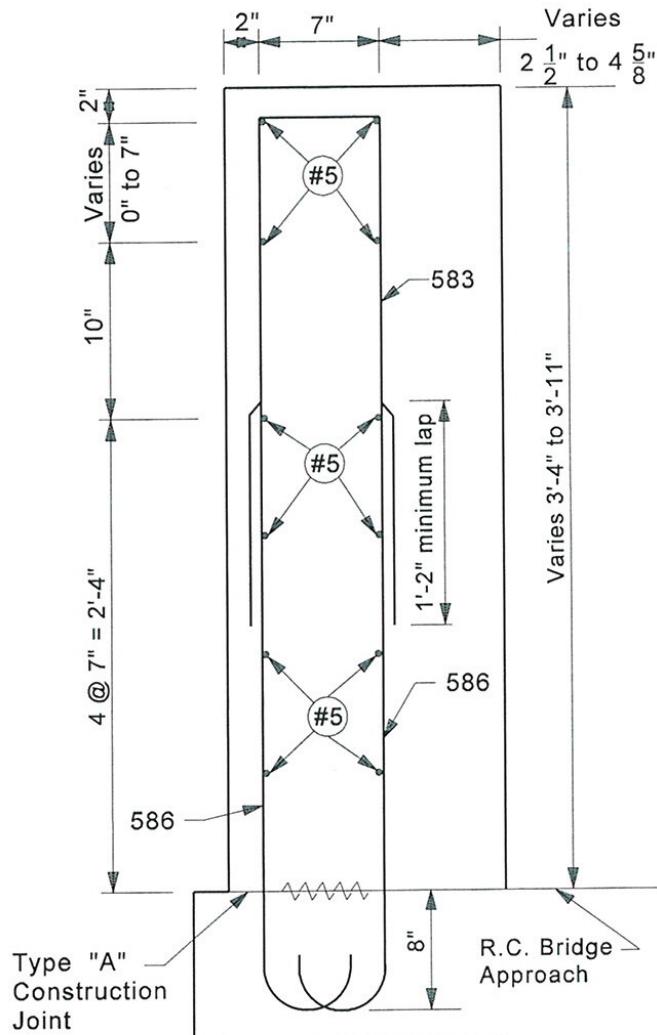

NOTES:


1. See Standard Drawing E 706-TPBT-04 for Section C-C location.
2. See Standard Drawing E 706-TPBT-09 and E 703-BRST-01 for reinforcing steel details.

*sections combined  
 706- TTF-02 & 03*

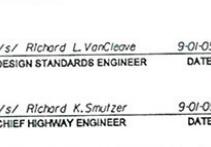INDIANA DEPARTMENT OF TRANSPORTATION	
BRIDGE RAILING TRANSITION	
TPBT SECTION C-C	
SEPTEMBER 2005	
STANDARD DRAWING NO. E 706-TPBT-07	
	
<i>/s/ Richard L. VanCleave 9-01-05</i> DESIGN STANDARDS ENGINEER DATE	
	
<i>/s/ Richard K. Smulzer 9-01-05</i> CHIEF HIGHWAY ENGINEER DATE	



REVISION TO STANDARD DRAWINGS

EXISTING 706-TPBT-08 BRIDGE RAILING TRANSITION TPBT SECTION D-D (WITH MARKUPS)

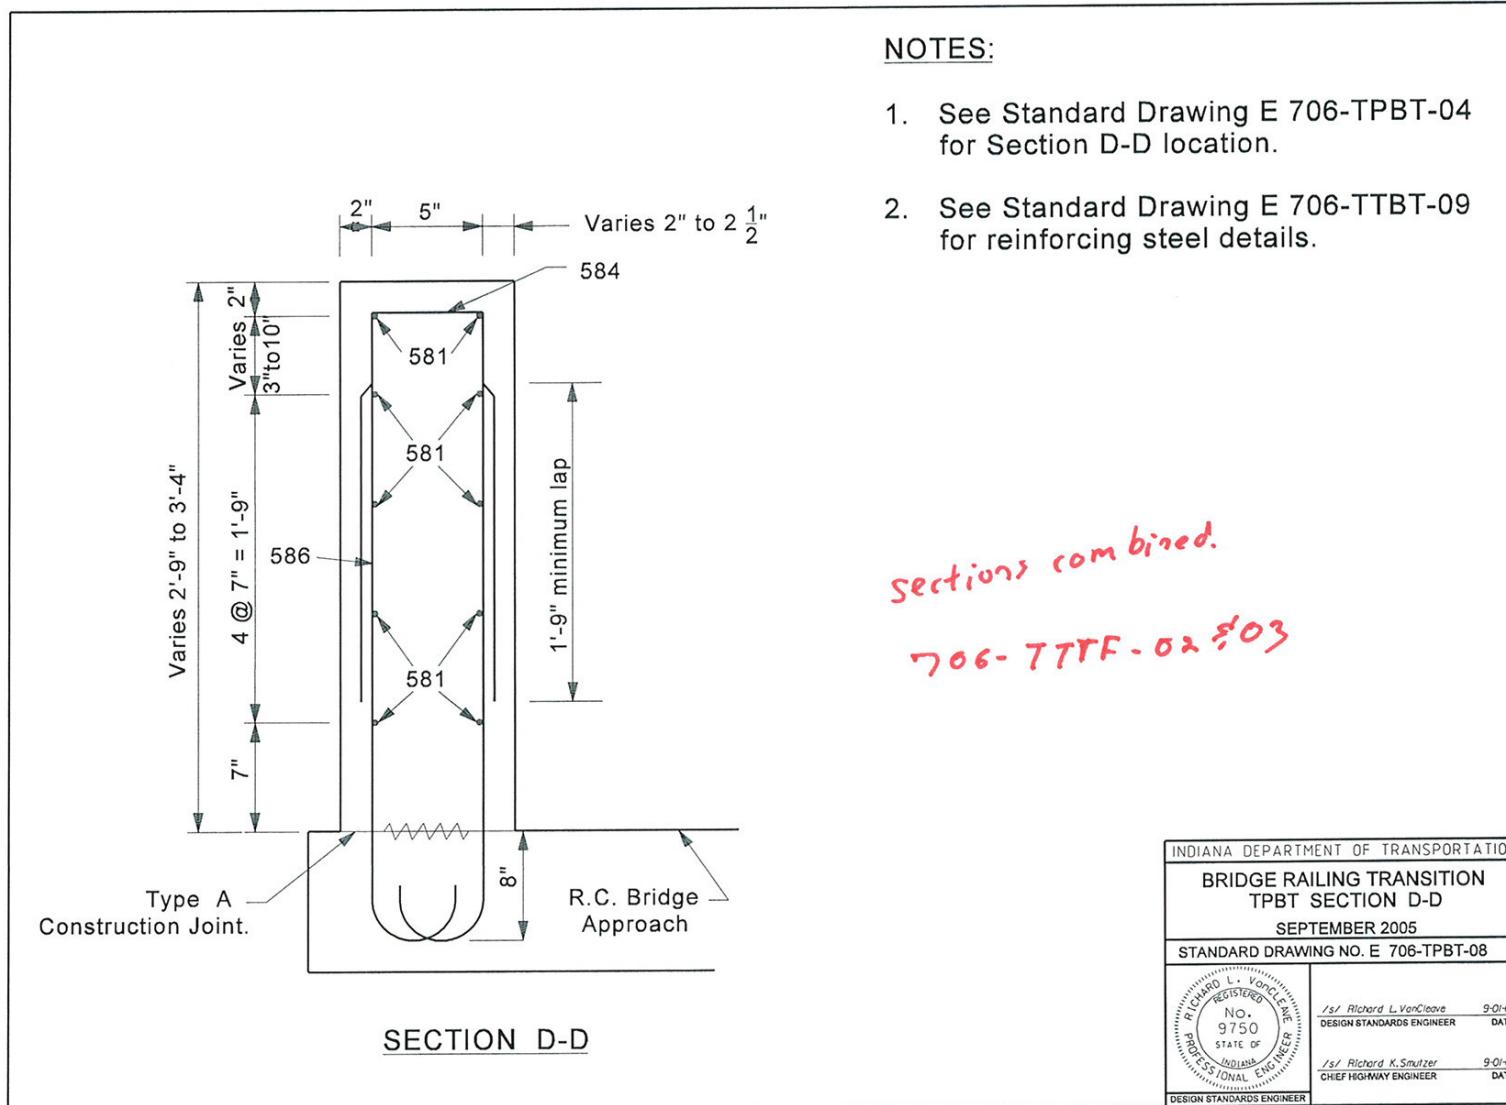


REVISION TO STANDARD DRAWINGS

EXISTING 706-TPBT-09 CONCRETE BRIDGE RAILING TRANSITION TYPE TPBT (WITH MARKUPS)

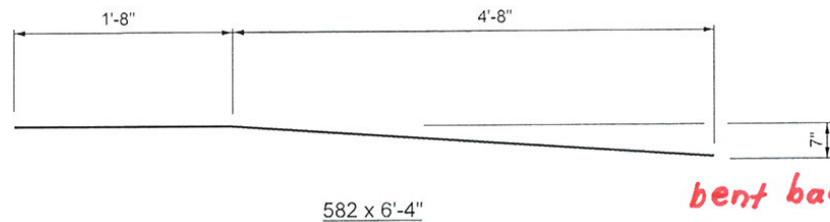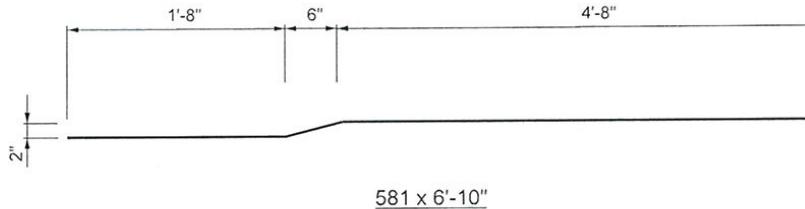

orientation revised.

bent bar  
designations  
revised

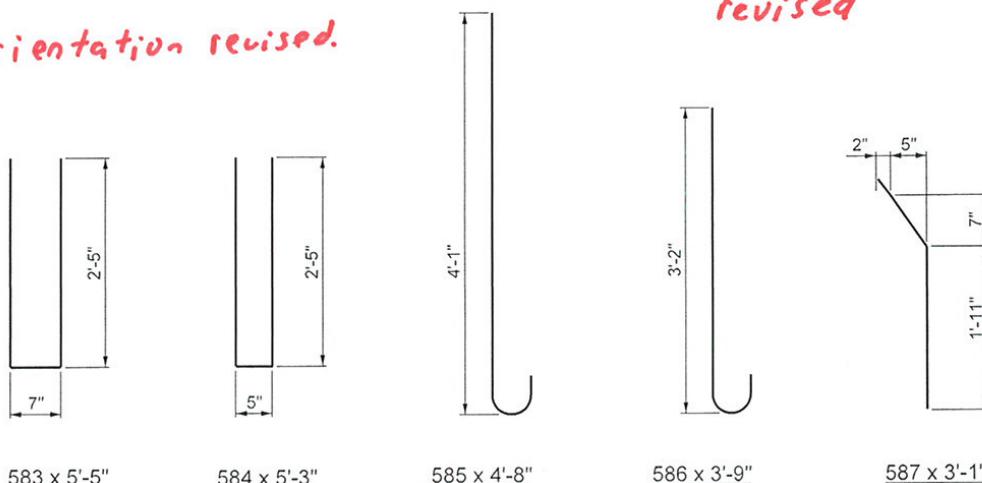


BILL OF MATERIALS			
These quantities are for one concrete bridge railing transition type TPBT.			
EPOXY COATED REINFORCING STEEL			
Size and Mark	No. of Bars	Length (ft.-in.)	Weight (lb.)
581	5	6'-10"	
582	2	6'-4"	
583	24	5'-5"	
584	13	5'-3"	
585	14	4'-8"	
586	46	3'-9"	
587	7	3'-1"	
#5	8	15'-0"	
#5	2	12'-2"	
#5	2	8'-2"	
#5	4	4'-0"	
#5	5	6'-8"	
Total #5 Bars		760	
Total Epoxy Coated Steel		760	
Concrete Class C in Railing		4.3 yd <sup>3</sup>	
Surface Seal		17.2 yd <sup>2</sup>	

Bill revised

INDIANA DEPARTMENT OF TRANSPORTATION	
CONCRETE BRIDGE RAILING	
TRANSITION TYPE TPBT	
SEPTEMBER 2005 <b>TTF-2</b>	
STANDARD DRAWING NO. E 706-TPBT-09	
RICHARD L. VON CLEVE REGISTERED NO. 9750 PROFESSIONAL ENGINEER STATE OF INDIANA DESIGN STANDARDS ENGINEER	/s/ Richard L. VonCleve 9-01-05 DESIGN STANDARDS ENGINEER DATE



REVISION TO STANDARD DRAWINGS

706-TTTF-01 CONCRETE BRIDGE RAILING TRANSITION, TTF-2 (DRAFT)

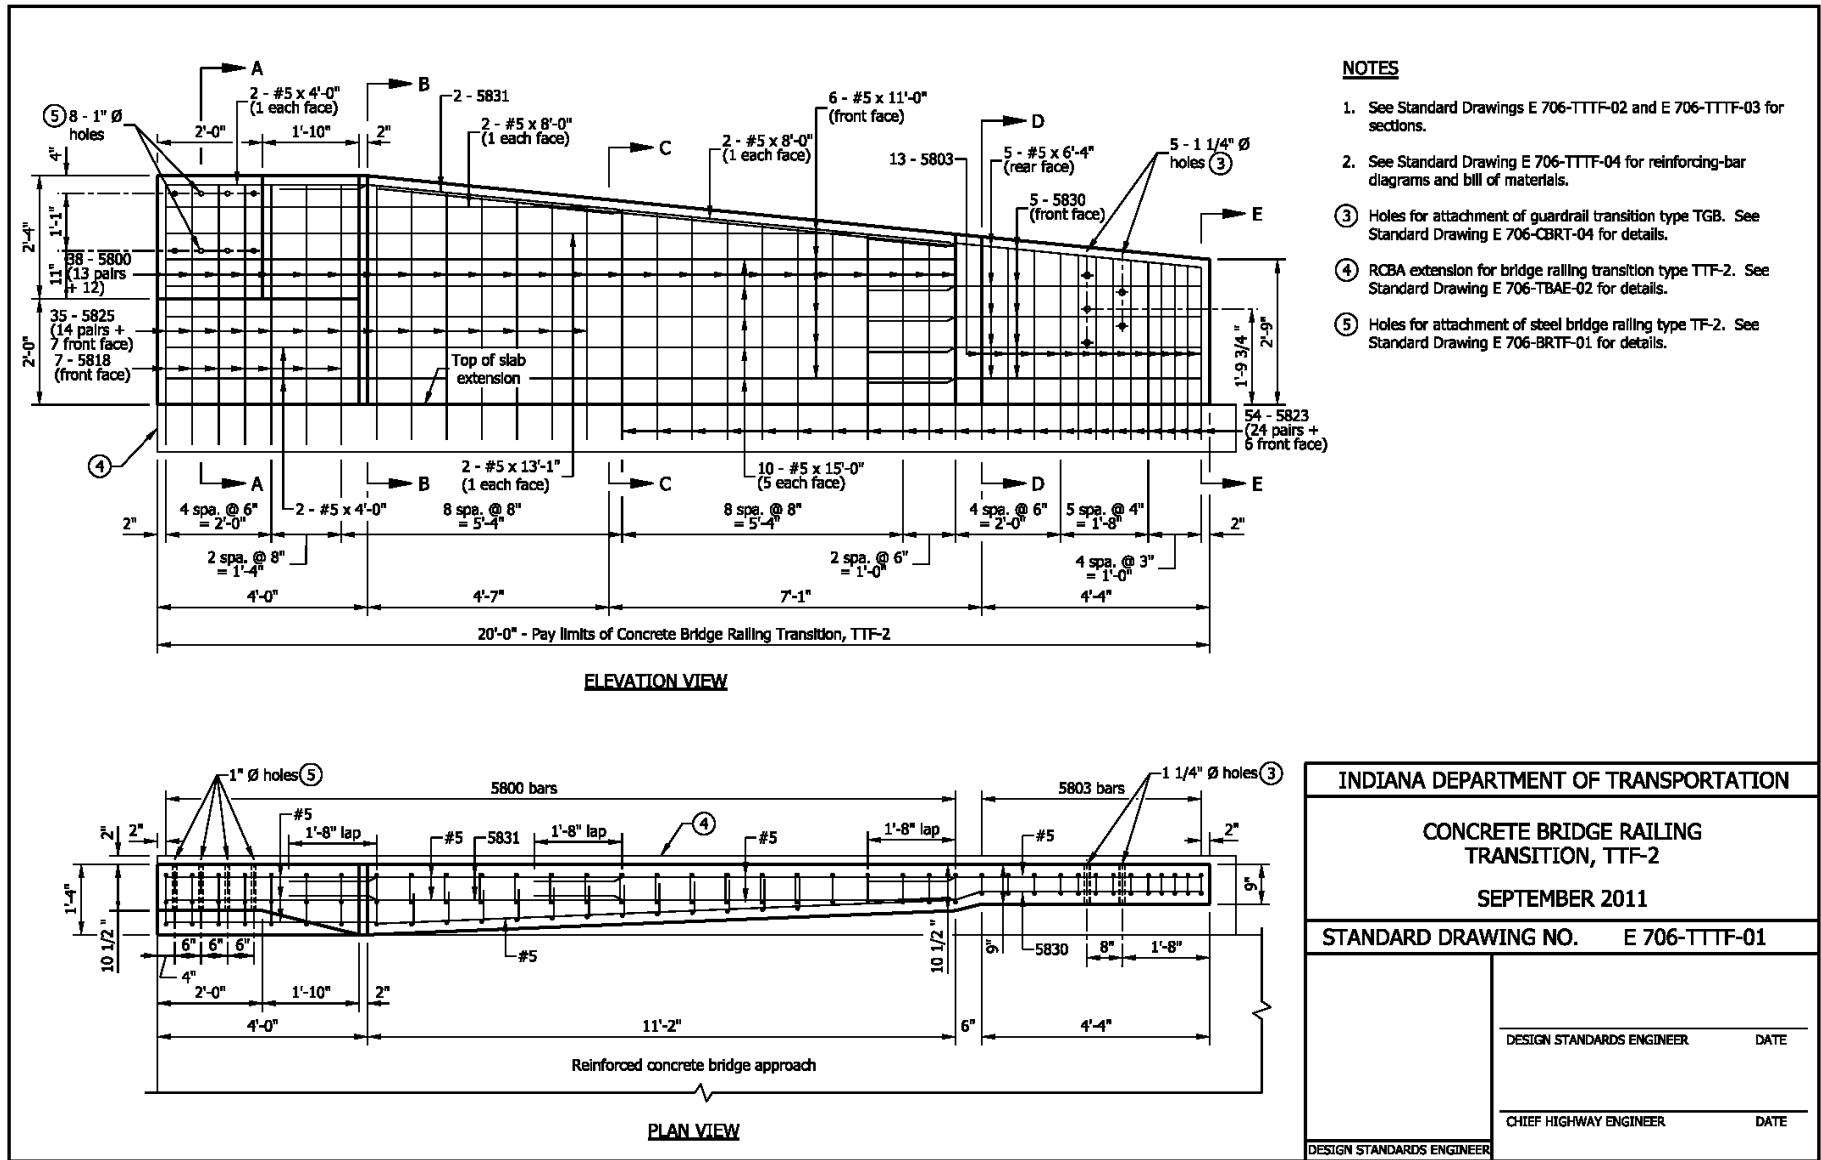

REVISION TO STANDARD DRAWINGS

706-TTTF-02 CONCRETE BRIDGE RAILING TRANSITION, TTF-2 (DRAFT)

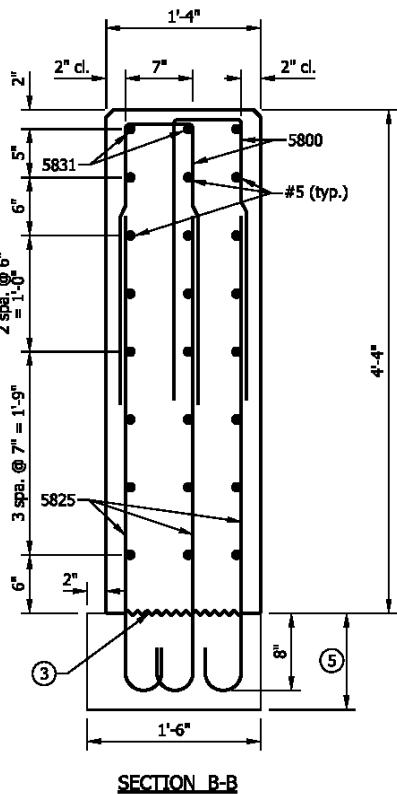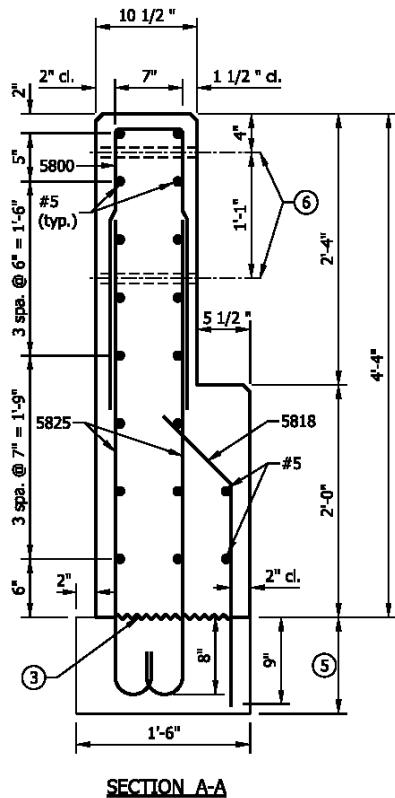


**NOTES**

1. See Standard Drawing E 706-TTTF-01 for elevation and plan.
2. All chamfered edges shall be 3/4".
3. Construction joint type A. See Standard Drawing E 702-CJTA-01 for details.
4. See Standard Drawing E 706-TTTF-04 for reinforcing-bar diagrams.
5. RCBA extension for bridge railing transition type TTF-2. See Standard Drawing E 706-TBAE-02 for details.
6. 1" Ø hole for attachment of steel bridge railing type TF-2. See Standard Drawing E 706-BRTF-01 for details.


INDIANA DEPARTMENT OF TRANSPORTATION	
CONCRETE BRIDGE RAILING TRANSITION, TTF-2	
SEPTEMBER 2005	
STANDARD DRAWING NO.	E 706-TTTF-02
DESIGN STANDARDS ENGINEER	DATE
CHIEF HIGHWAY ENGINEER	DATE
DESIGN STANDARDS ENGINEER	

REVISION TO STANDARD DRAWINGS


706-TTTF-03 CONCRETE BRIDGE RAILING TRANSITION, TTF-2 (DRAFT)

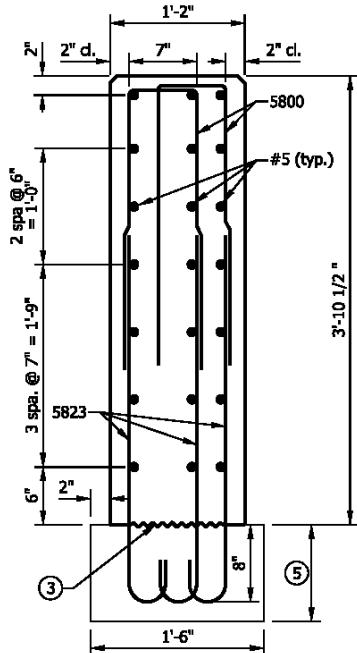

SECTION C-C

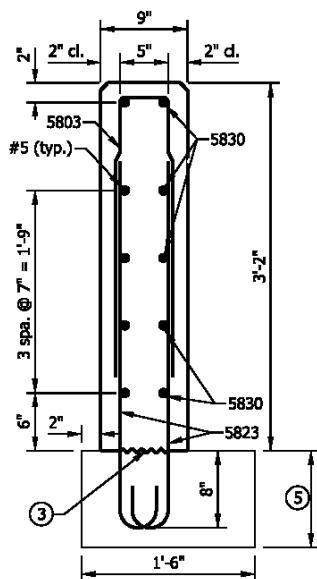

SECTION D-D

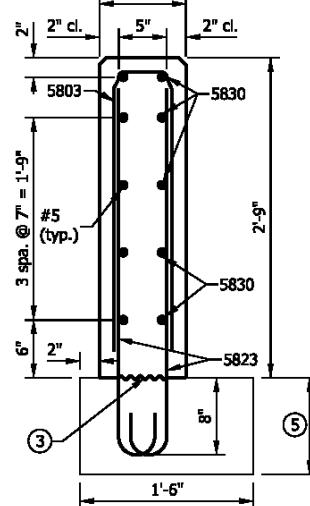

SECTION E-E


NOTES

1. See Standard Drawing E 706-TTTF-01 for elevation and plan.
2. All chamfered edges shall be 3/4".
3. Construction joint type A. See Standard Drawing E 702-CJTA-01 for details.
4. See Standard Drawing E 706-TTTF-04 for reinforcing-bar diagrams.
5. RCBA extension for bridge railing transition type TTF-2. See Standard Drawing E 706-TASE-02 for details.

INDIANA DEPARTMENT OF TRANSPORTATION	
CONCRETE BRIDGE RAILING TRANSITION, TTF-2	
SEPTEMBER 2005	
STANDARD DRAWING NO.	E 706-TTTF-03
DESIGN STANDARDS ENGINEER	DATE
CHIEF HIGHWAY ENGINEER	DATE
DESIGN STANDARDS ENGINEER	

REVISION TO STANDARD DRAWINGS

706-TTTF-04 CONCRETE BRIDGE RAILING TRANSITION, TTF-2 (DRAFT)

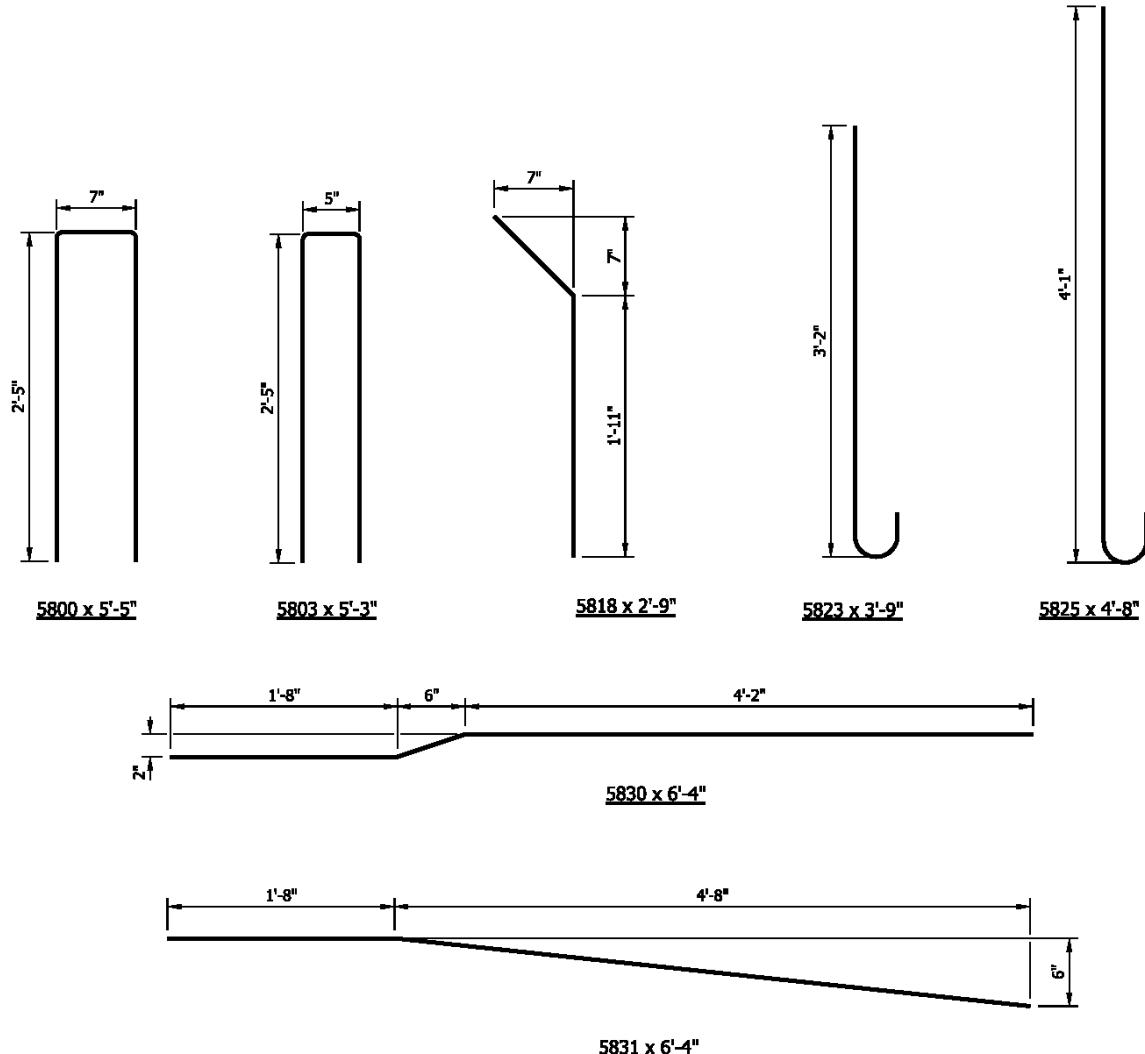

NOTE


1. See Standard Drawing E 703-BRST-01 for reinforcing-bar bending details and notes.

BILL OF MATERIALS		
Quantities are for one concrete bridge railing transition type TTF-2		
EPOXY-COATED REINFORCING STEEL		
Mark / Size	No. of Bars	Weight
5800	38	
5803	13	
5818	7	
5823	54	
5825	35	
5830	5	
5831	2	
#5 x 15'-0"	10	
#5 x 13'-1"	2	
#5 x 11'-0"	6	
#5 x 8'-0"	4	
#5 x 6'-4"	5	
#5 x 4'-0"	4	
Total Epoxy-Coated Reinforcing Steel		1072 LBS
MISCELLANEOUS		
Concrete, Class C	2.9 CYS	
Surface Seal	182 SFT	

INDIANA DEPARTMENT OF TRANSPORTATION	
CONCRETE BRIDGE RAILING TRANSITION, TTF-2	
SEPTEMBER 2005	
STANDARD DRAWING NO.	E 706-TTTF-04
DESIGN STANDARDS ENGINEER	DATE
CHIEF HIGHWAY ENGINEER	DATE
DESIGN STANDARDS ENGINEER	





REVISION TO STANDARD DRAWINGS

EXISTING 706-TTBC-01 CONCRETE BRIDGE RAILING TRANSITION TBC PLAN AND ELEVATION (WITH MARKUPS)

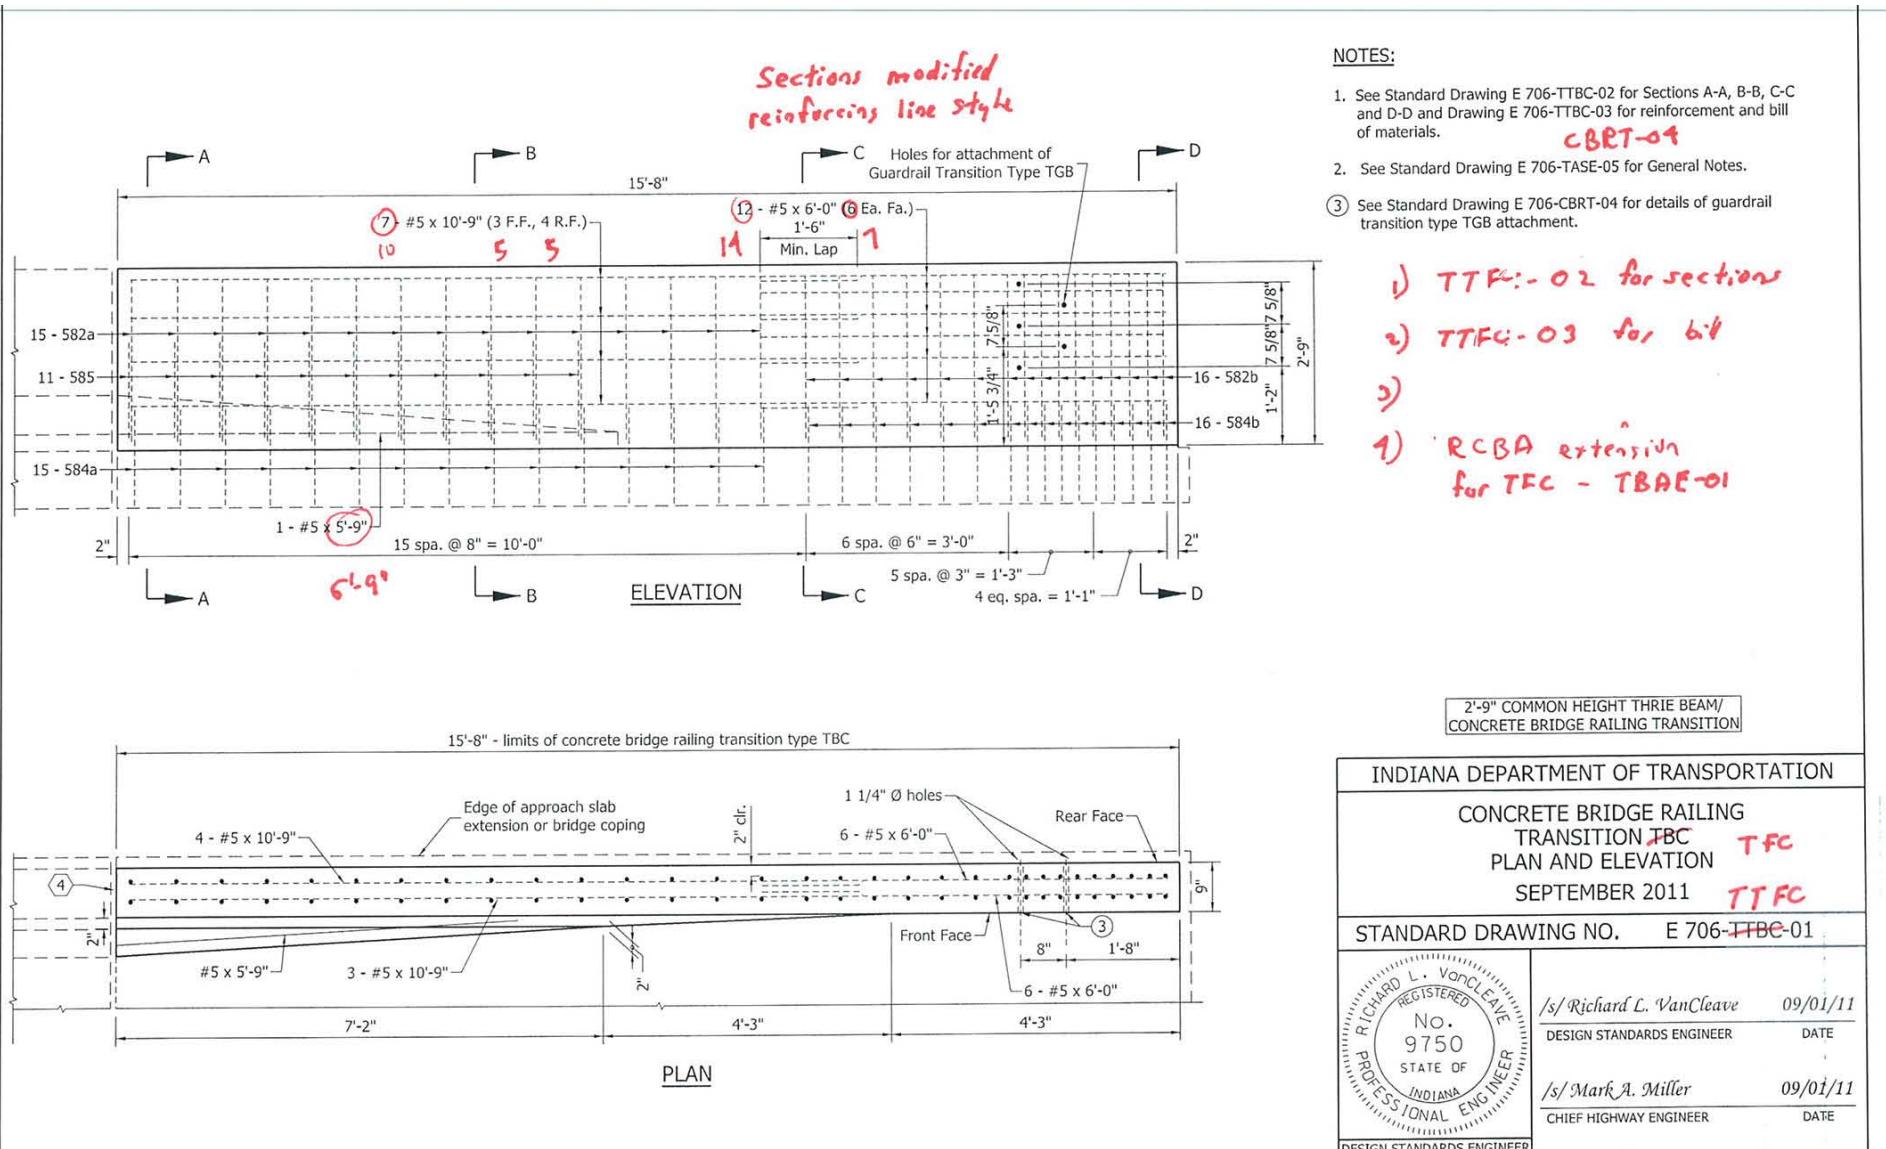

REVISION TO STANDARD DRAWINGS

EXISTING 706-TTBC-02 CONCRETE BRIDGE RAILING TRANSITION TYPE TBC SECTIONS (WITH MARKUPS)

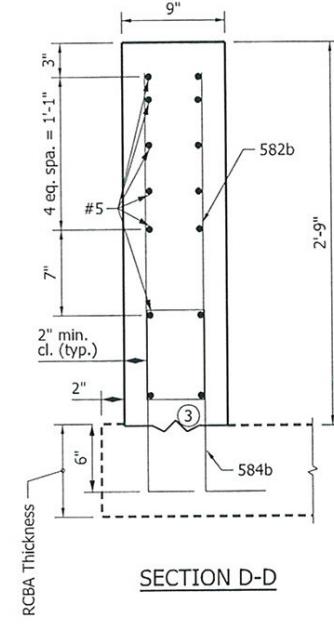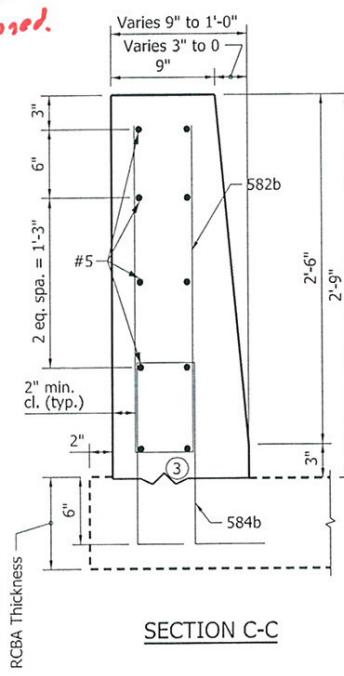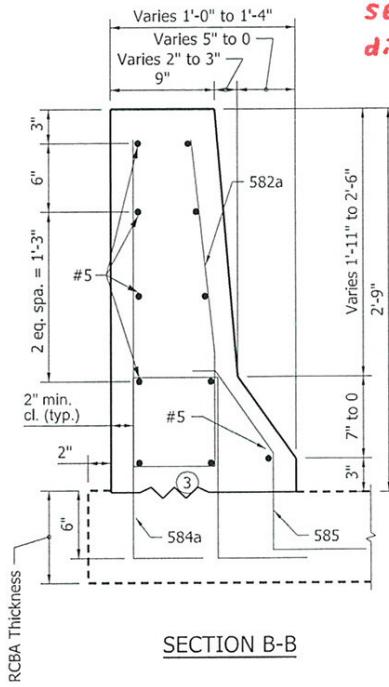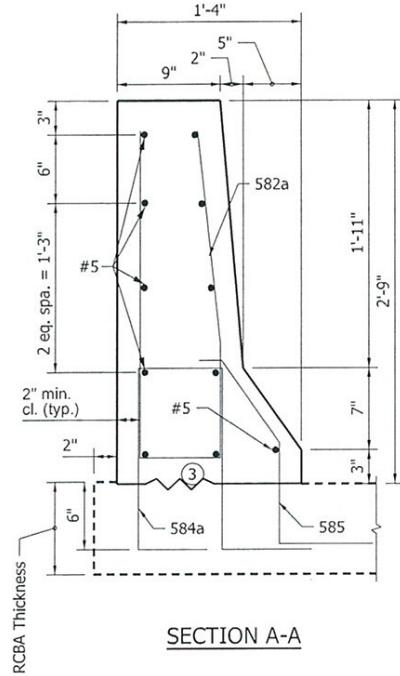


NOTES:

1. See Standard Drawing E 706-TTBC-01 for Plan and Elevation.
2. See Standard Drawing E 703-BRST-01 for bar bending details and reinforcing bar notes.
- 3) Type A construction joint. See Standard Drawing E 702-CJTA-01 for details.
4. See Standard Drawing E 706-TTBC-03 for reinforcement details.

5 slab ext added.


2'-9" COMMON HEIGHT THRIE BEAM  
CONCRETE BRIDGE RAILING TRANSITION

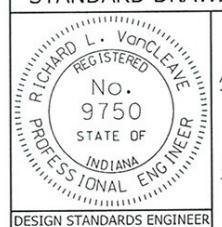INDIANA DEPARTMENT OF TRANSPORTATION	
CONCRETE BRIDGE RAILING TRANSITION TYPE TBC SECTIONS	
SEPTEMBER 2011	
STANDARD DRAWING NO. E 706-TTBC-02	
	
/s/ Richard L. VanCleave DESIGN STANDARDS ENGINEER	09/01/11 DATE
/s/ Mark A. Miller CHIEF HIGHWAY ENGINEER	09/01/11 DATE

Item No.02 03/15/12 (2012 SS)(contd.)  
 Mr. Strain  
 Date: 03/15/12


REVISION TO STANDARD DRAWINGS

EXISTING 706-TTBC-03 CONCRETE BRIDGE RAILING TRANSITION TYPE TBC (WITH MARKUPS)

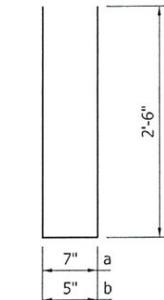


582a x 5'-7

582b x 5'-5

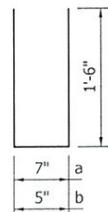

584a x 3'-7

584b x 3'-5

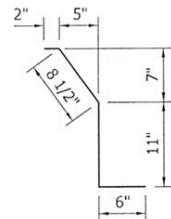

585 x 2'-4

584 revised to be equivalent  
to bridge rail stee

585 embedment increased

NOTE:

1. See Standard Drawing E 706-TASE-05 for General Notes.

BILL OF MATERIALS			
These quantities are for one concrete bridge railing transition type TBC.			
EPOXY COATED REINFORCING STEEL			
Size and Mark	No. of Bars	Length (Ft.-in.)	Weight (Lbs.)
582a	15	5'-7"	
582b	16	5'-5"	
584a	15	3'-7"	
584b	16	3'-5"	
585	11	2'-4"	
#5	13	6'-0"	
#5	7	10'-9"	
Total #5 Bars			477
Total Epoxy Coated Steel			477
Concrete Class C in Railing			1.2 yd <sup>3</sup>
Surface Seal			100 ft <sup>2</sup>


B:1  
revised.

INDIANA DEPARTMENT OF TRANSPORTATION

CONCRETE BRIDGE RAILING  
TRANSITION TYPE TBC

SEPTEMBER 2011

STANDARD DRAWING NO. E 706-TTBC-03

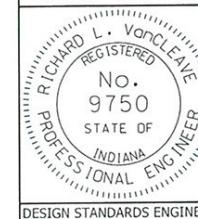

/s/ Richard L. VanCleave 09/01/11

DESIGN STANDARDS ENGINEER DATE


/s/ Mark A. Miller 09/01/11

CHIEF HIGHWAY ENGINEER DATE

DESIGN STANDARDS ENGINEER


REVISION TO STANDARD DRAWINGS

706-TTFC-01 CONCRETE BRIDGE RAILING TRANSITION TFC PLAN AND ELEVATION (DRAFT)

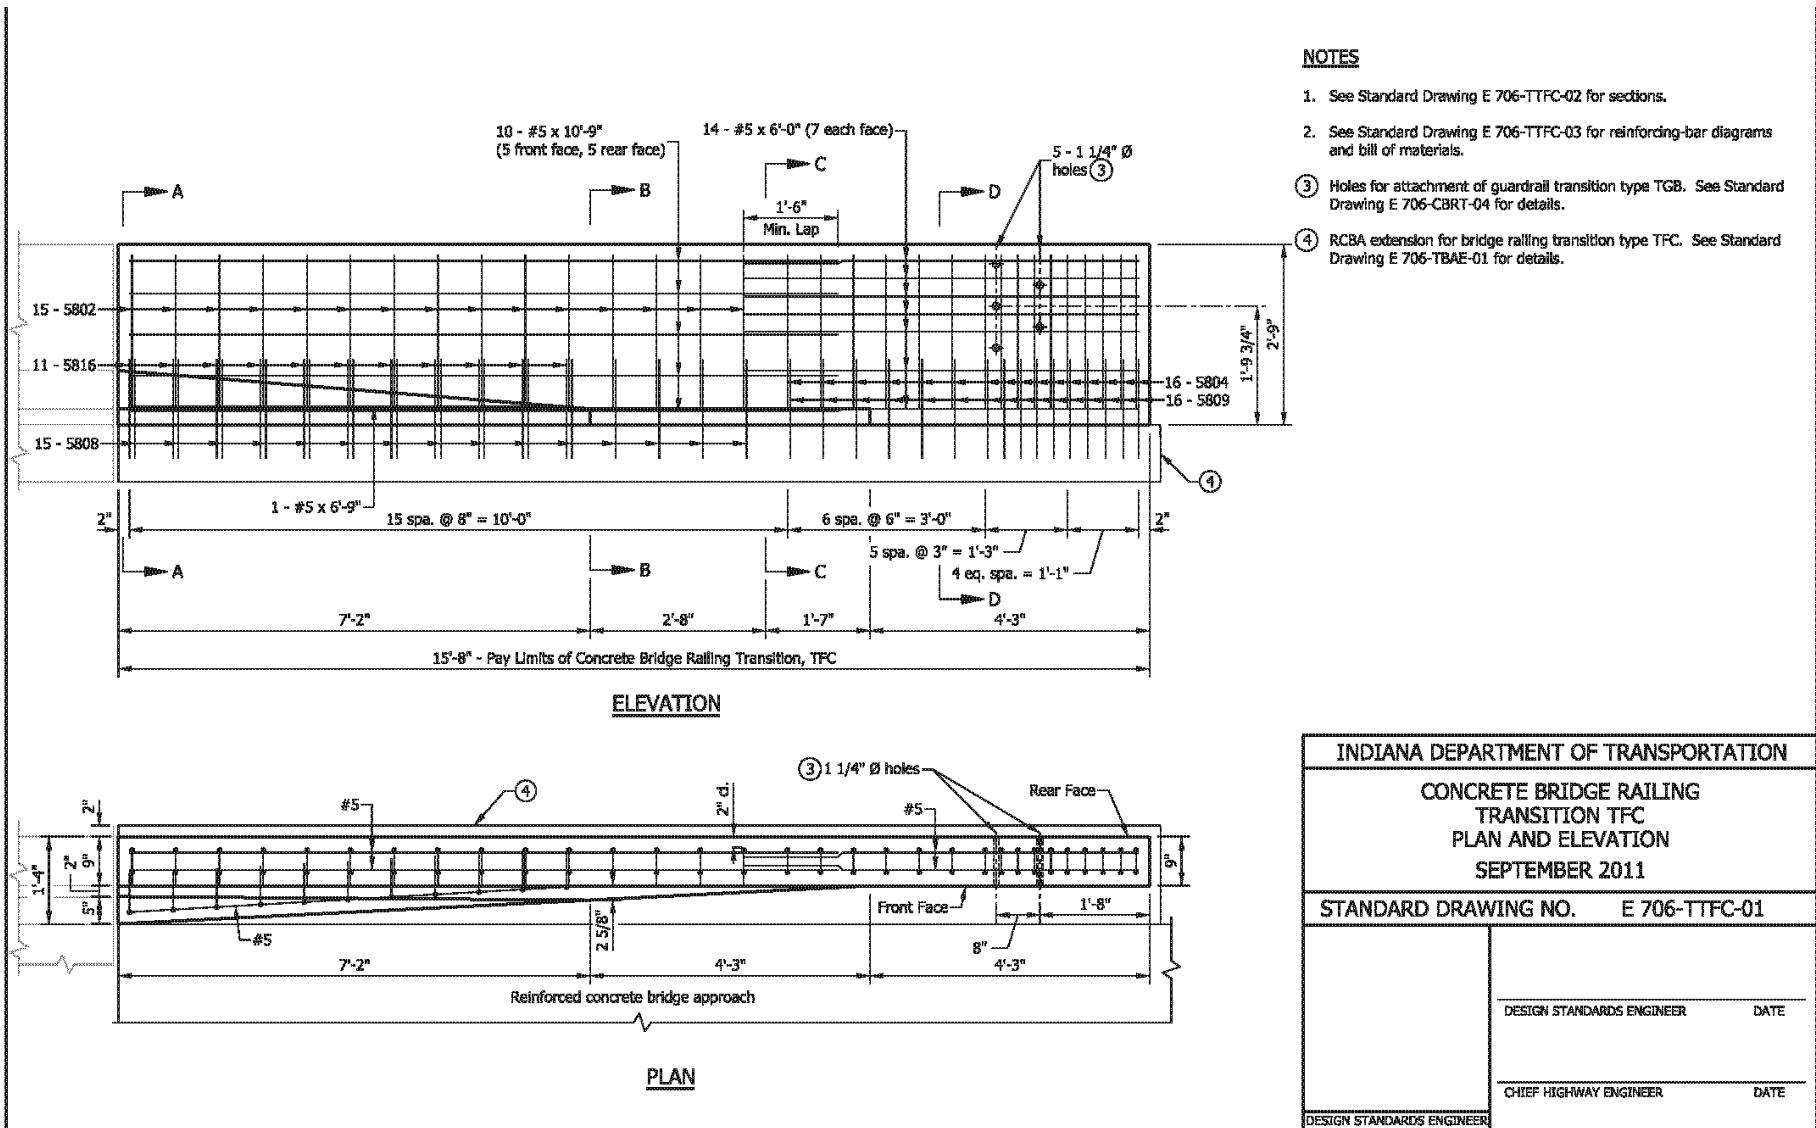


REVISION TO STANDARD DRAWINGS


706-TTFC-02 CONCRETE BRIDGE RAILING TRANSITION, TFC SECTIONS (DRAFT)

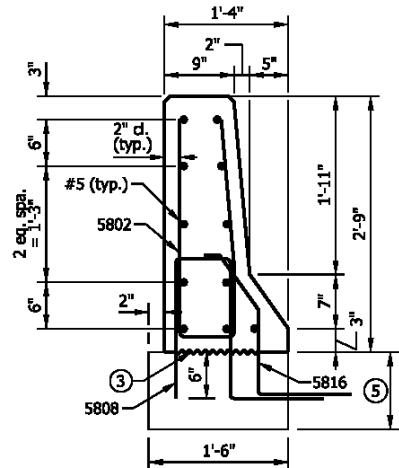


SECTION A-A

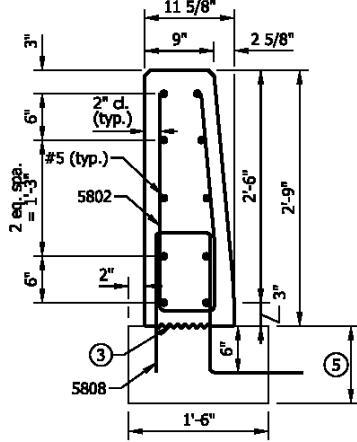

SECTION B-B

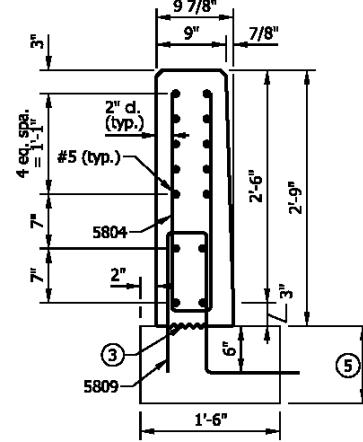

SECTION C-C

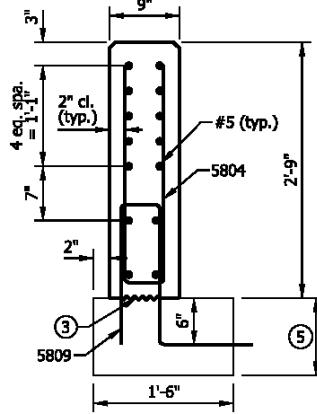

SECTION D-D

NOTES






1. See Standard Drawing E 706-TTFC-01 for elevation and plan.
2. All chamfered edges shall be 3/4".
3. Construction joint type A. See Standard Drawing E 702-CJTA-01 for details.
4. See Standard Drawing E 706-TTFC-03 for reinforcing-bar diagrams.
5. RCBA extension for bridge railing type TFC. See Standard Drawing E 706-TBAE-01 for details.

INDIANA DEPARTMENT OF TRANSPORTATION	
CONCRETE BRIDGE RAILING TRANSITION, TFC SECTIONS	
SEPTEMBER 2011	
STANDARD DRAWING NO. E 706-TTFC-02	
DESIGN STANDARDS ENGINEER	DATE
CHIEF HIGHWAY ENGINEER	DATE
DESIGN STANDARDS ENGINEER	

Item No.02 03/15/12 (2012 SS)(contd.)  
 Mr. Strain  
 Date: 03/15/12

REVISION TO STANDARD DRAWINGS

706-TTFC-03 CONCRETE BRIDGE RAILING TRANSITION, TFC (DRAFT)

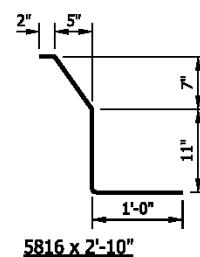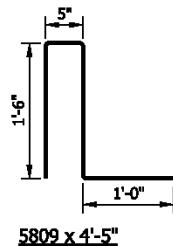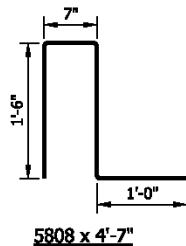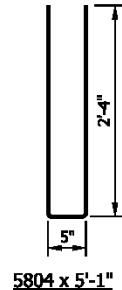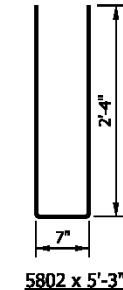

NOTE

1. See Standard Drawing E 703-BRST-01 for reinforcing-bar bending details and notes.


BILL OF MATERIALS		
Quantities are for one concrete bridge railing transition type TFC		
EPOXY-COATED REINFORCING STEEL		
Mark / Size	No. of Bars	Weight
5802	15	
5804	16	
5808	15	
5809	16	
5816	11	
#5 x 10'-9"	10	
#5 x 6'-9"	1	
#5 x 6'-0"	14	
Total Epoxy-Coated Reinforcing Steel		552 LBS
MISCELLANEOUS		
Concrete, Class C	1.2 CYS	
Surface Seal	100 SFT	

INDIANA DEPARTMENT OF TRANSPORTATION		
CONCRETE BRIDGE RAILING TRANSITION, TFC		
SEPTEMBER 2011		
STANDARD DRAWING NO. E 706-TTFC-03		
DESIGN STANDARDS ENGINEER		DATE
CHIEF HIGHWAY ENGINEER		DATE
DESIGN STANDARDS ENGINEER		

REVISION TO STANDARD DRAWINGS

EXISTING 706-TTBP-01 CONCRETE BRIDGE RAILING TRANSITION, TPF-1 (WITH MARKUPS)

*Sections re-ordered and taken at locations in  
change of geometry*

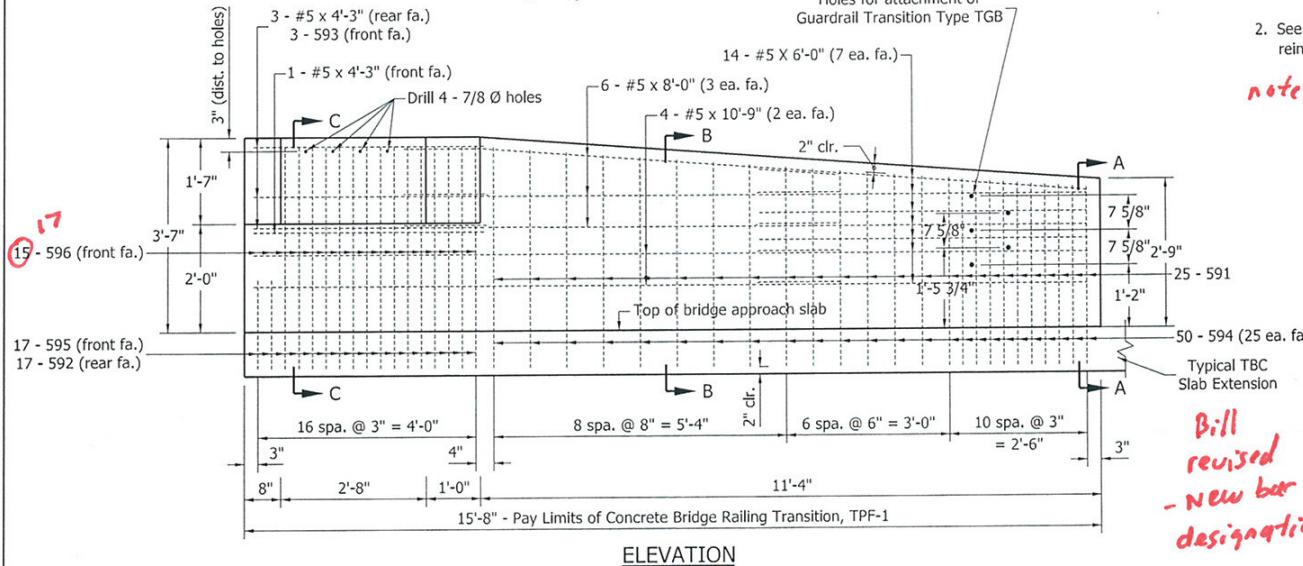



NOTES:

1. See Standard Drawing E 706-TTBP-09 for general notes.  
 2. See Standard Drawing E 706-TTBP-02 for sections and reinforcing-bar diagrams.

*TT PP  
TT PP  
3) E C B A T B A E - 01  
4) Holes - DR PP-01  
notes added.*


BILL OF MATERIALS, TPF-1 EPOXY-COATED REINFORCING STEEL			
Mark / Size	No. of Bars	Total Length	Weight
591 x 5'-4"	25	133'-4"	
592 x 4'-8"	17	79'-4"	
593 x 4'-3"	3	12'-9"	
594 x 3'-7"	50	179'-2"	
595 x 3'-1"	17	52'-5"	
596 x 3'-0"	15	43'-0"	
#5 x 10'-9"	4	43'-0"	
#5 x 8'-0"	6	48'-0"	
#5 x 6'-0"	14	84'-0"	
#5 x 4'-3"	4	17'-0"	
Total Epoxy-Coated Reinforcing Steel		694'-2"	724 lb
MISCELLANEOUS			
Concrete, Class C		1.5 cys	
Surface Seal		121 sft	

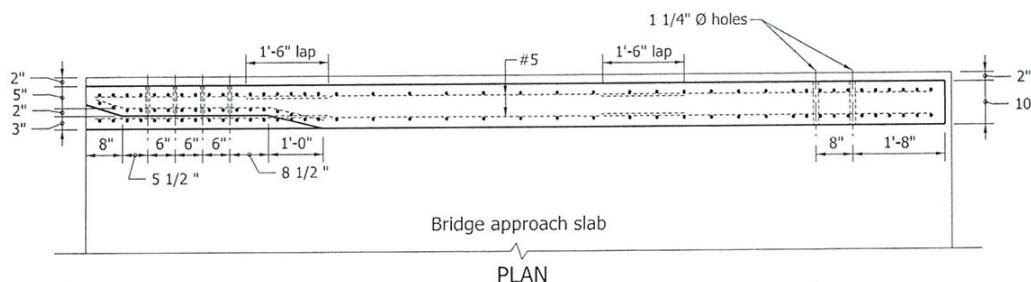

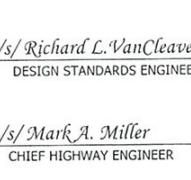INDIANA DEPARTMENT OF TRANSPORTATION	
CONCRETE BRIDGE RAILING TRANSITION, TPF-1	
SEPTEMBER 2011	
STANDARD DRAWING NO. E 706-TTBP-01	
	/s/ Richard L. VanCleave 09/01/11
	DESIGN STANDARDS ENGINEER
	/s/ Mark A. Miller 09/01/11
	CHIEF HIGHWAY ENGINEER
DATE	
DATE	
DESIGN STANDARDS ENGINEER	

## REVISION TO STANDARD DRAWINGS


**EXISTING 706-TTBP-02 CONCRETE BRIDGE RAILING TRANSITION, TPF-1 (WITH MARKUPS)**

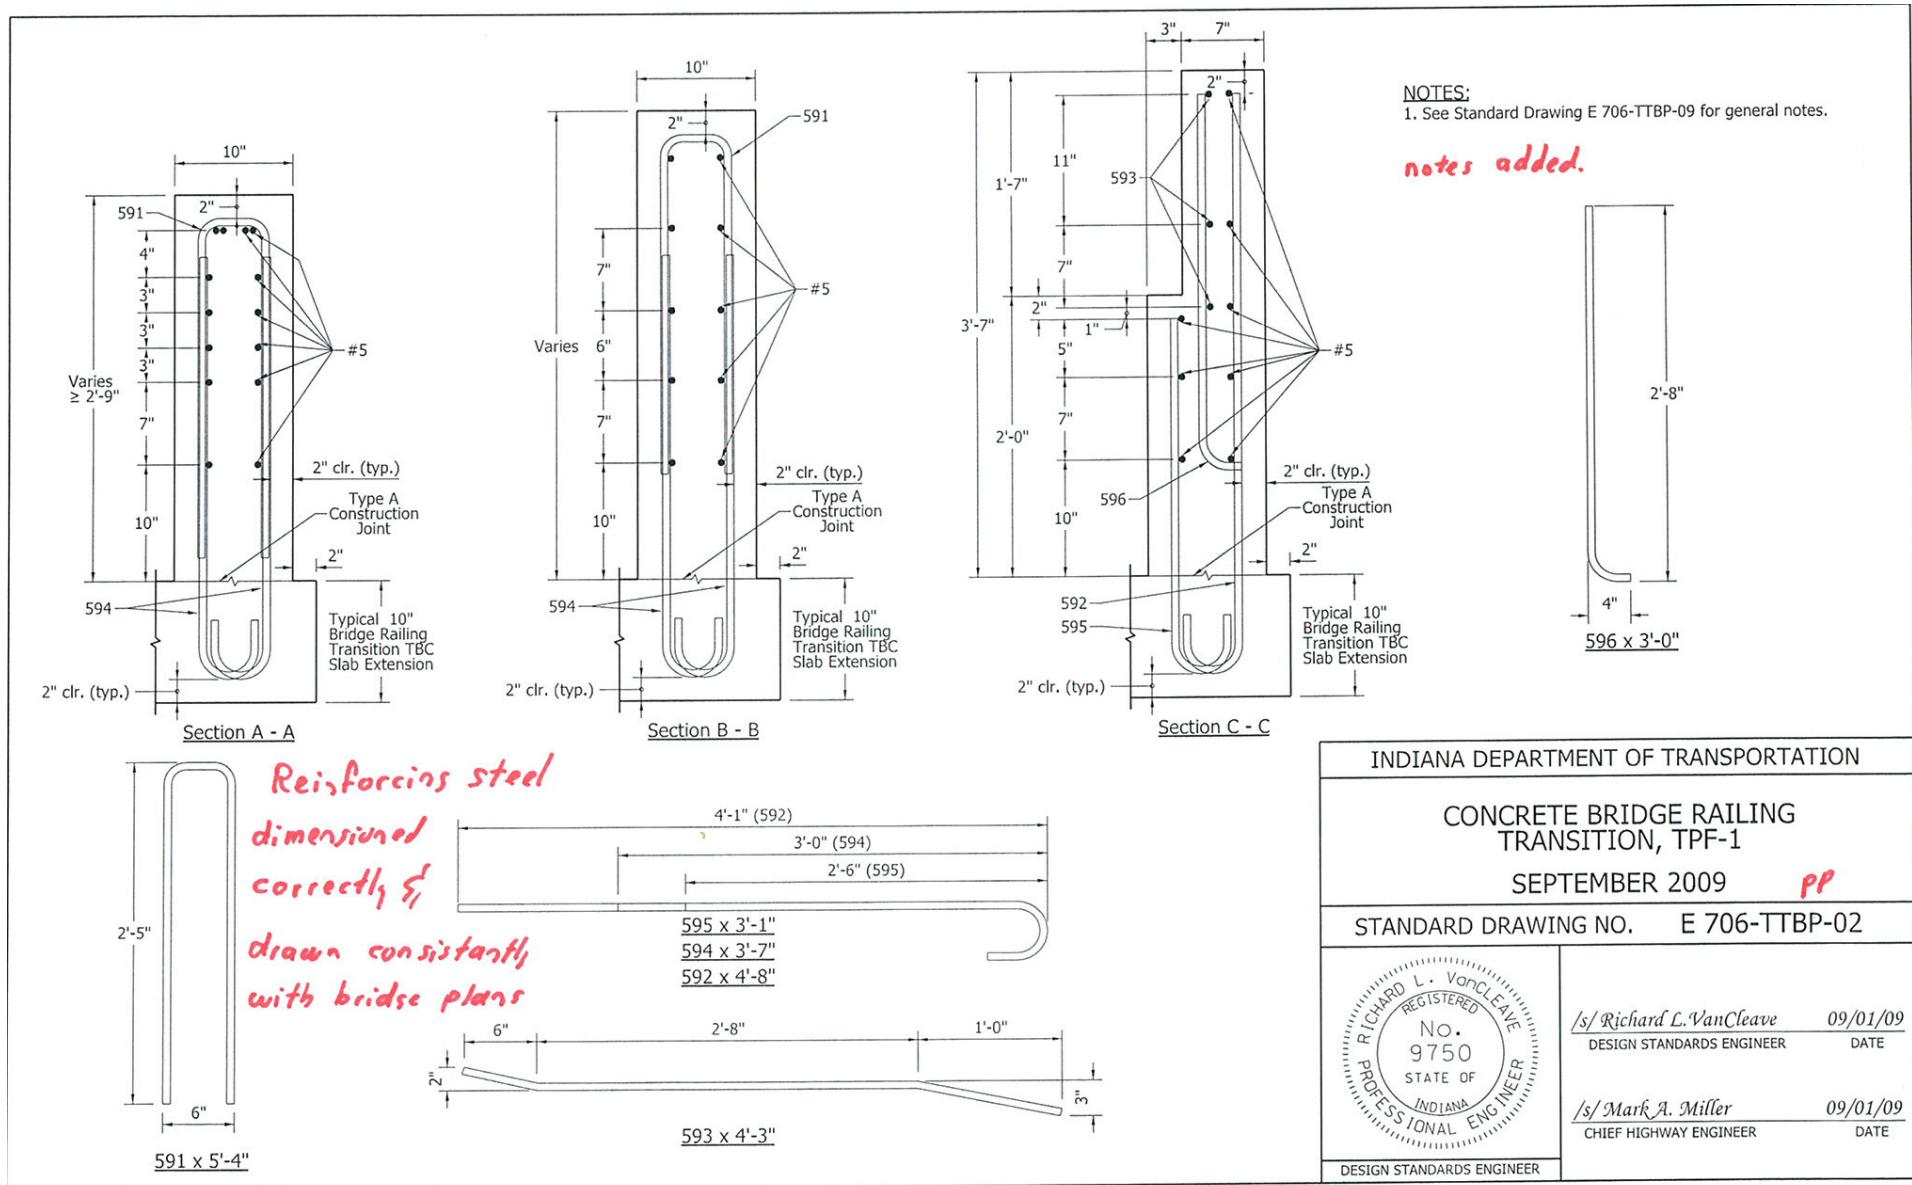

31

REVISION TO STANDARD DRAWINGS

EXISTING 706-TTBP-03 CONCRETE BRIDGE RAILING TRANSITION, TPF-2 (WITH MARKUPS)

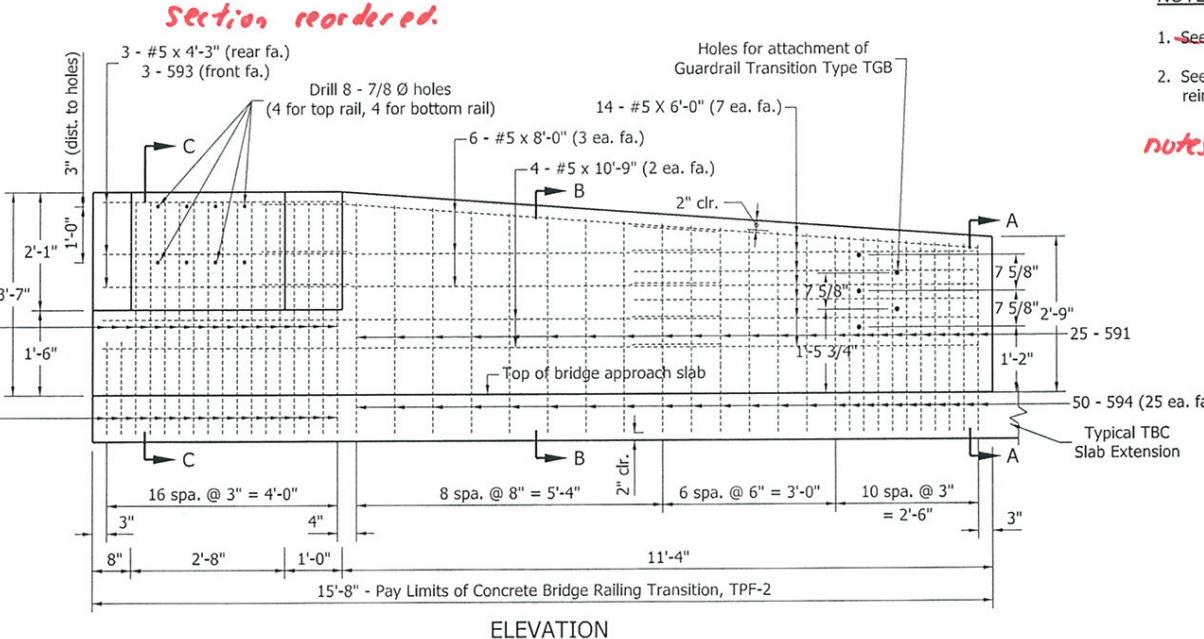


NOTES:

1. See Standard Drawing E 706-TTBP-09 for general notes. *PP*

2. See Standard Drawing E 706-TTBP-04 for sections and reinforcing-bar diagrams.

*notes added 3) ECBA - TBPE-02  
 1) holes- BRPP-02*


BILL OF MATERIALS, TPF-2 EPOXY-COATED REINFORCING STEEL			
Mark / Size	No. of Bars	Total Length	Weight
591 x 5'-4"	25	133'-4"	
592 x 4'-8"	17	79'-4"	
593 x 4'-3"	3	12'-9"	
594 x 3'-7"	50	179'-2"	
595 x 2'-7"	17	43'-11"	
596 x 3'-0"	15	43'-0"	
#5 x 10'-9"	4	43'-0"	
#5 x 8'-0"	6	48'-0"	
#5 x 6'-0"	14	84'-0"	
#5 x 4'-3"	3	12'-9"	
Total Epoxy-Coated Reinforcing Steel		679'-3"	711 lb
MISCELLANEOUS			
Concrete, Class C		1.5 cys	
Surface Seal		121 sft	

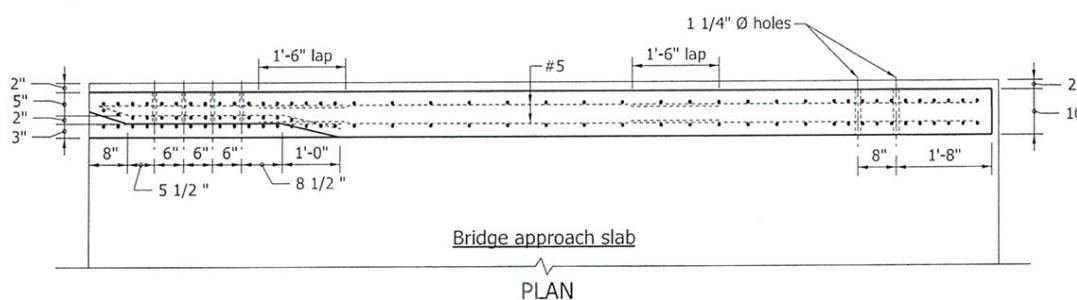

INDIANA DEPARTMENT OF TRANSPORTATION		
CONCRETE BRIDGE RAILING TRANSITION, TPF-2		
SEPTEMBER 2011 <i>PP</i>		
STANDARD DRAWING NO. E 706-TTBP-03		
<div>                     RICHARD L. VANCLEAVE                      REGISTERED                      NO. 9750                      STATE OF INDIANA                      PROFESSIONAL ENGINEER                 </div>		<i>/s/ Richard L. VanCleave</i> 09/01/11 DESIGN STANDARDS ENGINEER DATE
<i>/s/ Mark A. Miller</i> 09/01/11 CHIEF HIGHWAY ENGINEER		
DESIGN STANDARDS ENGINEER		


REVISION TO STANDARD DRAWINGS

EXISTING 706-TTBP-04 CONCRETE BRIDGE RAILING TRANSITION, TPF-2 (WITH MARKUPS)

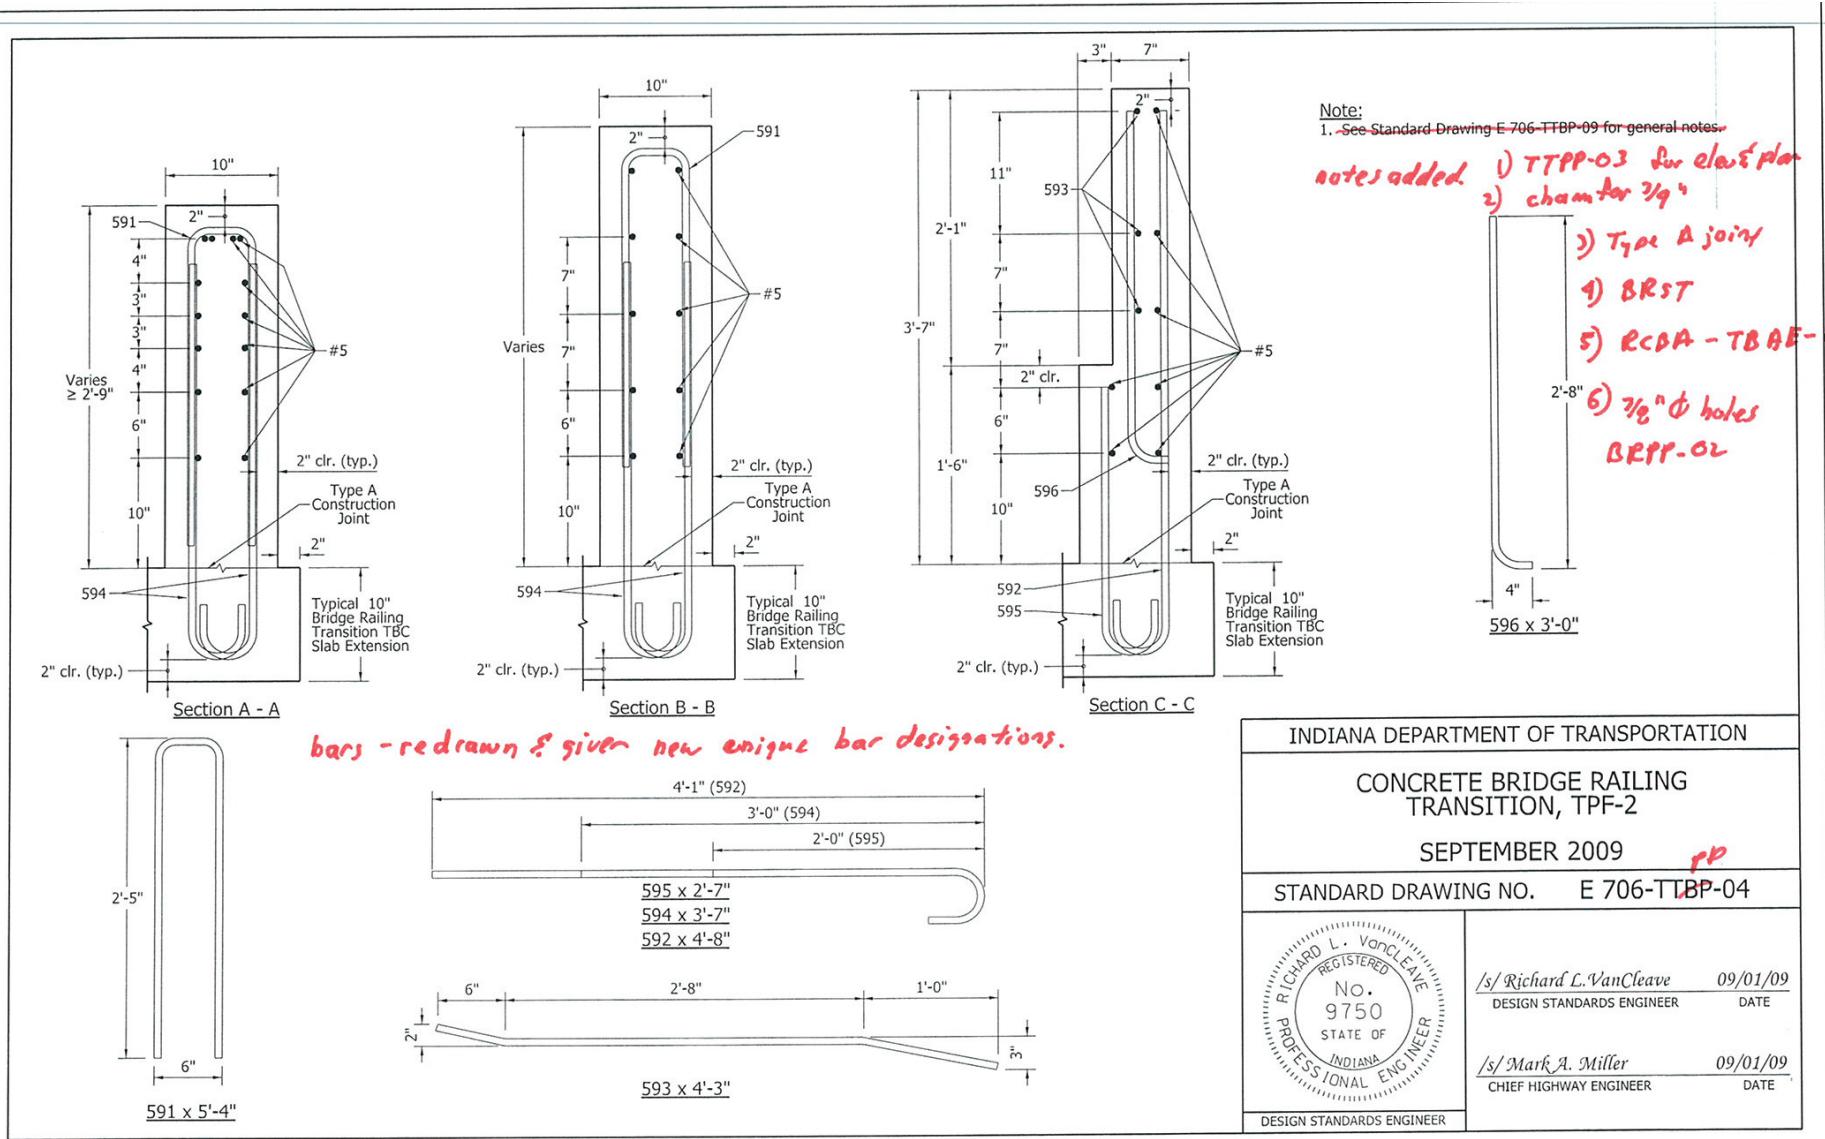


REVISION TO STANDARD DRAWINGS

EXISTING 706-TTBP-05 CONCRETE BRIDGE RAILING TRANSITION, TPS-1 (WITH MARKUPS)

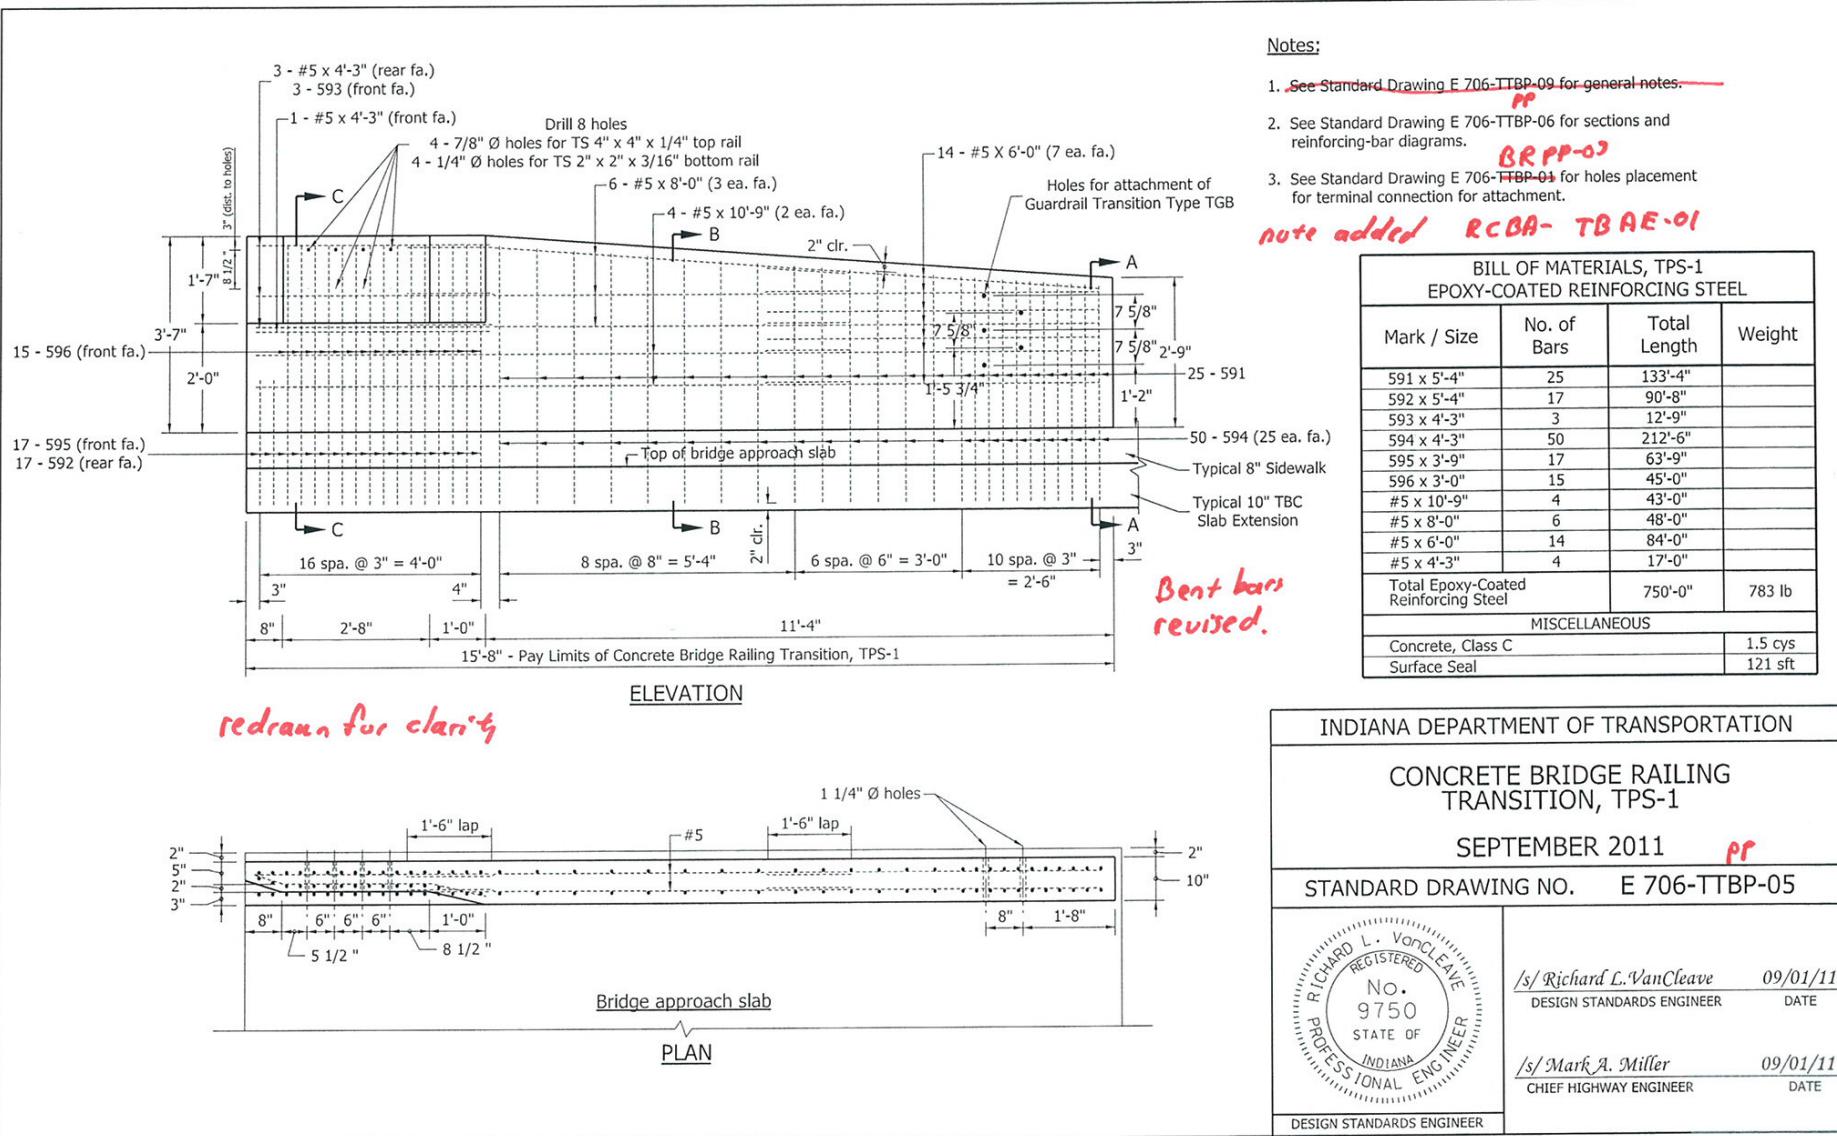


REVISION TO STANDARD DRAWINGS

EXISTING 706-TTBP-06 CONCRETE BRIDGE RAILING TRANSITION, TPS-1 (WITH MARKUPS)

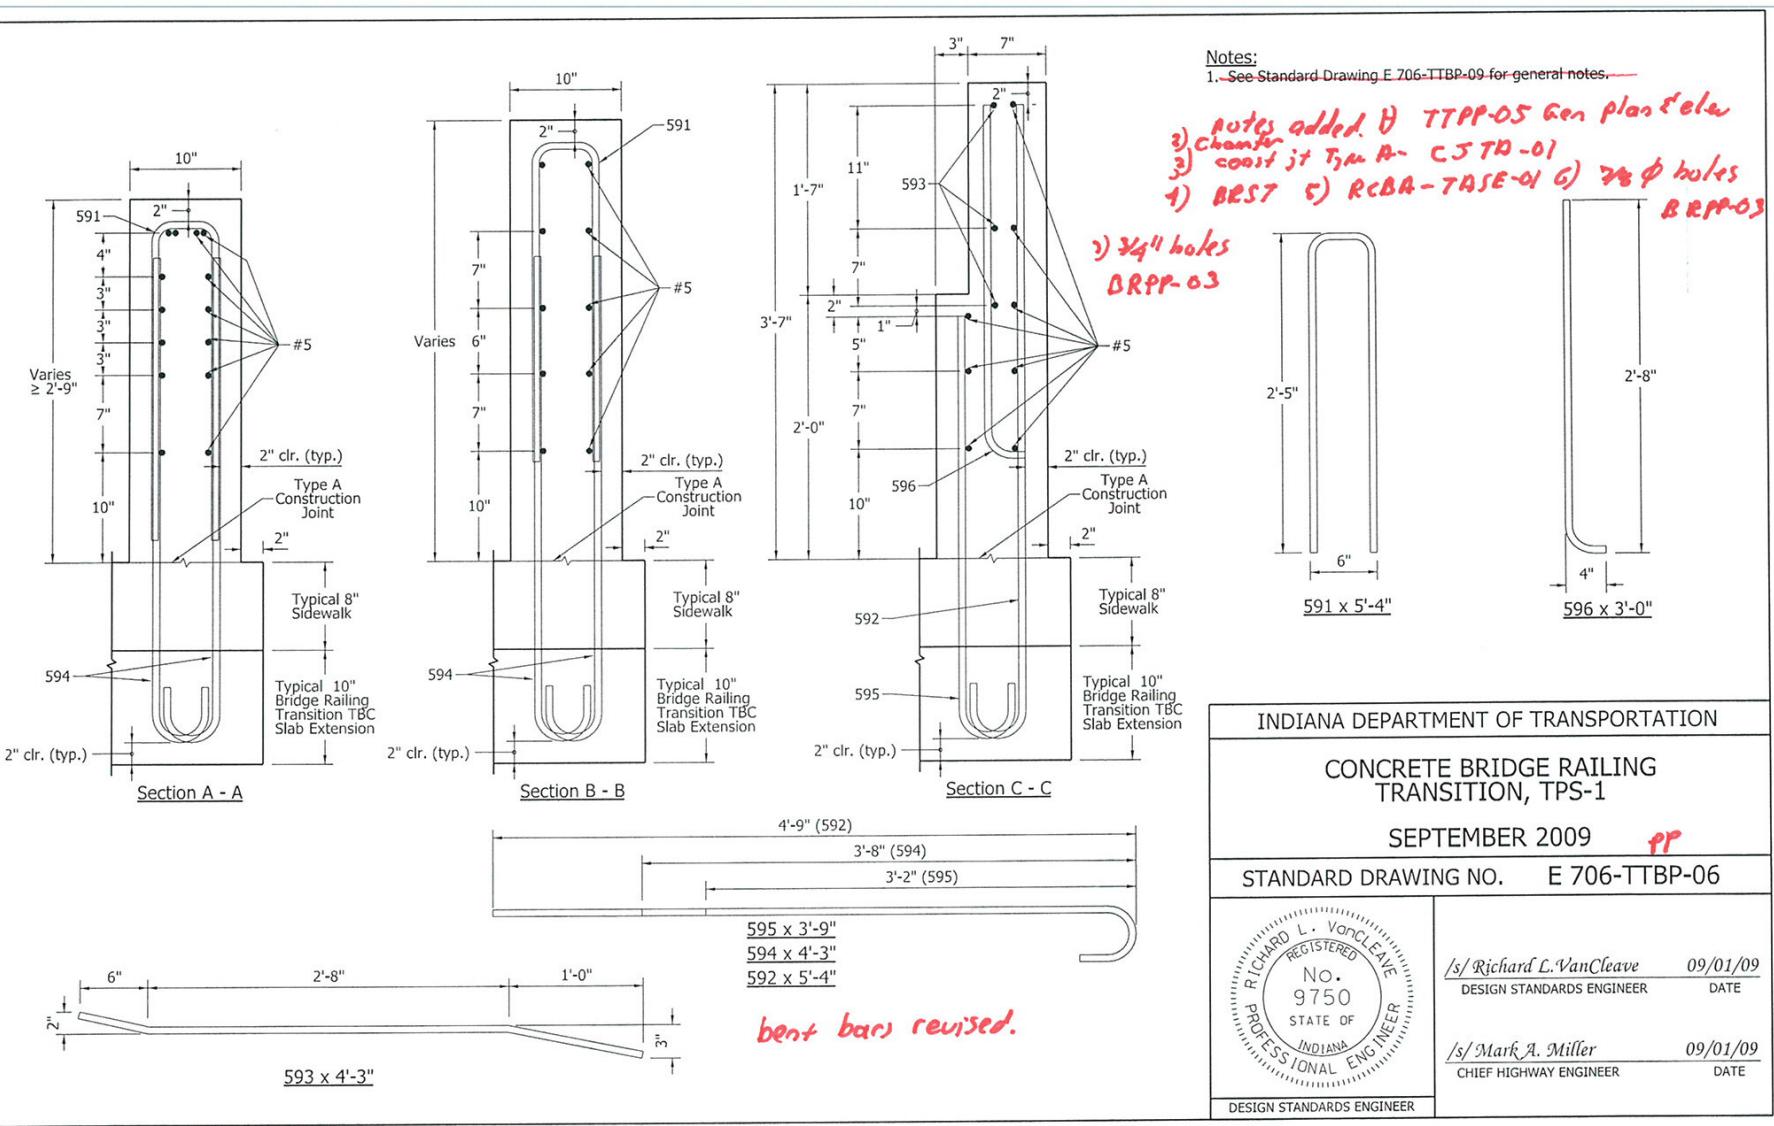


REVISION TO STANDARD DRAWINGS

EXISTING 706-TTBP-07 CONCRETE BRIDGE RAILING TRANSITION, TPS-2 (WITH MARKUPS)

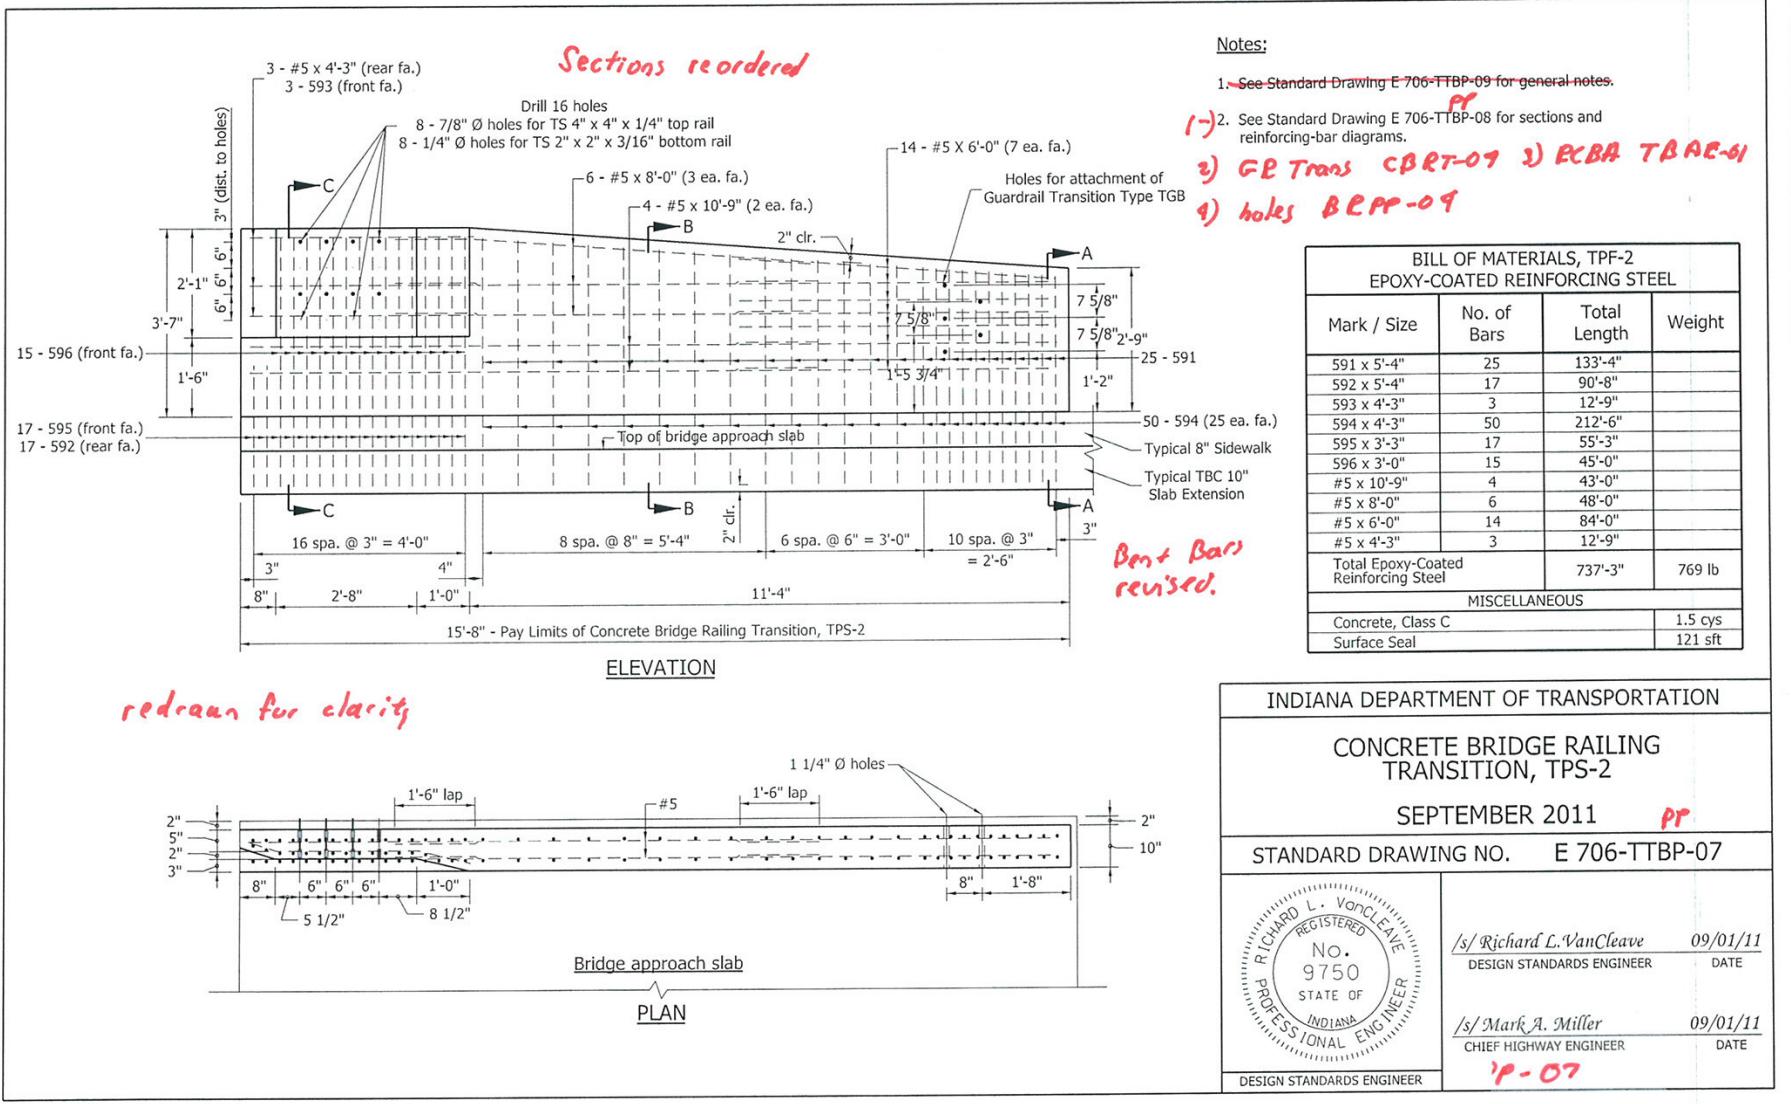

REVISION TO STANDARD DRAWINGS

EXISTING 706-TTBP-08 CONCRETE BRIDGE RAILING TRANSITION, TPS-2 (WITH MARKUPS)

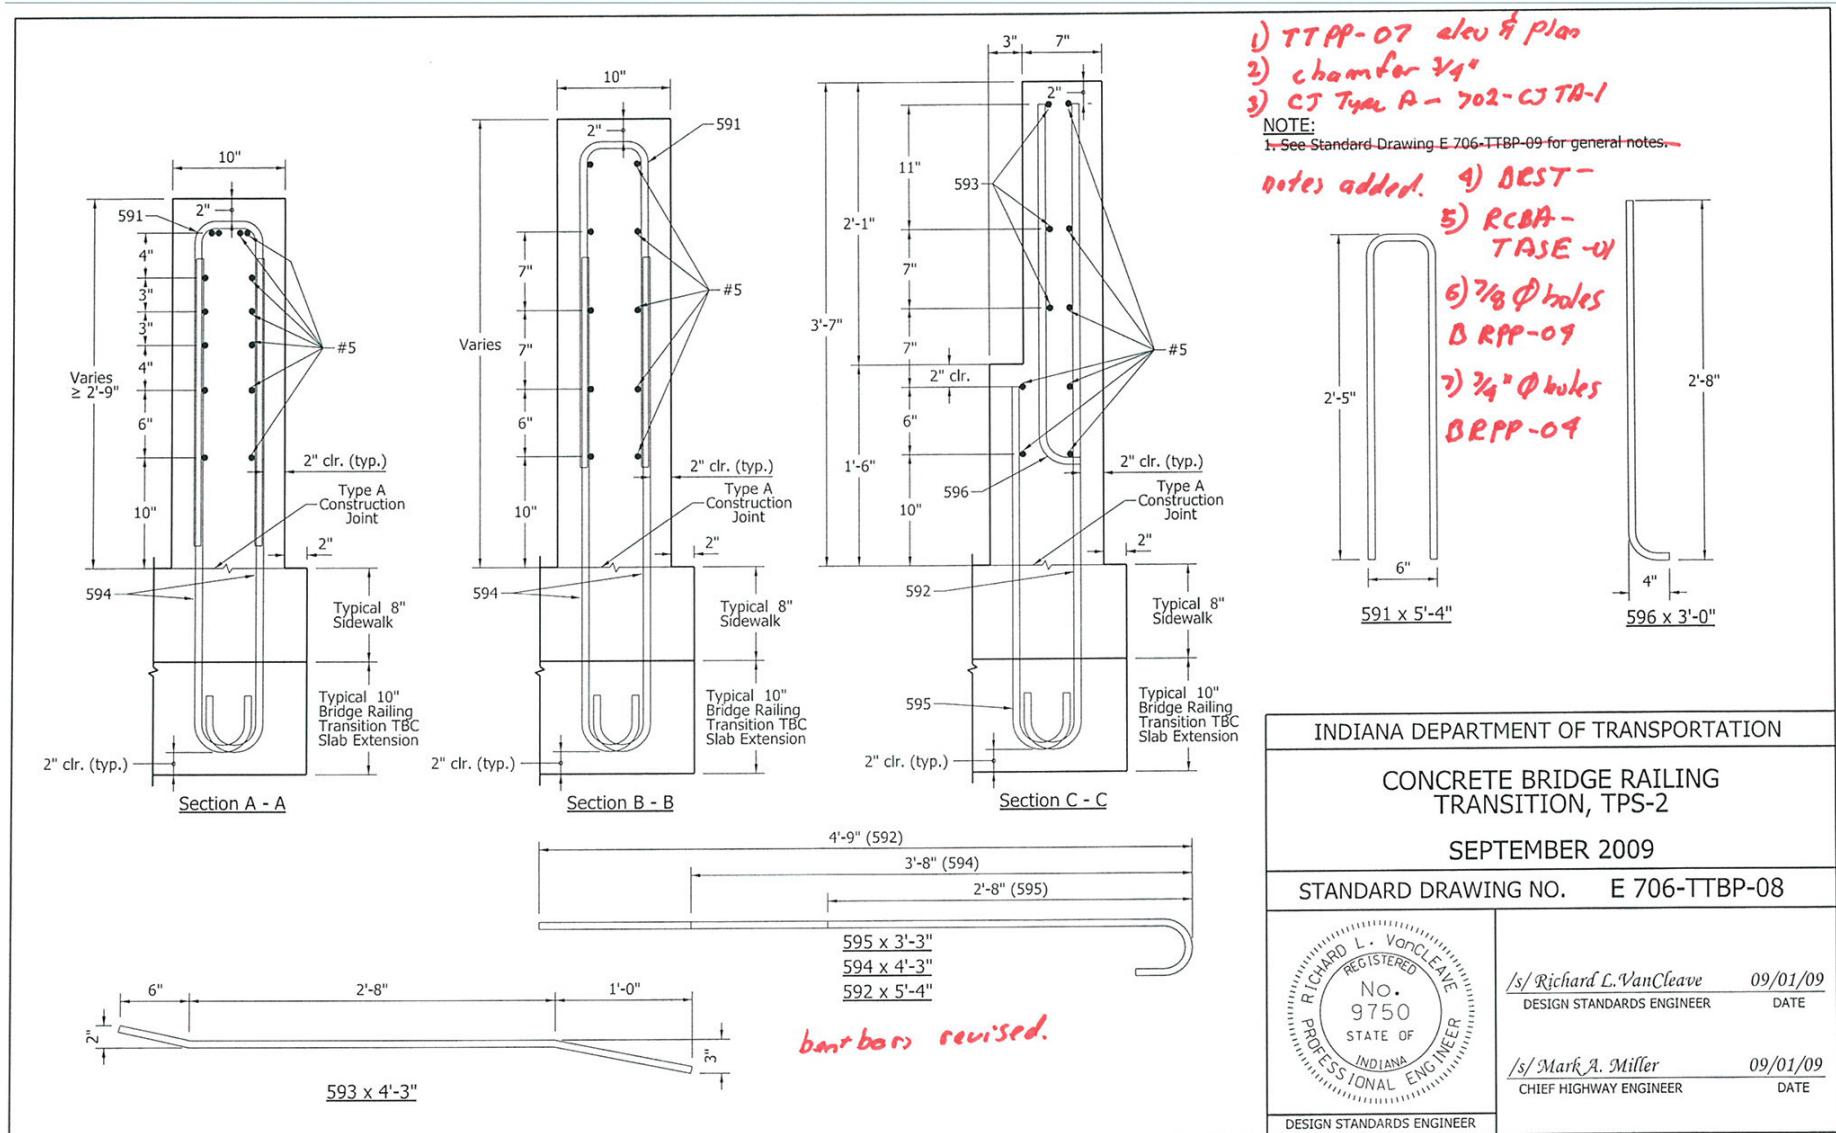

INDIANA DEPARTMENT OF TRANSPORTATION	
CONCRETE BRIDGE RAILING TRANSITION, TPS-2	
SEPTEMBER 2009	
STANDARD DRAWING NO. E 706-TTBP-08	
<i>/s/ Richard L. VanCleave</i> 09/01/09 DESIGN STANDARDS ENGINEER DATE	
<i>/s/ Mark A. Miller</i> 09/01/09 CHIEF HIGHWAY ENGINEER DATE	

Item No.02 03/15/12 (2012 SS)(contd.)  
Mr. Strain  
Date: 03/15/12


REVISION TO STANDARD DRAWINGS

EXISTING 706-TTBP-09 CONCRETE BRIDGE RAILING TRANSITION TYPE TPF, TPS, OR TTX (PROPOSED TO DELETE)

GENERAL NOTES:


1. All reinforcing-bars shall be epoxy coated.
2. Concrete shall be class C.
3. See Standard Drawing E 703-BRST-01 for reinforcing-bar bending details.
4. See Standard Drawing E 706-CBRT-02 for attachment of guardrail transition type TGB.
5. See Standard Drawing E 706-TASE-01, -02 and -05 for bridge-railing transition type TBC slab extension.

*Sheet deleted.*

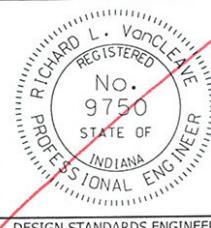INDIANA DEPARTMENT OF TRANSPORTATION	
CONCRETE BRIDGE RAILING TRANSITION TYPE TPF, TPS, OR TTX	
SEPTEMBER 2009	
STANDARD DRAWING NO. E 706-TTBP-09	
	/s/ Richard L. VanCleave 09/01/09 DESIGN STANDARDS ENGINEER
	/s/ Mark A. Miller 09/01/09 CHIEF HIGHWAY ENGINEER


REVISION TO STANDARD DRAWINGS

706-TTPP-01 CONCRETE BRIDGE RAILING TRANSITION, TPF-1 (DRAFT)

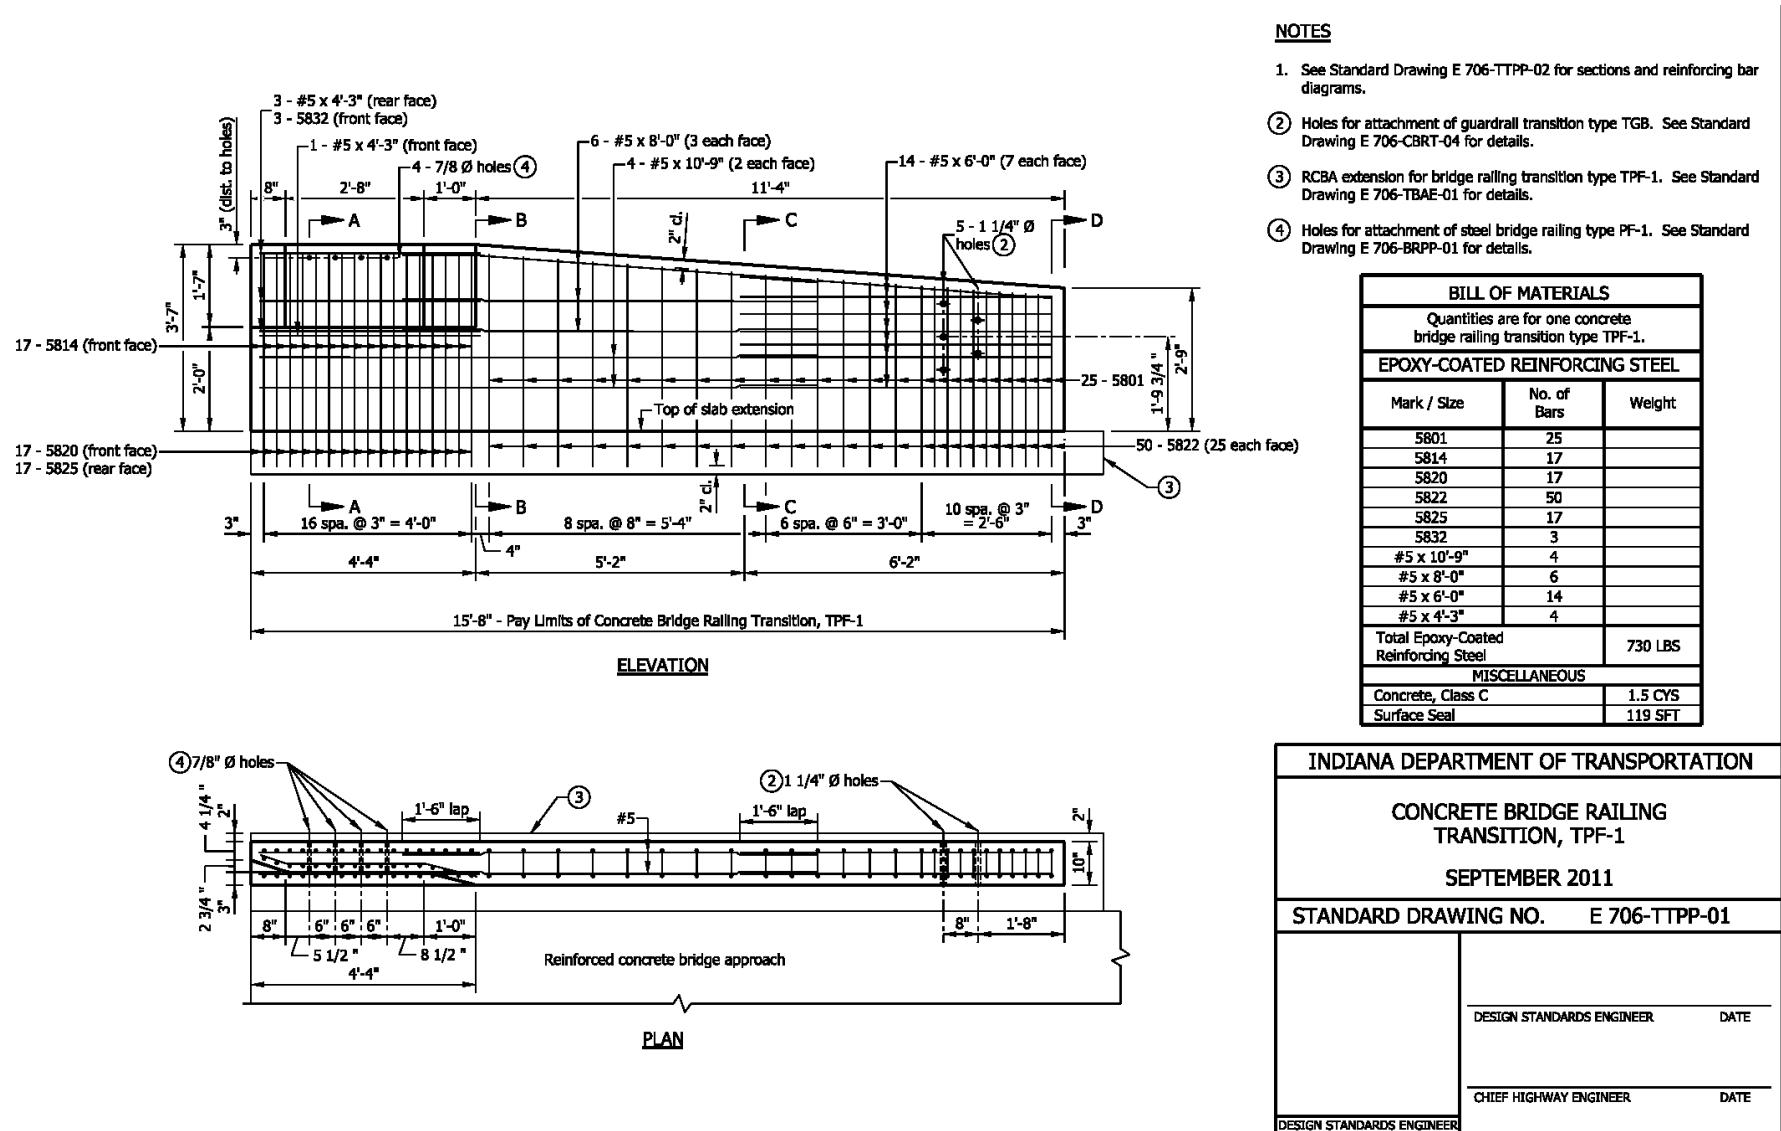


## REVISION TO STANDARD DRAWINGS


706-TTPP-02 CONCRETE BRIDGE RAILING TRANSITION, TPF-1 (DRAFT)

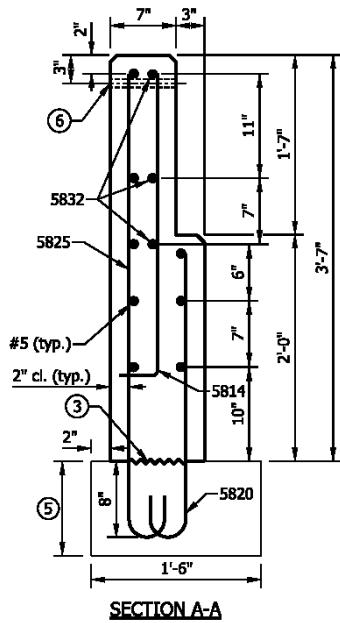


## **SECTION A-A**

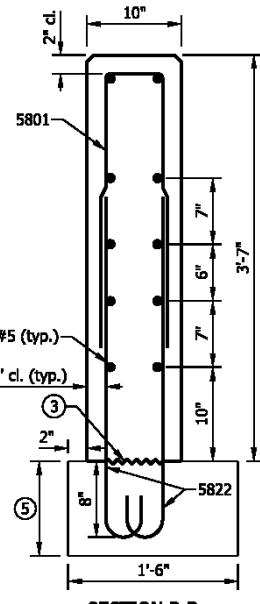

## **SECTION B-B**

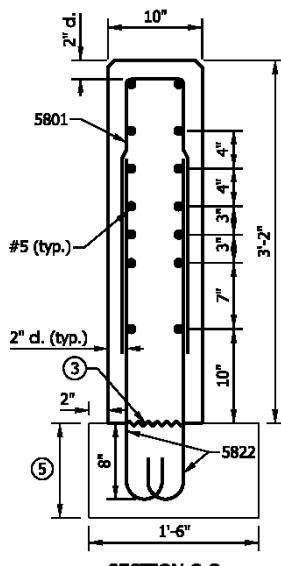


**SECTION C-C**

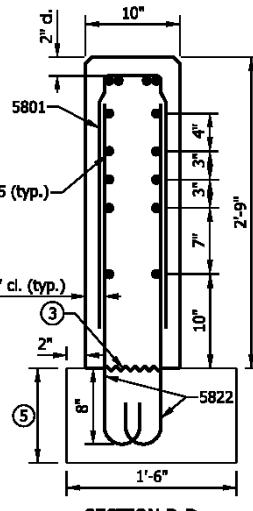


## **SECTION D-D**

## NOTES

1. See Standard Drawing E 706-TTPP-01 for elevation and plan.
2. All chamfered edges shall be  $3/4"$ .
3. Construction joint type A. See Standard Drawing E 702-CJTA-01 for details.
4. See Standard Drawing E 703-BRST-01 for reinforcing-bar bending details and notes.
5. RCBA extension for bridge railing transition type TPF-1. See Standard Drawing E 706-TBAE-01 details.
6. 7/8" Ø hole for attachment of steel bridge railing type PF-1. See Standard Drawing E 706-BRP-01 for details.

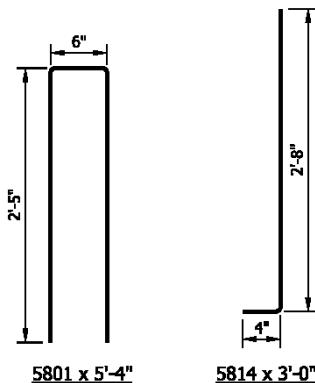

5814 x 3'-0"


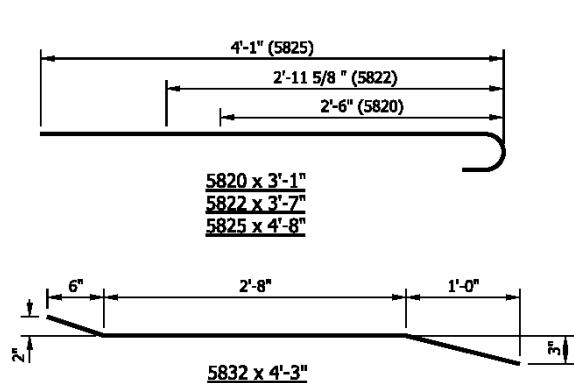


5832 x 4'-3"

INDIANA DEPARTMENT OF TRANSPORTATION	
CONCRETE BRIDGE RAILING TRANSITION, TPF-1	
SEPTEMBER 2009	
STANDARD DRAWING NO. E 706-TTPP-02	
	DESIGN STANDARDS ENGINEER _____ DATE _____
	CHIEF HIGHWAY ENGINEER _____ DATE _____
DESIGN STANDARDS ENGINEER	

REVISION TO STANDARD DRAWINGS

706-TTPP-03 CONCRETE BRIDGE RAILING TRANSITION, TPF-2 (DRAFT)

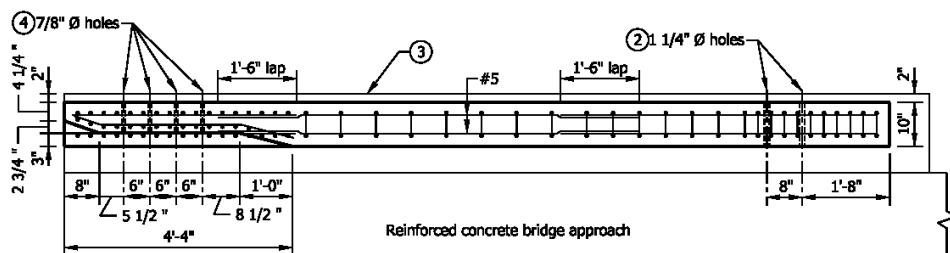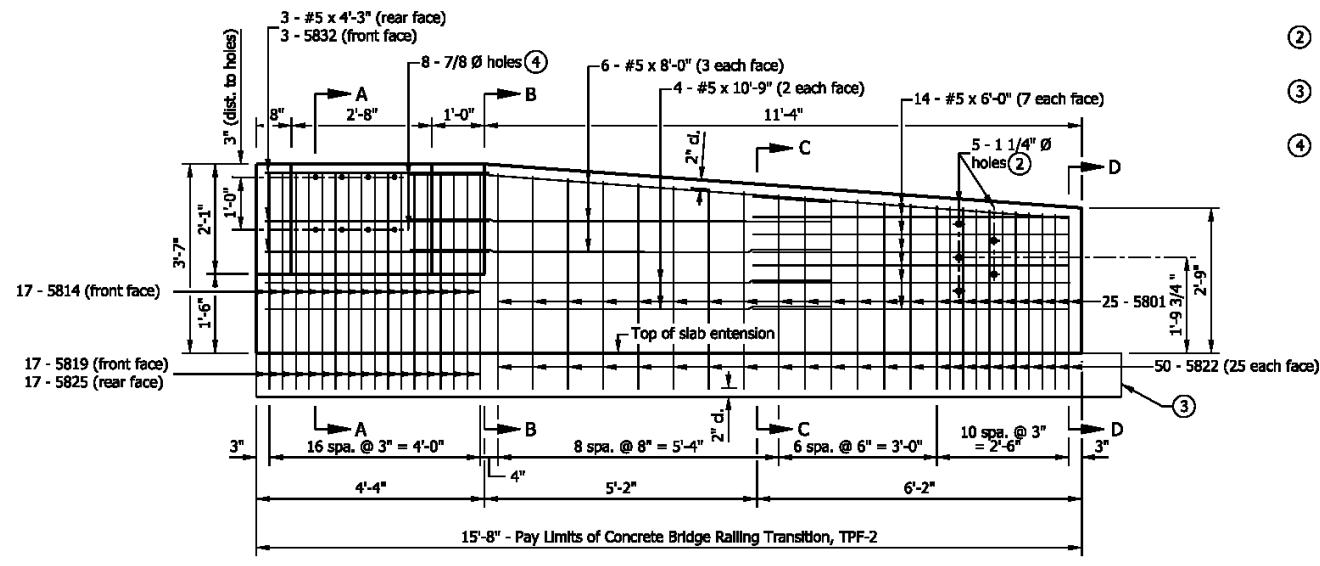

**NOTES**


1. See Standard Drawing E 706-TTPP-04 for sections and reinforcing bar diagrams.
2. Holes for attachment of guardrail transition type TGB. See Standard Drawing E 706-CBRT-04 for details.
3. RCBA extension for bridge railing transition type TPF-2. See Standard Drawing E 706-TBAE-01 for details.
4. Holes for attachment of steel bridge railing type PF-2. See Standard Drawing E 706-BRPP-02 for details.

BILL OF MATERIALS		
Quantities are for one concrete bridge railing transition type TPF-2.		
EPOXY-COATED REINFORCING STEEL		
Mark / Size	No. of Bars	Weight
5801	25	
5814	17	
5819	17	
5822	50	
5825	17	
5832	3	
#5 x 10'-9"	4	
#5 x 8'-0"	6	
#5 x 6'-0"	14	
#5 x 4'-3"	3	
Total Epoxy-Coated Reinforcing Steel		717 LBS
MISCELLANEOUS		
Concrete, Class C	1.5 CYS	
Surface Seal	119 SFT	

INDIANA DEPARTMENT OF TRANSPORTATION	
CONCRETE BRIDGE RAILING TRANSITION, TPF-2	
SEPTEMBER 2011	
STANDARD DRAWING NO.	E 706-TTPP-03
DESIGN STANDARDS ENGINEER	DATE
CHIEF HIGHWAY ENGINEER	DATE
DESIGN STANDARDS ENGINEER	DATE


REVISION TO STANDARD DRAWINGS

706-TTPP-04 CONCRETE BRIDGE RAILING TRANSITION, TPF-2 (DRAFT)

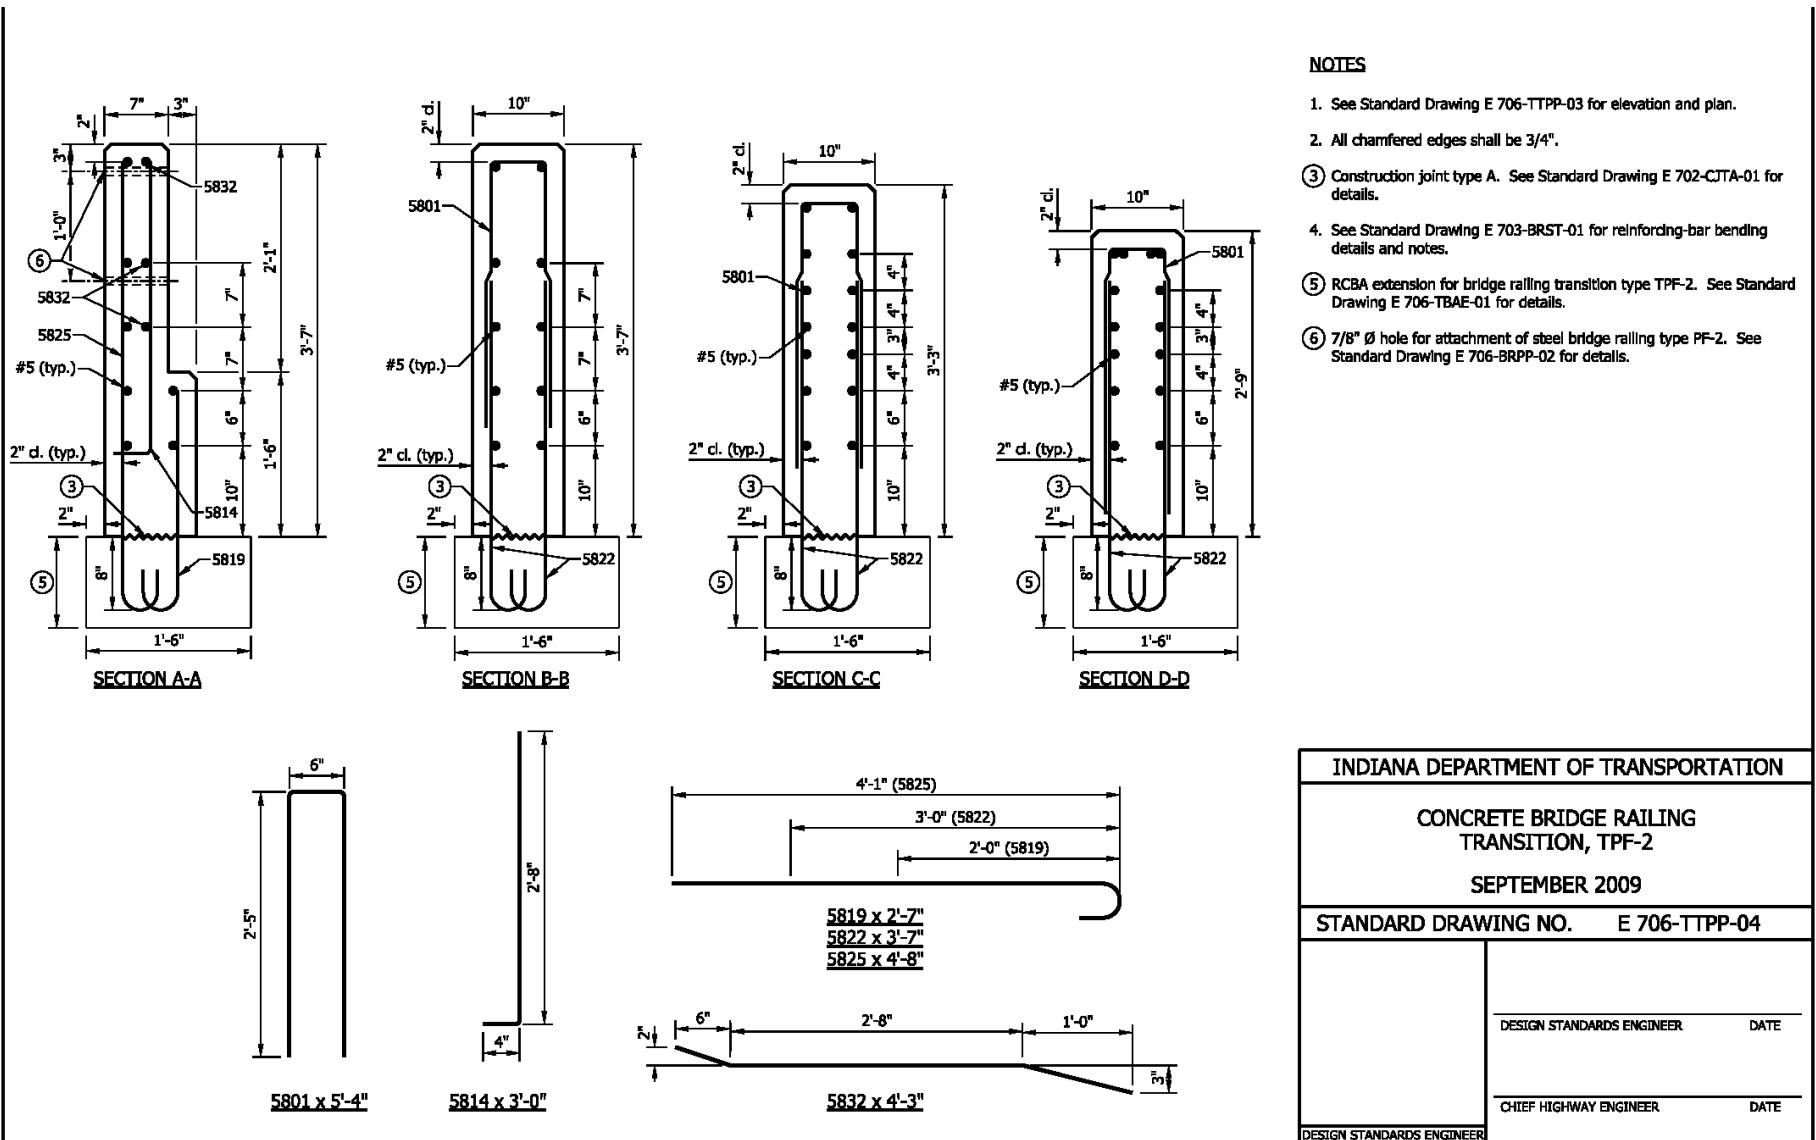


REVISION TO STANDARD DRAWINGS

706-TTPP-05 CONCRETE BRIDGE RAILING TRANSITION, TPS-1 (DRAFT)

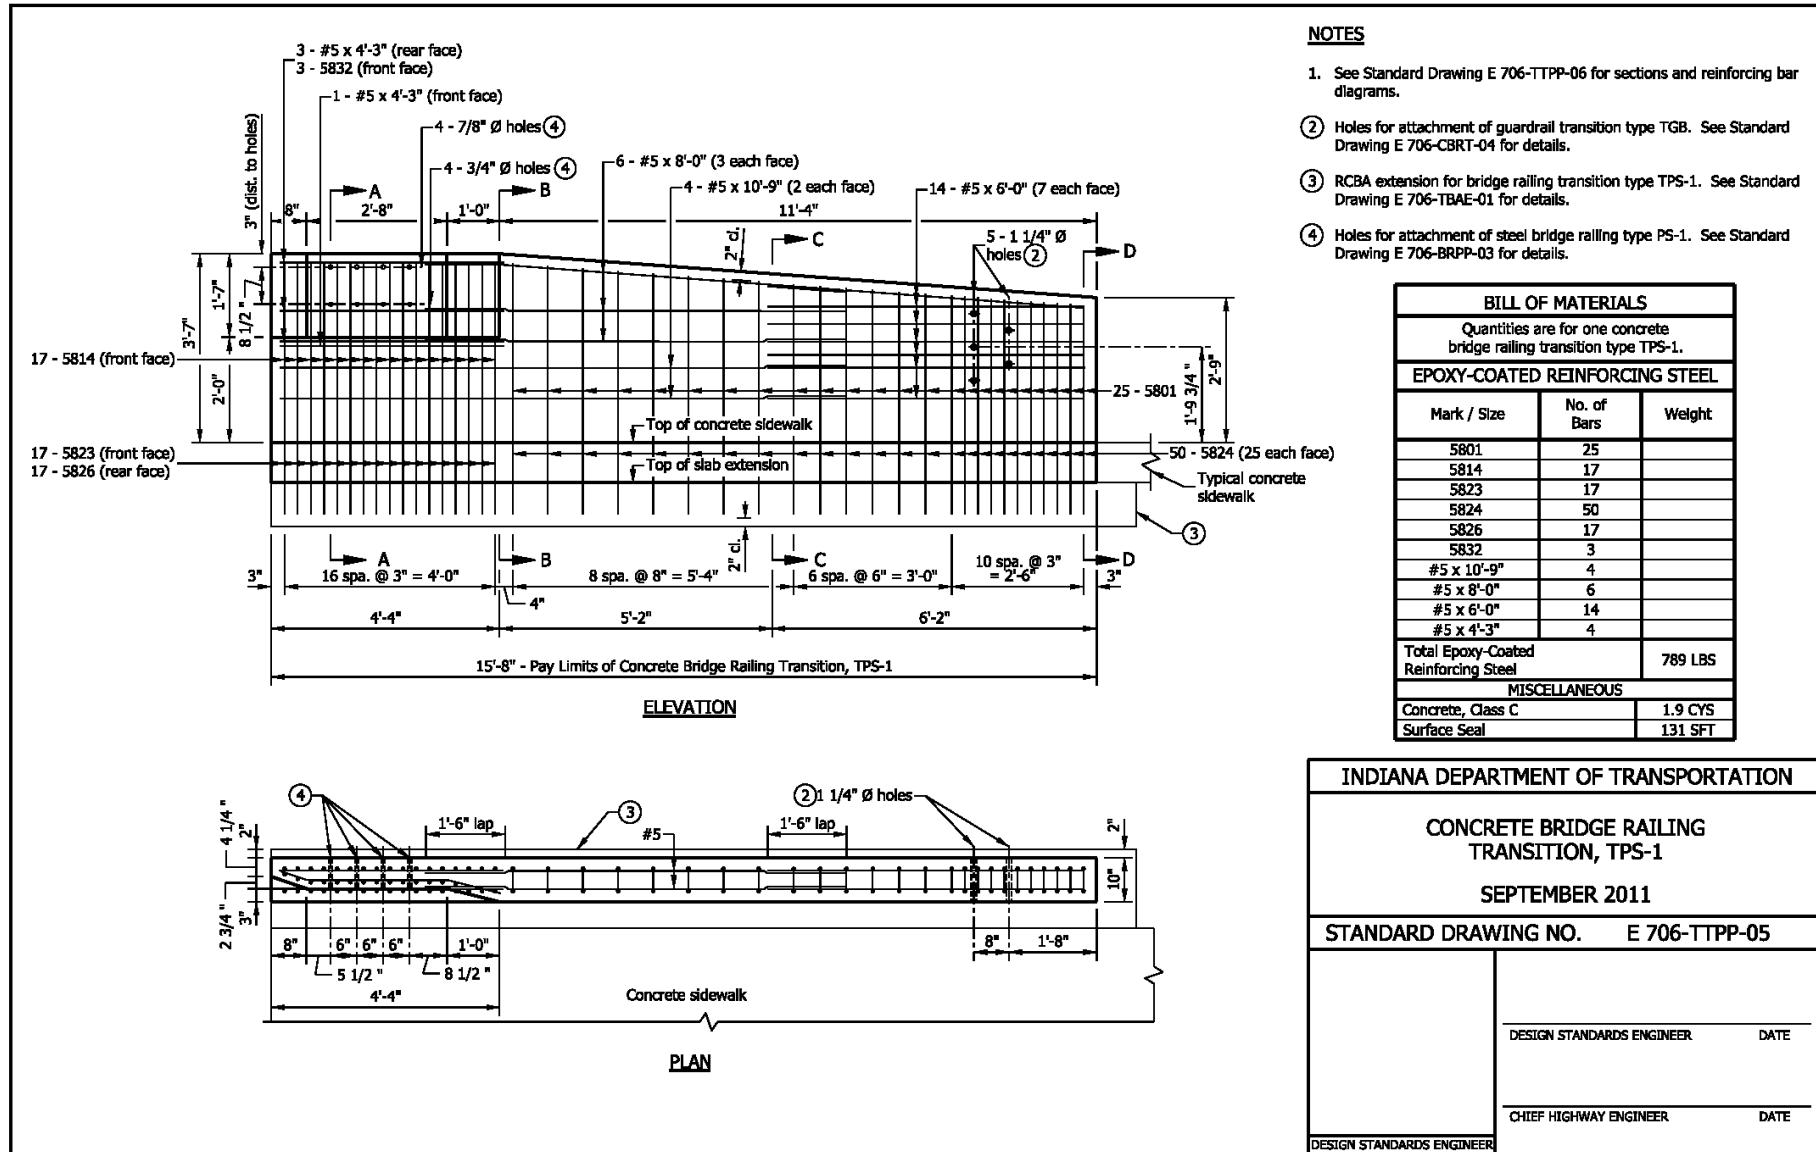


REVISION TO STANDARD DRAWINGS

706-TTPP-06 CONCRETE BRIDGE RAILING TRANSITION, TPS-1 (DRAFT)

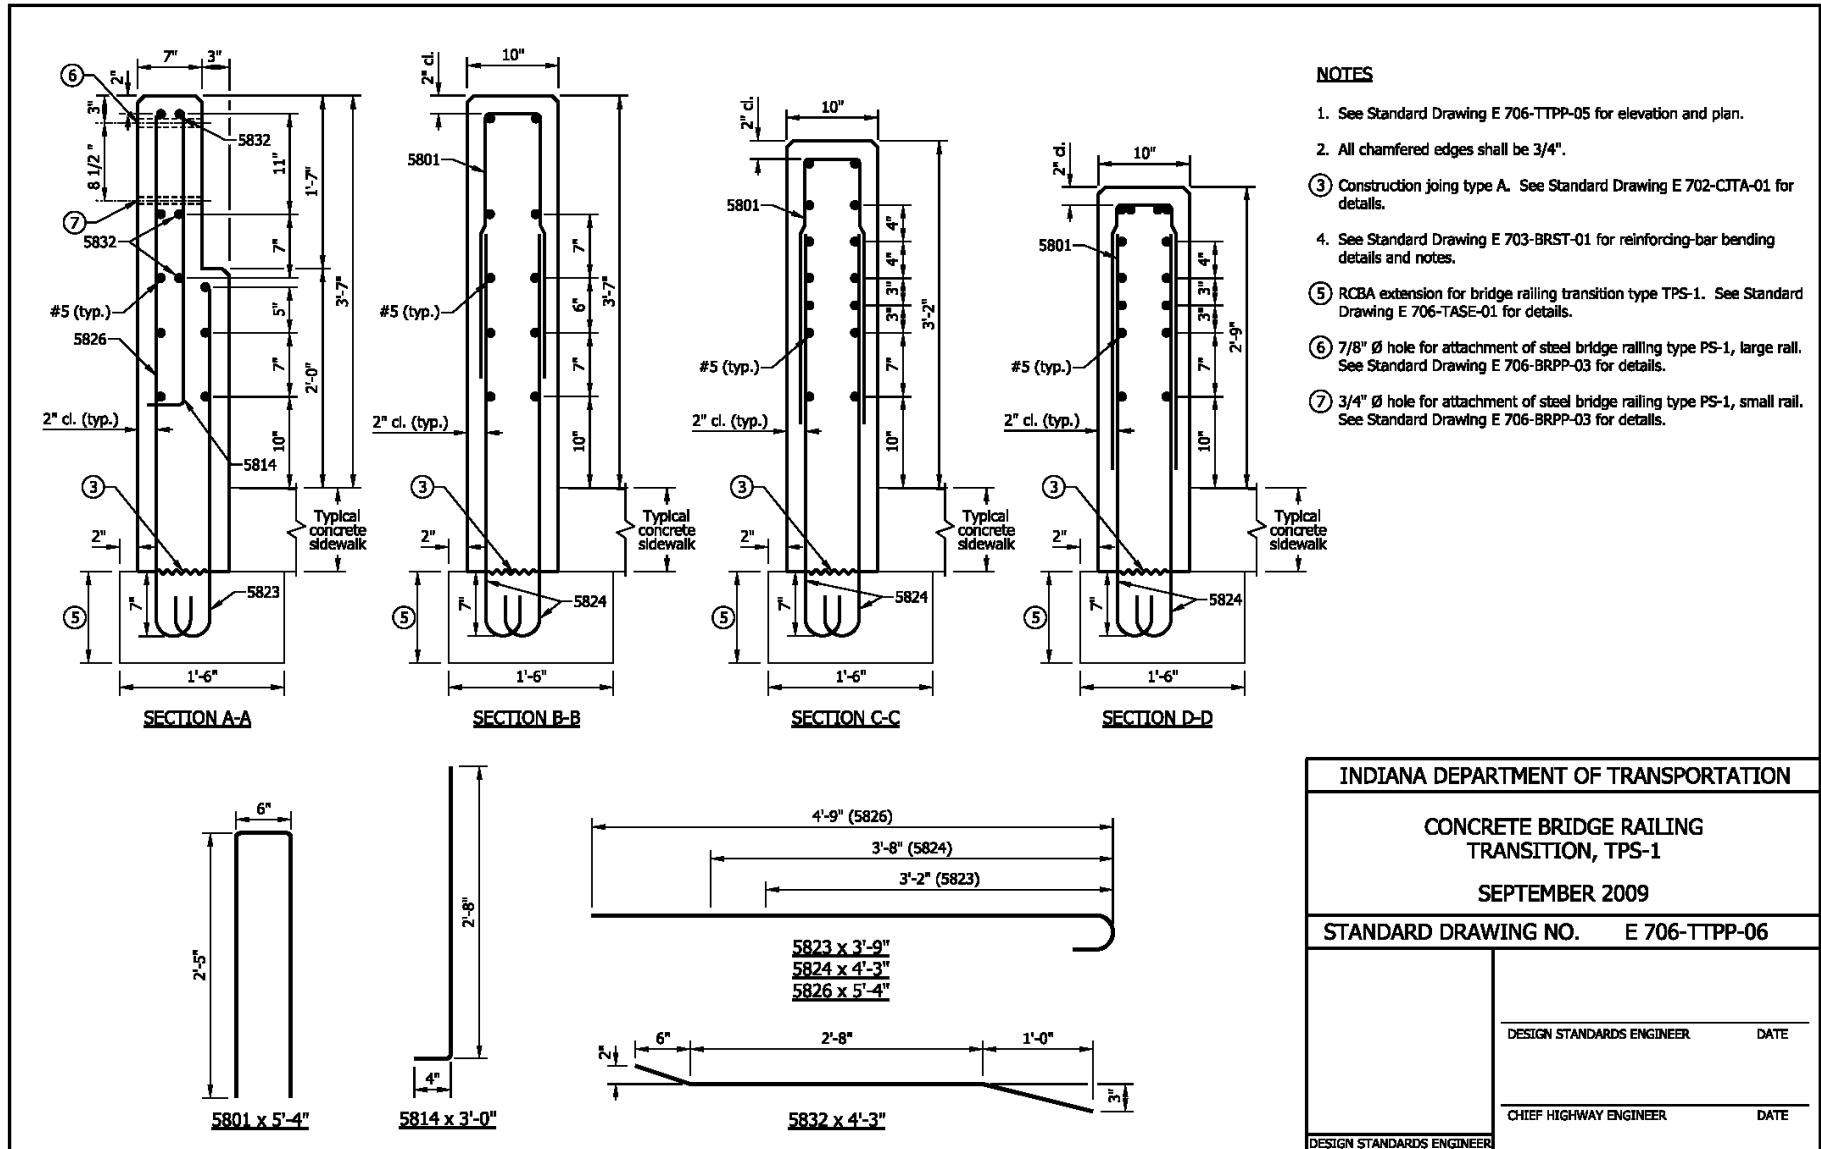


REVISION TO STANDARD DRAWINGS

706-TTPP-07 CONCRETE BRIDGE RAILING TRANSITION, TPS-2 (DRAFT)

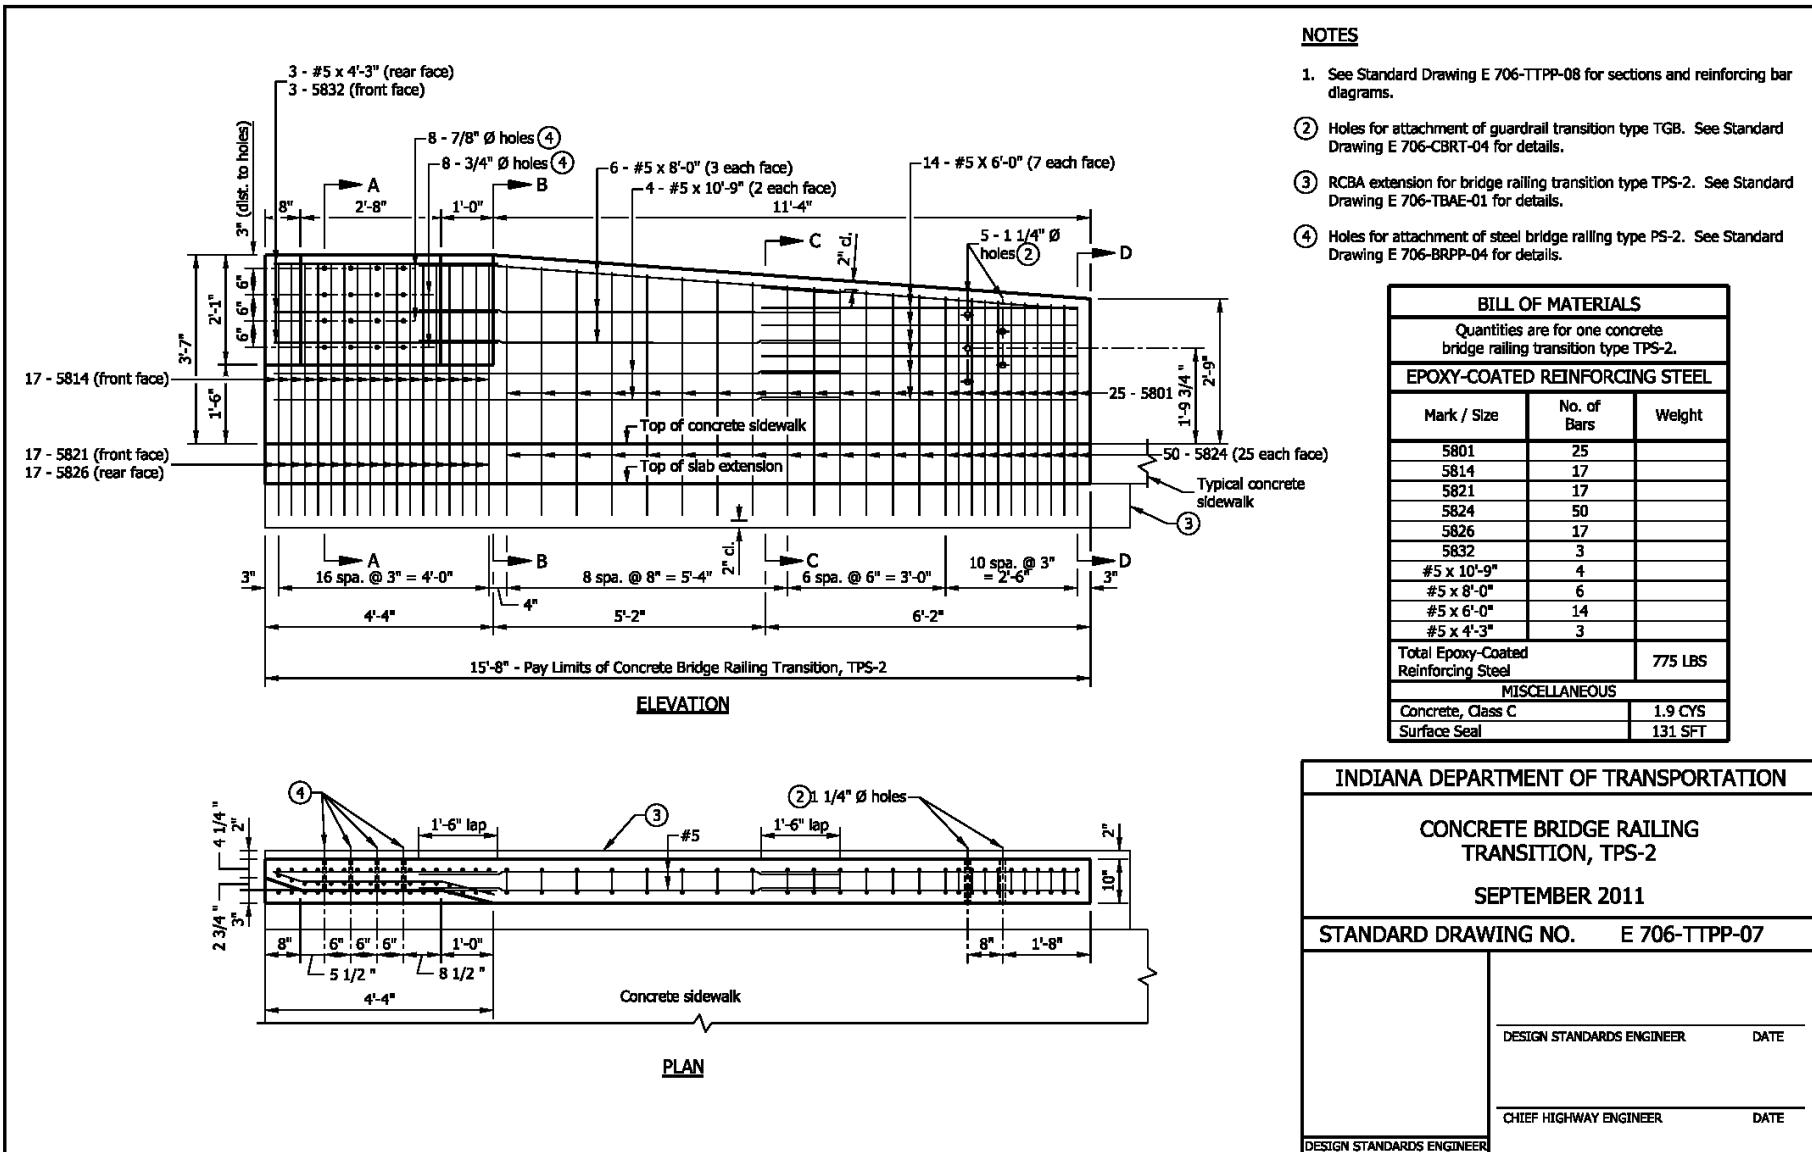

REVISION TO STANDARD DRAWINGS

706-TTPP-08 CONCRETE BRIDGE RAILING TRANSITION, TPS-2 (DRAFT)

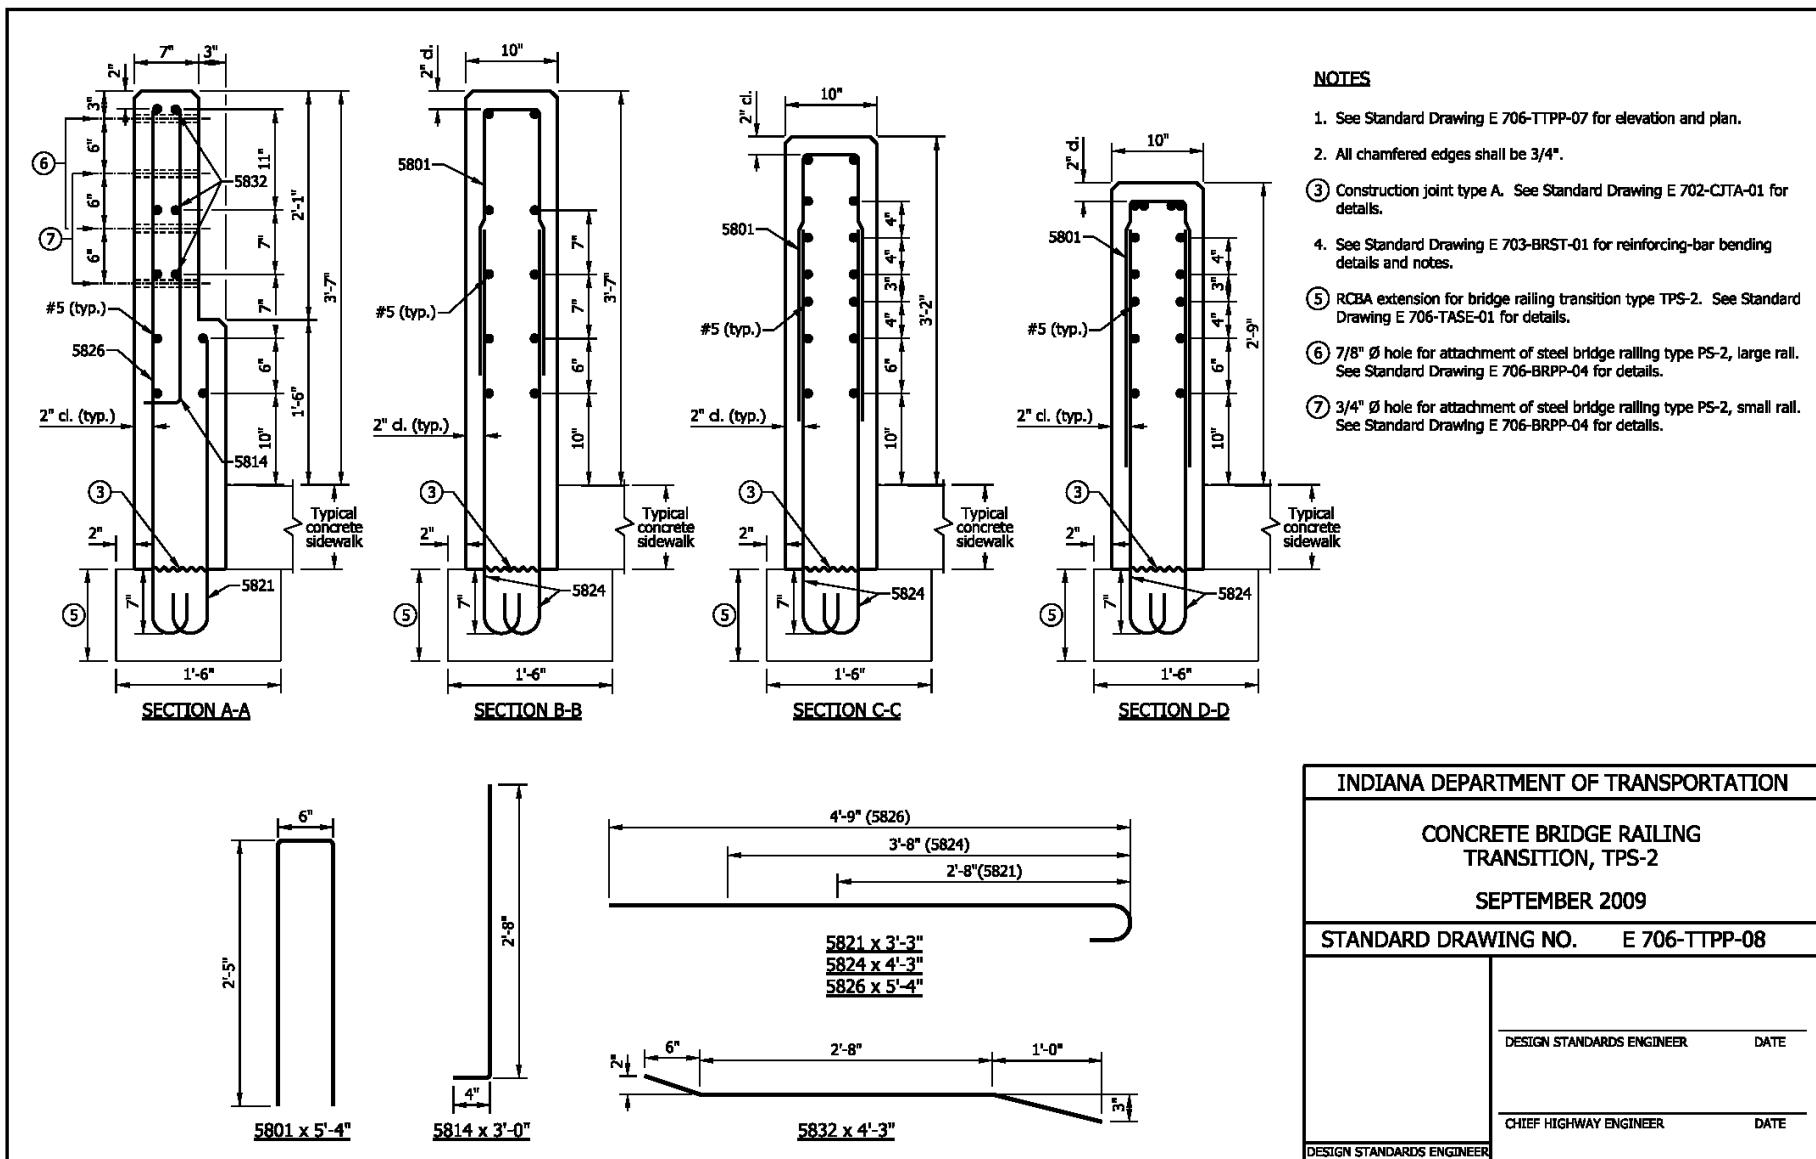


INDIANA DEPARTMENT OF TRANSPORTATION	
CONCRETE BRIDGE RAILING TRANSITION, TPS-2	
SEPTEMBER 2009	
STANDARD DRAWING NO.	E 706-TTPP-08
DESIGN STANDARDS ENGINEER	DATE
CHIEF HIGHWAY ENGINEER	DATE
DESIGN STANDARDS ENGINEER	DATE

Item No. 02 03/15/12 (2012 SS) (contd.)  
 Mr. Strain  
 Date: 03/15/12


REVISION TO STANDARD DRAWINGS

EXISTING 706-TTBT-01 CONCRETE BRIDGE RAILING TRANSITION TBT PLAN AND ELEVATION (WITH MARKUPS)

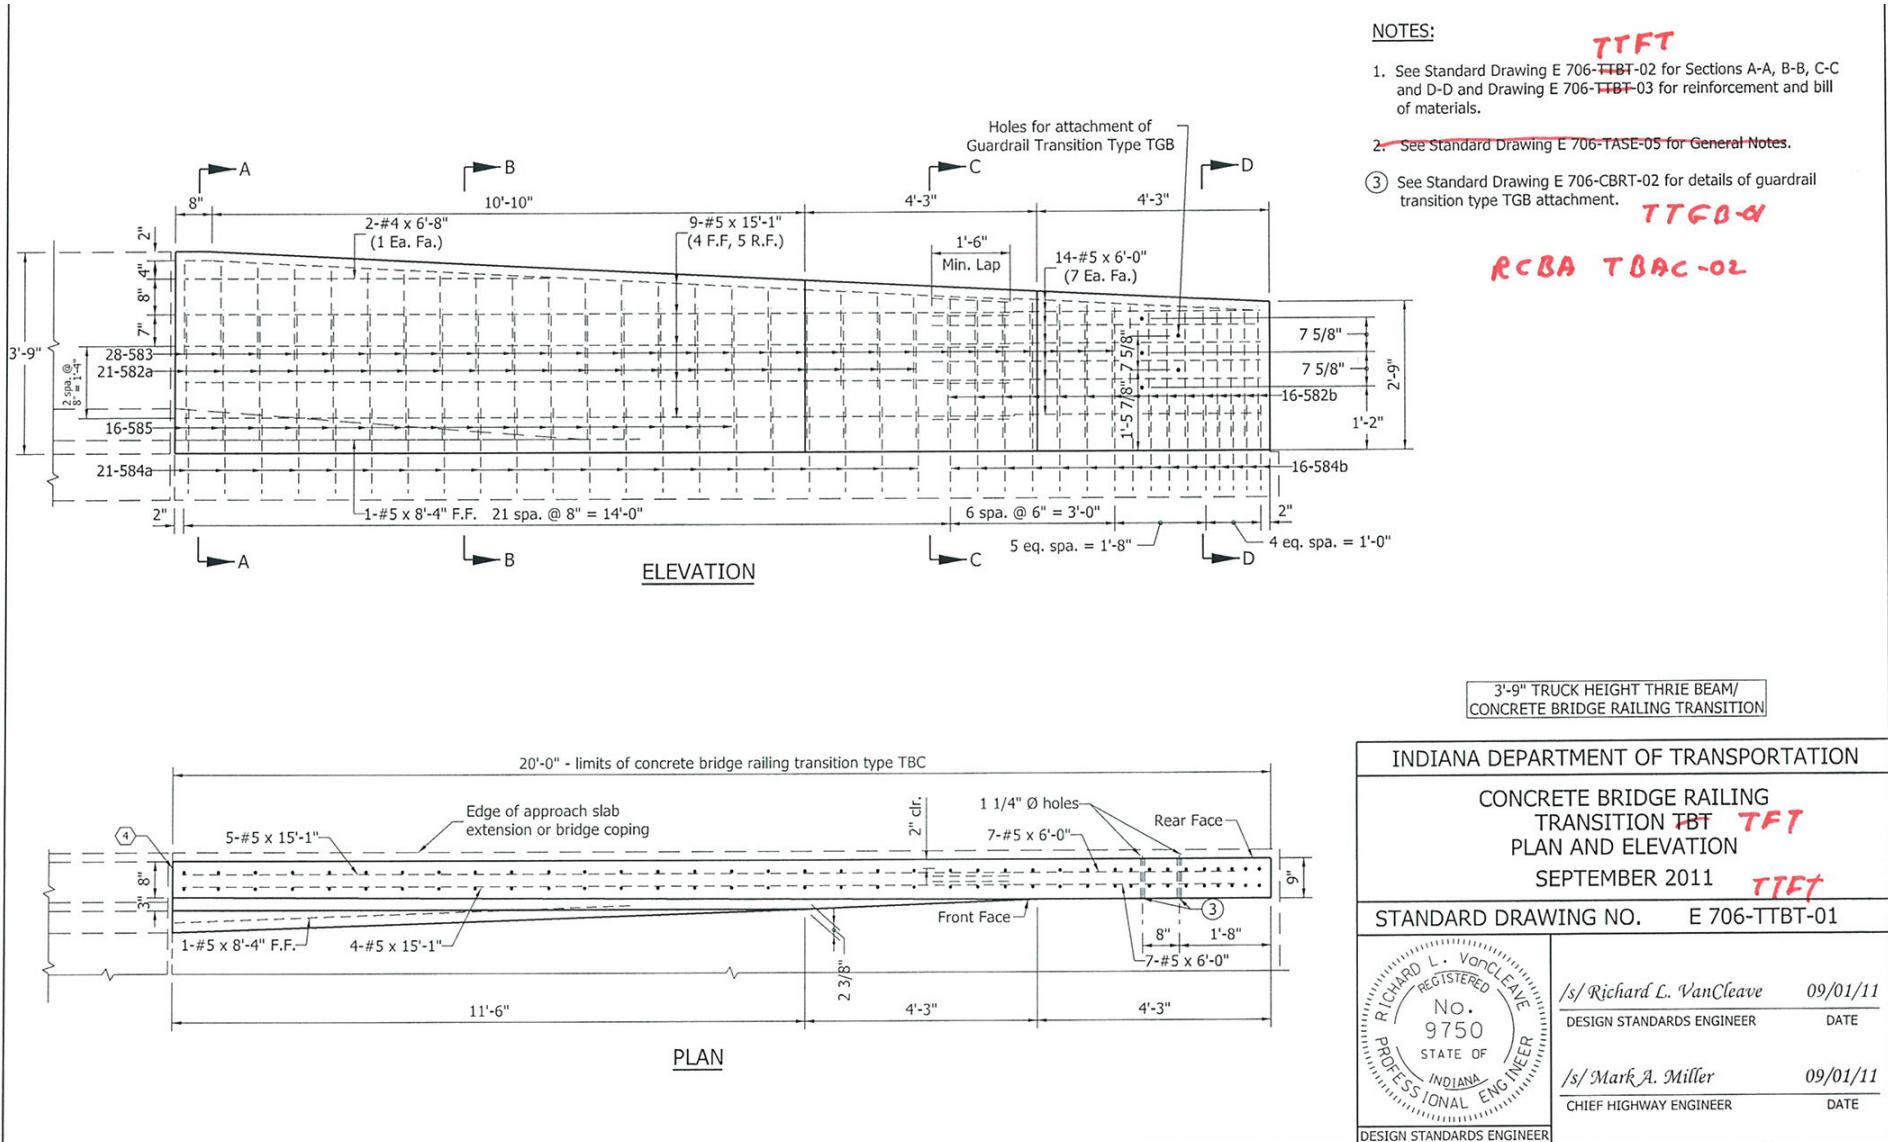

REVISION TO STANDARD DRAWINGS


EXISTING 706-TTBT-02 CONCRETE BRIDGE RAILING TRANSITION TYPE TBT

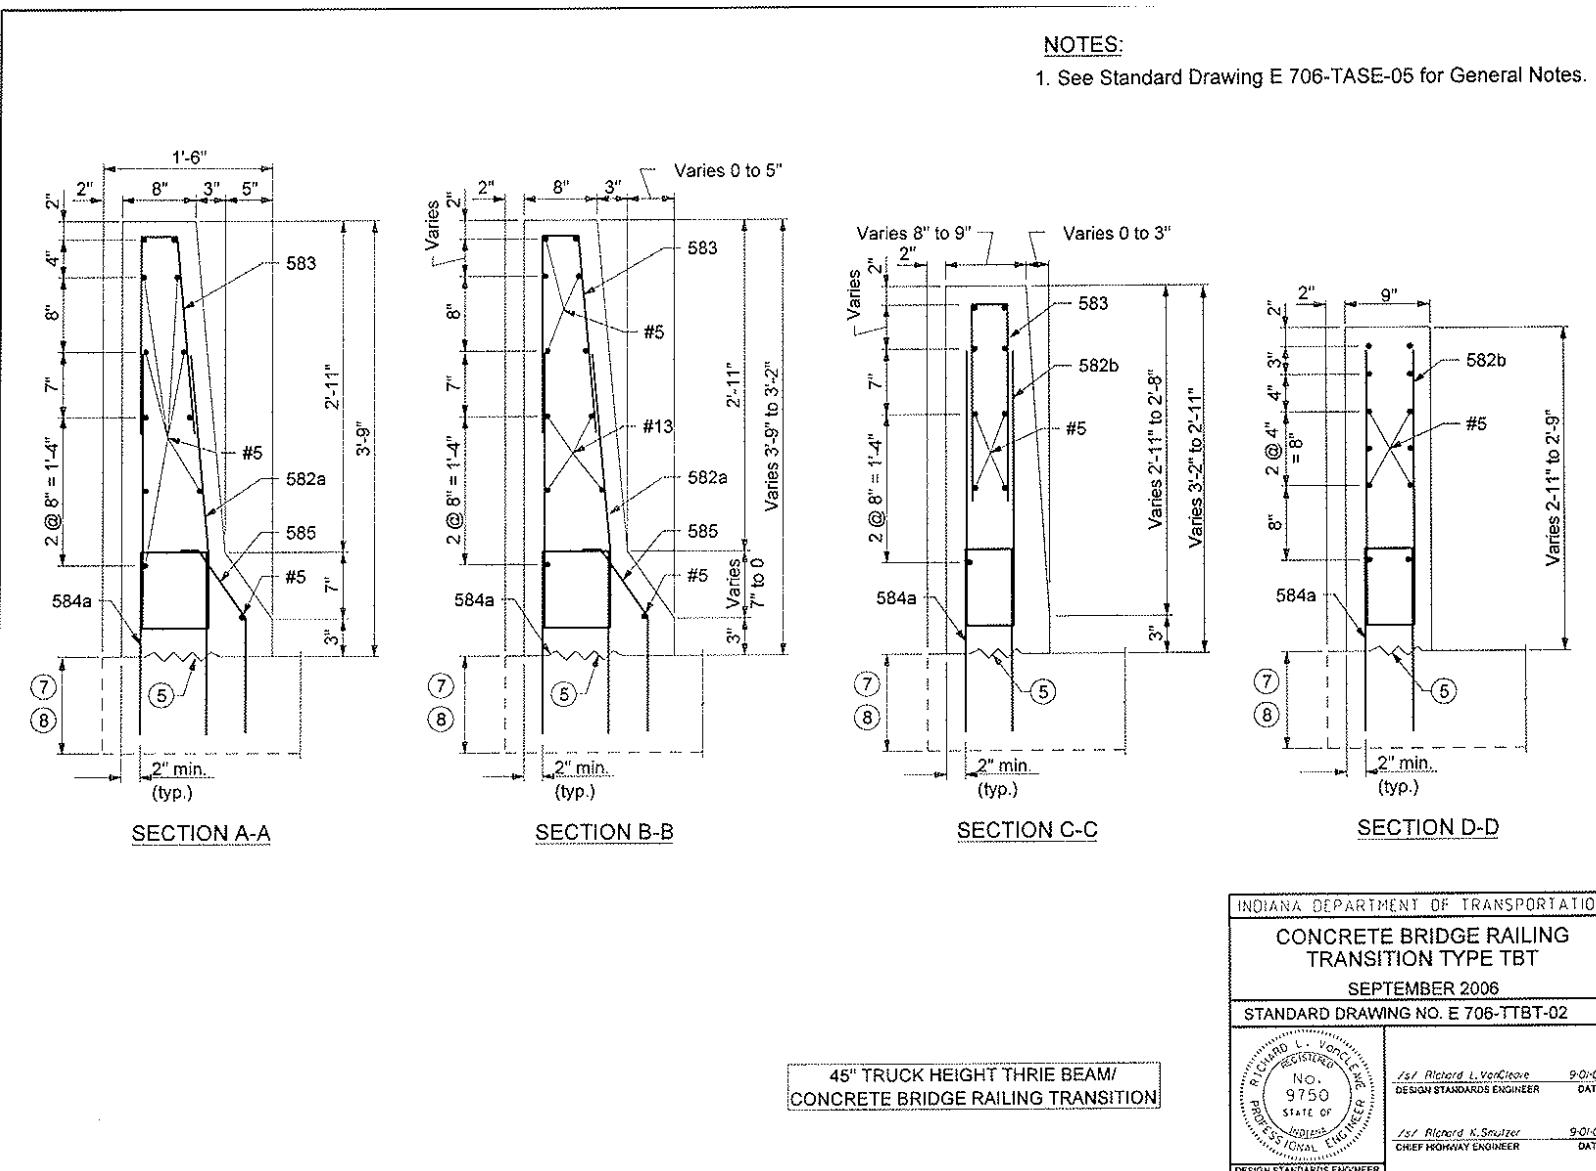


Item No.02 03/15/12 (2012 SS)(contd.)  
 Mr. Strain  
 Date: 03/15/12

REVISION TO STANDARD DRAWINGS


EXISTING 706-TTBT-03 CONCRETE BRIDGE RAILING TRANSITION TYPE TBT

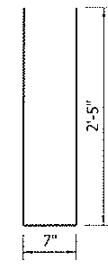


582b x 5'-5"

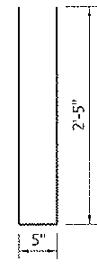


582b x 5'-3"

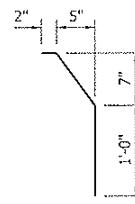


585 x 2'-0"

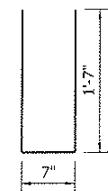


584a x 3'-9"

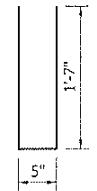

584b x 3'-7"

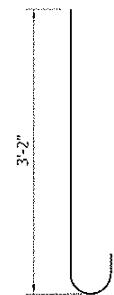

589 x 3'-9"


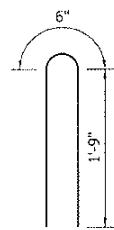


583 x 4'-0"

NOTE:

1. See Standard Drawing E 706-TASE-05 for General Notes.

BILL OF MATERIALS			
These quantities are for one concrete bridge railing transition type TBT.			
EPOXY COATED REINFORCING STEEL			
Size and Mark	No. of Bars	Length (Ft.-in.)	Weight (Lbs.)
582a	21	5'-5"	
582b	16	5'-3"	
583	28	4'-0"	
584a	21	3'-7"	
584b	16	3'-7"	
585	16	2'-0"	
#5	9	15'-1"	
#5	1	8'-4"	
#5	2	6'-8"	
#5	14	6'-0"	
Total #5 Bars		1133	
Total Epoxy Coated Steel		1133	
Concrete Class C in Railing		2.0 yd <sup>3</sup>	
Surface Seal		13.4 yd <sup>2</sup>	

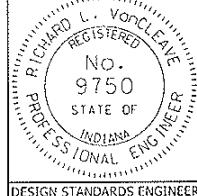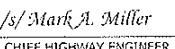
INDIANA DEPARTMENT OF TRANSPORTATION	
CONCRETE BRIDGE RAILING TRANSITION TYPE TBT	
SEPTEMBER 2011	
STANDARD DRAWING NO. E 706-TTBT-03	
	/s/ Richard L. VanCleave 09/01/11
	DESIGN STANDARDS ENGINEER DATE
	/s/ Mark A. Miller 09/01/11
	CHIEF HIGHWAY ENGINEER DATE
DESIGN STANDARDS ENGINEER	

REVISION TO STANDARD DRAWINGS


706-TTFT-01 CONCRETE BRIDGE RAILING TRANSITION TFT PLAN AND ELEVATION (DRAFT)

NOTES

1. See Standard Drawing E 706-TTFT-02 for sections.
2. See Standard Drawing E 706-TTFT-03 for reinforcing-bar diagrams and bill of materials.
3. Holes for attachment of guardrail transition type TGB. See Standard Drawing E 601-TTGB-01 for details.
4. RCBA extension for bridge railing transition type TFT. See Standard Drawing E 706-TBAE-02 for details.

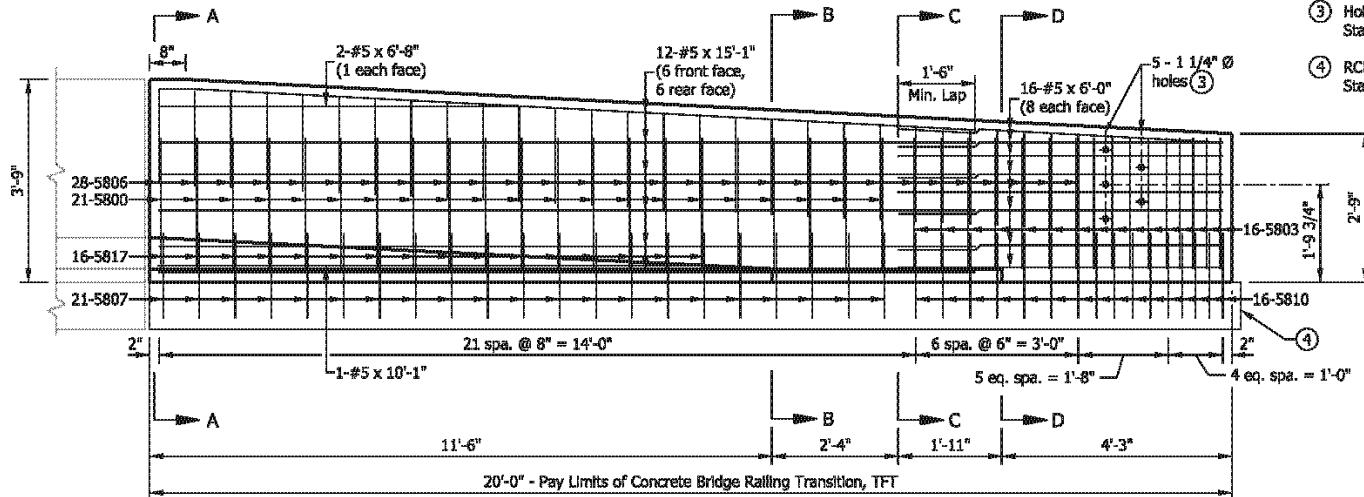

ELEVATION




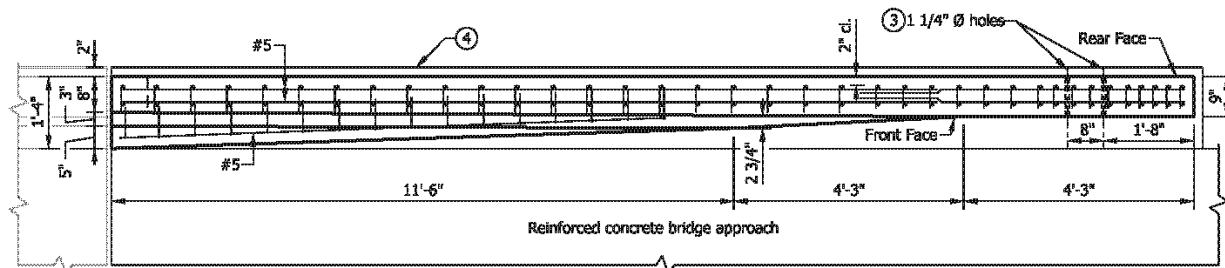


PLAN

INDIANA DEPARTMENT OF TRANSPORTATION	
CONCRETE BRIDGE RAILING TRANSITION TFT PLAN AND ELEVATION	
SEPTEMBER 2011	
STANDARD DRAWING NO. E 706-TTFT-01	
DESIGN STANDARDS ENGINEER	DATE
CHIEF HIGHWAY ENGINEER	DATE
DESIGN STANDARDS ENGINEER	

REVISION TO STANDARD DRAWINGS

706-TTFT-02 CONCRETE BRIDGE RAILING TRANSITION, TFT (DRAFT)

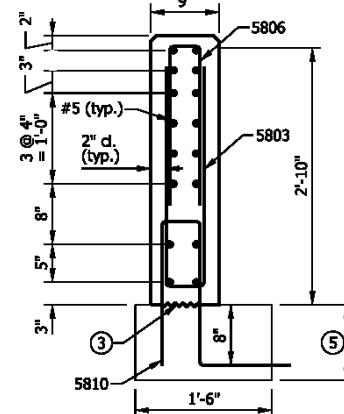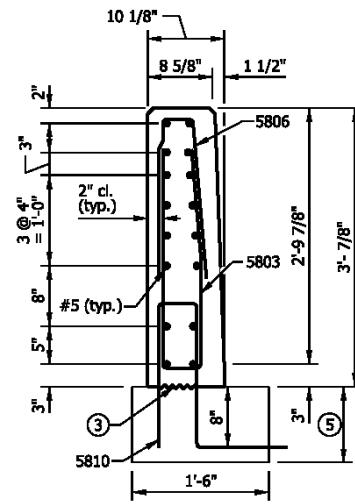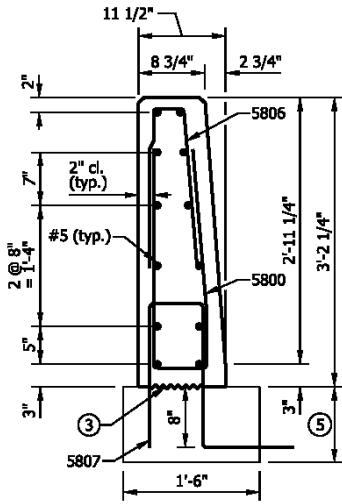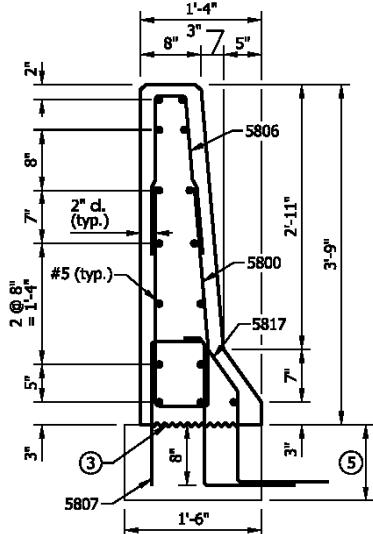

NOTES







1. See Standard Drawing E 706-TTFT-01 for elevation and plan.
2. All chamfered edges shall be 3/4".
- ③ Construction joint type A. See Standard Drawing E 702-CJTA-01 for details.
4. See Standard Drawing E 706-TTFT-03 for reinforcing-bar diagrams.
- ⑤ RCBA extension for bridge railing transition type TFT. See Standard Drawing E 706-TBAE-02 for details.

INDIANA DEPARTMENT OF TRANSPORTATION	
CONCRETE BRIDGE RAILING TRANSITION, TFT	
SEPTEMBER 2006	
STANDARD DRAWING NO.	E 706-TTFT-02
DESIGN STANDARDS ENGINEER	DATE
CHIEF HIGHWAY ENGINEER	DATE
DESIGN STANDARDS ENGINEER	

Item No.02 03/15/12 (2012 SS)(contd.)  
 Mr. Strain  
 Date: 03/15/12

REVISION TO STANDARD DRAWINGS

706-TTFT-03 CONCRETE BRIDGE RAILING TRANSITION TYPE TFT (DRAFT)

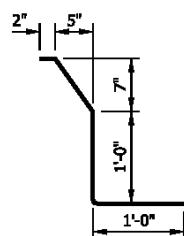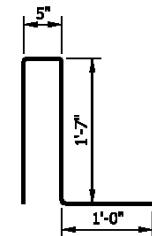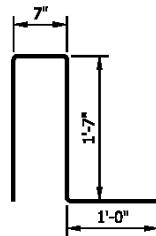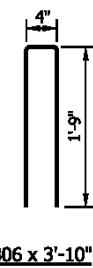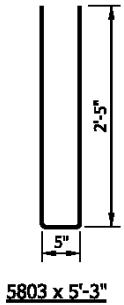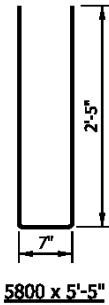

NOTE

1. See Standard Drawing E 703-BRST-01 for reinforcing-bar bending details and notes.

BILL OF MATERIALS		
Quantities are for one concrete bridge railing transition type TFT		
EPOXY-COATED REINFORCING STEEL		
Mark / Size	No. of Bars	Weight
5800	21	
5803	16	
5806	28	
5807	21	
5810	16	
5817	16	
#5 x 15'-1"	12	
#5 x 10'-1"	1	
#5 x 6'-8"	2	
#5 x 6'-0"	16	
Total Epoxy-Coated Reinforcing Steel		862 LBS
MISCELLANEOUS		
Concrete, Class C	2.0 CYS	
Surface Seal	13.4 SYS	

INDIANA DEPARTMENT OF TRANSPORTATION

CONCRETE BRIDGE RAILING  
TRANSITION TYPE TFT

SEPTEMBER 2011

STANDARD DRAWING NO. E 706-TTFT-03


DESIGN STANDARDS ENGINEER DATE

CHIEF HIGHWAY ENGINEER DATE

DESIGN STANDARDS ENGINEER


REVISION TO STANDARD DRAWINGS

EXISTING 706-TTTX-01 CONCRETE BRIDGE RAILING TRANSITION, TTX (WITH MARKUPS)

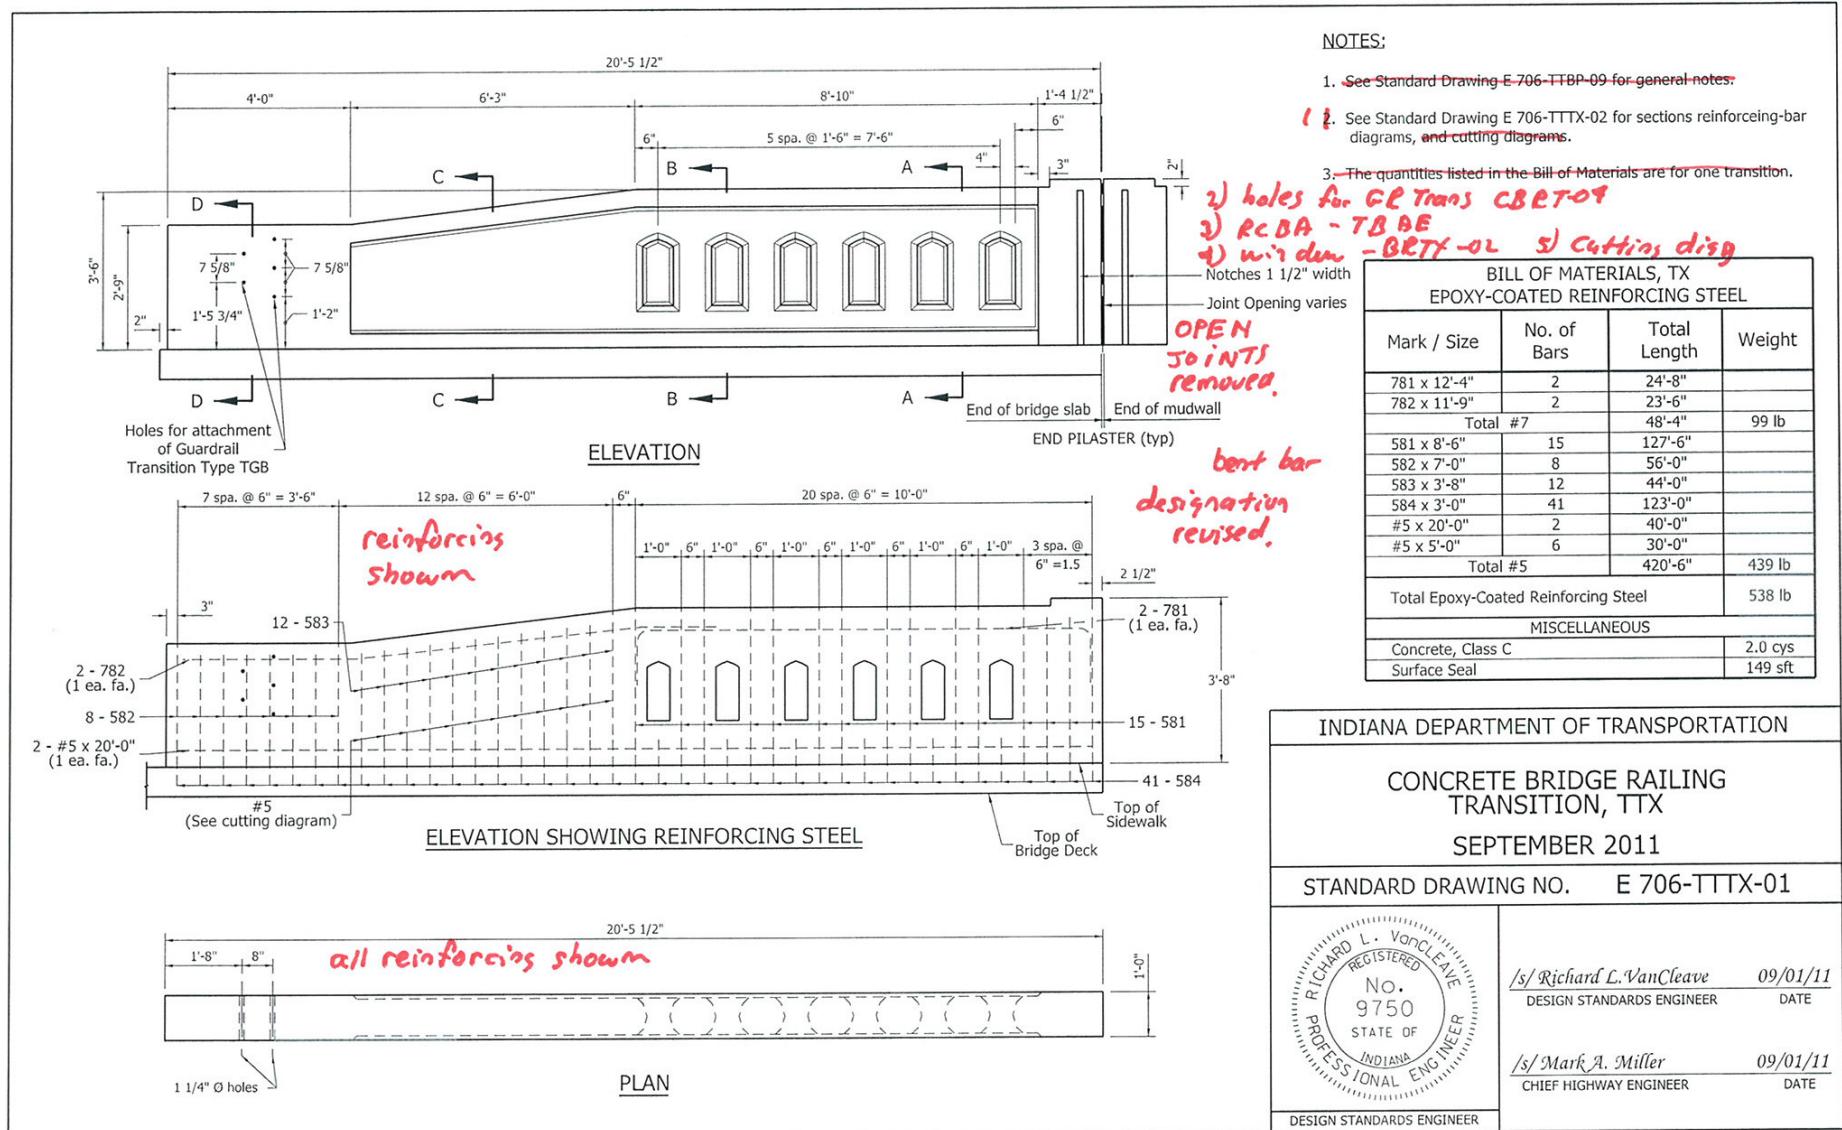


REVISION TO STANDARD DRAWINGS

EXISTING 706-TTTX-02 CONCRETE BRIDGE RAILING TRANSITION, TTX (WITH MARKUPS)

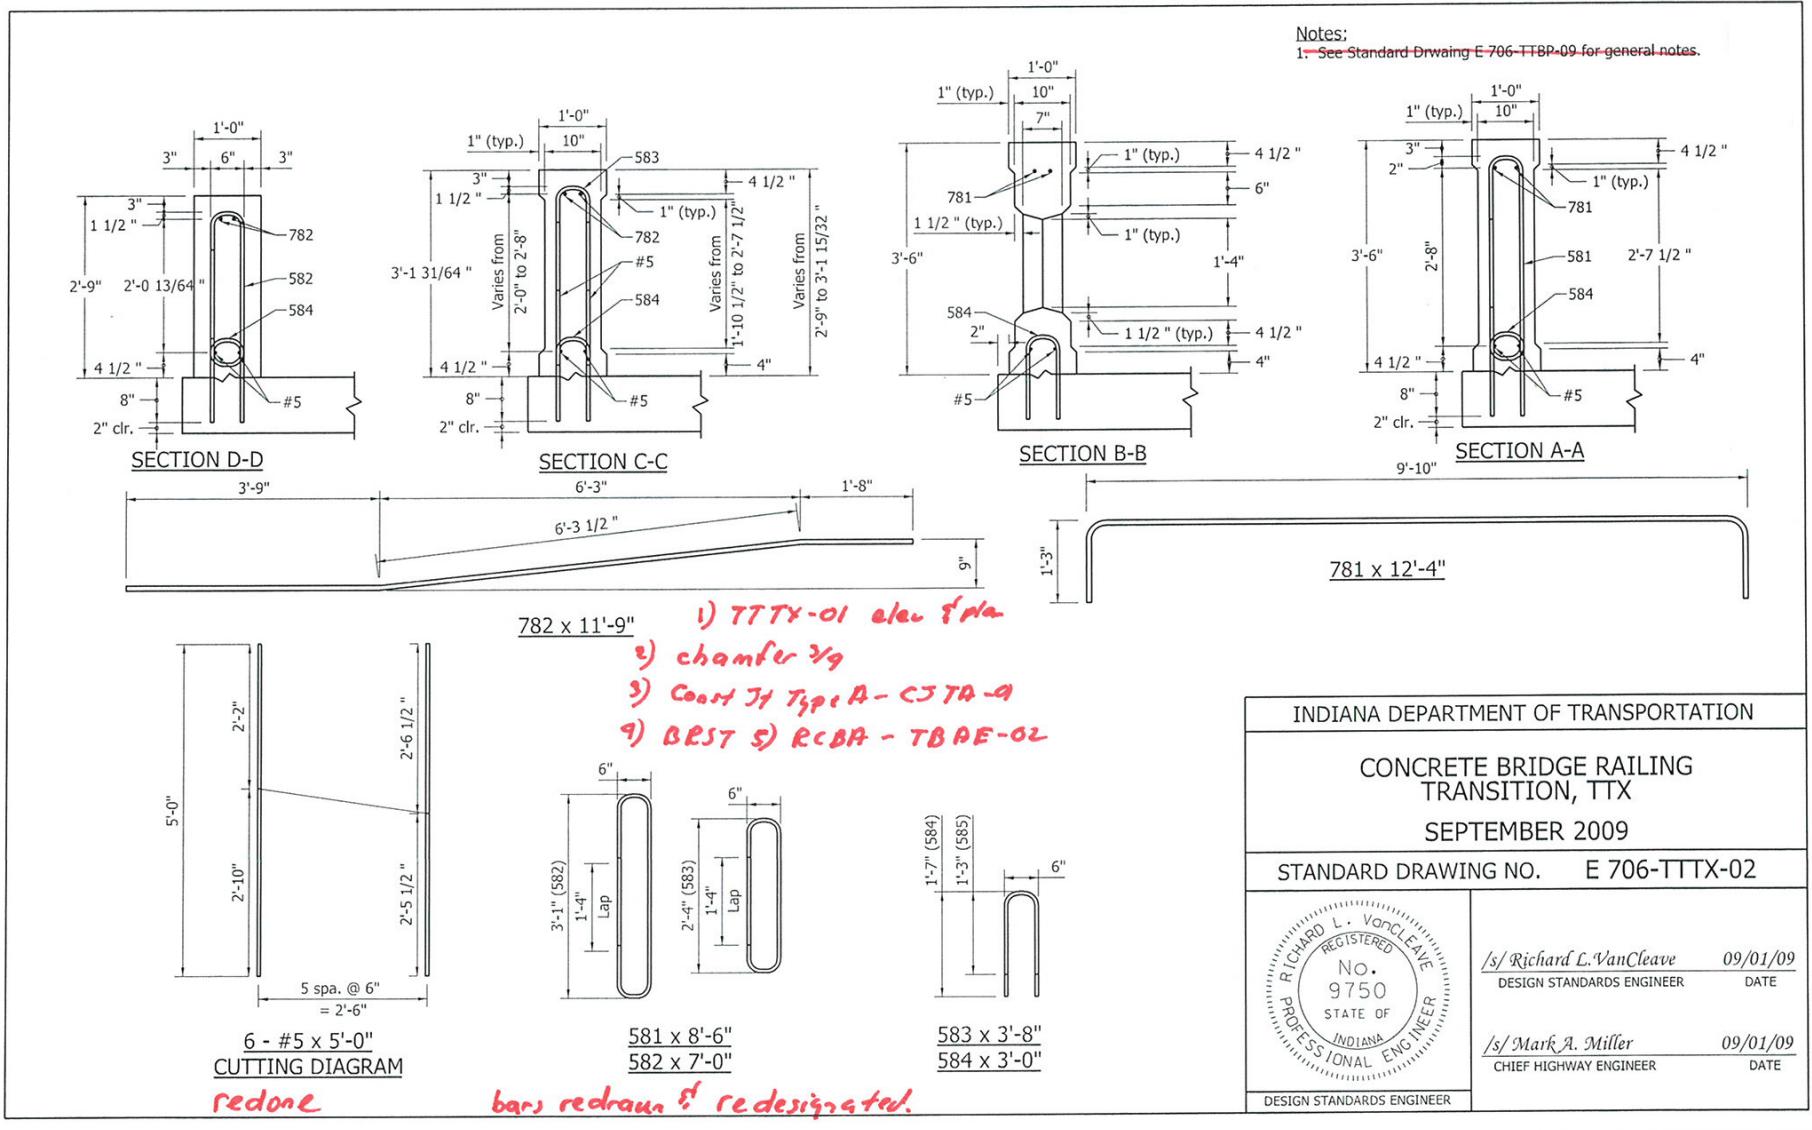


REVISION TO STANDARD DRAWINGS

706-TTTX-01 CONCRETE BRIDGE RAILING TRANSITION, TTX (DRAFT)

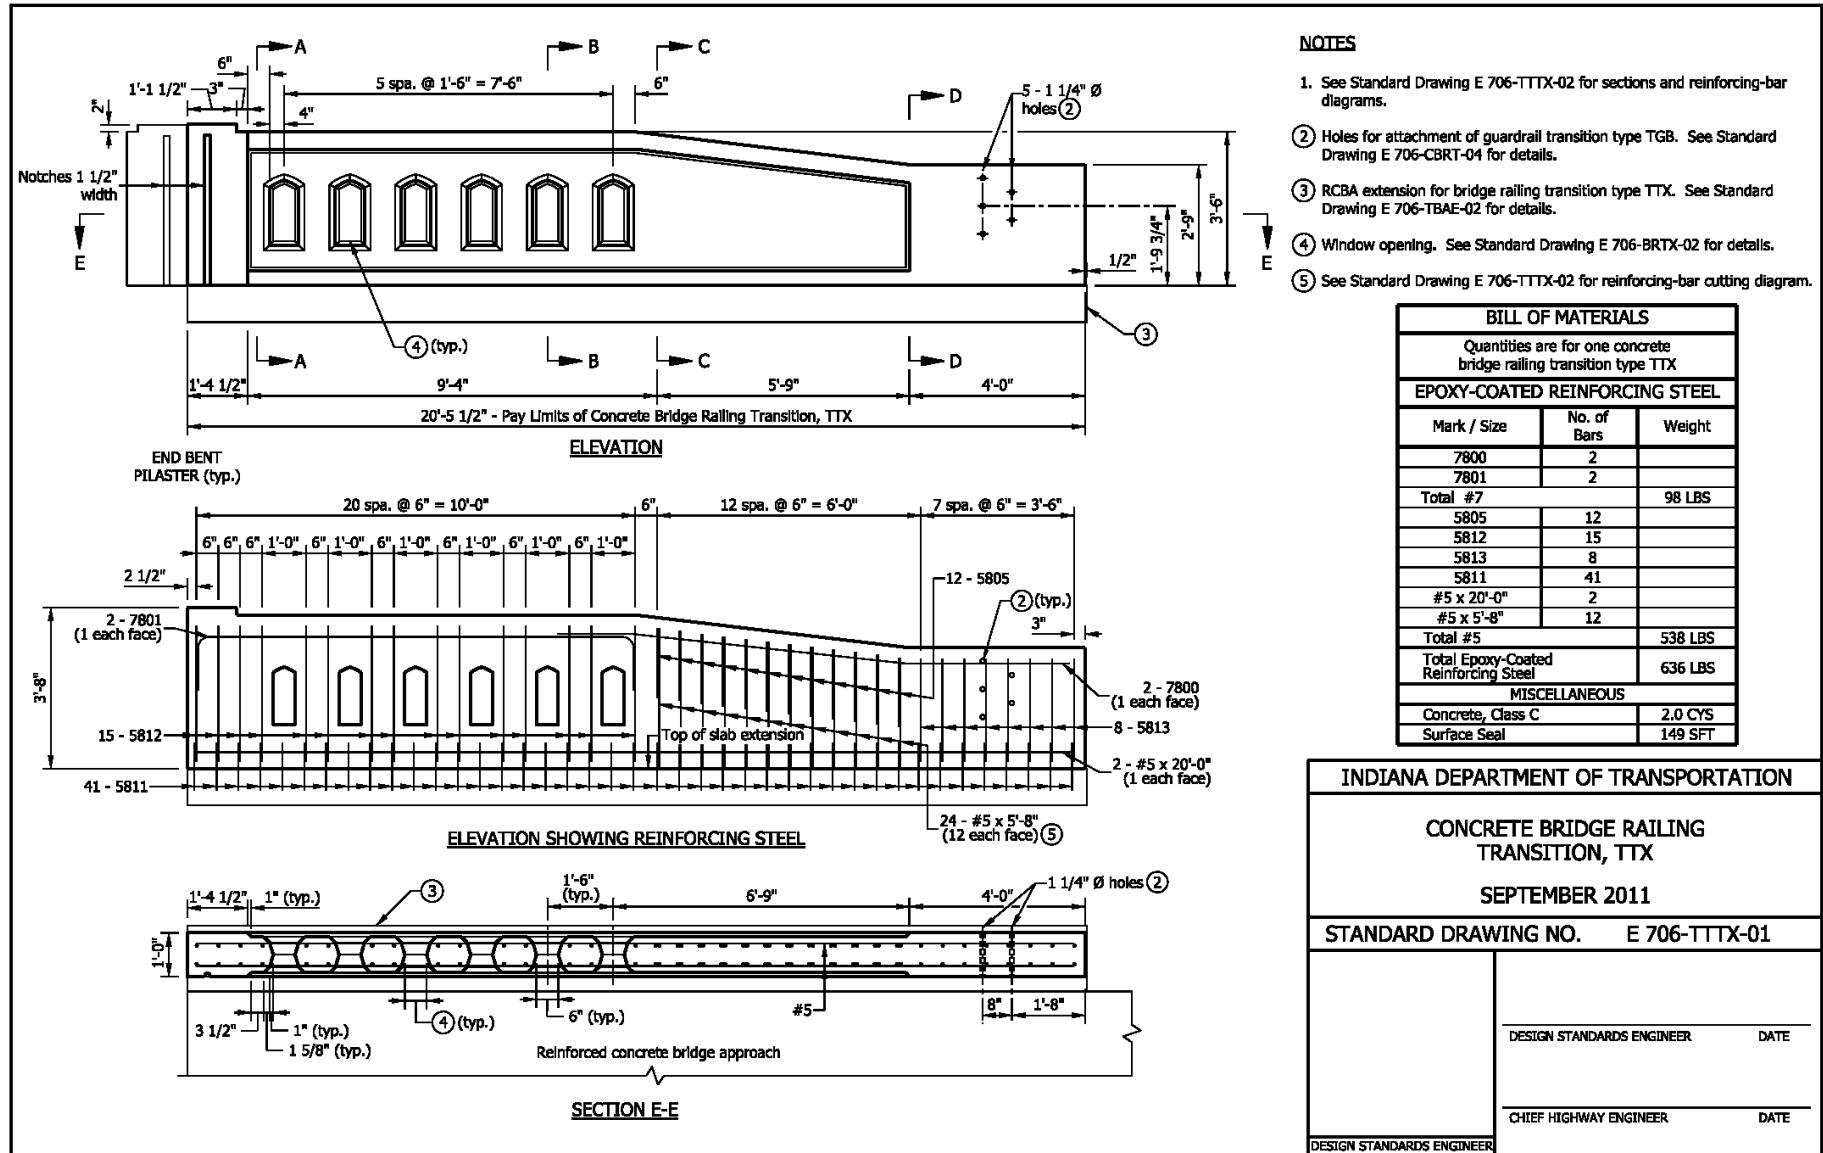



REVISION TO STANDARD DRAWINGS

706-TTTX-02 CONCRETE BRIDGE RAILING TRANSITION, TTX (DRAFT)

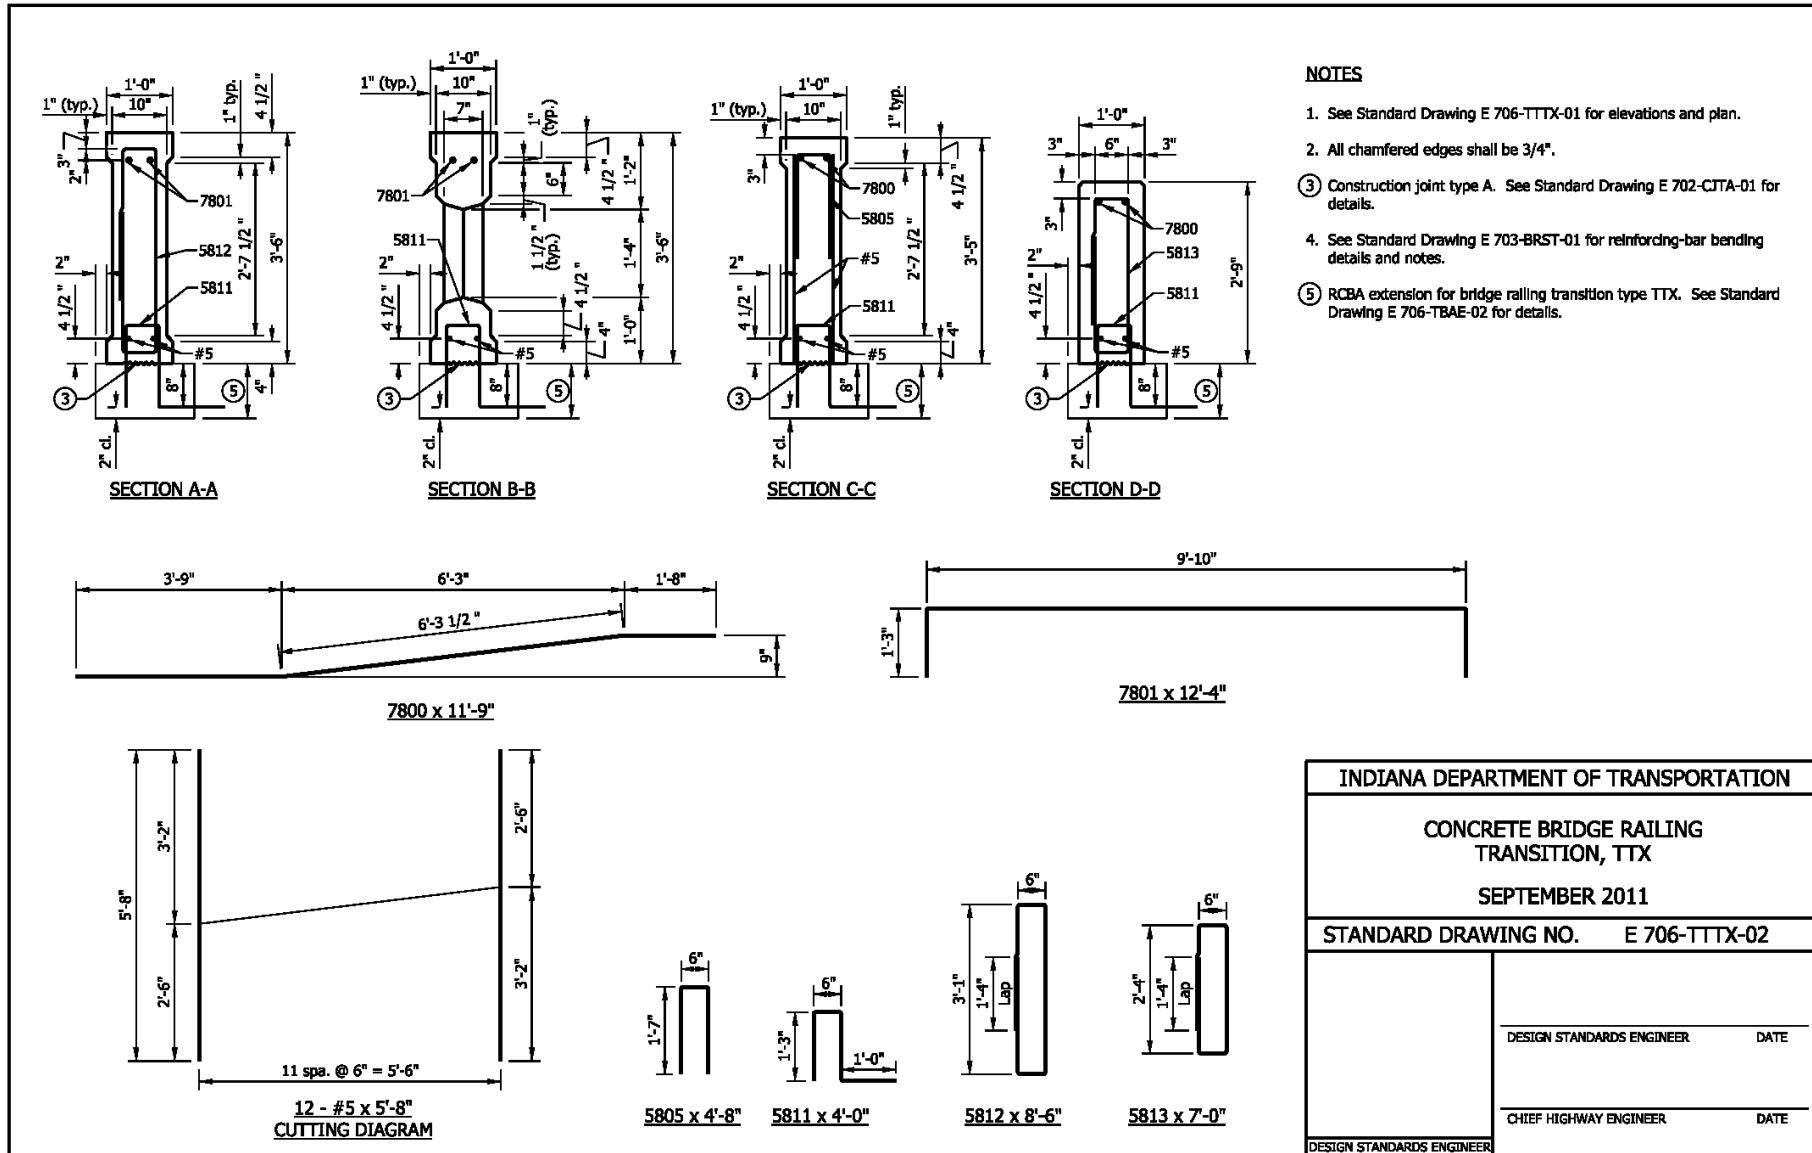

REVISION TO STANDARD DRAWINGS

EXISTING 706-TWBC-01 CONCRETE BRIDGE RAILING TRANSITION TYPE WBC (WITH MARKUPS)

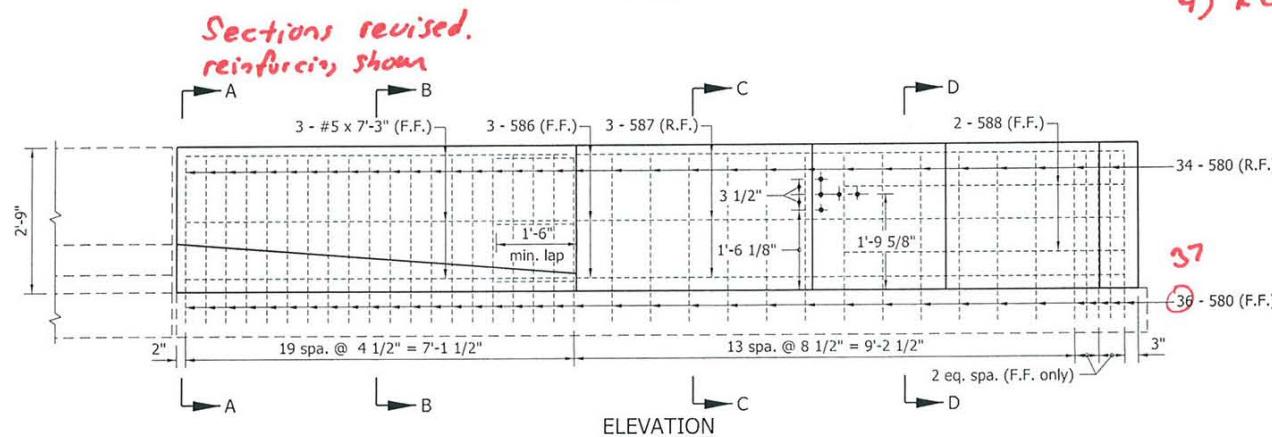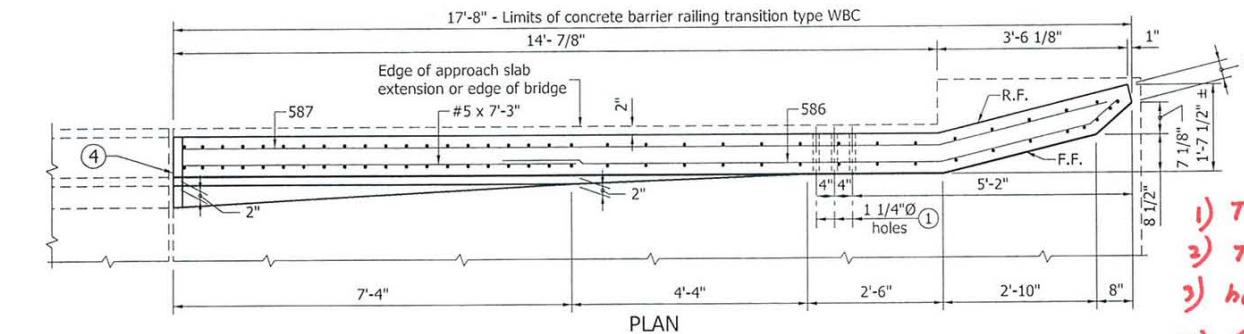

NOTES:

- ① See Standard Drawing E 706-CBRT-02 for details of guardrail transition type WGB attachment.
2. See Standard Drawing E 706-TWBC-02 for Section A-A, B-B, C-C and D-D and Drawing E 706-TWBC-03 for reinforcement and bill of materials.
3. See Standard Drawing E 706-TASE-05 for General Notes.

2 & 3 combined  
Ext indus added.


- 1) TWFC-02 for sections
- 2) TWFC-03 reinforcing diag
- 3) holes or trans CBRT-02
- 4) RCBA-TBAE-03

2'-9" COMMON HEIGHT W-BEAM/  
CONCRETE BRIDGE RAILING TRANSITION


INDIANA DEPARTMENT OF TRANSPORTATION	
CONCRETE BRIDGE RAILING TRANSITION TYPE WBC	
SEPTEMBER 2011	
STANDARD DRAWING NO.	E 706-TWBC-01
 DESIGN STANDARDS ENGINEER	09/01/11
/s/ Richard L. VanCleave DESIGN STANDARDS ENGINEER	DATE
/s/ Mark A. Miller CHIEF HIGHWAY ENGINEER	09/01/11
DESIGN STANDARDS ENGINEER	

REVISION TO STANDARD DRAWINGS


EXISTING 706-TWBC-02 CONCRETE BRIDGE RAILING TRANSITION TYPE WBC (WITH MARKUPS)

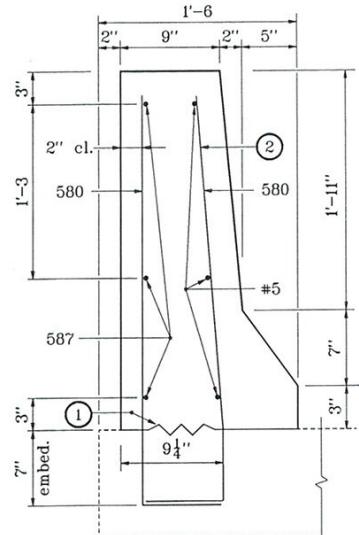


SECTION A-A

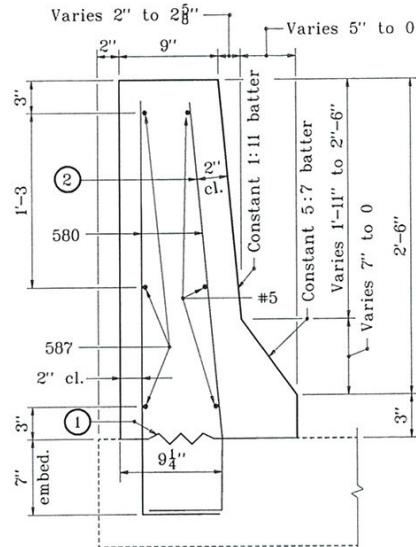

SECTION B-B

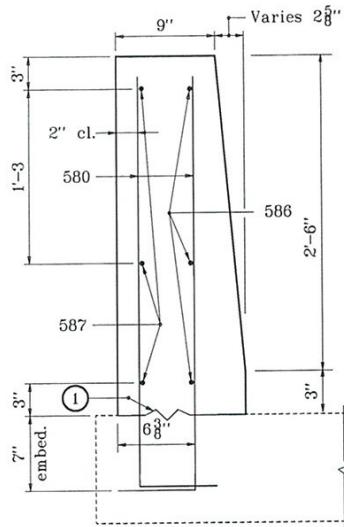

SECTION C-C

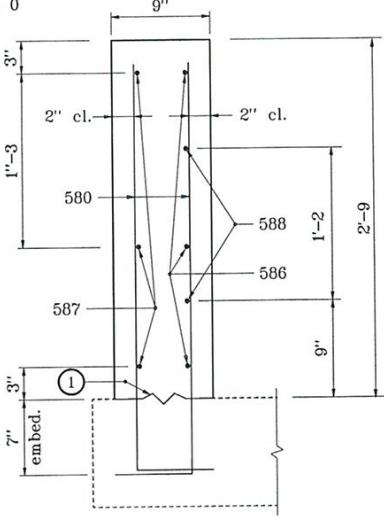

SECTION D-D

NOTES :

- (1) Type A construction joint.
- (2) These bars shall be field bent to provide 2" clearance along the batter (constant 1:1), front face bridge rail.

1) See Standard Drawing E 706-TWBC-01 for Plan and Elevation.

**TWFC**


- 2) Chamfer 3/4
- 3) Cont JNT - CJTA
- 4) TWFC-03 for bar diag
- 5) RCBA - TBAE-03
- 6) Bar bending for clearance
- 7, 8) batter call outs

INDIANA DEPARTMENT OF TRANSPORTATION	
CONCRETE BRIDGE RAILING	
TRANSITION TYPE <b>WBC</b>	
SEPTEMBER 2001 <b>WFC</b>	
STANDARD DRAWING NO. E 706-TWBC-02	
<b>TWFC</b> 	
/s/ Anthony L. Uremovich 9-04-01 DESIGN STANDARDS ENGINEER DATE  /s/ Firooz Zandi 9-04-01 CHIEF HIGHWAY ENGINEER DATE	
DESIGN STANDARDS ENGINEER	

Item No.02 03/15/12 (2012 SS)(contd.)  
 Mr. Strain  
 Date: 03/15/12

REVISION TO STANDARD DRAWINGS

EXISTING 706-TWBC-03 CONCRETE BRIDGE RAILING TRANSITION TYPE WBC (WITH MARKUPS)

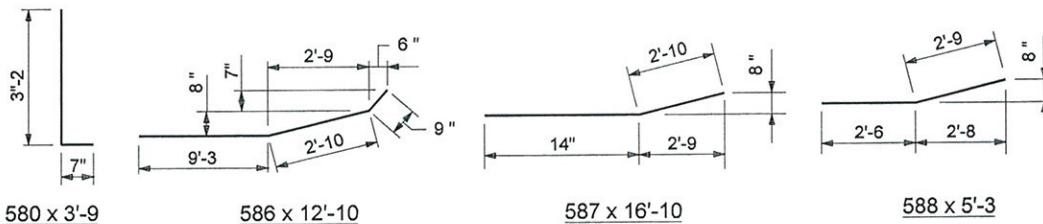

reinforcing drawn to scale  
 bent bars redesignated.

B:II  
 revised


BILL OF MATERIALS			
These quantities are for one concrete bridge railing transition type WBC. The concrete quantity is provided for information only and is not the pay item.			
<b>EPOXY COATED REINFORCING STEEL</b>			
Size & type	No. of Bars	Length ft-in	Weight lb
580	68	3'-9	
586	3	12'-10	
587	3	16'-10	
588	2	5'-3	
#5	3	7'-3	
Total Epoxy Coated Steel			393
<b>MISCELLANEOUS</b>			
Concrete, Class C (yd <sup>3</sup> )		1.6	
Surface Seal (ft <sup>2</sup> )		113	

INDIANA DEPARTMENT OF TRANSPORTATION	
CONCRETE BRIDGE RAILING TRANSITION TYPE WBC	
MARCH 2006 <b>TWFC</b>	
STANDARD DRAWING NO. E 706-TWBC-03	
 <small>PROFESSIONAL ENGINEER</small> <small>REGISTERED INDIANA</small> <small>Richard L. VanCleave</small> <small>NO. 9750</small> <small>STATE OF INDIANA</small> <small>PROFESSIONAL ENGINEER</small> <small>DESIGN STANDARDS ENGINEER</small>	<small>3-01-06</small> <small>Richard L. VanCleave</small> <small>DESIGN STANDARDS ENGINEER</small> <small>3-01-06</small> <small>Richard K. Smulzer</small> <small>CHIEF HIGHWAY ENGINEER</small> <small>3-01-06</small>

Item No.02 03/15/12 (2012 SS)(contd.)  
Mr. Strain  
Date: 03/15/12


REVISION TO STANDARD DRAWINGS

EXISTING 706-TWBC-04 CONCRETE BRIDGE RAILING TRANSITION TYPE WGB (PROPOSED TO DELETE)

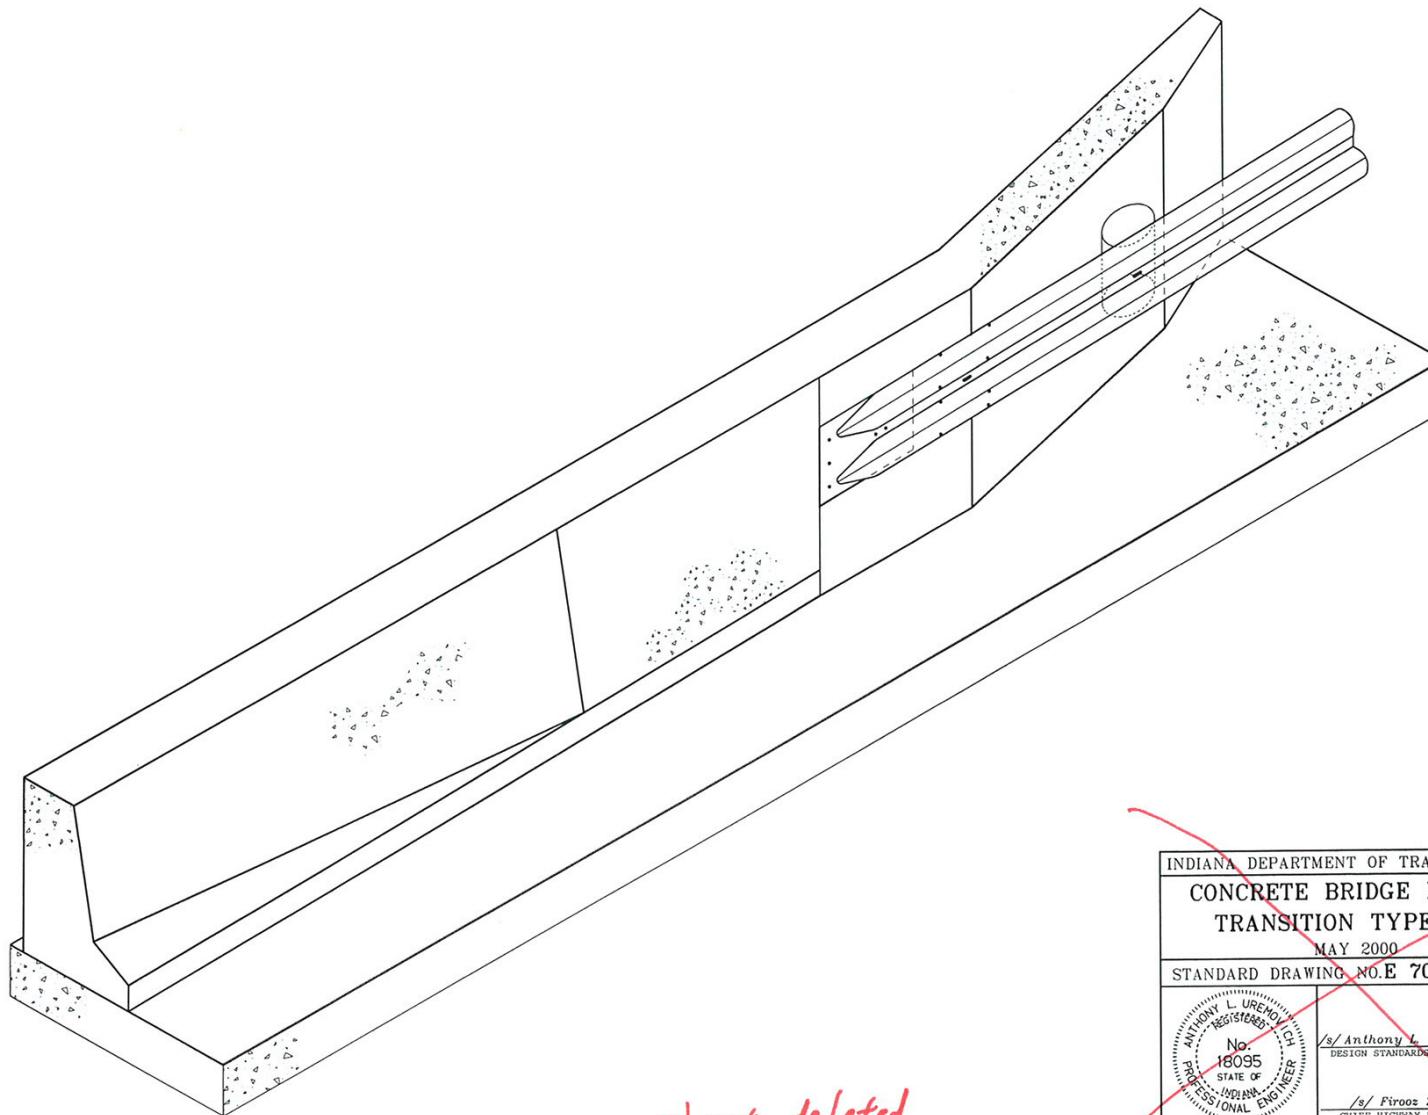


REVISION TO STANDARD DRAWINGS

706-TWFC-01 CONCRETE BRIDGE RAILING TRANSITION TYPE WFC (DRAFT)

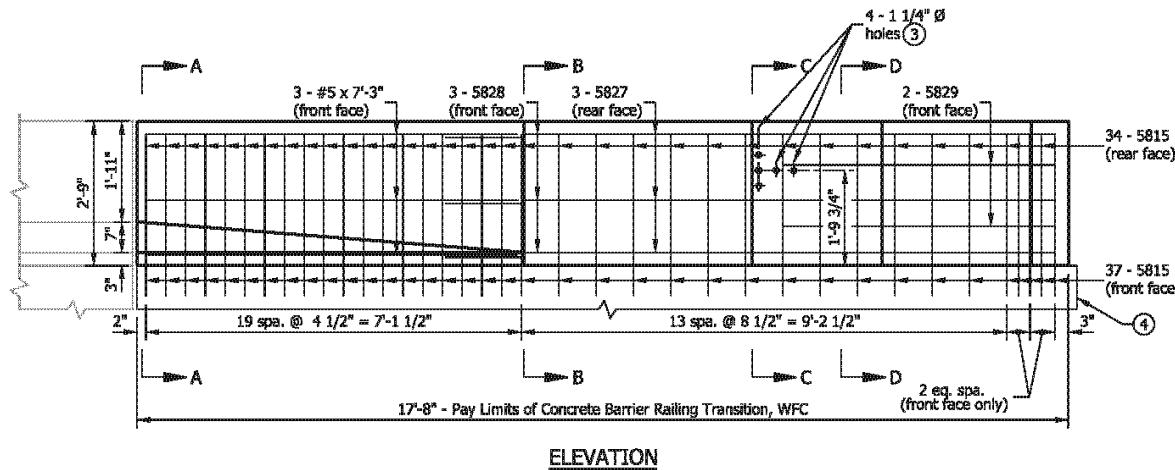

NOTES


1. See Standard Drawing E 706-TWFC-02 for sections.
2. See Standard Drawing E 706-TWFC-03 for reinforcing-bar diagrams and bill of materials.
- ③ Holes for attachment of guardrail transition type WGB. See Standard Drawing E 706-CBRT-02 for details.
- ④ RCBA extension for bridge railing transition type WFC. See Standard Drawing E 706-TBAE-03 for details.

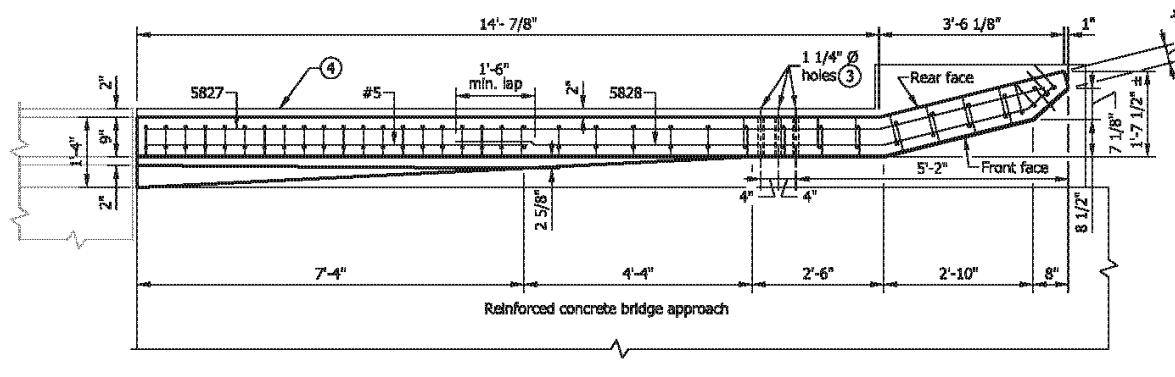


INDIANA DEPARTMENT OF TRANSPORTATION	
CONCRETE BRIDGE RAILING TRANSITION TYPE WFC	
SEPTEMBER 2011	
STANDARD DRAWING NO. E 706-TWFC-01	
DESIGN STANDARDS ENGINEER	DATE
CHIEF HIGHWAY ENGINEER	DATE
DESIGN STANDARDS ENGINEER	

REVISION TO STANDARD DRAWINGS


706-TWFC-02 CONCRETE BRIDGE RAILING TRANSITION TYPE WFC (DRAFT)

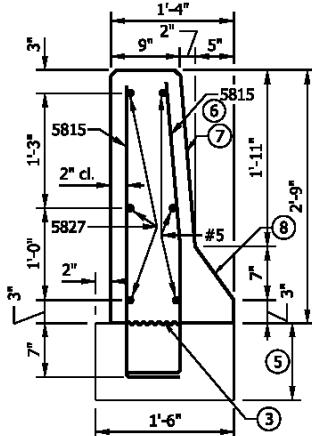


SECTION A-A

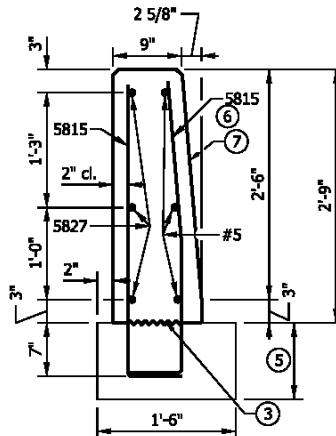

SECTION B-B

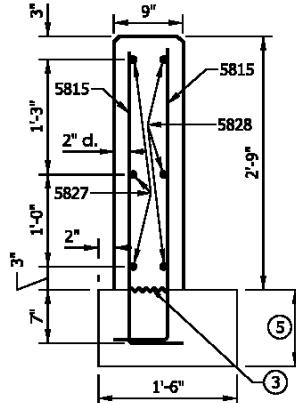

SECTION C-C

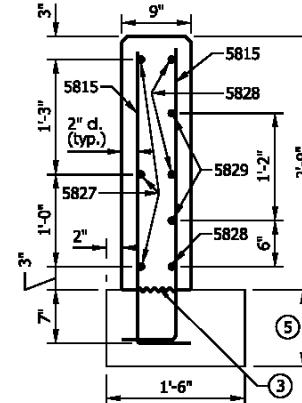

SECTION D-D

NOTES


1. See Standard Drawing E 706-TWFC-01 for elevation and plan.
2. All chamfered edges shall be 3/4".
- ③ Construction joint type A. See Standard Drawing E 702-CJTA-01 for details.
4. See Standard Drawing E 706-TWFC-03 for reinforcing-bar diagrams.
- ⑤ RCBA extension for bridge railing transition type WFC. See Standard Drawing E 706-TBAE-03 for details.
- ⑥ These bars shall be field bent to provide 2" clearance along the front face batter.
- ⑦ Constant 1:11 batter.
- ⑧ Constant 5:7 batter.

INDIANA DEPARTMENT OF TRANSPORTATION	
CONCRETE BRIDGE RAILING TRANSITION TYPE WFC	
STANDARD DRAWING NO.	E 706-TWFC-02
DESIGN STANDARDS ENGINEER	DATE
CHIEF HIGHWAY ENGINEER	DATE
DESIGN STANDARDS ENGINEER	

Item No.02 03/15/12 (2012 SS)(contd.)  
 Mr. Strain  
 Date: 03/15/12

REVISION TO STANDARD DRAWINGS

706-TWFC-03 CONCRETE BRIDGE RAILING TRANSITION TYPE WFC (DRAFT)

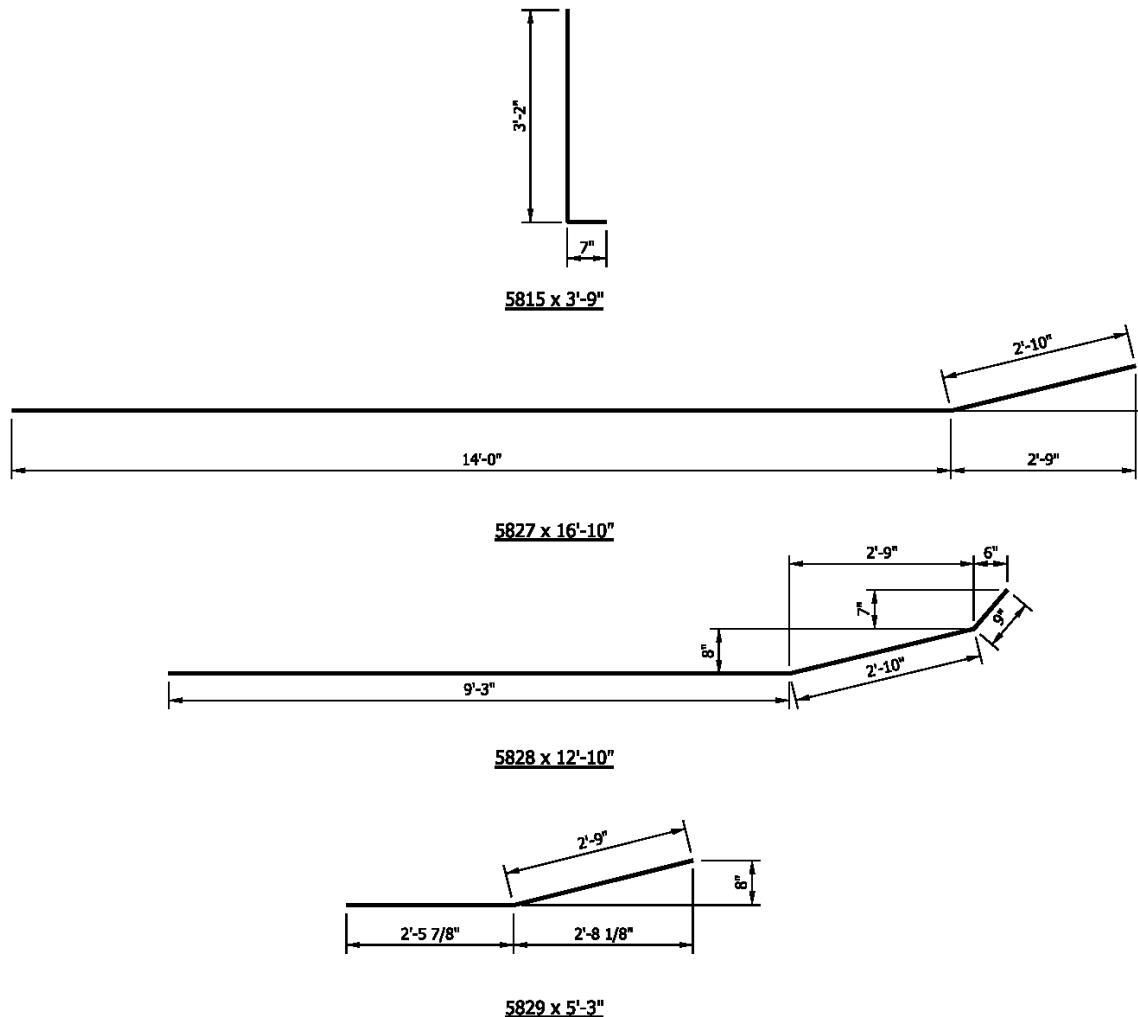

NOTE

1. See Standard Drawing E 703-BRST-01 for reinforcing-bar bending details and notes.

BILL OF MATERIALS		
Quantities are for one concrete bridge railing transition type WFC		
EPOXY-COATED REINFORCING STEEL		
Mark / Size	No. of Bars	Weight
5815	71	
5827	3	
5828	3	
5829	2	
#5 x 7'-3"	3	
Total Epoxy-Coated Reinforcing Steel		404 LBS
MISCELLANEOUS		
Concrete, Class C	1.6 CYS	
Surface Seal	113 SYS	

INDIANA DEPARTMENT OF TRANSPORTATION	
CONCRETE BRIDGE RAILING TRANSITION TYPE WFC	
MARCH 2006	
STANDARD DRAWING NO.	E 706-TWFC-03
DESIGN STANDARDS ENGINEER	DATE
CHIEF HIGHWAY ENGINEER	DATE
DESIGN STANDARDS ENGINEER	

Item No.02 03/15/12 (2012 SS)(contd.)  
Mr. Strain  
Date: 03/15/12

REVISION TO STANDARD DRAWINGS  
EXISTING 7 (WITH MARKUPS)

---

THIS PAGE LEFT INTENTIONALLY BLANK

AGENDA ITEM 02

Item No.02 03/15/12 (2012 SS)(contd.)  
Mr. Strain  
Date: 03/15/12

REVISION TO STANDARD DRAWINGS

706-CBRT-01 - 04; 706-TPBT-01 - 09; 706-TTBC-01 - 03;  
706-TTBP-01 - 09; 706-TTBT-01 - 02; 706-TTTX-01 - 02; 706-TWBC-01 - 04

Motion:	Action:
Second:	<input type="checkbox"/> Passed as Submitted <input type="checkbox"/> Passed as Revised <input type="checkbox"/> Withdrawn
Ayes:	
Nays:	
Standard Specifications Sections affected:	<input type="checkbox"/> 20 Standard Specifications Book <input type="checkbox"/> Revise Pay Items List  <input type="checkbox"/> Create RSP (No. ____) Effective ____ Letting RSP Sunset Date: ____
NONE	
Recurring Special Provision affected:	 <input type="checkbox"/> Revise RSP (No. ____) Effective ____ Letting RSP Sunset Date: ____
NONE	
Standard Sheets affected:	 <input type="checkbox"/> Standard Drawing Effective ____ <input type="checkbox"/> Create RPD (No. ____) Effective ____ Letting <input type="checkbox"/> Technical Advisory
706-CBRT-01 - 04 706-TPBT-01 - 09 706-TTBC-01 - 03 706-TTBP-01 - 09 706-TTBT-01 - 02 706-TTTX-01 - 02 706-TWBC-01 - 04	
Design Manual Sections affected:	 <input type="checkbox"/> GIFE Update Req'd.? Y ____ N ____ By ____ Addition or ____ Revision
NONE	
GIFE Sections cross-references:	 <input type="checkbox"/> Frequency Manual Update Req'd? Y ____ N ____ By ____ Addition or ____ Revision
NONE	
	Received FHWA Approval? ____