

SPECIFICATIONS, SPECIAL PROVISIONS AND STANDARD DRAWINGS  
REVISION TO STANDARD DRAWINGS

PROPOSAL TO STANDARDS COMMITTEE

PROBLEM(S) ENCOUNTERED: In review of the bridge railing transition Standards inconsistencies were found in presentation and minor errors and omissions were present.

PROPOSED SOLUTION: The bridge railing Standards have been revised so that the Standards are consistent in detailing and overall presentation.

APPLICABLE STANDARD SPECIFICATIONS: none

APPLICABLE STANDARD DRAWINGS:

<u>Current Standard Drawing</u>	<u>Transition</u>	<u>Proposed Drawing Designation</u>
706-CBRT-01 thru 04		same
706-TPBT-01 thru 09	TF-2	706-TTTF-01 thru 04
706-TTBC-01 thru 03	FC	706-TTFC-01 thru 03
706-TTBP-01 thru 09	PF-1, PF-2, PS-1, PS-2	706-TTPP-01 thru 08
706-TTBT-01 thru 03	FT	706-TTFT-01 thru 03
706-TTXX-01 thru 04	TX	same
706-TWBC-01 thru 03	W-Beam	706-TWFC-01 thru 03
706-TWBC-04		to delete

APPLICABLE DESIGN MANUAL SECTION: None

APPLICABLE SECTION OF GIFE: None

APPLICABLE RECURRING SPECIAL PROVISIONS: None

PAY ITEMS AFFECTED: None

SPECIFICATIONS, SPECIAL PROVISIONS AND STANDARD DRAWINGS  

---

REVISION TO STANDARD DRAWINGS

Submitted By: Randy Strain

Title: INDOT Bridge Standard and Policy Engineer

Organization: INDOT

Phone Number: 232-3339

Date: Feb 14, 2012

APPLICABLE SUB-COMMITTEE ENDORSEMENT: none


FIRST DRAFT MINUTES ITEM 02

REVISION TO STANDARD DRAWINGS

EXISTING 706-CBRT-01 BRIDGE RAILING TRANSITION WBC OR TBC DETAILS AT END BENT (WITH MARKUPS)



*BJS-01 Does not exist*

*609-BRJT-01*

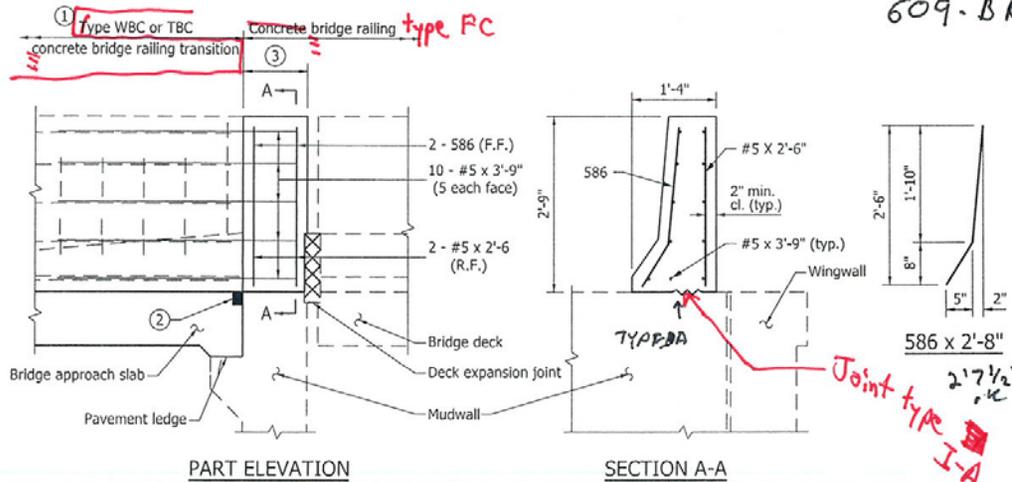

NOTES:

- ① See Standard Drawings E 706-TWBC-01 through -03 for concrete bridge railing transition type WBC details. See Standard Drawing E 706-TTBC-01 & 02 for concrete bridge railing transition type TBC details. *609-BRJT-01 through -03*
- ② See Standard Drawing E 724-BJTS-01 for type W joint details. *I-A*
- ③ This shall be part of the concrete bridge railing, but shall be poured with the concrete bridge-railing transition. The minimum length shall be equal to the width of the mudwall. See Standard Drawing E 706-BCBR-01 for bridge railing type FC dimensions.

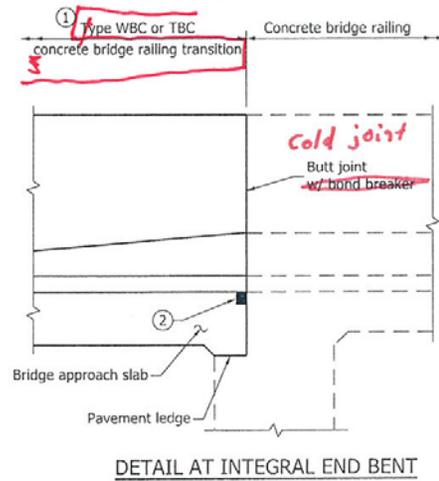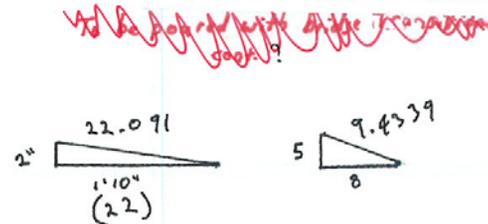


INDIANA DEPARTMENT OF TRANSPORTATION	
BRIDGE RAILING TRANSITION WBC OR TBC DETAILS AT END BENT	
SEPTEMBER 2011	
STANDARD DRAWING NO. E 706-CBRT-01	
	/s/ Richard L. VanCleave 09/01/11 DESIGN STANDARDS ENGINEER DATE
	/s/ Mark A. Miller 09/01/11 CHIEF HIGHWAY ENGINEER DATE

REVISION TO STANDARD DRAWINGS

EXISTING 706-CBRT-02 BRIDGE RAILING TRANSITION WBC ATTACHMENT OF GUARDRAIL (WITH MARKUPS)

*we have enough shear force/capacity here to pull a large vessel*

*But the material is wrong!*

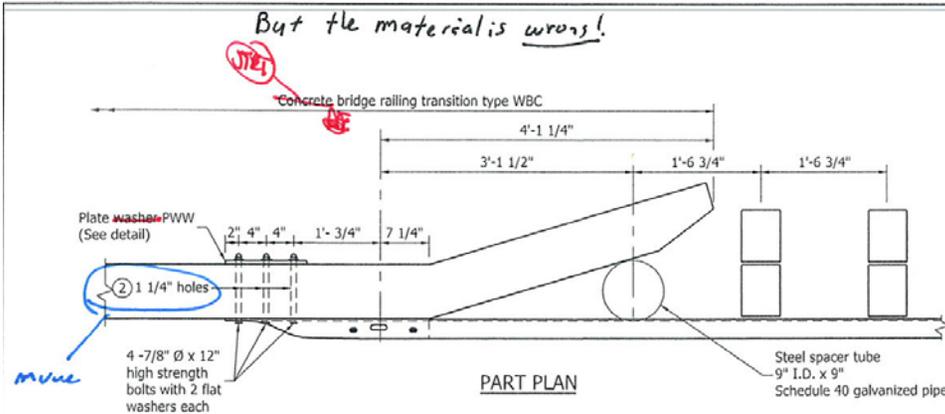

NOTES:

1. See Standard Drawing E 709-TWBC-01 for bridge railing transition type WBC. See Standard Drawings E 601-TWGB-01 through -03 for guardrail transition type WGB.

② These holes, intended for the connection of the guardrail transition type WGB to the end of the concrete bridge railing transition type WBC, shall be preformed.

*6 through -03 for concrete*

*preformed*

*type WBC*

*rewrite*

*bolts & plate should be salvaged*


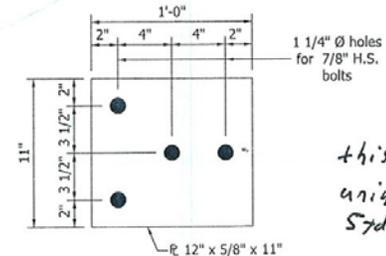


PLATE WASHER-PWW

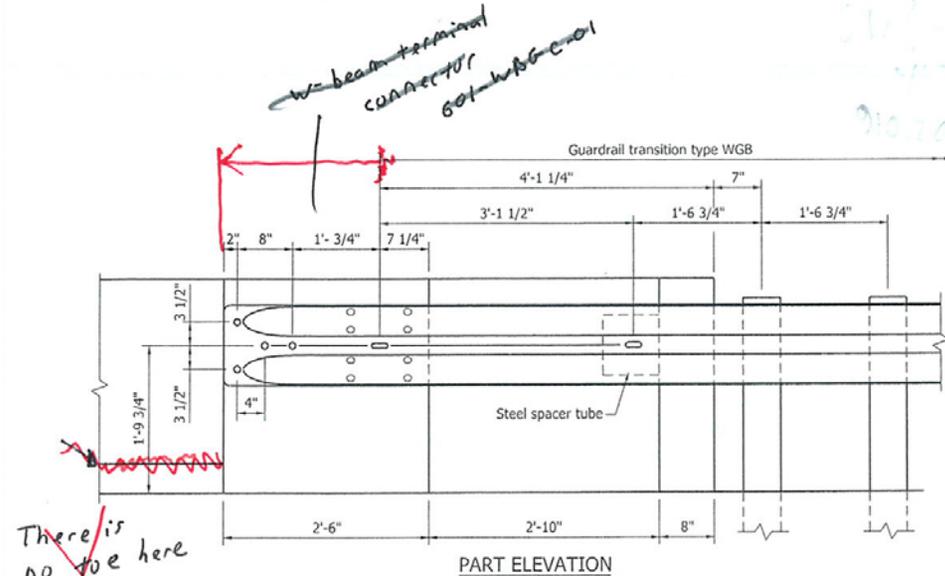


~~There is no toe here 706-TWBC-01~~

INDIANA DEPARTMENT OF TRANSPORTATION	
BRIDGE RAILING TRANSITION WBC ATTACHMENT OF GUARDRAIL	
SEPTEMBER 2011	
STANDARD DRAWING NO.	E 706-CBRT-02
	/s/ Richard L. VanCleave 09/01/11 DESIGN STANDARDS ENGINEER DATE
	/s/ Mark A. Miller 09/01/11 CHIEF HIGHWAY ENGINEER DATE

REVISION TO STANDARD DRAWINGS

EXISTING 706-CBRT-03 BRIDGE RAILING TRANSITION TBT DETAILS AT END BENT (WITH MARKUPS)


*recommend order to change*

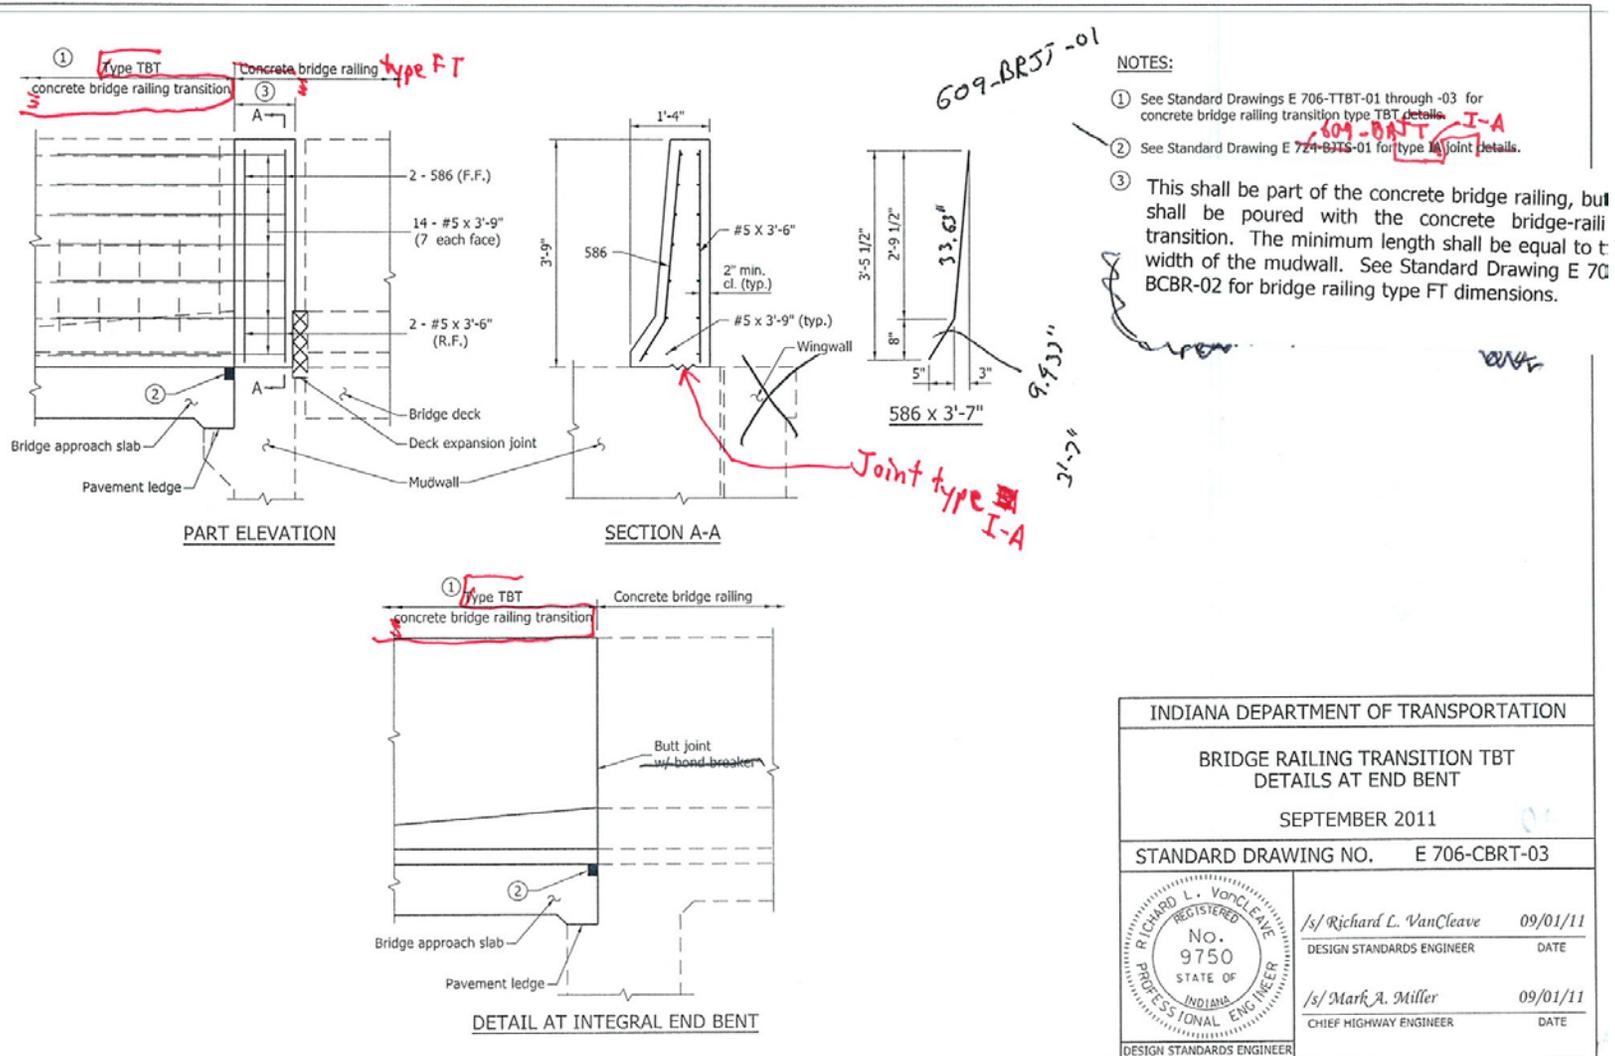

INDIANA DEPARTMENT OF TRANSPORTATION	
BRIDGE RAILING TRANSITION TBT DETAILS AT END BENT	
SEPTEMBER 2011	
STANDARD DRAWING NO.	E 706-CBRT-03
	/s/ Richard L. VanCleave 09/01/11 DESIGN STANDARDS ENGINEER DATE
	/s/ Mark A. Miller 09/01/11 CHIEF HIGHWAY ENGINEER DATE
DESIGN STANDARDS ENGINEER	


REVISION TO STANDARD DRAWINGS

EXISTING 706-CBRT-04 BRIDGE RAILING TRANSITION TBC OR TBT ATTACHMENT OF GUARDRAIL (WITH MARKUPS)

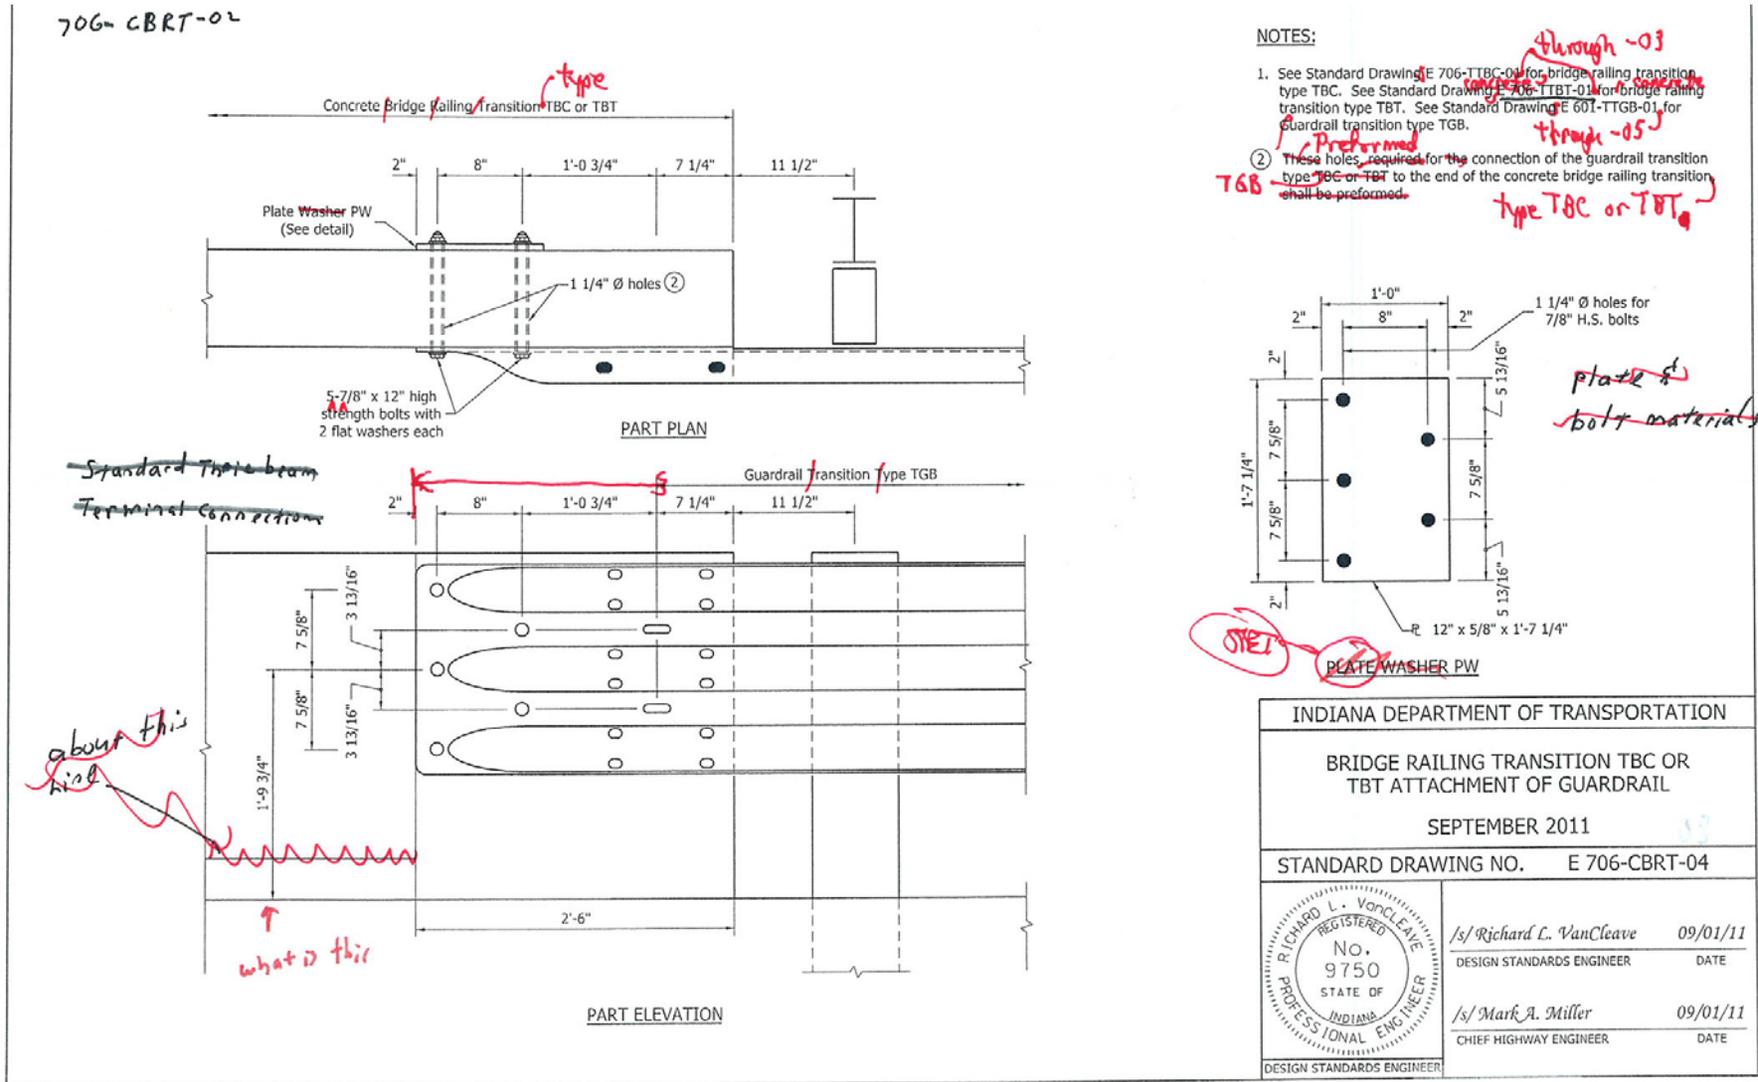

NOTES:

- See Standard Drawing E 706-TTBC-01 for bridge railing transition type TBC. See Standard Drawing E 706-TTBT-01 for bridge railing transition type TBT. See Standard Drawing E 607-TTGB-01 for Guardrail transition type TGB.
- These holes, required for the connection of the guardrail transition type TBC or TBT to the end of the concrete bridge railing transition shall be preformed.

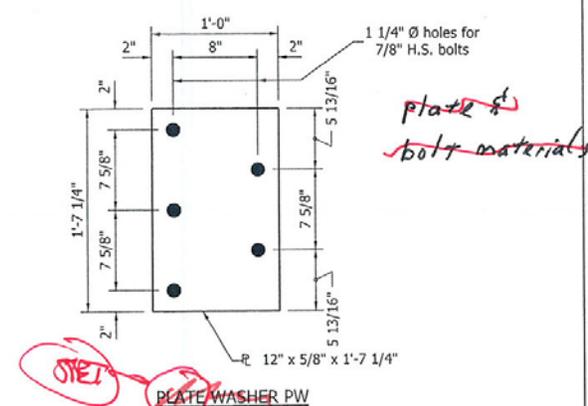


INDIANA DEPARTMENT OF TRANSPORTATION	
BRIDGE RAILING TRANSITION TBC OR TBT ATTACHMENT OF GUARDRAIL	
SEPTEMBER 2011	
STANDARD DRAWING NO.	E 706-CBRT-04
	/s/ Richard L. VanCleave 09/01/11 DESIGN STANDARDS ENGINEER DATE
	/s/ Mark A. Miller 09/01/11 CHIEF HIGHWAY ENGINEER DATE
DESIGN STANDARDS ENGINEER	

THREE-BEAM OR Comp  
 Shows Three Beam Terminal Connector

T GET TO T BRT


REVISION TO STANDARD DRAWINGS

706-CBRT-01 BRIDGE RAILING TRANSITION WFC OR TFC DETAILS AT END BENT (DRAFT)

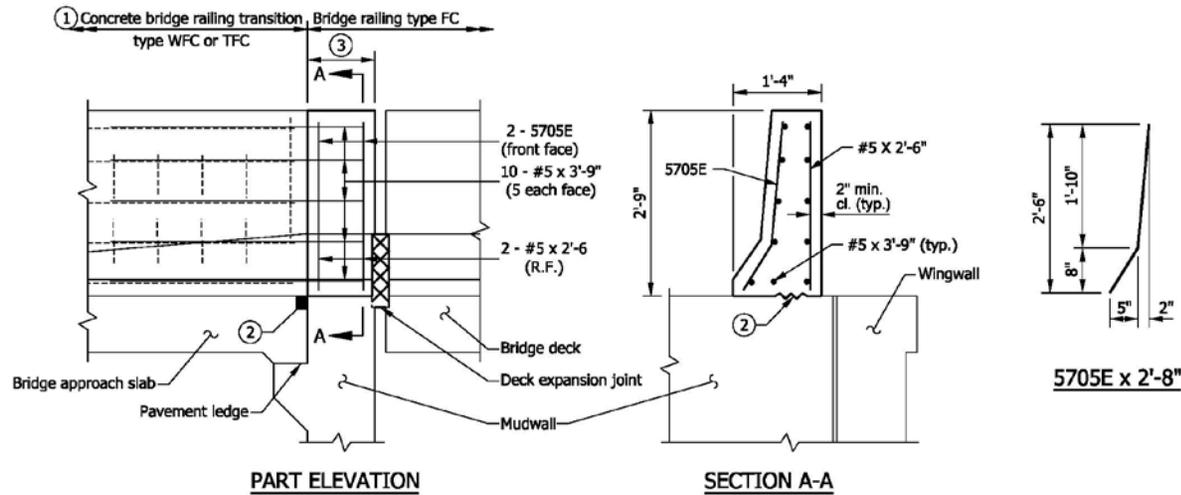

NOTES



- ① See Standard Drawings E 706-TWFC-01 through -03 for concrete bridge railing transition type WFC. See Standard Drawings E 706-TTFC-01 through -03 for concrete bridge railing transition type TFC.
- ② See Standard Drawing E 609-BRJT-01 for joint type I-A.
- ③ This shall be part of the concrete bridge railing, but it shall be poured with the concrete bridge-railing transition. The minimum length shall be equal to the width of the mudwall. See Standard Drawing E 706-GRSF-01 for bridge railing type FC dimensions.
4. See Standard Drawing E 703-BRST-01 for reinforcing-bar bending details and notes.

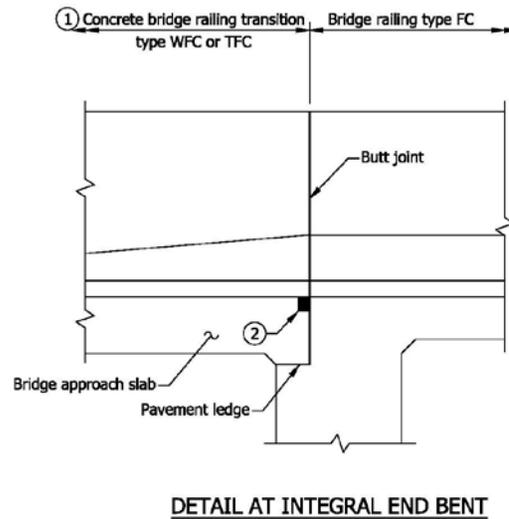

INDIANA DEPARTMENT OF TRANSPORTATION	
BRIDGE RAILING TRANSITION WFC OR TFC DETAILS AT END BENT	
SEPTEMBER 2012	
STANDARD DRAWING NO. E 706-CBRT-01	
	DESIGN STANDARDS ENGINEER _____ DATE _____
	CHIEF HIGHWAY ENGINEER _____ DATE _____
DESIGN STANDARDS ENGINEER _____	

REVISION TO STANDARD DRAWINGS

706-CBRT-02 BRIDGE RAILING TRANSITION WFC ATTACHMENT OF GUARDRAIL (DRAFT)

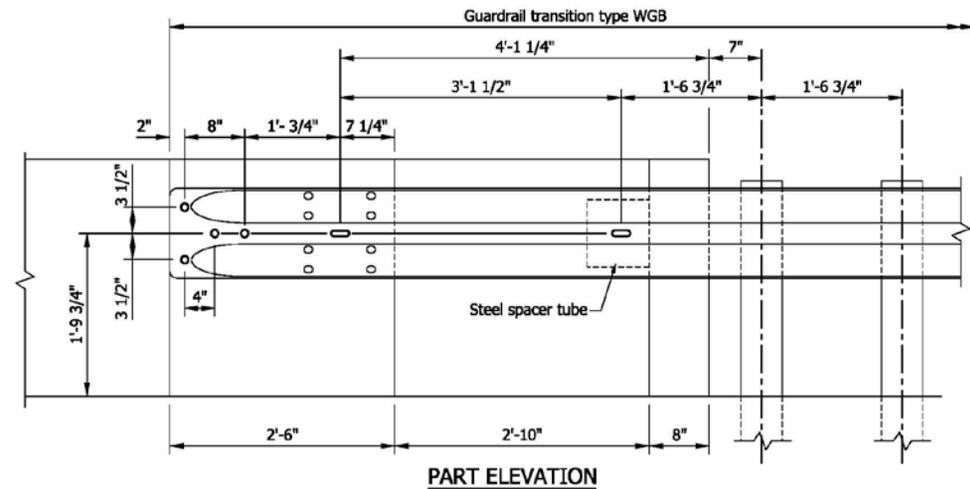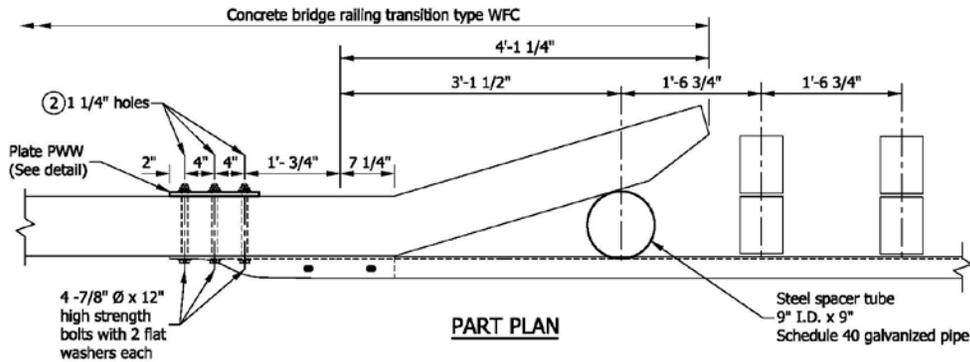

NOTES

1. See Standard Drawing E 706-TWFC-01 through -03 for concrete bridge railing transition type WFC. See Standard Drawings E 601-TWGB-01 through -03 for guardrail transition type WGB.
2. Preformed holes, for connection of the guardrail transition type WGB to the end of the concrete bridge railing transition type WFC.


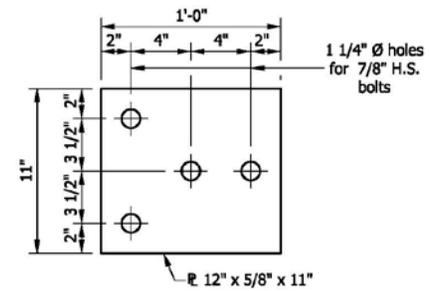


PLATE PWW

INDIANA DEPARTMENT OF TRANSPORTATION	
BRIDGE RAILING TRANSITION WFC ATTACHMENT OF GUARDRAIL	
SEPTEMBER 2012	
STANDARD DRAWING NO. E 706-CBRT-02	
DESIGN STANDARDS ENGINEER	DATE
CHIEF HIGHWAY ENGINEER	DATE
DESIGN STANDARDS ENGINEER	


REVISION TO STANDARD DRAWINGS

706-CBRT-03 BRIDGE RAILING TRANSITION TFT DETAILS AT END BENT (DRAFT)

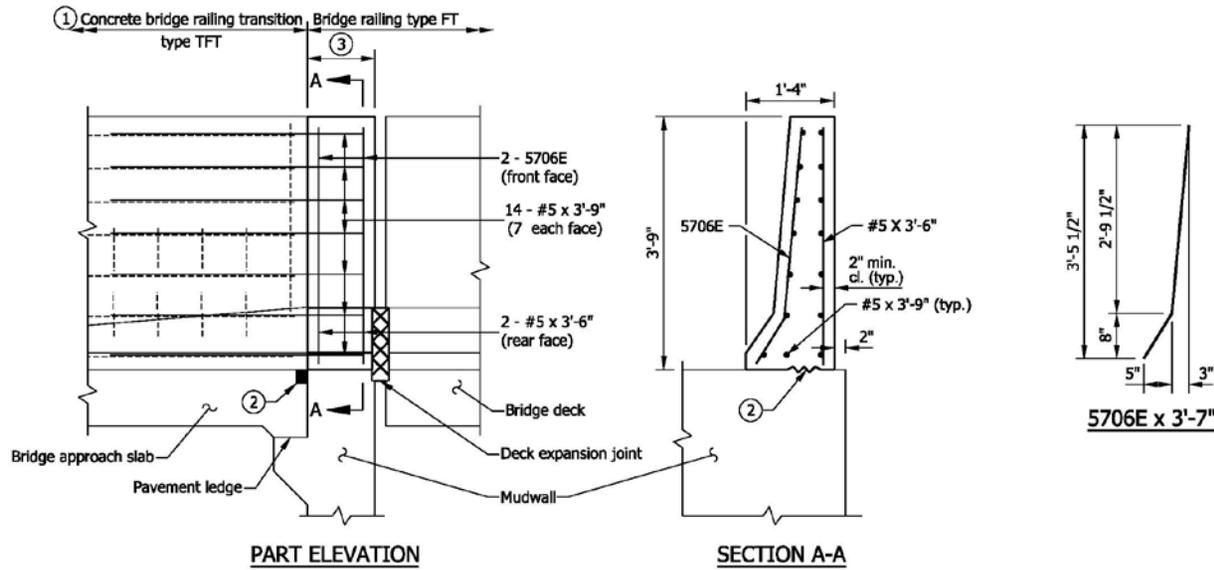

NOTES


- ① See Standard Drawings E 706-TTFT-01 through -03 for concrete bridge railing transition type TFT details.
- ② See Standard Drawing E 609-BRJT-01 for joint type I-A.
- ③ This shall be part of the concrete bridge railing, but it shall be poured with the concrete bridge-railing transition. The minimum length shall be equal to the width of the mudwall. See Standard Drawing E 706-BRSF-02 for bridge railing type FT dimensions.
4. See Standard Drawing E 703-BRST-01 for reinforcing-bar bending diagrams and notes.

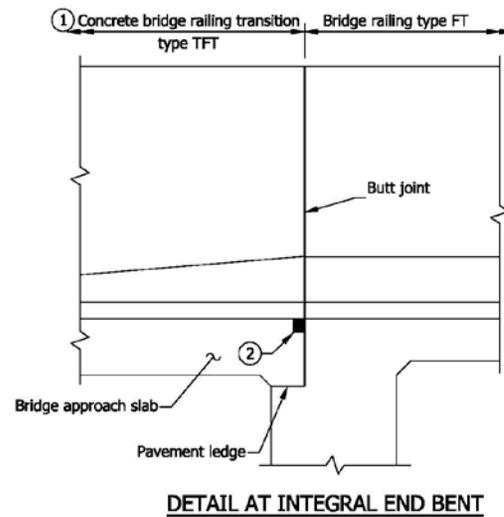

INDIANA DEPARTMENT OF TRANSPORTATION	
BRIDGE RAILING TRANSITION TFT DETAILS AT END BENT	
SEPTEMBER 2012	
STANDARD DRAWING NO. E 706-CBRT-03	
	DESIGN STANDARDS ENGINEER      DATE
	CHIEF HIGHWAY ENGINEER      DATE
DESIGN STANDARDS ENGINEER	


REVISION TO STANDARD DRAWINGS

706-CBRT-04 BRIDGE RAILING TRANSITION TFC OR TFT ATTACHMENT OF GUARDRAIL (DRAFT)

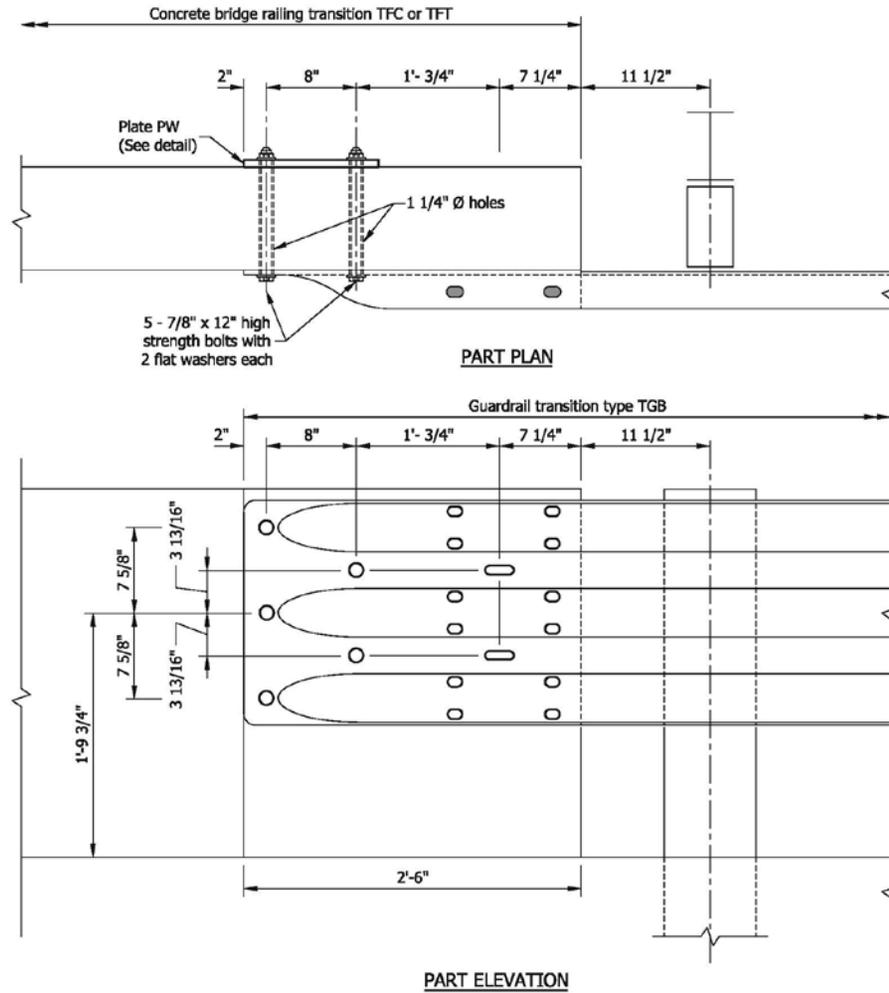

**NOTES**


1. See Standard Drawings E 706-TTFC-01 through -03 for concrete bridge railing transition type TFC. See Standard Drawings E 706-TTFT-01 through -03 for concrete bridge railing transition type TFT. See Standard Drawings E 601-TTGB-01 through -05 for guardrail transition type TGB.
2. Preformed holes, for connection of the guardrail transition type TGB to the end of the concrete bridge railing transition type TFC or TFT.

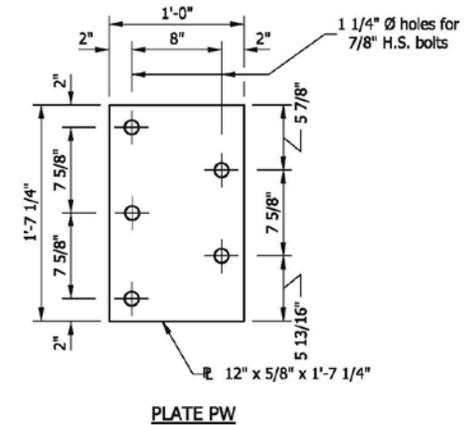

INDIANA DEPARTMENT OF TRANSPORTATION	
BRIDGE RAILING TRANSITION TFC OR TFT ATTACHMENT OF GUARDRAIL	
SEPTEMBER 2012	
STANDARD DRAWING NO.	E 706-CBRT-04
DESIGN STANDARDS ENGINEER	DATE
CHIEF HIGHWAY ENGINEER	DATE
DESIGN STANDARDS ENGINEER	

REVISION TO STANDARD DRAWINGS

EXISTING 706-TPBT-01 BRIDGE RAILING TRANSITION TPBT ELEVATION (WITH MARKUPS)

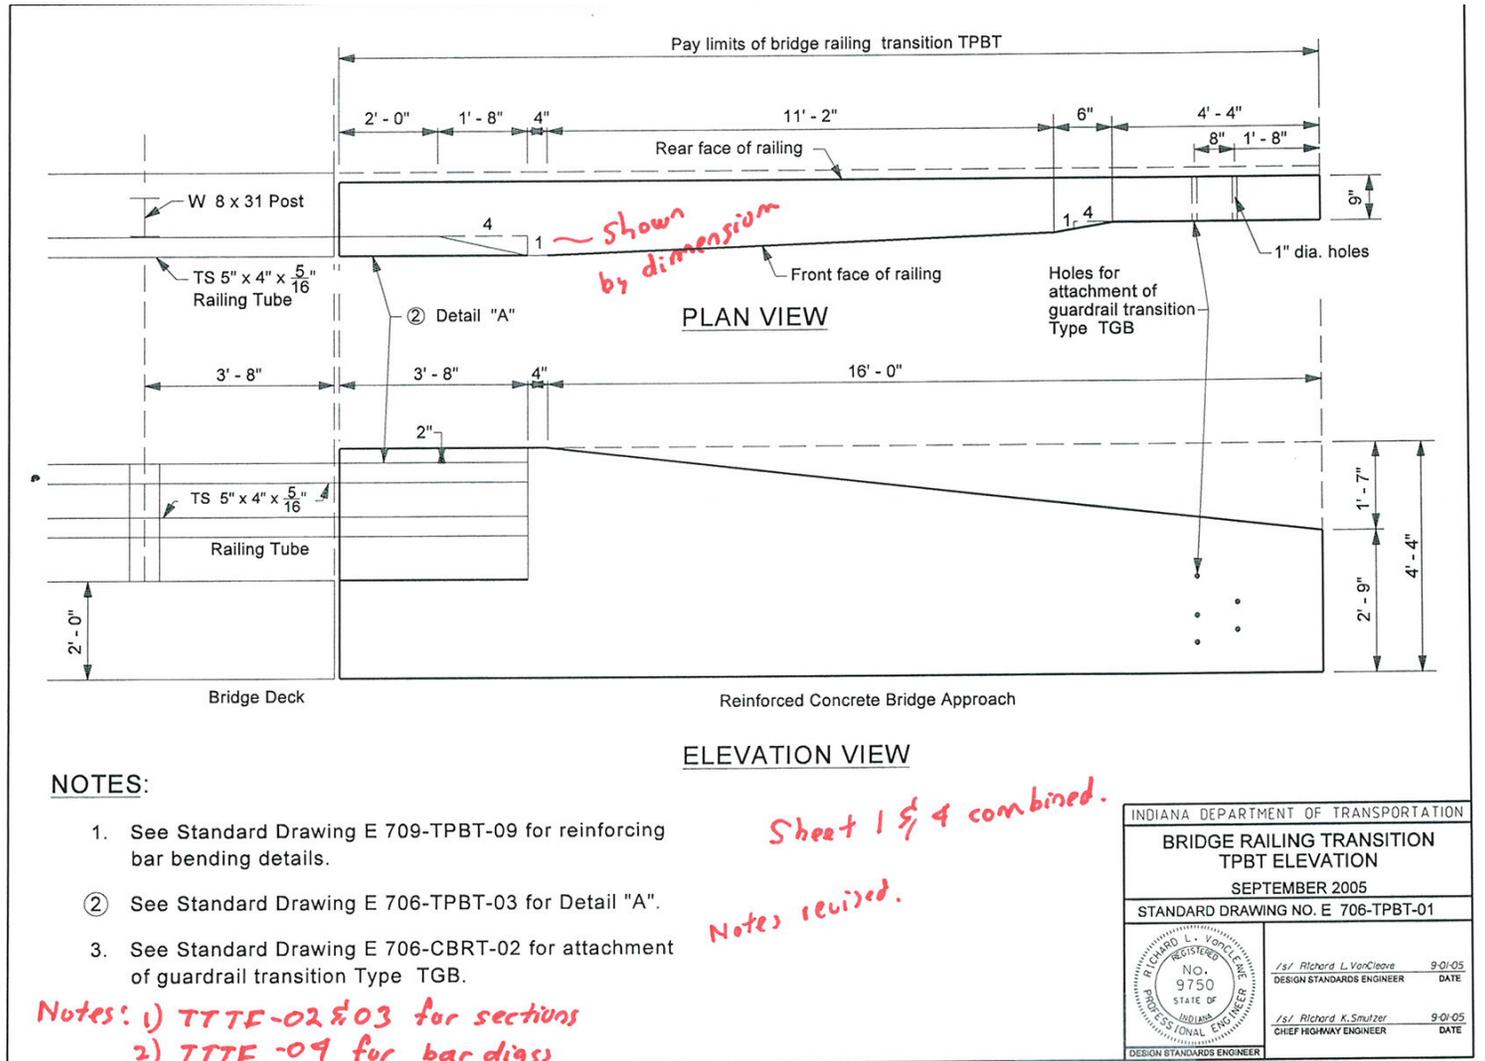

NOTES:

1. See Standard Drawing E 709-TPBT-09 for reinforcing bar bending details.
- ② See Standard Drawing E 706-TPBT-03 for Detail "A".
3. See Standard Drawing E 706-CBRT-02 for attachment of guardrail transition Type TGB.

- Notes: 1) TTF-02 & 03 for sections  
 2) TTF-09 for bar dia's  
 3) Holes for GR Tray CBRT-09  
 4) RCBA - TBAE-02  
 5) holes - BRTE-01

Sheet 1 of 4 combined.

Notes revised.


INDIANA DEPARTMENT OF TRANSPORTATION	
BRIDGE RAILING TRANSITION TPBT ELEVATION	
SEPTEMBER 2005	
STANDARD DRAWING NO. E 706-TPBT-01	
	/s/ Richard L. VanCleave 9-01-05 DESIGN STANDARDS ENGINEER DATE
	/s/ Richard K. Smutzer 9-01-05 CHIEF HIGHWAY ENGINEER DATE
DESIGN STANDARDS ENGINEER	

Concrete  
 Bridge Railing  
 Transition  
 TTF-2

706.

REVISION TO STANDARD DRAWINGS

EXISTING 706-TPBT-02 BRIDGE RAILING TRANSITION TPBT (PROPOSED TO DELETE)

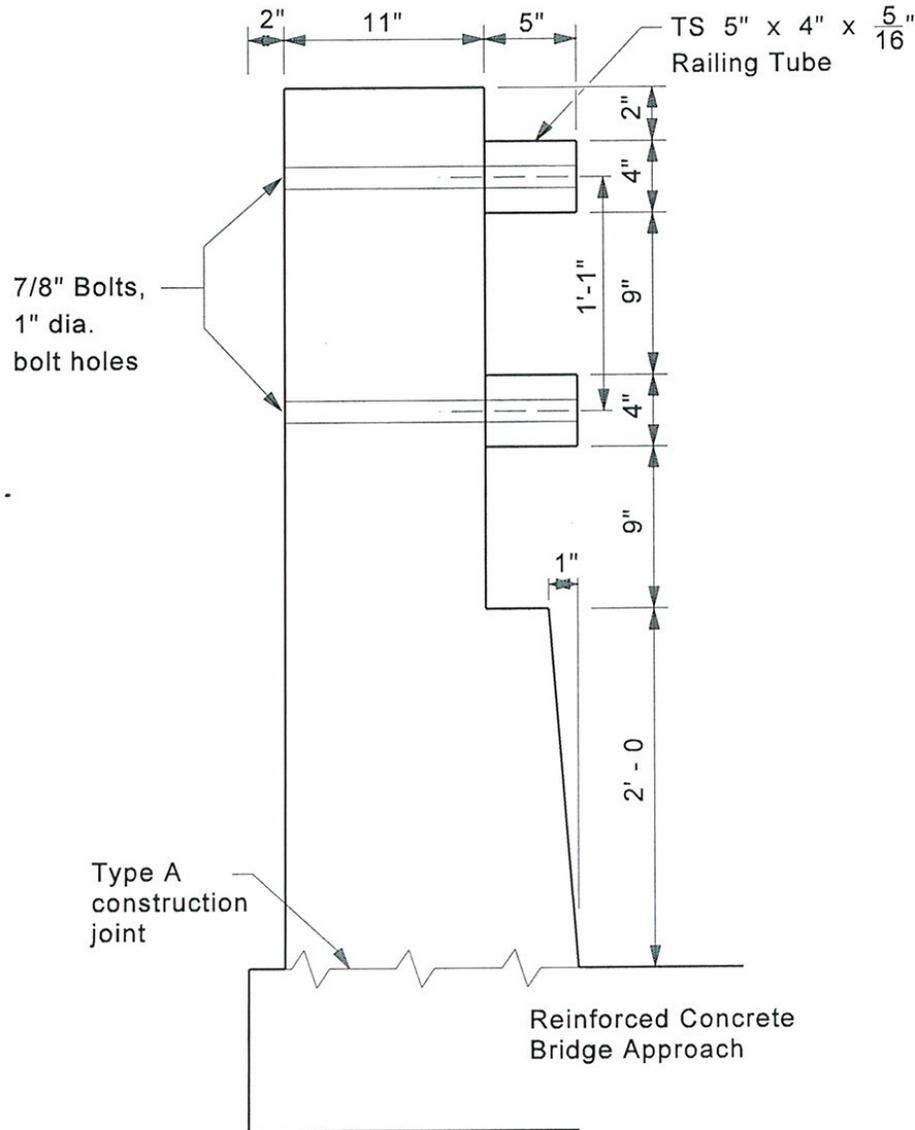

NOTES:

1. Reinforcing steel not shown for clarity.
2. Bolts shall be  $\frac{7}{8}$ " diameter 1'-6" long Round heads.



*holes shown on sheet /  
 bolts shown in bridge Std.*

*Sheet deleted.*

INDIANA DEPARTMENT OF TRANSPORTATION	
BRIDGE RAILING TRANSITION TPBT	
SEPTEMBER 2005	
STANDARD DRAWING NO. E 706-TPBT-02	
	/s/ Richard L. VanCleave 9-01-05 DESIGN STANDARDS ENGINEER DATE
	/s/ Richard K. Smutzer 9-01-05 CHIEF HIGHWAY ENGINEER DATE
DESIGN STANDARDS ENGINEER	

REVISION TO STANDARD DRAWINGS

EXISTING 706-TPBT-03 BRIDGE RAILING TRANSITION TPBT DETAIL "A" (PROPOSED TO DELETE)

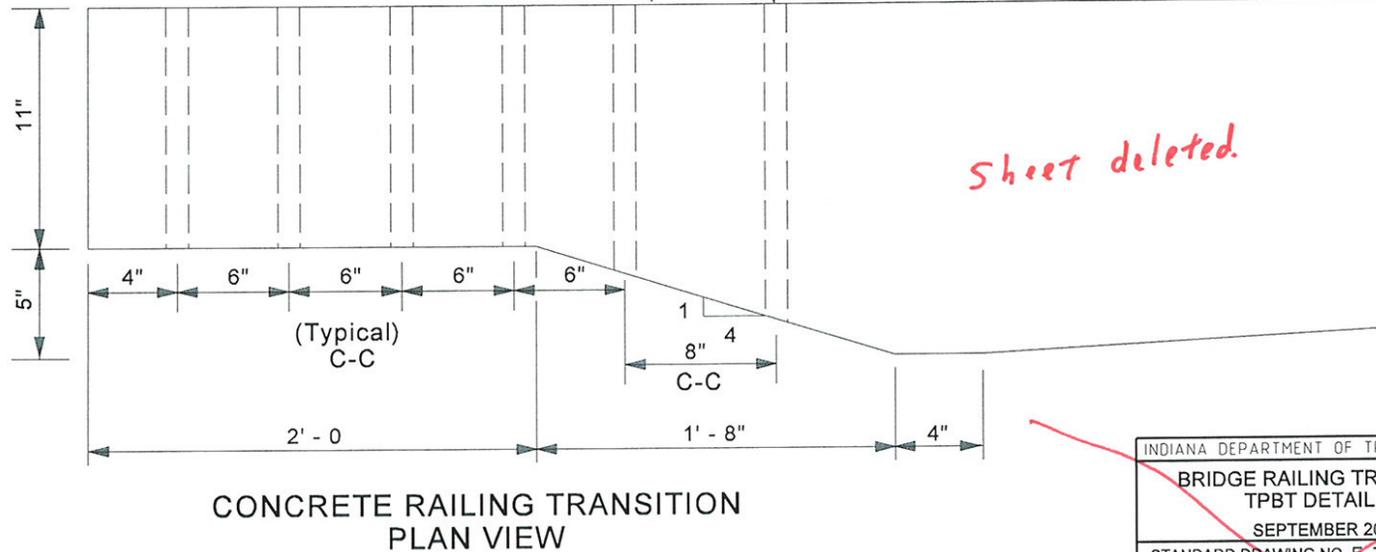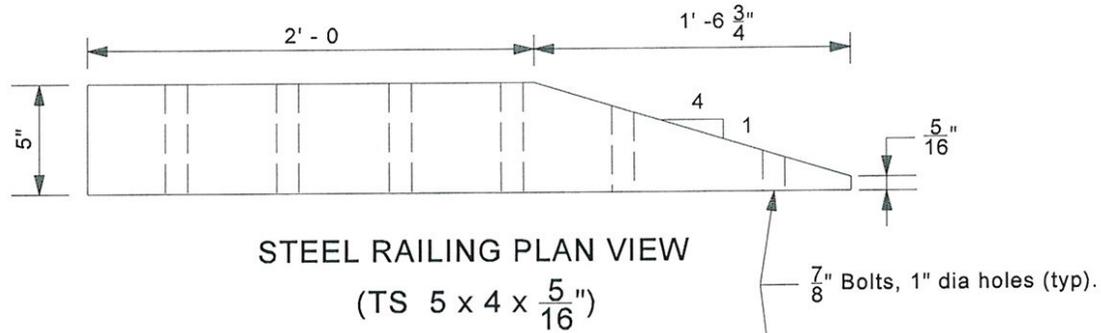


NOTES:

1. Reinforcing steel not shown for clarity.
2. Bolts shall be  $\frac{7}{8}$ " diameter, 1'-6" long round heads.


INDIANA DEPARTMENT OF TRANSPORTATION	
BRIDGE RAILING TRANSITION TPBT DETAIL "A"	
SEPTEMBER 2005	
STANDARD DRAWING NO. E 706-TPBT-03	
	/s/ Richard L. VanCleave 9-01-05 DESIGN STANDARDS ENGINEER DATE
	/s/ Richard K. Smutzer 9-01-05 CHIEF HIGHWAY ENGINEER DATE
DESIGN STANDARDS ENGINEER	

REVISION TO STANDARD DRAWINGS

EXISTING 706-TPBT-04 BRIDGE RAILING TRANSITION TPBT (FOR TF-2) REINFORCEMENT ELEVATION (WITH MARKUPS)

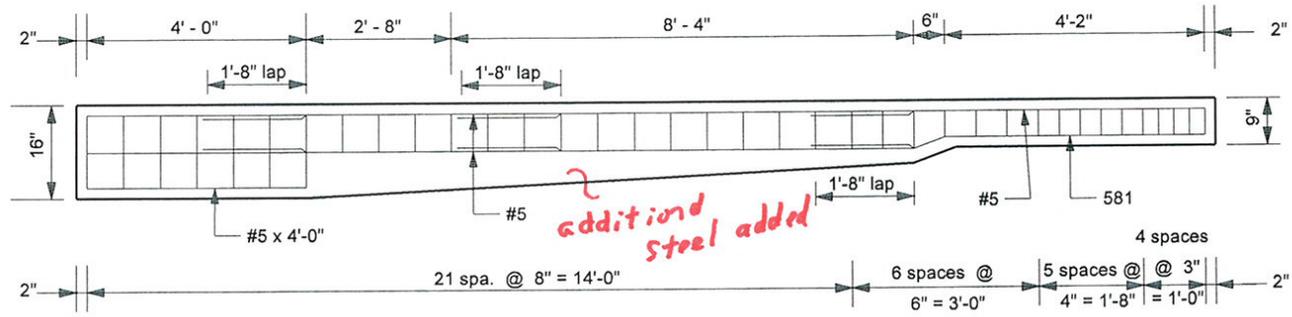

PLAN VIEW

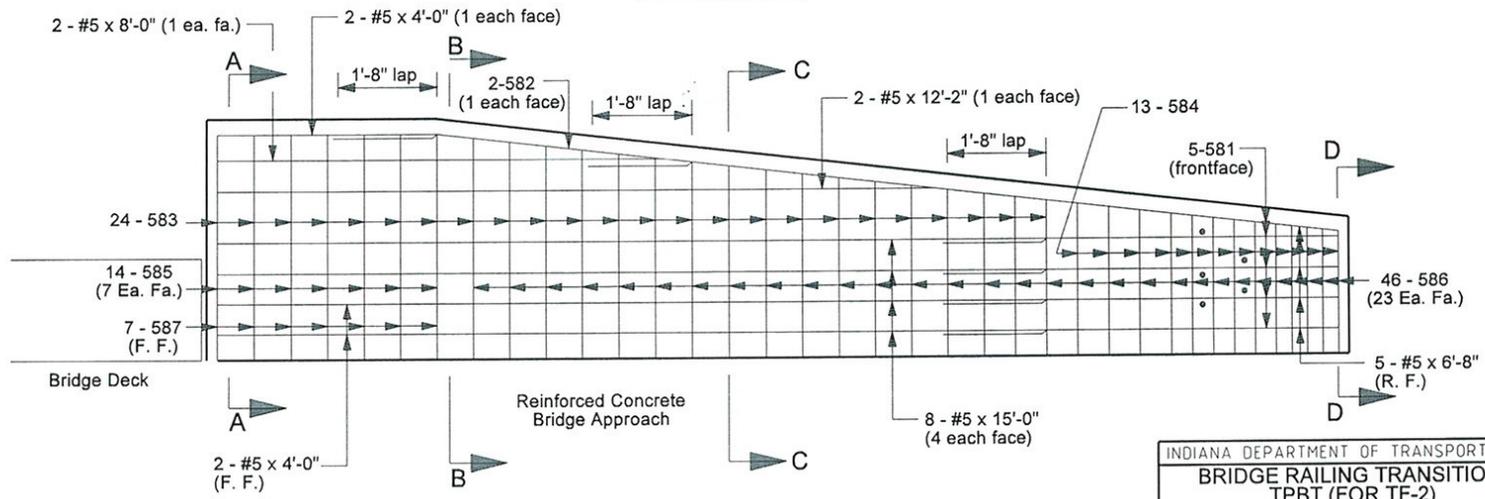


ELEVATION VIEW

*Sheet combined with  
TTTF-01*

INDIANA DEPARTMENT OF TRANSPORTATION	
BRIDGE RAILING TRANSITION TPBT (FOR TF-2) REINFORCEMENT ELEVATION SEPTEMBER 2005	
STANDARD DRAWING NO. E 706-TPBT-04	
	/s/ Richard L. VanCleave 9-01-05 DESIGN STANDARDS ENGINEER DATE
	/s/ Richard K. Smutzer 9-01-05 CHIEF HIGHWAY ENGINEER DATE

REVISION TO STANDARD DRAWINGS

EXISTING 706-TPBT-05 BRIDGE RAILING TRANSITION TPBT SECTION A-A WITH REINFORCEMENT (PROPOSED TO DELETE)

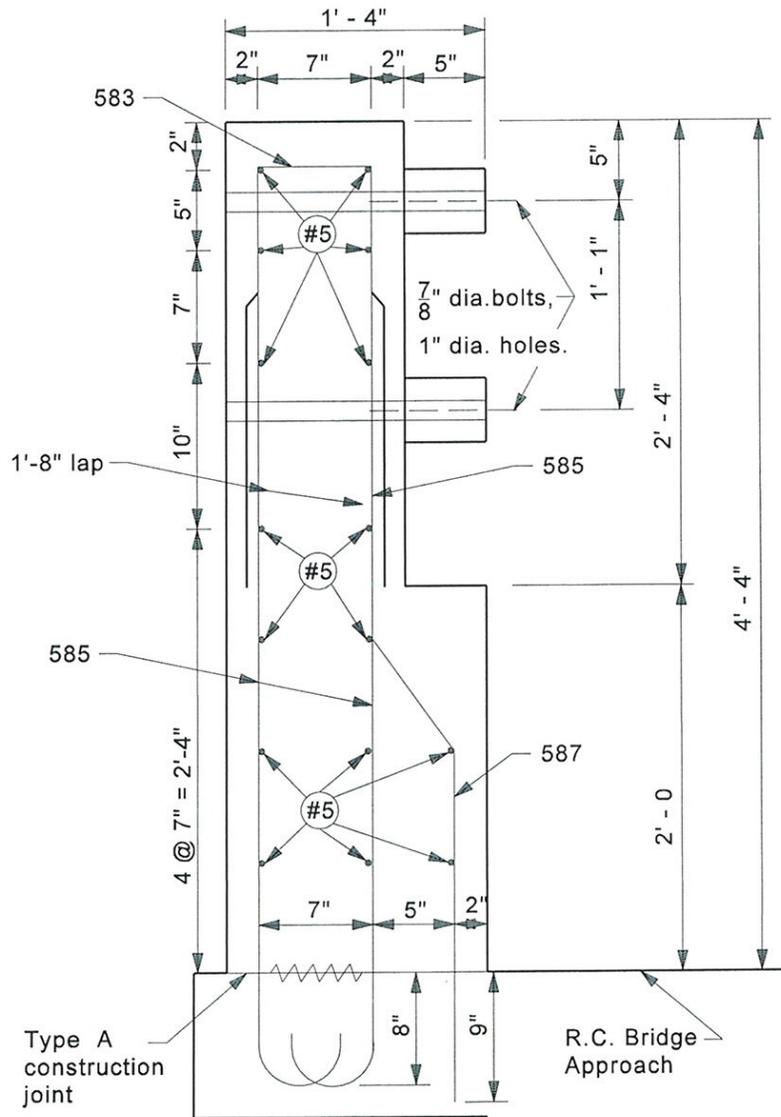


*Sheet deleted.  
 Sections combined.*

INDIANA DEPARTMENT OF TRANSPORTATION	
BRIDGE RAILING TRANSITION TPBT SECTION A-A WITH REINFORCEMENT SEPTEMBER 2005	
STANDARD DRAWING NO. E 706-TPBT-05	
	/s/ Richard L. VanCleave 9-01-05 DESIGN STANDARDS ENGINEER DATE
	/s/ Richard K. Smutzer 9-01-05 CHIEF HIGHWAY ENGINEER DATE
DESIGN STANDARDS ENGINEER	

REVISION TO STANDARD DRAWINGS

EXISTING 706-TPBT-06 BRIDGE RAILING TRANSITION TPBT SECTION B-B (WITH MARKUPS)

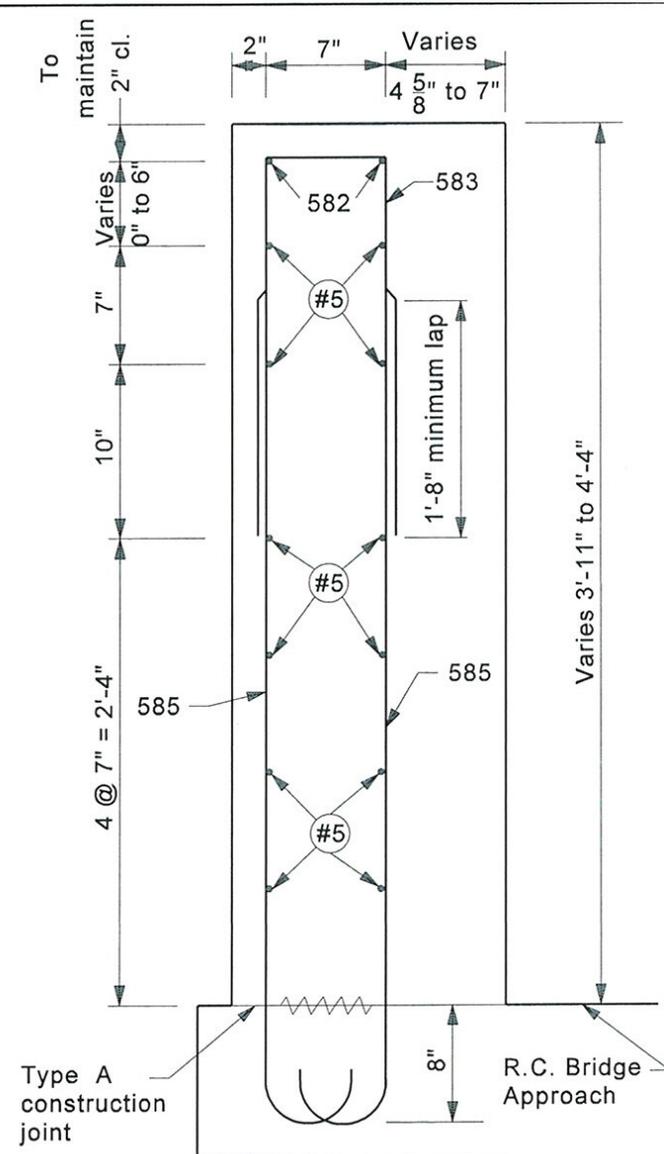

NOTES:


1. See Standard Drawing E 706-TPBT-04 for Section B-B location.
2. See Standard Drawing E 706-TPBT-09 and E 703-BRST-01 for reinforcing steel details.

*Sections combined.  
 706-TTT F-02 §03*

INDIANA DEPARTMENT OF TRANSPORTATION	
BRIDGE RAILING TRANSITION TPBT SECTION B-B	
SEPTEMBER 2005	
STANDARD DRAWING NO. E 706-TPBT-06	
	<i>/s/ Richard L. VanCleave</i> 9-01-05 DESIGN STANDARDS ENGINEER DATE
	<i>/s/ Richard K. Smutzer</i> 9-01-05 CHIEF HIGHWAY ENGINEER DATE
DESIGN STANDARDS ENGINEER	

REVISION TO STANDARD DRAWINGS

EXISTING 706-TPBT-07 BRIDGE RAILING TRANSITION TPBT SECTION C-C (WITH MARKUPS)

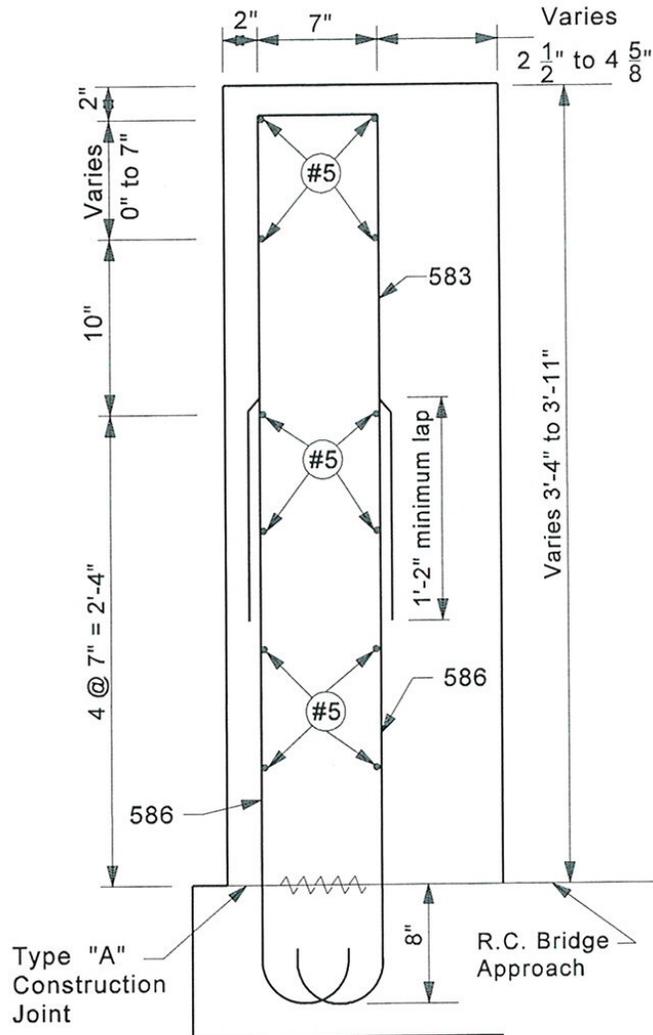

NOTES:


1. See Standard Drawing E 706-TPBT-04 for Section C-C location.
2. See Standard Drawing E 706-TPBT-09 and E 703-BRST-01 for reinforcing steel details.

*Sections combined  
 706-TTTE-02 & 03*

INDIANA DEPARTMENT OF TRANSPORTATION	
BRIDGE RAILING TRANSITION TPBT SECTION C-C	
SEPTEMBER 2005	
STANDARD DRAWING NO. E 706-TPBT-07	
	<i>/s/ Richard L. VanCleave</i> 9-01-05 DESIGN STANDARDS ENGINEER DATE
	<i>/s/ Richard K. Smutzer</i> 9-01-05 CHIEF HIGHWAY ENGINEER DATE
DESIGN STANDARDS ENGINEER	

REVISION TO STANDARD DRAWINGS

EXISTING 706-TPBT-08 BRIDGE RAILING TRANSITION TPBT SECTION D-D (WITH MARKUPS)

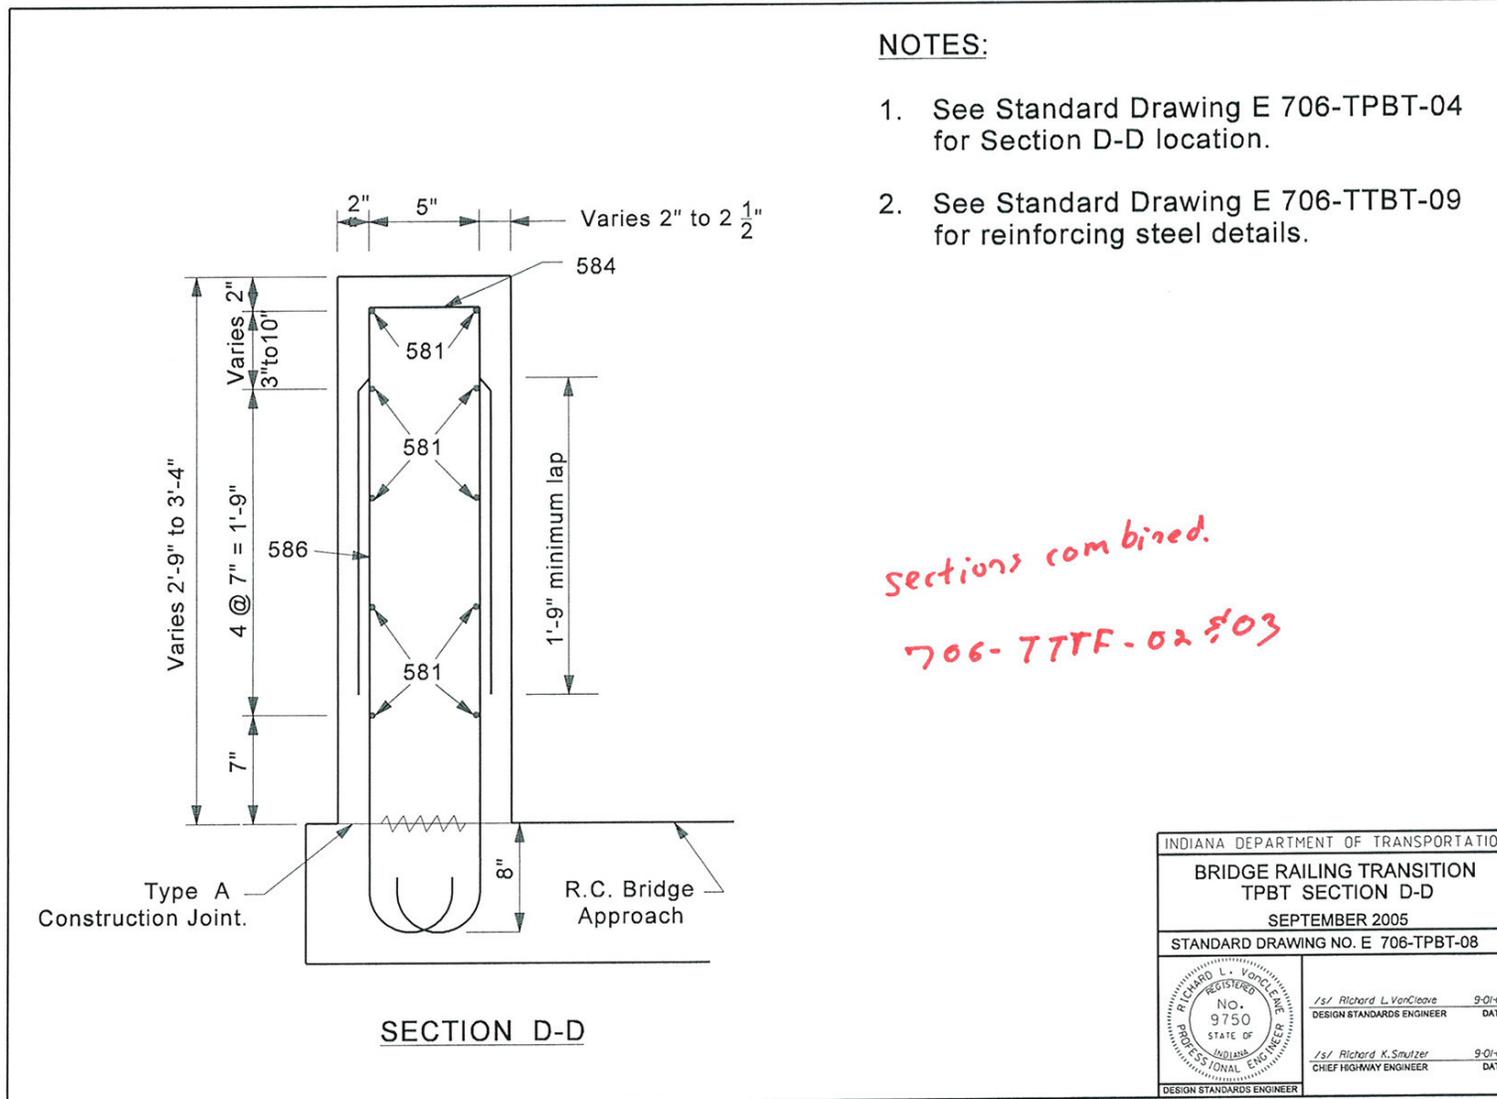

NOTES:


1. See Standard Drawing E 706-TPBT-04 for Section D-D location.
2. See Standard Drawing E 706-TTBT-09 for reinforcing steel details.

*Sections combined.  
 706-TTTF-02 §03*

INDIANA DEPARTMENT OF TRANSPORTATION	
BRIDGE RAILING TRANSITION TPBT SECTION D-D	
SEPTEMBER 2005	
STANDARD DRAWING NO. E 706-TPBT-08	
	<i>/s/ Richard L. VanCleave</i> 9-01-05 DESIGN STANDARDS ENGINEER DATE
	<i>/s/ Richard K. Smutzer</i> 9-01-05 CHIEF HIGHWAY ENGINEER DATE
DESIGN STANDARDS ENGINEER	


REVISION TO STANDARD DRAWINGS

EXISTING 706-TPBT-09 CONCRETE BRIDGE RAILING TRANSITION TYPE TPBT (WITH MARKUPS)

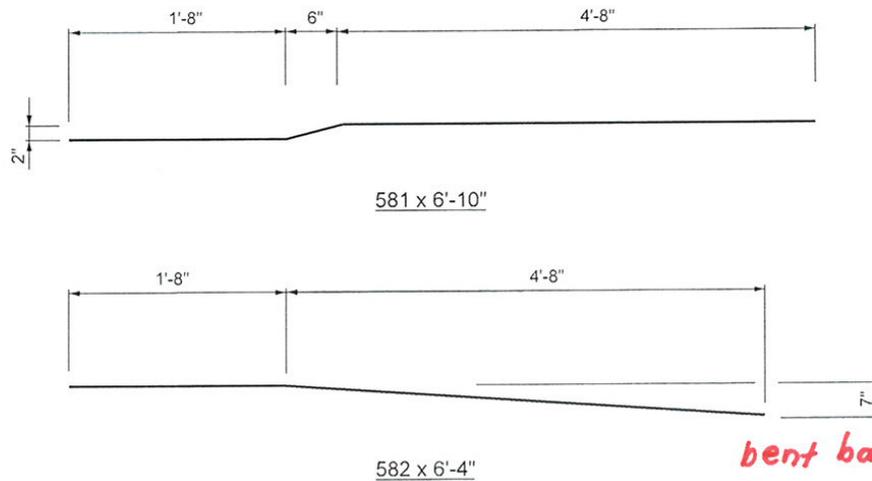


*orientation revised.*


*bent bar designations revised*

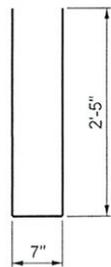


583 x 5'-5"

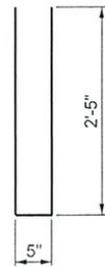


584 x 5'-3"

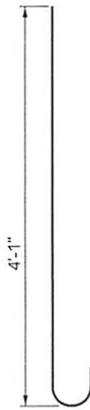

585 x 4'-8"

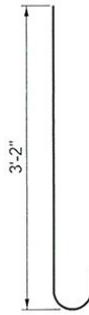

586 x 3'-9"

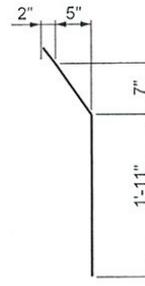

587 x 3'-1"


BILL OF MATERIALS			
These quantities are for one concrete bridge railing transition type TPBT.			
EPOXY COATED REINFORCING STEEL			
Size and Mark	No. of Bars	Length (ft.-in.)	Weight (lb.)
581	5	6'-10"	
582	2	6'-4"	
583	24	5'-5"	
584	13	5'-3"	
585	14	4'-8"	
586	46	3'-9"	
587	7	3'-1"	
#5	8	15'-0"	
#5	2	12'-2"	
#5	2	8'-2"	
#5	4	4'-0"	
#5	5	6'-8"	
Total #5 Bars			760
Total Epoxy Coated Steel			760
Concrete Class C in Railing			4.3 yd <sup>3</sup>
Surface Seal			17.2 yd <sup>2</sup>

*Bill revised*


INDIANA DEPARTMENT OF TRANSPORTATION	
CONCRETE BRIDGE RAILING TRANSITION TYPE TPBT	
SEPTEMBER 2005 <i>TFE-2</i>	
STANDARD DRAWING NO. E 706-TPBT-09	
	<i>/s/ Richard L. VanCleave</i> 9-01-05 DESIGN STANDARDS ENGINEER DATE
	<i>/s/ Richard K. Smutzer</i> 9-01-05 CHIEF HIGHWAY ENGINEER DATE
DESIGN STANDARDS ENGINEER	

REVISION TO STANDARD DRAWINGS

706-TTTF-01 CONCRETE BRIDGE RAILING TRANSITION, TTF-2 (DRAFT)

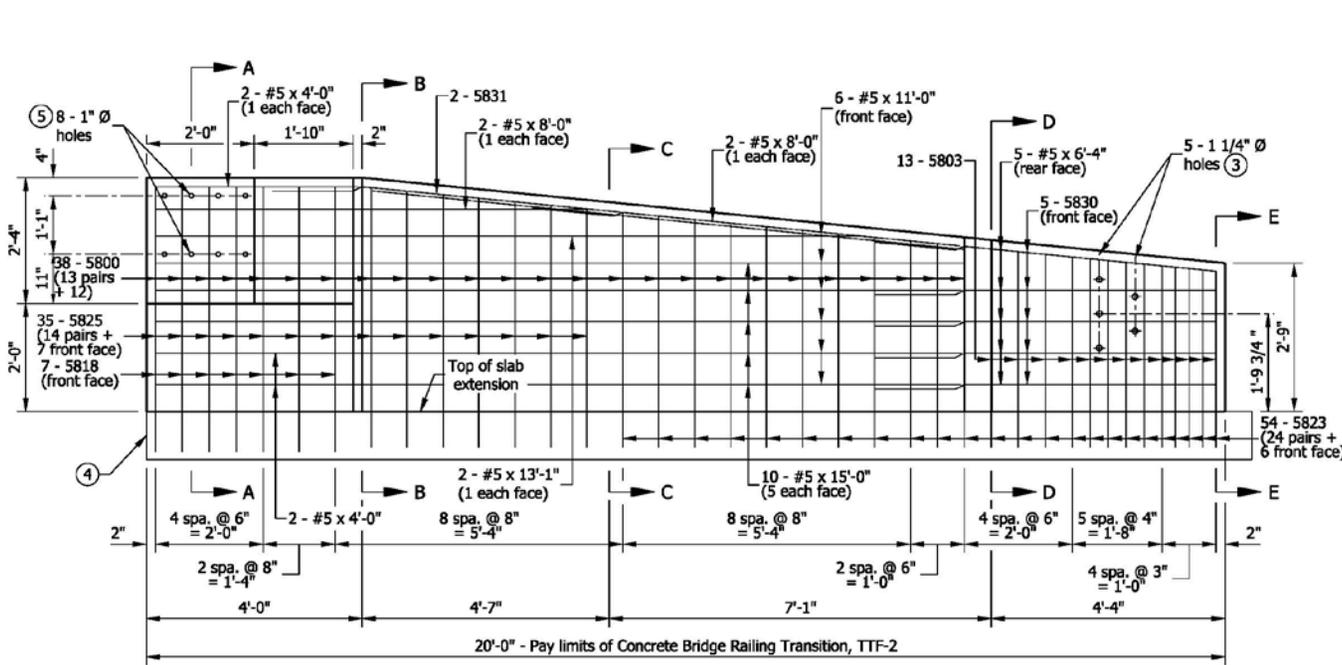

ELEVATION VIEW

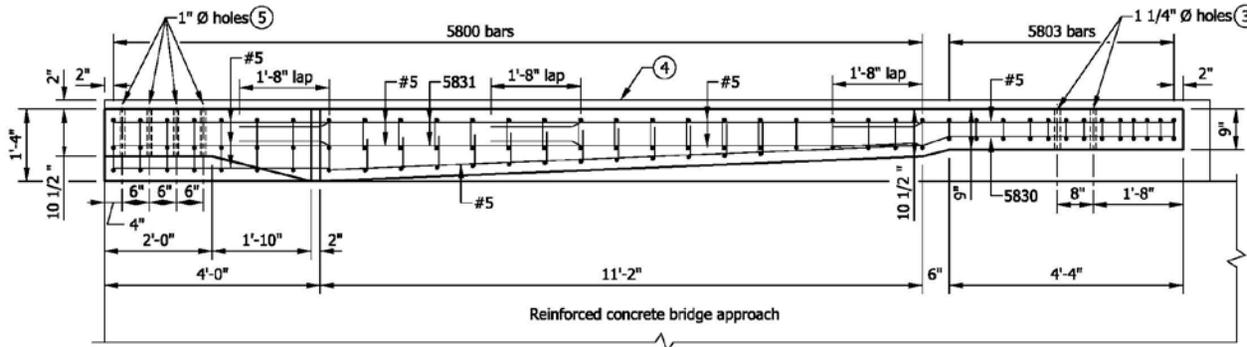

PLAN VIEW



NOTES

1. See Standard Drawings E 706-TTTF-02 and E 706-TTTF-03 for sections.
2. See Standard Drawing E 706-TTTF-04 for reinforcing-bar diagrams and bill of materials.
- ③ Holes for attachment of guardrail transition type TGB. See Standard Drawing E 706-CBRT-04 for details.
- ④ RCBA extension for bridge railing transition type TTF-2. See Standard Drawing E 609-TBAE-02 for details.
- ⑤ Holes for attachment of steel bridge railing type TF-2. See Standard Drawing E 706-BRTF-01 for details.

INDIANA DEPARTMENT OF TRANSPORTATION	
CONCRETE BRIDGE RAILING TRANSITION, TTF-2	
SEPTEMBER 2012	
STANDARD DRAWING NO. E 706-TTTF-01	
DESIGN STANDARDS ENGINEER	DATE
CHIEF HIGHWAY ENGINEER	DATE
DESIGN STANDARDS ENGINEER	

REVISION TO STANDARD DRAWINGS

706-TTTF-02 CONCRETE BRIDGE RAILING TRANSITION, TTF-2 (DRAFT)

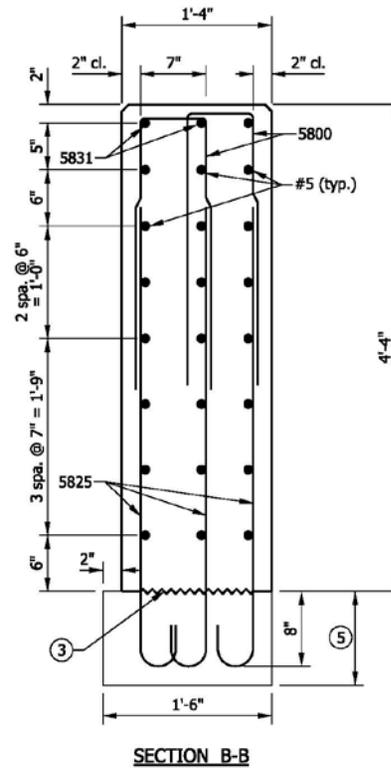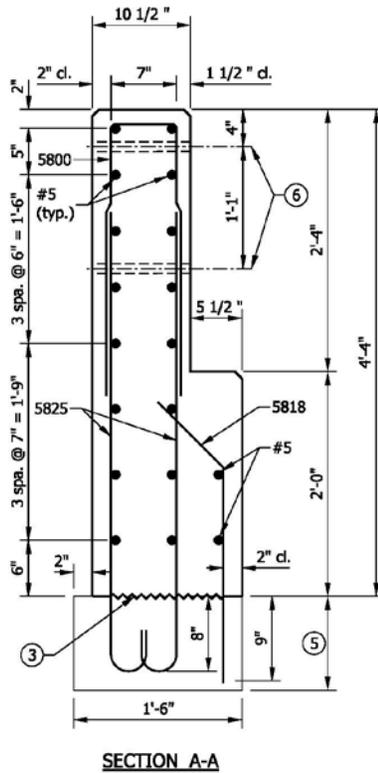


**NOTES**

1. See Standard Drawing E 706-TTTF-01 for elevation and plan.
2. All chamfered edges shall be 3/4".
3. Construction joint type A. See Standard Drawing E 702-CJTA-01 for details.
4. See Standard Drawing E 706-TTTF-04 for reinforcing-bar diagrams.
5. RCBA extension for bridge railing transition type TTF-2. See Standard Drawing E 609-TBAE-02 for details.
6. 1"  $\varnothing$  hole for attachment of steel bridge railing type TF-2. See Standard Drawing E 706-BRTF-01 for details.


<b>INDIANA DEPARTMENT OF TRANSPORTATION</b>	
<b>CONCRETE BRIDGE RAILING TRANSITION, TTF-2</b>	
<b>SEPTEMBER 2012</b>	
<b>STANDARD DRAWING NO. E 706-TTTF-02</b>	
DESIGN STANDARDS ENGINEER	DATE
CHIEF HIGHWAY ENGINEER	DATE
DESIGN STANDARDS ENGINEER	

REVISION TO STANDARD DRAWINGS


706-TTTF-03 CONCRETE BRIDGE RAILING TRANSITION, TTF-2 (DRAFT)

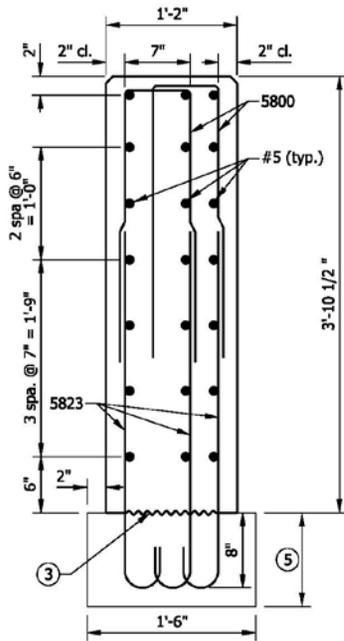

SECTION C-C

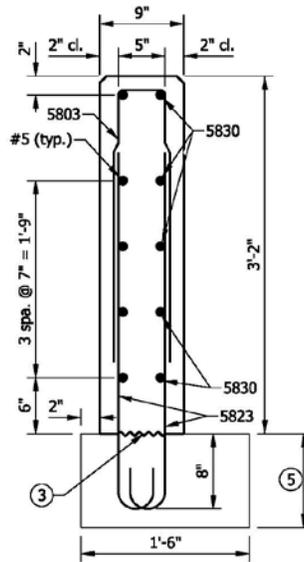

SECTION D-D

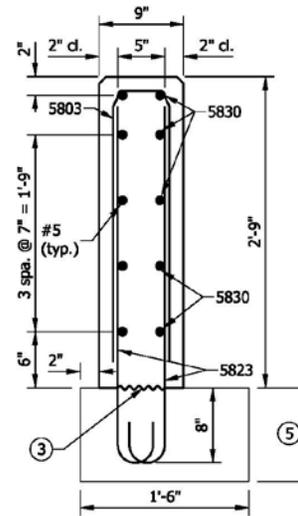

SECTION E-E




**NOTES**

1. See Standard Drawing E 706-TTTF-01 for elevation and plan.
2. All chamfered edges shall be 3/4".
3. Construction joint type A. See Standard Drawing E 702-CJTA-01 for details.
4. See Standard Drawing E 706-TTTF-04 for reinforcing-bar diagrams.
5. RCBA extension for bridge railing transition type TTF-2. See Standard Drawing E 609-TBAE-02 for details.

<b>INDIANA DEPARTMENT OF TRANSPORTATION</b>	
<b>CONCRETE BRIDGE RAILING TRANSITION, TTF-2</b>	
<b>SEPTEMBER 2012</b>	
<b>STANDARD DRAWING NO. E 706-TTTF-03</b>	
	_____ DESIGN STANDARDS ENGINEER      DATE
	_____ CHIEF HIGHWAY ENGINEER      DATE
DESIGN STANDARDS ENGINEER	

REVISION TO STANDARD DRAWINGS

706-TTTF-04 CONCRETE BRIDGE RAILING TRANSITION, TTF-2 (DRAFT)

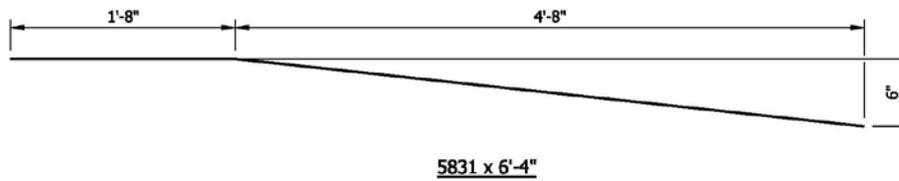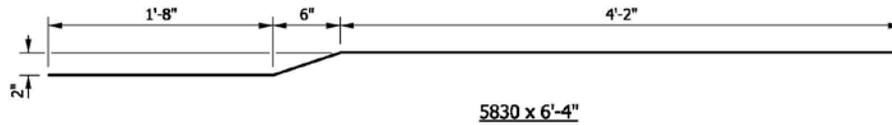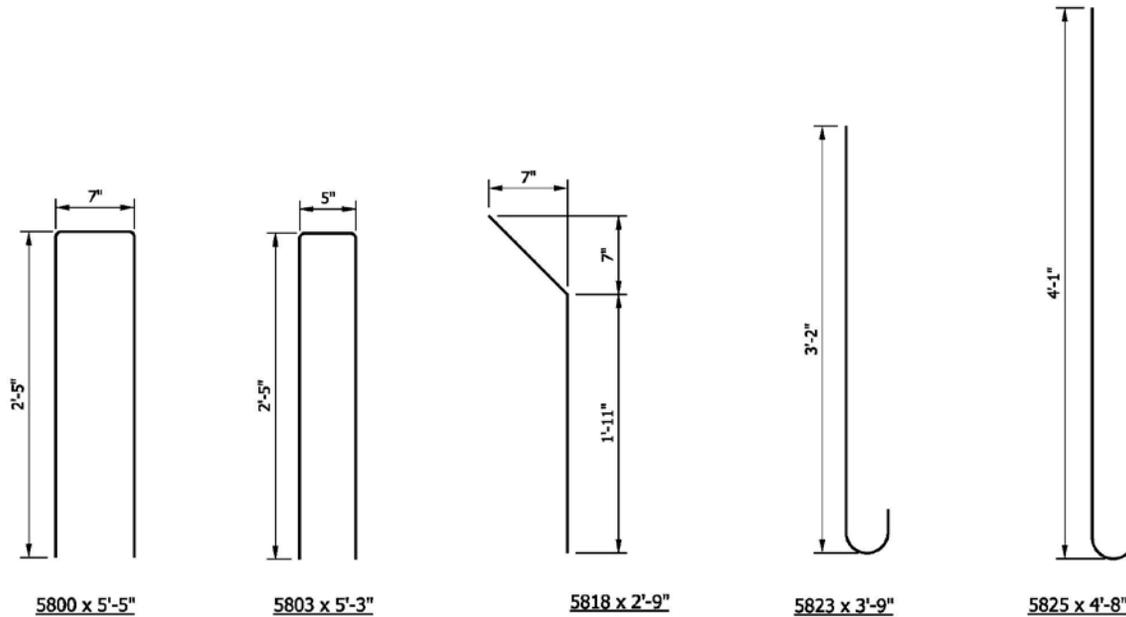

NOTE


- See Standard Drawing E 703-BRST-01 for reinforcing-bar bending details and notes.

BILL OF MATERIALS		
Quantities are for one concrete bridge railing transition type TTF-2		
EPOXY-COATED REINFORCING STEEL		
MARK / SIZE	NO. OF BARS	WEIGHT
5800	38	
5803	13	
5818	7	
5823	54	
5825	35	
5830	5	
5831	2	
#5 x 15'-0"	10	
#5 x 13'-1"	2	
#5 x 11'-0"	6	
#5 x 8'-0"	4	
#5 x 6'-4"	5	
#5 x 4'-0"	4	
TOTAL EPOXY-COATED REINFORCING STEEL		1072 LBS
MISCELLANEOUS		
CONCRETE, CLASS C		2.9 CYS
SURFACE SEAL		182 SFT

INDIANA DEPARTMENT OF TRANSPORTATION	
CONCRETE BRIDGE RAILING TRANSITION, TTF-2	
SEPTEMBER 2012	
STANDARD DRAWING NO.	E 706-TTTF-04
DESIGN STANDARDS ENGINEER	DATE
CHIEF HIGHWAY ENGINEER	DATE
DESIGN STANDARDS ENGINEER	

REVISION TO STANDARD DRAWINGS


EXISTING 706-TTBC-01 CONCRETE BRIDGE RAILING TRANSITION TBC PLAN AND ELEVATION (WITH MARKUPS)

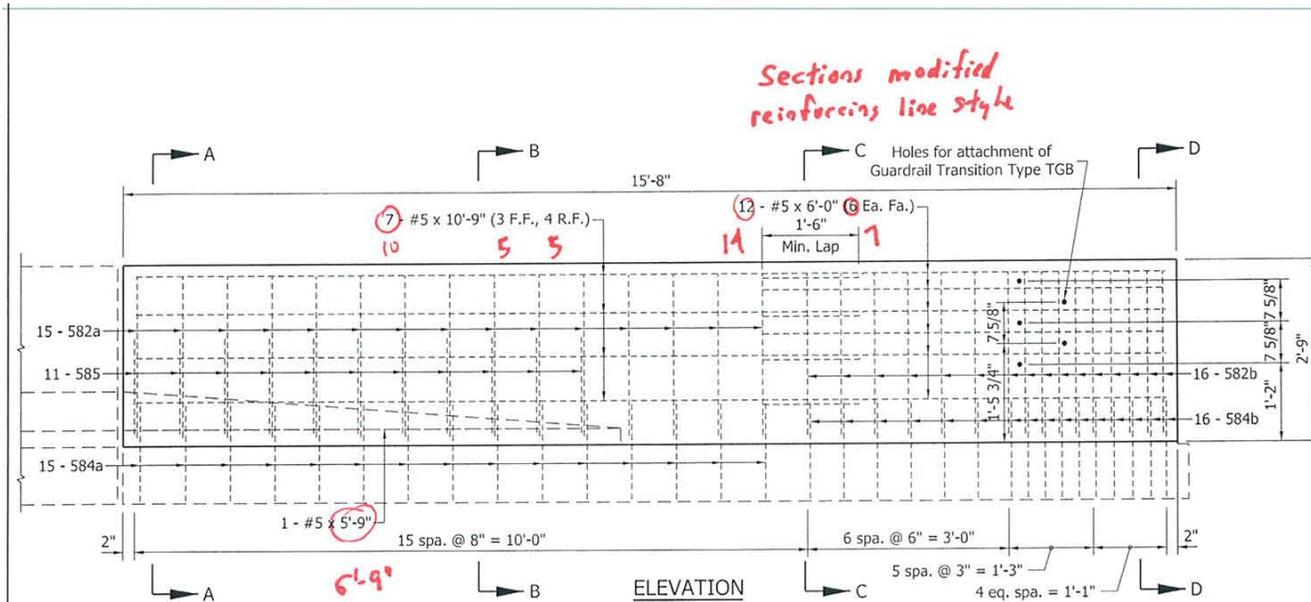

NOTES:

1. See Standard Drawing E 706-TTBC-02 for Sections A-A, B-B, C-C and D-D and Drawing E 706-TTBC-03 for reinforcement and bill of materials. **CBRT-04**
2. See Standard Drawing E 706-TASE-05 for General Notes.
3. See Standard Drawing E 706-CBRT-04 for details of guardrail transition type TGB attachment.


- 1) TTF:- 02 for sections
- 2) TTF:- 03 for bit
- 3)
- 1) RCBA extension for TFC - TBAE-01

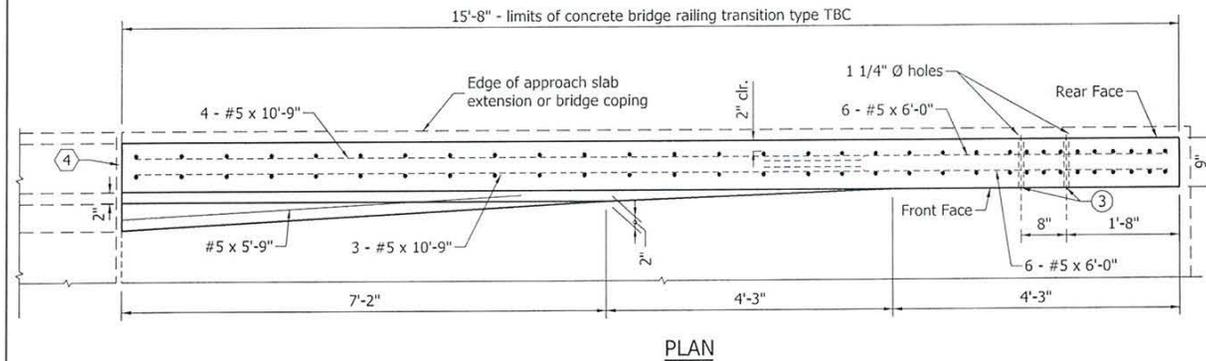


INDIANA DEPARTMENT OF TRANSPORTATION		
CONCRETE BRIDGE RAILING TRANSITION TBC <b>TFC</b> PLAN AND ELEVATION SEPTEMBER 2011 <b>TTFC</b>		
STANDARD DRAWING NO. E 706- <del>TTBC</del> -01		
	/s/ Richard L. VanCleave	09/01/11
	DESIGN STANDARDS ENGINEER	DATE
	/s/ Mark A. Miller	09/01/11
DESIGN STANDARDS ENGINEER	CHIEF HIGHWAY ENGINEER	DATE

REVISION TO STANDARD DRAWINGS

EXISTING 706-TTBC-02 CONCRETE BRIDGE RAILING TRANSITION TYPE TBC SECTIONS (WITH MARKUPS)

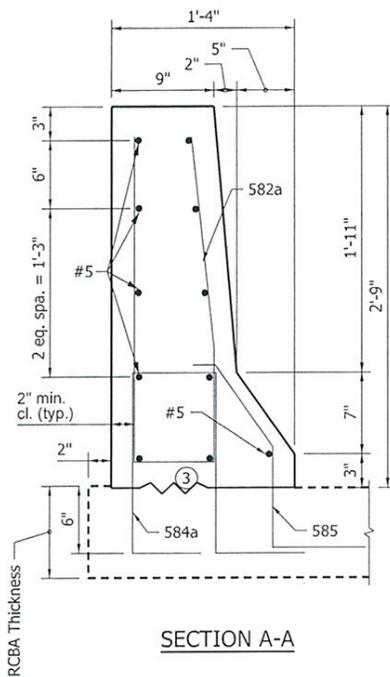


SECTION A-A

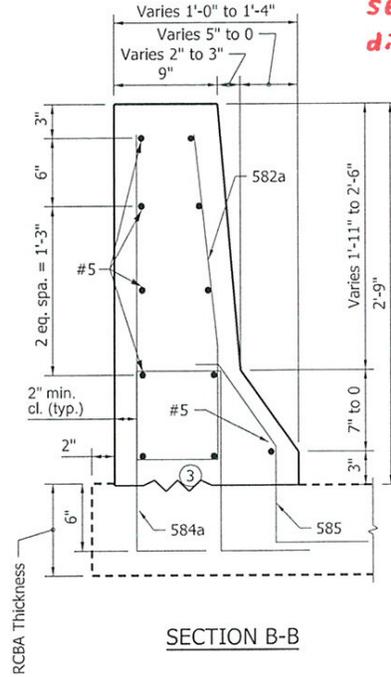


SECTION B-B

*Section dimensioned.*

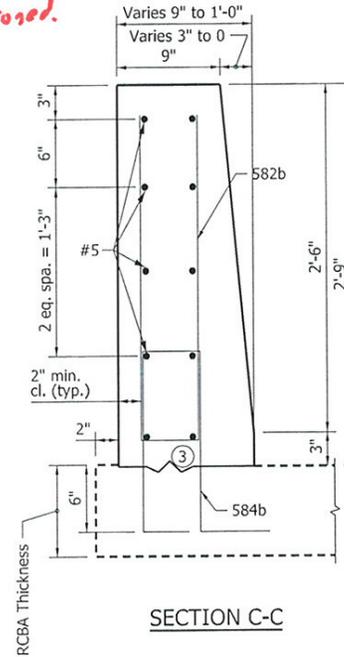

SECTION C-C

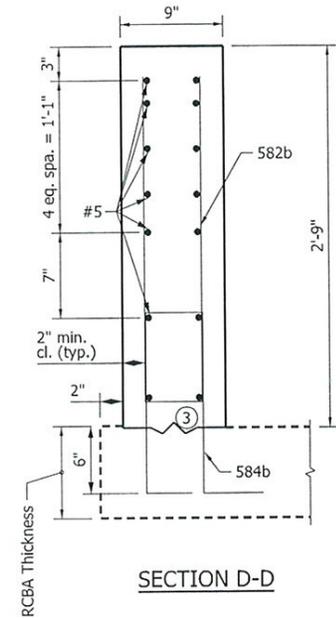

SECTION D-D

*584, 585 revised.*

NOTES:

1. See Standard Drawing E 706-TTBC-01 for Plan and Elevation.
2. See Standard Drawing E 703-BRST-01 for bar bending details and reinforcing bar notes.
- ③ Type A construction joint. See Standard Drawing E 702-CJTA-01 for details.
4. See Standard Drawing E 706-TTBC-03 for reinforcement details.

*5 slab ext added.*

2'-9" COMMON HEIGHT THRIE BEAM  
 CONCRETE BRIDGE RAILING TRANSITION


INDIANA DEPARTMENT OF TRANSPORTATION	
CONCRETE BRIDGE RAILING TRANSITION TYPE TBC SECTIONS SEPTEMBER 2011	
STANDARD DRAWING NO. E 706-TTBC-02	
	/s/ Richard L. VanCleave 09/01/11 DESIGN STANDARDS ENGINEER DATE
	/s/ Mark A. Miller 09/01/11 CHIEF HIGHWAY ENGINEER DATE
DESIGN STANDARDS ENGINEER	

REVISION TO STANDARD DRAWINGS

EXISTING 706-TTBC-03 CONCRETE BRIDGE RAILING TRANSITION TYPE TBC (WITH MARKUPS)


NOTE:

1. See Standard Drawing E 706-TASE-05 for General Notes.

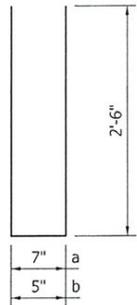


582a x 5'-7

582b x 5'-5

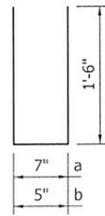

584a x 3'-7

584b x 3'-5

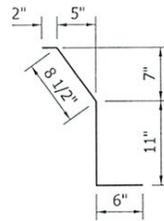

585 x 2'-4

584 revised to be equivalent  
to bridge rail step

585 embedment increased

BILL OF MATERIALS			
These quantities are for one concrete bridge railing transition type TBC.			
EPOXY COATED REINFORCING STEEL			
Size and Mark	No. of Bars	Length (Ft.-in.)	Weight (Lbs.)
582a	15	5'-7"	
582b	16	5'-5"	
584a	15	3'-7"	
584b	16	3'-5"	
585	11	2'-4"	
#5	13	6'-0"	
#5	7	10'-9"	
Total #5 Bars			477
Total Epoxy Coated Steel			477
Concrete Class C in Railing			1.2 yd <sup>3</sup>
Surface Seal			100 ft <sup>2</sup>


B:1  
revised.

2'-9" COMMON HEIGHT THRIE BEAM /  
CONCRETE BRIDGE RAILING TRANSITION


INDIANA DEPARTMENT OF TRANSPORTATION	
CONCRETE BRIDGE RAILING TRANSITION TYPE TBC	
SEPTEMBER 2011	
STANDARD DRAWING NO.	E 706-TTBC-03
	/s/ Richard L. VanCleave 09/01/11 DESIGN STANDARDS ENGINEER DATE
	/s/ Mark A. Miller 09/01/11 CHIEF HIGHWAY ENGINEER DATE

REVISION TO STANDARD DRAWINGS

706-TTFC-01 CONCRETE BRIDGE RAILING TRANSITION TFC PLAN AND ELEVATION (DRAFT)

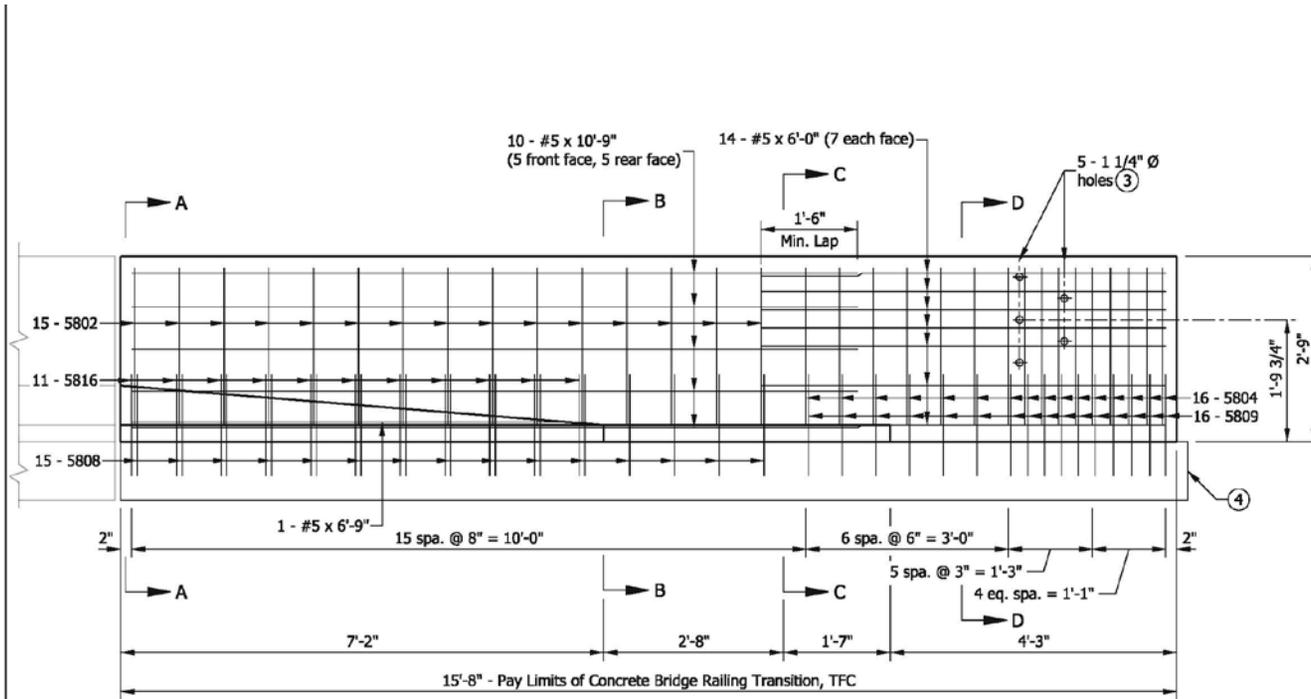

ELEVATION

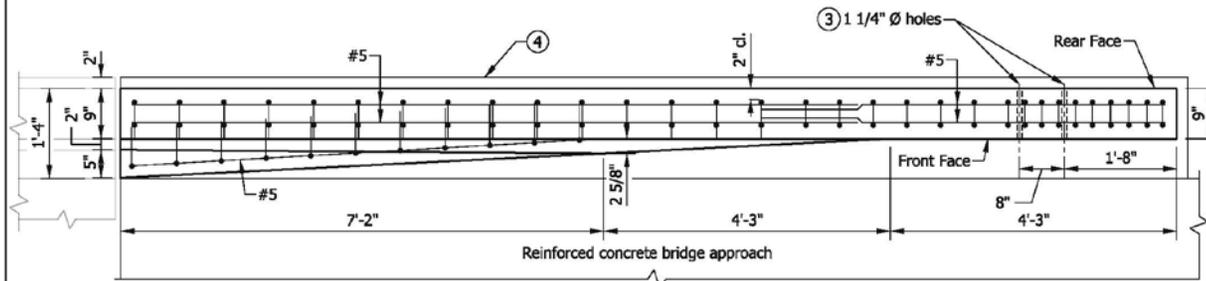

PLAN


NOTES

1. See Standard Drawing E 706-TTFC-02 for sections.
2. See Standard Drawing E 706-TTFC-03 for reinforcing-bar diagrams and bill of materials.
- ③ Holes for attachment of guardrail transition type TGB. See Standard Drawing E 706-CBRT-04 for details.
- ④ RCBA extension for bridge railing transition type TFC. See Standard Drawing E 609-TBAE-01 for details.


INDIANA DEPARTMENT OF TRANSPORTATION	
CONCRETE BRIDGE RAILING TRANSITION TFC PLAN AND ELEVATION SEPTEMBER 2012	
STANDARD DRAWING NO.	E 706-TTFC-01
DESIGN STANDARDS ENGINEER	DATE
CHIEF HIGHWAY ENGINEER	DATE
DESIGN STANDARDS ENGINEER	

REVISION TO STANDARD DRAWINGS


706-TTFC-02 CONCRETE BRIDGE RAILING TRANSITION, TFC SECTIONS (DRAFT)

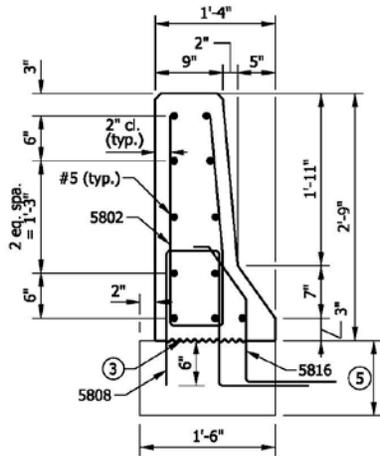


SECTION A-A

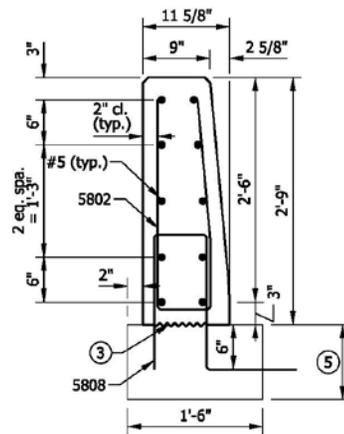

SECTION B-B

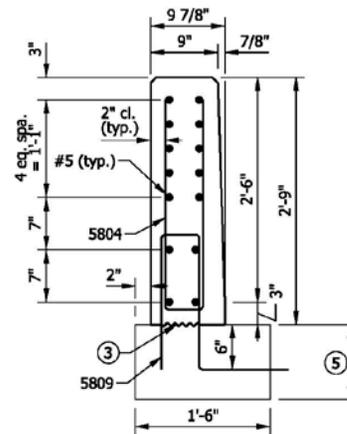

SECTION C-C

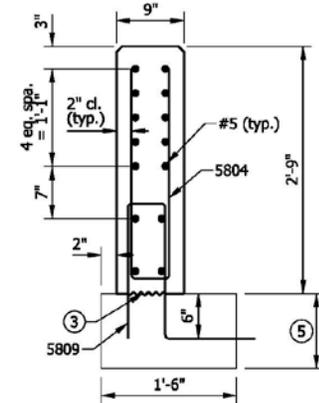

SECTION D-D






**NOTES**

1. See Standard Drawing E 706-TTFC-01 for elevation and plan.
2. All chamfered edges shall be 3/4".
- ③ Construction joint type A. See Standard Drawing E 702-CJTA-01 for details.
4. See Standard Drawing E 706-TTFC-03 for reinforcing-bar diagrams.
- ⑤ RCBA extension for bridge railing type TFC. See Standard Drawing E 609-TBAE-01 for details.

<b>INDIANA DEPARTMENT OF TRANSPORTATION</b>	
<b>CONCRETE BRIDGE RAILING TRANSITION, TFC SECTIONS</b>	
<b>SEPTEMBER 2012</b>	
<b>STANDARD DRAWING NO. E 706-TTFC-02</b>	
DESIGN STANDARDS ENGINEER	DATE
CHIEF HIGHWAY ENGINEER	DATE
DESIGN STANDARDS ENGINEER	

REVISION TO STANDARD DRAWINGS

706-TTFC-03 CONCRETE BRIDGE RAILING TRANSITION, TFC (DRAFT)

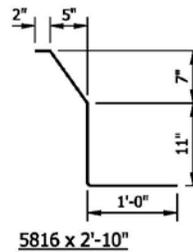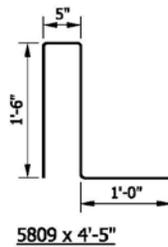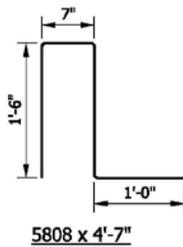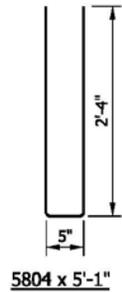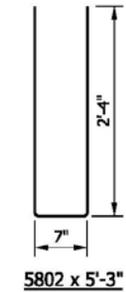

**NOTE**

1. See Standard Drawing E 703-BRST-01 for reinforcing-bar bending details and notes.


BILL OF MATERIALS		
Quantities are for one concrete bridge railing transition type TFC		
EPOXY-COATED REINFORCING STEEL		
MARK / SIZE	NO. OF BARS	WEIGHT
5802	15	
5804	16	
5808	15	
5809	16	
5816	11	
#5 x 10'-9"	10	
#5 x 6'-9"	1	
#5 x 6'-0"	14	
TOTAL EPOXY-COATED REINFORCING STEEL		552 LBS
MISCELLANEOUS		
CONCRETE, CLASS C		1.2 CYS
SURFACE SEAL		100 SFT

INDIANA DEPARTMENT OF TRANSPORTATION	
CONCRETE BRIDGE RAILING TRANSITION, TFC	
SEPTEMBER 2012	
STANDARD DRAWING NO.	E 706-TTFC-03
DESIGN STANDARDS ENGINEER	DATE
CHIEF HIGHWAY ENGINEER	DATE
DESIGN STANDARDS ENGINEER	

REVISION TO STANDARD DRAWINGS

EXISTING 706-TTBP-01 CONCRETE BRIDGE RAILING TRANSITION, TPF-1 (WITH MARKUPS)

*Sections re-ordered and taken at locations in change of geometry*

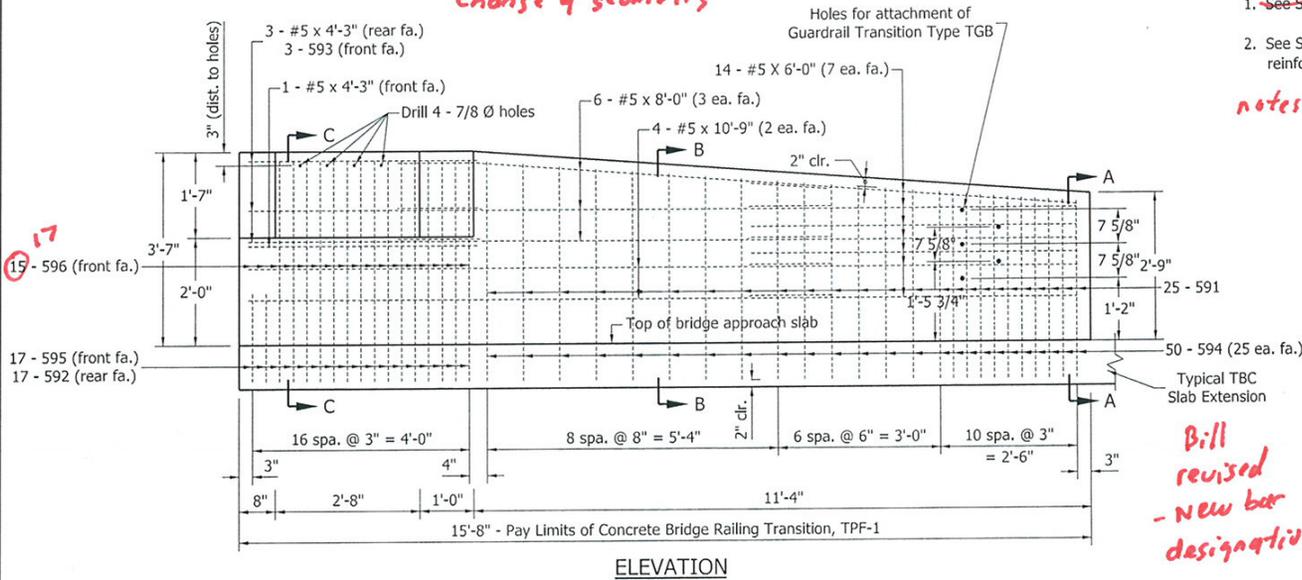


NOTES:

1. See Standard Drawing E 706-TTBP-09 for general notes.
2. See Standard Drawing E 706-TTBP-02 for sections and reinforcing-bar diagrams.

*TTTP*  
*TTTP*  
*notes added. 3) RCBA TBAE-01*  
*4) Holes - BR PP-01*

BILL OF MATERIALS, TPF-1 EPOXY-COATED REINFORCING STEEL			
Mark / Size	No. of Bars	Total Length	Weight
591 x 5'-4"	25	133'-4"	
592 x 4'-8"	17	79'-4"	
593 x 4'-3"	3	12'-9"	
594 x 3'-7"	50	179'-2"	
595 x 3'-1"	17	52'-5"	
596 x 3'-0"	15	43'-0"	
#5 x 10'-9"	4	43'-0"	
#5 x 8'-0"	6	48'-0"	
#5 x 6'-0"	14	84'-0"	
#5 x 4'-3"	4	17'-0"	
Total Epoxy-Coated Reinforcing Steel		694'-2"	724 lb
MISCELLANEOUS			
Concrete, Class C			1.5 cys
Surface Seal			121 sft

*Bill revised - new bar designations*

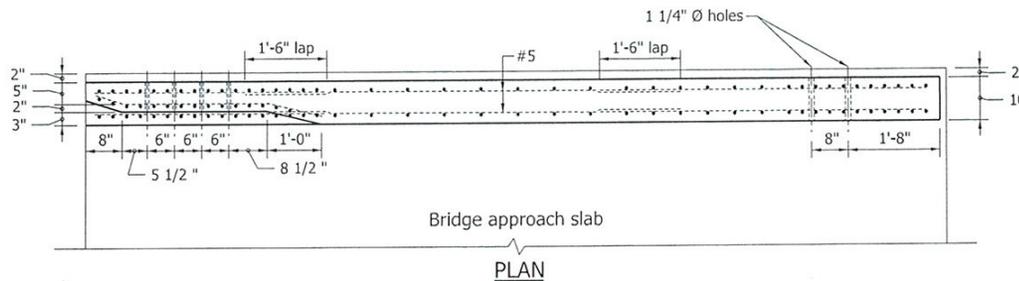


INDIANA DEPARTMENT OF TRANSPORTATION

CONCRETE BRIDGE RAILING TRANSITION, TPF-1

SEPTEMBER 2011

STANDARD DRAWING NO. E 706-TTBP-01

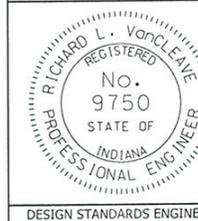

/s/ Richard L. VanCleave 09/01/11  
 DESIGN STANDARDS ENGINEER DATE


/s/ Mark A. Miller 09/01/11  
 CHIEF HIGHWAY ENGINEER DATE

DESIGN STANDARDS ENGINEER




REVISION TO STANDARD DRAWINGS

EXISTING 706-TTBP-03 CONCRETE BRIDGE RAILING TRANSITION, TPF-2 (WITH MARKUPS)

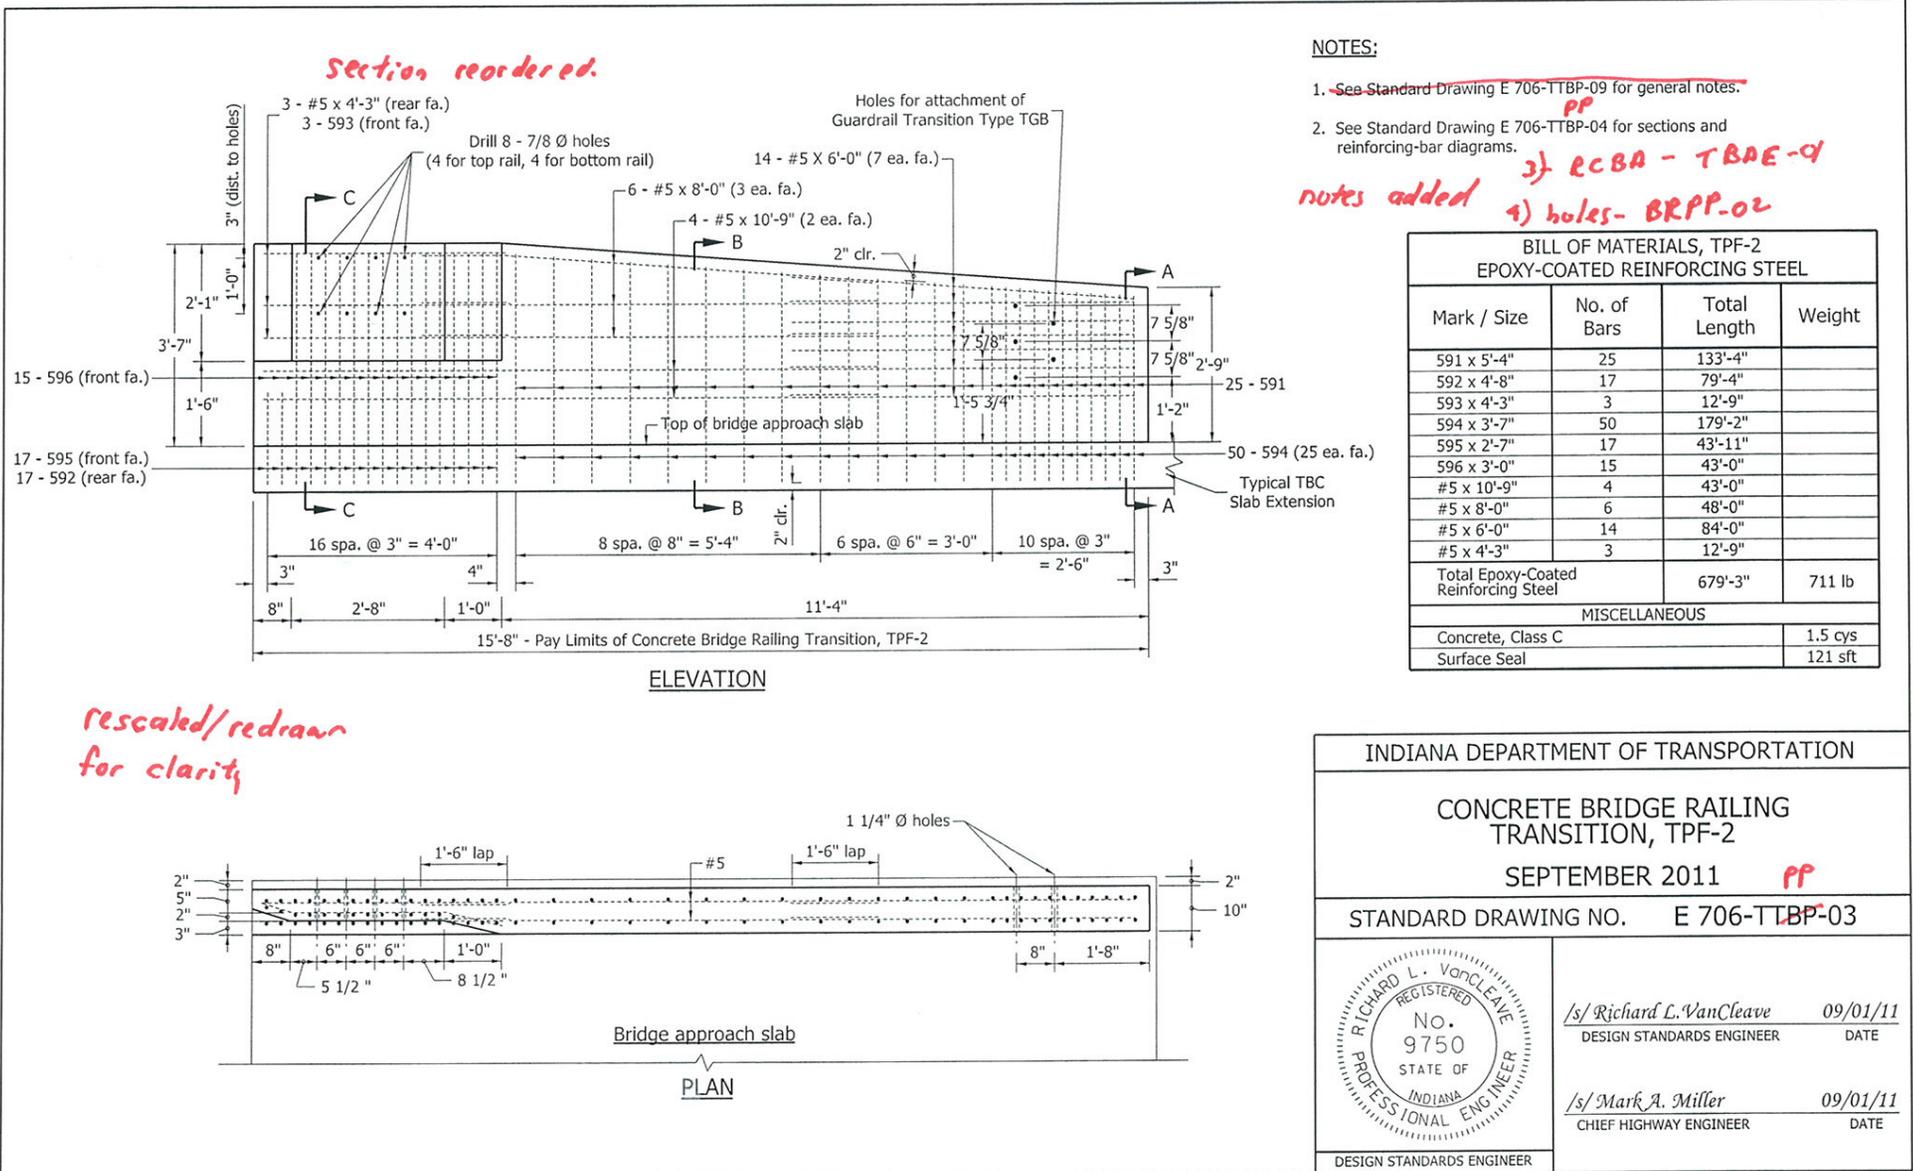


REVISION TO STANDARD DRAWINGS

EXISTING 706-TTBP-04 CONCRETE BRIDGE RAILING TRANSITION, TPF-2 (WITH MARKUPS)

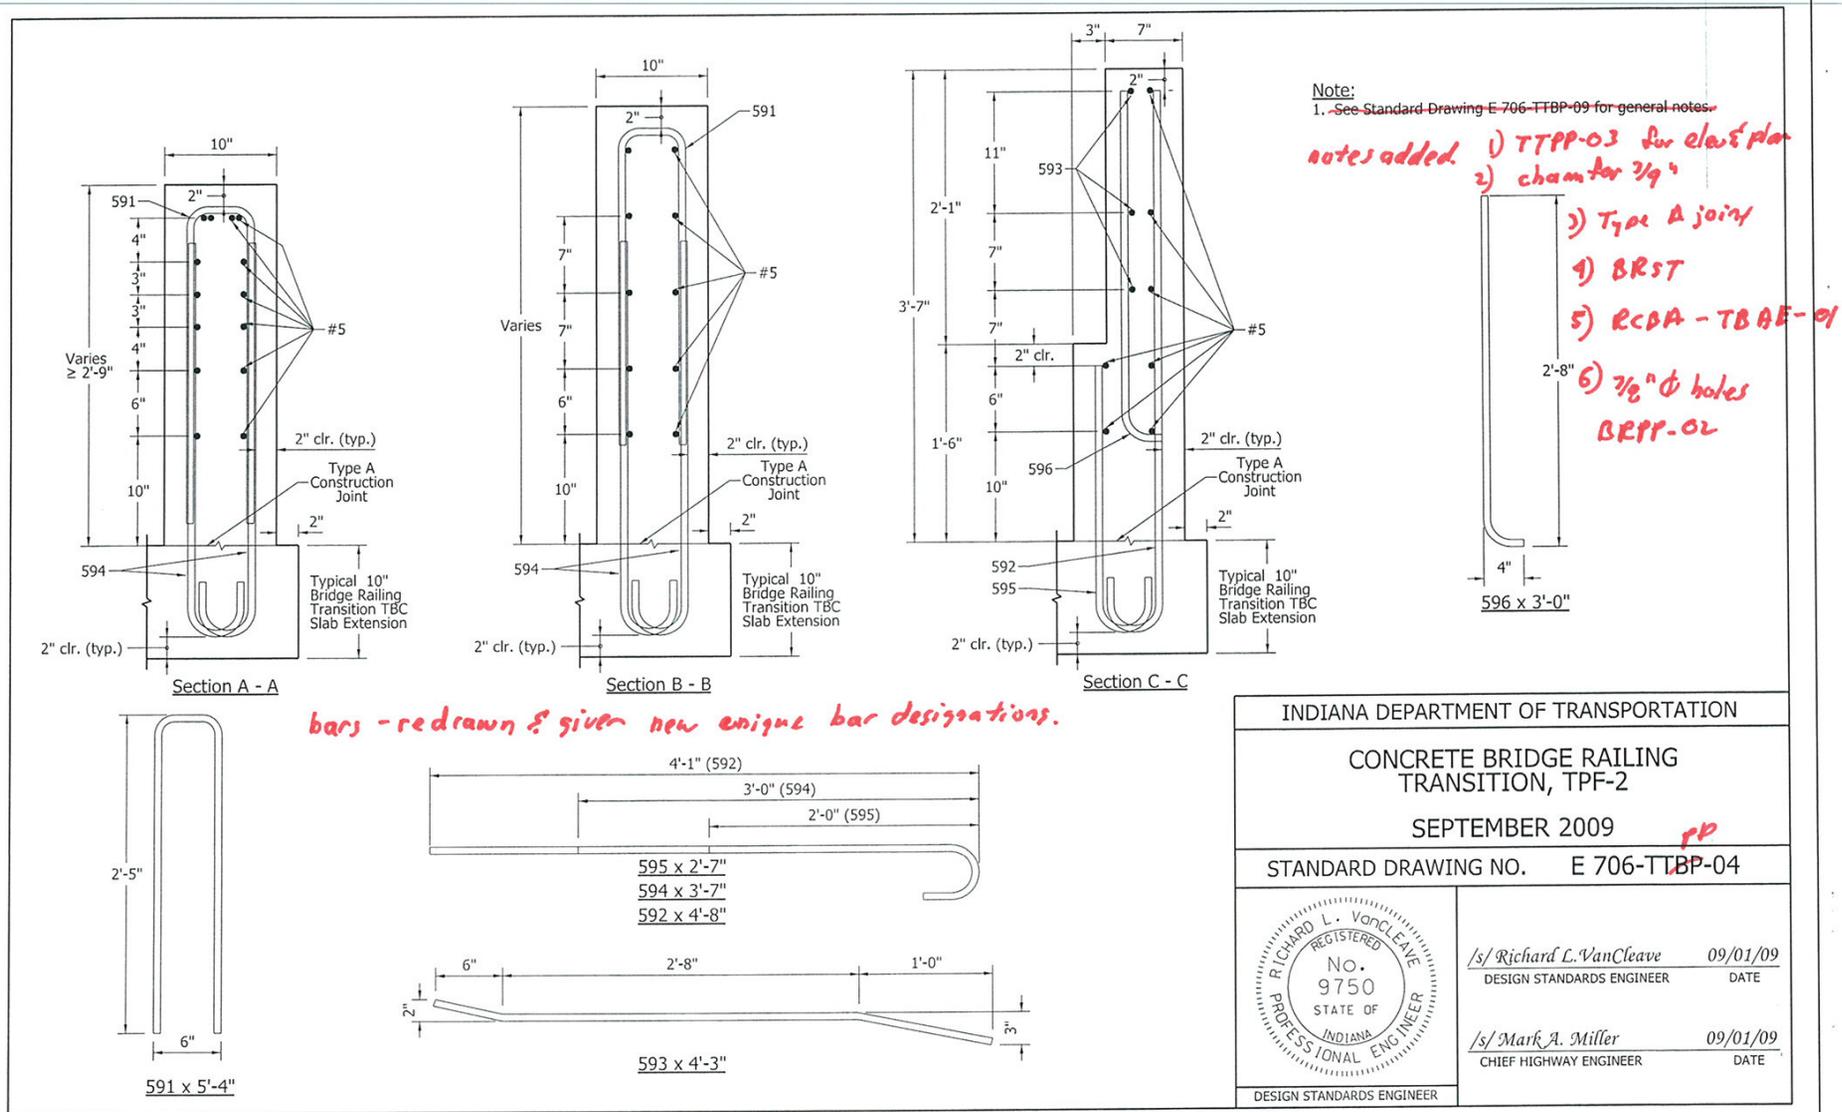

REVISION TO STANDARD DRAWINGS

EXISTING 706-TTBP-05 CONCRETE BRIDGE RAILING TRANSITION, TPS-1 (WITH MARKUPS)

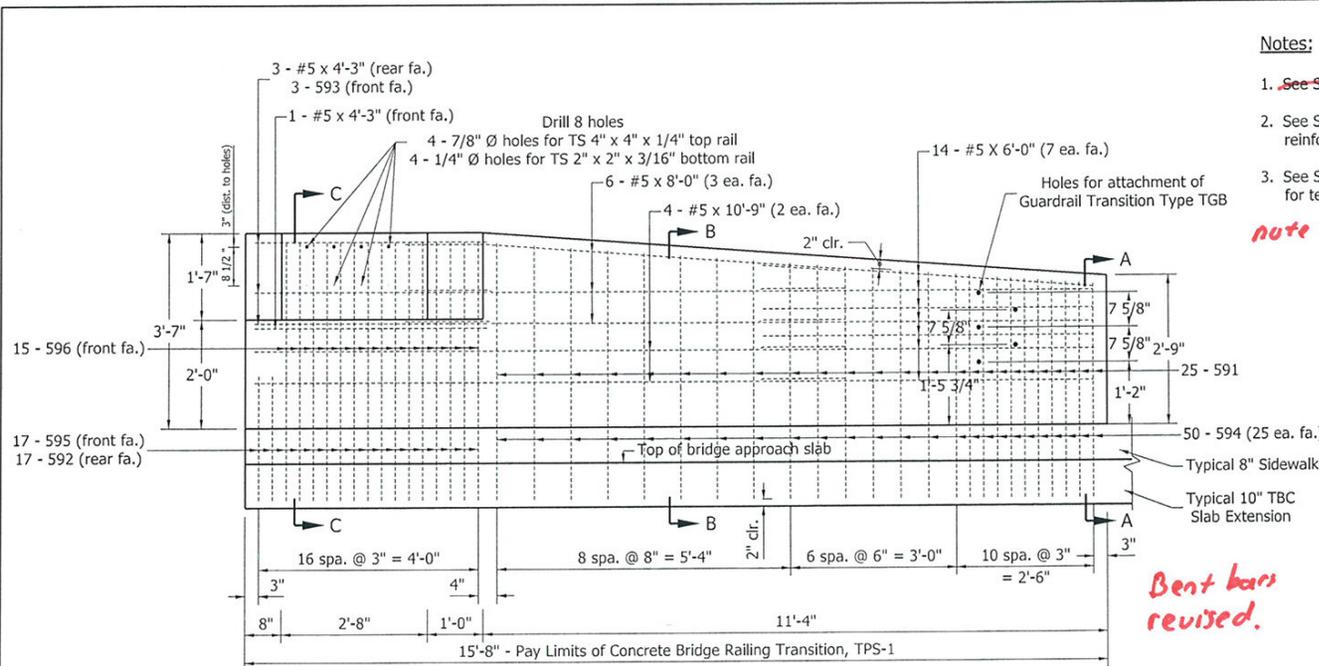


Notes:

1. See Standard Drawing E 706-TTBP-09 for general notes.
  2. See Standard Drawing E 706-TTBP-06 for sections and reinforcing-bar diagrams.
  3. See Standard Drawing E 706-TTBP-01 for holes placement for terminal connection for attachment.
- BRPP-03*  
*note added RCBA-TBAE-01*

BILL OF MATERIALS, TPS-1 EPOXY-COATED REINFORCING STEEL			
Mark / Size	No. of Bars	Total Length	Weight
591 x 5'-4"	25	133'-4"	
592 x 5'-4"	17	90'-8"	
593 x 4'-3"	3	12'-9"	
594 x 4'-3"	50	212'-6"	
595 x 3'-9"	17	63'-9"	
596 x 3'-0"	15	45'-0"	
#5 x 10'-9"	4	43'-0"	
#5 x 8'-0"	6	48'-0"	
#5 x 6'-0"	14	84'-0"	
#5 x 4'-3"	4	17'-0"	
Total Epoxy-Coated Reinforcing Steel		750'-0"	783 lb
MISCELLANEOUS			
Concrete, Class C			1.5 cys
Surface Seal			121 sft

*Bent bars revised.*

*redrawn for clarity*

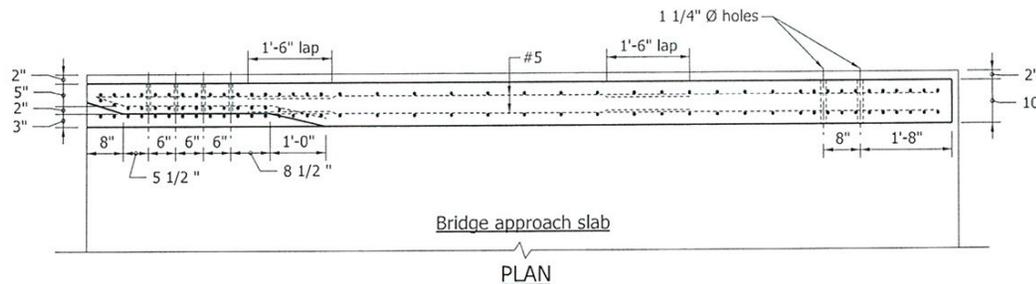

INDIANA DEPARTMENT OF TRANSPORTATION

CONCRETE BRIDGE RAILING TRANSITION, TPS-1

SEPTEMBER 2011 *PF*


STANDARD DRAWING NO. E 706-TTBP-05

	/s/ Richard L. VanCleave	09/01/11
	DESIGN STANDARDS ENGINEER	DATE
	/s/ Mark A. Miller	09/01/11
DESIGN STANDARDS ENGINEER	CHIEF HIGHWAY ENGINEER	DATE




REVISION TO STANDARD DRAWINGS

EXISTING 706-TTBP-07 CONCRETE BRIDGE RAILING TRANSITION, TPS-2 (WITH MARKUPS)

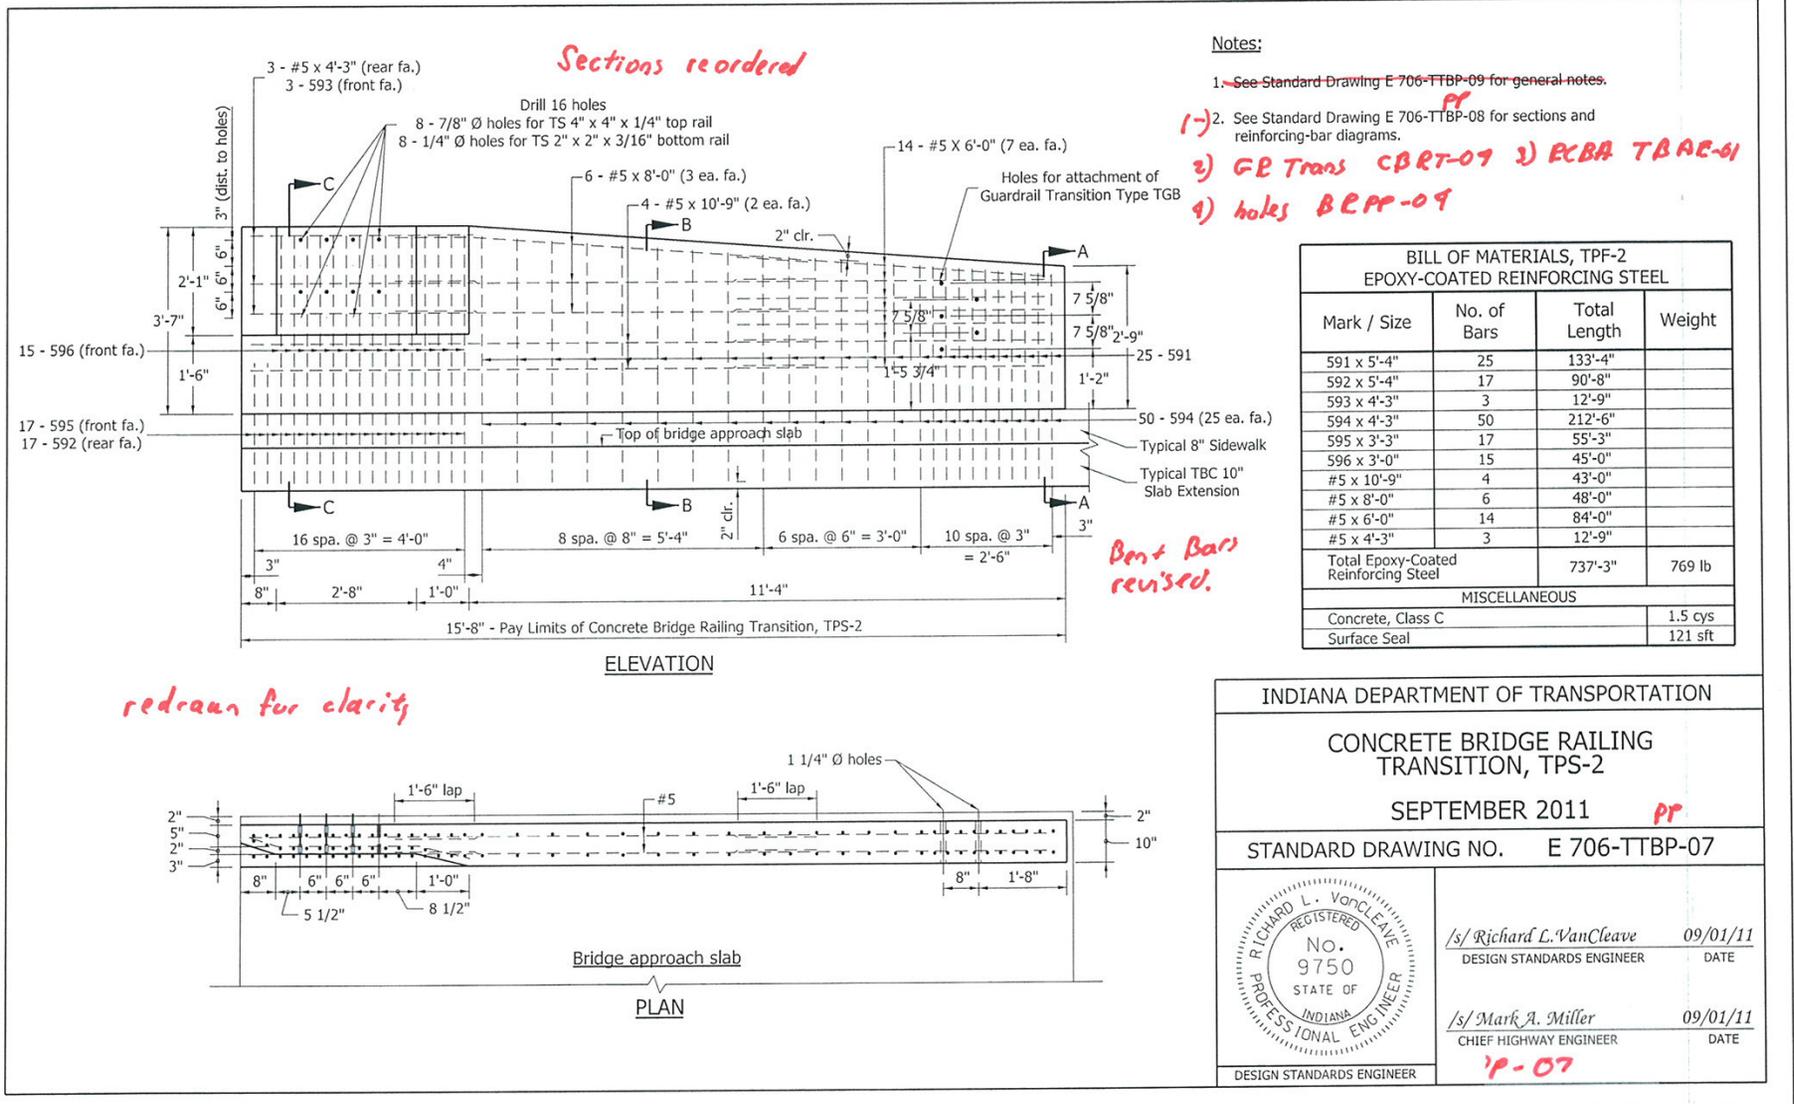

REVISION TO STANDARD DRAWINGS


EXISTING 706-TTBP-08 CONCRETE BRIDGE RAILING TRANSITION, TPS-2 (WITH MARKUPS)

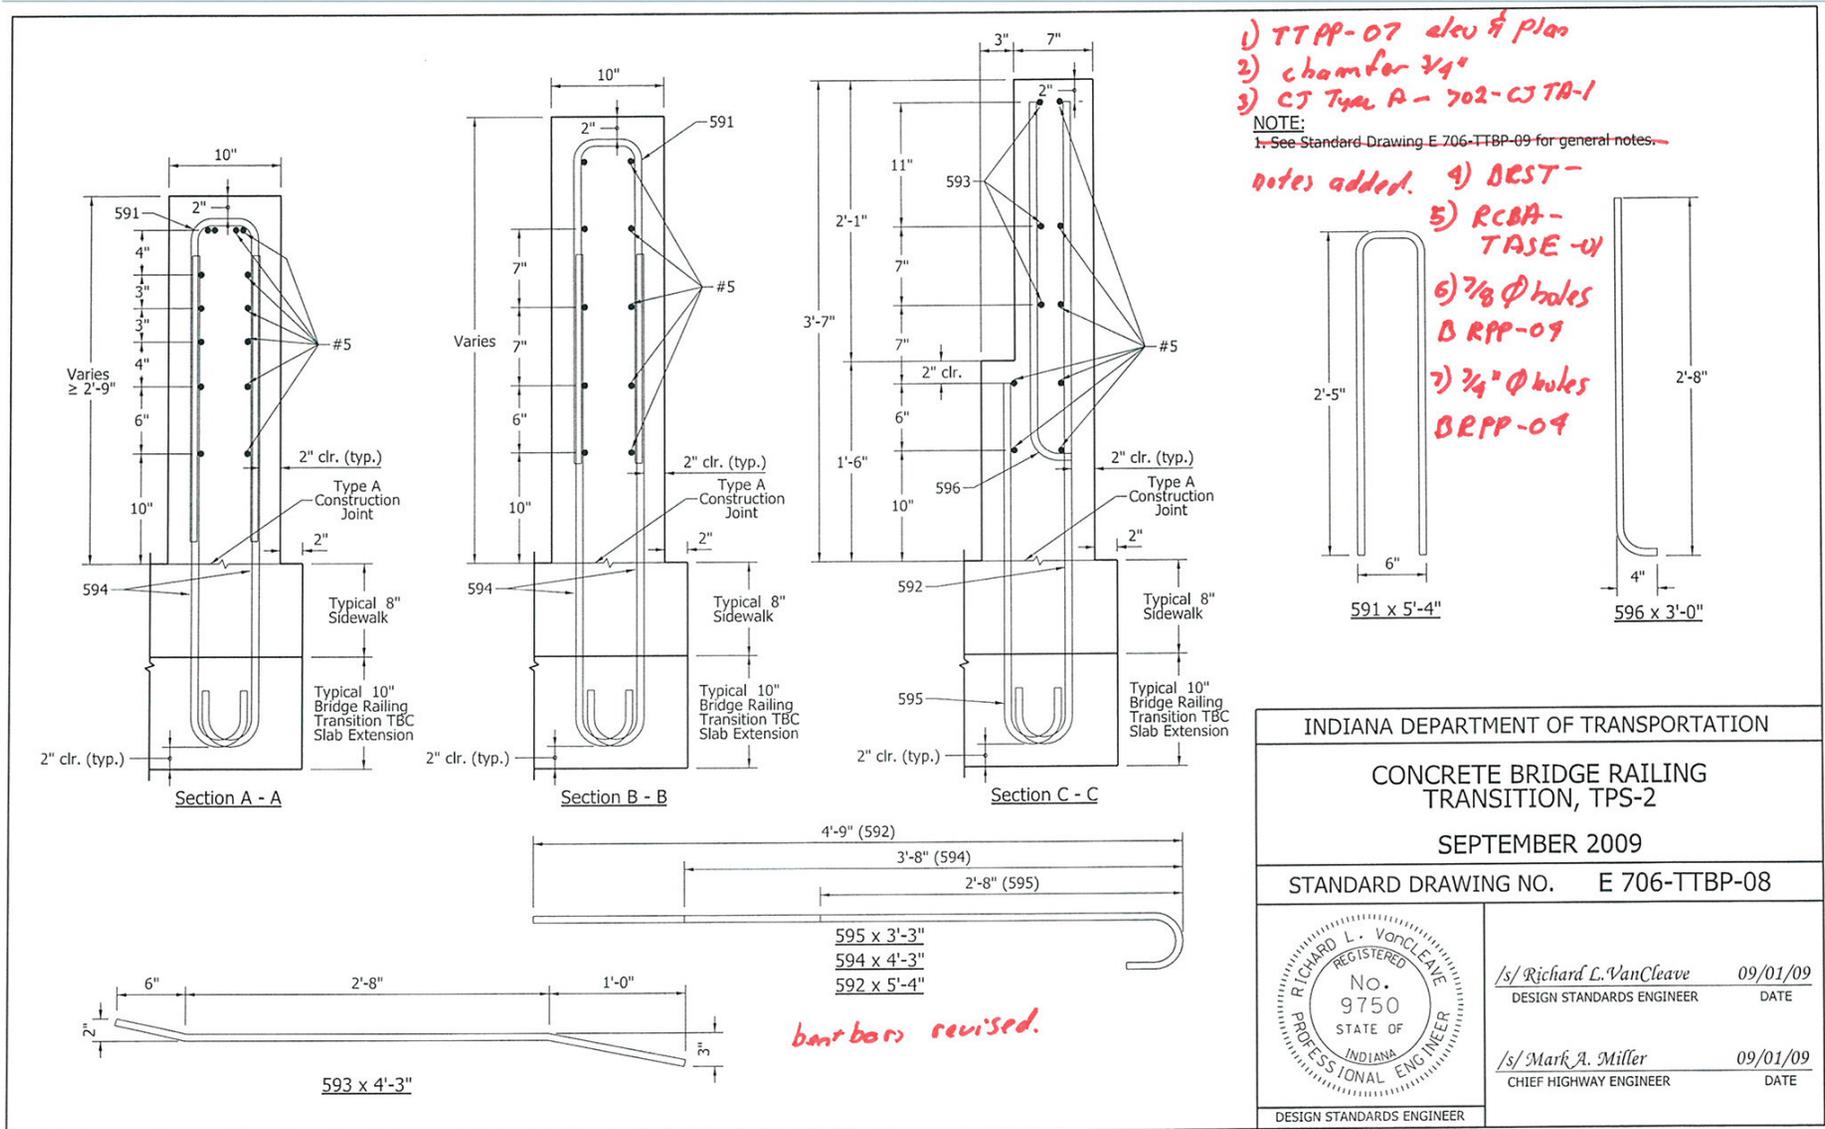

- 1) TTPP-07 elev & plan
- 2) chamfer 3/4"
- 3) CJ Type A - 702-CJTA-1

NOTE:  
 1- See Standard Drawing E.706-TTBP-09 for general notes.

- notes added.
- 4) BEST - RCBA-TASE-W
  - 5) 7/8" holes BRPP-09
  - 6) 3/4" holes BRPP-09

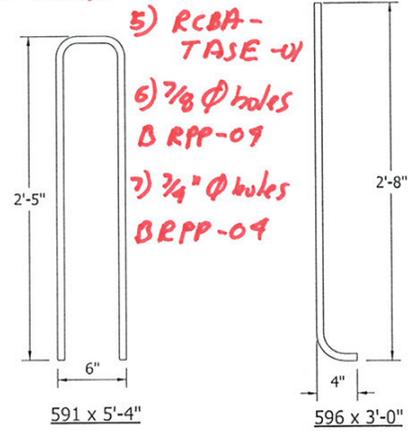

INDIANA DEPARTMENT OF TRANSPORTATION	
CONCRETE BRIDGE RAILING TRANSITION, TPS-2	
SEPTEMBER 2009	
STANDARD DRAWING NO.	E 706-TTBP-08
	/s/ Richard L. VanCleave      09/01/09 DESIGN STANDARDS ENGINEER      DATE
	/s/ Mark A. Miller      09/01/09 CHIEF HIGHWAY ENGINEER      DATE
DESIGN STANDARDS ENGINEER	


REVISION TO STANDARD DRAWINGS

EXISTING 706-TTBP-09 CONCRETE BRIDGE RAILING TRANSITION TYPE TPF, TPS, OR TTX (PROPOSED TO DELETE)

GENERAL NOTES:

1. All reinforcing-bars shall be epoxy coated.
2. Concrete shall be class C.
3. See Standard Drawing E 703-BRST-01 for reinforcing-bar bending details.
4. See Standard Drawing E 706-CBRT-02 for attachment of guardrail transition type TGB.
5. See Standard Drawing E 706-TASE-01, -02 and -05 for bridge-railing transition type TBC slab extension.


*Sheet deleted.*

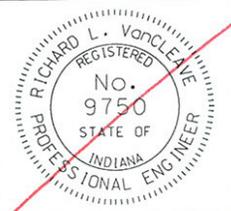INDIANA DEPARTMENT OF TRANSPORTATION	
CONCRETE BRIDGE RAILING TRANSITION TYPE TPF, TPS, OR TTX SEPTEMBER 2009	
STANDARD DRAWING NO. E 706-TTBP-09	
	<i>/s/ Richard L. VanCleave</i> 09/01/09 DESIGN STANDARDS ENGINEER DATE
	<i>/s/ Mark A. Miller</i> 09/01/09 CHIEF HIGHWAY ENGINEER DATE
DESIGN STANDARDS ENGINEER	


FIRS

REVISION TO STANDARD DRAWINGS

706-TTPP-01 CONCRETE BRIDGE RAILING TRANSITION, TPF-1 (DRAFT)

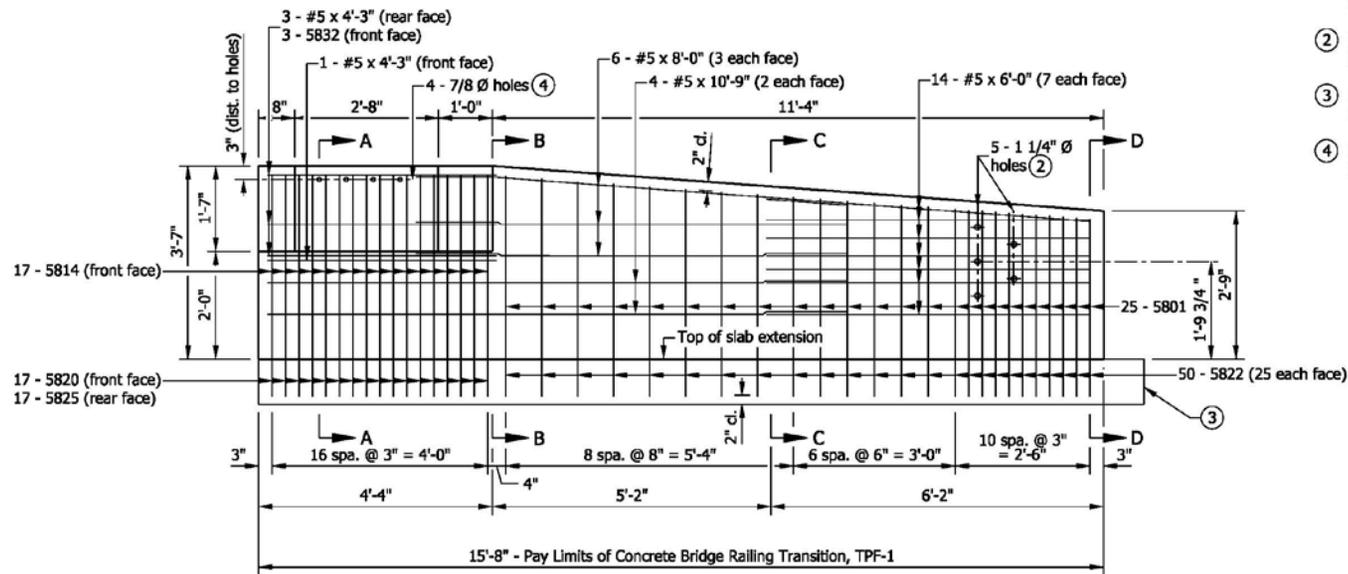

ELEVATION

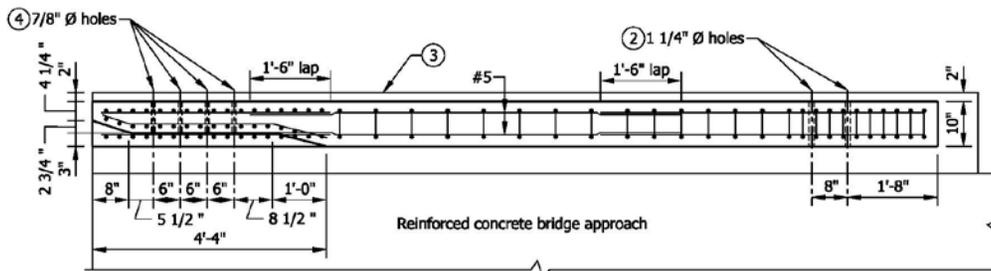

PLAN

NOTES

1. See Standard Drawing E 706-TTPP-02 for sections and reinforcing bar diagrams.
- ② Holes for attachment of guardrail transition type TGB. See Standard Drawing E 706-CBRT-04 for details.
- ③ RCBA extension for bridge railing transition type TPF-1. See Standard Drawing E 609-TBAE-01 for details.
- ④ Holes for attachment of steel bridge railing type PF-1. See Standard Drawing E 706-BRPP-01 for details.

BILL OF MATERIALS		
Quantities are for one concrete bridge railing transition type TPF-1.		
EPOXY-COATED REINFORCING STEEL		
MARK / SIZE	NO. OF BARS	WEIGHT
5801	25	
5814	17	
5820	17	
5822	50	
5825	17	
5832	3	
#5 x 10'-9"	4	
#5 x 8'-0"	6	
#5 x 6'-0"	14	
#5 x 4'-3"	4	
TOTAL EPOXY-COATED REINFORCING STEEL		730 LBS
MISCELLANEOUS		
CONCRETE, CLASS C		1.5 CYS
SURFACE SEAL		119 SFT

INDIANA DEPARTMENT OF TRANSPORTATION

CONCRETE BRIDGE RAILING TRANSITION, TPF-1


SEPTEMBER 2012

STANDARD DRAWING NO. E 706-TTPP-01

	DESIGN STANDARDS ENGINEER	DATE
	CHIEF HIGHWAY ENGINEER	DATE

REVISION TO STANDARD DRAWINGS



706-TTPP-02 CONCRETE BRIDGE RAILING TRANSITION, TPF-1 (DRAFT)

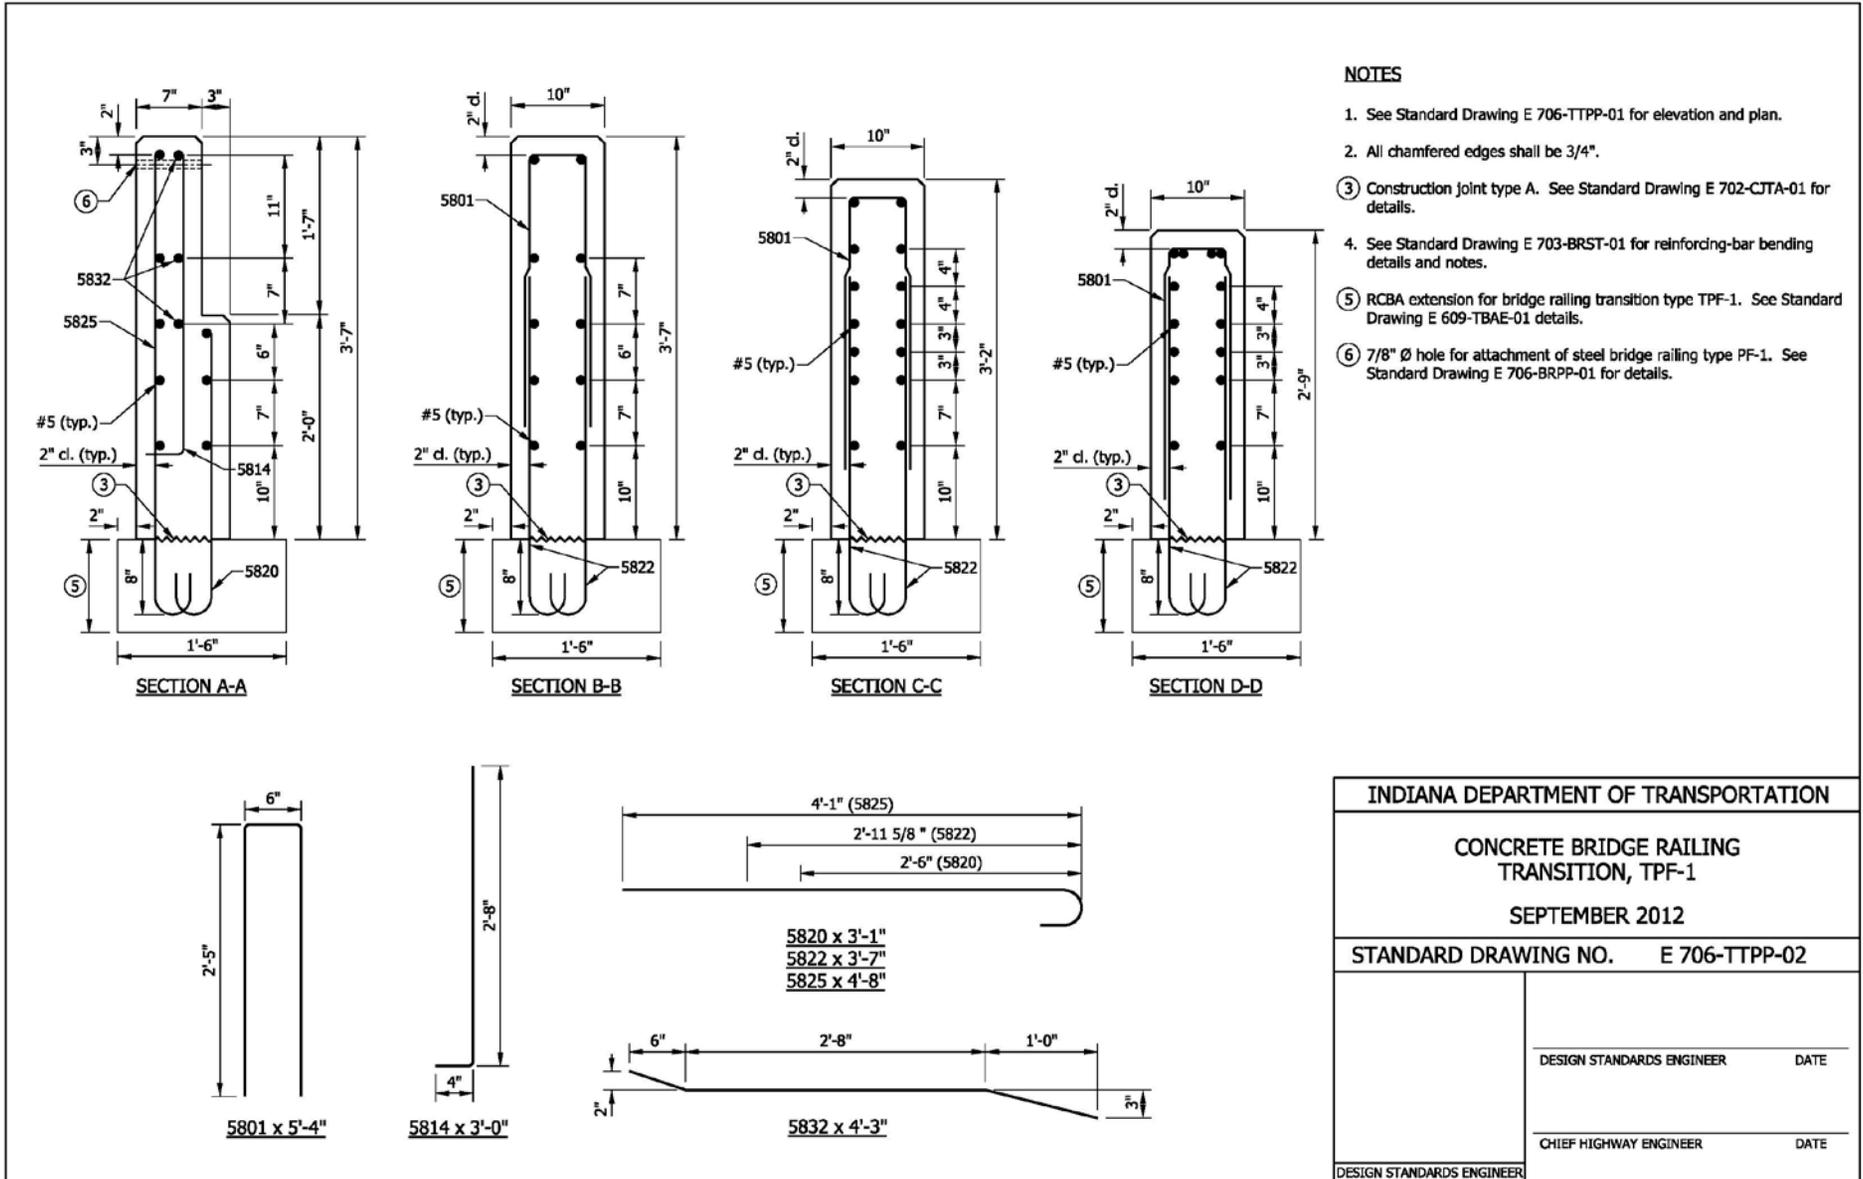

INDIANA DEPARTMENT OF TRANSPORTATION	
CONCRETE BRIDGE RAILING TRANSITION, TPF-1	
SEPTEMBER 2012	
STANDARD DRAWING NO.	E 706-TTPP-02
DESIGN STANDARDS ENGINEER	DATE
CHIEF HIGHWAY ENGINEER	DATE
DESIGN STANDARDS ENGINEER	

REVISION TO STANDARD DRAWINGS

706-TTPP-03 CONCRETE BRIDGE RAILING TRANSITION, TPF-2 (DRAFT)

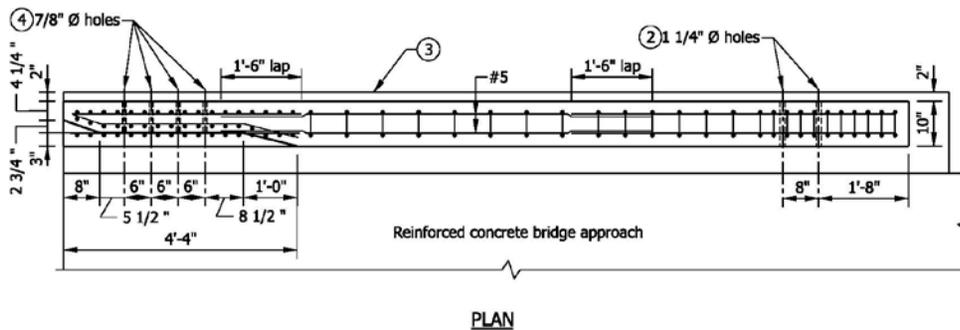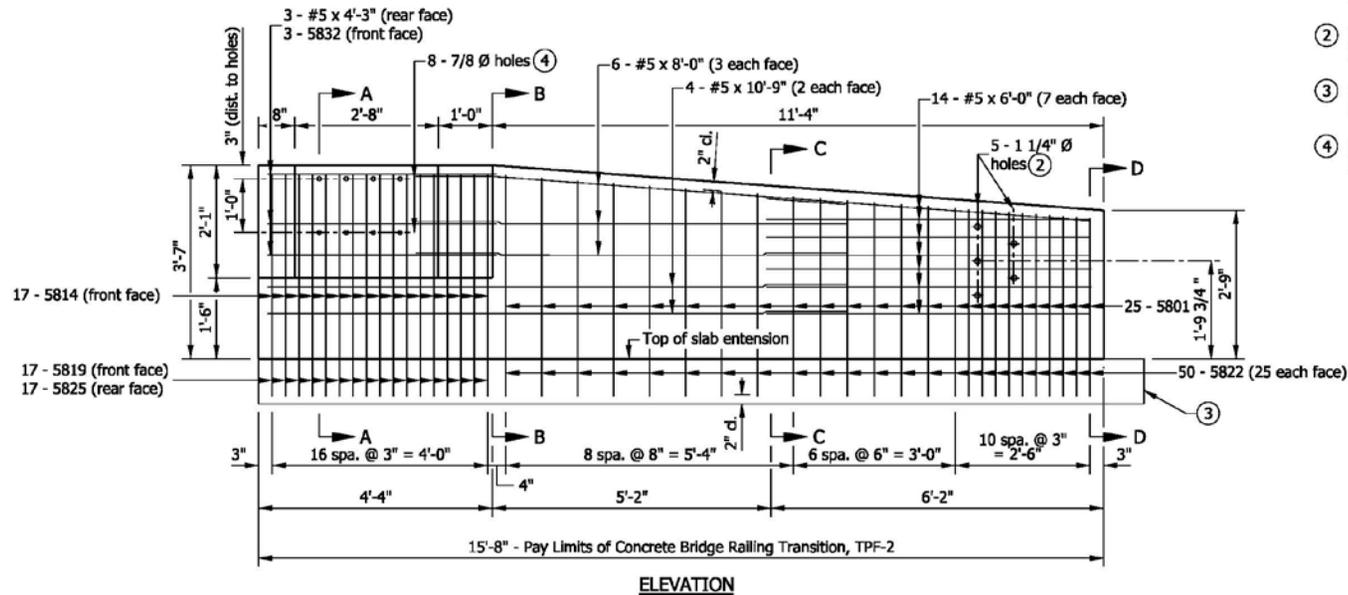

NOTES


1. See Standard Drawing E 706-TTPP-04 for sections and reinforcing bar diagrams.
2. Holes for attachment of guardrail transition type TGB. See Standard Drawing E 706-CBRT-04 for details.
3. RCBA extension for bridge railing transition type TPF-2. See Standard Drawing E 609-TBAE-01 for details.
4. Holes for attachment of steel bridge railing type PF-2. See Standard Drawing E 706-BRPP-02 for details.

BILL OF MATERIALS		
Quantities are for one concrete bridge railing transition type TPF-2.		
EPOXY-COATED REINFORCING STEEL		
MARK / SIZE	NO. OF BARS	WEIGHT
5801	25	
5814	17	
5819	17	
5822	50	
5825	17	
5832	3	
#5 x 10'-9"	4	
#5 x 8'-0"	6	
#5 x 6'-0"	14	
#5 x 4'-3"	3	
TOTAL EPOXY-COATED REINFORCING STEEL		717 LBS
MISCELLANEOUS		
CONCRETE, CLASS C		1.5 CYS
SURFACE SEAL		119 SFT

INDIANA DEPARTMENT OF TRANSPORTATION	
CONCRETE BRIDGE RAILING TRANSITION, TPF-2	
SEPTEMBER 2012	
STANDARD DRAWING NO.	E 706-TTPP-03
DESIGN STANDARDS ENGINEER	DATE
CHIEF HIGHWAY ENGINEER	DATE
DESIGN STANDARDS ENGINEER	


REVISION TO STANDARD DRAWINGS

706-TTPP-04 CONCRETE BRIDGE RAILING TRANSITION, TPF-2 (DRAFT)

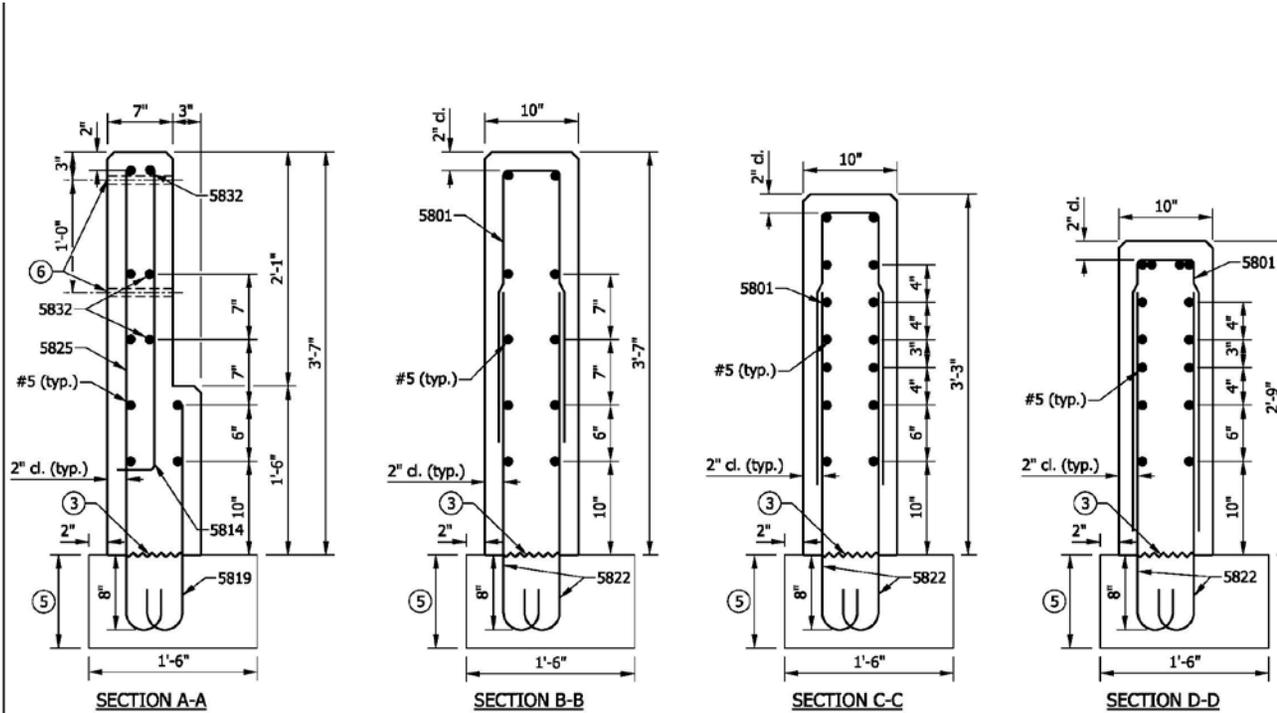


NOTES


1. See Standard Drawing E 706-TTPP-03 for elevation and plan.
2. All chamfered edges shall be 3/4".
- ③ Construction joint type A. See Standard Drawing E 702-CJTA-01 for details.
4. See Standard Drawing E 703-BRST-01 for reinforcing-bar bending details and notes.
- ⑤ RCBA extension for bridge railing transition type TPF-2. See Standard Drawing E 609-TBAE-01 for details.
- ⑥ 7/8" Ø hole for attachment of steel bridge railing type PF-2. See Standard Drawing E 706-BRPP-02 for details.

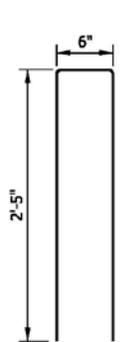

5801 x 5'-4"

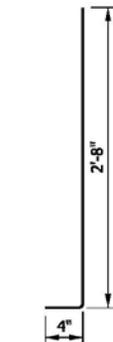

5814 x 3'-0"

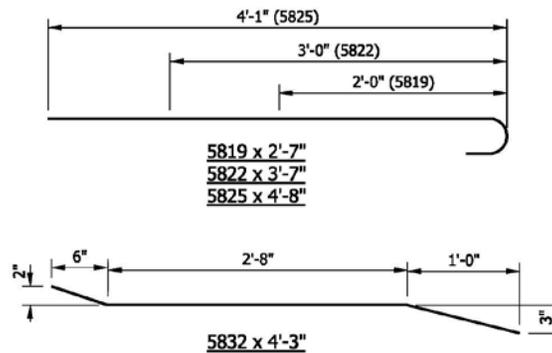


5819 x 2'-7"  
 5822 x 3'-7"  
 5825 x 4'-8"

5832 x 4'-3"

INDIANA DEPARTMENT OF TRANSPORTATION	
CONCRETE BRIDGE RAILING TRANSITION, TPF-2	
SEPTEMBER 2012	
STANDARD DRAWING NO. E 706-TTPP-04	
DESIGN STANDARDS ENGINEER	DATE
CHIEF HIGHWAY ENGINEER	DATE
DESIGN STANDARDS ENGINEER	

REVISION TO STANDARD DRAWINGS

706-TTPP-05 CONCRETE BRIDGE RAILING TRANSITION, TPS-1 (DRAFT)

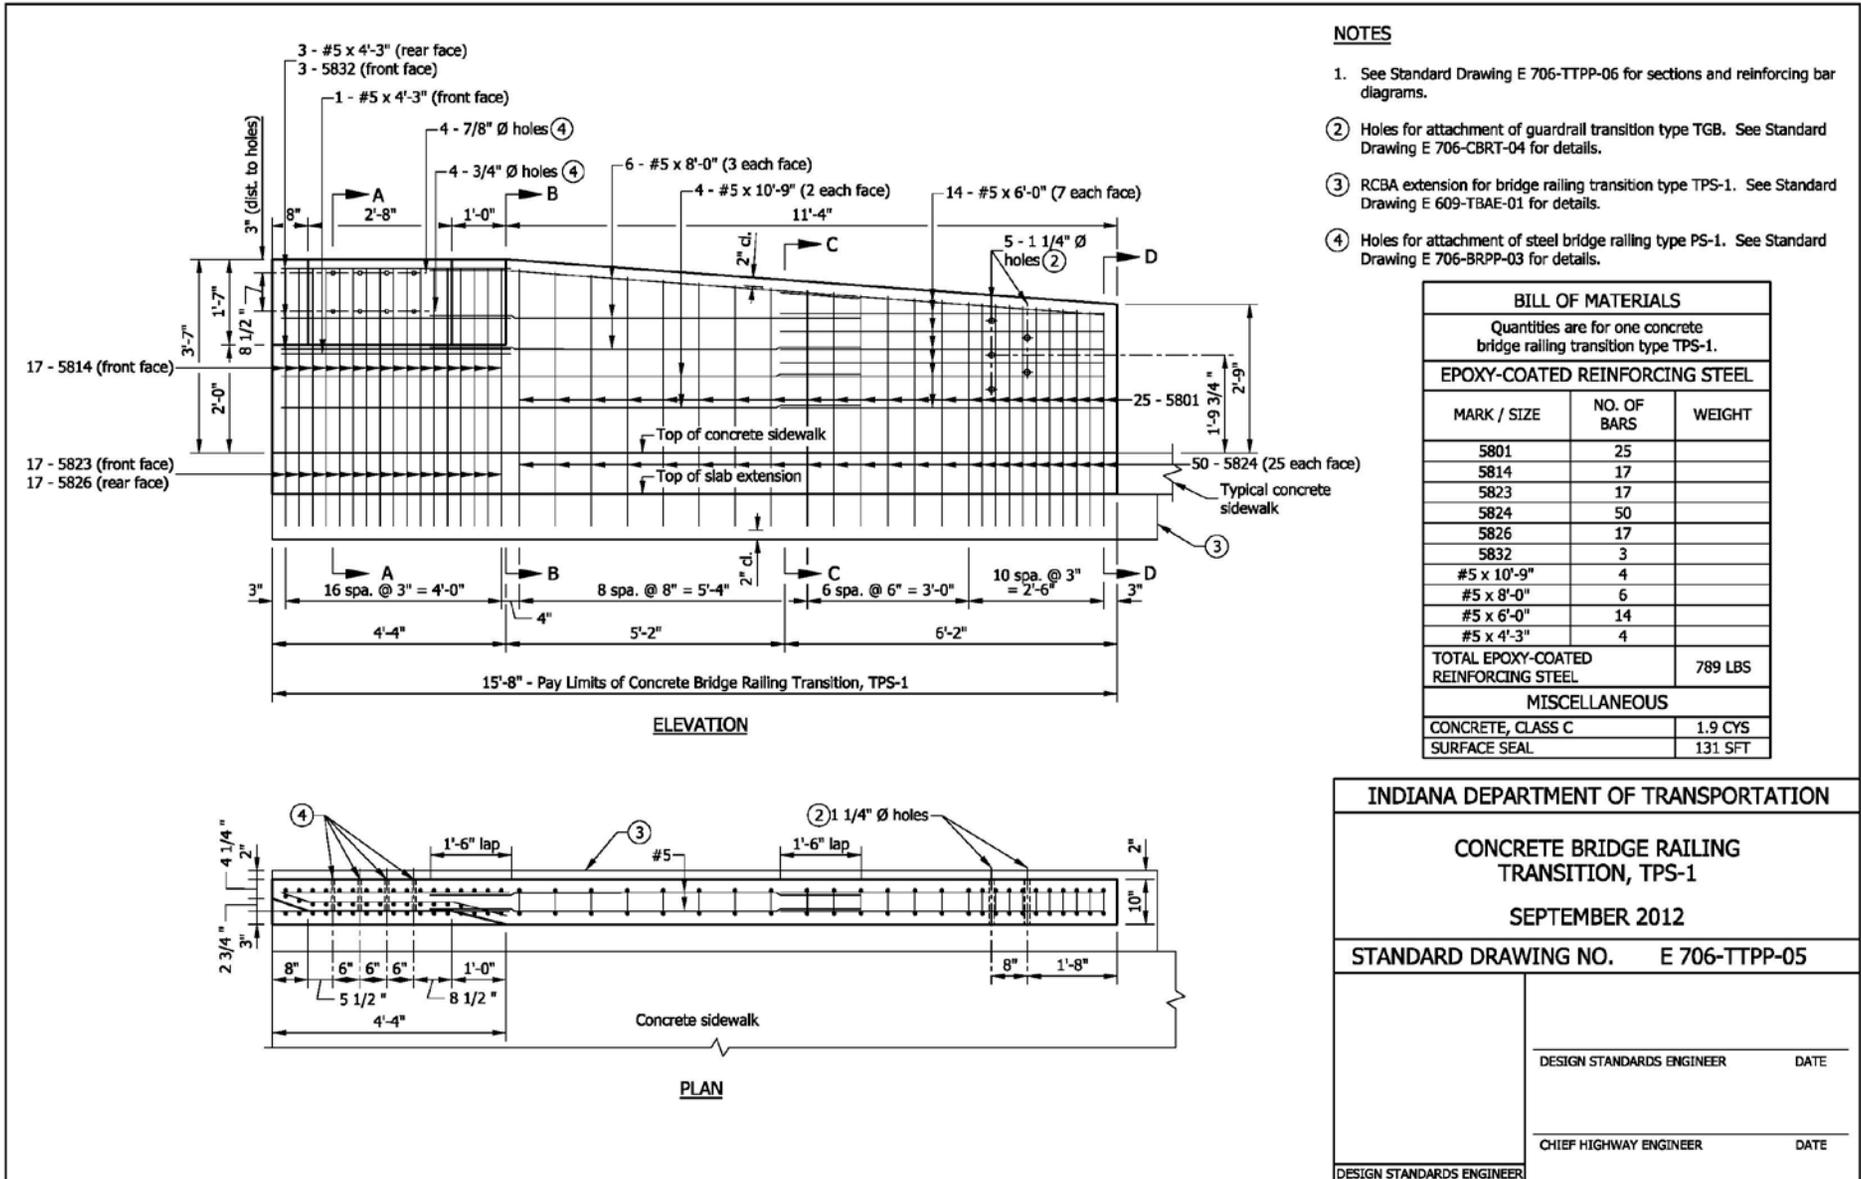

**NOTES**


1. See Standard Drawing E 706-TTPP-06 for sections and reinforcing bar diagrams.
- ② Holes for attachment of guardrail transition type TGB. See Standard Drawing E 706-CBRT-04 for details.
- ③ RCBA extension for bridge railing transition type TPS-1. See Standard Drawing E 609-TBAE-01 for details.
- ④ Holes for attachment of steel bridge railing type PS-1. See Standard Drawing E 706-BRPP-03 for details.

BILL OF MATERIALS		
Quantities are for one concrete bridge railing transition type TPS-1.		
EPOXY-COATED REINFORCING STEEL		
MARK / SIZE	NO. OF BARS	WEIGHT
5801	25	
5814	17	
5823	17	
5824	50	
5826	17	
5832	3	
#5 x 10'-9"	4	
#5 x 8'-0"	6	
#5 x 6'-0"	14	
#5 x 4'-3"	4	
TOTAL EPOXY-COATED REINFORCING STEEL		789 LBS
MISCELLANEOUS		
CONCRETE, CLASS C		1.9 CYS
SURFACE SEAL		131 SFT

INDIANA DEPARTMENT OF TRANSPORTATION	
CONCRETE BRIDGE RAILING TRANSITION, TPS-1	
SEPTEMBER 2012	
STANDARD DRAWING NO.	E 706-TTPP-05
DESIGN STANDARDS ENGINEER	DATE
CHIEF HIGHWAY ENGINEER	DATE
DESIGN STANDARDS ENGINEER	


REVISION TO STANDARD DRAWINGS

706-TTPP-06 CONCRETE BRIDGE RAILING TRANSITION, TPS-1 (DRAFT)

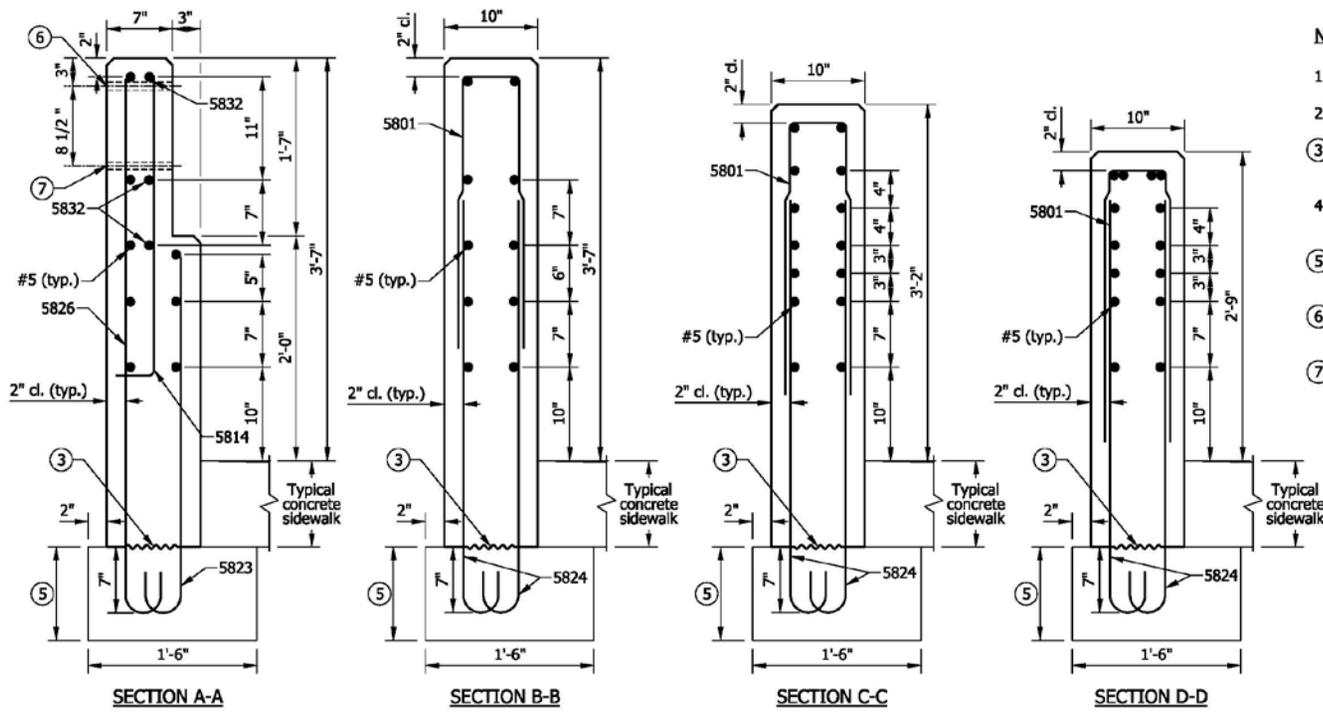

NOTES

1. See Standard Drawing E 706-TTPP-05 for elevation and plan.
2. All chamfered edges shall be 3/4".
3. Construction jointing type A. See Standard Drawing E 702-CJTA-01 for details.
4. See Standard Drawing E 703-BRST-01 for reinforcing-bar bending details and notes.
5. RCBA extension for bridge railing transition type TPS-1. See Standard Drawing E 609-TBAE-01 for details.
6. 7/8" Ø hole for attachment of steel bridge railing type PS-1, large rail. See Standard Drawing E 706-BRPP-03 for details.
7. 3/4" Ø hole for attachment of steel bridge railing type PS-1, small rail. See Standard Drawing E 706-BRPP-03 for details.

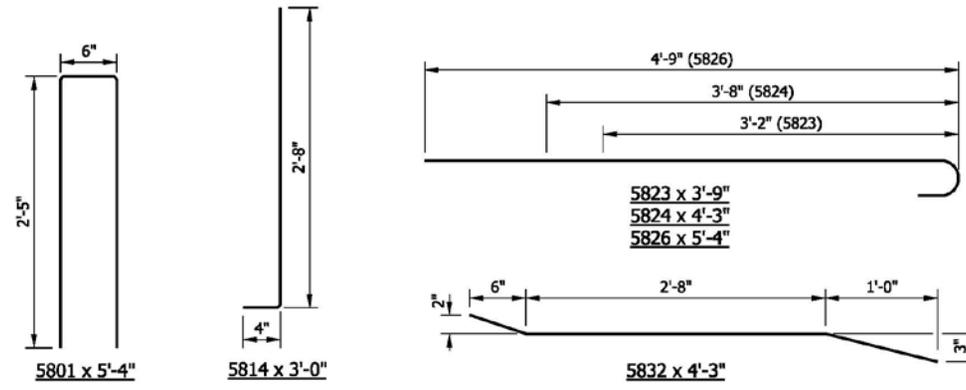


INDIANA DEPARTMENT OF TRANSPORTATION	
CONCRETE BRIDGE RAILING TRANSITION, TPS-1	
SEPTEMBER 2012	
STANDARD DRAWING NO. E 706-TTPP-06	
DESIGN STANDARDS ENGINEER	DATE
CHIEF HIGHWAY ENGINEER	DATE
DESIGN STANDARDS ENGINEER	

REVISION TO STANDARD DRAWINGS


706-TTPP-07 CONCRETE BRIDGE RAILING TRANSITION, TPS-2 (DRAFT)

NOTES

1. See Standard Drawing E 706-TTPP-08 for sections and reinforcing bar diagrams.
- ② Holes for attachment of guardrail transition type TGB. See Standard Drawing E 706-CBRT-04 for details.
- ③ RCBA extension for bridge railing transition type TPS-2. See Standard Drawing E 609-TBAE-01 for details.
- ④ Holes for attachment of steel bridge railing type PS-2. See Standard Drawing E 706-BRPP-04 for details.

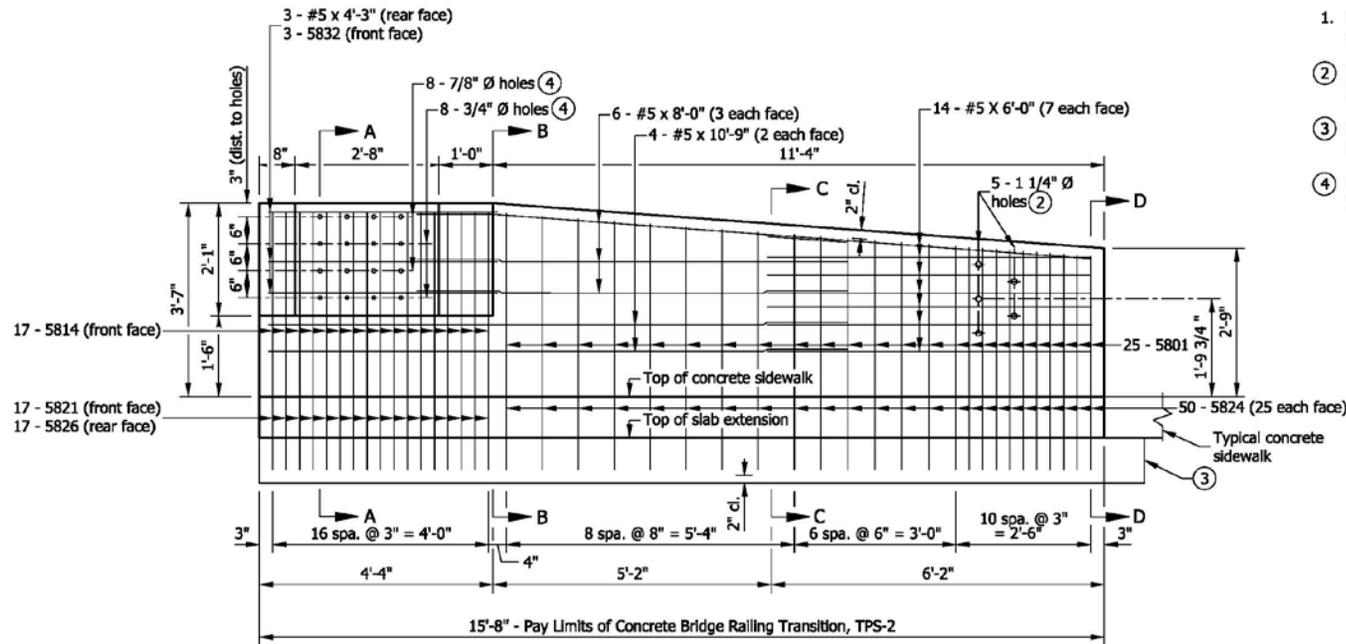

ELEVATION

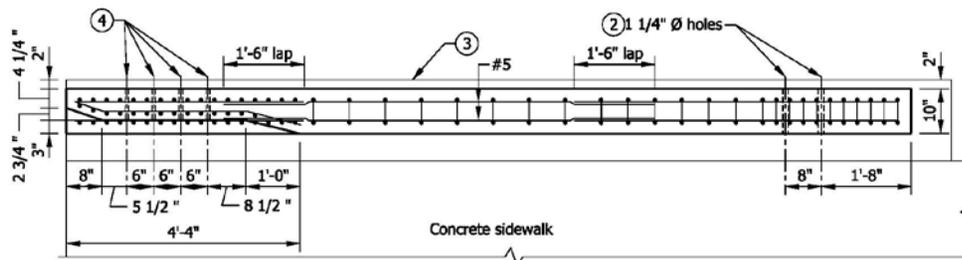

PLAN

BILL OF MATERIALS		
Quantities are for one concrete bridge railing transition type TPS-2.		
EPOXY-COATED REINFORCING STEEL		
MARK / SIZE	NO. OF BARS	WEIGHT
5801	25	
5814	17	
5821	17	
5824	50	
5826	17	
5832	3	
#5 x 10'-9"	4	
#5 x 8'-0"	6	
#5 x 6'-0"	14	
#5 x 4'-3"	3	
TOTAL EPOXY-COATED REINFORCING STEEL		775 LBS
MISCELLANEOUS		
CONCRETE, CLASS C		1.9 CYS
SURFACE SEAL		131 SFT

INDIANA DEPARTMENT OF TRANSPORTATION

CONCRETE BRIDGE RAILING TRANSITION, TPS-2

SEPTEMBER 2012

STANDARD DRAWING NO. E 706-TTPP-07



DESIGN STANDARDS ENGINEER	DATE
	CHIEF HIGHWAY ENGINEER
DATE	

REVISION TO STANDARD DRAWINGS

706-TTPP-08 CONCRETE BRIDGE RAILING TRANSITION, TPS-2 (DRAFT)

NOTES

1. See Standard Drawing E 706-TTPP-07 for elevation and plan.
2. All chamfered edges shall be 3/4".
3. Construction joint type A. See Standard Drawing E 702-CJTA-01 for details.
4. See Standard Drawing E 703-BRST-01 for reinforcing-bar bending details and notes.
5. RCBA extension for bridge railing transition type TPS-2. See Standard Drawing E 609-TBAE-01 for details.
6. 7/8" Ø hole for attachment of steel bridge railing type PS-2, large rail. See Standard Drawing E 706-BRPP-04 for details.
7. 3/4" Ø hole for attachment of steel bridge railing type PS-2, small rail. See Standard Drawing E 706-BRPP-04 for details.

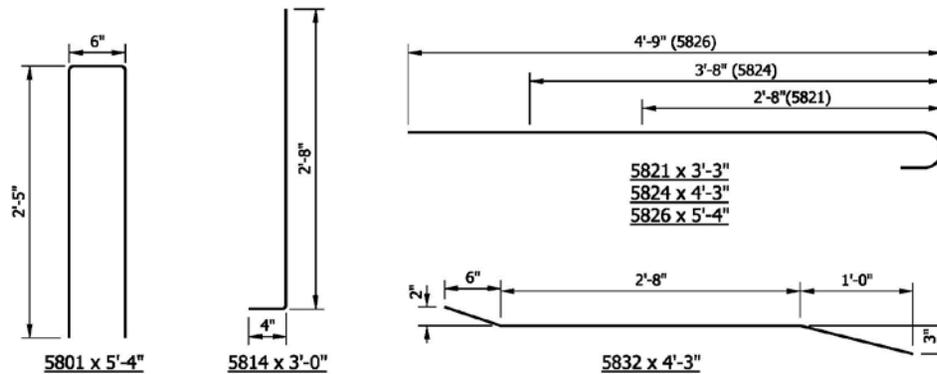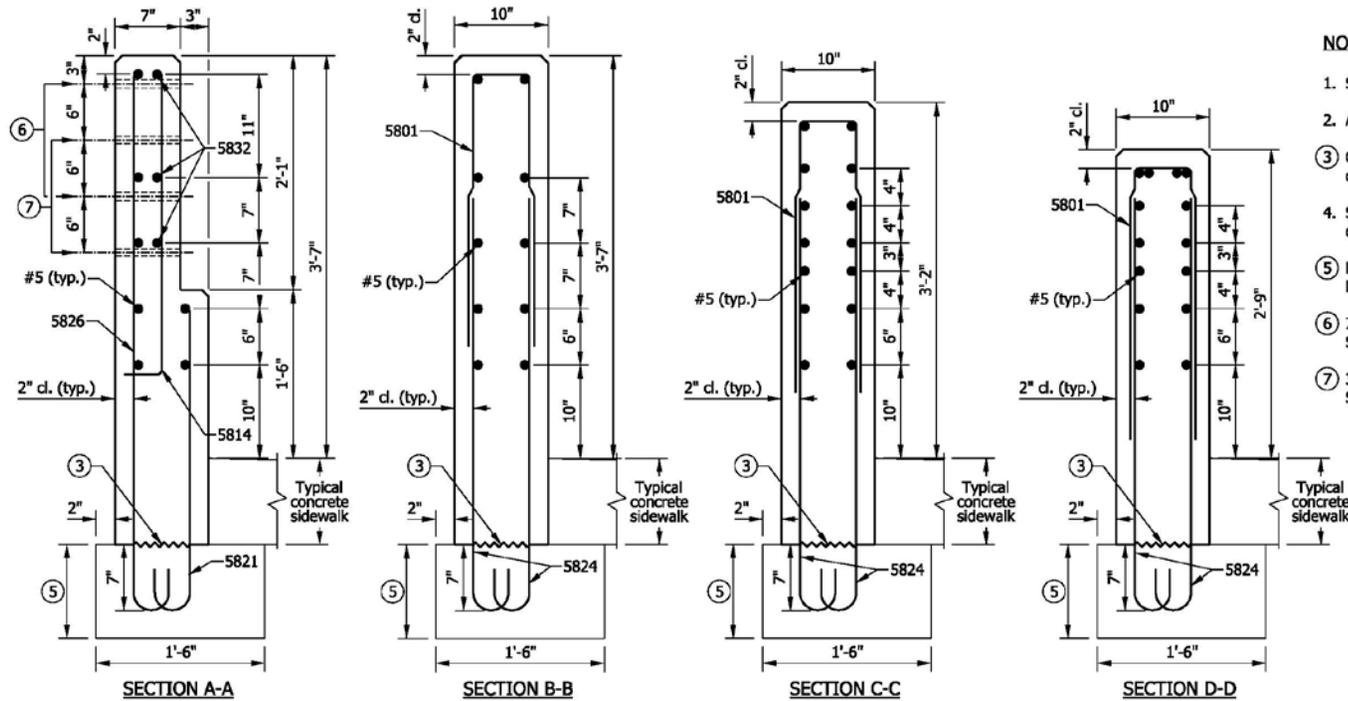


INDIANA DEPARTMENT OF TRANSPORTATION	
CONCRETE BRIDGE RAILING TRANSITION, TPS-2	
SEPTEMBER 2012	
STANDARD DRAWING NO. E 706-TTPP-08	
DESIGN STANDARDS ENGINEER	DATE
CHIEF HIGHWAY ENGINEER	DATE
DESIGN STANDARDS ENGINEER	

Item No.02 03/15/12 (2012 SS)(contd.)  
 Mr. Strain  
 Date: 03/15/12

REVISION TO STANDARD DRAWINGS

EXISTING 706-TTBT-01 CONCRETE BRIDGE RAILING TRANSITION TBT PLAN AND ELEVATION (WITH MARKUPS)

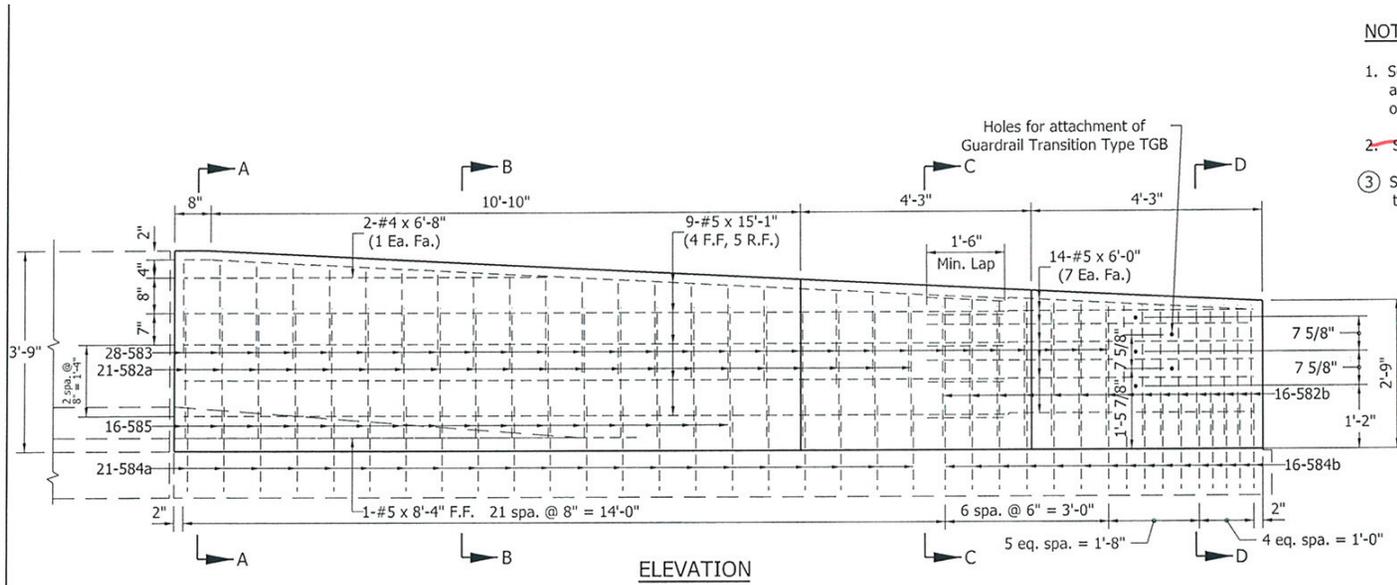

ELEVATION


NOTES:

1. See Standard Drawing E 706-~~TTBT~~-02 for Sections A-A, B-B, C-C and D-D and Drawing E 706-~~TTBT~~-03 for reinforcement and bill of materials.
2. See Standard Drawing E 706-TASE-05 for General Notes.
3. See Standard Drawing E 706-CBRT-02 for details of guardrail transition type TGB attachment.

**TTFT**  
**TTGB-4**  
**RCBA TBAC-02**

3'-9" TRUCK HEIGHT THRIE BEAM/  
 CONCRETE BRIDGE RAILING TRANSITION

INDIANA DEPARTMENT OF TRANSPORTATION	
CONCRETE BRIDGE RAILING TRANSITION TBT <b>TTFT</b>	
PLAN AND ELEVATION	
SEPTEMBER 2011 <b>TTFT</b>	
STANDARD DRAWING NO.	E 706-TTBT-01
	/s/ Richard L. VanCleave 09/01/11 DESIGN STANDARDS ENGINEER DATE
	/s/ Mark A. Miller 09/01/11 CHIEF HIGHWAY ENGINEER DATE

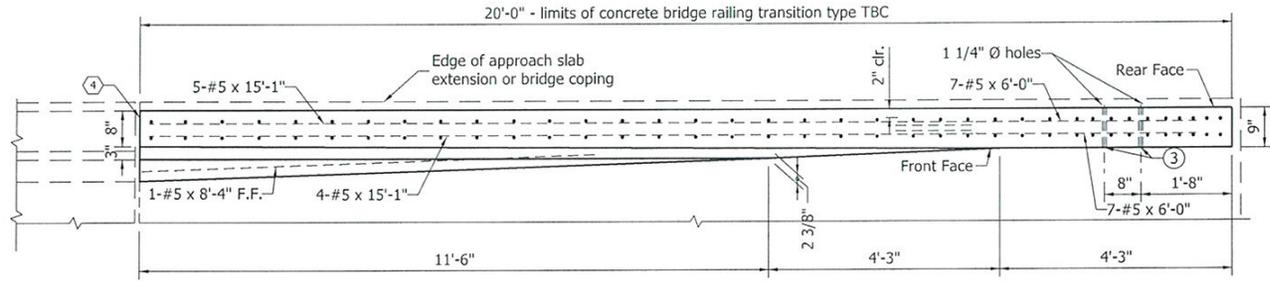


PLAN

REVISION TO STANDARD DRAWINGS


EXISTING 706-TTBT-02 CONCRETE BRIDGE RAILING TRANSITION TYPE TBT

NOTES:


1. See Standard Drawing E 706-TASE-05 for General Notes.

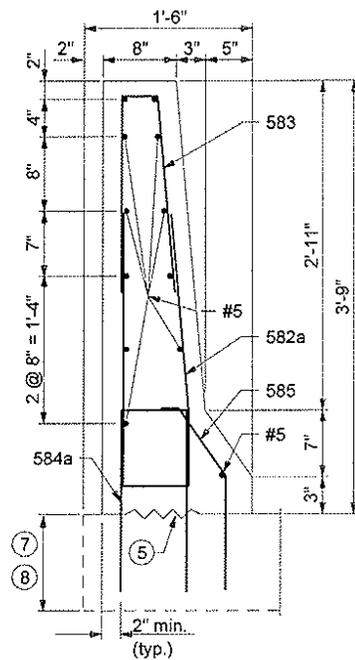


SECTION A-A

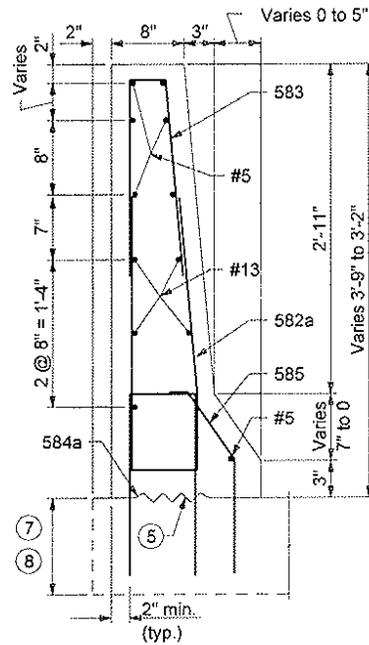

SECTION B-B

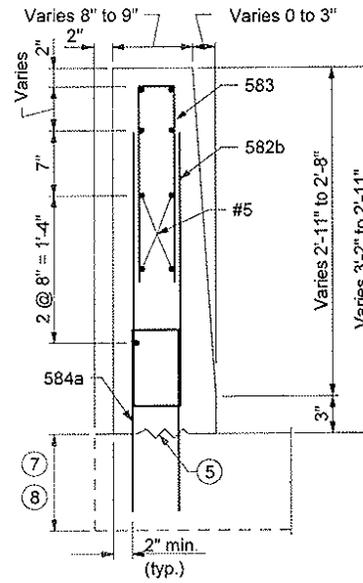

SECTION C-C

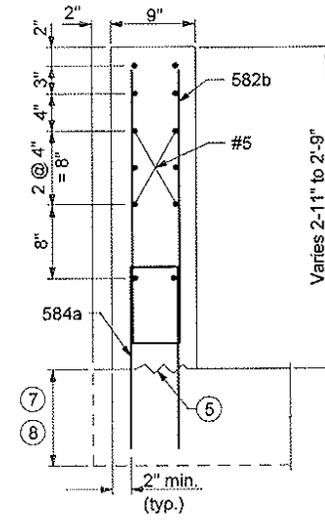

SECTION D-D

45" TRUCK HEIGHT THRIE BEAM/  
 CONCRETE BRIDGE RAILING TRANSITION








INDIANA DEPARTMENT OF TRANSPORTATION	
CONCRETE BRIDGE RAILING TRANSITION TYPE TBT	
SEPTEMBER 2006	
STANDARD DRAWING NO. E 706-TTBT-02	
	<i>1st Richard L. VanCleave</i> 9-01-06 DESIGN STANDARDS ENGINEER DATE
	<i>1st Richard N. Spitzer</i> 9-01-06 CHIEF HIGHWAY ENGINEER DATE

REVISION TO STANDARD DRAWINGS

EXISTING 706-TTBT-03 CONCRETE BRIDGE RAILING TRANSITION TYPE TBT

NOTE:

1. See Standard Drawing E 706-TASE-05 for General Notes.

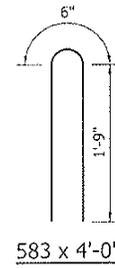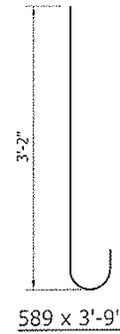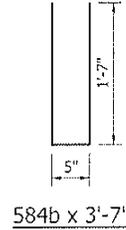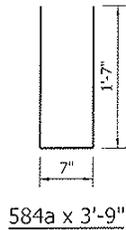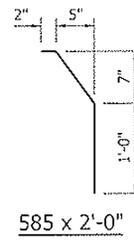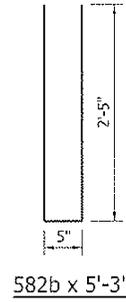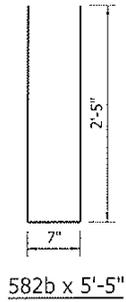

3'-9" TRUCK HEIGHT THRIE BEAM/  
 CONCRETE BRIDGE RAILING TRANSITION

BILL OF MATERIALS			
These quantities are for one concrete bridge railing transition type TBT.			
EPOXY COATED REINFORCING STEEL			
Size and Mark	No. of Bars	Length (Ft.-in.)	Weight (Lbs.)
582a	21	5'-5"	
582b	16	5'-3"	
583	28	4'-0"	
584a	21	3'-9"	
584b	16	3'-7"	
585	16	2'-0"	
#5	9	15'-1"	
#5	1	8'-4"	
#5	2	6'-8"	
#5	14	6'-0"	
Total #5 Bars			1133
Total Epoxy Coated Steel			1133
Concrete Class C in Railing			2.0 yd <sup>3</sup>
Surface Seal			13.4 yd <sup>2</sup>


INDIANA DEPARTMENT OF TRANSPORTATION	
CONCRETE BRIDGE RAILING TRANSITION TYPE TBT	
SEPTEMBER 2011	
STANDARD DRAWING NO.	E 706-TTBT-03
	/s/ Richard L. VanCleave 09/01/11 DESIGN STANDARDS ENGINEER DATE
	/s/ Mark A. Miller 09/01/11 CHIEF HIGHWAY ENGINEER DATE
DESIGN STANDARDS ENGINEER	

REVISION TO STANDARD DRAWINGS


706-TTFT-01 CONCRETE BRIDGE RAILING TRANSITION TFT PLAN AND ELEVATION (DRAFT)

NOTES

1. See Standard Drawing E 706-TTFT-02 for sections.
2. See Standard Drawing E 706-TTFT-03 for reinforcing-bar diagrams and bill of materials.
- ③ Holes for attachment of guardrail transition type TGB. See Standard Drawing E 601-TTGB-01 for details.
- ④ RCBA extension for bridge railing transition type TFT. See Standard Drawing E 609-TBAE-02 for details.

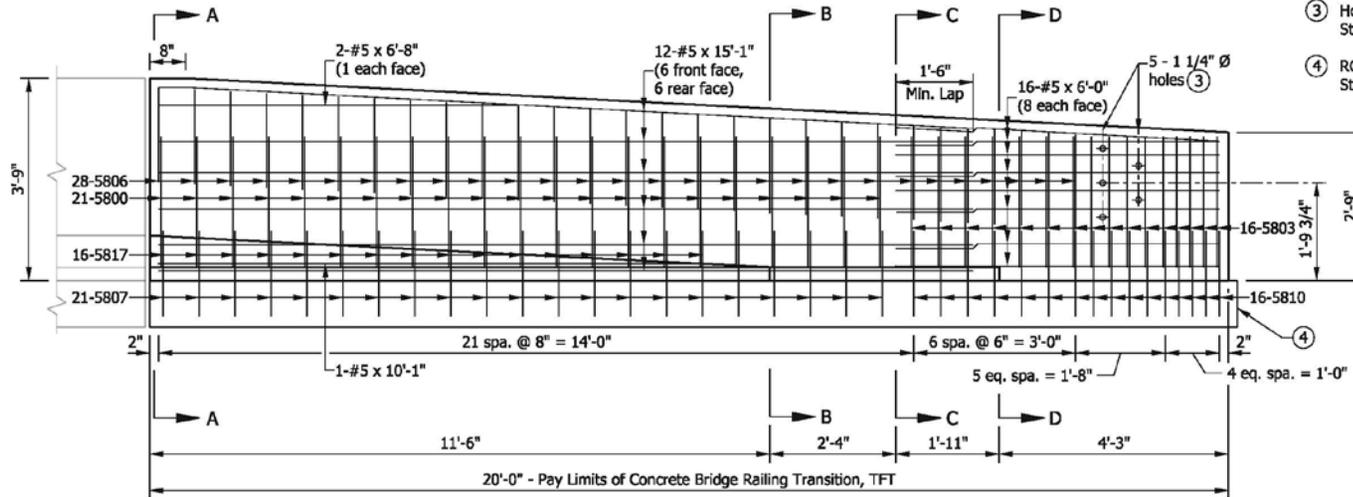

ELEVATION

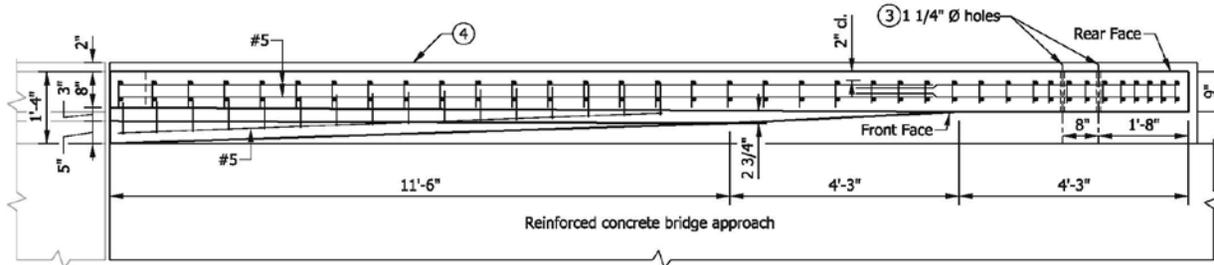


PLAN


INDIANA DEPARTMENT OF TRANSPORTATION	
CONCRETE BRIDGE RAILING TRANSITION TFT PLAN AND ELEVATION SEPTEMBER 2012	
STANDARD DRAWING NO. E 706-TTFT-01	
DESIGN STANDARDS ENGINEER	DATE
CHIEF HIGHWAY ENGINEER	DATE
DESIGN STANDARDS ENGINEER	

REVISION TO STANDARD DRAWINGS


706-TTFT-02 CONCRETE BRIDGE RAILING TRANSITION, TFT (DRAFT)

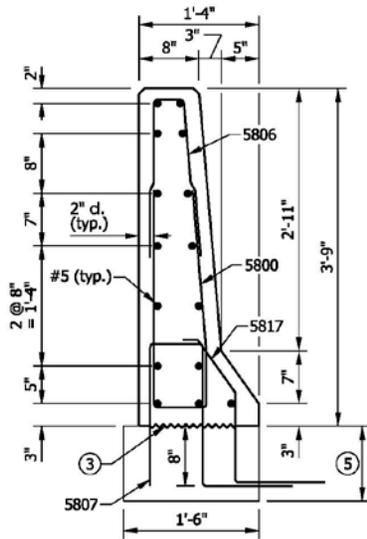


SECTION A-A

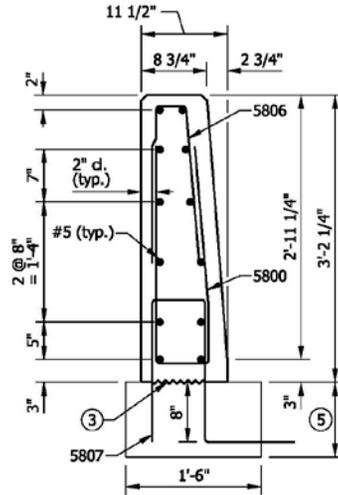

SECTION B-B

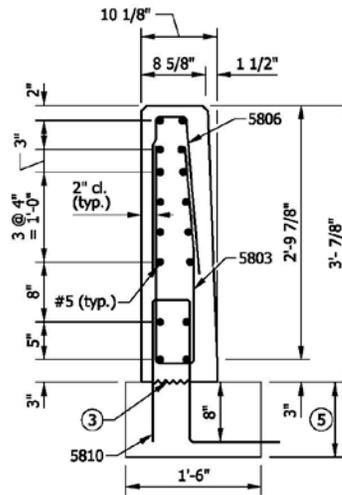

SECTION C-C

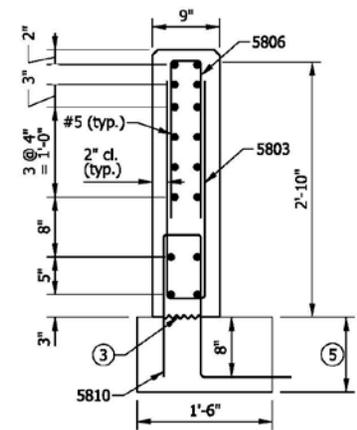

SECTION D-D

NOTES

1. See Standard Drawing E 706-TTFT-01 for elevation and plan.
2. All chamfered edges shall be 3/4".
- ③ Construction joint type A. See Standard Drawing E 702-CJTA-01 for details.
4. See Standard Drawing E 706-TTFT-03 for reinforcing-bar diagrams.
- ⑤ RCBA extension for bridge railing transition type TFT. See Standard Drawing E 609-TBAE-02 for details.







INDIANA DEPARTMENT OF TRANSPORTATION	
CONCRETE BRIDGE RAILING TRANSITION, TFT	
SEPTEMBER 2012	
STANDARD DRAWING NO. E 706-TTFT-02	
DESIGN STANDARDS ENGINEER	DATE
DESIGN STANDARDS ENGINEER	DATE

REVISION TO STANDARD DRAWINGS

706-TTFT-03 CONCRETE BRIDGE RAILING TRANSITION TYPE TFT (DRAFT)

**NOTE**

1. See Standard Drawing E 703-BRST-01 for reinforcing-bar bending details and notes.

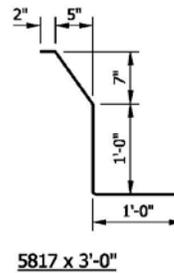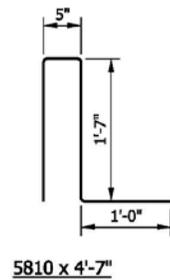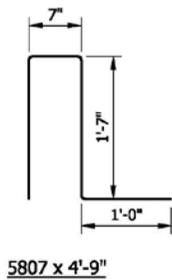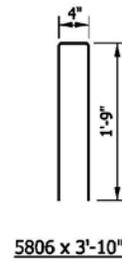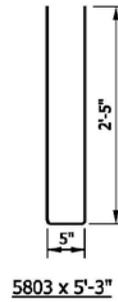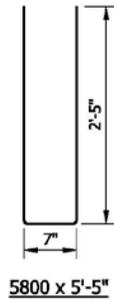


BILL OF MATERIALS		
Quantities are for one concrete bridge railing transition type TFT		
EPOXY-COATED REINFORCING STEEL		
MARK / SIZE	NO. OF BARS	WEIGHT
5800	21	
5803	16	
5806	28	
5807	21	
5810	16	
5817	16	
#5 x 15'-1"	12	
#5 x 10'-1"	1	
#5 x 6'-8"	2	
#5 x 6'-0"	16	
TOTAL EPOXY-COATED REINFORCING STEEL		862 LBS
MISCELLANEOUS		
CONCRETE, CLASS C		2.0 CYS
SURFACE SEAL		13.4 SYS

INDIANA DEPARTMENT OF TRANSPORTATION	
CONCRETE BRIDGE RAILING TRANSITION TYPE TFT  SEPTEMBER 2012	
STANDARD DRAWING NO. E 706-TTFT-03	
	_____ DESIGN STANDARDS ENGINEER      DATE
	_____ CHIEF HIGHWAY ENGINEER      DATE
DESIGN STANDARDS ENGINEER	


REVISION TO STANDARD DRAWINGS

EXISTING 706-TTXX-01 CONCRETE BRIDGE RAILING TRANSITION, TTX (WITH MARKUPS)

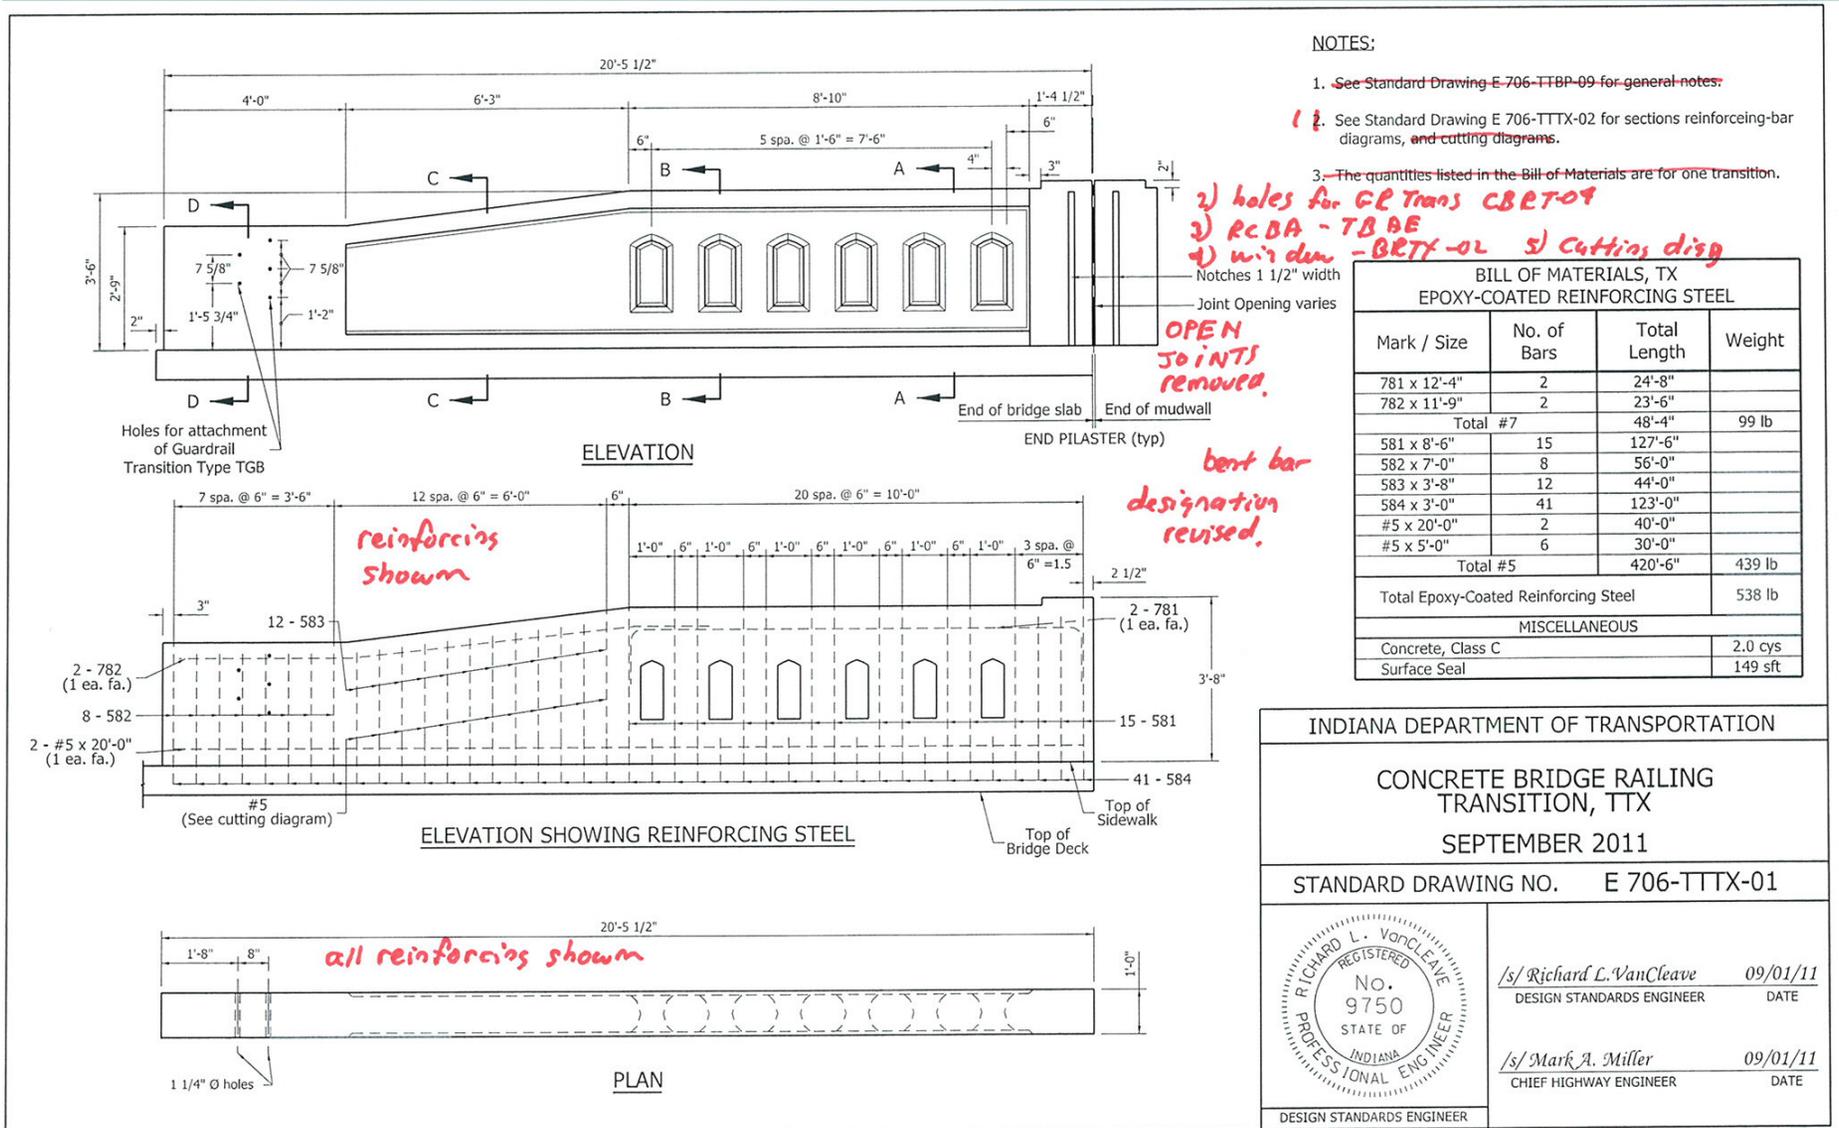


REVISION TO STANDARD DRAWINGS

EXISTING 706-TTXX-02 CONCRETE BRIDGE RAILING TRANSITION, TTX (WITH MARKUPS)

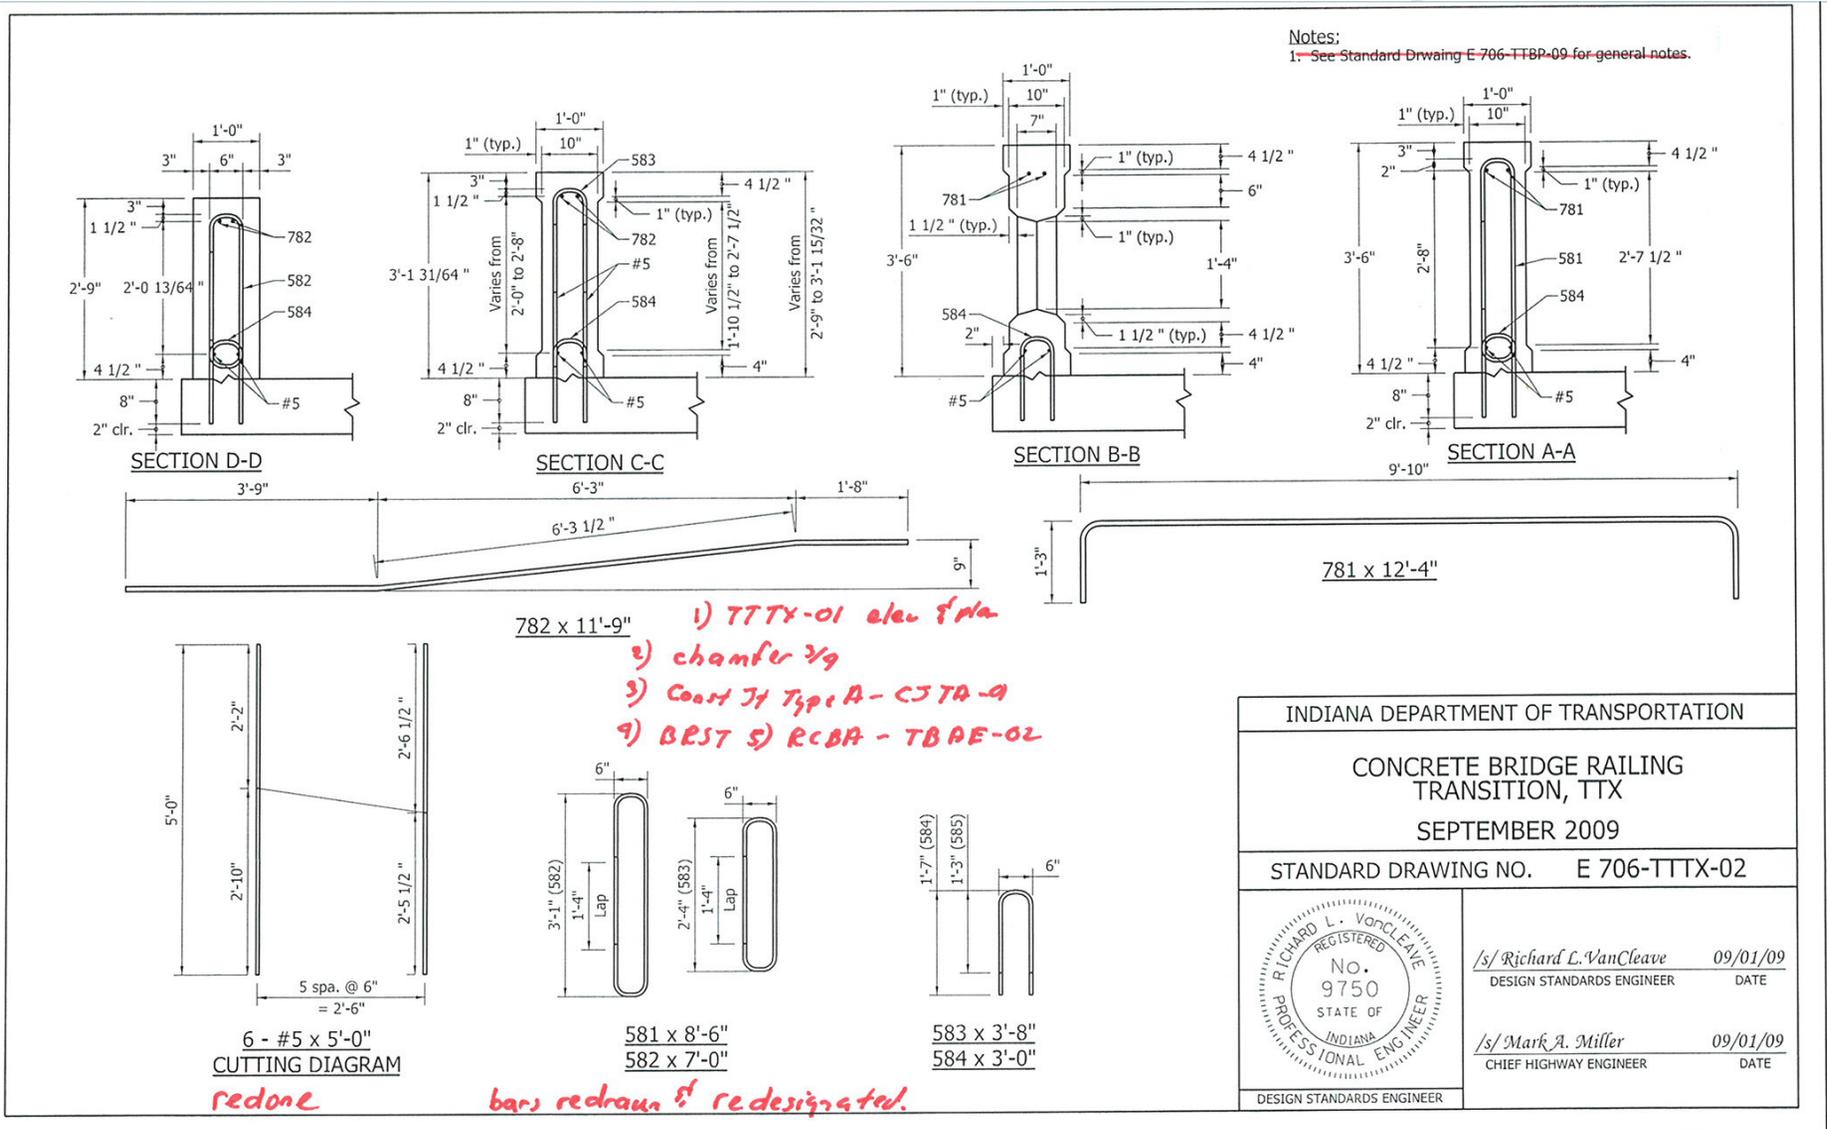

REVISION TO STANDARD DRAWINGS

706-TTXX-01 CONCRETE BRIDGE RAILING TRANSITION, TTX (DRAFT)

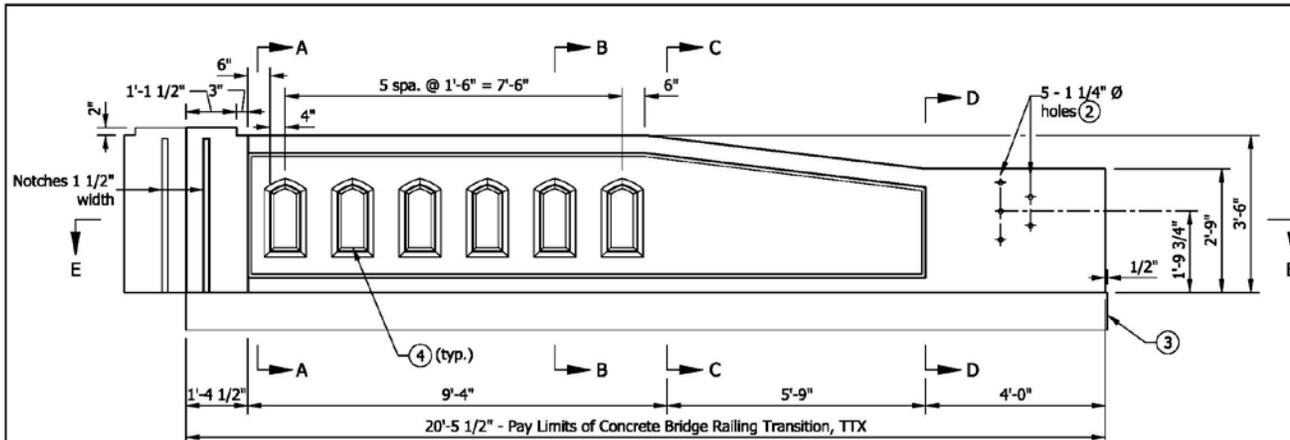


END BENT  
 PILASTER (typ.)

ELEVATION


NOTES

1. See Standard Drawing E 706-TTXX-02 for sections and reinforcing-bar diagrams.
- ② Holes for attachment of guardrail transition type TGB. See Standard Drawing E 706-CBRT-04 for details.
- ③ RCBA extension for bridge railing transition type TTX. See Standard Drawing E 609-TBAE-02 for details.
- ④ Window opening. See Standard Drawing E 706-BRTX-02 for details.
- ⑤ See Standard Drawing E 706-TTXX-02 for reinforcing-bar cutting diagram.

BILL OF MATERIALS		
Quantities are for one concrete bridge railing transition type TTX		
EPOXY-COATED REINFORCING STEEL		
MARK / SIZE	NO. OF BARS	WEIGHT
7800	2	
7801	2	
Total #7		98 LBS
5805	12	
5812	15	
5813	8	
5811	41	
#5 x 20'-0"	2	
#5 x 5'-8"	12	
Total #5		538 LBS
TOTAL EPOXY-COATED REINFORCING STEEL		636 LBS
MISCELLANEOUS		
CONCRETE, CLASS C		2.0 CYS
SURFACE SEAL		149 SFT

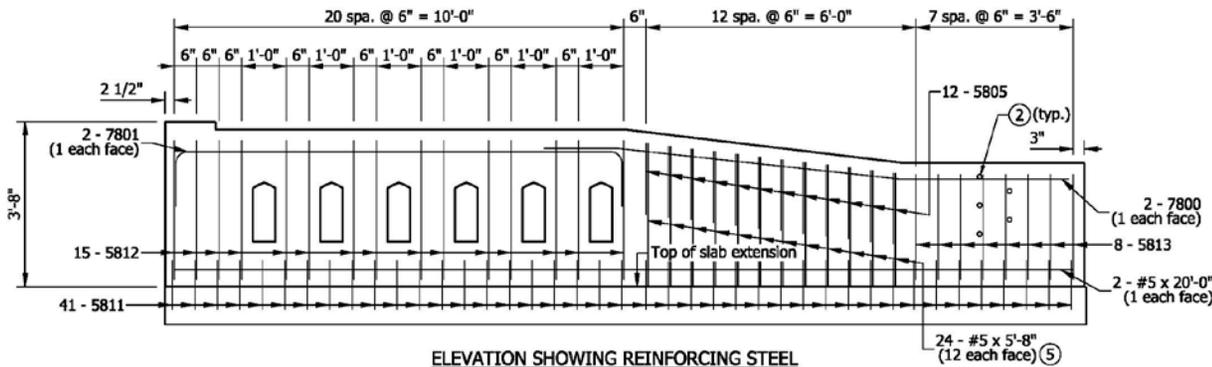

ELEVATION SHOWING REINFORCING STEEL

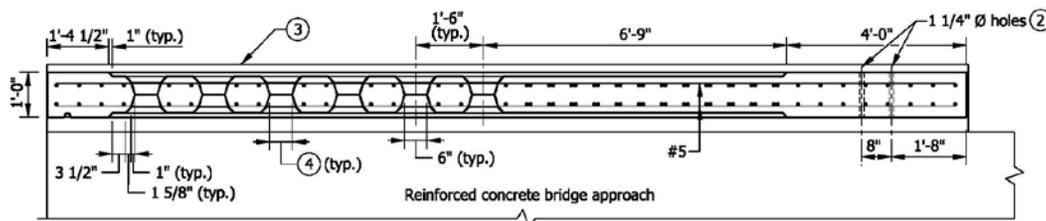


SECTION E-E

INDIANA DEPARTMENT OF TRANSPORTATION	
CONCRETE BRIDGE RAILING TRANSITION, TTX	
SEPTEMBER 2012	
STANDARD DRAWING NO.	E 706-TTXX-01
DESIGN STANDARDS ENGINEER	DATE
CHIEF HIGHWAY ENGINEER	DATE
DESIGN STANDARDS ENGINEER	




REVISION TO STANDARD DRAWINGS

706-TTXX-02 CONCRETE BRIDGE RAILING TRANSITION, TTX (DRAFT)

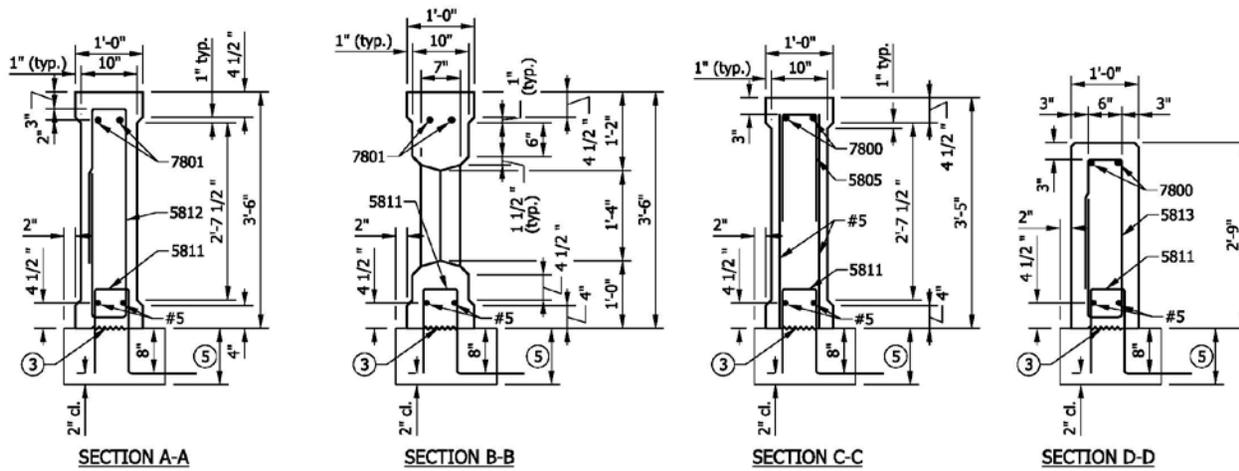


NOTES


1. See Standard Drawing E 706-TTXX-01 for elevations and plan.
2. All chamfered edges shall be 3/4".
3. Construction joint type A. See Standard Drawing E 702-CJTA-01 for details.
4. See Standard Drawing E 703-BRST-01 for reinforcing-bar bending details and notes.
5. RCBA extension for bridge railing transition type TTX. See Standard Drawing E 609-TBAE-02 for details.

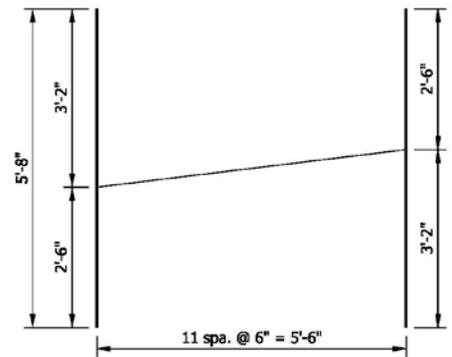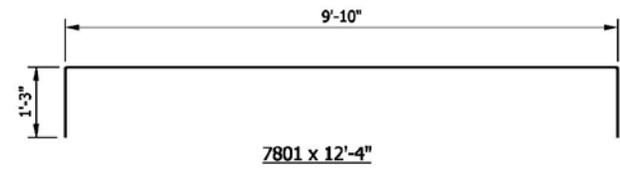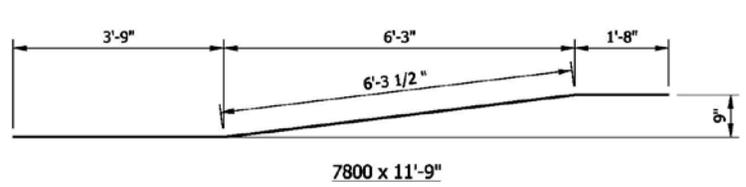


12 - #5 x 5'-8"  
CUTTING DIAGRAM

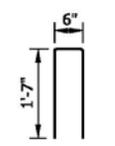


5805 x 4'-8"

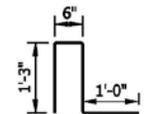

5811 x 4'-0"

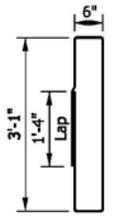

5812 x 8'-6"

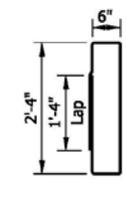

5813 x 7'-0"

INDIANA DEPARTMENT OF TRANSPORTATION	
CONCRETE BRIDGE RAILING TRANSITION, TTX	
SEPTEMBER 2012	
STANDARD DRAWING NO. E 706-TTXX-02	
DESIGN STANDARDS ENGINEER	DATE
CHIEF HIGHWAY ENGINEER	DATE
DESIGN STANDARDS ENGINEER	

REVISION TO STANDARD DRAWINGS

EXISTING 706-TWBC-01 CONCRETE BRIDGE RAILING TRANSITION TYPE WBC (WITH MARKUPS)

NOTES:


- ① See Standard Drawing E 706-CBRT-02 for details of guardrail transition type WGB attachment.
2. See Standard Drawing E 706-TWBC-02 for Section A-A, B-B, C-C and D-D and Drawing E 706-TWBC-03 for reinforcement and bill of materials.
3. See Standard Drawing E 706-TASE-05 for General Notes.

LEGEND:


F.F. = Front Face  
 R.F. = Rear Face

*2 & 3 combined  
 Ext incls added.*

- 1) TWFC-02 for sections*
- 2) TWFC-03 reinforcing diag*
- 3) holes GR Trans CBRT-02*
- 4) RCBA-TBAE-03*

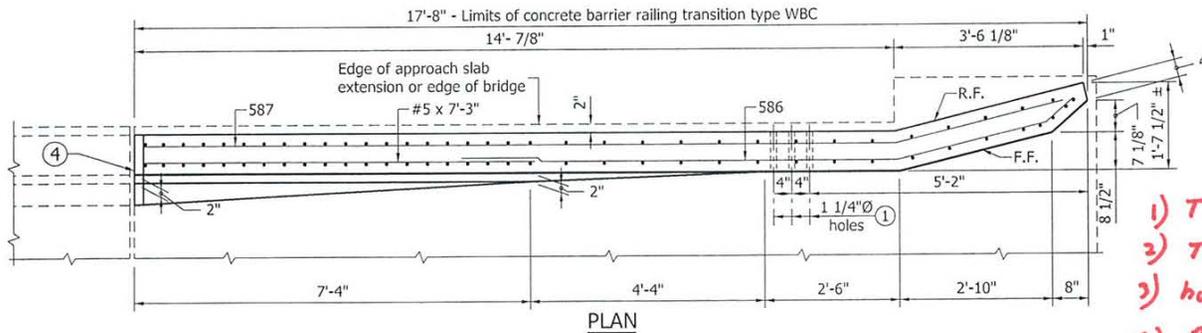

*Sections revised.  
 reinfurcis, show*

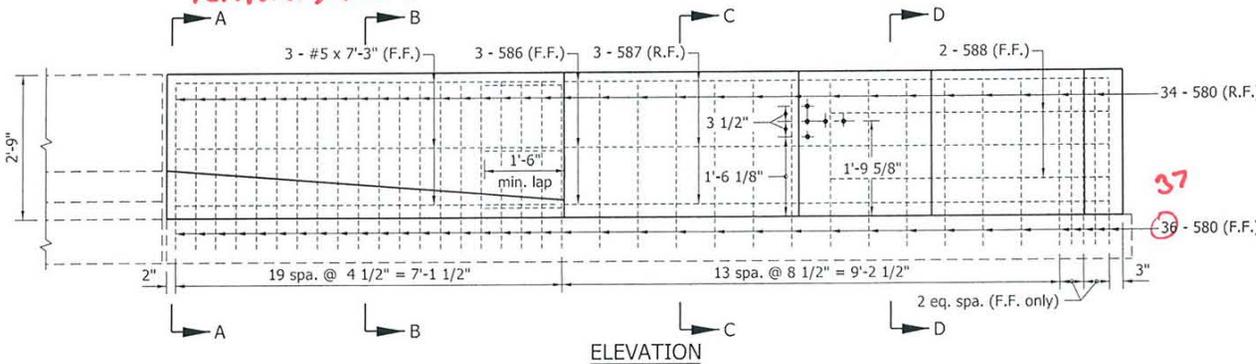


2'-9" COMMON HEIGHT W-BEAM/  
 CONCRETE BRIDGE RAILING TRANSITION


INDIANA DEPARTMENT OF TRANSPORTATION	
CONCRETE BRIDGE RAILING TRANSITION TYPE WBC	
SEPTEMBER 2011	
STANDARD DRAWING NO. E 706-TWBC-01	
	/s/ Richard L. VanCleave 09/01/11 DESIGN STANDARDS ENGINEER DATE
	/s/ Mark A. Miller 09/01/11 CHIEF HIGHWAY ENGINEER DATE
	DESIGN STANDARDS ENGINEER

REVISION TO STANDARD DRAWINGS


EXISTING 706-TWBC-02 CONCRETE BRIDGE RAILING TRANSITION TYPE WBC (WITH MARKUPS)

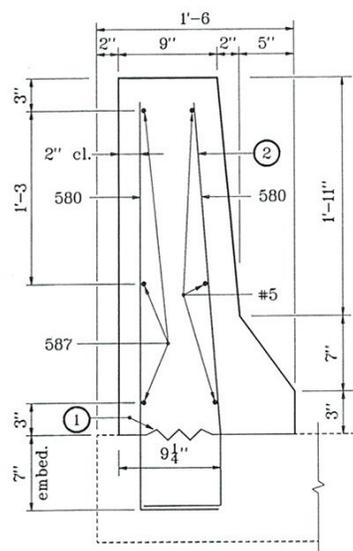


SECTION A-A

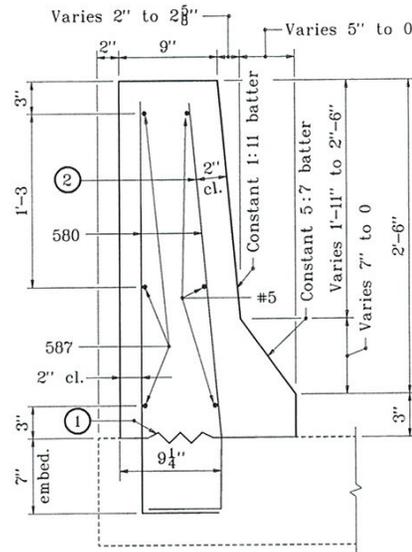

SECTION B-B

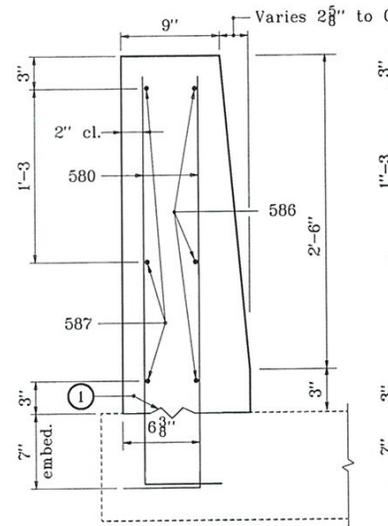

SECTION C-C

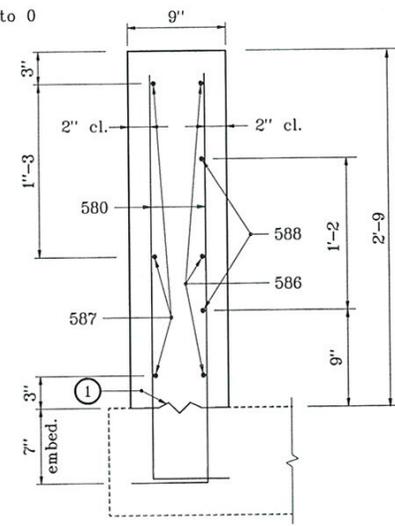

SECTION D-D

NOTES :

- ① Type A construction joint.
- ② These bars shall be field bent to provide 2" clearance along the batter (constant 1:11), front face bridge rail.
- ③ See Standard Drawing E 706-TWBC-01 for Plan and Elevation.


*2) Chamfer 3/4 3) Const JNT - CJTA 4) TWFC-03 for bar diag  
 5) RCBA-TBAE-03 6) Bar bendings for clearance 7), 8) batter call outs*

INDIANA DEPARTMENT OF TRANSPORTATION	
CONCRETE BRIDGE RAILING	
TRANSITION TYPE <del>WBC</del> <b>WFC</b>	
SEPTEMBER 2001	
STANDARD DRAWING NO. E 706-TWBC-02	
	/s/ Anthony L. Uremovich 9-04-01 DESIGN STANDARDS ENGINEER DATE
	/s/ Firooz Zandi 9-04-01 CHIEF HIGHWAY ENGINEER DATE

Item No.02 03/15/12 (2012 SS)(contd.)  
 Mr. Strain  
 Date: 03/15/12

REVISION TO STANDARD DRAWINGS

EXISTING 706-TWBC-03 CONCRETE BRIDGE RAILING TRANSITION TYPE WBC (WITH MARKUPS)

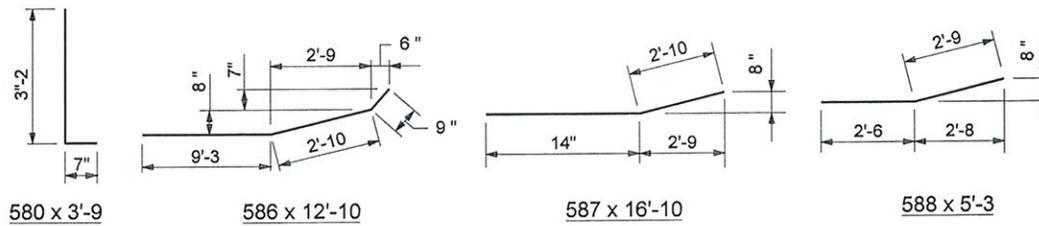

*reinforcings drawn to scale  
 bent bars redesignated.*

*B:11  
 revised*

BILL OF MATERIALS			
These quantities are for one concrete bridge railing transition type WBC. The concrete quantity is provided for information only and is not the pay item.			
EPOXY COATED REINFORCING STEEL			
Size & type	No. of Bars	Length ft-in	Weight lb
580	68	3'-9	
586	3	12'-10	
587	3	16'-10	
588	2	5'-3	
#5	3	7'-3	
Total Epoxy Coated Steel			393
MISCELLANEOUS			
Concrete, Class C (yd <sup>3</sup> )		1.6	
Surface Seal (ft <sup>2</sup> )		113	

INDIANA DEPARTMENT OF TRANSPORTATION

CONCRETE BRIDGE RAILING  
 TRANSITION TYPE WBC  
 MARCH 2006 **TWBC**


STANDARD DRAWING NO. E 706-TWBC-03

	/s/ Richard L. VanCleave	3-01-06
	DESIGN STANDARDS ENGINEER	DATE
	/s/ Richard K. Smutzer	3-01-06
DESIGN STANDARDS ENGINEER	CHIEF HIGHWAY ENGINEER	DATE

Item No.02 03/15/12 (2012 SS)(contd.)  
Mr. Strain  
Date: 03/15/12

REVISION TO STANDARD DRAWINGS

EXISTING 706-TWBC-04 CONCRETE BRIDGE RAILING TRANSITION TYPE WGB (PROPOSED TO DELETE)

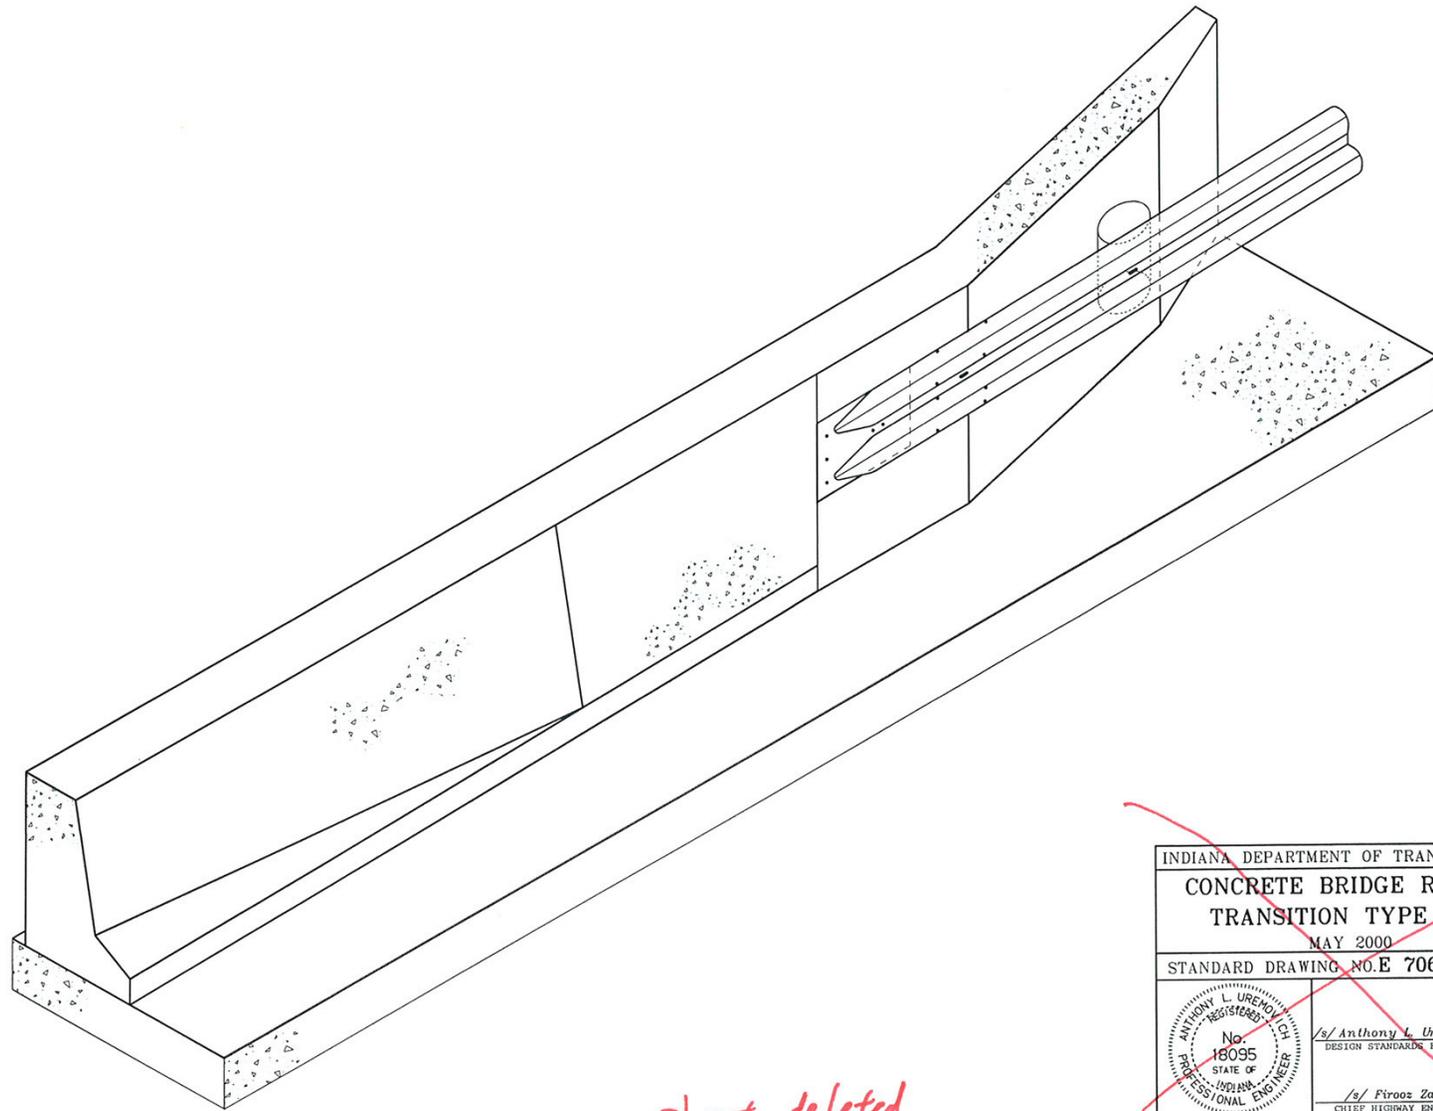


*Sheet deleted.*


INDIANA DEPARTMENT OF TRANSPORTATION	
CONCRETE BRIDGE RAILING TRANSITION TYPE WGB	
MAY 2000	
STANDARD DRAWING NO. E 706-TWBC-04	
	/s/ Anthony L. Uremovich 5-01-00 DESIGN STANDARDS ENGINEER DATE
	/s/ Firooz Zandi 5-01-00 CHIEF HIGHWAY ENGINEER DATE
DESIGN STANDARDS ENGINEER	

REVISION TO STANDARD DRAWINGS

706-TWFC-01 CONCRETE BRIDGE RAILING TRANSITION TYPE WFC (DRAFT)

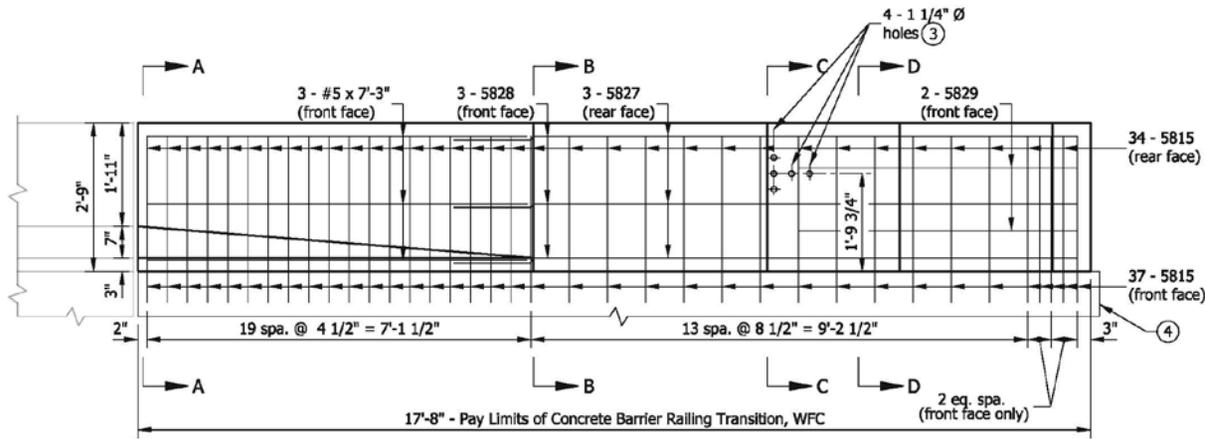

ELEVATION

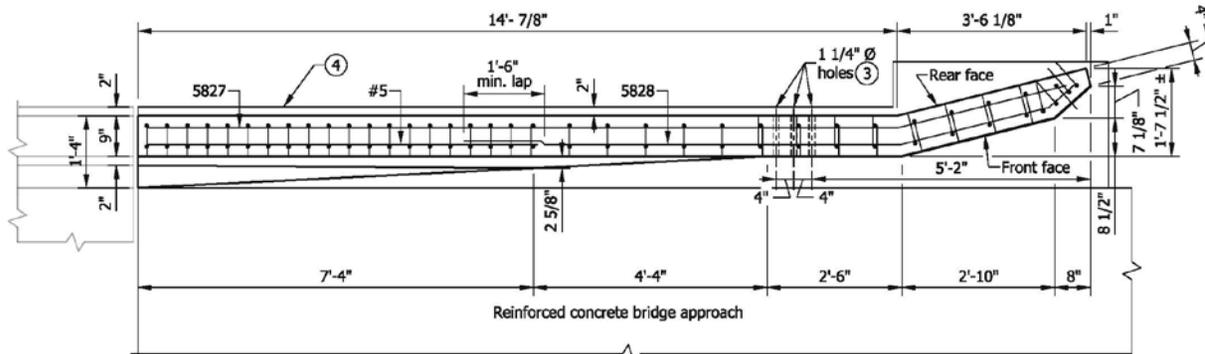

PLAN


NOTES

1. See Standard Drawing E 706-TWFC-02 for sections.
2. See Standard Drawing E 706-TWFC-03 for reinforcing-bar diagrams and bill of materials.
- ③ Holes for attachment of guardrail transition type WGB. See Standard Drawing E 706-CBRT-02 for details.
- ④ RCBA extension for bridge railing transition type WFC. See Standard Drawing E 609-TBAE-03 for details.


INDIANA DEPARTMENT OF TRANSPORTATION	
CONCRETE BRIDGE RAILING TRANSITION TYPE WFC	
SEPTEMBER 2012	
STANDARD DRAWING NO. E 706-TWFC-01	
DESIGN STANDARDS ENGINEER	DATE
DESIGN STANDARDS ENGINEER	DATE

REVISION TO STANDARD DRAWINGS


706-TWFC-02 CONCRETE BRIDGE RAILING TRANSITION TYPE WFC (DRAFT)

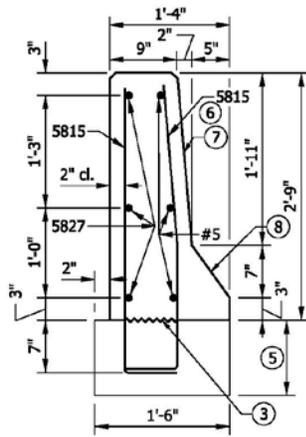


SECTION A-A

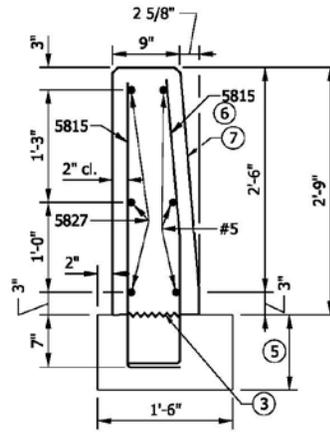

SECTION B-B

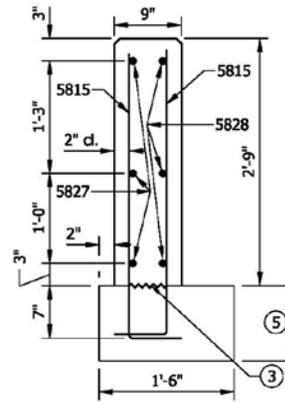

SECTION C-C

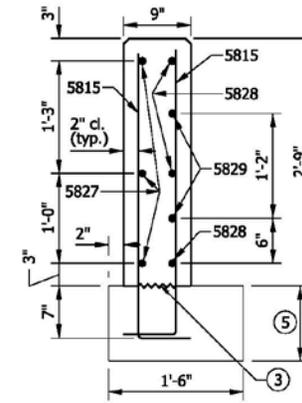

SECTION D-D


**NOTES**

1. See Standard Drawing E 706-TWFC-01 for elevation and plan.
2. All chamfered edges shall be 3/4".
- 3 Construction joint type A. See Standard Drawing E 702-CJTA-01 for details.
4. See Standard Drawing E 706-TWFC-03 for reinforcing-bar diagrams.
- 5 RCBA extension for bridge railing transition type WFC. See Standard Drawing E 609-TBAE-03 for details.
- 6 These bars shall be field bent to provide 2" clearance along the front face batter.
- 7 Constant 1:11 batter.
- 8 Constant 5:7 batter.

<b>INDIANA DEPARTMENT OF TRANSPORTATION</b>	
<b>CONCRETE BRIDGE RAILING TRANSITION TYPE WFC</b>	
<b>SEPTEMBER 2012</b>	
<b>STANDARD DRAWING NO. E 706-TWFC-02</b>	
DESIGN STANDARDS ENGINEER	DATE
DESIGN STANDARDS ENGINEER	DATE

REVISION TO STANDARD DRAWINGS

706-TWFC-03 CONCRETE BRIDGE RAILING TRANSITION TYPE WFC (DRAFT)

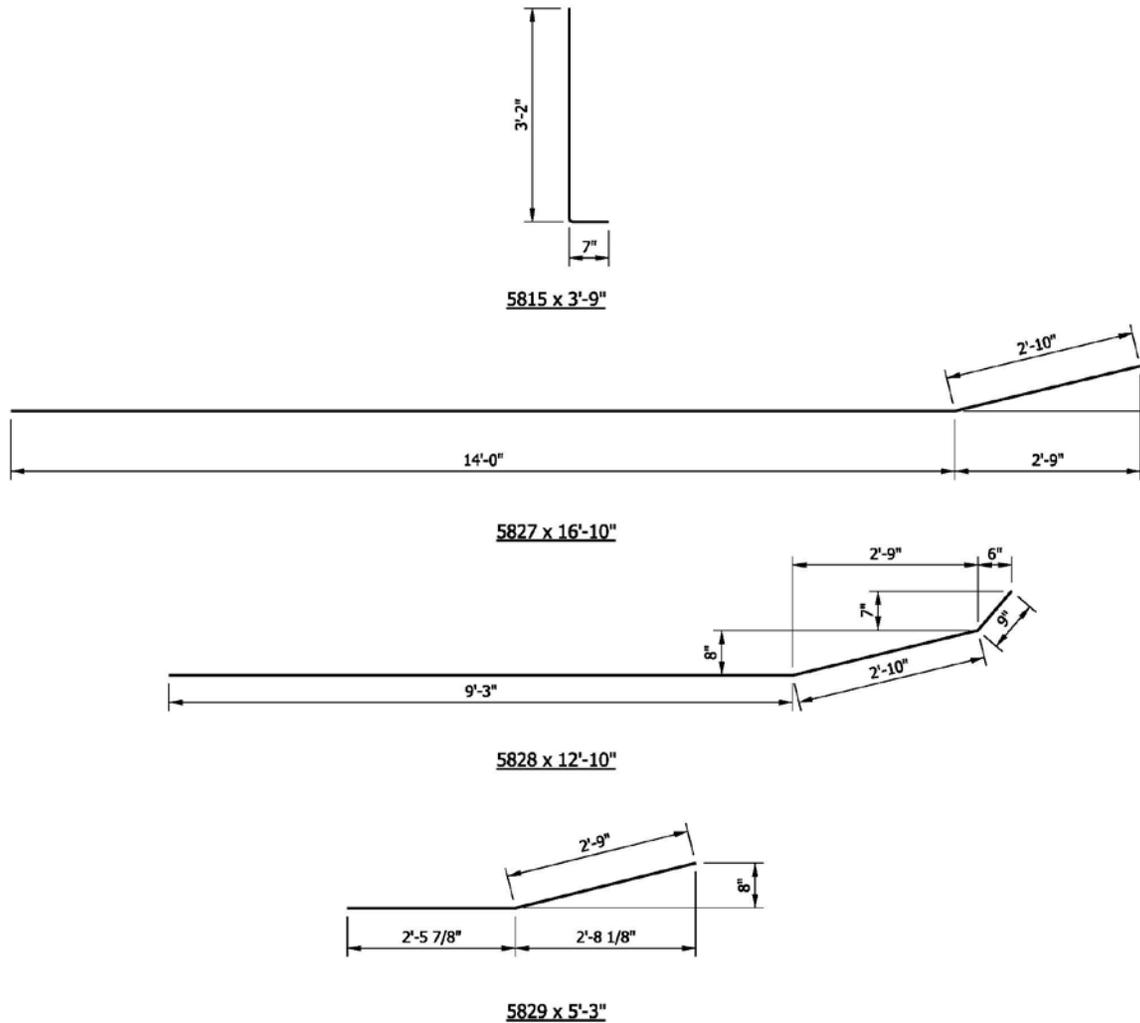

**NOTE**

1. See Standard Drawing E 703-BRST-01 for reinforcing-bar bending details and notes.

BILL OF MATERIALS		
Quantities are for one concrete bridge railing transition type WFC		
EPOXY-COATED REINFORCING STEEL		
MARK / SIZE	NO. OF BARS	WEIGHT
5815	71	
5827	3	
5828	3	
5829	2	
#5 x 7'-3"	3	
TOTAL EPOXY-COATED REINFORCING STEEL		404 LBS
MISCELLANEOUS		
CONCRETE, CLASS C		1.6 CYS
SURFACE SEAL		113 SYS

INDIANA DEPARTMENT OF TRANSPORTATION	
CONCRETE BRIDGE RAILING TRANSITION TYPE WFC	
SEPTEMBER 2012	
STANDARD DRAWING NO.	E 706-TWFC-03
DESIGN STANDARDS ENGINEER	DATE
CHIEF HIGHWAY ENGINEER	DATE
DESIGN STANDARDS ENGINEER	

THIS PAGE LEFT INTENTIONALLY BLANK

FIRST DRAFT MINUTES ITEM 02

REVISION TO STANDARD DRAWINGS

706-CBRT-01 - 04; 706-TPBT-01 - 09; 706-TTBC-01 - 03;  
 706-TTBP-01 - 09; 706-TTBT-01 - 02; 706-TTTX-01 - 02; 706-TWBC-01 - 04

DISCUSSION: This item was introduced and presented by Mr. Strain who stated that these are primarily clean up items. Standard drawing 706-TWBC-04 was deleted since it no longer serves a useful purpose. The other drawings shown are revised to be consistent with the Standards and for clarification. Mr. Strain further explained some of the revisions that were made and the reasoning behind those revisions.

The final drafts of the drawings are shown in these minutes.

Motion: Second: Ayes: Nays:	Action: <input checked="" type="checkbox"/> Passed as Submitted <input type="checkbox"/> Passed as Revised <input type="checkbox"/> Withdrawn
Standard Specifications Sections affected:  <p style="text-align: center;">NONE</p>	<input type="checkbox"/> 20 Standard Specifications Book <input type="checkbox"/> Revise Pay Items List
Recurring Special Provision affected:  <p style="text-align: center;">NONE</p>	<input type="checkbox"/> Create RSP (No.____) Effective ____ Letting RSP Sunset Date: ____
Standard Sheets affected:  706-CBRT-01 - 04 706-TPBT-01 - 09 706-TTBC-01 - 03 706-TTBP-01 - 09 706-TTBT-01 - 02 706-TTTX-01 - 02 706-TWBC-01 - 04	<input type="checkbox"/> Revise RSP (No.____) Effective ____ Letting RSP Sunset Date: ____  Standard Drawing Effective <b>Sept. 01, 2012</b> <input type="checkbox"/> Create RPD (No. ____) Effective ____ Letting <input type="checkbox"/> Technical Advisory
Design Manual Sections affected:  <p style="text-align: center;">NONE</p>	GIFE Update Req'd.? Y __ N __ By ____ Addition or ____ Revision
GIFE Sections cross-references:  <p style="text-align: center;">NONE</p>	Frequency Manual Update Req'd? Y __ N __ By ____ Addition or ____ Revision  Received FHWA Approval? <b>YES</b>