



## INDIANA DEPARTMENT OF TRANSPORTATION

100 North Senate Avenue  
Room N925 CM  
Indianapolis, Indiana 46204

PHONE: (317) 232-5502  
FAX: (317) 232-5551

**Eric Holcomb, Governor**  
**Joe McGuinness, Commissioner**

# APPROVED MINUTES

April 19, 2018 Standards Committee Meeting

June 28, 2018

TO: Standards Committee

FROM: Scott Trammell, Secretary

RE: Minutes from the April 19, 2018 Standards Committee Meeting

The Standards Committee meeting was called to order at 09:03 a.m. on April 19, 2018 in the N955 Bay Window Conference Room. The meeting was adjourned at 10:48 a.m.

The following committee members were in attendance:

John Leckie, Chairman, Construction and Materials Management  
Michael Beuchel, Contract Administration Division  
Dave Boruff, Traffic Engineering Division  
Mark Orton, Bridges Division  
Greg Pankow, Construction Management Division  
Kumar Dave, Pavement Engineering, Highway Design  
Matthew Beeson, Office of Materials Management  
Michael Koch, District Construction, Fort Wayne District  
Rob Goldner, Construction Technical Support

Also in attendance were the following:

Gerry Montgomery, INDOT  
Lynn Butcher, INDOT  
Michael Jorns, INDOT  
Michael Nelson, INDOT  
Steve Fisher, INDOT  
Tom Duncan, FHWA  
Traci Powell, TMC/INDOT  
Steve Duncan, INDOT

Mischa Kachler, INDOT  
Lana Podorvanova, INDOT  
Dan Osborn, ICI  
Tom Harris, INDOT  
Derrick Hauser, INDOT  
Scott Trammell, INDOT  
Joe Bruno, INDOT

The following items were listed for consideration:

### A. GENERAL BUSINESS ITEMS

#### OLD BUSINESS

(No items were listed)

NEW BUSINESS1. *Approval of the Minutes from the March 15, 2018 meeting*

DISCUSSION: Mr. Leckie requested a motion to approve the minutes from the March 15, 2018 meeting.

Motion: Mr. Pankow  
 Second: Mr. Koch  
 Ayes: 8  
 Nays: 0

ACTION: PASSED AS SUBMITTED

B. CONCEPTUAL PROPOSAL ITEMSOLD BUSINESS

(No items were listed)

NEW BUSINESS

(No items were listed)

C. STANDARD SPECIFICATIONS, SPECIAL PROVISIONS AND STANDARD DRAWINGS PROPOSED ITEMSOLD BUSINESS

(No items were listed)

NEW BUSINESS

<u>Item No. 1 (2018 SS)</u>	Mr. Pankow	pg 6
Recurring Special Provision: 709-C-256	ALTERNATE CONCRETE SEALERS	

ACTION:	WITHDRAWN
---------	-----------

<u>Item No. 2 (2018 SS)</u>	Mr. Boruff	pg 10
Standard Drawings: (SEE PROPOSAL)		

E 801-TCCO-01	TEMPORARY CROSSOVERS <del>ADVANCED SIGNING DETAILS</del> INDEX AND GENERAL NOTES
E 801-TCCO-02	TEMPORARY CROSSOVERS <del>ENTRANCE DETAIL</del> ADVANCED SIGNING DETAILS
E 801-TCCO-03	TEMPORARY CROSSOVERS <del>EXIT</del> ENTRANCE DETAIL
E 801-TCCO-04	TEMPORARY CROSSOVERS EXIT DETAIL
E 801-TCCO-05	TEMPORARY SPLIT CROSSOVER TYPE B PAVING ENTRANCE DETAIL AND CLOSURE LAYOUT
E 801-TCCO-06	<del>CLOSURE OF TEMPORARY SPLIT CROSSOVER EXIT DETAIL</del>
E 801-TCCO-07	PAVING AND TEMPORARY CLOSURE LAYOUT

	TYPE B CROSSOVER TYPICAL SECTIONS
E 801-TCCO-08	TEMPORARY CROSSOVER TYPICAL SECTIONS
E 801-TCCO-09	PERMANENT CLOSURE OF A TEMPORARY CROSSOVER
E 801-TCCO-10	TUBULAR MARKER USE ON A NONFREEWAY CROSSOVER
E 801-TCFO-01	FLAGGER OPERATIONS FOR RURAL TWO LANE ROADS WITH SPEEDS $\geq$ 50 MPH
E 801-TCFO-02	MAINTENANCE OF TRAFFIC FOR MOVINGMOBILE OPERATION WITH FLAGGERS
E 801-TCFO-03	MAINTENANCE OF TRAFFIC FOR REFLECTOR REPLACEMENTFLAGGER OPERATIONS FOR RURAL TWO LANE ROADS WITH SPEEDS $\leq$ 45 MPH.
E 801-TCFO-04	TRAFFIC CONTROL FOR OVERHEAD SIGN INSTALLATION
E 801-TCFO-05	TRAFFIC CONTROL FOR OVERHEAD INSTALLATION
E 801-TCFO-06	TRAFFIC CONTROL FOR INTERSECTION WORK
E 801-TCLC-01	LANE CLOSURES INTERSTATE APPLICATIONSINDEX SHEET AND GENERAL NOTES
E 801-TCLC-02	CONTINOUS LANE CLOSURES RIGHT LANE CLOSEDAPPLICATIONS ON DIVIDED HIGHWAYS
E 801-TCLC-03	CONTINUOUS LANE CLOSURES CENTER RIGHT LANE CLOSED
E 801-TCLC-04	CONTINUOUSCENTER LANE CLOSURES LEFT LANEON FREEWAYS CLOSED
E 801-TCLC-05	DAYLIGHTLEFT LANE CLOSURES RIGHT LANEON FREEWAYS CLOSED
E 801-TCLC-06	DAYLIGHTSHORT-TERM LANE CLOSURES LEFT OR CENTER LANE CLOSED
E 801-TCLC-07	TRAFFIC CONTROL FOR SHOULDER WORKSHORT-TERM LEFT OR CENTER LANE CLOSURE
E 801-TCLC-08	TRAFFIC CONTROL FOR LANE CLOSURE ON A THREE LANE ROAD
E 801-TCLC-09	TRAFFIC CONTROL FOR LANEFREEWAY OR EXPRESSWAY EXIT CLOSURE ON A THREE LANE ROAD
E 801-TCLC-10	TRAFFIC CONTROL FOR SHOULDER WORK RIGHT LANE CLOSURE NEAR INTERCHANGE (EXIT OPEN)
E 801-TCLC-11	TRAFFIC CONTROL FOR LANE CLOSURE NEAR ENTRANCE RAMP
E 801-TCLC-12	TRAFFIC CONTROL FOR SHOULDER WORK
E 801-TCLC-13	TRAFFIC CONTROL FOR OVERHEAD SIGN INSTALLATION
E 801-TCLC-14	TRAFFIC CONTROL FOR OVERHEAD SIGN INSTALLATION
E 801-TCLC-15	TRAFFIC CONTROL FOR OVERHEAD SIGN INSTALLATION
E 801-TCLC-16	TRAFFIC CONTROL FOR LANE CLOSURE
E 801-TCLC-17	TEMPORARY U TURN FOR CONTRACTOR'S VEHICLES

E 801-TCMO-01	TRAFFIC CONTROL FOR MOBILE OPERATIONS ON A DIVIDED HIGHWAY
E 801-TCMO-02	MAINTENANCE OF TRAFFIC FOR RPM REFLECTOR REPLACEMENT
E 801-TCMO-03	MAINTENANCE OF TRAFFIC FOR RPM REFLECTOR REPLACEMENT
E 801-TCSC-01	TRAFFIC CONTROL SHOULDER CLOSURE
E 801-TCSC-02	TRAFFIC CONTROL SHOULDER CLOSURE WITH LOCAL ACCESS
E 801-TCSC-03	TRAFFIC CONTROL SHOULDER CLOSURE WITH LOCAL ACCESS
E 801-TCSC-04	SHOULDER CLOSURE FOR ROADSIDE WORK
E 801-TCTC-01	TEMPORARY CLOSURES OF A DIVIDED HIGHWAY
E 801-TCTC-02	TEMPORARY CLOSURES FOR PROJECT FOLLOWING COMPLETION OF GRADING PROJECT
E 801-TCTC-03	TEMPORARY CLOSURES
E 801-TCTC-04	TEMPORARY CLOSURES
<del>E 801-TCTC-05</del>	<del>TRAFFIC CONTROL FOR DAYTIME LANE CLOSURE</del>
<del>E 801-TCTC-06</del>	<del>MAINTENANCE OF TRAFFIC CONTROL FOR RPM CASTING INSTALLATION CLOSURE</del>
<del>E 801-TCTC-07</del>	<del>MAINTENANCE OF TRAFFIC CONTROL FOR RPM CASTING REPLACEMENT</del>
E 801-TCTC-08	MAINTAINCE OF TRAFFIC CONTROL FOR RPM CASTING REPLACEMENT
E 801-TCTC-09	MAINTENANCE OF TRAFFIC FOR RPM REFLECTOR REPLACEMENT
E 801-TCTC-10	MAINTENANCE OF TRAFFIC FOR RPM REFLECTOR REPLACEMENT
E 801-TCTC-11	TUBULAR MARKER DELINEATION
E 801-TCTC-12	TUBULAR MARKER DELINEATION AT INTERSECTION
<del>E 801-TCTS-01</del>	<del>TEMPORARY SHOULDER FOR TRAFFIC MAINTENANCE</del>

ACTION:

WITHDRAWN

Item No. 3 (2018 SS)

Recurring Special Provision:

801-T-XXX

Mr. Boruff

pg 92

BLACK TEMPORARY TAPE

ACTION:

PASSED AS REVISED

Item No. 4 (2018 SS)

410.05

Mr. Beeson

pg 100

410.16

SMA Mix Design

410.20(c)

Density

BSG of the Density Core

ACTION:

PASSED AS SUBMITTED

Item No. 5 (2018 SS)

502.04(a)

Mr. Beeson

pg 104

Portland Cement Concrete

502.04(b)

High-Early Strength Concrete Section

702.05

Proportioning

( CONTINUED )

702.07  
702.12

Mixing  
Consistency

ACTION:

PASSED AS SUBMITTED

cc: Committee Members  
FHWA  
ICI

STANDARD SPECIFICATIONS, SPECIAL PROVISIONS AND STANDARD DRAWINGS  
REVISION TO SPECIAL PROVISIONS

PROPOSAL TO STANDARDS COMMITTEE

PROBLEM(S) ENCOUNTERED: No allowable reduction to the lump sum pay item price for surface sealing when an alternate concrete mix design is used as per RSP 709-R-256.

PROPOSED SOLUTION: Revise RSP 709-R-256 to permit a reduction in surface seal area when an alternate concrete mix design is used.

APPLICABLE STANDARD SPECIFICATIONS: 709

APPLICABLE STANDARD DRAWINGS: N/A

APPLICABLE DESIGN MANUAL SECTION: N/A

APPLICABLE SECTION OF GIFE: N/A

APPLICABLE RECURRING SPECIAL PROVISIONS: 709-R-256

PAY ITEMS AFFECTED: N/A

APPLICABLE SUB-COMMITTEE ENDORSEMENT: Reviewed by: Greg Pankow, Roland Fegan, Andrew Pangallo and Mike Nelson.

IMPACT ANALYSIS (attach report): Yes

Submitted By: Michael Prather

Title: Construction Area Engineer

Organization: Greenfield District

Phone Number: 317-607-3177

Date: 02/15/18

STANDARD SPECIFICATIONS, SPECIAL PROVISIONS AND STANDARD DRAWINGS  
REVISION TO SPECIAL PROVISIONS

IMPACT ANALYSIS REPORT CHECKLIST

*Explain the business case as to why this item should be presented to the Standards Committee for approval.  
Answer the following questions with Yes, No or N/A.*

Does this item appear in any other specification sections? No

Will approval of this item affect the Approved Materials List? No

Will this proposal improve:

Construction costs? Yes

Construction time? No

Customer satisfaction? Yes

Congestion/travel time? No

Ride quality? No

Will this proposal reduce operational costs or maintenance effort? Yes

Will this item improve safety:

For motorists? No

For construction workers? No

Will this proposal improve quality for:

Construction procedures/processes? Yes

Asset preservation? Yes

Design process? No

Will this change provide the contractor more flexibility? Yes

Will this proposal provide clarification for the Contractor and field personnel? Yes

Can this item improve/reduce the number of potential change orders? Yes

Is this proposal needed for compliance with:

Federal or State regulations? No

AASHTO or other design code? No

Is this item editorial? No

Provide any further information as to why this proposal should be placed on the Standards Committee meeting Agenda:

REVISION TO SPECIAL PROVISION  
709-C-256 ALTERNATE CONCRETE SEALERS

709-C-256 ALTERNATE TO CONCRETE SEALERS

The Standard Specifications are revised as follows:

SECTION 709, BEGIN LINE 123, DELETE AND INSERT AS FOLLOWS:

**(e) Alternate To Concrete Sealers**

In lieu of concrete surface sealing for concrete barrier wall, ~~and concrete bridge decks, reinforced concrete bridge approaches, pier and bent caps, bridge railing, and bridge railing transitions~~, an alternate concrete mix design may be used.

SECTION 709, BEGIN LINE 144, DELETE AND INSERT AS FOLLOWS:

**709.07 Method of Measurement**

~~Since payment will be made in a lump sum, only those measurements necessary to verify application rates will be made. Surface seal will be measured as necessary to verify the surface sealant application rate but will not be measured for payment unless the concrete surface requiring a surface seal used an alternate concrete mix design in accordance with 709.05(e). If an alternate concrete mix design in accordance with 709.05(e) was used, then the total surface seal area will be reduced as follows:~~

$$\text{Surface Seal, \%} = (A - B) / A * 100$$

where:

*A = total surface seal area for all concrete surfaces requiring a surface seal.*

*B = surface seal area for the concrete surface using an alternate concrete mix design*

**709.08 Basis of Payment**

*Surface seal will not be paid for when an alternate concrete mix design in accordance with 709.05(e) was used in the concrete surface requiring a surface seal.*

The accepted quantities of this work will be paid for ~~at~~ by multiplying the surface seal percentage by the contract lump sum price for surface seal.

~~If an alternate concrete mix design in accordance with 709.05(e) is used in lieu of concrete surface sealing or portions thereof, it will be paid for as surface seal.~~

## COMMENTS AND ACTION

## 709-C-256 ALTERNATE CONCRETE SEALERS

DISCUSSION:

This item was introduced and presented by Mr. Pankow who stated that there currently is no allowable reduction to the lump sum pay item price for surface sealing when an alternate concrete mix design is used in accordance with RSP 709-R-256. Mr. Pankow had intended to propose to revise RSP 709-R-256 as shown, but had second thoughts about this item and will welcome any comments or recommendations.

Mr. Koch suggested the language remain unchanged since the Contractor will most likely select the most cost efficient material. Mr. Pankow agreed, stating that we do not want our people to have to make measurement calculations. Mr. Pankow stated that he would like to withdraw this item.

Mr. Pankow addressed Mr. Beeson's concern in that only the material used will be paid for. Mr. Leckie asked about DBE participation if the seal would be applied by the DBE. Mr. Pankow stated that the Contractor should know those details concerning what they are going to do and who is going to do it prior to bid time.

Mr. Nelson said that the epoxy penetrating sealer will be struck from the upcoming revisions.

Motion: Mr. Pankow	Action:
Second: Mr.	
Ayes:	<input type="checkbox"/> Passed as Submitted
Nays:	<input type="checkbox"/> Passed as Revised
FHWA Approval:	<input checked="" type="checkbox"/> Withdrawn
Standard Specifications Sections referenced and/or affected:	<input type="checkbox"/> 2020 Standard Specifications <input type="checkbox"/> Revise Pay Items List
709 pg 587 and 588.	
Recurring Special Provision affected:	<input type="checkbox"/> Create RSP (No. _____) Effective _____ Letting RSP Sunset Date:
709-C-256 ALTERNATE CONCRETE SEALERS.	<input type="checkbox"/> Revise RSP (No. _____) Effective _____ Letting RSP Sunset Date:
Standard Drawing affected:	<input type="checkbox"/> Standard Drawing Effective
NONE	
Design Manual Sections affected:	<input type="checkbox"/> Create RPD (No. _____) Effective _____ Letting
NONE	
GIFE Sections cross-references:	<input type="checkbox"/> GIFE Update <input type="checkbox"/> SiteManager Update
NONE	

STANDARD SPECIFICATIONS, SPECIAL PROVISIONS AND STANDARD DRAWINGS  
REVISION TO STANDARD DRAWINGS

PROPOSAL TO STANDARDS COMMITTEE

PROBLEM(S) ENCOUNTERED: The standard drawing series for temporary crossovers (801-TCCO), flagger operations (801-TCFO), lane closures (801-TCLC), shoulder closures (801-TCSC), and temporary closures (801-TCTC) have not been updated since the 2011 edition of the Indiana MUTCD was issued. Some of the series contain unnecessary sheets, duplicate sheets, or sheets that should be moved to another series. The flagger operations series should also be split into two series due to significant differences between stationary work and mobile operations.

PROPOSED SOLUTION: Revise and update the standard drawing series on temporary crossovers (801-TCCO), flagger operations (801-TCFO), lane closures (801-TCLC), shoulder closures (801-TCSC), and temporary closures (801-TCTC). Delete the standard drawing for temporary shoulders (801-TCTS). Create a new series for mobile operations (801-TCMO).

APPLICABLE STANDARD SPECIFICATIONS: 801 (no changes proposed)

APPLICABLE STANDARD DRAWINGS: 6 series [801-TCCO, 801-TCFO, 801-TCLC, 801-TCSC, 801-TCTC, and 801-TCTS]

<u>Proposed New (3)</u>	<u>Proposed Deletions (13)</u>	<u>Proposed Moves (6)</u>
801-TCCO-05 Split Crossover Entrance	801-TCFO-04	801-TCLC-12 to 801-TCMO-01
801-TCCO-06 Split Crossover Exit	801-TCFO-05	801-TCTC-08 to 801-TCLC-11
801-TCFO-03 Flagger Operations ≤ 45 mph	801-TCFO-06 801-TCLC-07 801-TCLC-08 801-TCLC-10	801-TCTC-09 to 801-TCMO-02 801-TCTC-10 to 801-TCMO-03 801-TCTC-11 to 801-TCCO-10 801-TCTC-12 to 801-TCCO-10
	801-TCLC-11	

APPLICABLE DESIGN MANUAL SECTION: No

APPLICABLE SECTION OF GIFE: No

APPLICABLE RECURRING SPECIAL PROVISIONS: No

PAY ITEMS AFFECTED: No

APPLICABLE SUB-COMMITTEE ENDORSEMENT: Yes, traffic standards subcommittee

IMPACT ANALYSIS (attach report): Yes, attached.

Submitted By: Joe Bruno on behalf of Dave Boruff

Title: Traffic Administration Engineer

Organization: INDOT

Phone Number: (317) 234-7949

Date: 3/26/18

STANDARD SPECIFICATIONS, SPECIAL PROVISIONS AND STANDARD DRAWINGS  
REVISION TO STANDARD DRAWINGS

IMPACT ANALYSIS REPORT CHECKLIST

Explain the business case as to why this item should be presented to the Standards Committee for approval. Answer the following questions with Yes, No or N/A.

Does this item appear in any other specification sections? No

Will approval of this item affect the Approved Materials List? No

Will this proposal improve:

Construction costs? Yes

Construction time? Yes

Customer satisfaction? Yes

Congestion/travel time? No

Ride quality? No

Will this proposal reduce operational costs or maintenance effort? Yes

Will this item improve safety:

For motorists? Yes

For construction workers? Yes

Will this proposal improve quality for:

Construction procedures/processes? Yes

Asset preservation? Yes

Design process? No

Will this change provide the contractor more flexibility? Yes

Will this proposal provide clarification for the Contractor and field personnel? Yes

Can this item improve/reduce the number of potential change orders? Yes

Is this proposal needed for compliance with:

Federal or State regulations? No


AASHTO or other design code? No

Is this item editorial? No

Provide any further information as to why this proposal should be placed on the Standards Committee meeting Agenda: N/A

## REVISION TO STANDARD DRAWINGS


## E 801-TCCO-01 TEMPORARY CROSSOVERS ADVANCED SIGNING DETAILS (WITH MARKUPS)

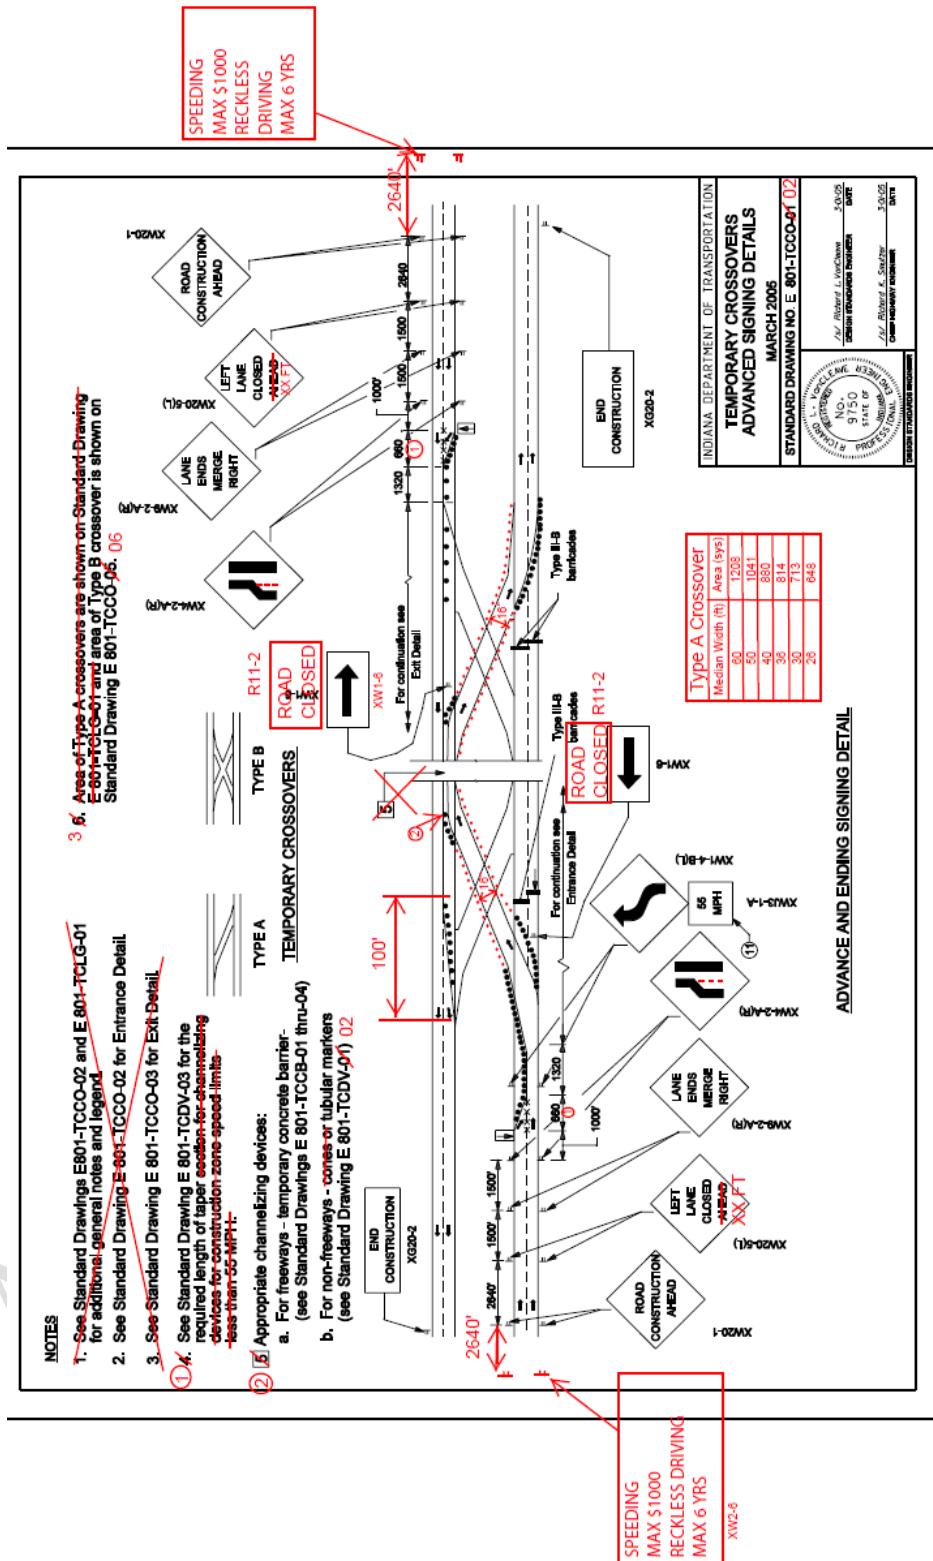

Add index sheet, entrance detail for split crossovers, exit detail for split crossovers, and move 801-TCTC-11 and -12 to this series.

## REVISION TO STANDARD DRAWINGS



E 801-TCCO-02 TEMPORARY CROSSOVERS ENTRANCE DETAIL (WITH MARKUPS)

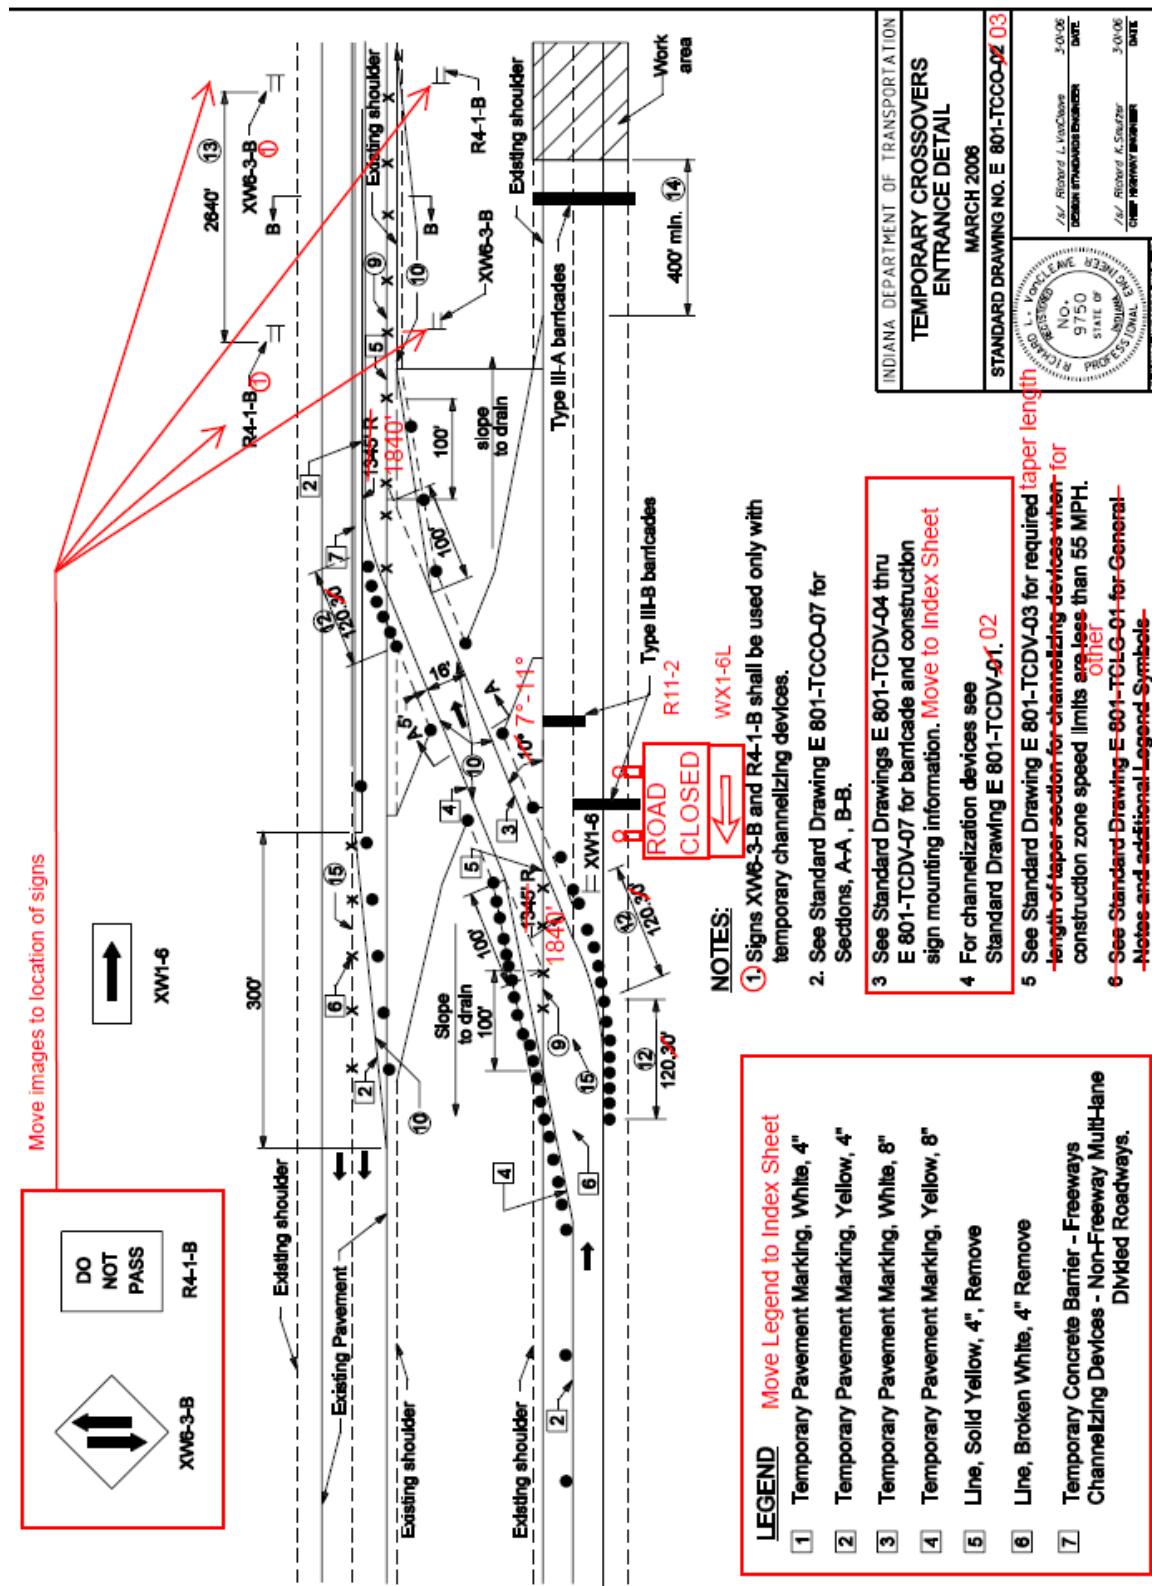

## REVISION TO STANDARD DRAWINGS

E 801-TCCO-03 TEMPORARY CROSSOVERS EXIT DETAIL (WITH MARKUPS)

Move images to sign locations

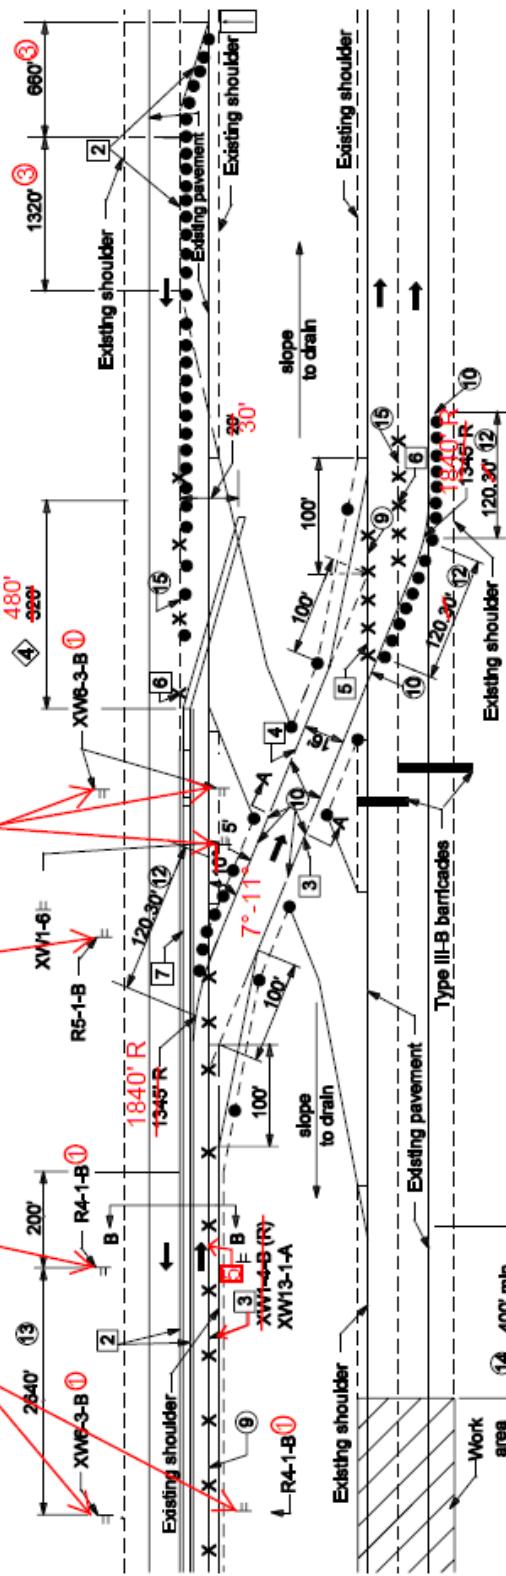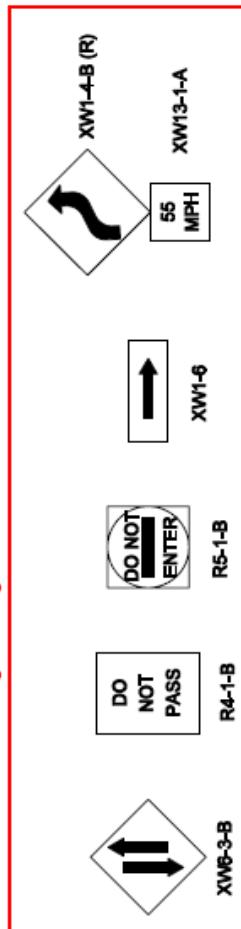

## NOTES

1. Signs XWB-3-B and R4-1-B shall be used only with temporary channelizing devices.

2. See Standard Drawing E 801-TCCO-07 for Sections, A-A, B-B, taper length

3. See Standard Drawing E 801-TCDV-03 for required ~~taper length~~ of taper section for ~~channelizing devices~~ for construction zone speed limits less than 55 MPH. ~~other than~~

4. Taper required when channelizing device is temporary concrete barrier, see Standard Drawing E 801-TCGB-01.

5. See Standard Drawing E 801-TCCO-02 for  Legend.

6. See Standard Drawing E 801-TCS-01 for General Notes and additional ~~legends~~.

1. Signs XWB-3-B and R4-1-B shall be used only with temporary channelizing devices.

See Standard Drawing E-801-TCC0017 for Sections A-A & B-B

3 See Standard Drawing E 801-TCDV-93 for required length of taper.

for channelling devices for construction zone speed limits less than 55 MPH. Other than

4 Paper required when channelizing device is temporary construction barrier, see Standard Drawing E 801-TCCB-01.

5. See Standard Drawing E-801-T000-02 for legend.

See Standard Drawing E-601-T-CL301 for General Notes and additional Legend Symbols.

## REVISION TO STANDARD DRAWINGS

E 801-TCCO-05 TEMPORARY CROSSOVER TYPE B PAVING AND CLOSURE LAYOUT  
(WITH MARKUPS)

## NOTES

**1. See Standard Drawing E 801-TCCO-~~06~~ for Sections A-A and B-B.**

## 2. Drain to drain

88

—

## **PAVING LIMITS AND DRUM CLOSURE**

The diagram illustrates a Type B Crossover for Earth Cover Closure. It shows a cross-section of a road with a temporary median crossover. The diagram includes several labels and arrows:

- Remove shading**: A red box with an arrow pointing to the shaded area of the diagram.
- PAVING LIMITS AND DRUM CLOSURE**: A label on the left side.
- A**: A vertical dimension line on the left.
- Temporary median crossover**: A label at the bottom right.
- 6:1 Slope to drain**: Labels for the side slopes of the embankment.
- 8:1 Slope**: Labels for the side slopes of the embankment.
- DR**: Labels for the drainage pipes.
- AC**: Labels for the drainage pipes.
- Remove elevation lines**: A red box with an arrow pointing to the elevation lines on the right side.
- EARTH COVER CLOSURE**: A label on the right side.

Remove elevation lines


## TYPE B CROSS OVER

Median Width W	Dimension A	Dimension B	Area of Paving strips
Feet	Feet	Feet	SQ. Yards
60	584	833	4310
50	505	774	3380
40	449	719	2605
36	427	696	2326
30	390	659	1930
26	371	640	1780

INDIANA DEPARTMENT OF TRANSPORTATION		STANDARD DRAWING NO. E 801-TCC0-05-06	
<b>TEMPORARY CROSSOVER TYPE-B PAVING AND CLOSURE LAYOUT</b>		DATE 9-22-03	
SEPTEMBER 2003		DESIGN STANDARDS ENGINEER Jef Richard L. Vanchine	
MICHAEL L. VANCE, P.E. REGISTERED ENGINEER NO. 9750 STATE OF INDIANA PROFESSIONAL ENGINEER		DATE 9-22-03	

## REVISION TO STANDARD DRAWINGS

E 801-TCCO-06 CLOSURE OF TEMPORARY CROSSOVER (WITH MARKUPS)

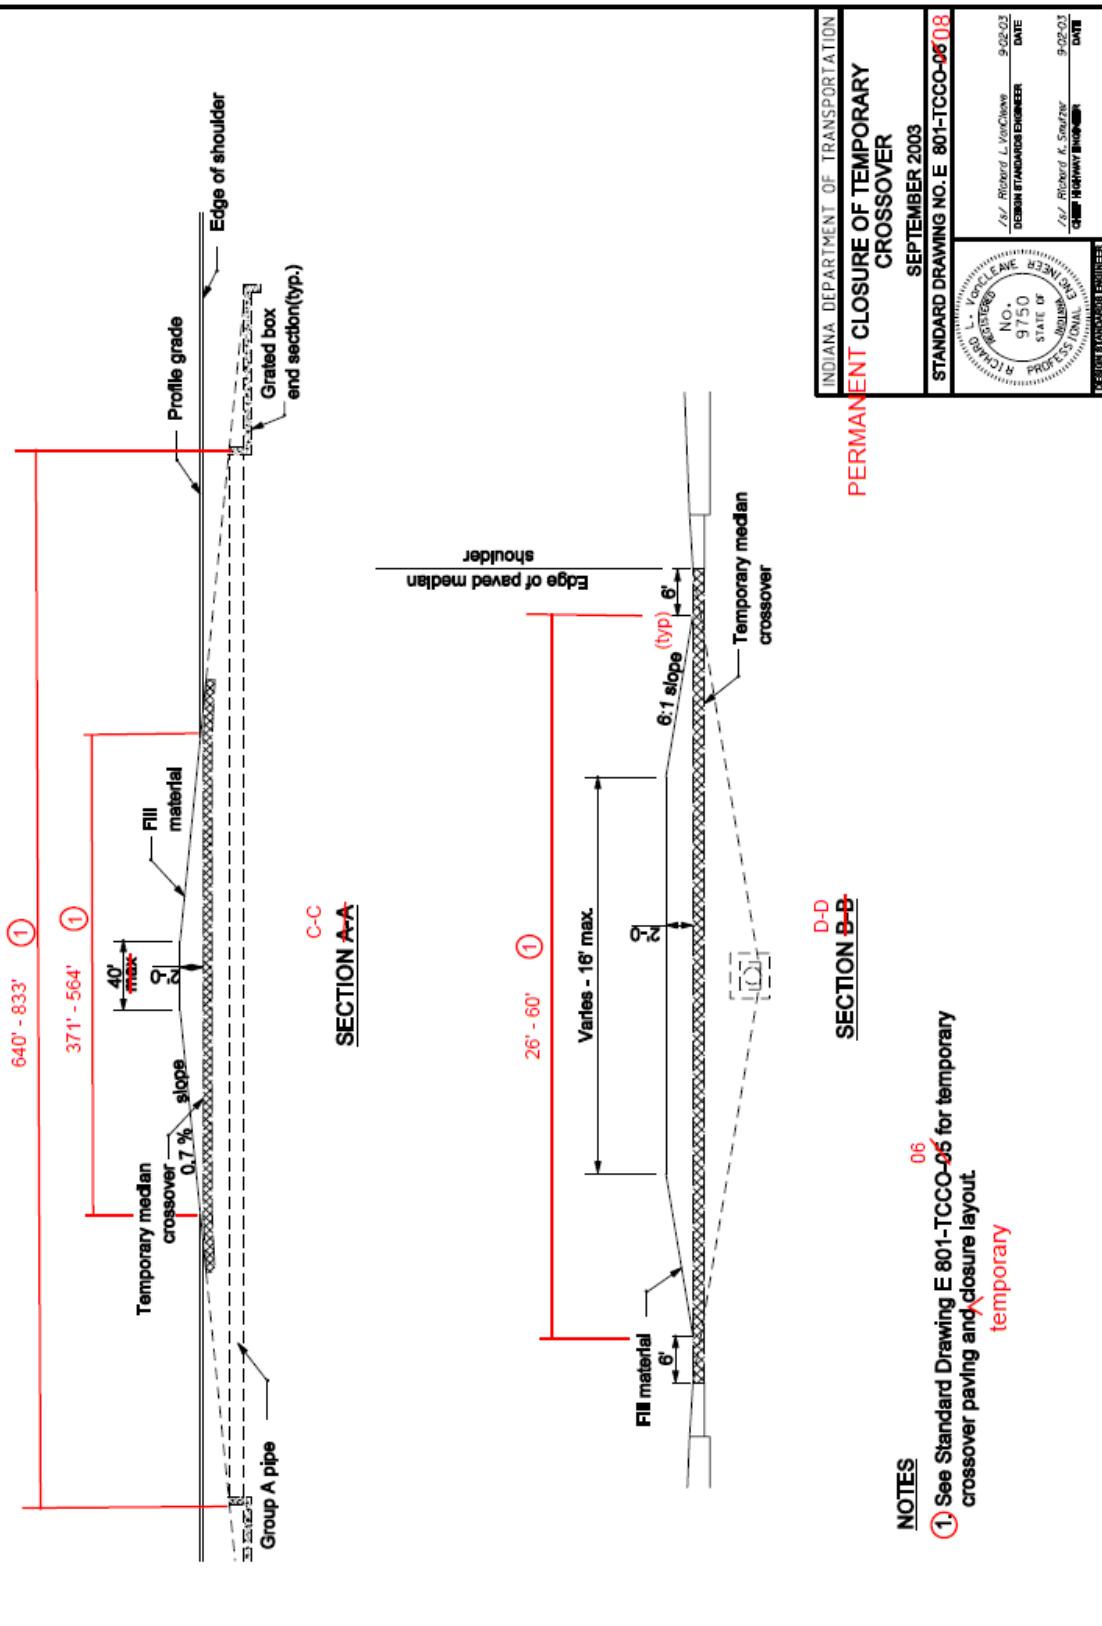


## REVISION TO STANDARD DRAWINGS


E 801-TCCO-07 TEMPORARY CROSSOVER TYPICAL SECTIONS (WITH MARKUPS)

## ~~GENERAL NOTES:~~


1. See Standard Drawing E-801-TCC0-02 for Legend

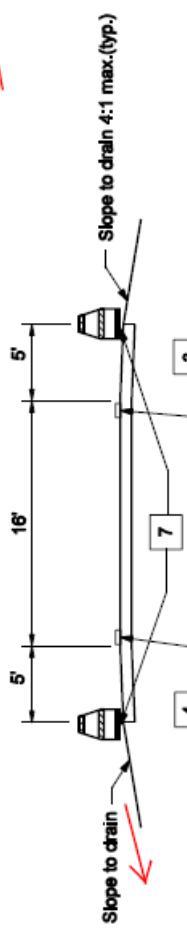

## SECTION A-A

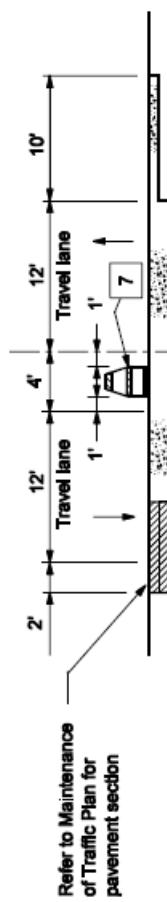

## TRAFFIC MAINTENANCE SECTION

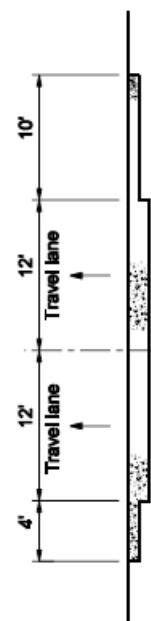

PRE CONSTRUCTION SECTION


**Refer to Maintenance  
of Traffic Plan for  
pavement section**

## Add Typical Section for Split Crossover

INDIANA DEPARTMENT OF TRANSPORTATION	
<b>TEMPORARY CROSSOVER TYPICAL SECTIONS</b> <b>MARCH 2006</b>	
<b>STANDARD DRAWING NO. E 801-TCC0-07</b>	
	<i>For</i> <b>Richard L. VandeCarr</b> <b>DESIGN STANDARDS ENGINEER</b> <i>For</i> <b>Richard K. Smalley</b> <b>HIGHWAY BRIGHENER</b> <b>DATE</b> <b>3-06</b>


## REVISION TO STANDARD DRAWINGS

E 801-TCFO-01 FLAGGER OPERATIONS (WITH MARKUPS)

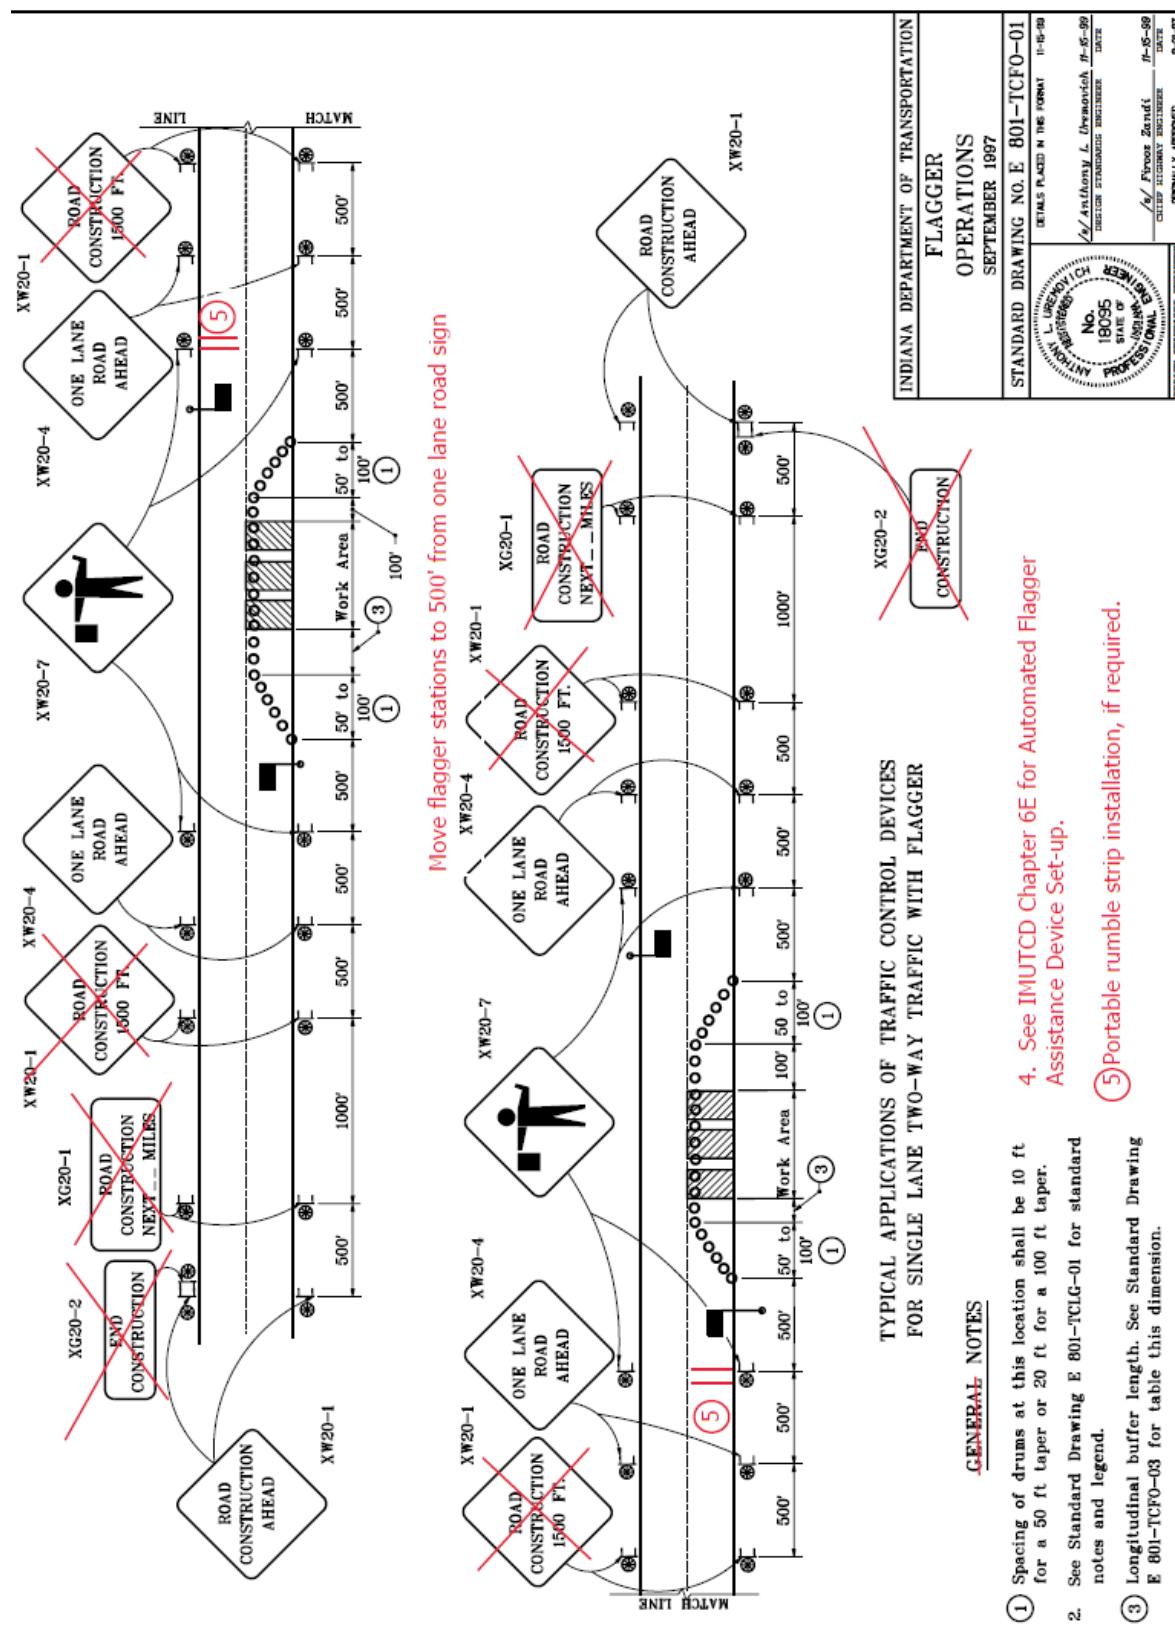


## REVISION TO STANDARD DRAWINGS

## E 801-TCFO-02 MAINTENANCE OF TRAFFIC FOR MOVING OPERATION (WITH MARKUPS)

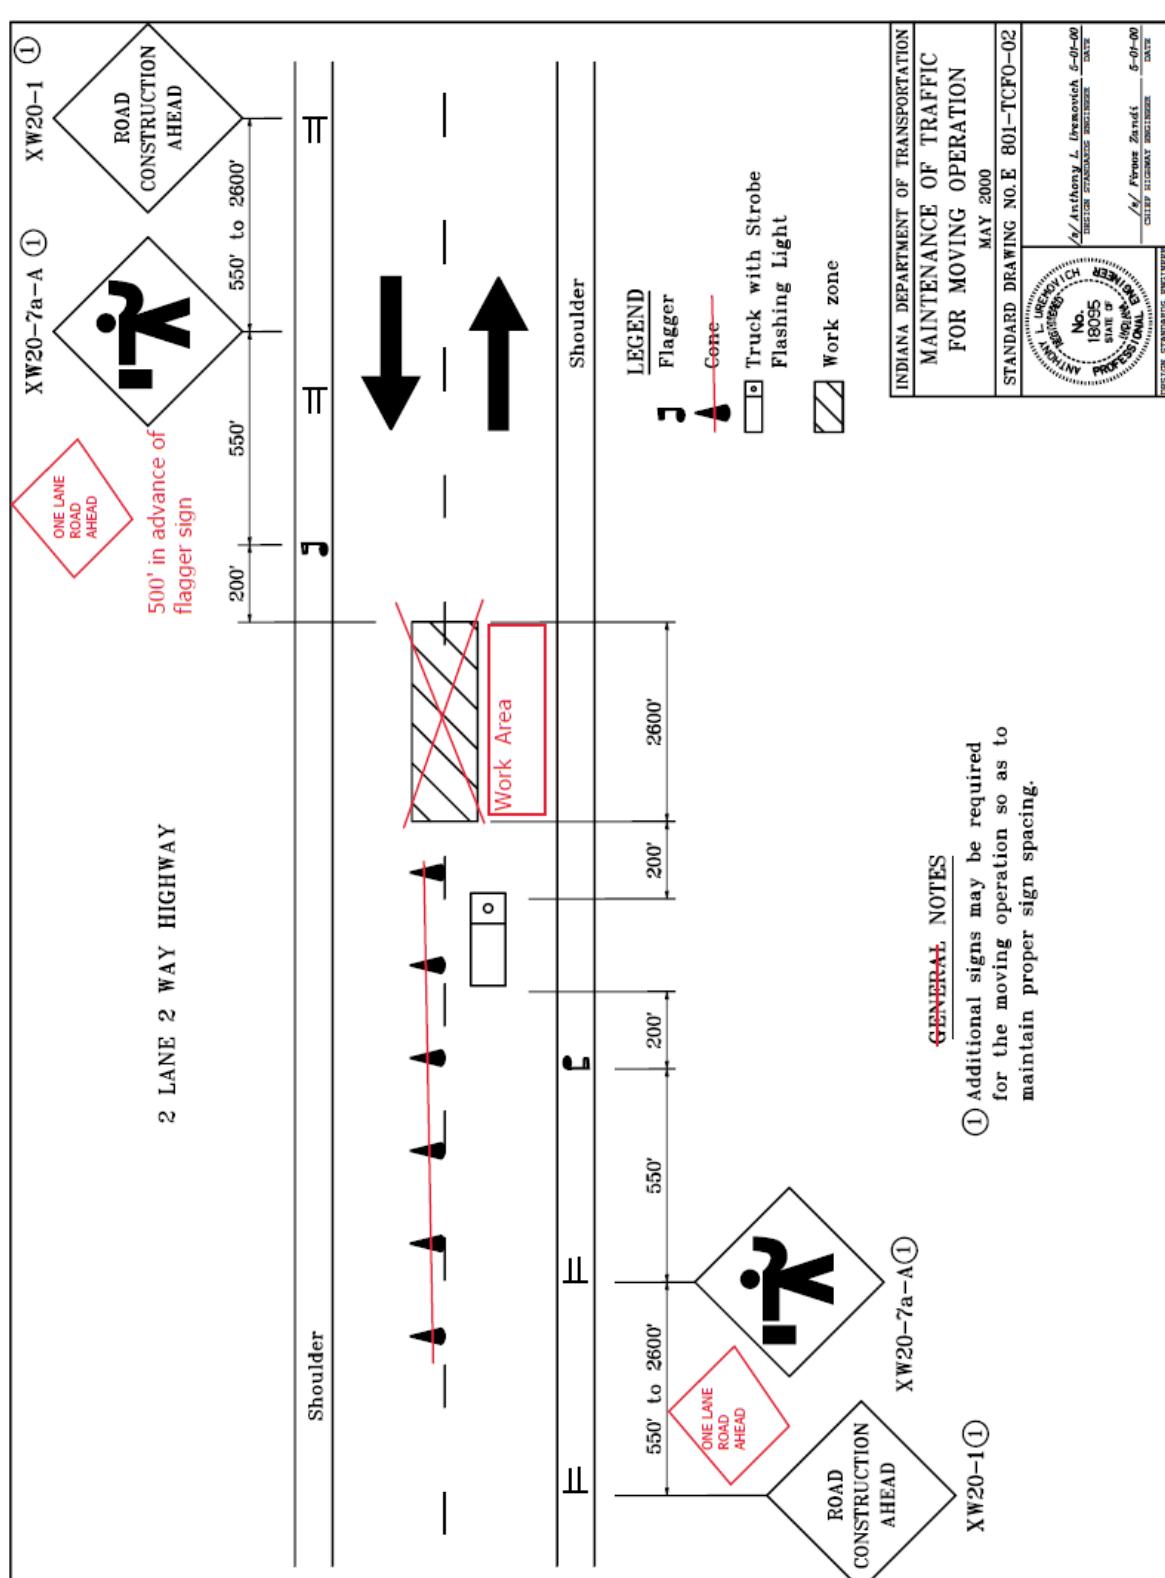


## REVISION TO STANDARD DRAWINGS

## E 801-TCFO-03 MAINTENANCE OF TRAFFIC FOR REFLECTOR REPLACEMENT (WITH MARKUPS)

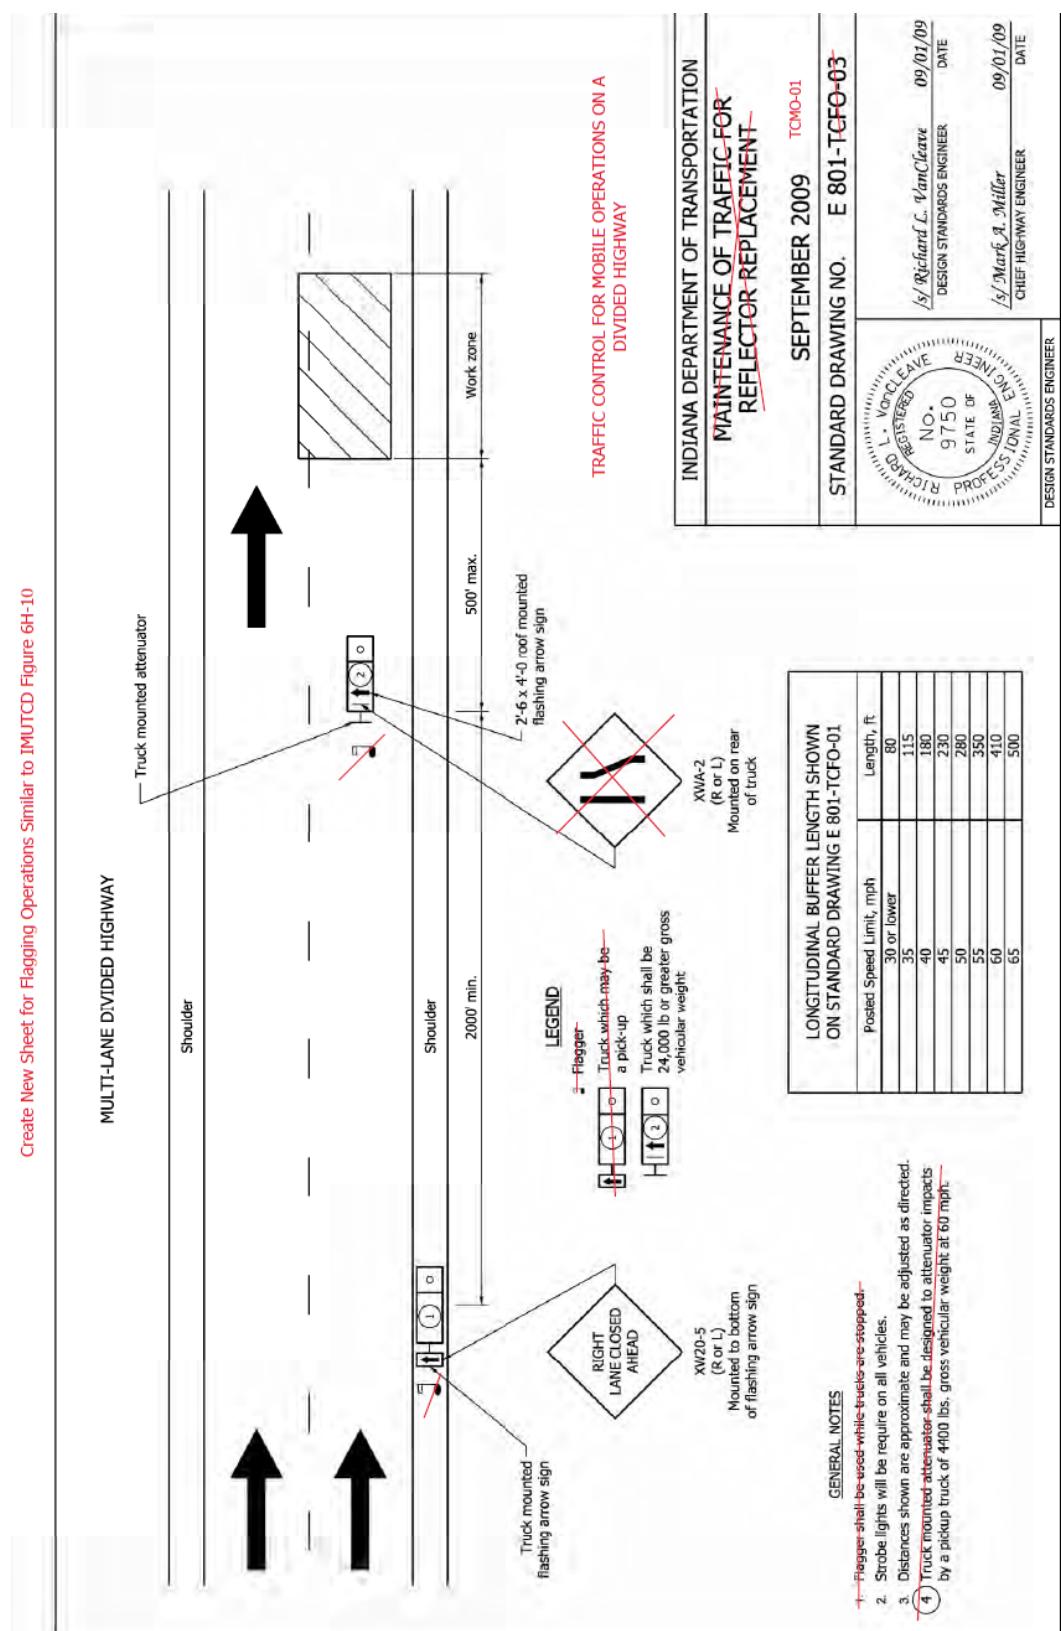

## REVISION TO STANDARD DRAWINGS

## E 801-TCFO-04 TRAFFIC CONTROL FOR OVERHEAD SIGN INSTALLATION (WITH MARKUPS)

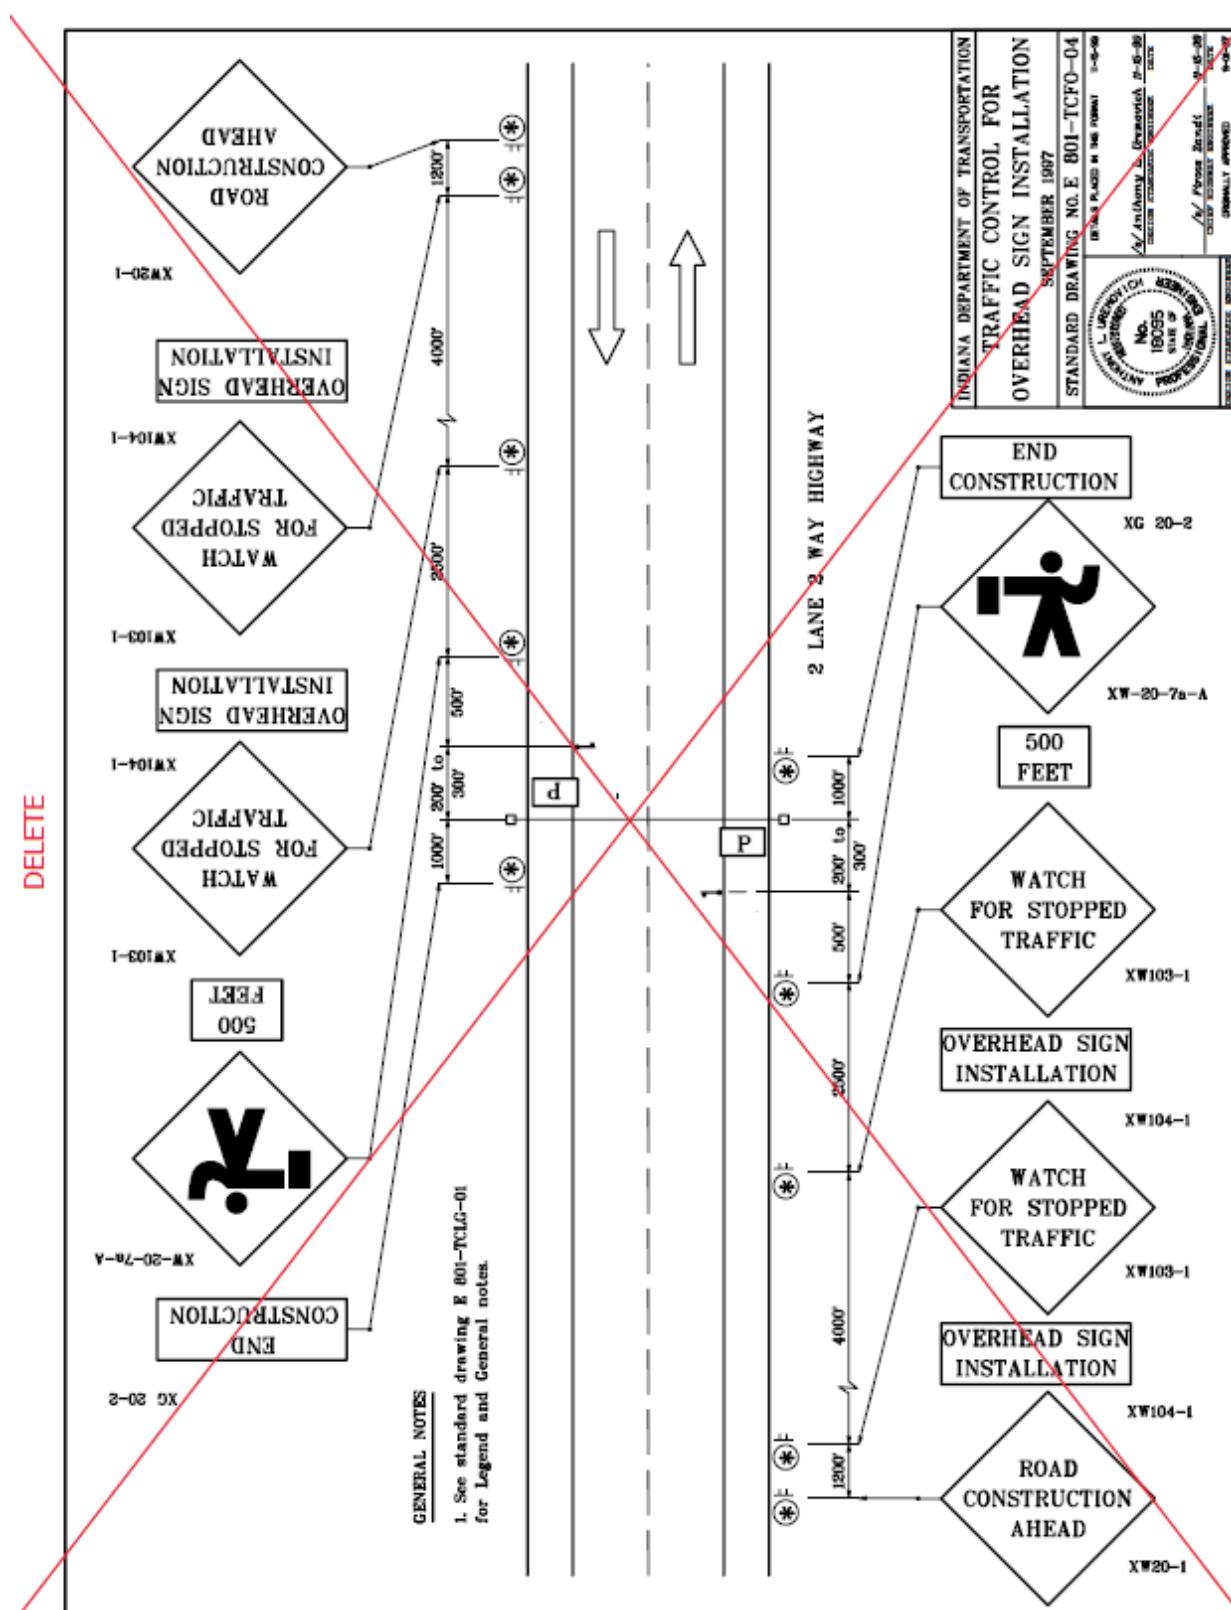

Item No. 2 4/19/18 (2018 SS) (contd.)


Mr. Boruff

Date: 4/19/18

## REVISION TO STANDARD DRAWINGS


E 801-TCFO-05 TRAFFIC CONTROL FOR OVERHEAD INSTALLATION (WITH MARKUPS)

**DELETE**

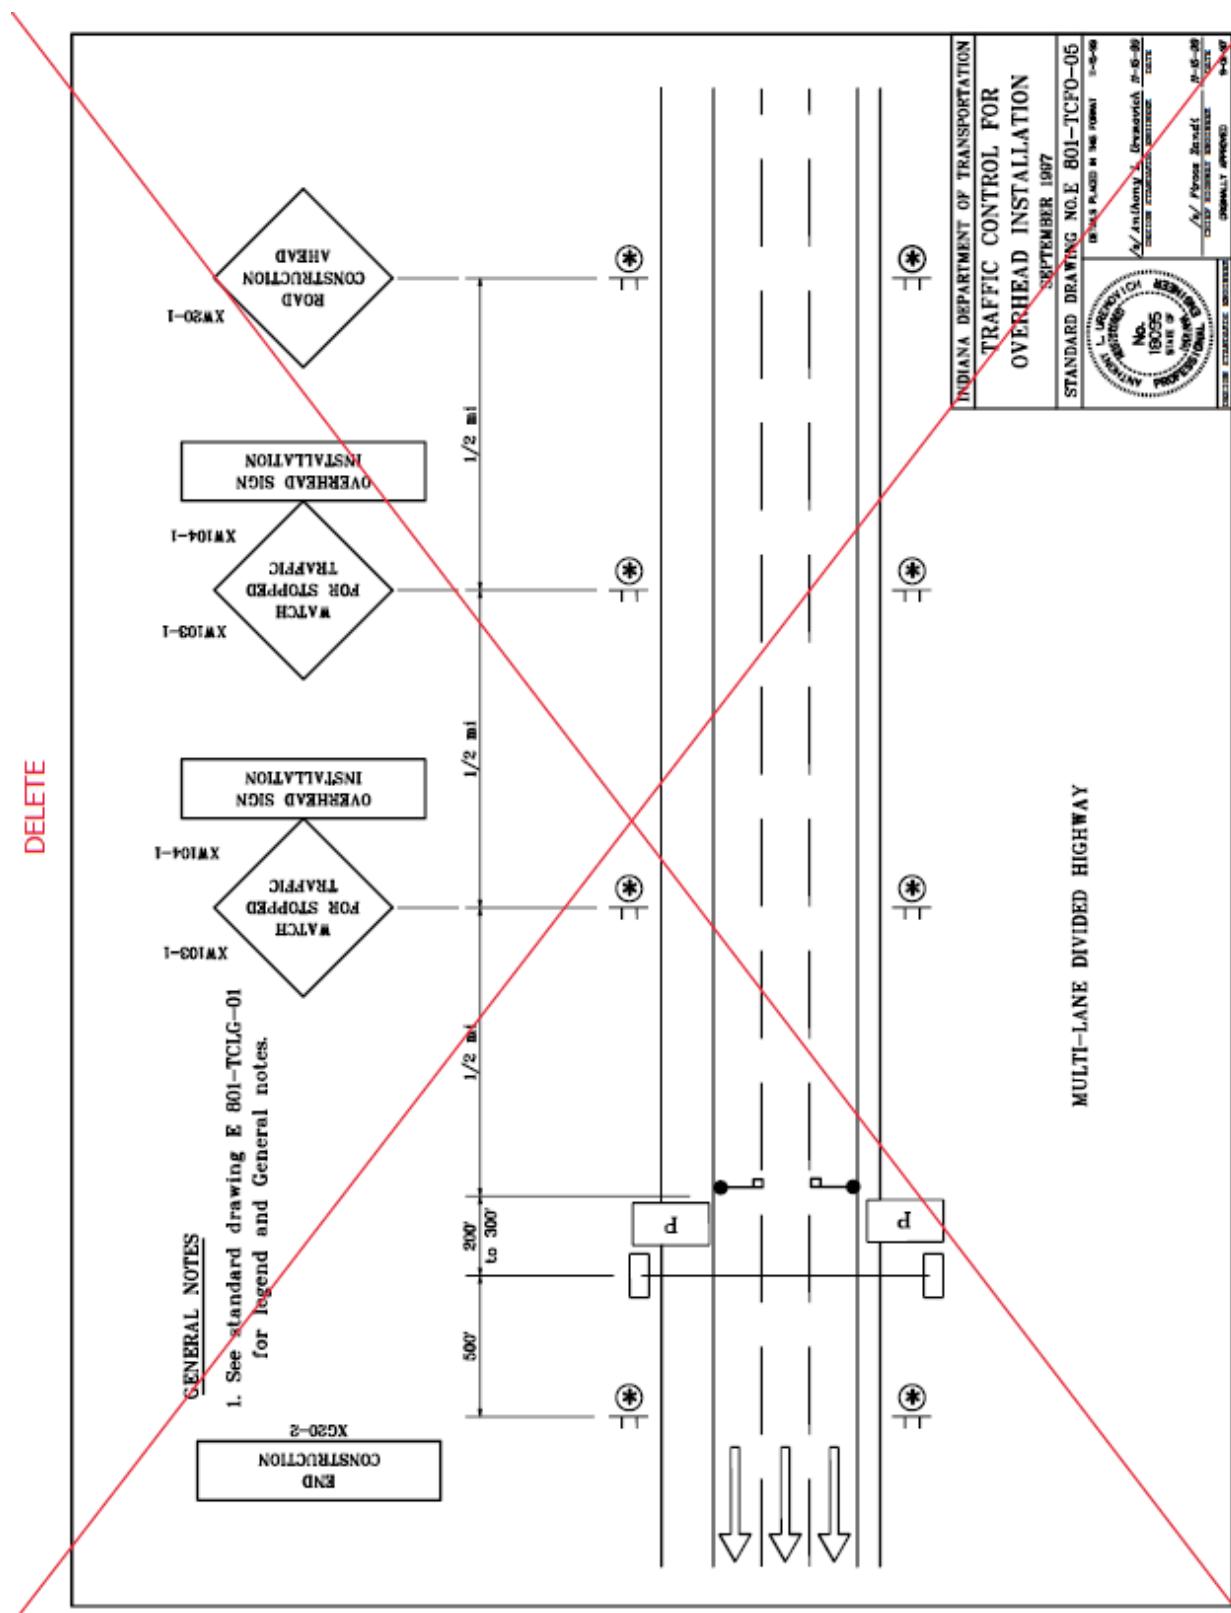


## REVISION TO STANDARD DRAWINGS

E 801-TCFO-06 TRAFFIC CONTROL FOR INTERSECTION WORK (WITH MARKUPS)

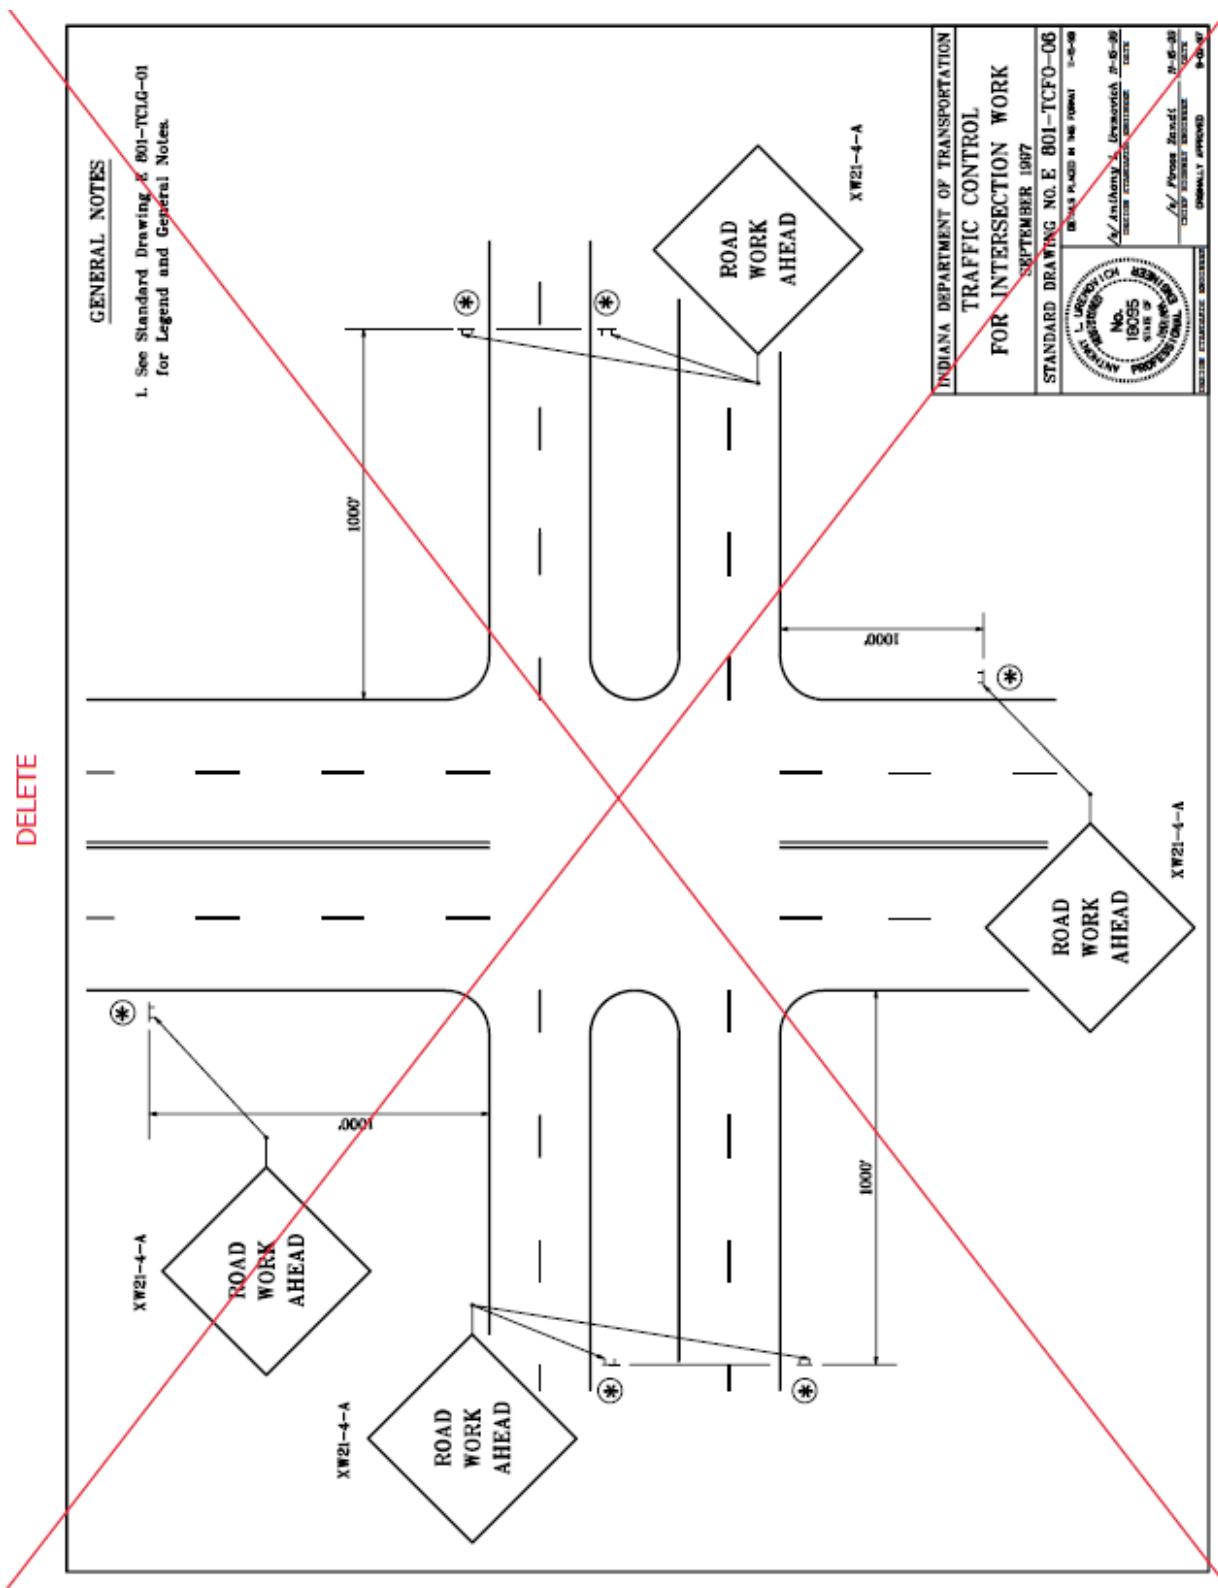


## REVISION TO STANDARD DRAWINGS

E 801-TCLC-01 LANE CLOSURES INTERSTATE APPLICATIONS (WITH MARKUPS)

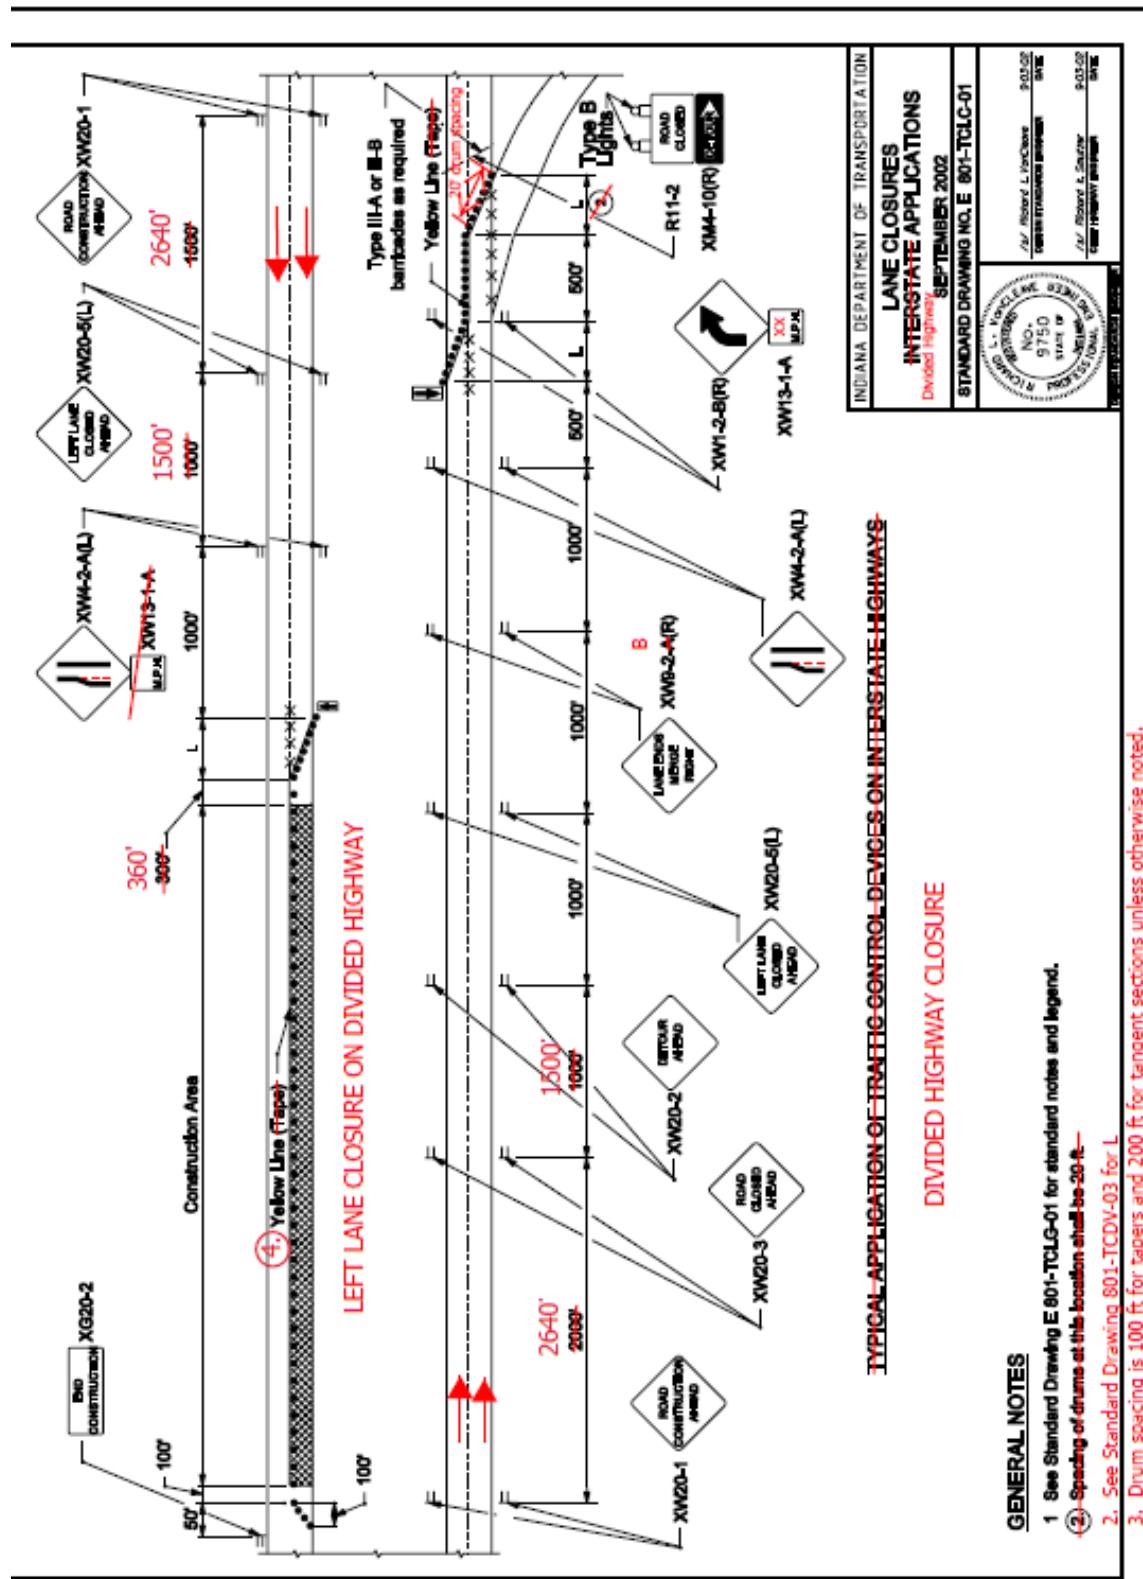


## REVISION TO STANDARD DRAWINGS

E 801-TCLC-02 CONTINUOUS LANE CLOSURES RIGHT LANE CLOSED (WITH MARKUPS)

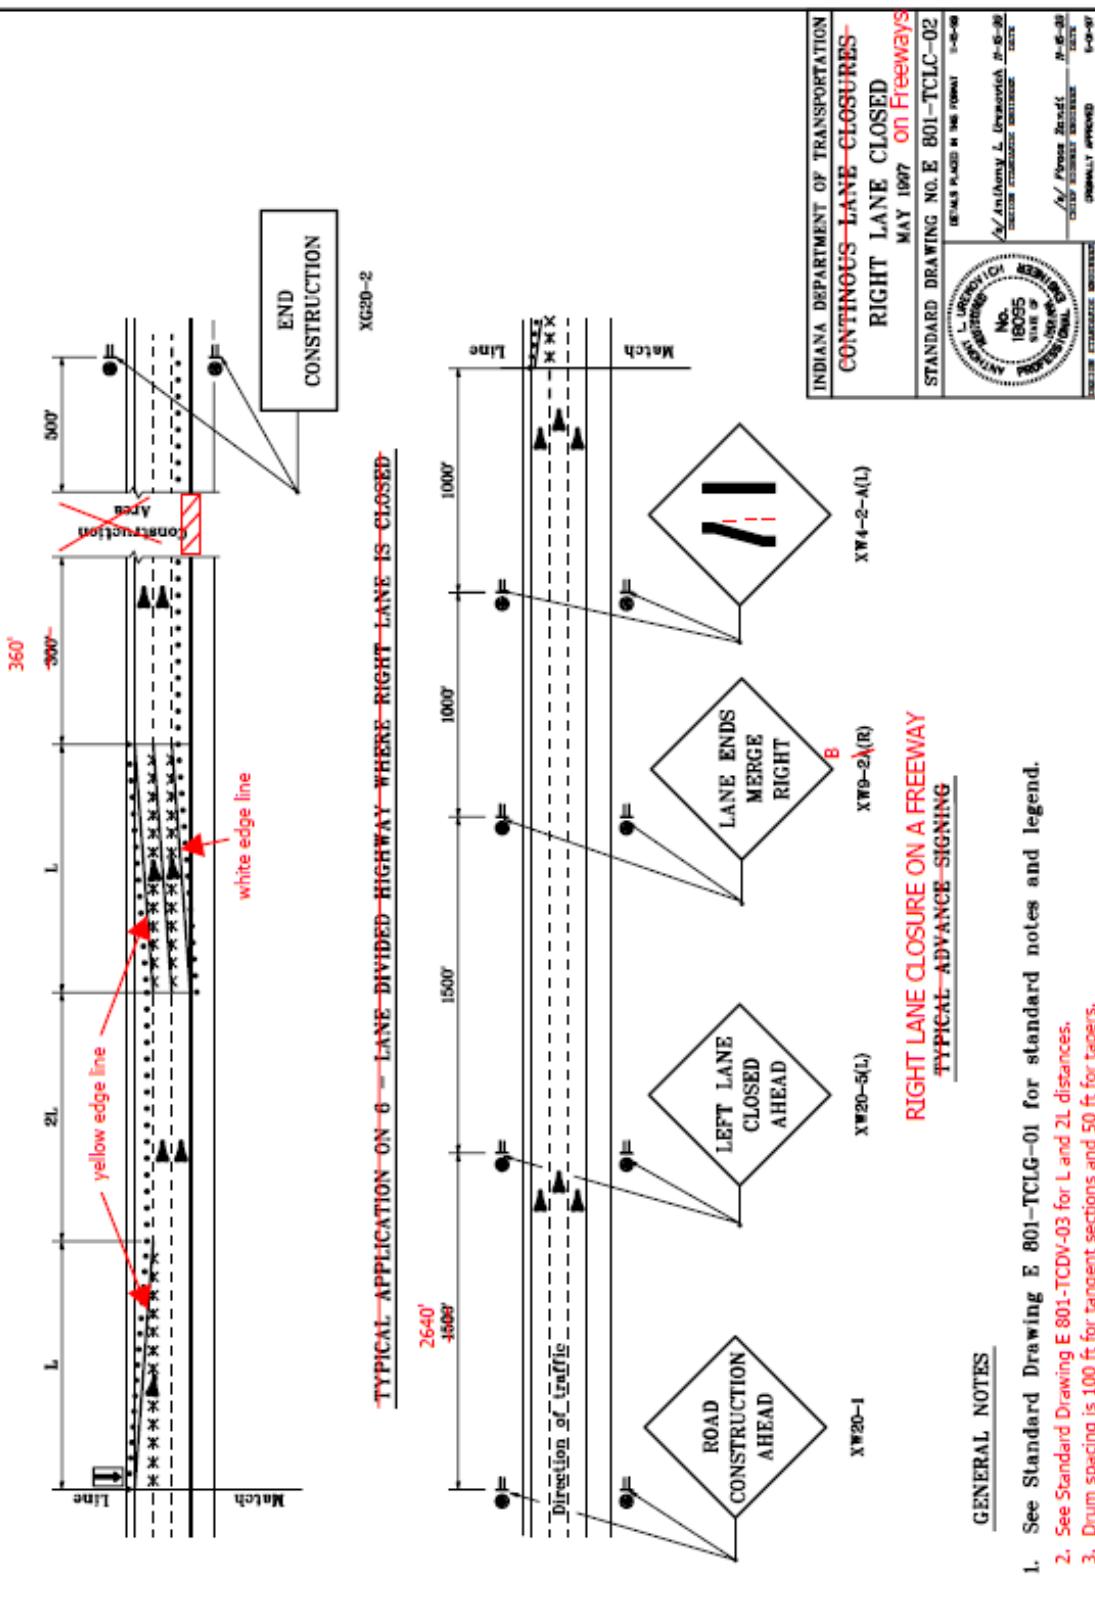


## REVISION TO STANDARD DRAWINGS

E 801-TCLC-03 CONTINUOUS LANE CLOSURES CENTER LANE CLOSED (WITH MARKUPS)

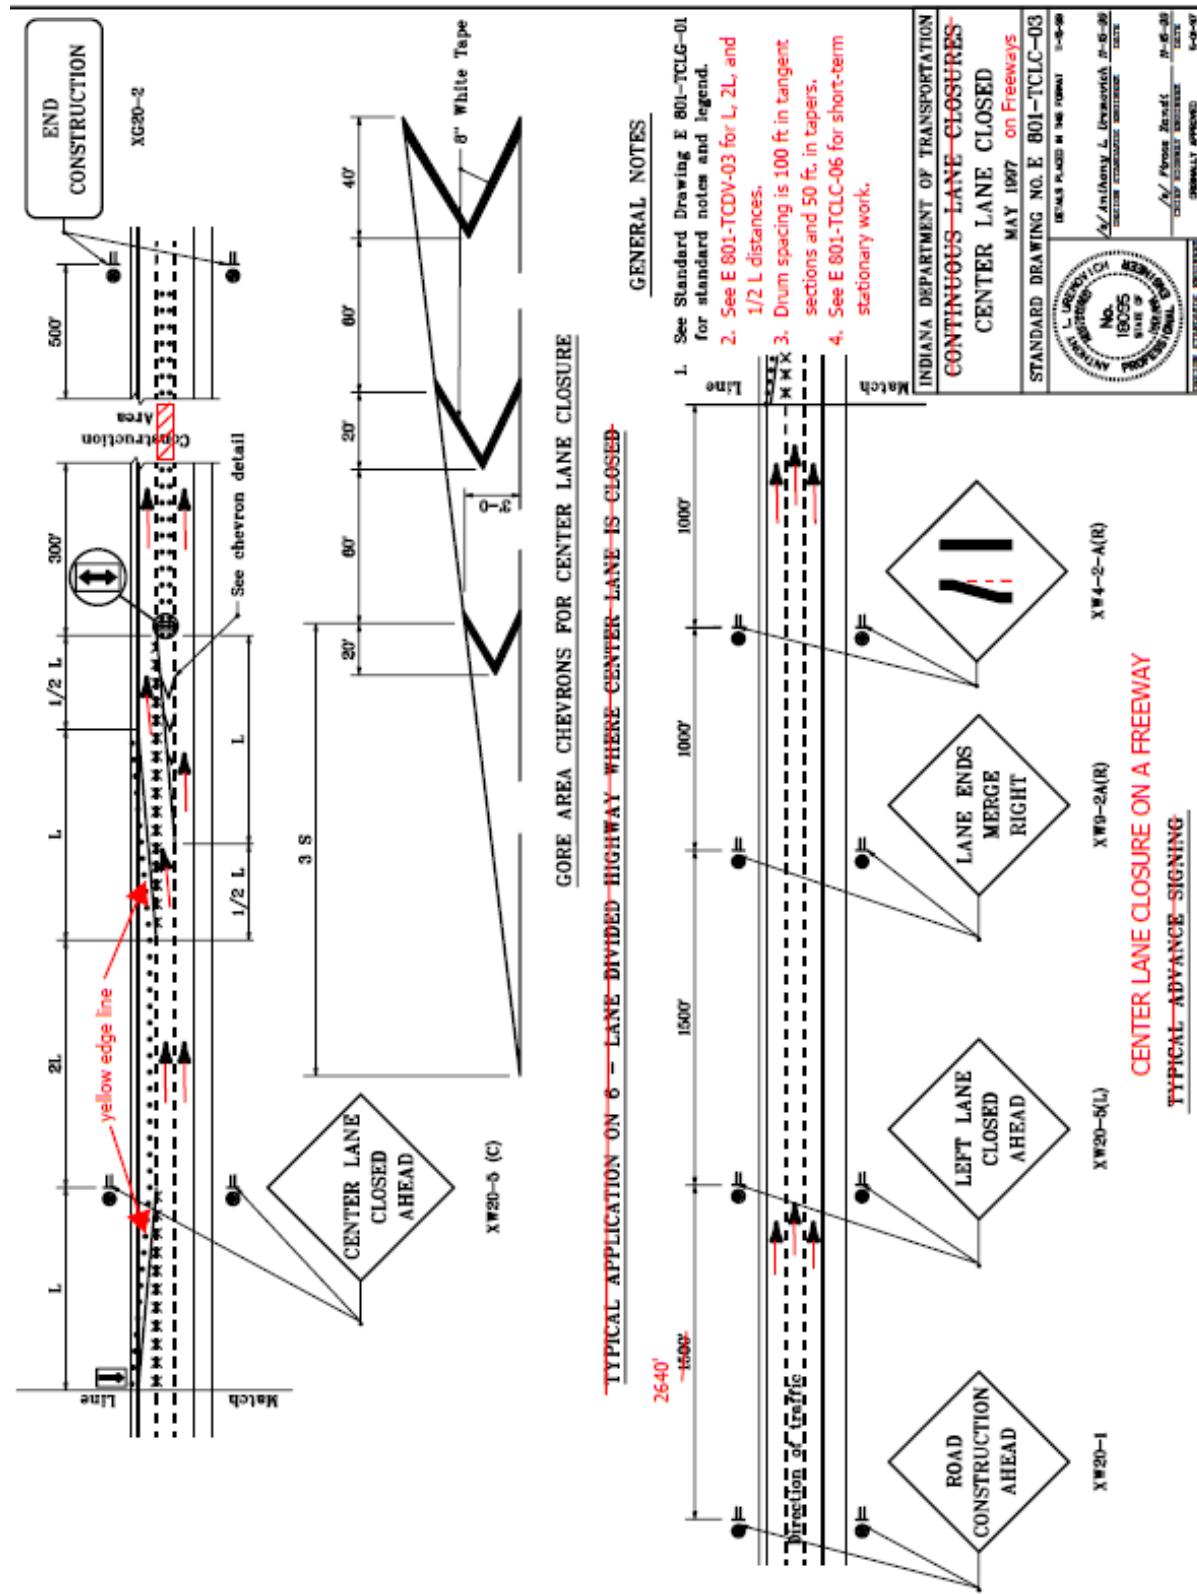


## REVISION TO STANDARD DRAWINGS

E 801-TCLC-04 CONTINUOUS LANE CLOSURES LEFT LANE CLOSED (WITH MARKUPS)

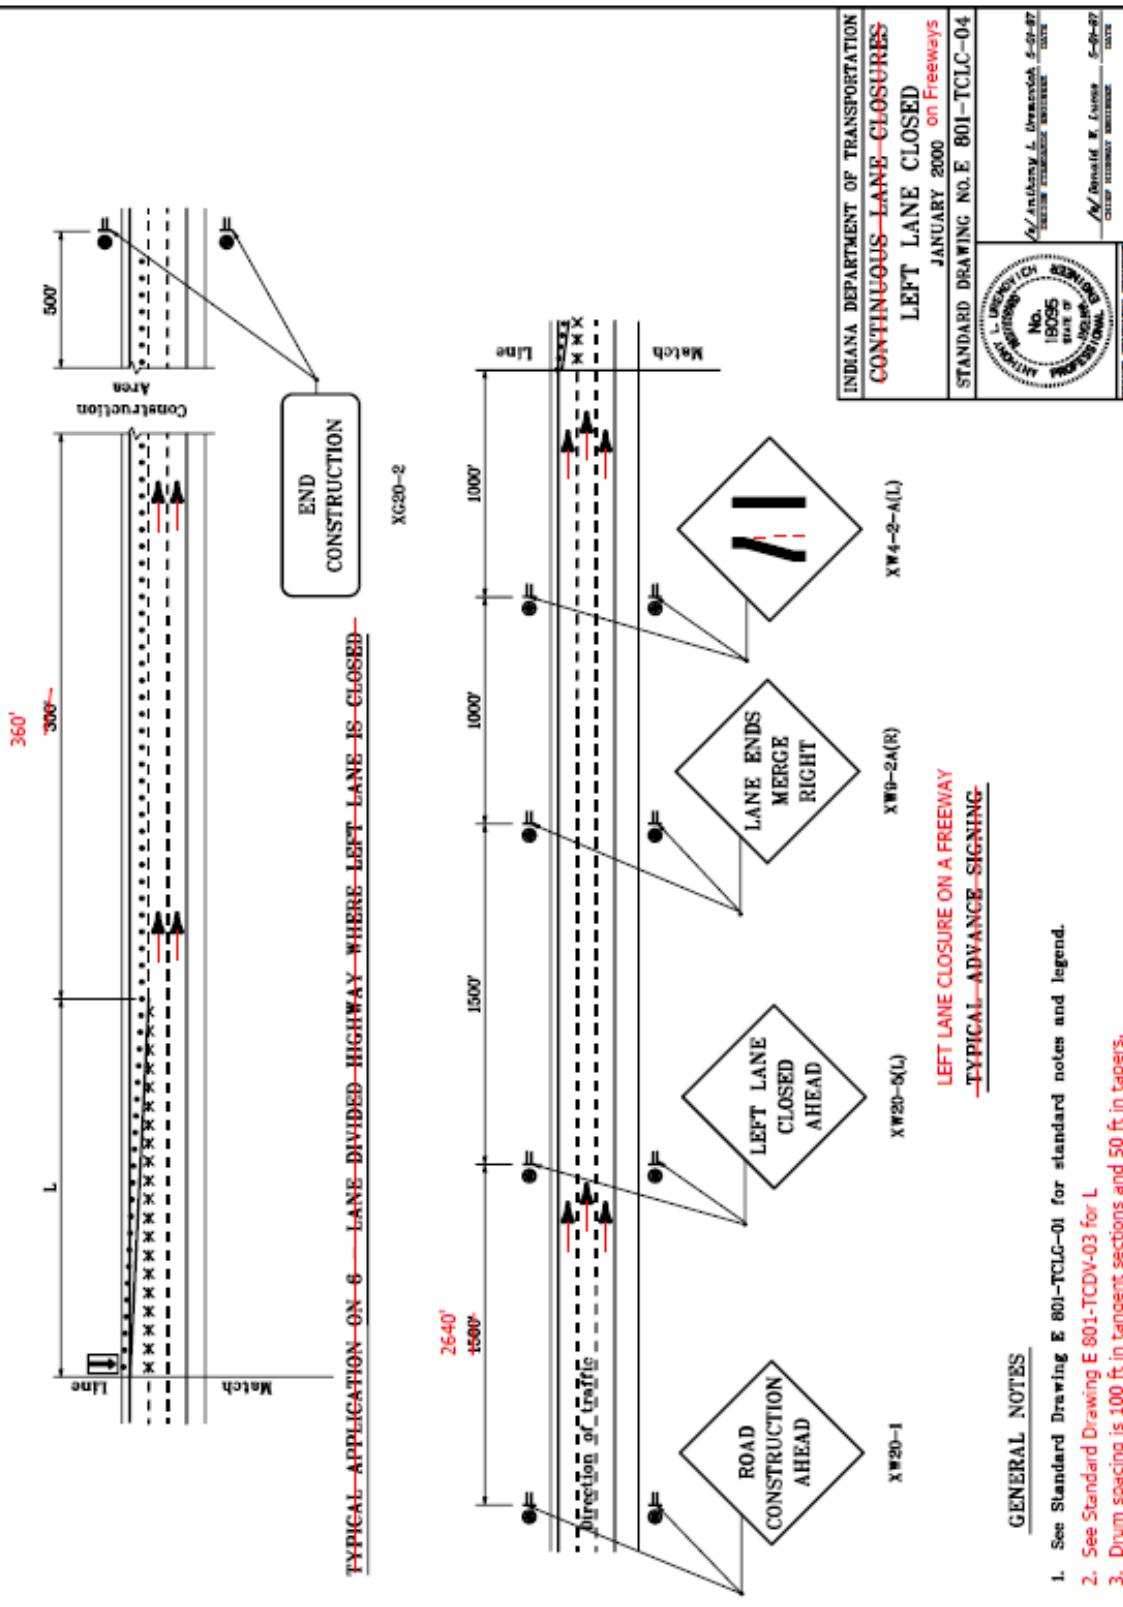

## REVISION TO STANDARD DRAWINGS

E 801-TCLC-05 DAYLIGHT LANE CLOSURES RIGHT LANE CLOSED (WITH MARKUPS)

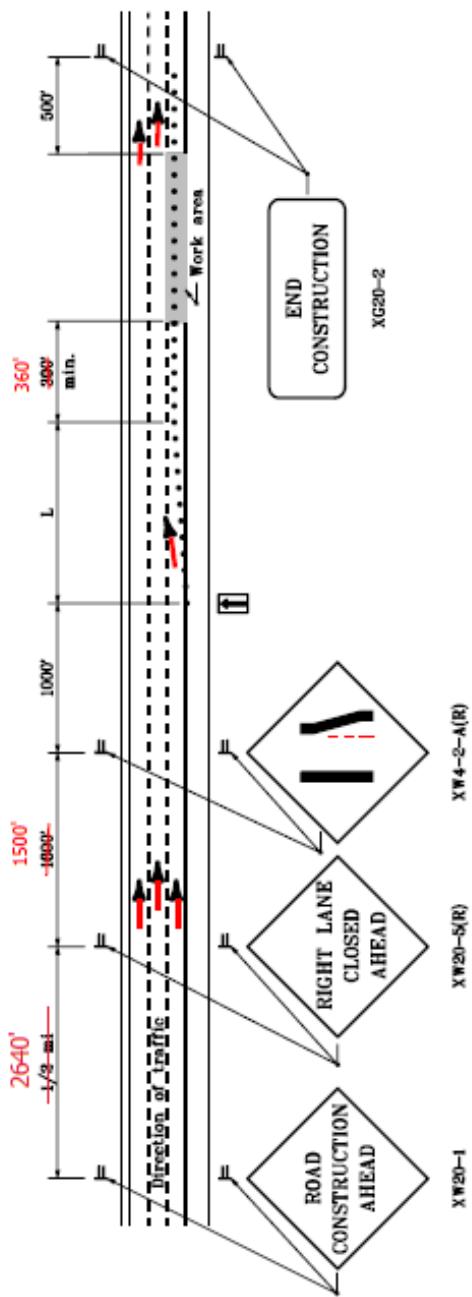

SHORT-TERM RIGHT LANE CLOSURE

INDIANA DEPARTMENT OF TRANSPORTATION	
<del>DAYLIGHT LANE CLOSURES</del>	
<del>RIGHT LANE CLOSED</del>	
MAY 1997	
STANDARD DRAWING NO. E 801-TCIC-05	
<p style="text-align: center;">(PRINTS PLACED IN THIS FORM)</p> <p style="text-align: center;">1-15-98</p>	
<p style="text-align: center;">A/ Anthony L. Fornachon, 11-6-98          ENGINEER, STATEMENT, SIGNED          DATE</p>	
<p style="text-align: center;">A/ Phoenix, Bradt, 11-6-98          ENGINEER, STATEMENT, SIGNED          DATE</p>	
<p style="text-align: center;">ORIGINALLY APPROVED:</p>	
<p style="text-align: center;">L. UREKOVICH          ENGINEER</p>	
<p style="text-align: center;">NO. 105          STATE OF          INDIANA          PROFESSIONAL          ENGINEER          CERTIFICATE NUMBER          DATE</p>	

#### GENERAL NOTES

1. All lanes are to be open after daylight working hours.
2. See Standard Drawing E 801-TCLG-01 for standard notes and legend.
3. See Standard Drawing E 801-TCDV-03 for L
4. Drum spacing is 100 ft in tangent sections and 50 ft in tapers.
5. See Standard Drawing E 801-TCLC-02 for long-term or intermediate term work.

## REVISION TO STANDARD DRAWINGS

E 801-TCLC-06 DAYLIGHT LANE CLOSURES LEFT OR CENTER LANE CLOSED (WITH MARKUPS)

## GENERAL NOTES

1. All lanes are to be open after daylight working hours.


2. See Standard Drawing E 801-TCLG-01 for standard notes and legend.

3. See Standard Drawing E 801-TCDV-03 for L<sub>2L</sub> and 1/2 L distances.


4. Drum spacing is 100 ft for tangent sections and 50 ft for tapers.

5. See Standard Drawing E 801-TCLC-03 for long or intermediate term center lane closures.

6. See Standard Drawing E 801-TCLC-04 for long or intermediate term left lane closures.

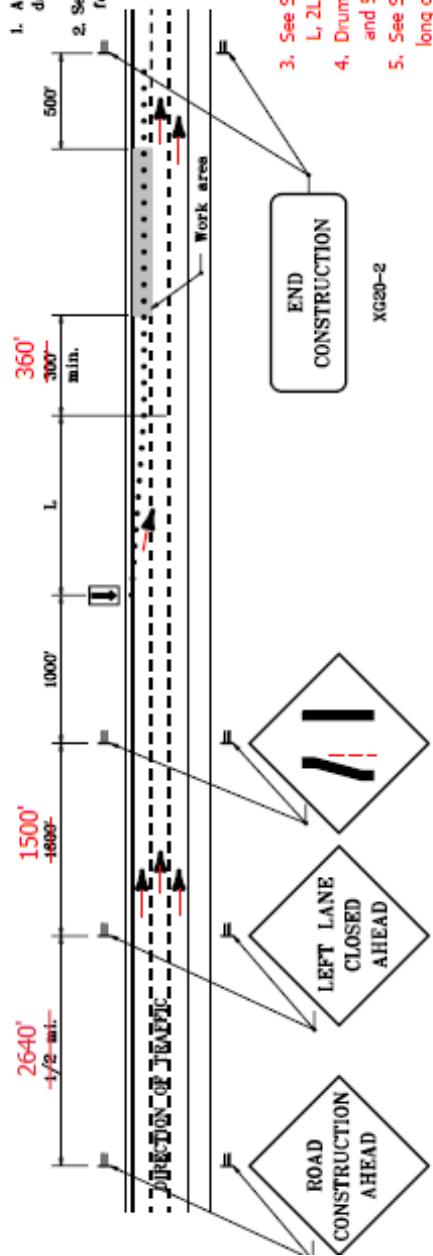

**SHORT-TERM LEFT LANE CLOSURE (Daytime Only)**

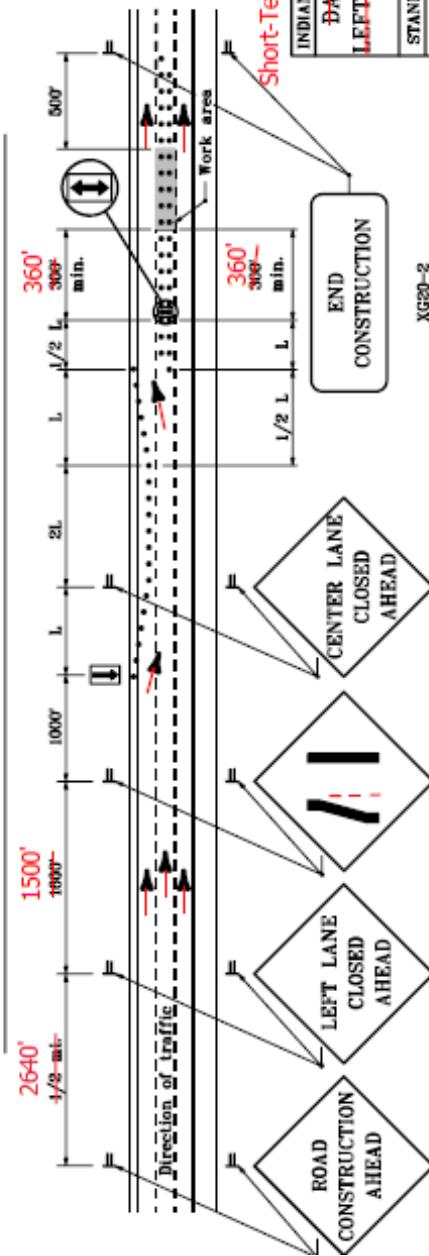


**SHOR-T TERM CENTER LANE CLOSURE (Daytime Only)**  
**TYPICAL APPLICATION ON 6 - LANE DIVIDED HIGHWAY WHERE CENTER LANE IS CLOSED**

INDIANA DEPARTMENT OF TRANSPORTATION	
<del>DAYLIGHT LANE CLOSURES</del>	
<del>LEFT OR CENTER LANE CLOSED</del>	
MAY 1997	
STANDARD DRAWING NO. E 801-TCLC-06	
ORIGINAL PLACED IN 1966 FORM	
 ✓ Anthony L. Brumfield, P.E. DIRECTOR, DIVISION OF HIGHWAYS APPROVED DRAWING NUMBER 16005 DATE DRAWN 10-15-98 DATE CHECKED 10-15-98 DATE APPROVED 10-15-98	

## REVISION TO STANDARD DRAWINGS


## E 801-TCLC-07 TRAFFIC CONTROL FOR SHOULDER WORK (WITH MARKUPS)

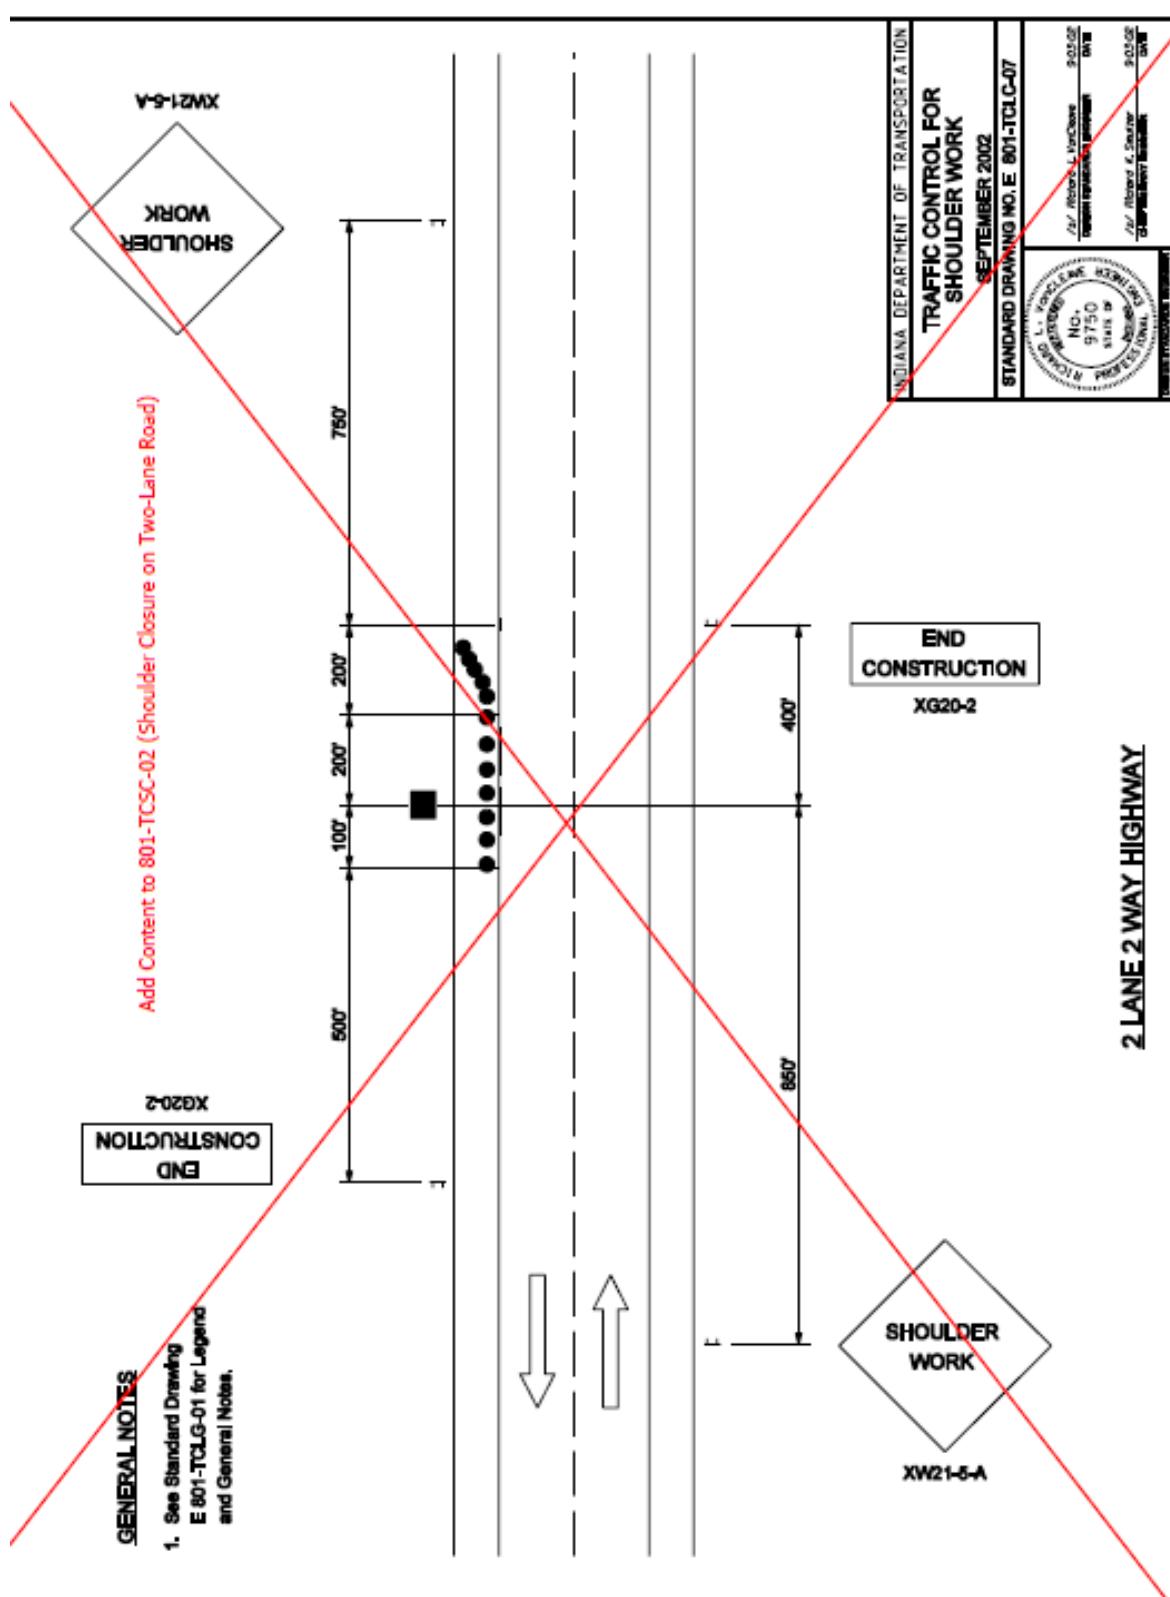

## REVISION TO STANDARD DRAWINGS


## E 801-TCLC-08 TRAFFIC CONTROL FOR LANE CLOSURE (WITH MARKUPS)

Address in 801-TCFD series (Flagger Operations)

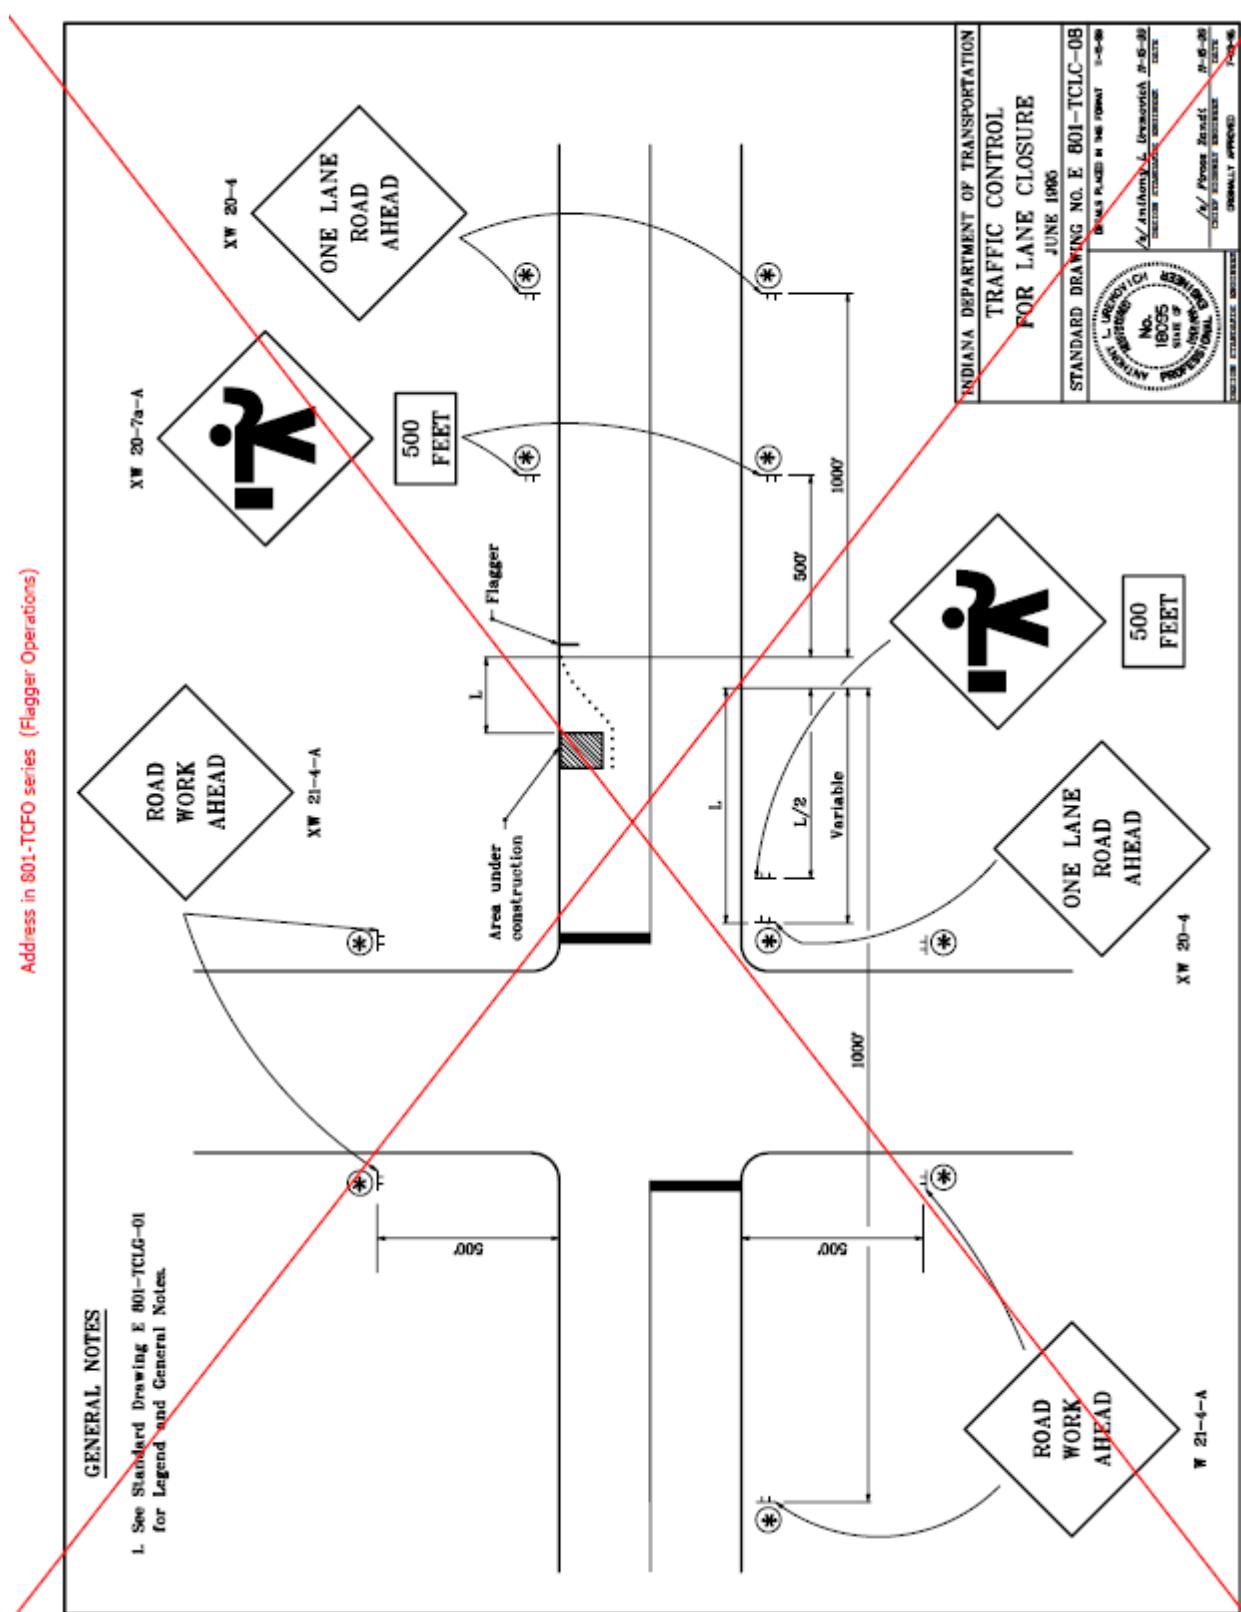


## REVISION TO STANDARD DRAWINGS

E 801-TCLC-09 TRAFFIC CONTROL FOR LANE CLOSURE ON A TREE LANE ROAD  
(WITH MARKUPS)

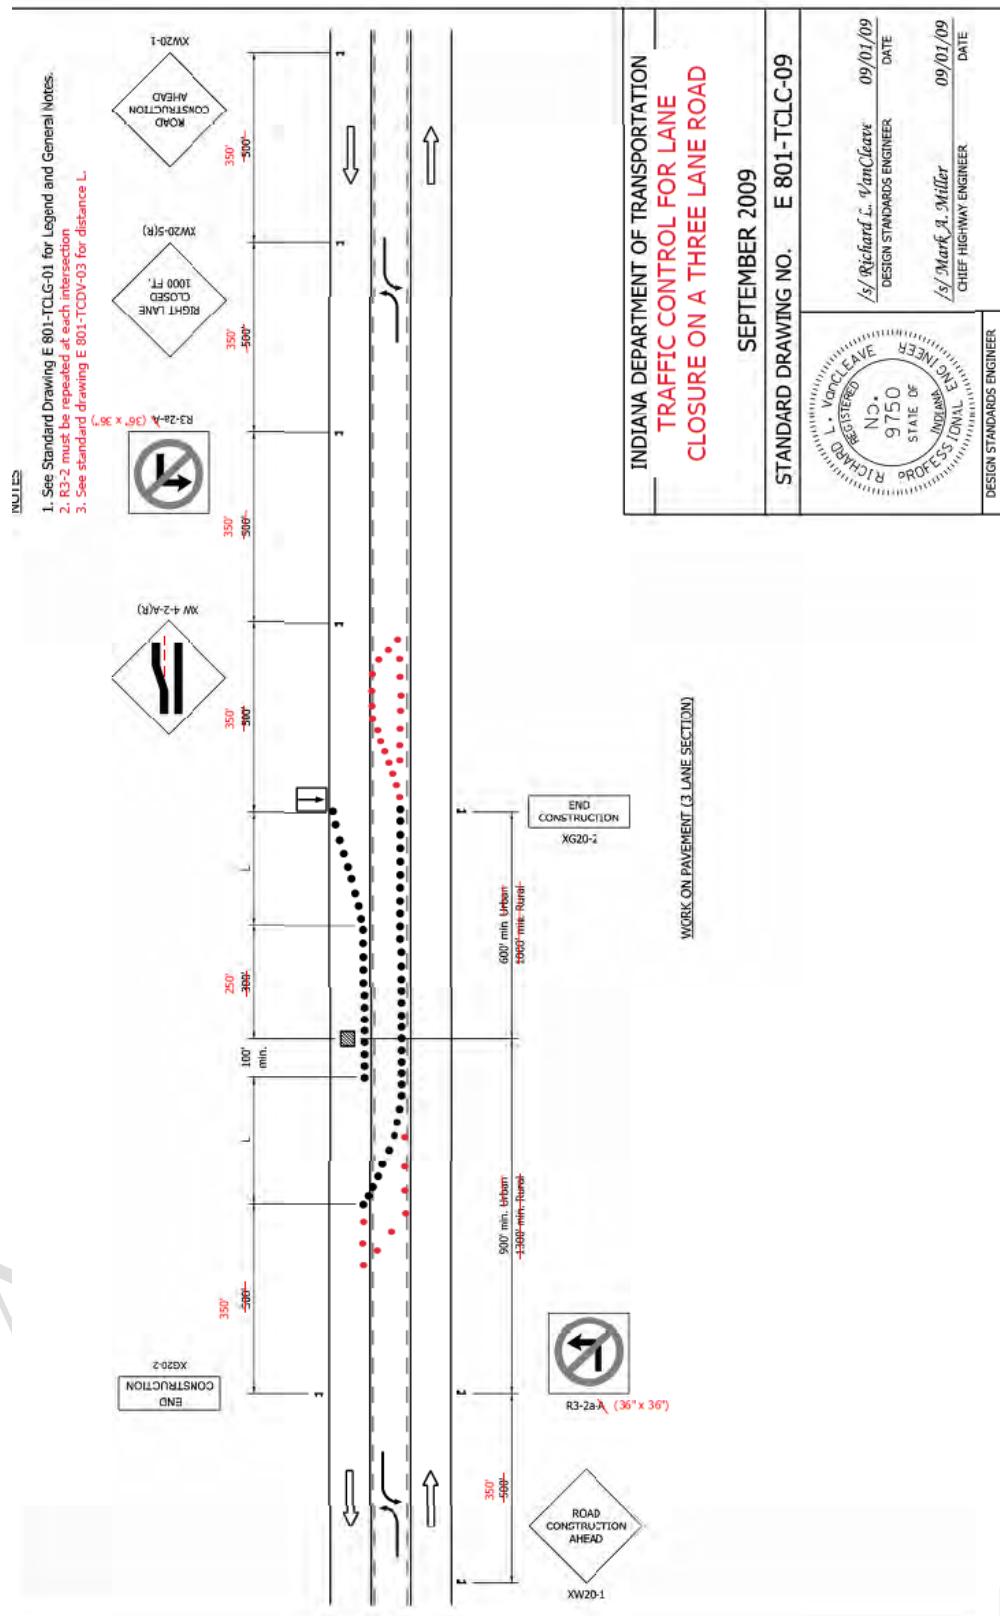

## REVISION TO STANDARD DRAWINGS

## E 801-TCLC-10 TRAFFIC CONTROL FOR SHOULDER WORK (WITH MARKUPS)

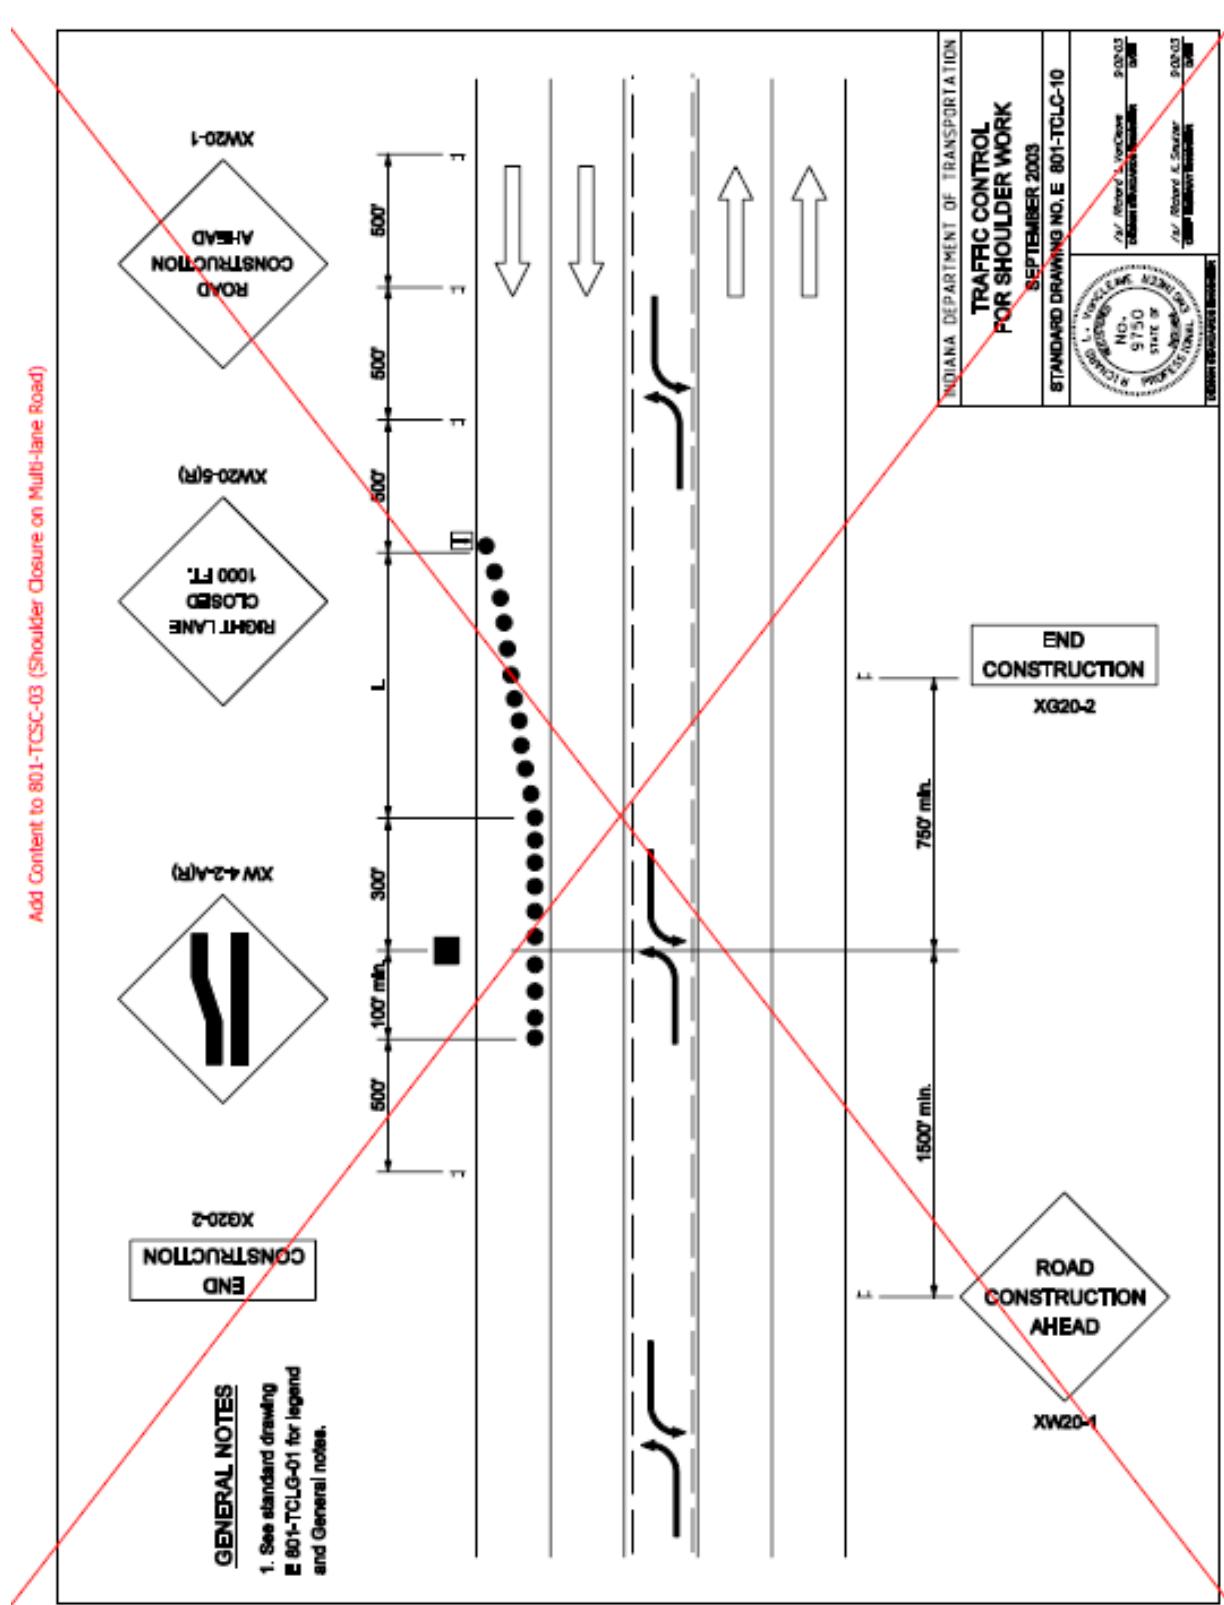


## REVISION TO STANDARD DRAWINGS

E 801-TCLC-11 TRAFFIC CONTROL FOR LANE CLOSURE (WITH MARKUPS)

**DELETE**

## GENERAL NOTES

1. See Standard Drawing E-801-TCLG-01 for additional general notes.

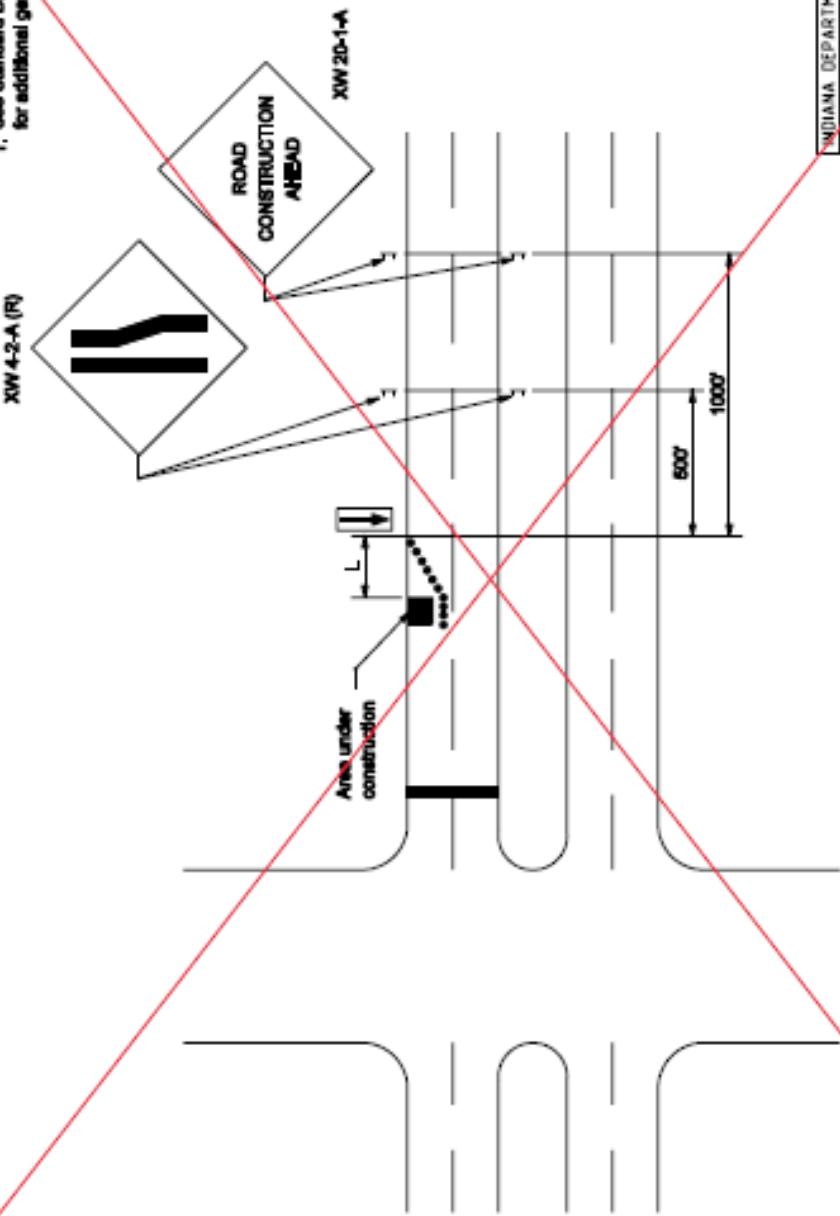


The sign is a rectangular metal plate with a black border. At the top, it says "INDIANA DEPARTMENT OF TRANSPORTATION" in all caps. Below that, in large letters, is "TRAFFIC CONTROL FOR LANE CLOSURE". Underneath that, in smaller letters, is "SEPTEMBER 2002". At the bottom, it says "STANDARD DRAWING NO. E 801-TC1C-11". A large red "X" is drawn across the entire sign from the top right corner to the bottom left corner.

## REVISION TO STANDARD DRAWINGS


E 801-TCLC-12 TRAFFIC CONTROL FOR SHOULDER WORK (WITH MARKUPS)

Move to 801-TCS SC Series

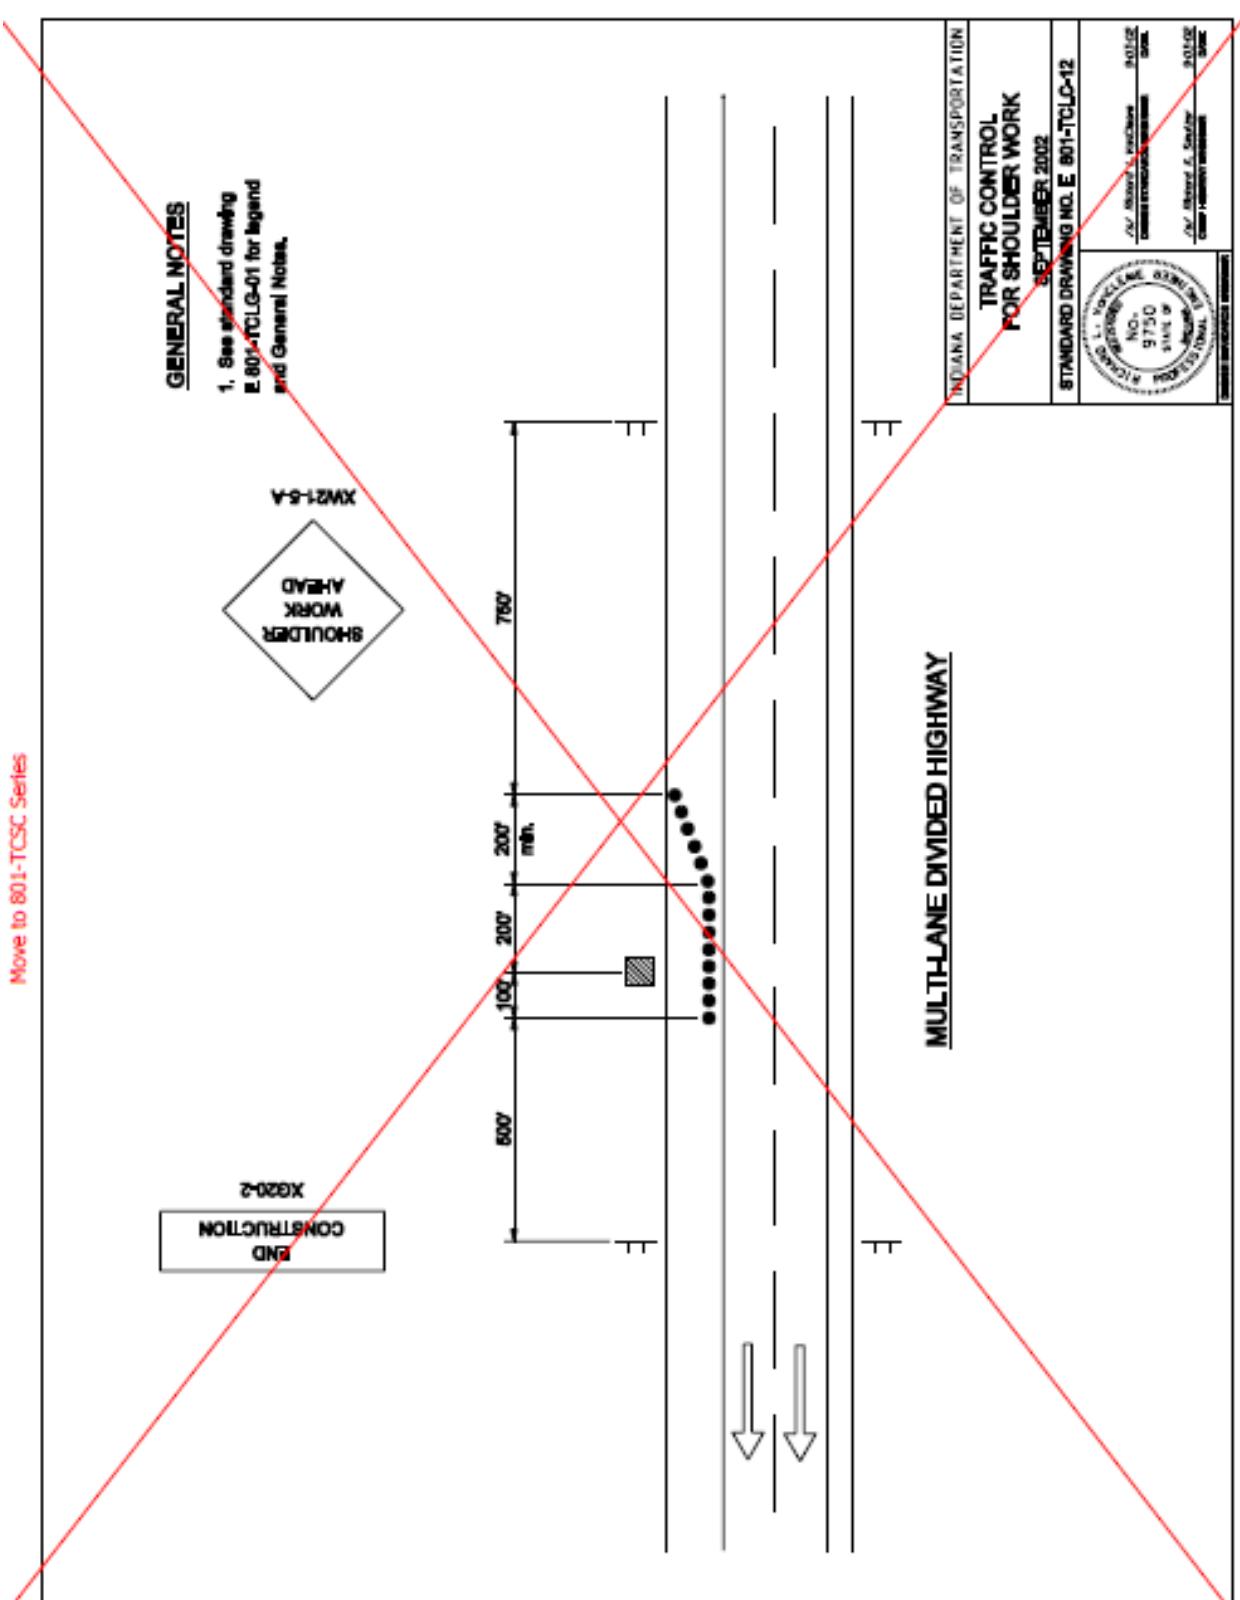

## REVISION TO STANDARD DRAWINGS

E 801-TCLC-13 TRAFFIC CONTROL FOR OVERHEAD SIGN INSTALLATION (WITH MARKUPS)

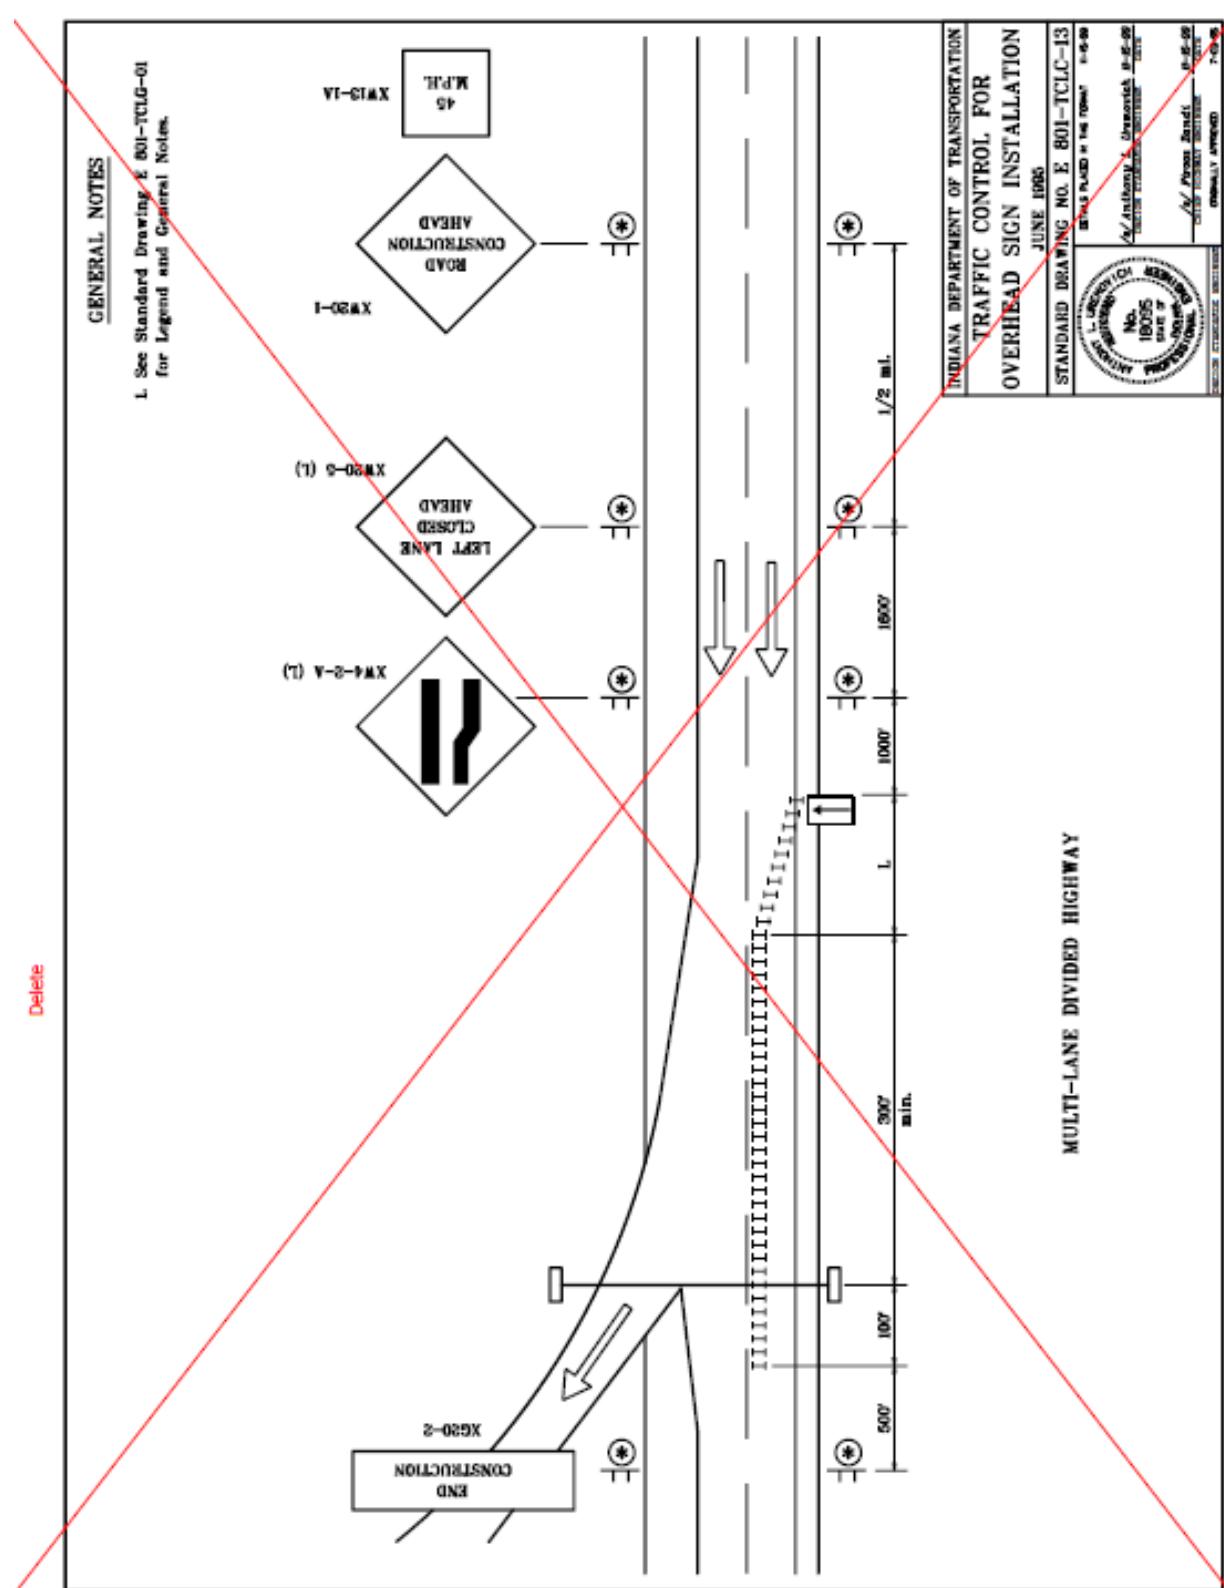




## REVISION TO STANDARD DRAWINGS

## E 801-TCLC-14 TRAFFIC CONTROL FOR OVERHEAD SIGN INSTALLATION (WITH MARKUPS)


GENERAL NOTES

1. See Standard Drawing E 801-TCLC-01 for Legend and General Notes.

2. Temporary traffic barrier shall be used for long-term stationary work. For short-term or intermediate-term stationary work the drum spacing shall be 20 ft.

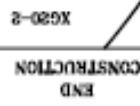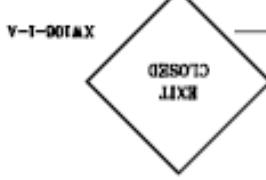
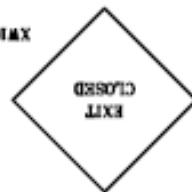


X620-2



















































































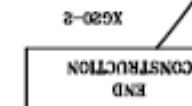


X620-2

37

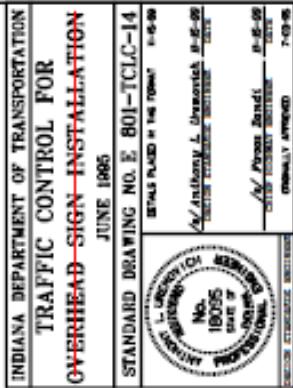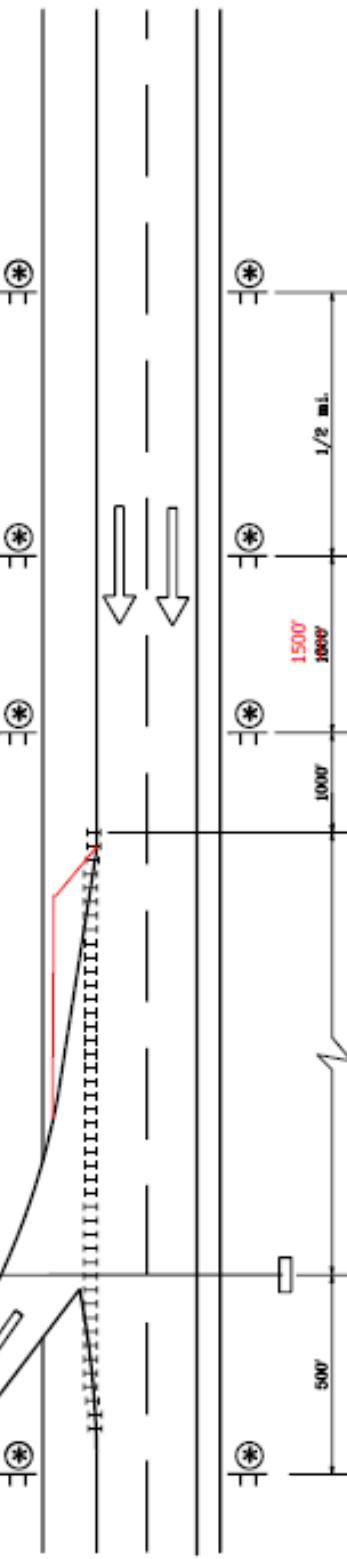

                                                                                  Freeway or Expressway Exit Closure  
MULTI-LANE DIVIDED HIGHWAY,  
LONG-TERM CLOSURE

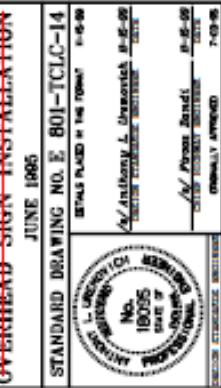


## REVISION TO STANDARD DRAWINGS

E 801-TCLC-15 TRAFFIC CONTROL FOR OVERHEAD SIGN INSTALLATION (WITH MARKUPS)

#### GENERAL NOTES

1. See Standard Drawing E 801-TCLG-01 for Legend and General Notes.
2. See General Note 2 on Standard Drawing E 801-TCLG-01.
3. See Standard Drawing E 801-TCDV-03 for L.

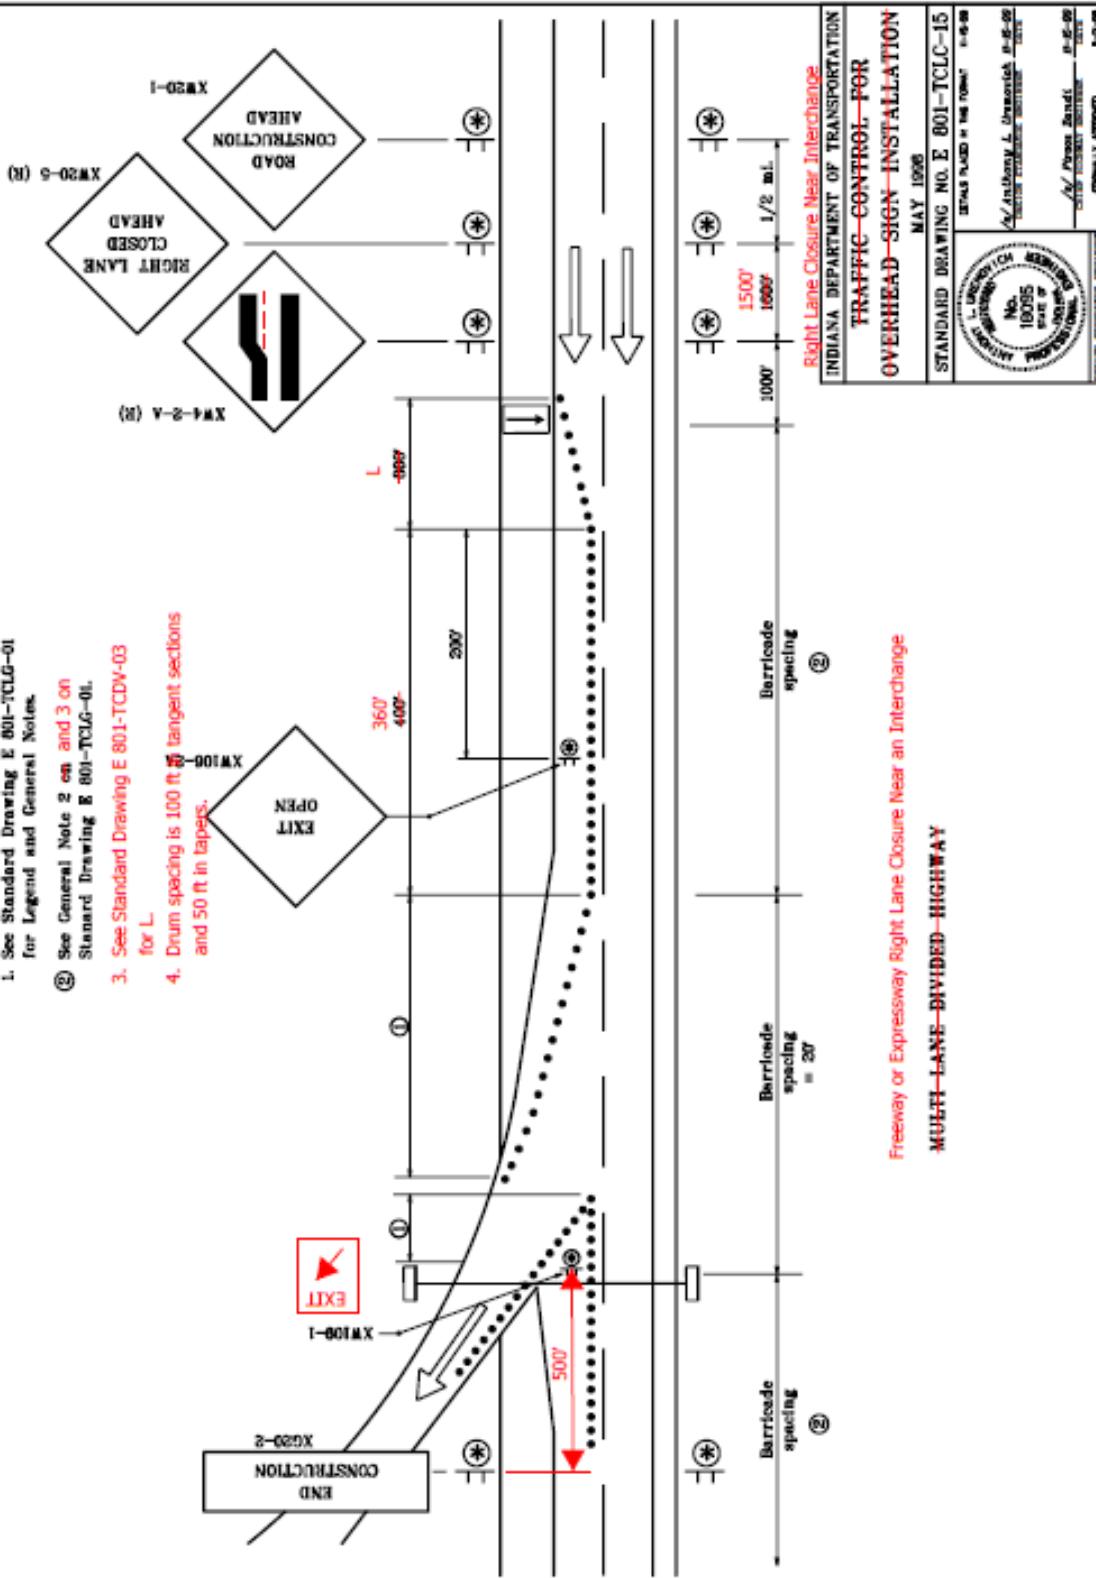

## REVISION TO STANDARD DRAWINGS


E 801-TCLC-16 TRAFFIC CONTROL FOR LANE CLOSURE (WITH MARKUPS)

Deutsche (approbated in 801-TDLC-02 and 05)

## GENERAL NOTES

1. See Standard Drawing E 801-TCD-01 for Legend and General Notes.


② See Standard Drawing E 801-TCDV-03 for values of  $L$ .

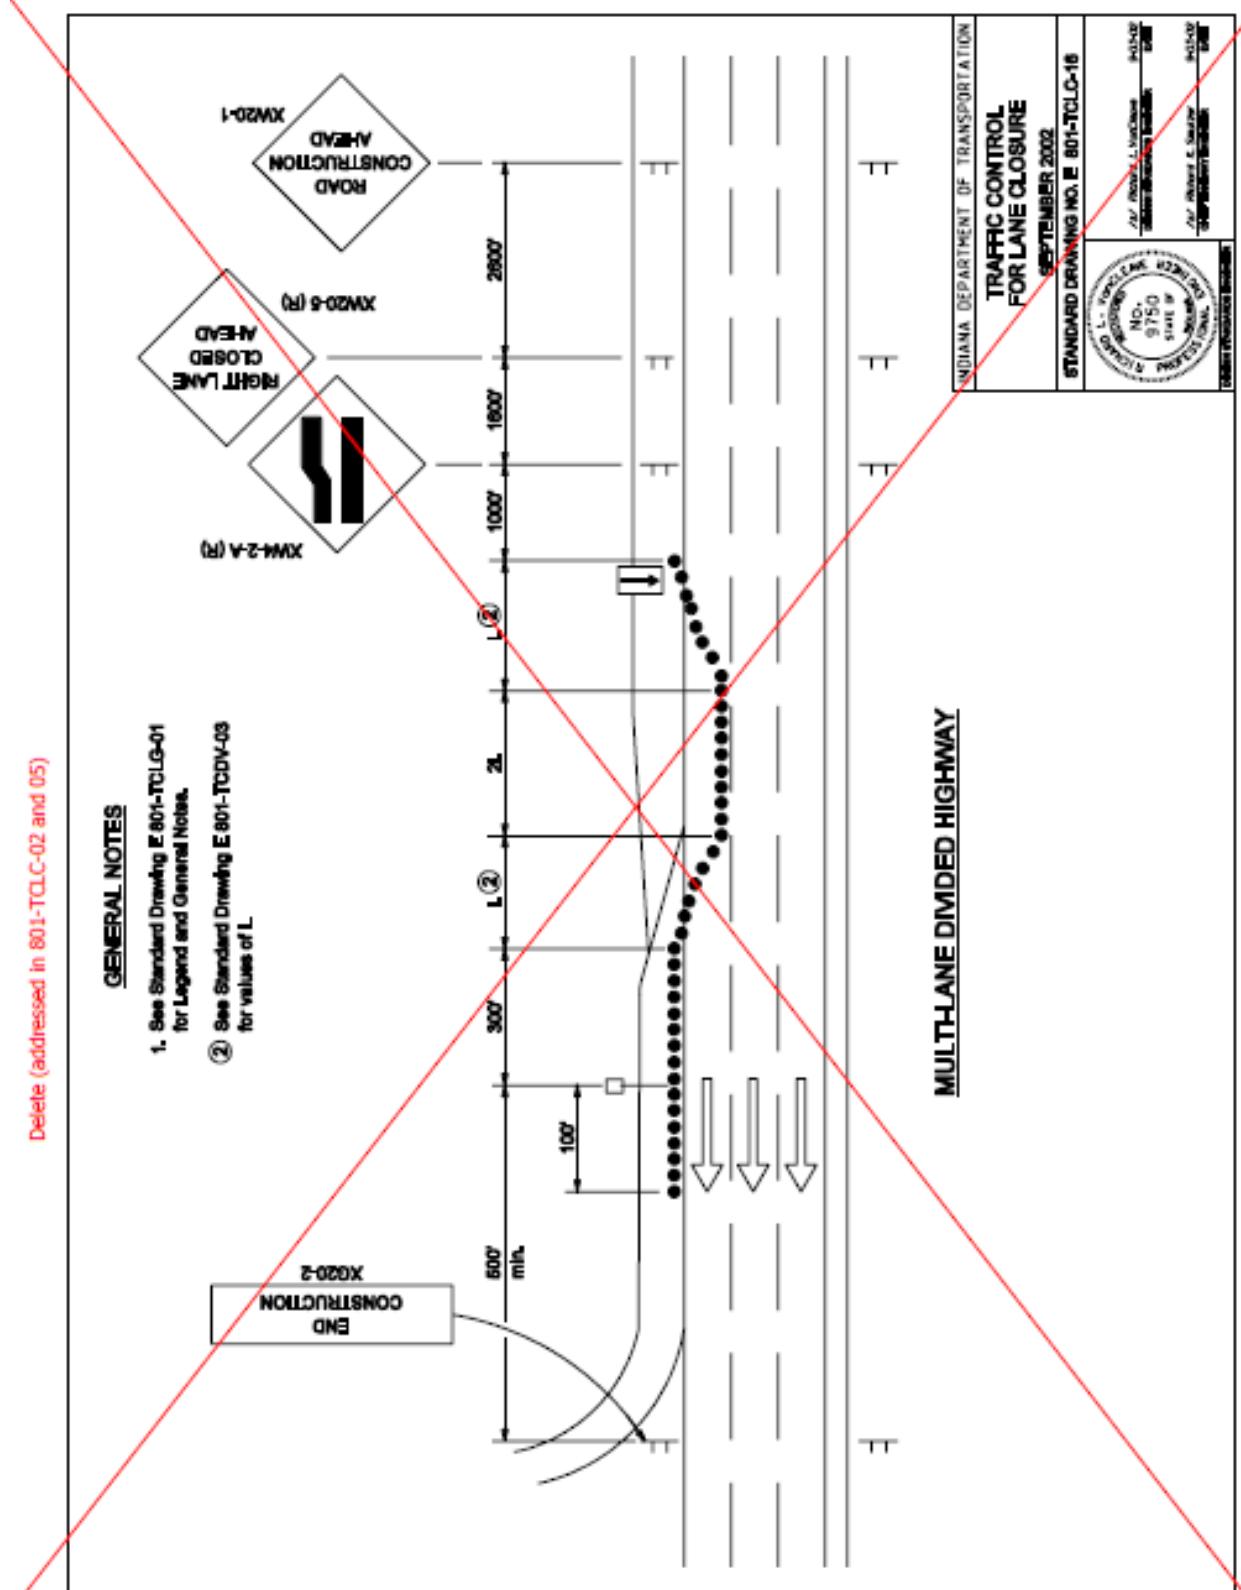

## REVISION TO STANDARD DRAWINGS


## E 801-TCLC-17 TEMPORARY U-TURN FOR CONTRACTOR'S VEHICLES (WITH MARKUPS)

DELETE DRAWING

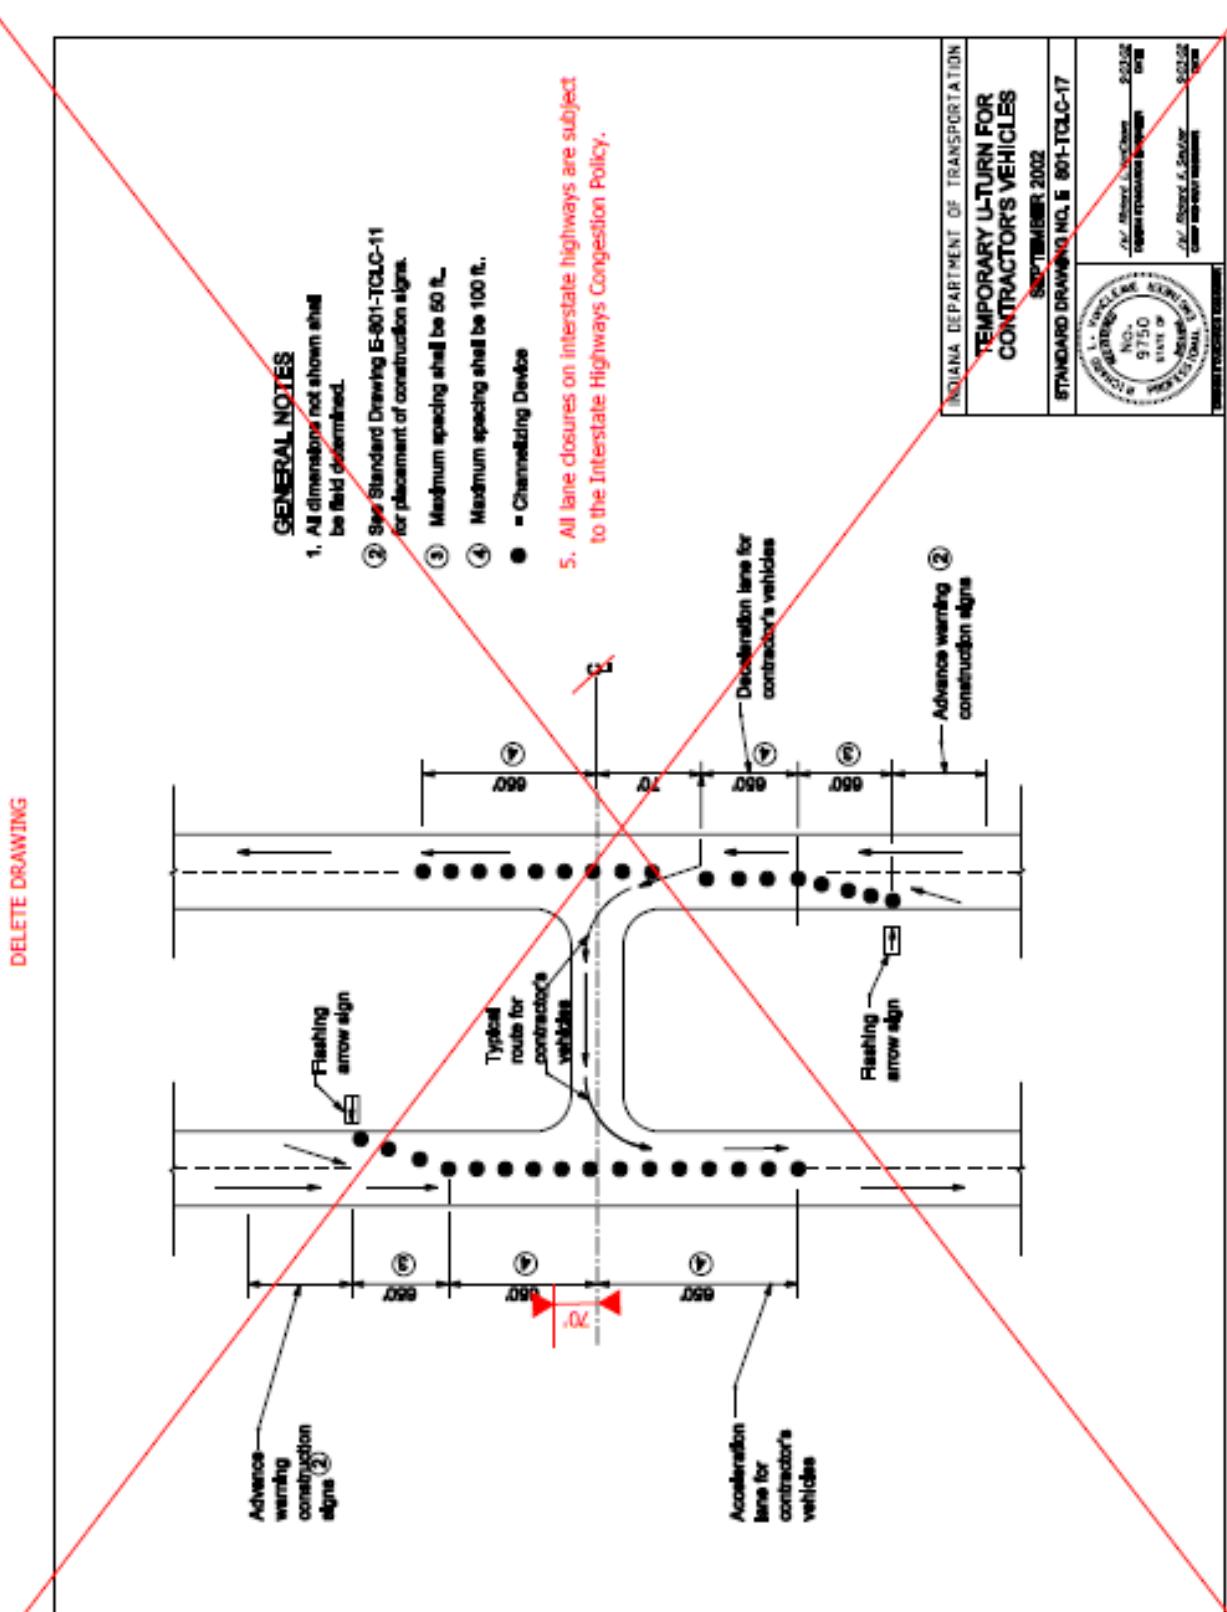


## REVISION TO STANDARD DRAWINGS

## E 801-TCSC-01 TRAFFIC CONTROL SHOULDER CLOSURE (WITH MARKUPS)

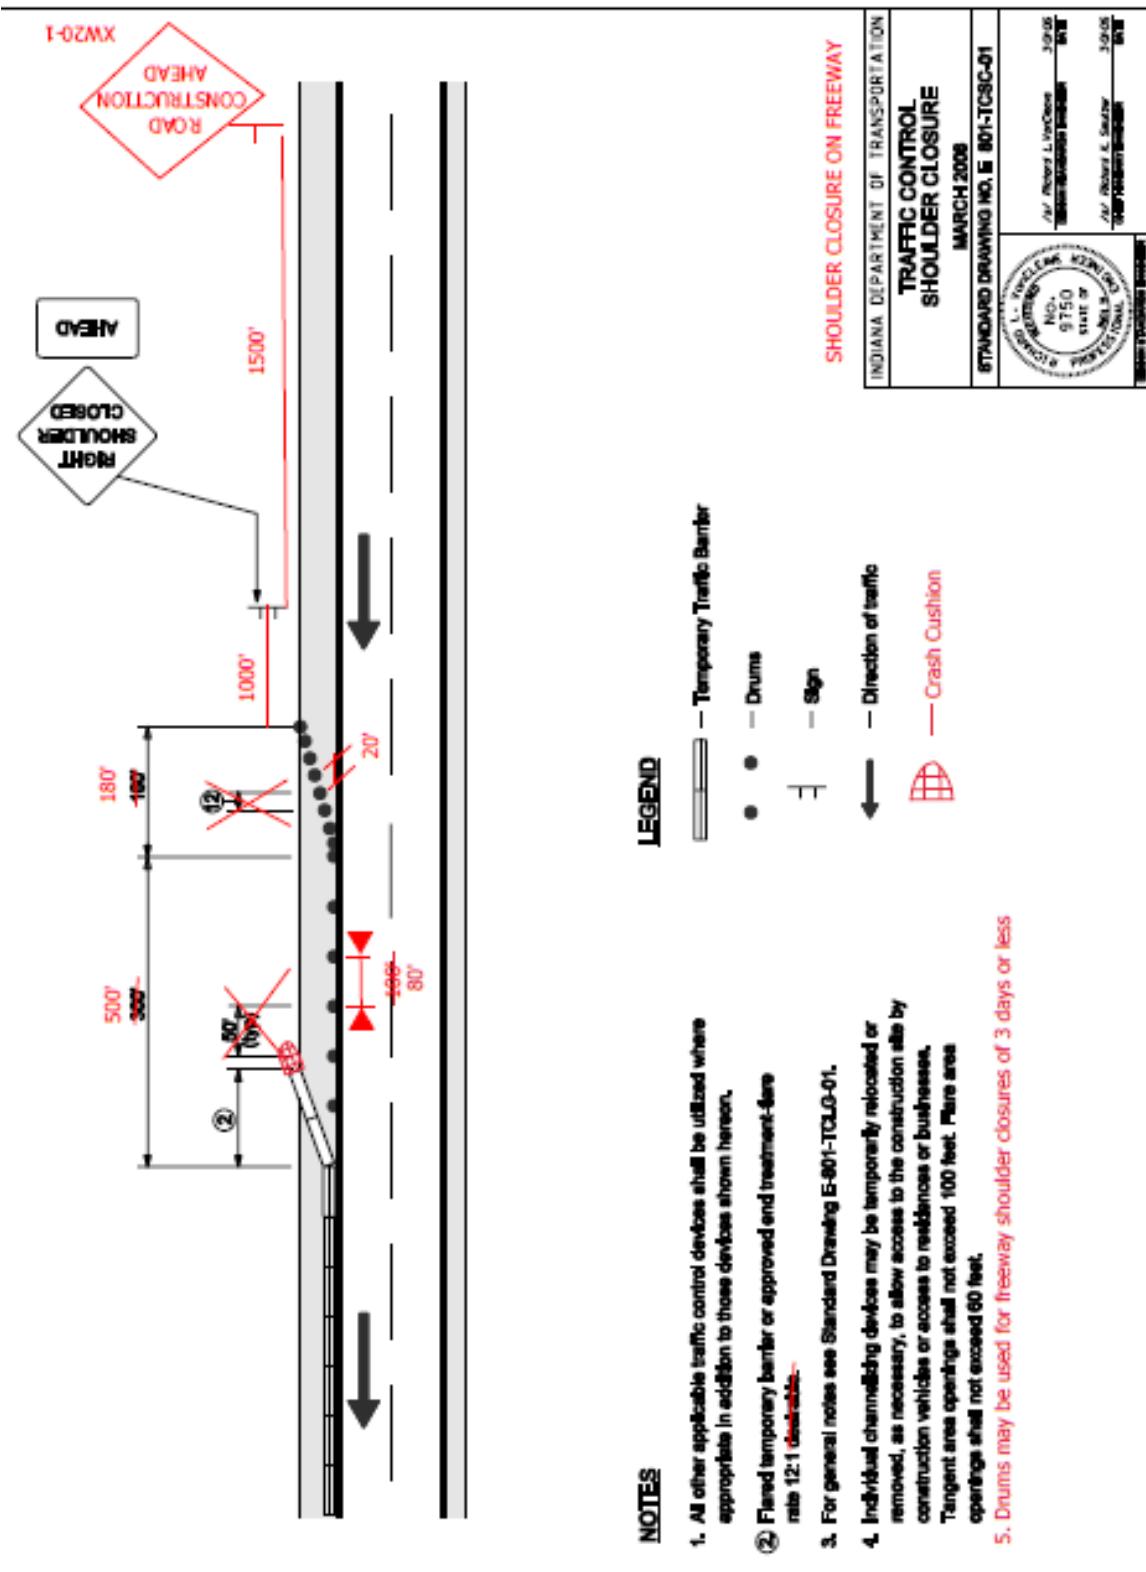


## REVISION TO STANDARD DRAWINGS

E 801-TCSC-02 TRAFFIC CONTROL SHOULDER CLOSURE LOCAL ACCESS (WITH MARKUPS)

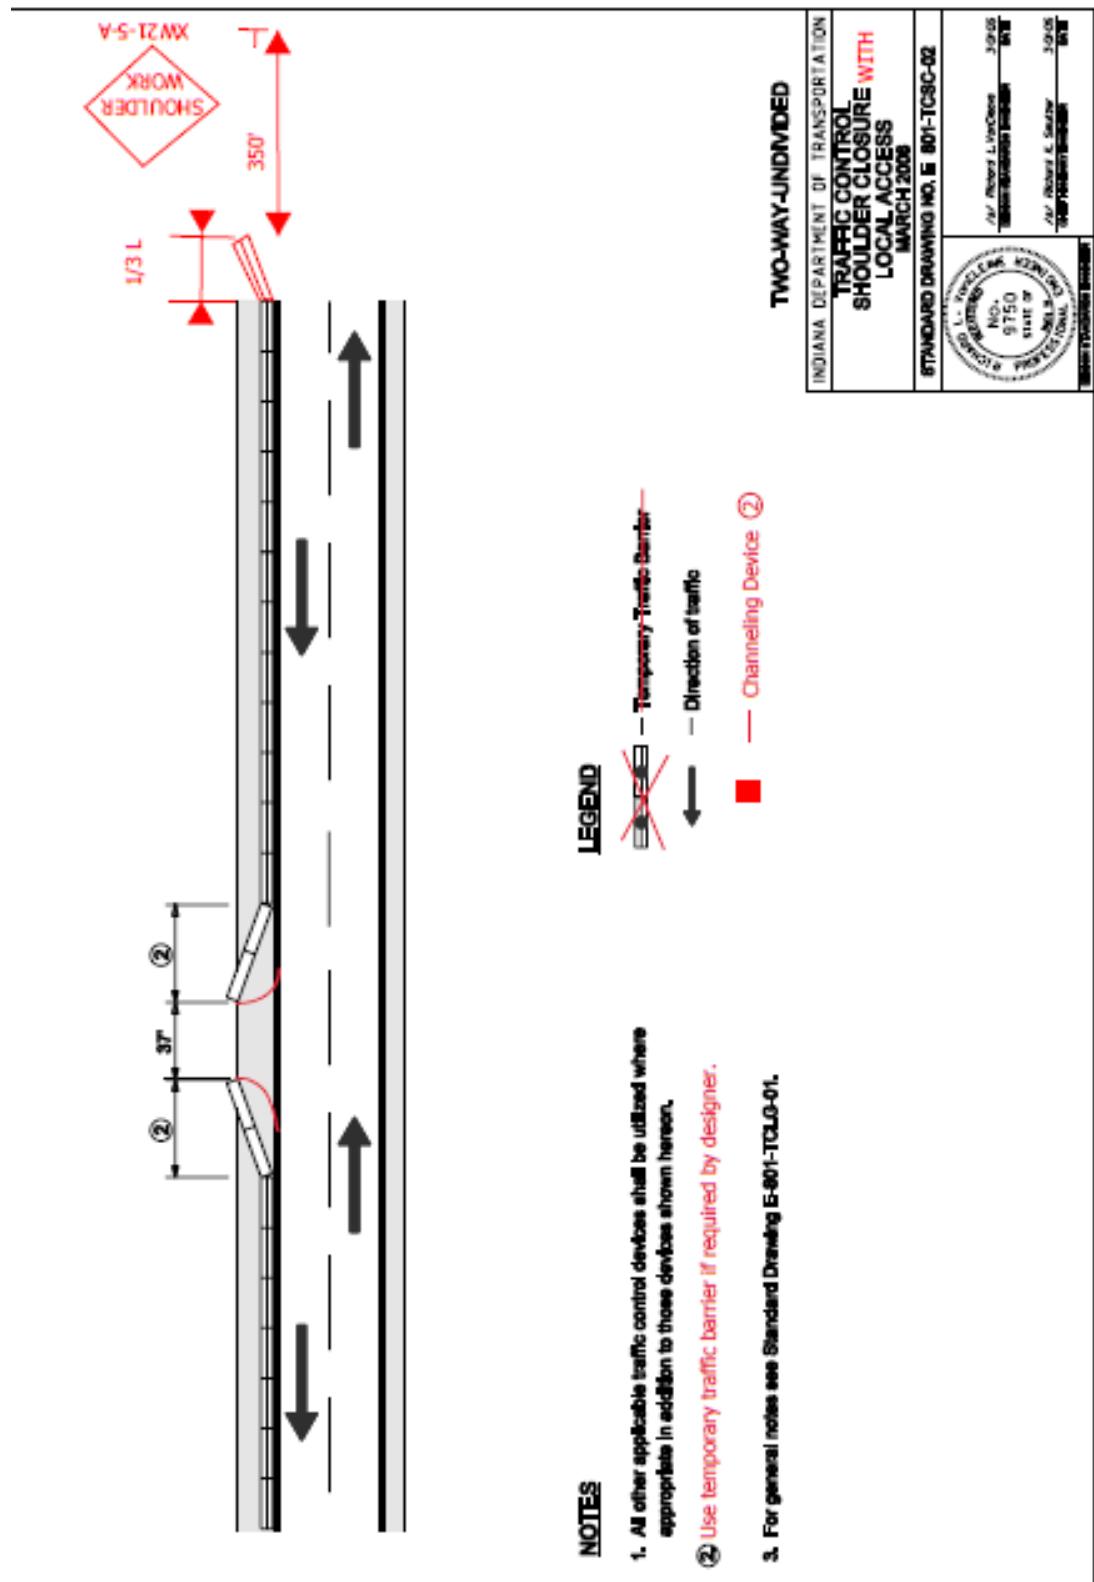

## REVISION TO STANDARD DRAWINGS

## E 801-TCSC-03 TRAFFIC CONTROL SHOULDER CLOSURE LOCAL ACCESS (WITH MARKUPS)

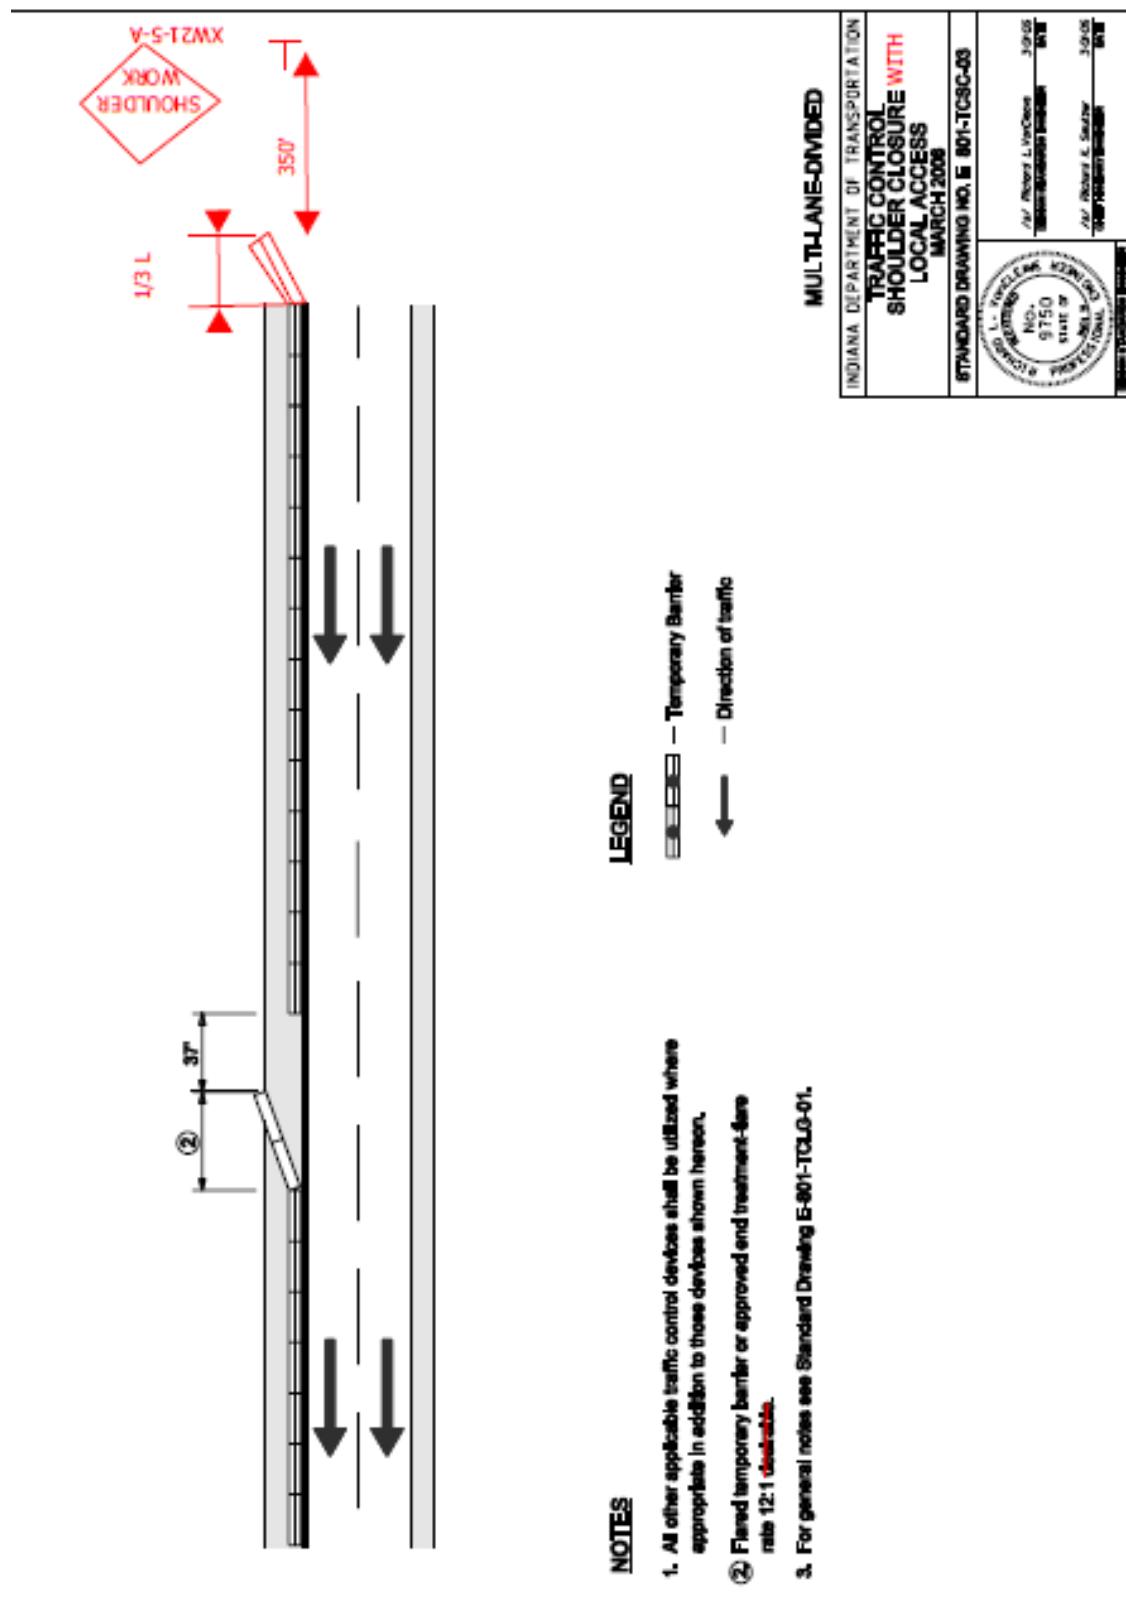


## REVISION TO STANDARD DRAWINGS


## E 801-TCTC-01 TEMPORARY CLOSURES (WITH MARKUPS)


## GENERAL NOTES


1. See Standard Drawing E 801-TCL0-01 for General Notes and Legend.
2. Use Type III barricades to ROW or point where no longer traversable.
3. See Standard Drawing E 801-TCDv04 for Type III barricade and road closure sign assemble detail.

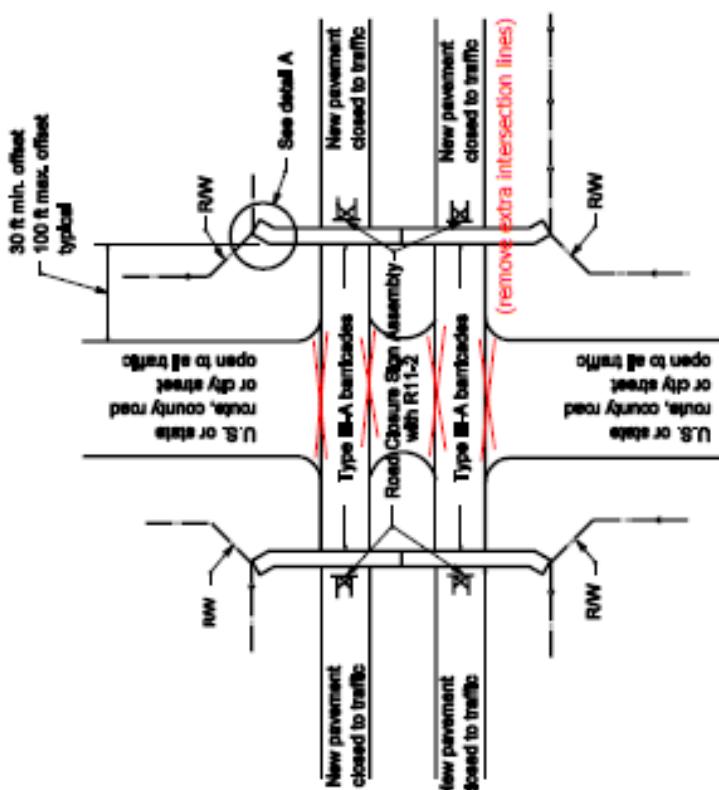

**TEMPORARY CLOSURE OF BOTH ~~NEW~~ SIDES OF A DIVIDED HIGHWAY**  
~~LINES OF PAVEMENT OF~~  
~~A DUAL LANE FACILITY~~

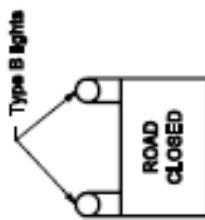

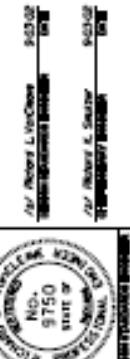INDIANA DEPARTMENT OF TRANSPORTATION	
<b>TEMPORARY CLOSURES</b>	
SEPTEMBER 2002	
STANDARD DRAWING NO. E 801-TCTC-01	
	
1. L. K. KIRKLAND, Director 2. Robert L. Vachon, Director 3. Michael E. Shaffer, Director 4. Robert E. Shaffer, Director 5. Robert E. Shaffer, Director 6. Robert E. Shaffer, Director	

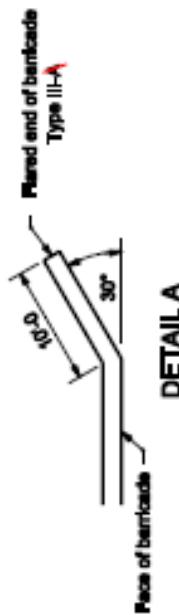


## REVISION TO STANDARD DRAWINGS


E 801-TCTC-02 TEMPORARY CLOSURES (WITH MARKUPS)

## GENERAL NOTES

1. See Standard Drawing E 801-TCL0-01 for General Notes and Legend.

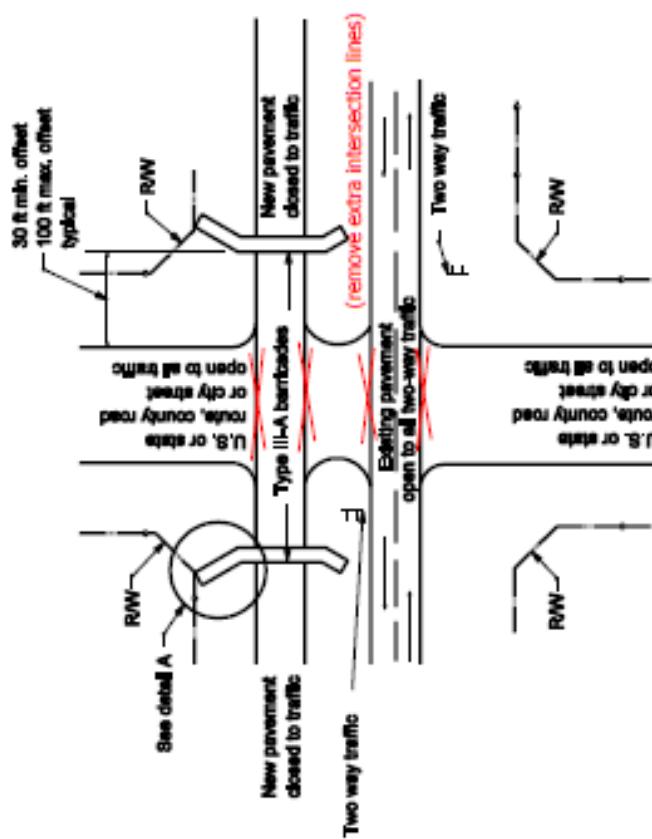

**TEMPORARY CLOSURE OF ONE NEW  
-LANE OF PAVEMENT OF A DUAL-  
-LANE Facility**

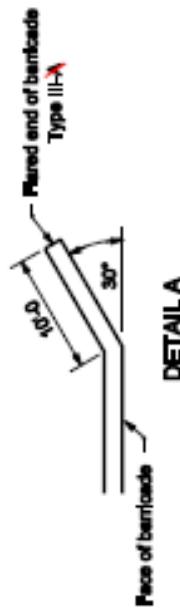

INDIANA DEPARTMENT OF TRANSPORTATION  
**TEMPORARY CLOSURES**  
SEPTEMBER 2002  
STANDARD DRAWING NO. E-801-TCTC-02

INDIANA STATE HIGHWAY  
Div. of Highways  
100 North Meridian Street  
Indianapolis, Indiana 46204-3737  
Telephone (317) 232-3600  
FAX (317) 232-3602  
E-mail: [INDOT.DOT@STATE.IN.US](mailto:INDOT.DOT@STATE.IN.US)

## REVISION TO STANDARD DRAWINGS


## E 801-TCTC-03 TEMPORARY CLOSURES (WITH MARKUPS)

## GENERAL NOTES

1. See Standard Drawing E 801-TCTC-01 for General Notes and Legend.

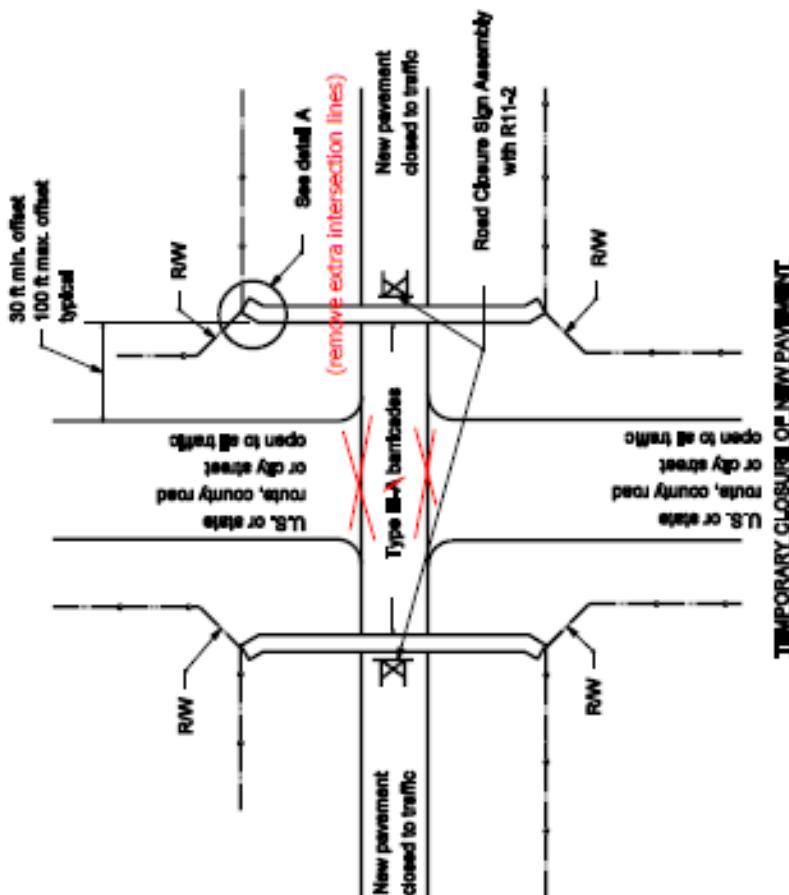

INDIANA DEPARTMENT OF TRANSPORTATION	
<b>TEMPORARY CLOSURES</b>	
SEPTEMBER 2002	
STANDARD DRAWING NO. E 801-TCTC-03	
	
Rev. 10/2002 Drawing J. VanCleave Supervising Engineer Date Issued: 2/20/03	Rev. 10/2002 Drawing J. VanCleave Supervising Engineer Date Issued: 2/20/03

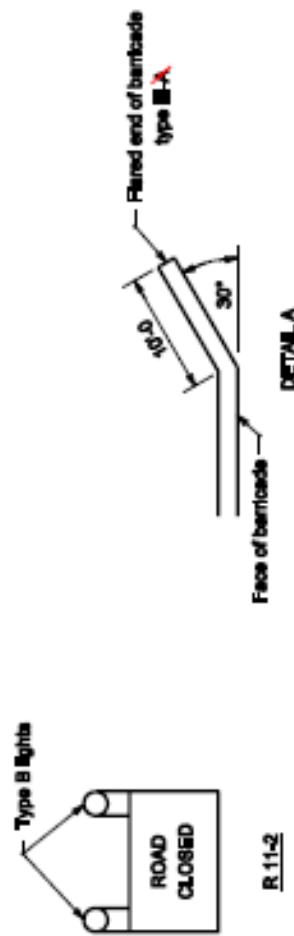





## REVISION TO STANDARD DRAWINGS

E 801-TCTC-05 TRAFFIC CONTROL FOR DAYTIME LANE CLOSURE (WITH MARKUPS)


Delete (Addressed in 801-TCFO Series)

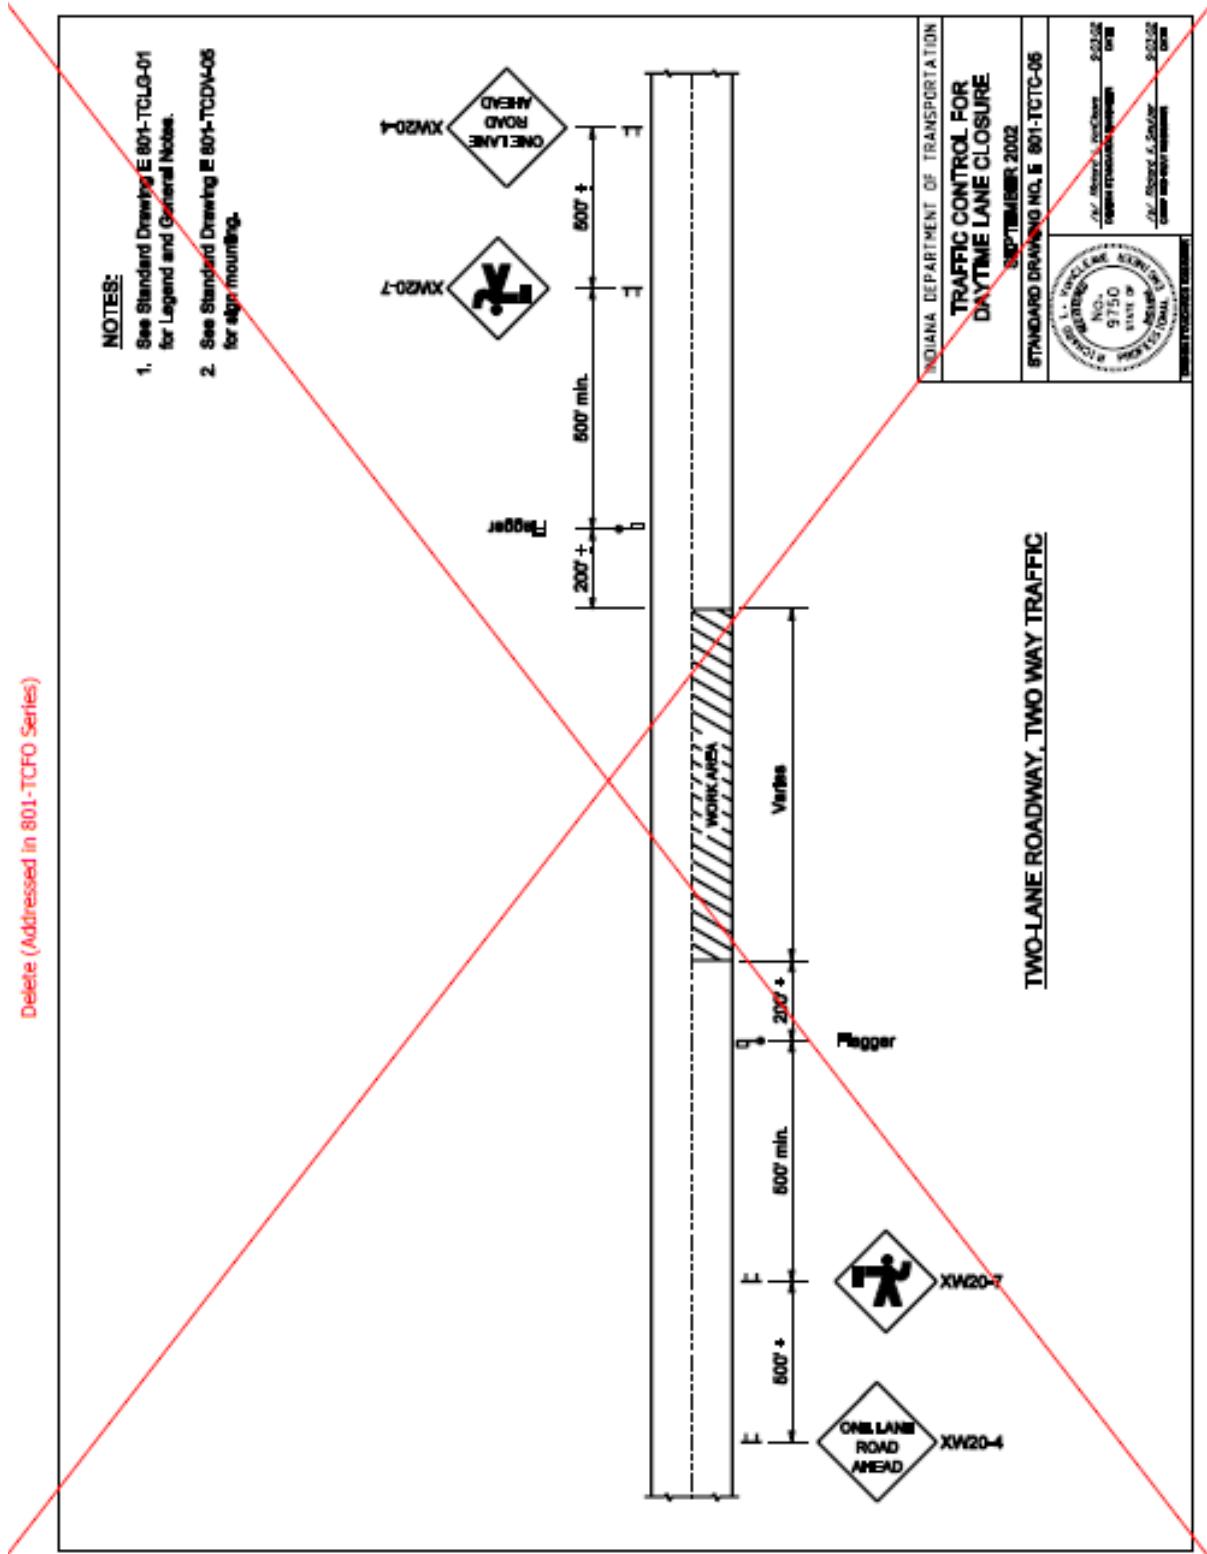

## REVISION TO STANDARD DRAWINGS

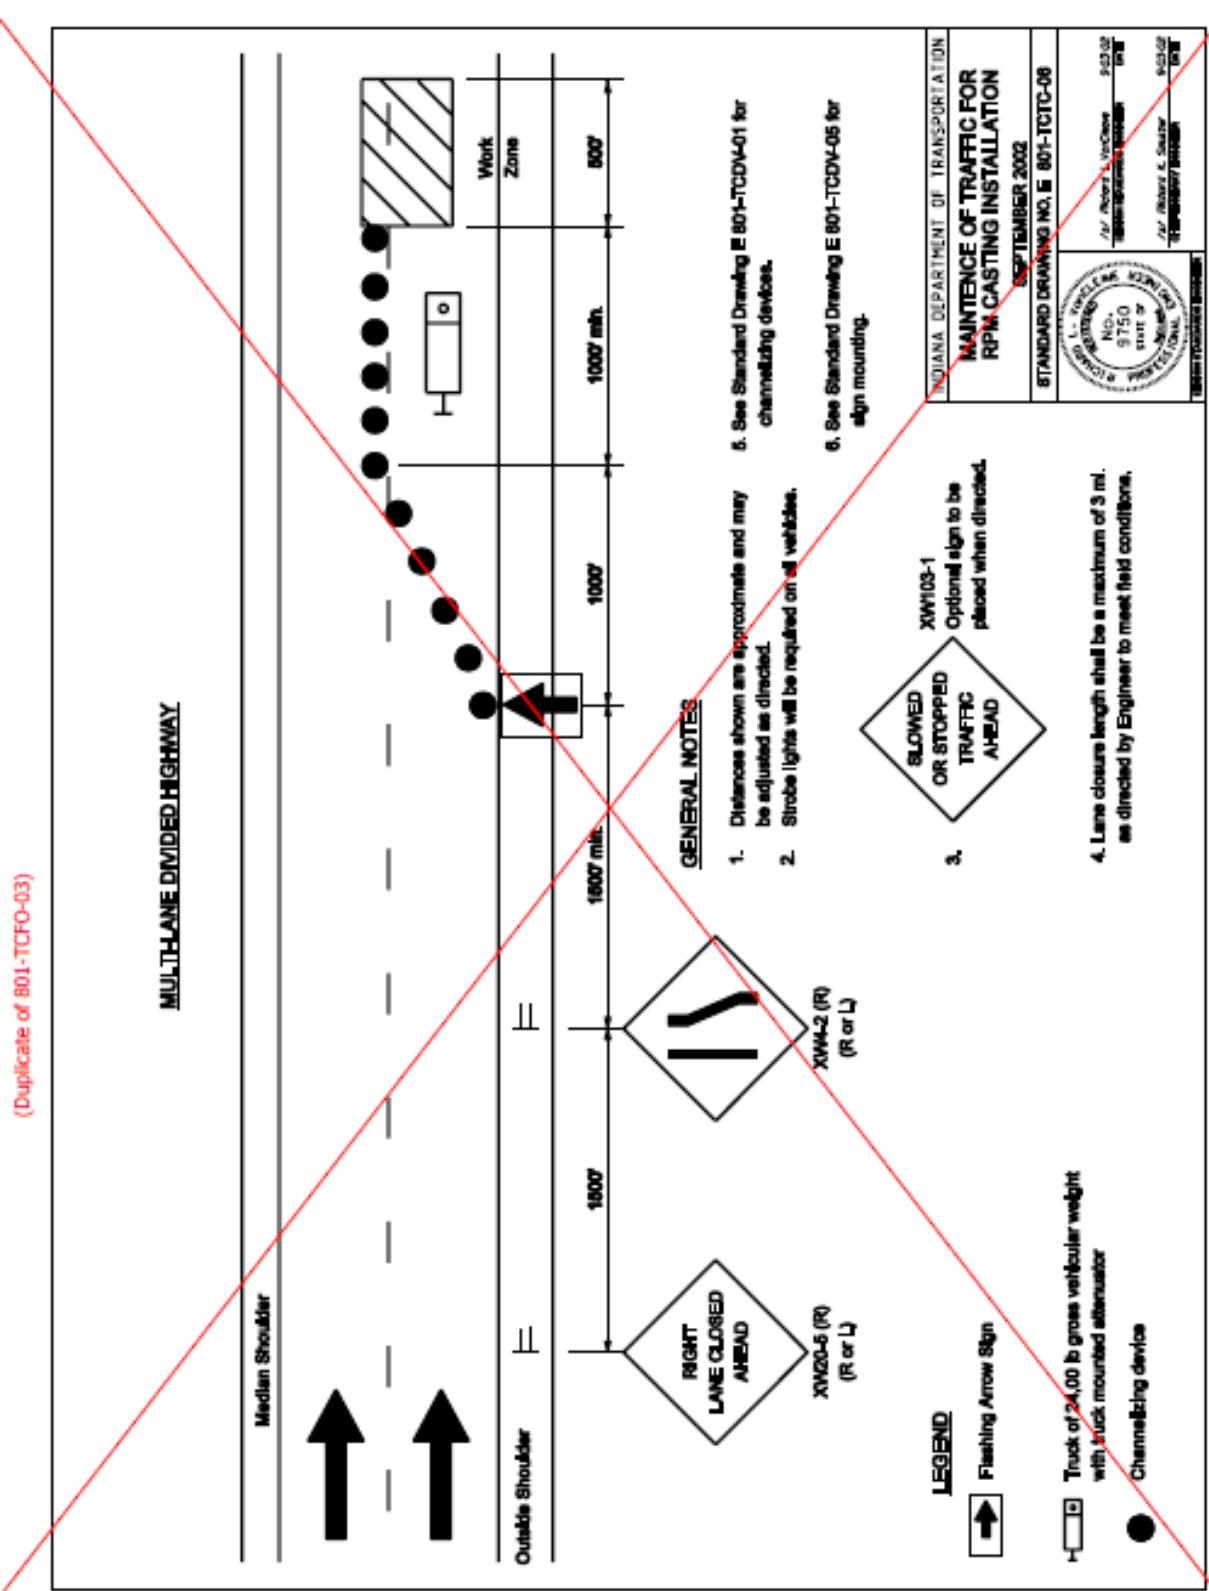
E 801-TCTC-06 MAINTENANCE OF TRAFFIC CONTROL FOR RPM CASTING INSTALLATION  
CLOSURE (WITH MARKUPS)

## REVISION TO STANDARD DRAWINGS

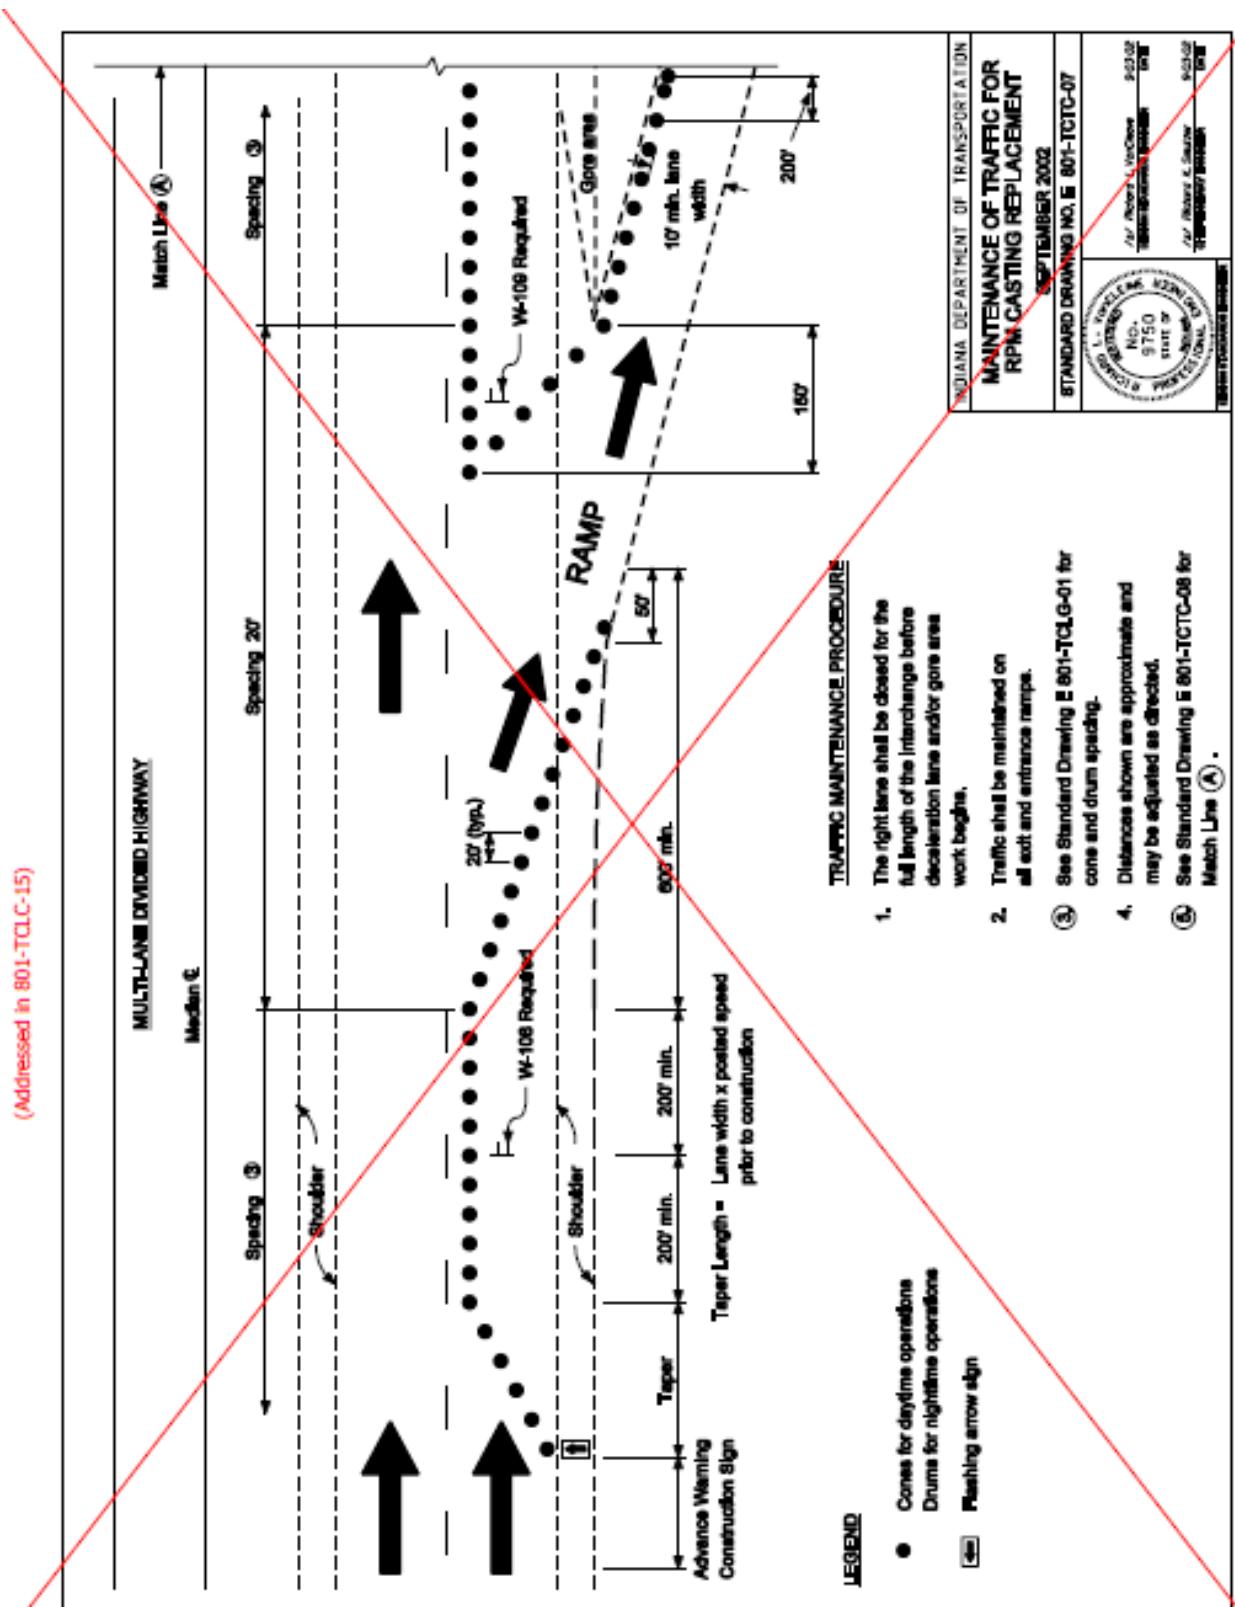E 801-TCTC-07 MAINTENANCE OF TRAFFIC CONTROL FOR RPM CASTING  
REPLACEMENT (WITH MARKUPS)

## REVISION TO STANDARD DRAWINGS


E 801-TCTC-08 MAINTAINCE OF TRAFFIC CONTROL FOR RPM CASTING REPLACEMENT  
(WITH MARKUPS)

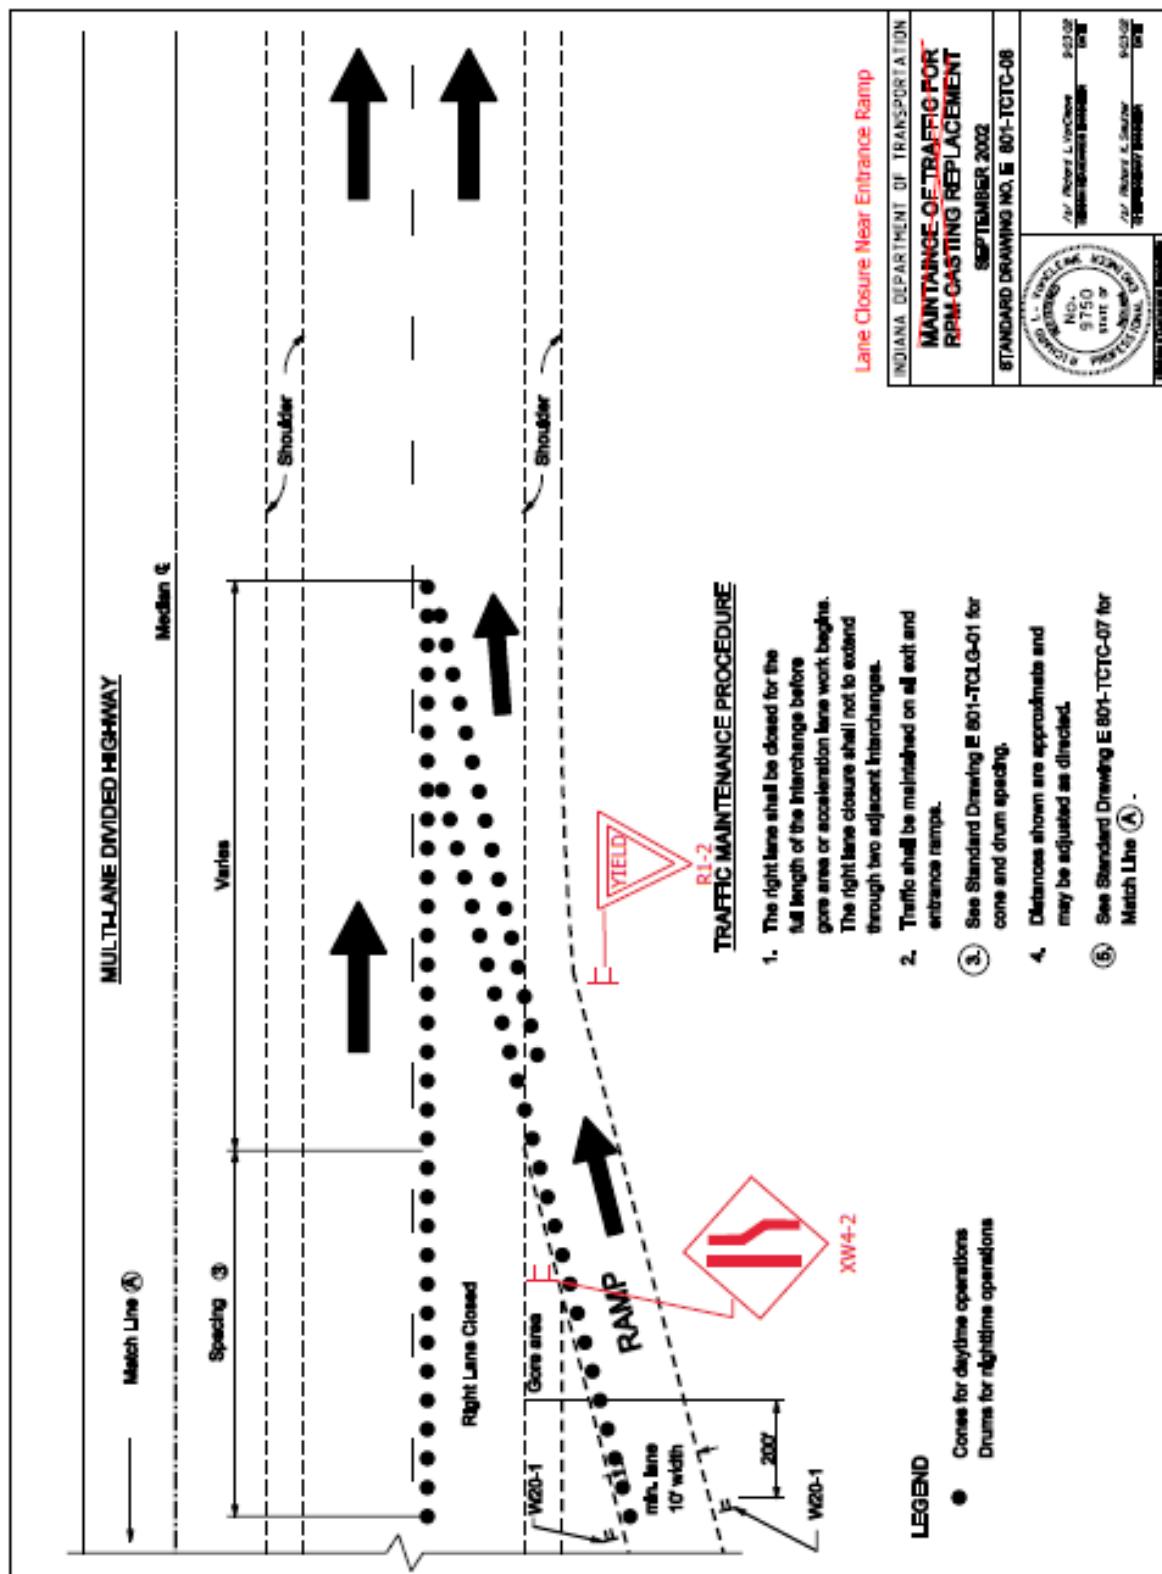

## REVISION TO STANDARD DRAWINGS


E 801-TCTC-09 MAINTENANCE OF TRAFFIC FOR RPM REFLECTOR REPLACEMENT  
(WITH MARKUPS)

## Move to New Series on Traffic Control for Mobile Operations

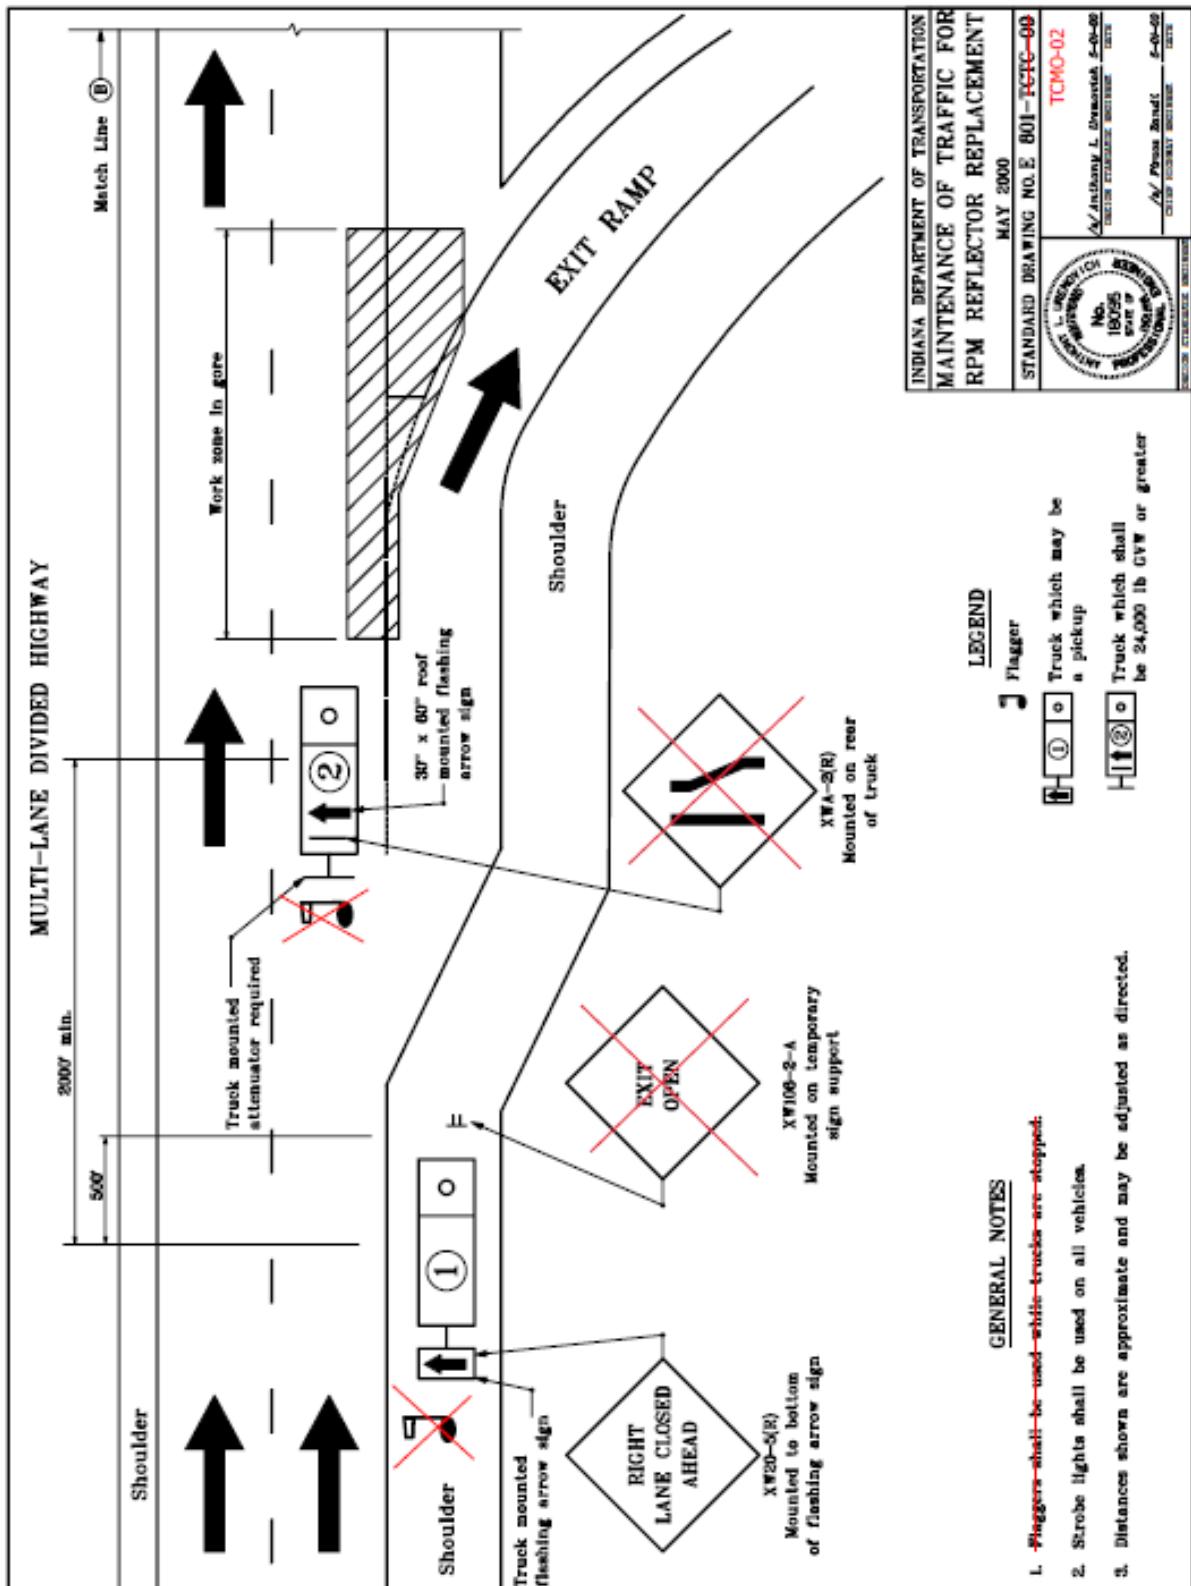

## REVISION TO STANDARD DRAWINGS

E 801-TCTC-10 MAINTENANCE OF TRAFFIC FOR RPM REFLECTOR REPLACEMENT  
(WITH MARKUPS)

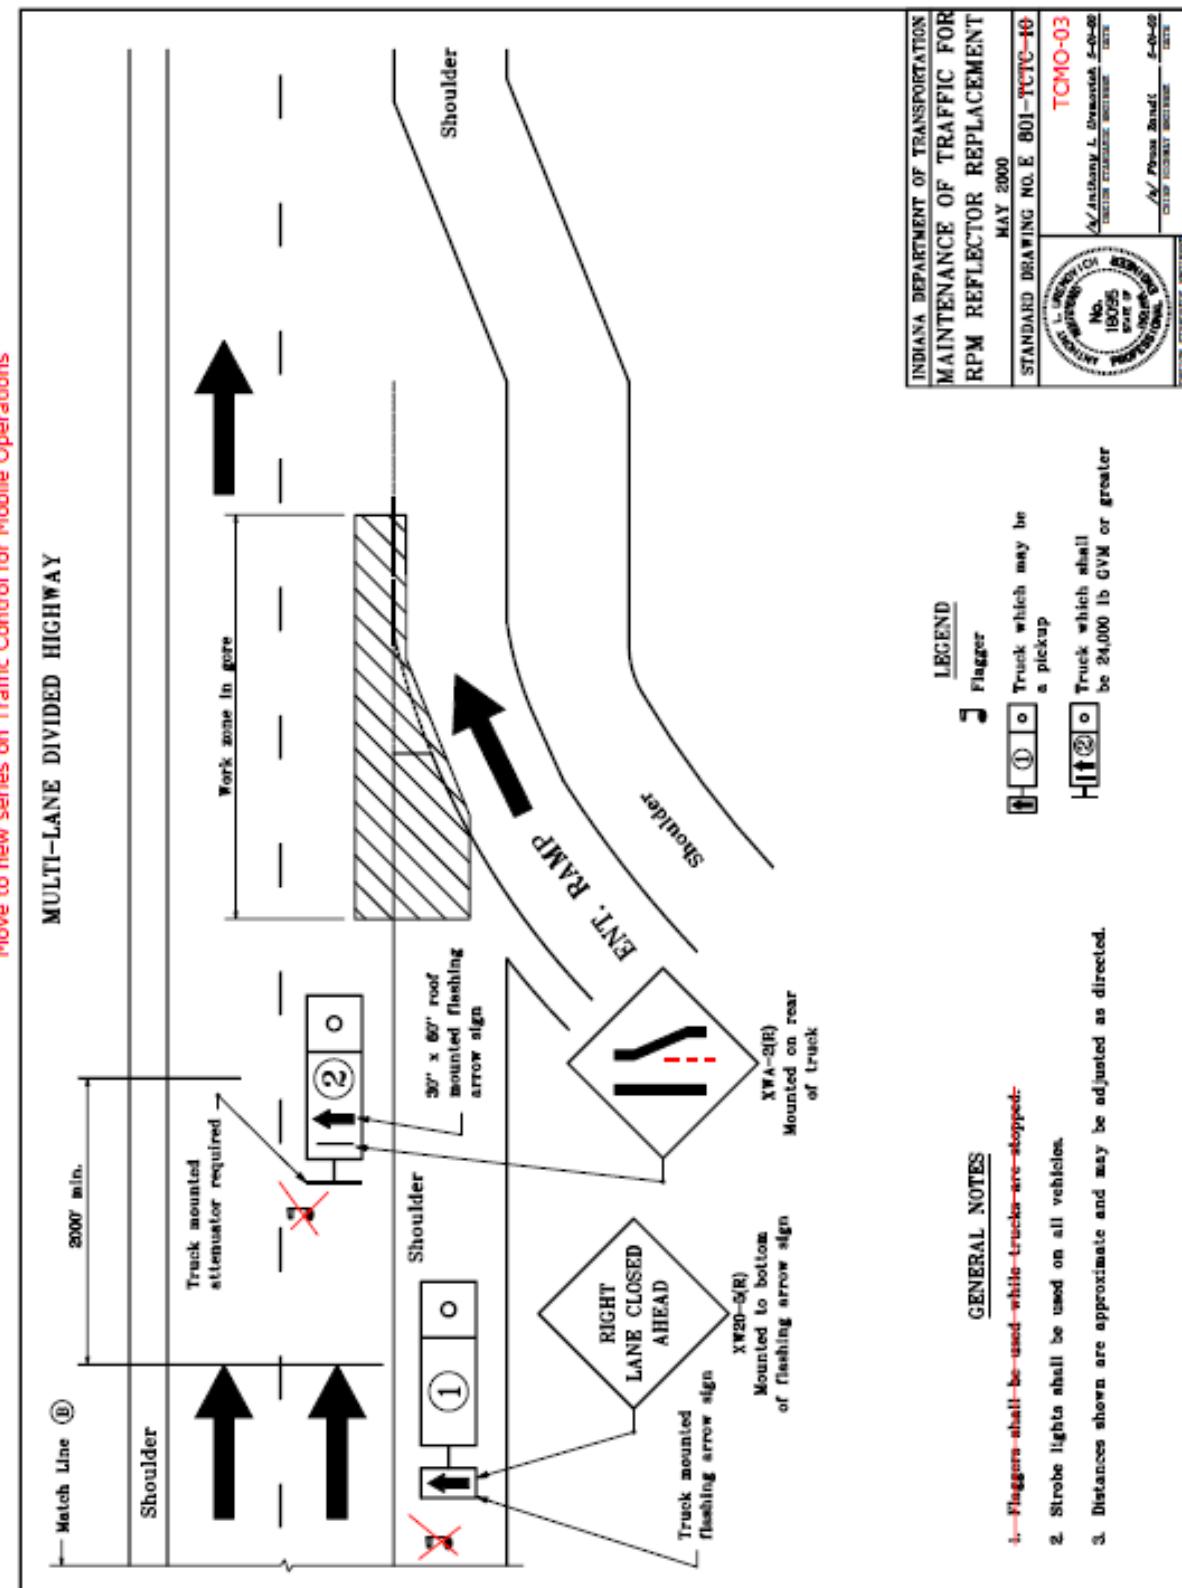

## REVISION TO STANDARD DRAWINGS

## E 801-TCTC-11 TUBULAR MARKER DELINEATION (WITH MARKUPS)



Move to TCCO Series

**GENERAL NOTES:**

1. Signing pattern typical both sides of roadway, for each direction of travel.
2. See Standard Drawing E 801-TCTC-01 for tubular marker details.



**LEGEND**

- ① RA-1-B "Do Not Pass"
- ② XMR-3 two-way traffic symbol
- Tubular markers

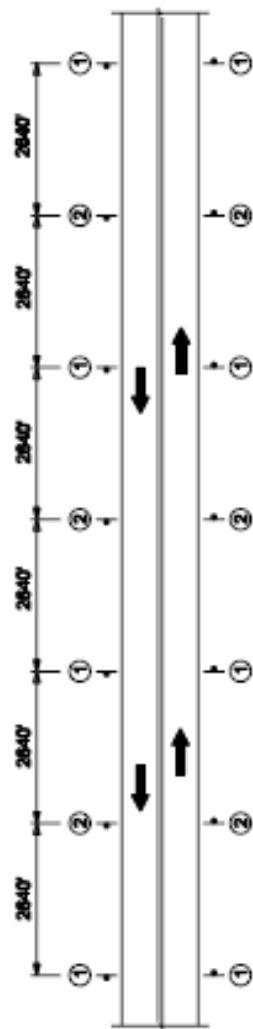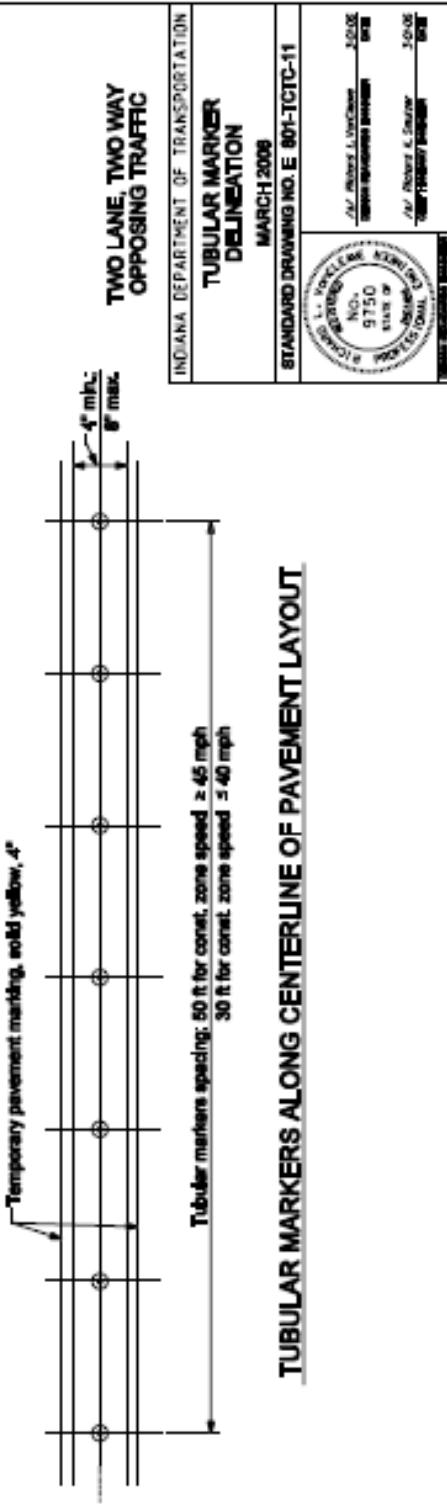**CONSTRUCTION SIGNS LOCATION DETAIL**

## REVISION TO STANDARD DRAWINGS

## E 801-TCTC-12 TUBULAR MARKER DELINEATION AT INTERSECTION (WITH MARKUPS)
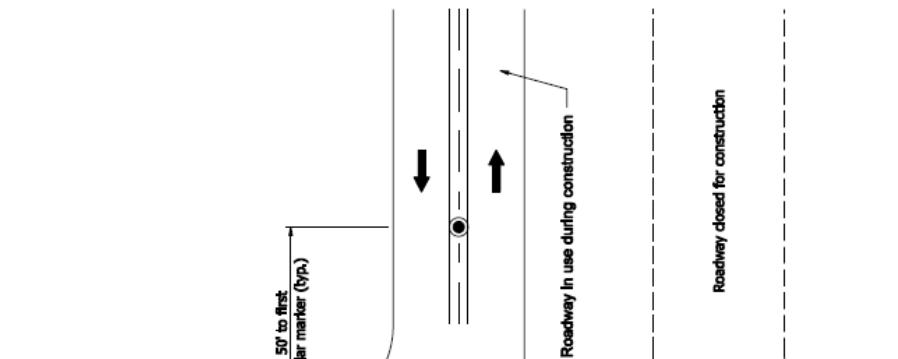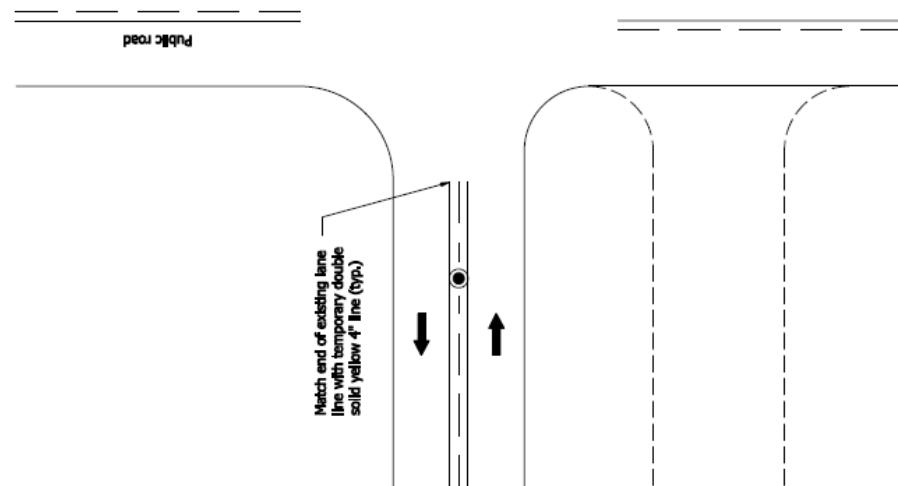
<p><b>GENERAL NOTES:</b></p> <p>1. See Standard Drawing E 801-TCTC-01 for tubular marker details.</p> <p><b>LEGEND</b></p> <p>● Tubular markers</p>		<p>INDIANA DEPARTMENT OF TRANSPORTATION TUBULAR MARKER DELINEATION AT INTERSECTION</p> <p>SEPTEMBER 2007</p> <p>STANDARD DRAWING NO. E 801-TCTC-12</p> <p>    <i>/s/ Richard L. Van Cleve</i>      09/04/07          DESIGN STANDARDS ENGINEER      DATE    <i>/s/ Mark A. Miller</i>      09/04/07          CHIEF HIGHWAY ENGINEER      DATE          DESIGN STANDARDS ENGINEER       </p>	
			
			

Move to TCCO Series

## REVISION TO STANDARD DRAWINGS

E 801-TCTS-01 TEMPORARY SHOULDER FOR TRAFFIC MAINTENANCE

**GENERAL NOTES:**

**①** Shoulder cross slope in superelevated section shall be as follows:

Where the high side is on the outside of the curve:

4% ↗ for horizontal curve radius  $R \geq 3820$  ft


2% ↗ for  $2870 \text{ ft} \leq R \leq 3820$  ft

Where the high side of the superelevated pavement is on the median side of the curve; maintain adjacent travel lane's superelevation transition rate or superelevation rate.

The low side of a superelevated pavement shall maintain the adjacent travel lane's superelevation transition rate or superelevation rate.

② See Standard Drawing 801-TCDV-01 for channelling details.

## Delete Drawing

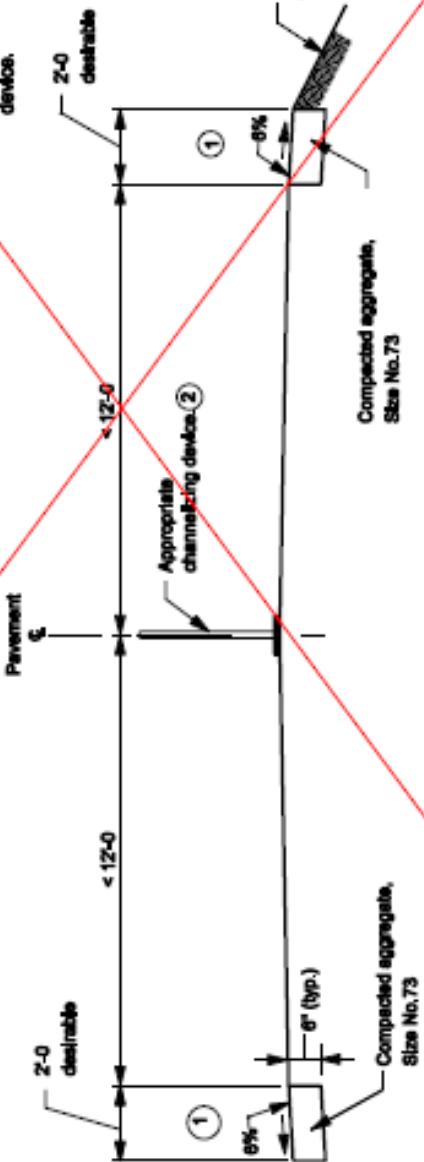

## REVISION TO STANDARD DRAWINGS

## E 801-TCCO-01 TEMPORARY CROSSOVERS INDEX AND GENERAL NOTES (DRAFT)

GENERAL NOTES:

1. See Standard Drawings E 801-TCDV-04 thru -07 for barricade and construction sign mounting information.
2. For channelization devices see Standard Drawing E 801-TCDV-02.
3. See Standard Drawing E 801-TCLG-01 for additional legend symbols, notes and (9) through (15).
4. A minimum 100 ft tangent section, at a 7° to 11° angle, shall be required between the curves on a Type A or Type B Crossover.

INDEX	
SHEET NO.	SUBJECT
1	Temporary Crossovers Index and General Notes
2	Temporary Crossovers Advanced Signing Details
3	Temporary Crossovers Entrance Detail
4	Temporary Crossovers Exit Detail
5	Split Crossover Entrance Detail
6	Split Crossover Exit Detail
7	Paving and Temporary Closure Layout, Type B Crossover
8	Typical Sections
9	Permanent Closure of a Temporary Crossover
10	Tubular Marker Use on a Nonfreeway Crossover


LEGEND

<input type="checkbox"/> 1	Temporary Pavement Marking, White, 4"
<input type="checkbox"/> 2	Temporary Pavement Marking, Yellow, 4"
<input type="checkbox"/> 3	Temporary Pavement Marking, White, 8"
<input type="checkbox"/> 4	Temporary Pavement Marking, Yellow, 8"
<input type="checkbox"/> 5	Line, Solid Yellow, 4", Remove
<input type="checkbox"/> 6	Line, Broken White, 5", Remove
<input type="checkbox"/> 7	Temporary Concrete Barrier - Freeways
	Channelizing Devices - Nonfreeway Multilane Divided Roadways

INDIANA DEPARTMENT OF TRANSPORTATION	TEMPORARY CROSSOVERS	DATE
	INDEX AND GENERAL NOTES	
	SEPTEMBER 2019	
STANDARD DRAWING NO.	E 801-TCCO-01	
DESIGN STANDARDS ENGINEER		
CHIEF ENGINEER		


## REVISION TO STANDARD DRAWINGS

## E 801-TCCO-02 TEMPORARY CROSSOVERS ADVANCED SIGNING DETAILS (DRAFT)

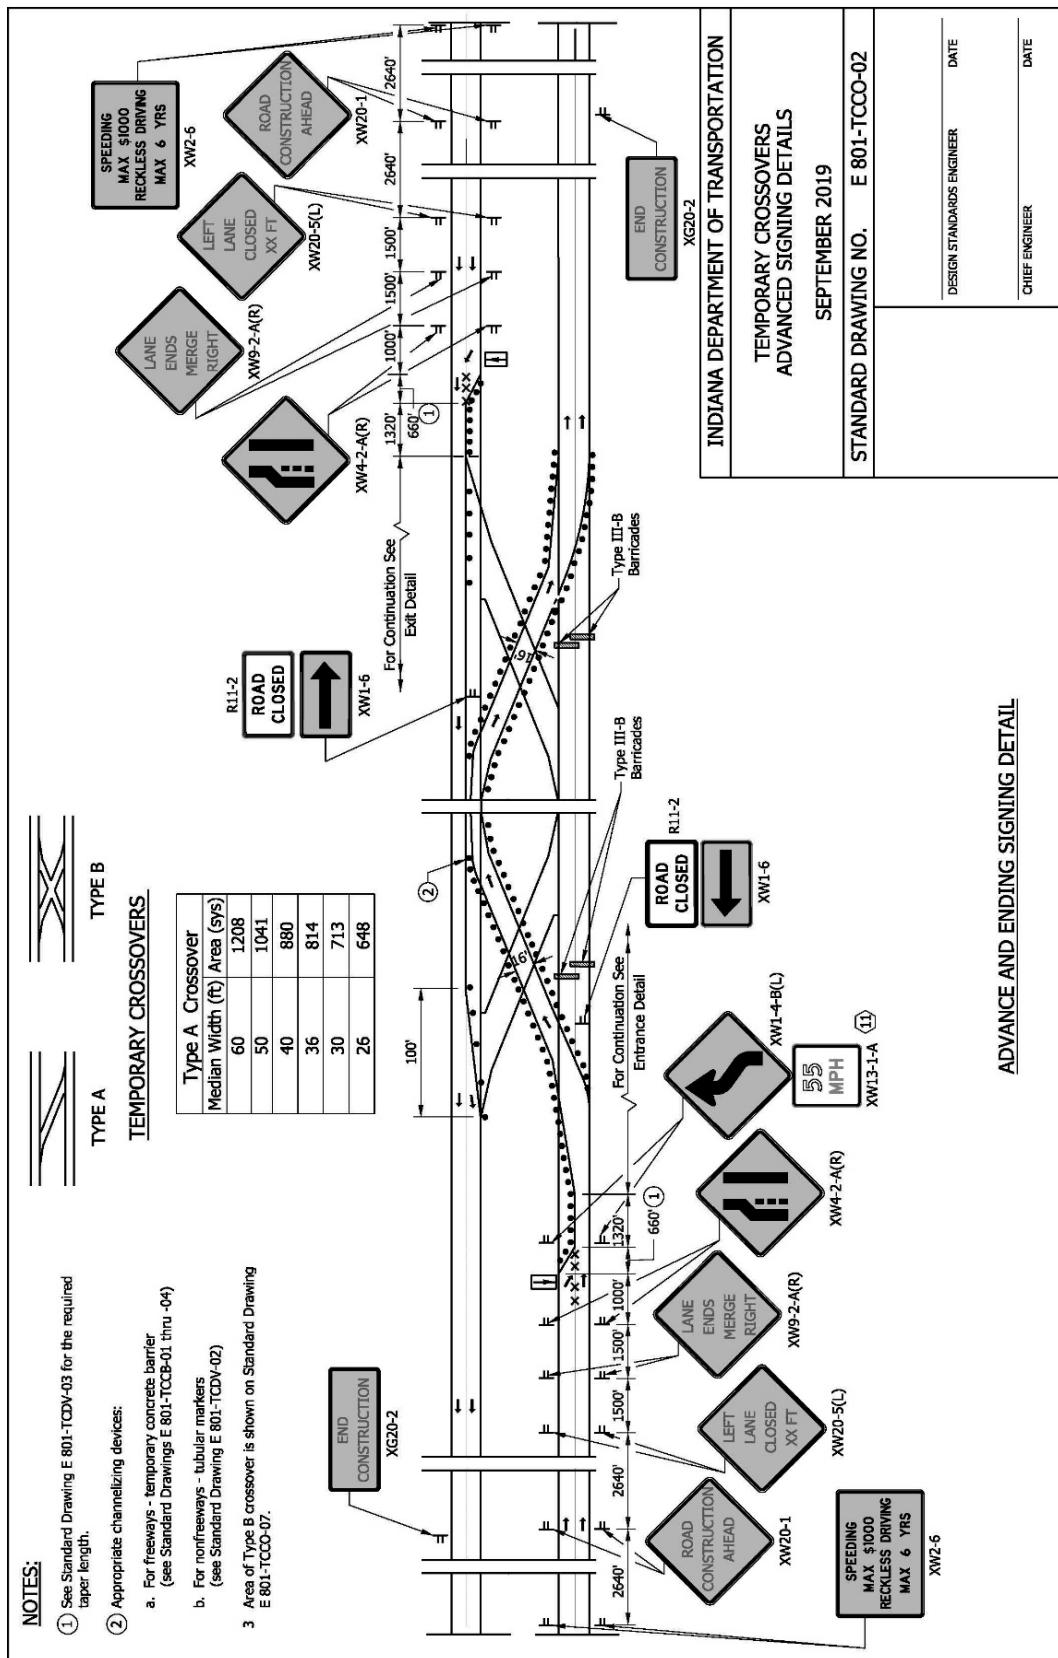

## REVISION TO STANDARD DRAWINGS

## E 801-TCCO-03 TEMPORARY CROSSOVERS ENTRANCE DETAIL (DRAFT)

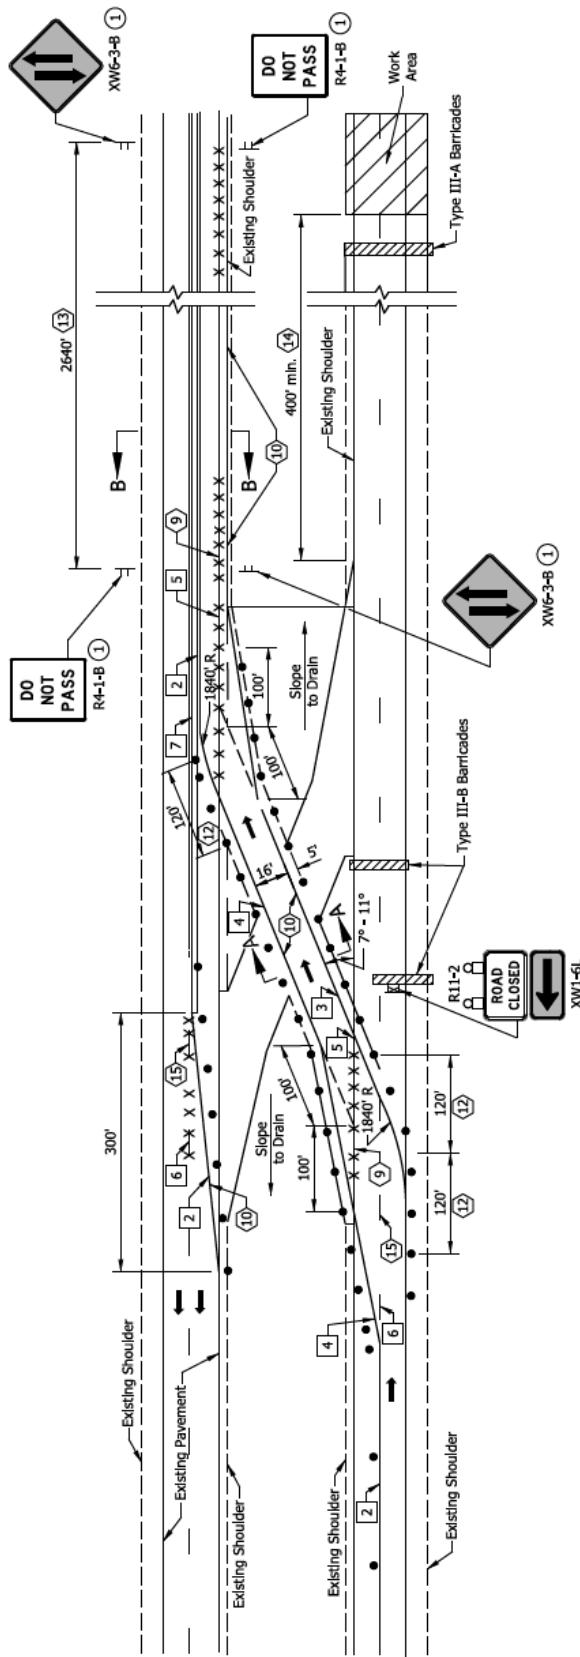

## NOTES:

(1) Signs XW6-3-B and R4-1-B shall be used only with temporary channelizing devices.

2. See Standard Drawing E 801-TCCO-08 for Sections A-A and B-B.

3. See Standard Drawing E 801-TCDV-03 for required taper length for construction zone speed limits other than 55 mph.


INDIANA DEPARTMENT OF TRANSPORTATION  
TEMPORARY CROSSOVERS  
ENTRANCE DETAIL  
SEPTEMBER 2019

STANDARD DRAWING NO. E 801-TCCO-03

DESIGN STANDARDS ENGINEER	DATE
CHIEF ENGINEER	DATE

## REVISION TO STANDARD DRAWINGS

## E 801-TCCO-04 TEMPORARY CROSSOVERS EXIT DETAIL (DRAFT)

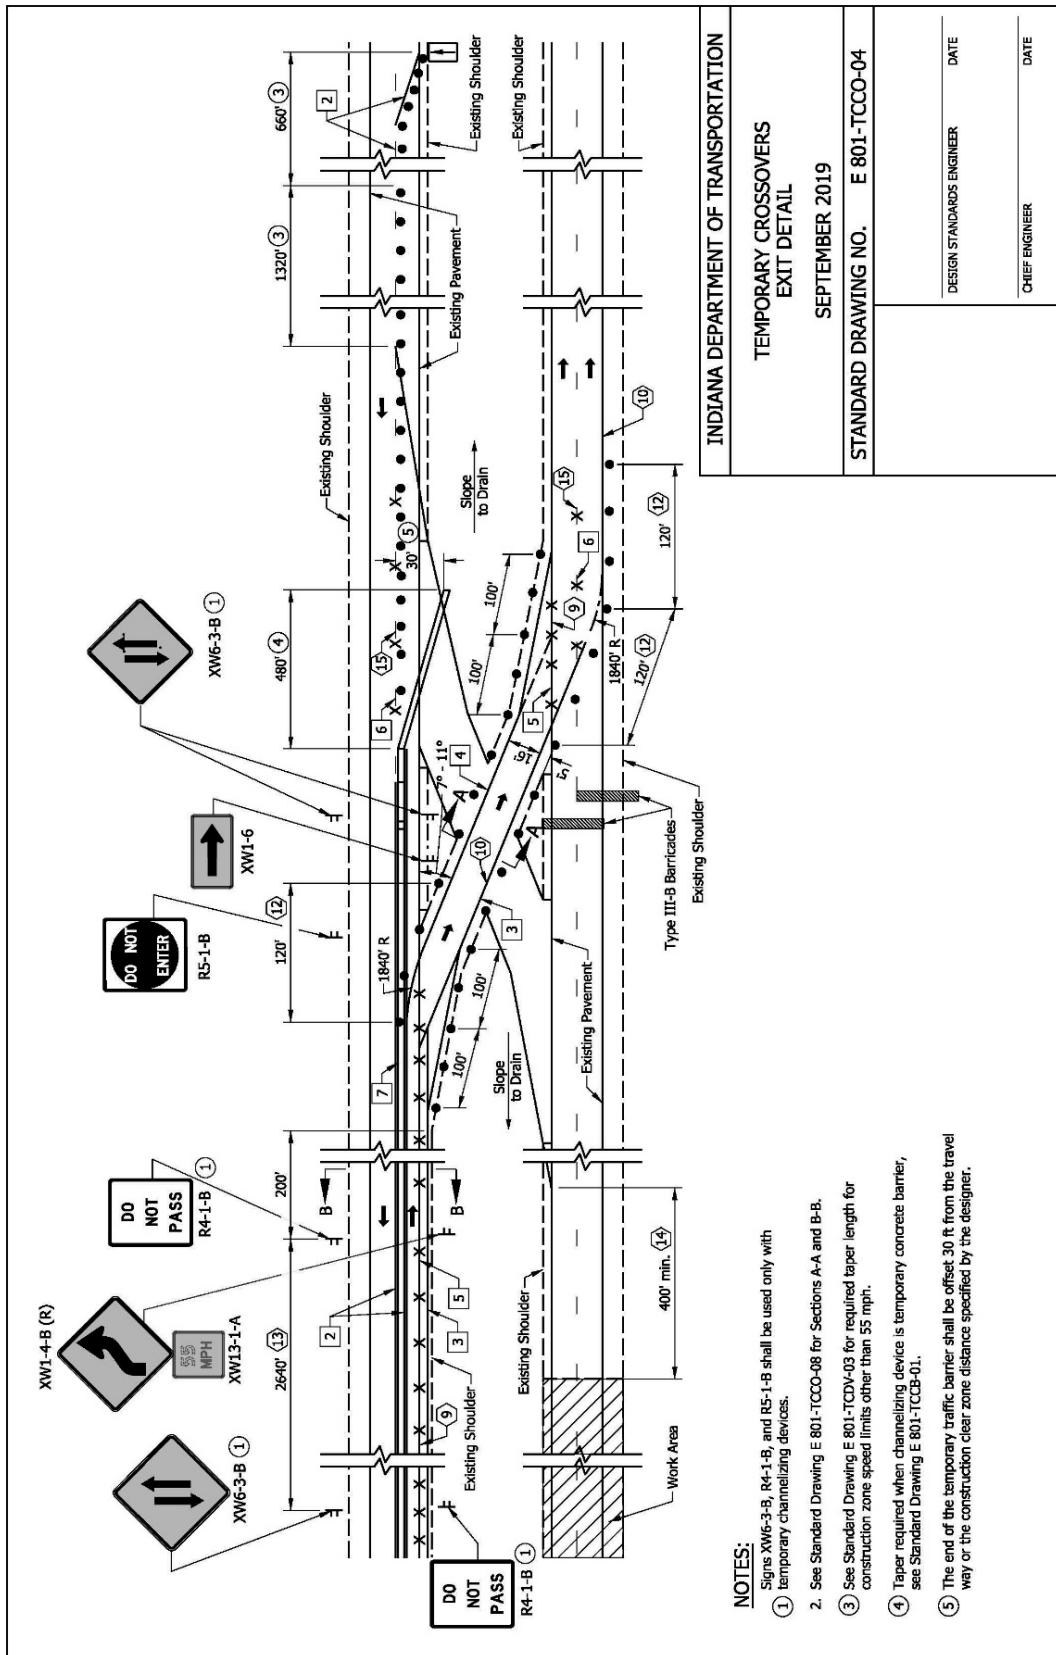


## REVISION TO STANDARD DRAWINGS

## E 801-TCCO-05 SPLIT CROSSOVER ENTRANCE DETAIL (DRAFT)

## NOTES:

- ① See Standard Drawing E 801-TCDV-03 for the required taper length for construction zone speed limits other than 55 mph.
- ② Complete message shall be as shown on the plans.
3. See Standard Drawing E 801-TCCO-02 for placement of XW2-6 "Wearable Added Penalty" signs.
4. Removed conflicting pavement markings and see Standard Drawing E 801-TCCO-03 and E 801-TCCO-04 for placement of temporary pavement markings.
5. See Standard Drawing E 801-TCCO-08 for Sections A-A and E-E.

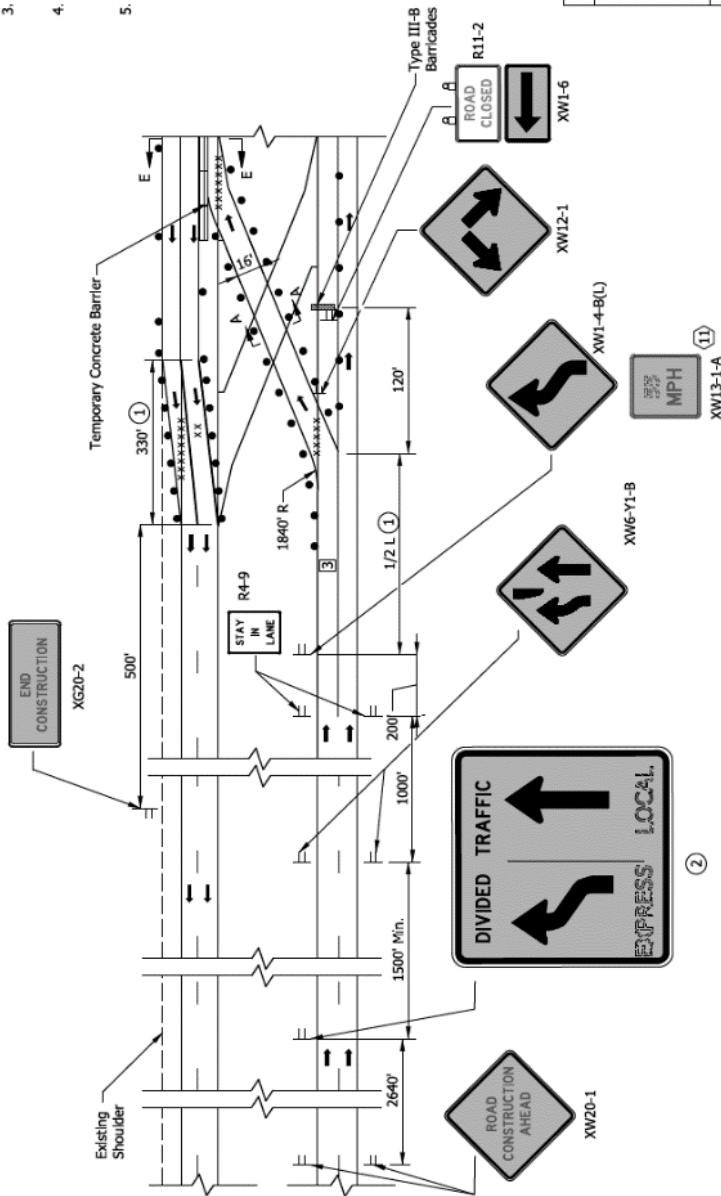

INDIANA DEPARTMENT OF TRANSPORTATION

SPLIT CROSSOVER ENTRANCE DETAIL

SEPTEMBER 2019


STANDARD DRAWING NO. E 801-TCCO-05

DESIGN STANDARDS ENGINEER DATE


CHIEF ENGINEER DATE

## REVISION TO STANDARD DRAWINGS

## E 801-TCCO-06 SPLIT CROSSOVER EXIT DETAIL (DRAFT)

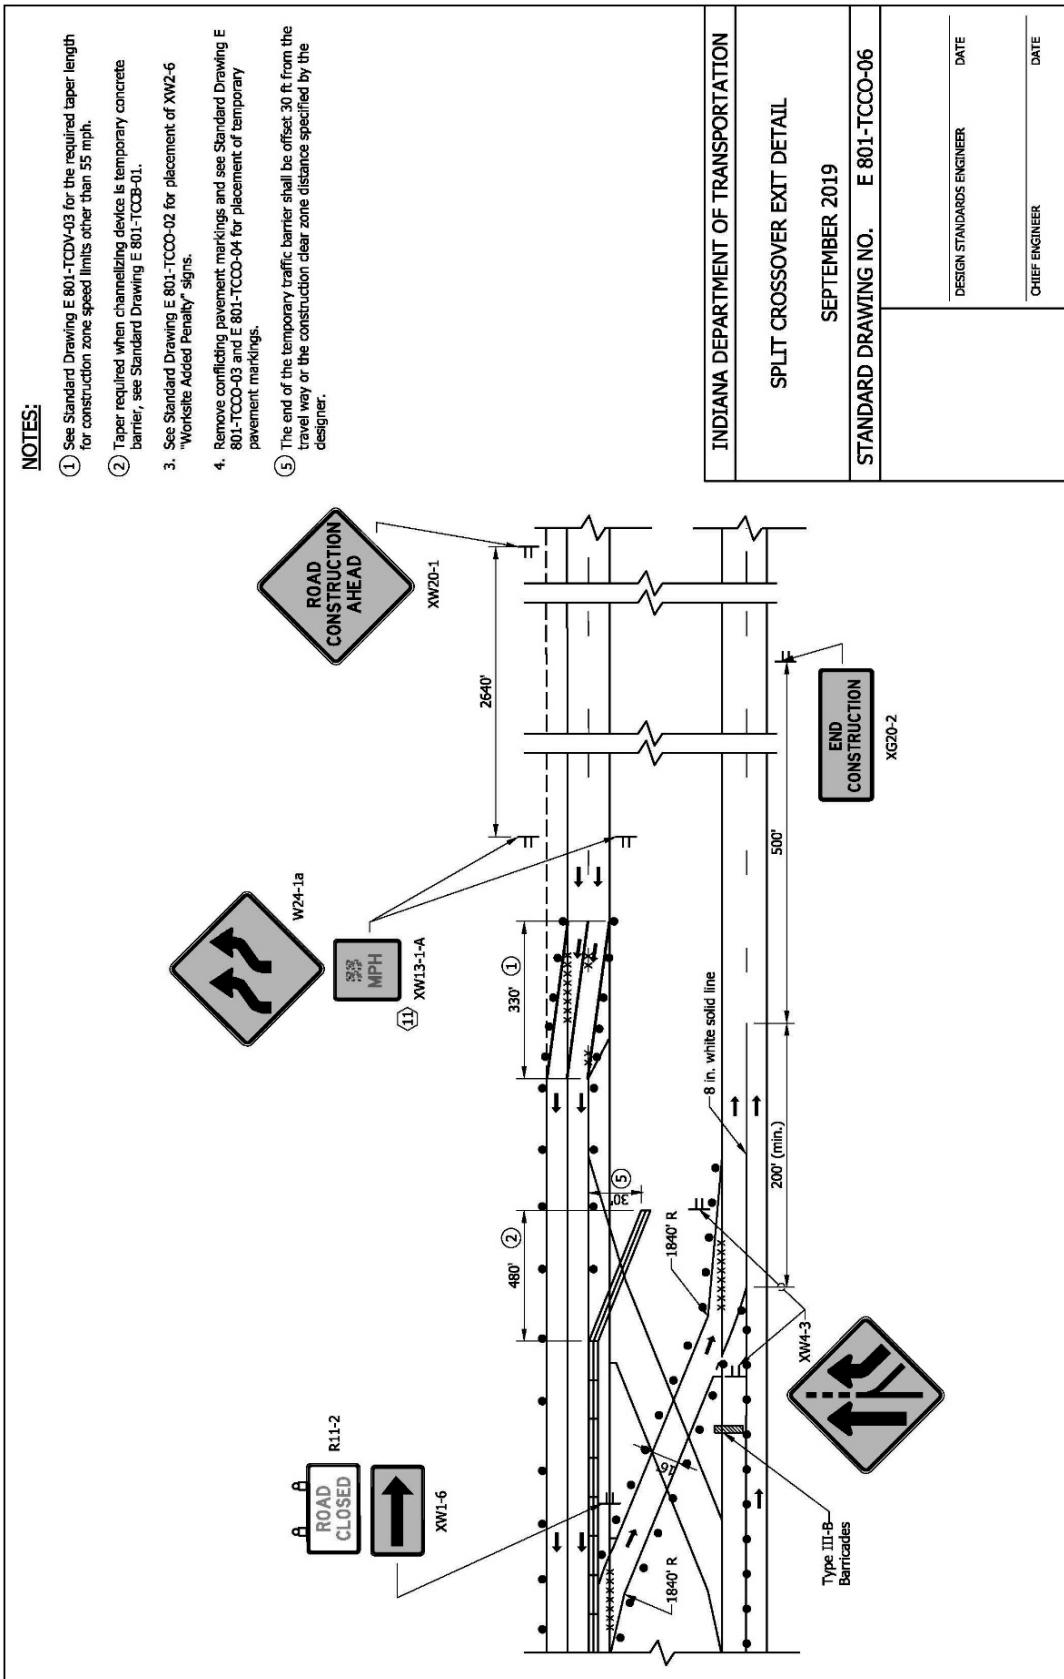


## REVISION TO STANDARD DRAWINGS

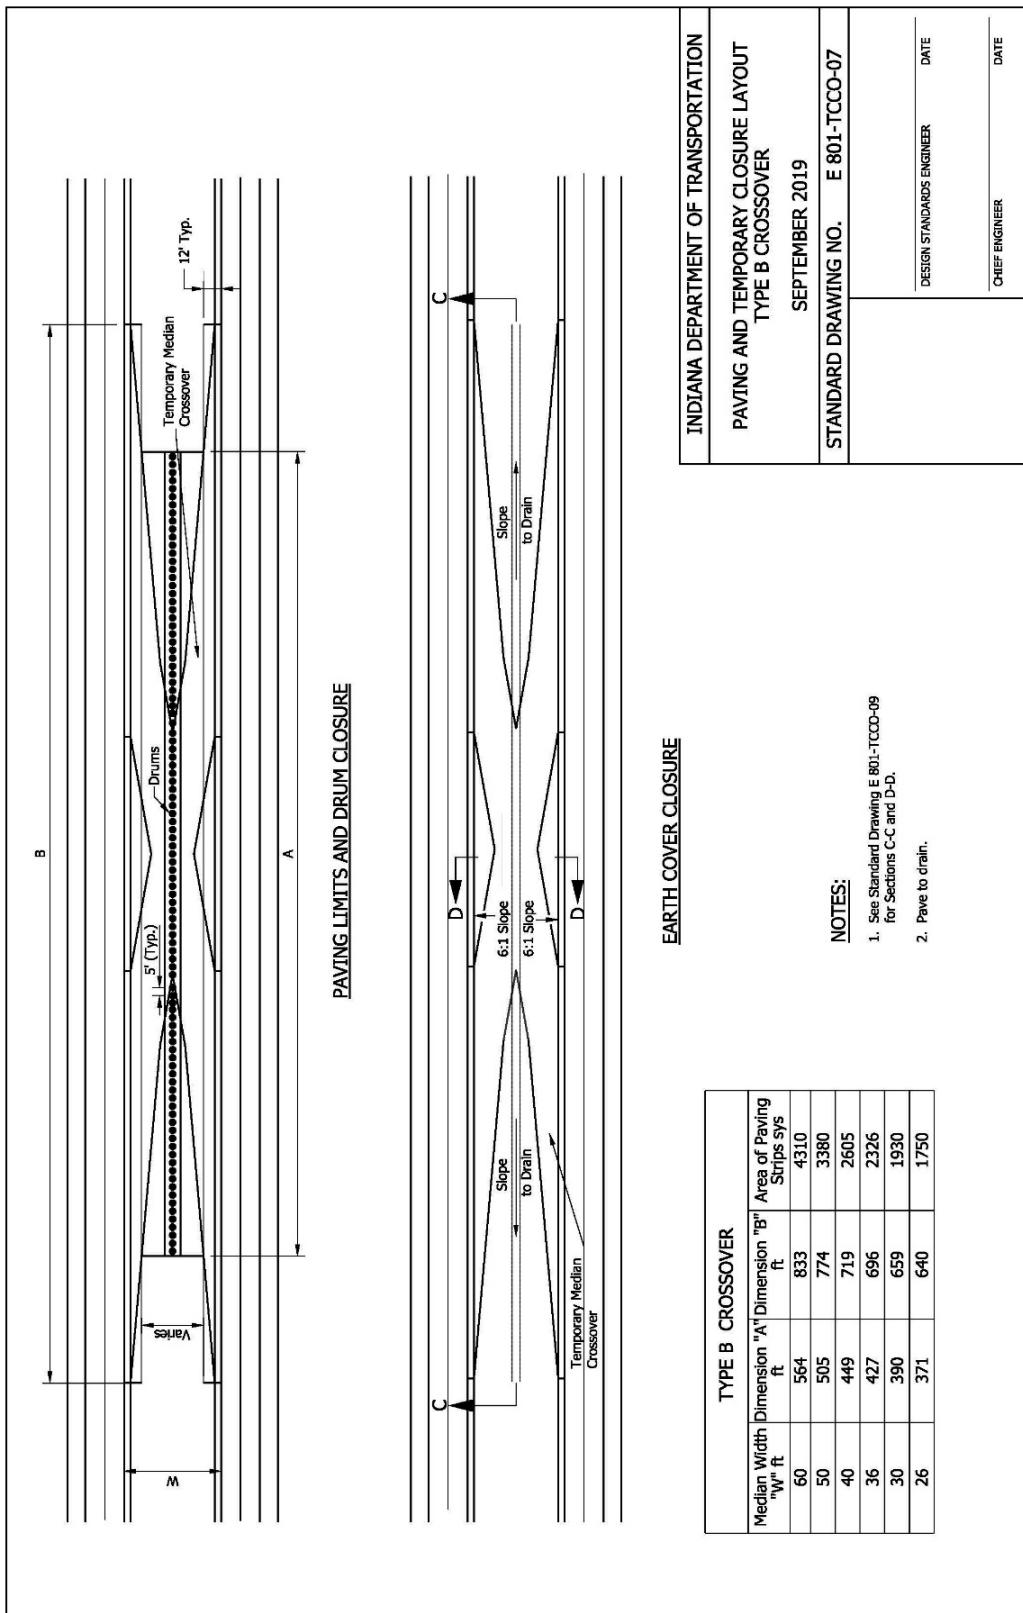E 801-TCCO-07 PAVING AND TEMPORARY CLOSURE LAYOUT TYPE B CROSSOVER  
(DRAFT)


## REVISION TO STANDARD DRAWINGS

## E 801-TCCO-08 TEMPORARY CROSSOVER TYPICAL SECTIONS (DRAFT)

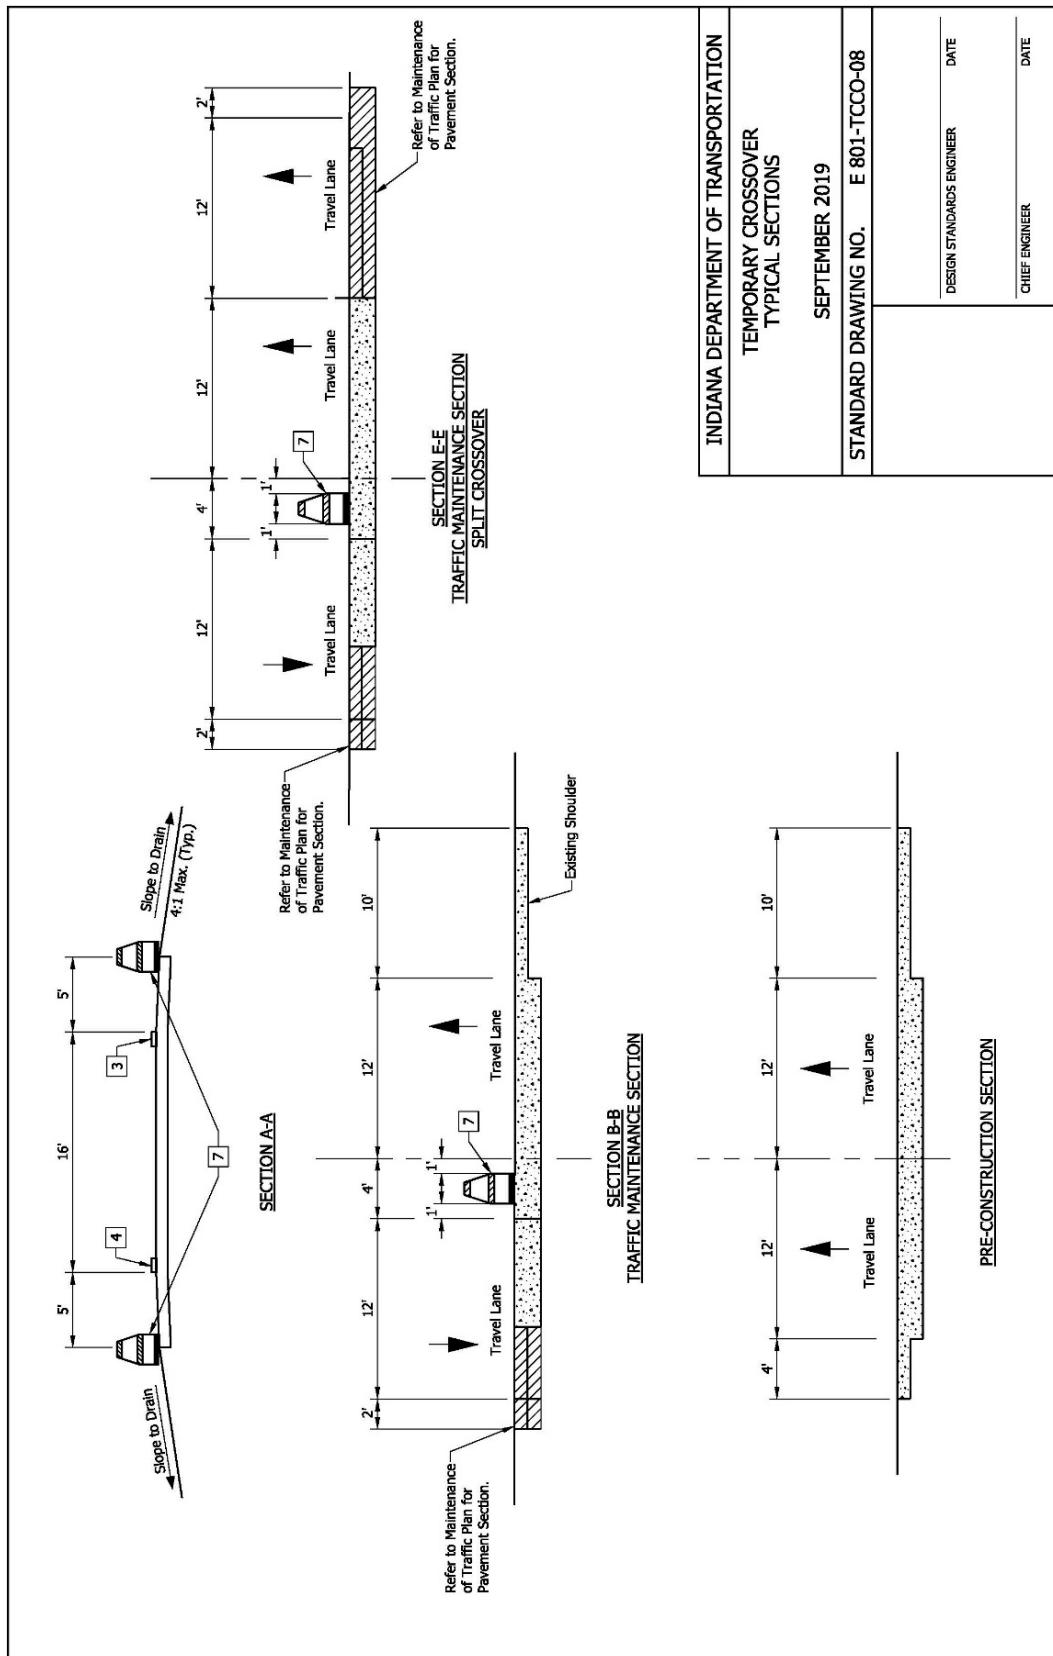


## REVISION TO STANDARD DRAWINGS

## E 801-TCCO-09 PERMANENT CLOSURE OF A TEMPORARY CROSSOVER (DRAFT)

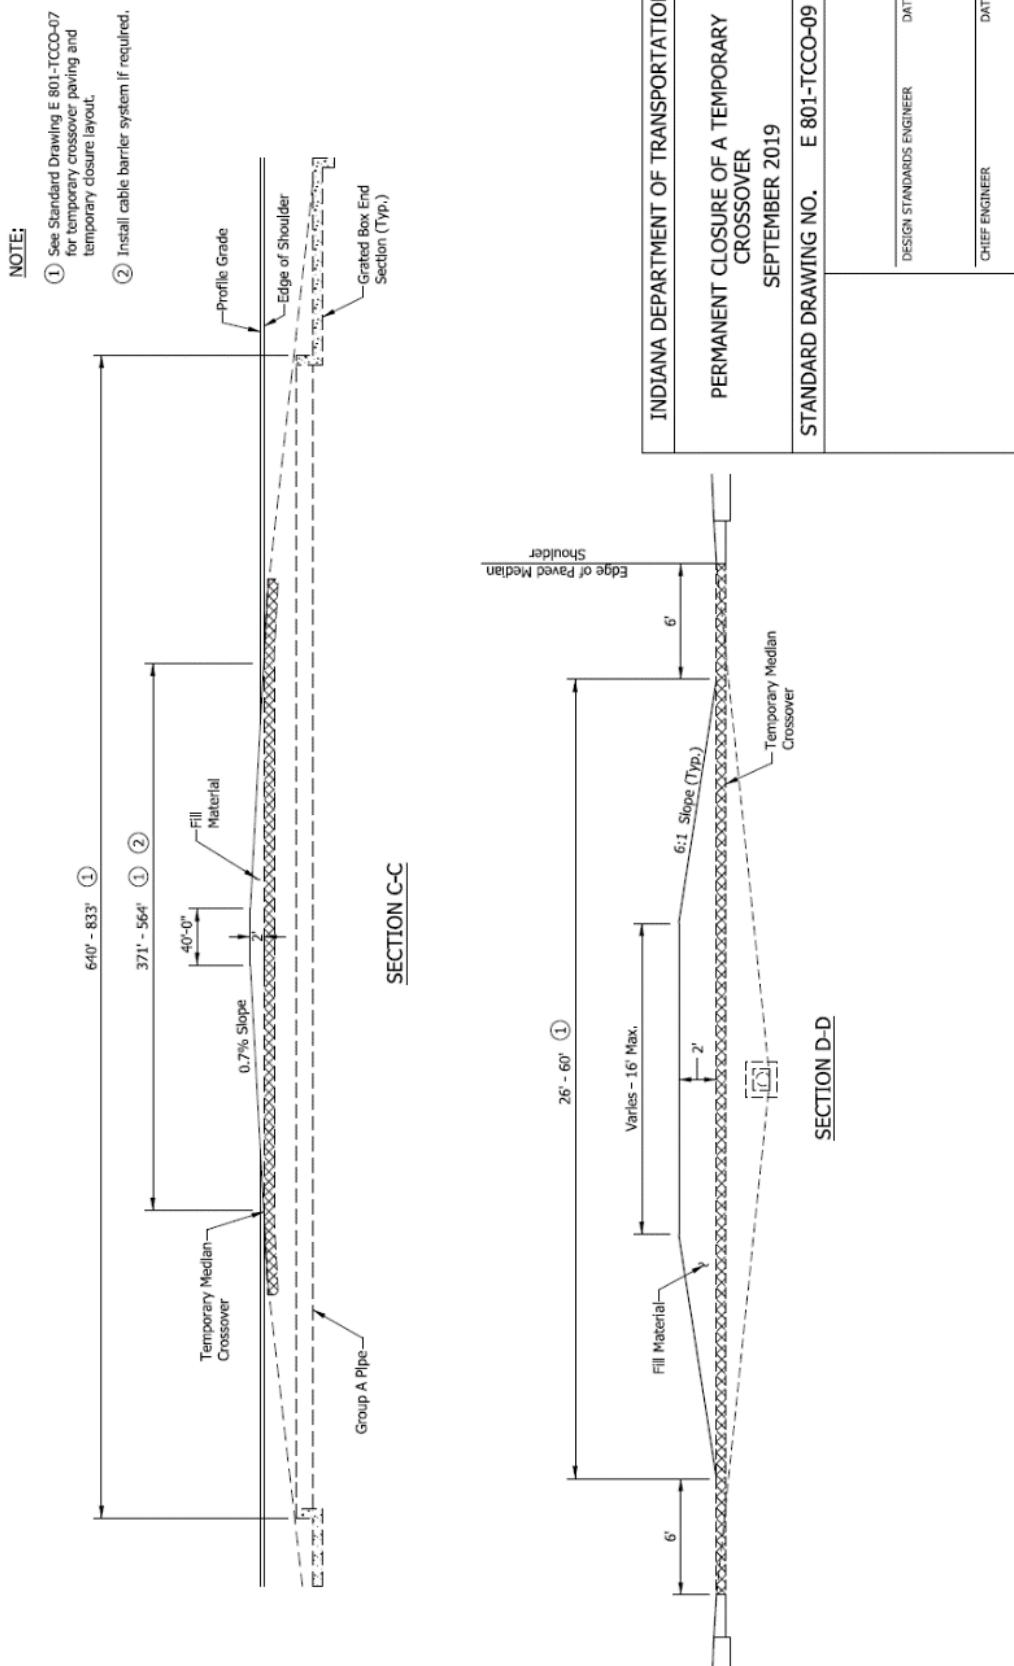


## REVISION TO STANDARD DRAWINGS

## E 801-TCCO-10 TUBULAR MARKER USE ON A NONFREEWAY CROSSOVER (DRAFT)

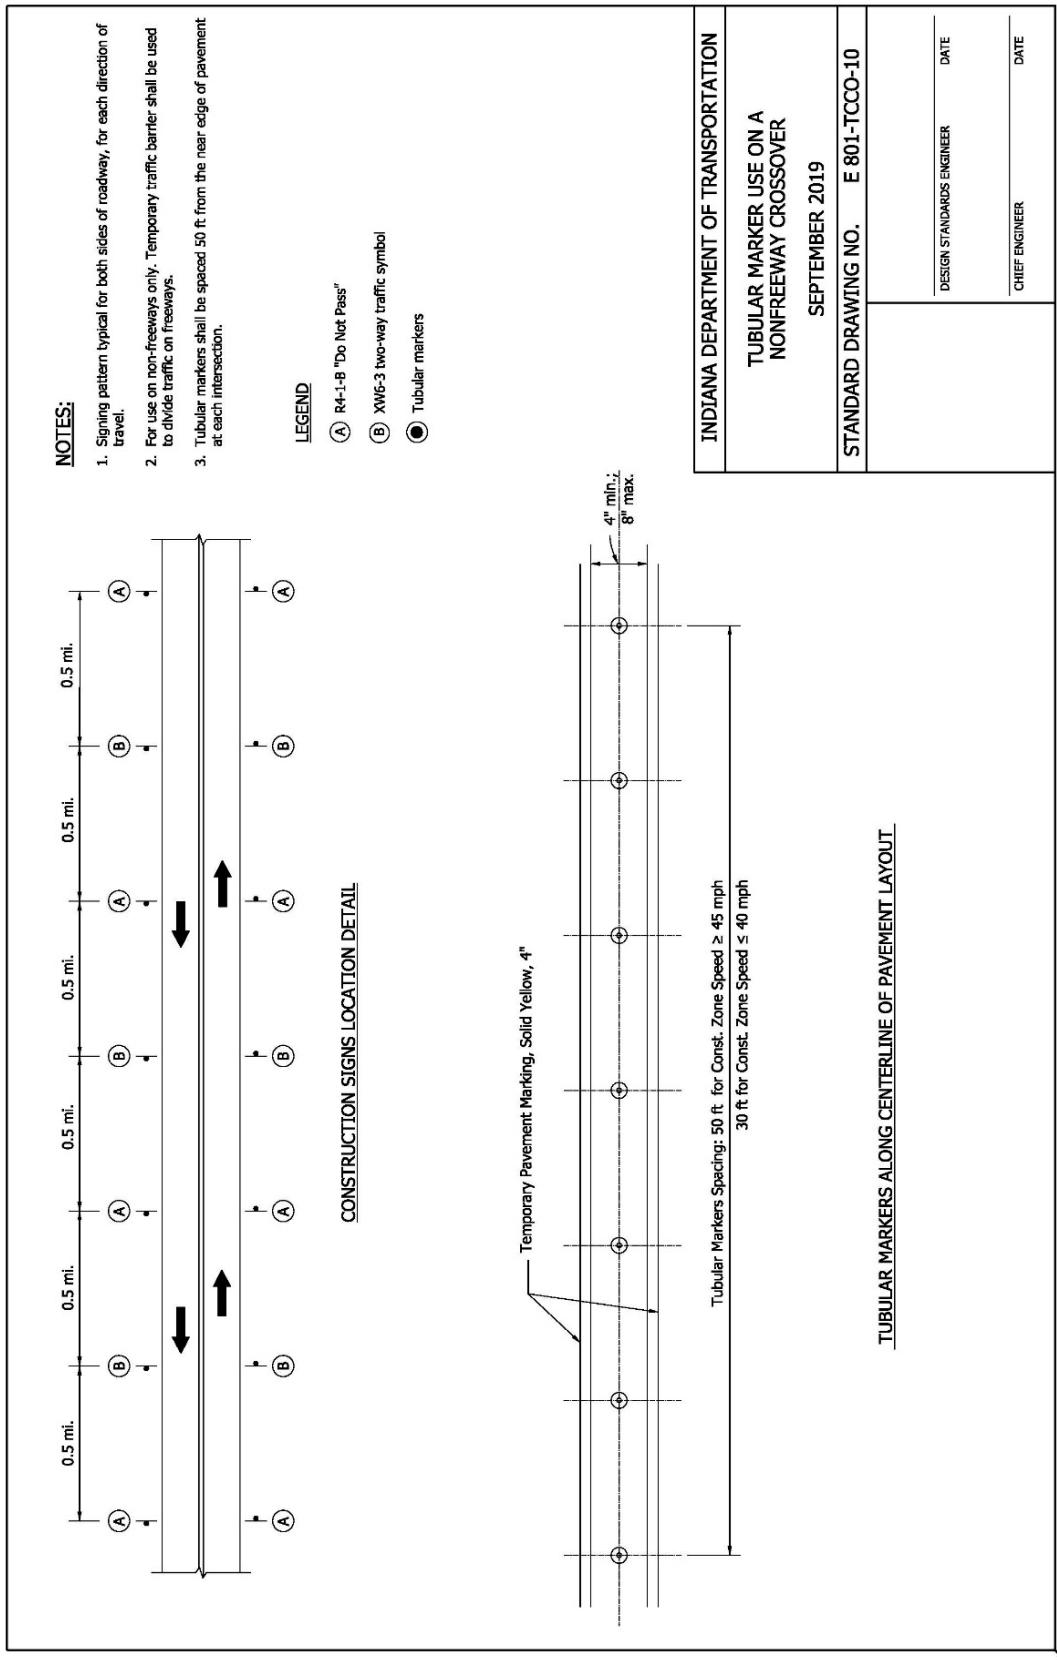


## REVISION TO STANDARD DRAWINGS


## E 801-TCFO-01 FLAGGER OPERATIONS FOR RURAL TWO LANE ROADS WITH SPEEDS &gt; 50 MPH (DRAFT)

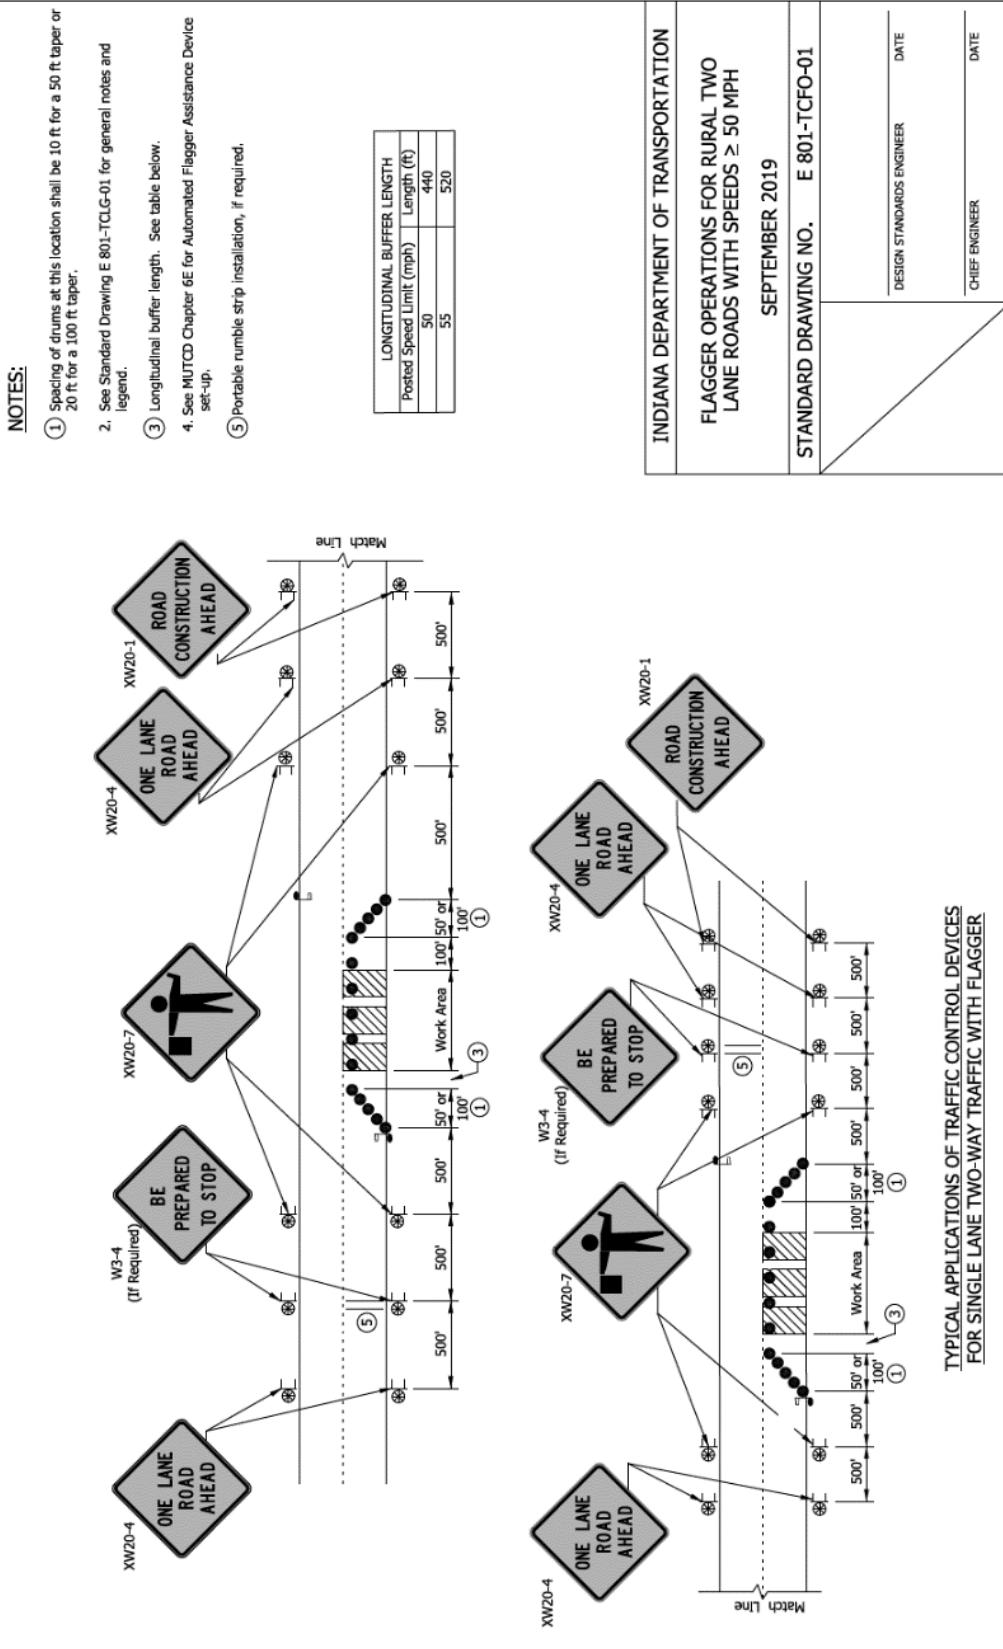

## REVISION TO STANDARD DRAWINGS

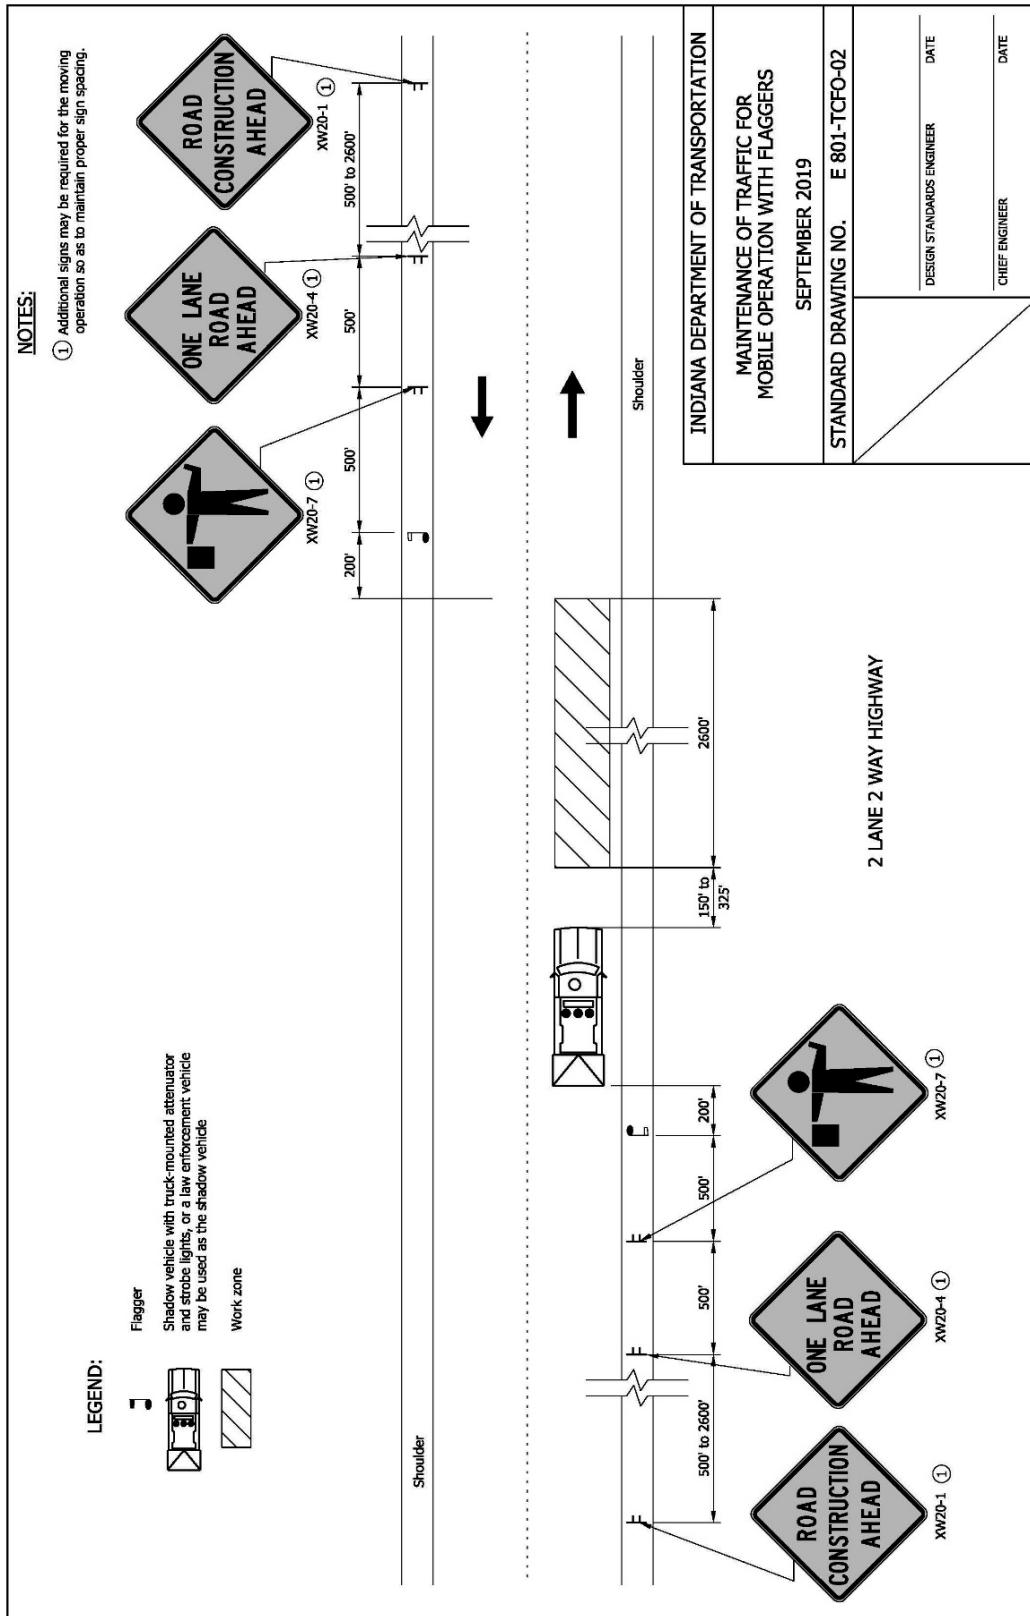E 801-TCFO-02 MAINTENANCE OF TRAFFIC FOR MOBILE OPERATION WITH FLAGGERS  
(DRAFT)

## REVISION TO STANDARD DRAWINGS

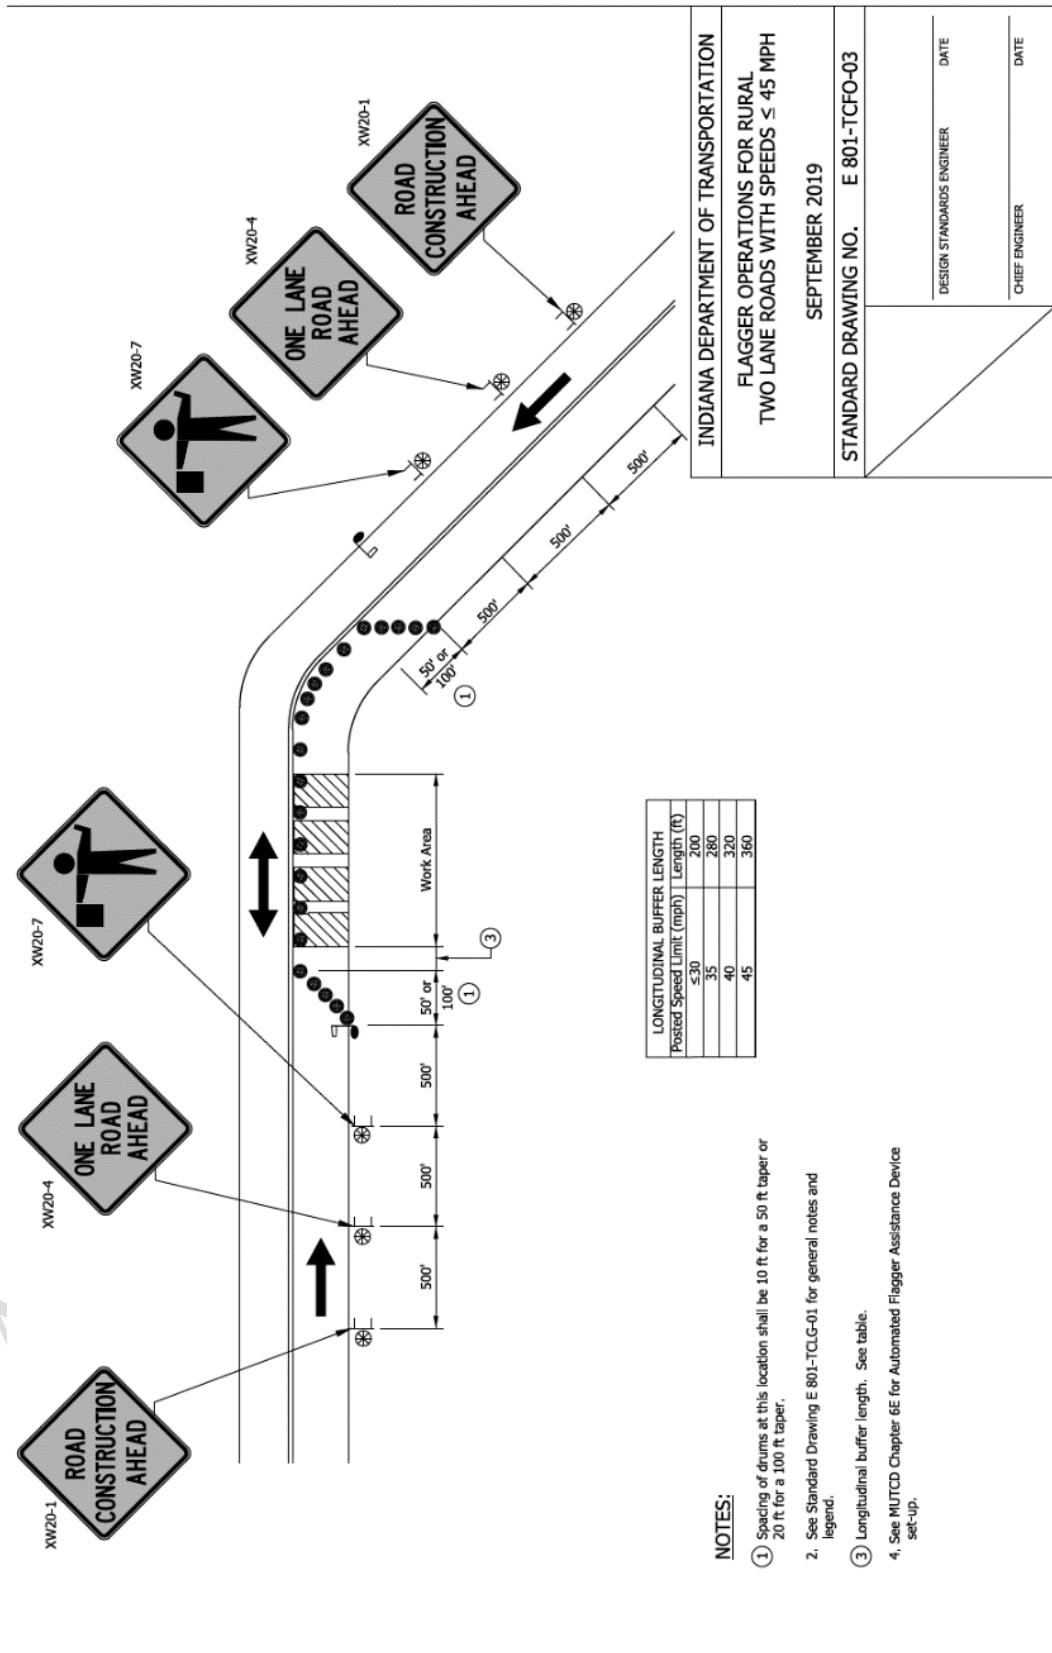E 801-TCFO-03 FLAGGER OPERATIONS FOR RURAL TWO LANE ROADS WITH SPEEDS  $\leq$  45 MPH (DRAFT)

REVISION TO STANDARD DRAWINGS

E 801-TCLC-01 LANE CLOSURES INDEX SHEET AND GENERAL NOTES (DRAFT)

INDEX	
SHEET NO.	SUBJECT
1	Lane Closures Index Sheet and General Notes
2	Lane Closure Applications on Divided Highways
3	Continuous Lane Closures, Right Lane Closed
4	Center Lane Closure on Freeways
5	Left Lane Closed on Freeways
6	Short-Term Right Lane Closure
7	Short-Term Left or Center Lane Closure
8	Traffic Control for Lane Closure on a Three Lane Road
9	Traffic Control for Freeway or Expressway Exit Closure
10	Right Lane Closure Near Interchange
11	Lane Closure Near Entrance Ramp


**GENERAL NOTES:**

1. See Standard Drawing E 801-TCLC-01 for legend and additional notes.
2. Long-term stationary is work that occupies a location for more than 3 days.
3. Intermediate-term stationary is work that occupies a location for more than 1 daylight period up to 3 days, or nighttime work lasting more than 1 hour.
4. Short-term stationary is work that occupies a location for more than 1 hour within a single daylight period.

INDIANA DEPARTMENT OF TRANSPORTATION	DATE
LANE CLOSURES	DATE
INDEX SHEET AND GENERAL NOTES	DATE
SEPTEMBER 2019	DATE
STANDARD DRAWING NO. E 801-TCLC-01	DATE
DESIGN STANDARDS ENGINEER	DATE
CHIEF ENGINEER	DATE


## REVISION TO STANDARD DRAWINGS

E 801-TCLC-02 LANE CLOSURE APPLICATIONS ON DIVIDED HIGHWAYS (DRAFT)

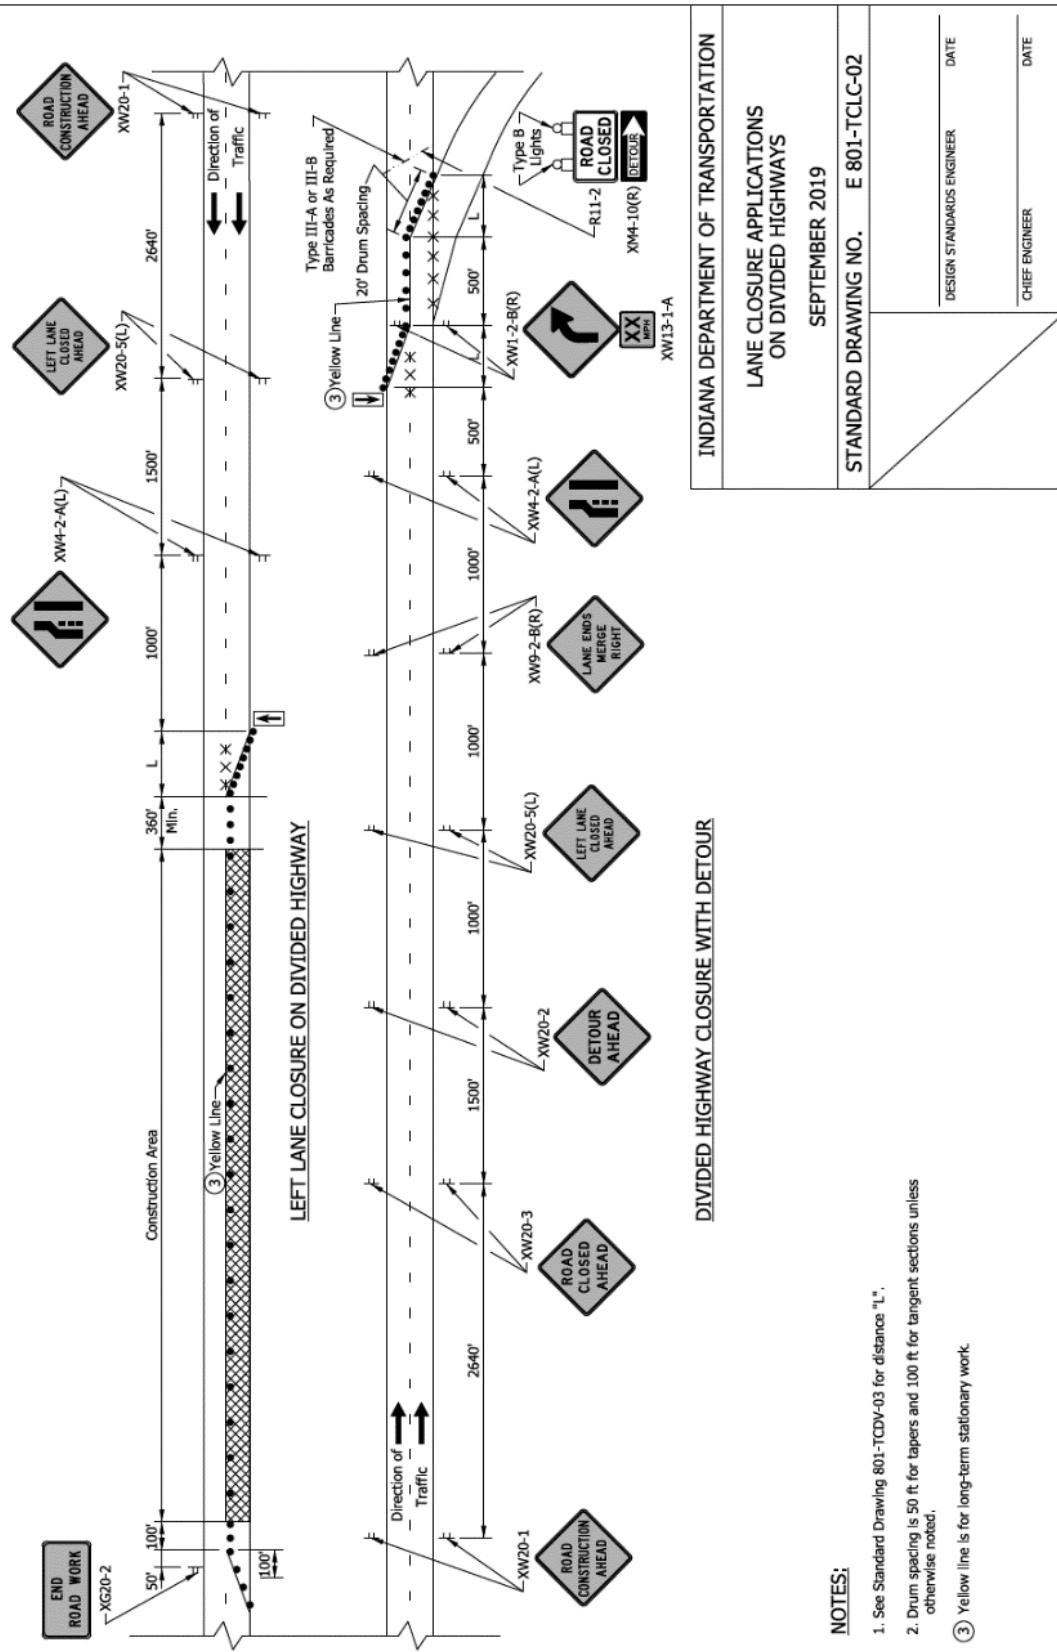

## REVISION TO STANDARD DRAWINGS

E 801-TCLC-03 CONTINUOUS LANE CLOSURES RIGHT LANE CLOSED (DRAFT)

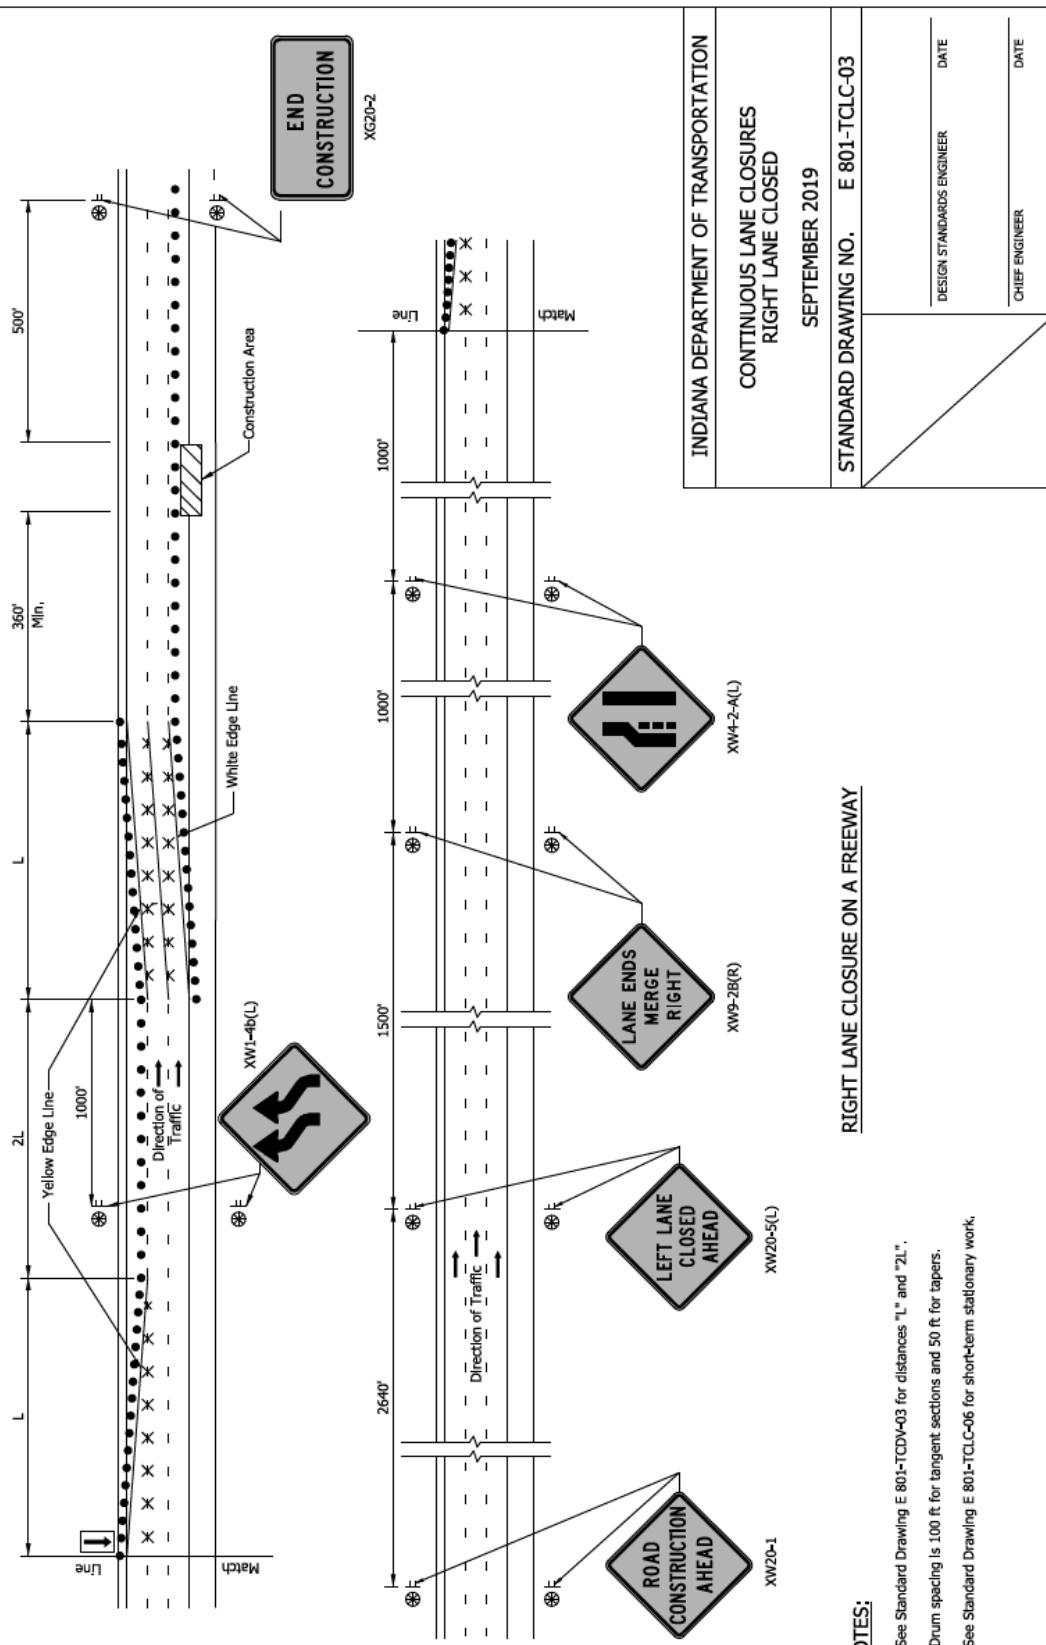


**NOTES:**

1. See Standard Drawing E 801-TCDV-03 for distances "L" and "2L".
2. Drum spacing is 100 ft for tangent sections and 50 ft for tapers.
3. See Standard Drawing E 801-TCLC-06 for short-term stationary work.


## REVISION TO STANDARD DRAWINGS

E 801-TCLC-04 CENTER LANE CLOSURE ON FREEWAYS (DRAFT)

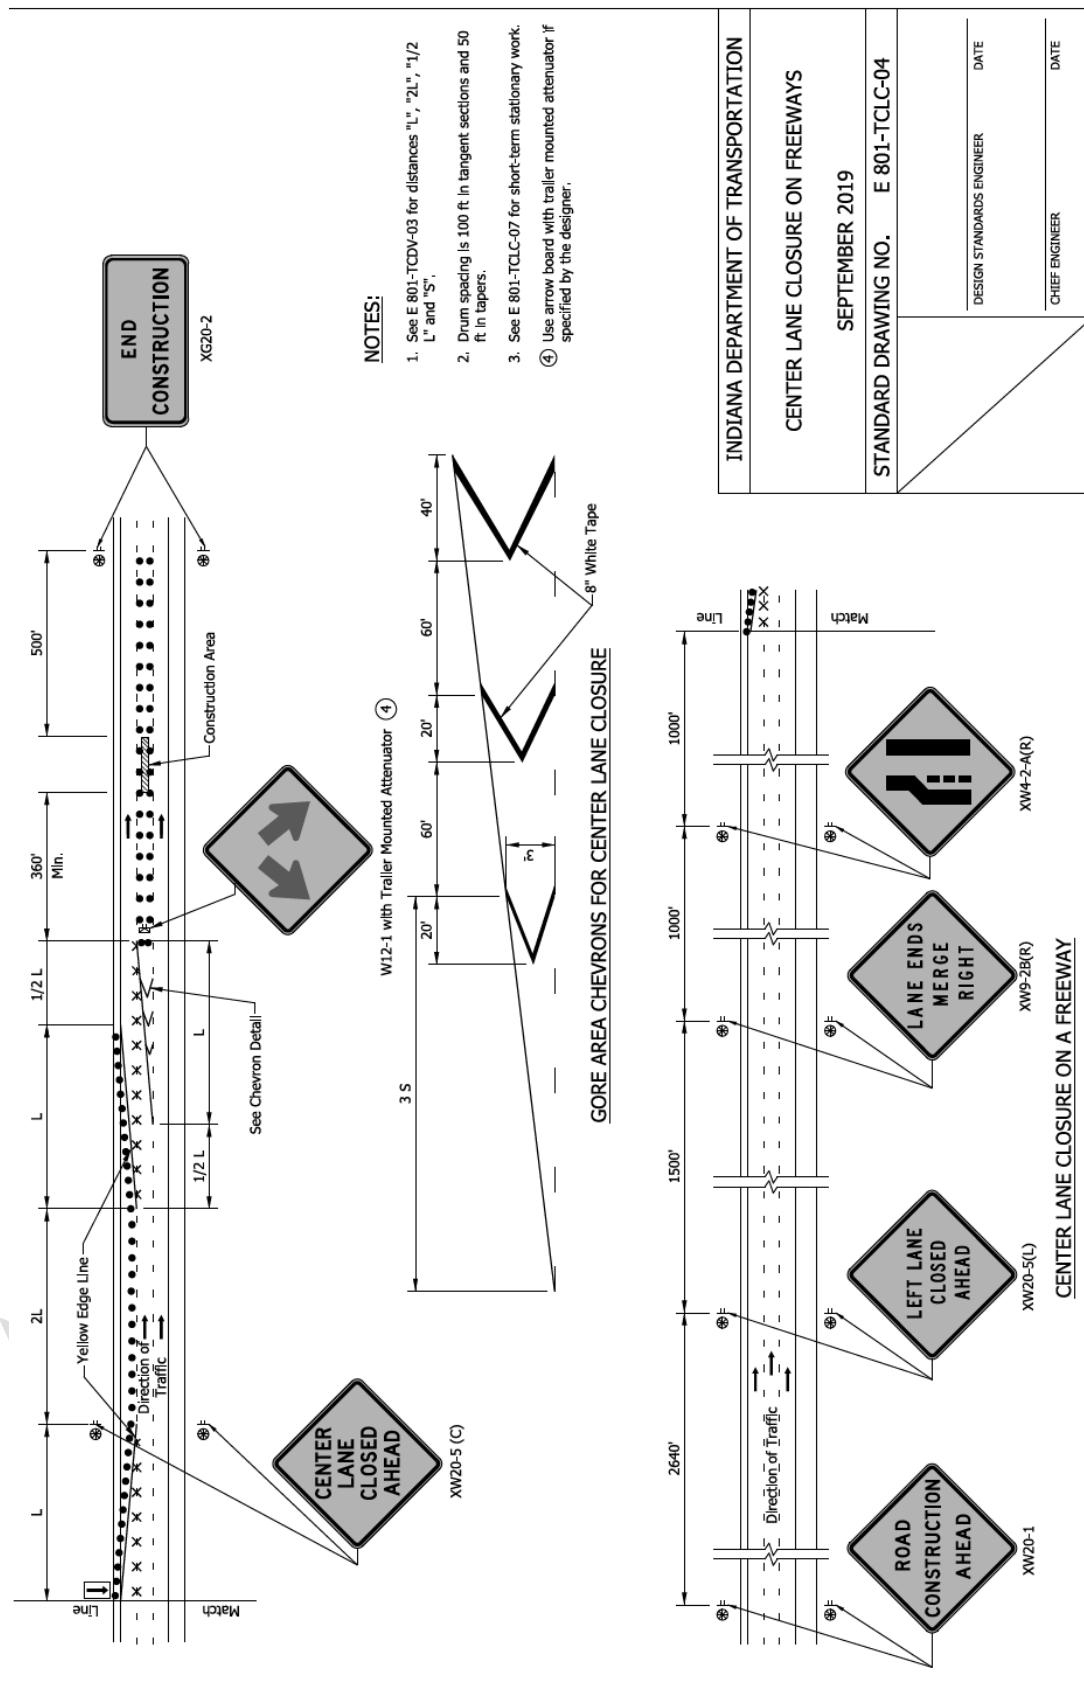


## REVISION TO STANDARD DRAWINGS

E 801-TCLC-05 LEFT LANE CLOSURE ON FREEWAYS (DRAFT)

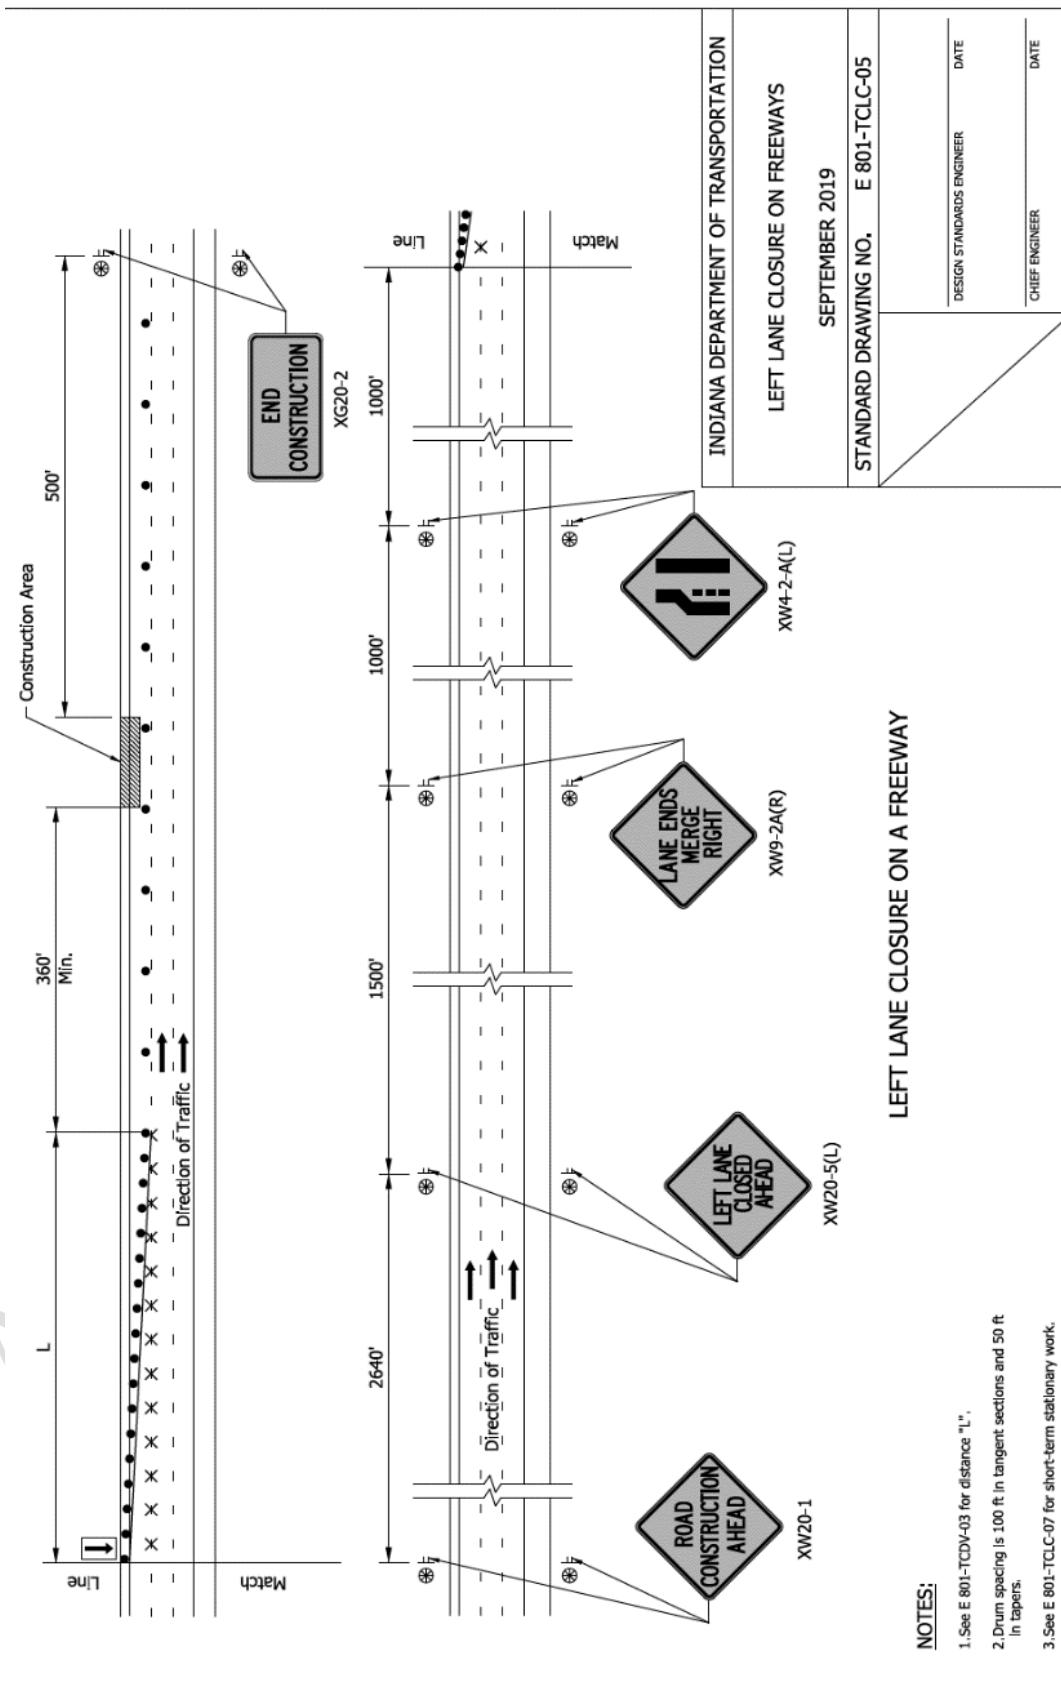

## REVISION TO STANDARD DRAWINGS

## E 801-TCLC-06 SHORT-TERM RIGHT LANE CLOSURE (DRAFT)

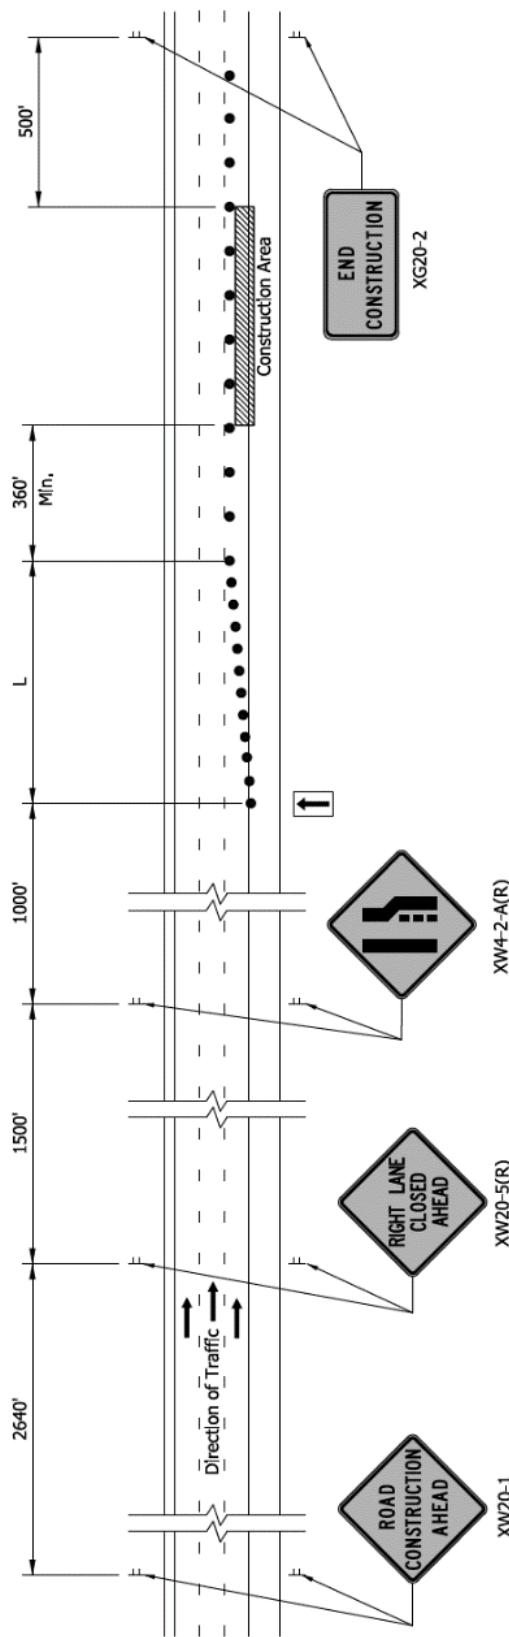

## SHORT-TERM RIGHT LANE CLOSURE (DAYTIME ONLY)


**NOTES:**

1. All lanes are to be open to traffic between sunset and sunrise.
2. See Standard Drawing E 801-TCDV-03 for distance "L".
3. Drum spacing is 100 ft in tangent sections and 50 ft in tapers.
4. See Standard Drawing E 801-TCLC-03 for long-term or intermediate-term work.


INDIANA DEPARTMENT OF TRANSPORTATION
SHORT-TERM RIGHT LANE CLOSURE
SEPTEMBER 2019
STANDARD DRAWING NO. E 801-TCLC-06
DESIGN STANDARDS ENGINEER _____ DATE _____
CHIEF ENGINEER _____ DATE _____

## REVISION TO STANDARD DRAWINGS


## E 801-TCLC-07 SHORT-TERM LEFT OR CENTER LANE CLOSURE (DRAFT)

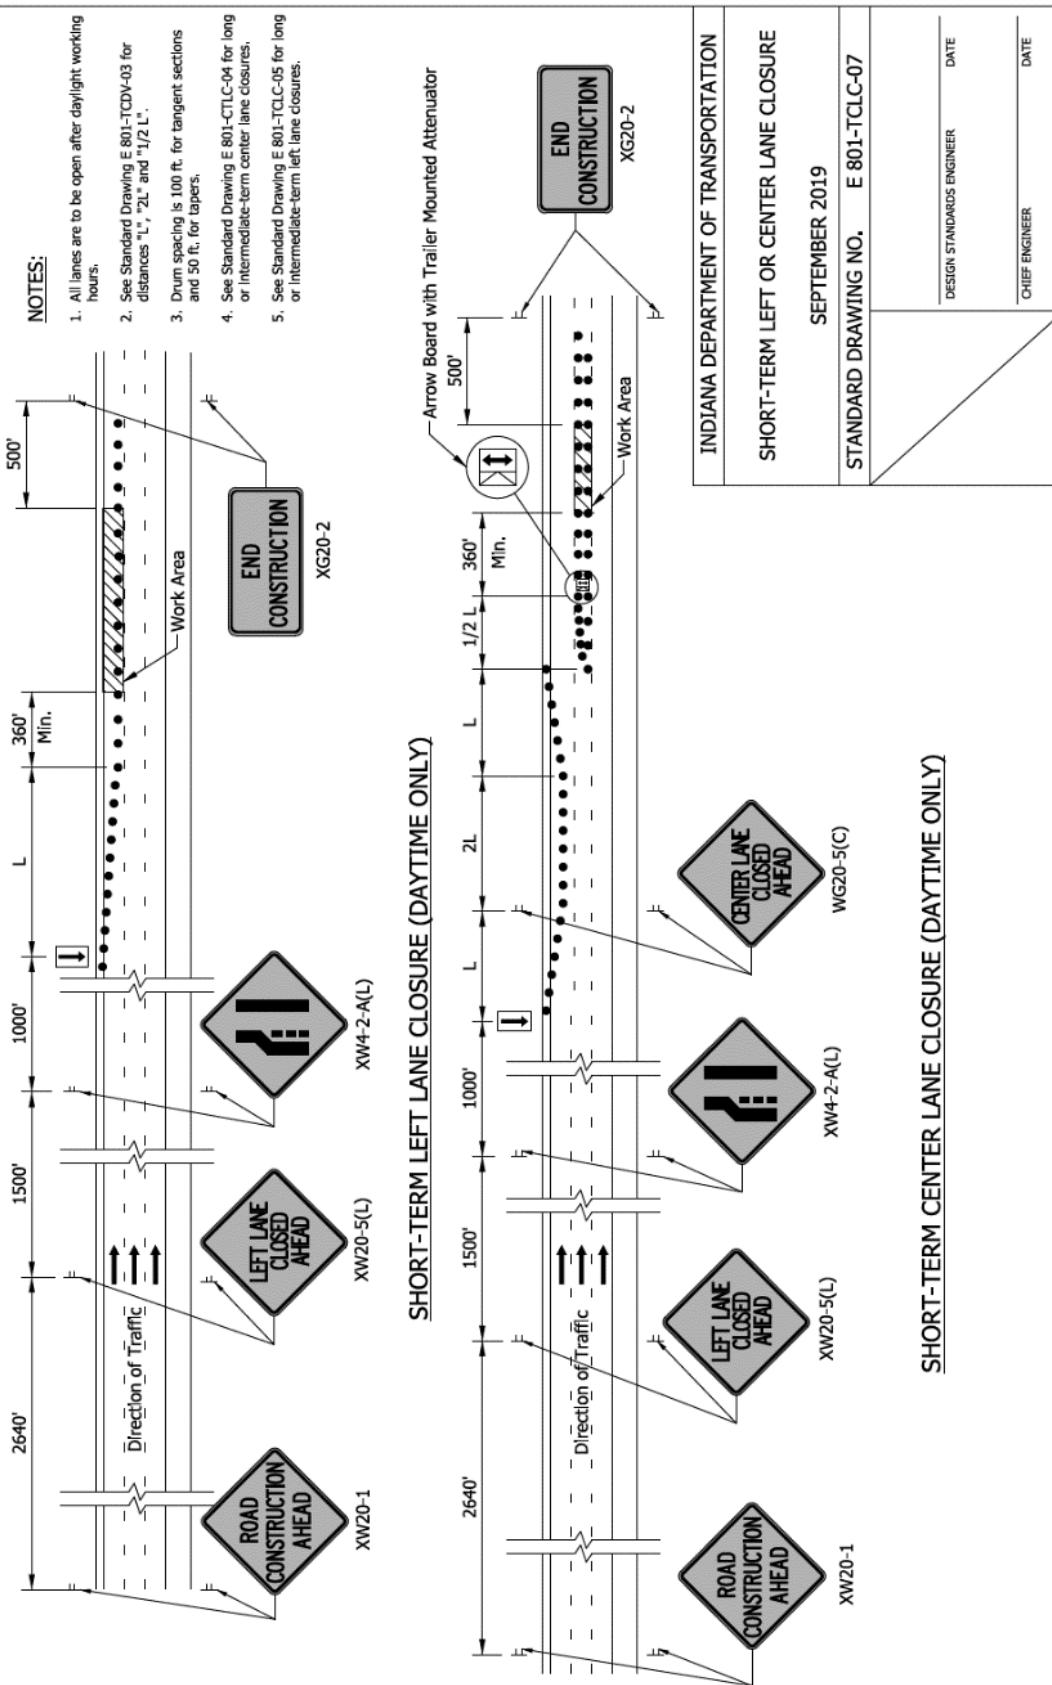

## REVISION TO STANDARD DRAWINGS

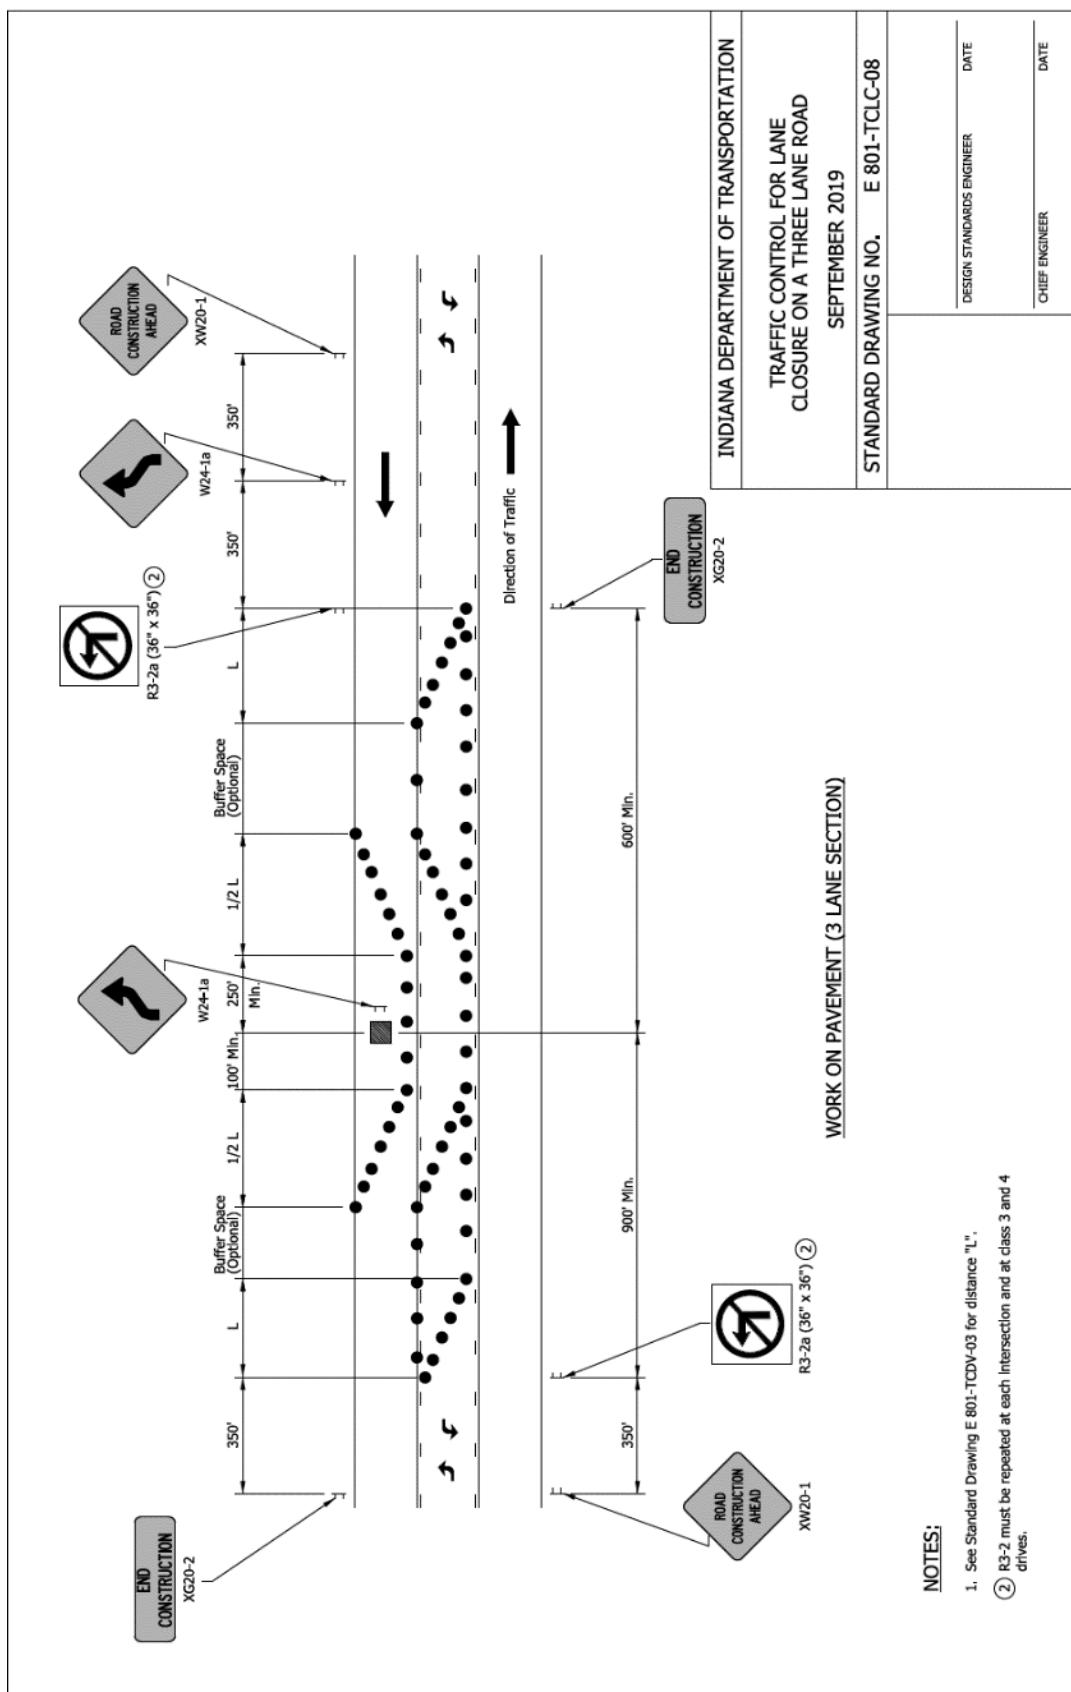E 801-TCLC-08 TRAFFIC CONTROL FOR LANE CLOSURE ON A THREE LANE ROAD  
(DRAFT)

## REVISION TO STANDARD DRAWINGS

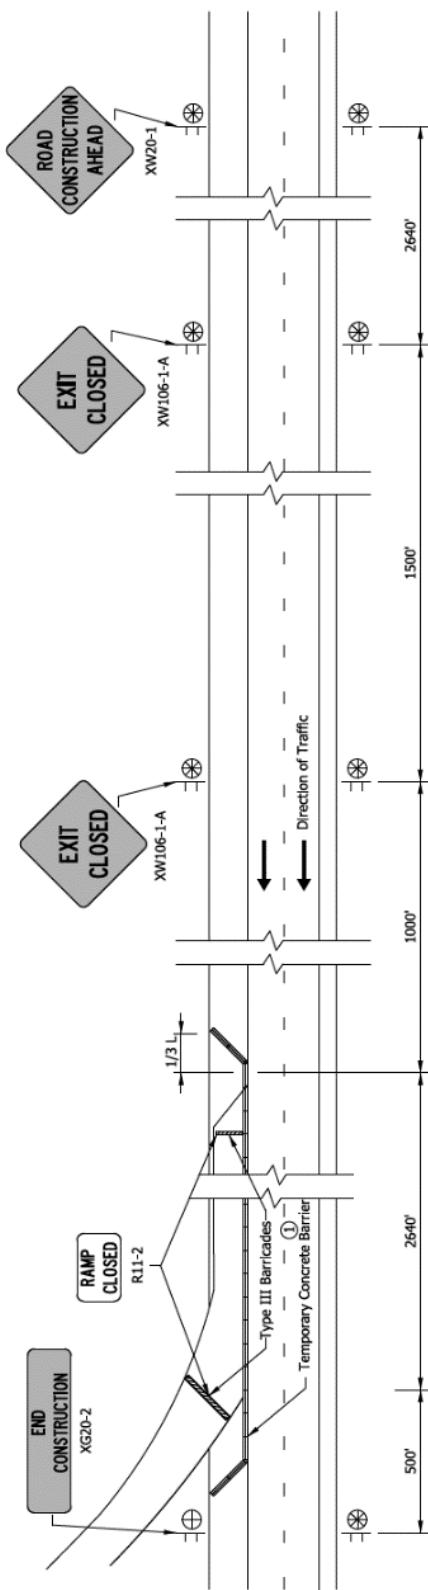E 801-TCLC-09 TRAFFIC CONTROL FOR FREEWAY OR EXPRESSWAY EXIT CLOSURE  
(DRAFT)

## FREEWAY OR EXPRESSWAY EXIT CLOSURE

## NOTES:

① Temporary concrete barrier shall be used for long-term stationary work.  
For short-term or intermediate-term stationary work, drums with 20 ft  
spacing may be used.

2. See Standard Drawing E 801-TCDV-03 for distance "L".

## INDIANA DEPARTMENT OF TRANSPORTATION


TRAFFIC CONTROL FOR FREEWAY OR  
EXPRESSWAY EXIT CLOSURE  
SEPTEMBER 2019

STANDARD DRAWING NO. E 801-TCLC-09

DESIGN STANDARDS ENGINEER	DATE
CHIEF ENGINEER	DATE


## REVISION TO STANDARD DRAWINGS

## E 801-TCLC-10 RIGHT LANE CLOSURE NEAR INTERCHANGE (EXIT OPEN) (DRAFT)

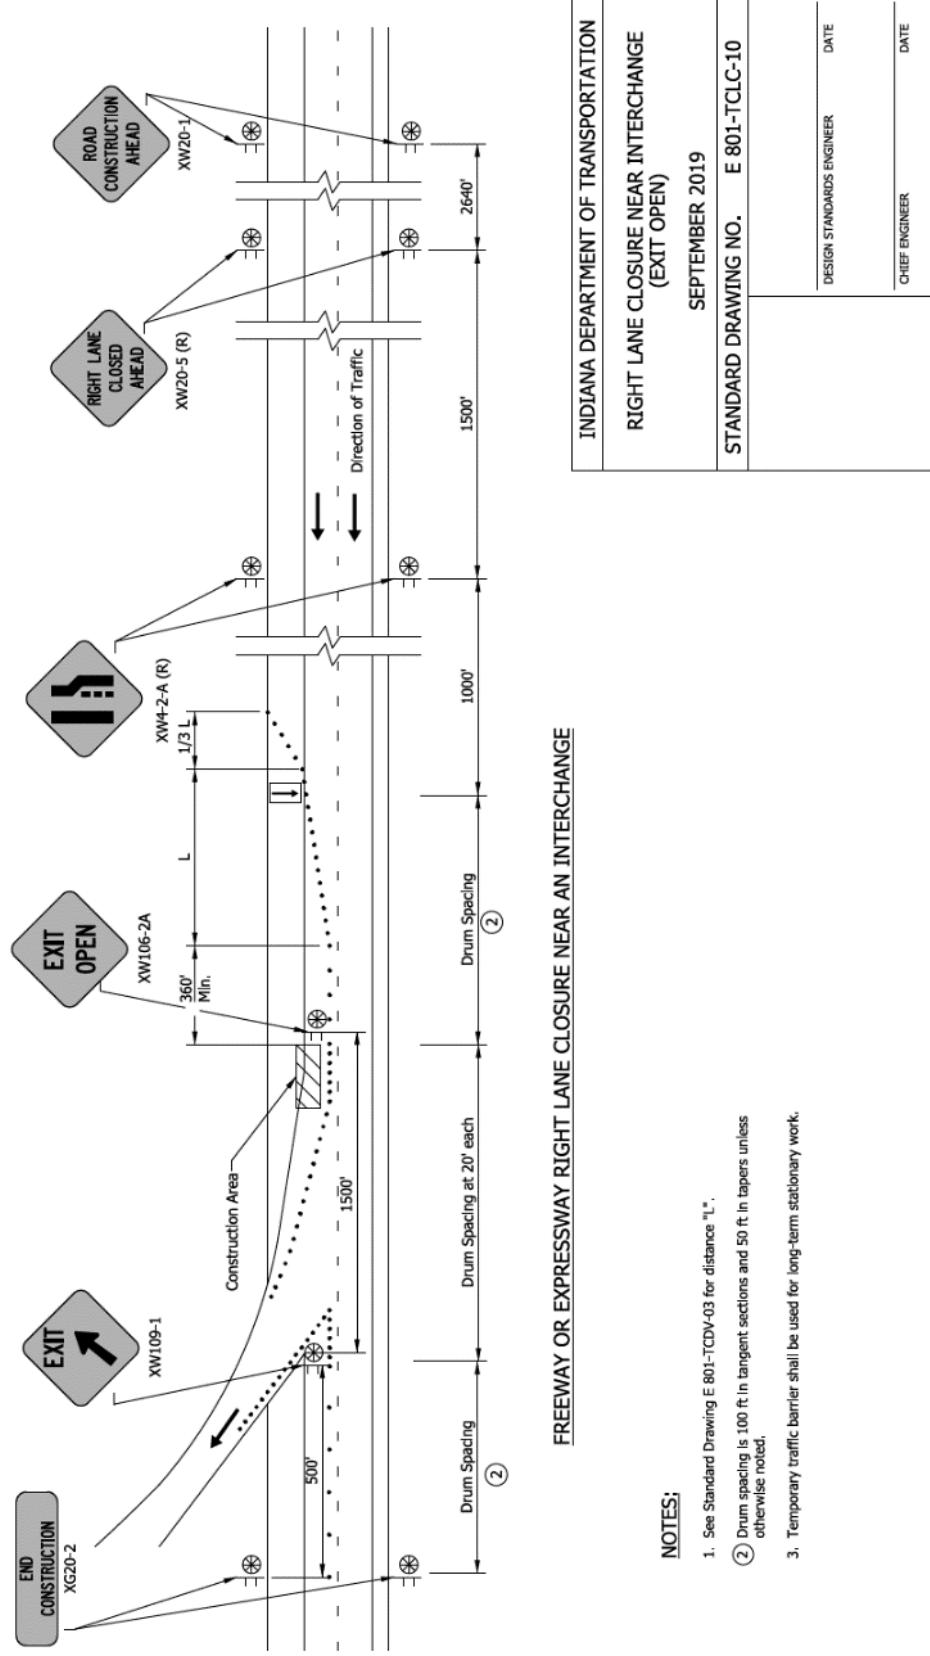


REVISION TO STANDARD DRAWINGS

E 801-TCLC-11 LANE CLOSURE NEAR ENTRANCE RAMP (DRAFT)

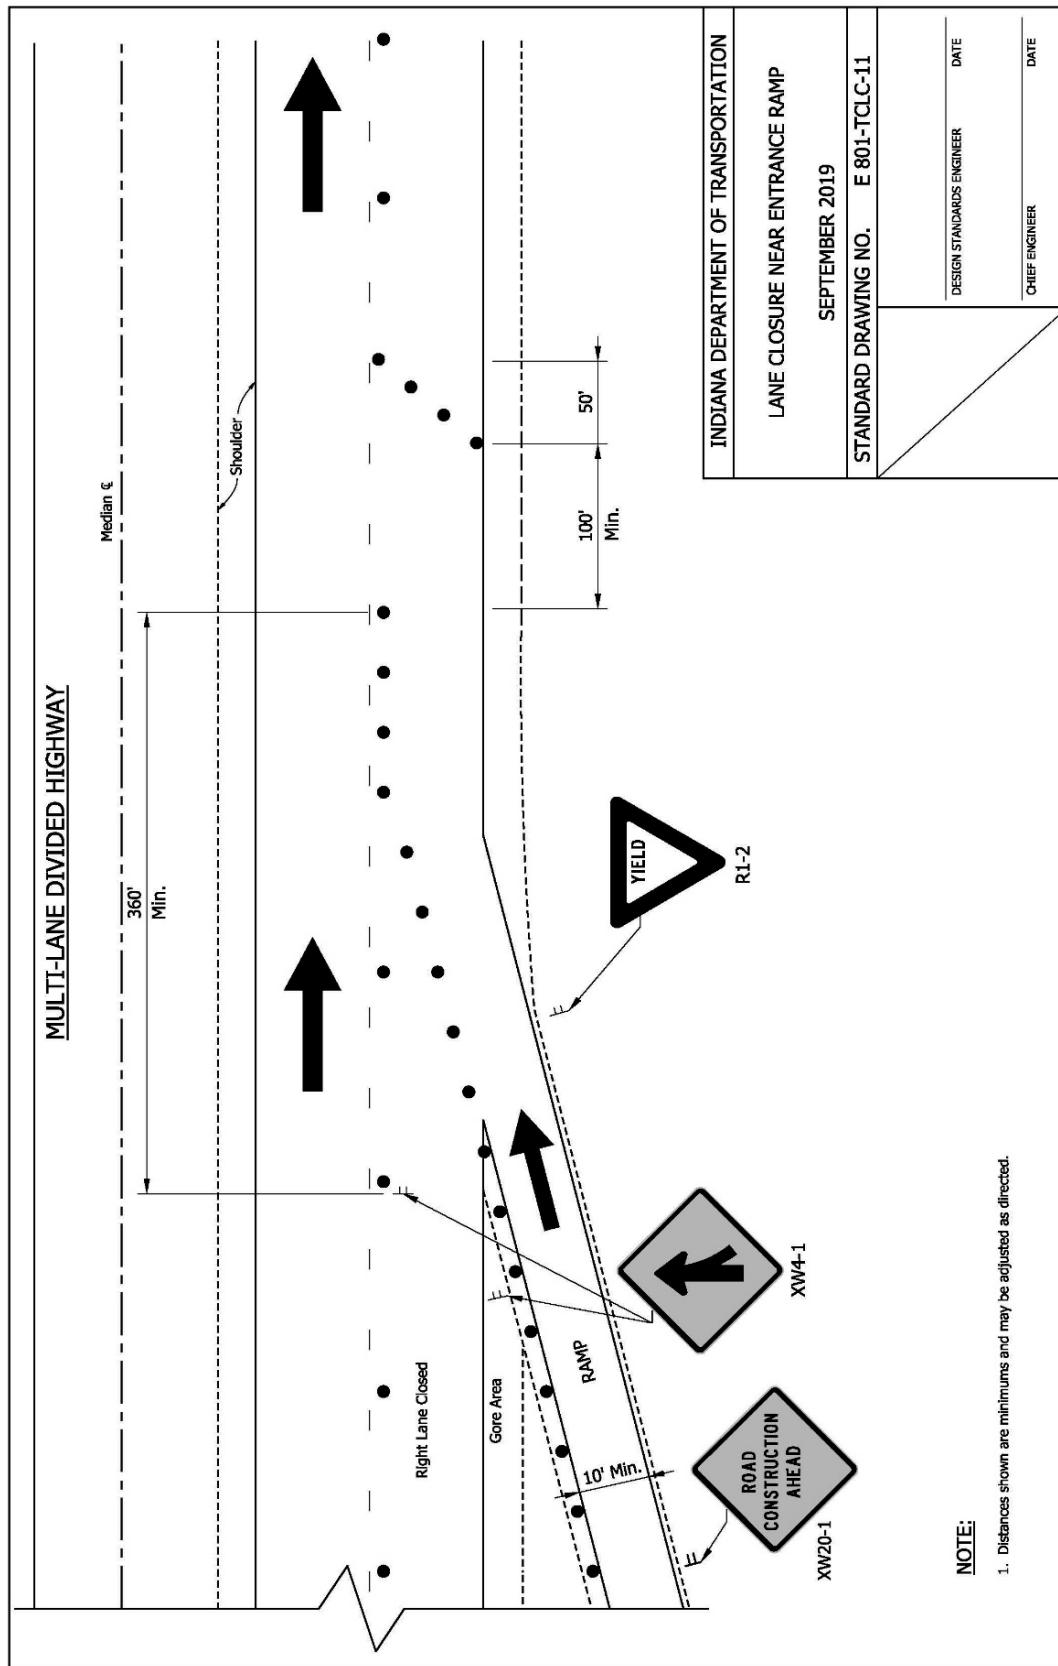


## REVISION TO STANDARD DRAWINGS

## E 801-TCMO-01 TRAFFIC CONTROL FOR MOBILE OPERATIONS ON A DIVIDED HIGHWAY (DRAFT)

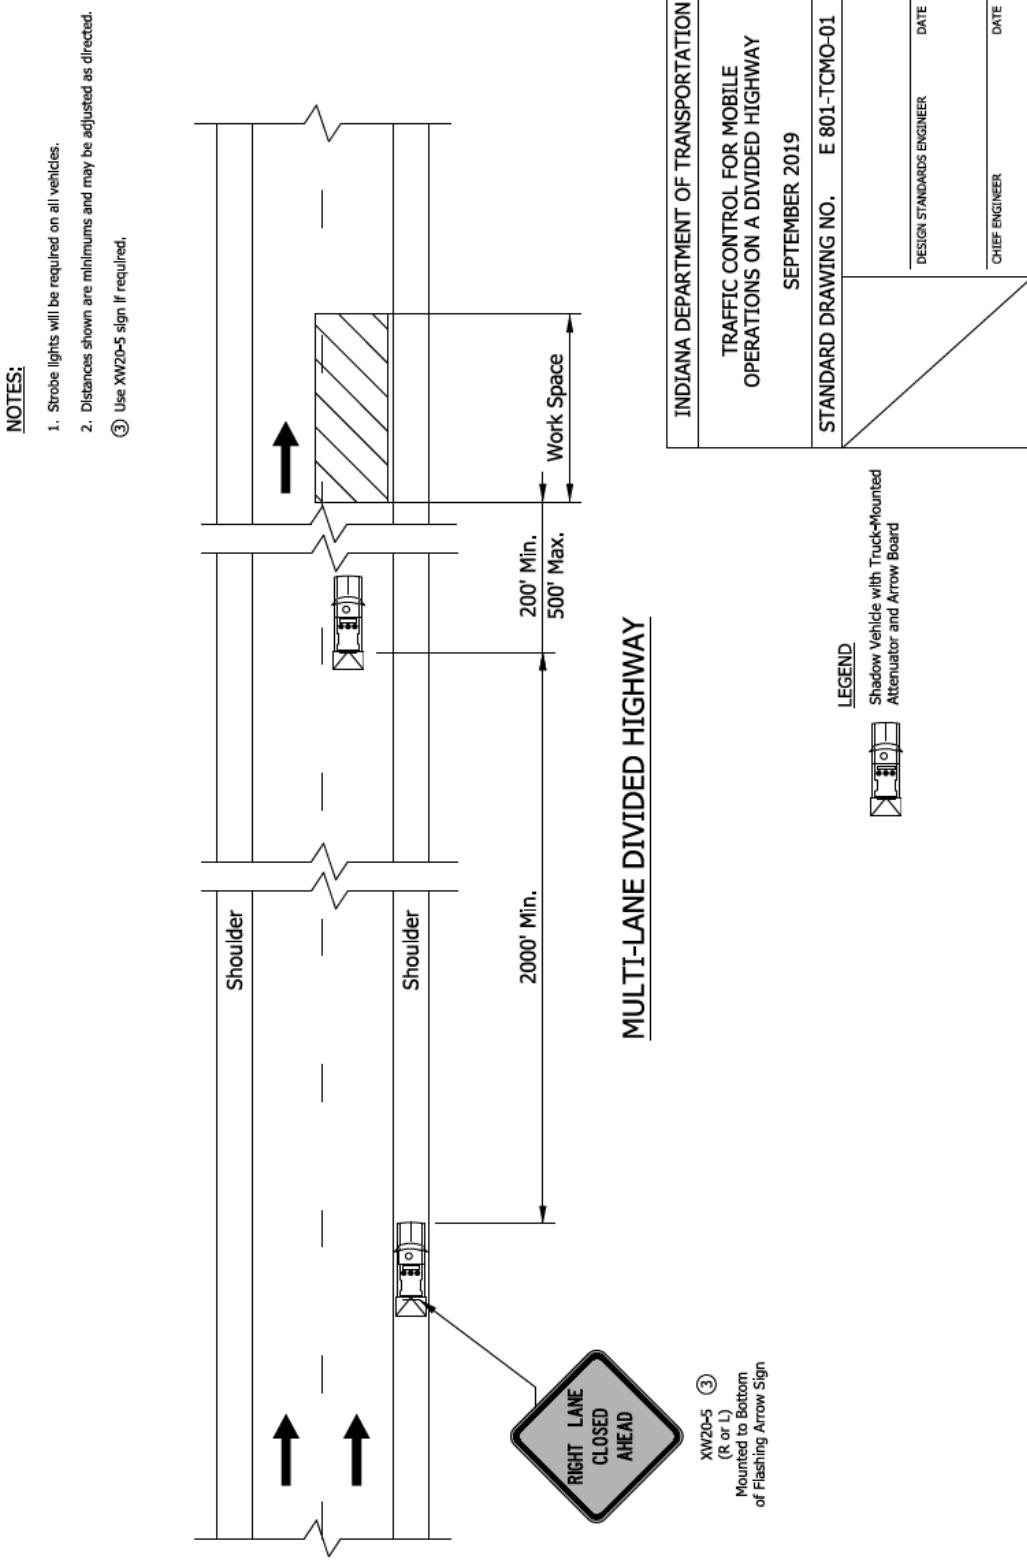

REVISION TO STANDARD DRAWINGS

E 801-TCMO-02 MAINTENANCE OF TRAFFIC FOR RPM REFLECTOR REPLACEMENT  
 (DRAFT)

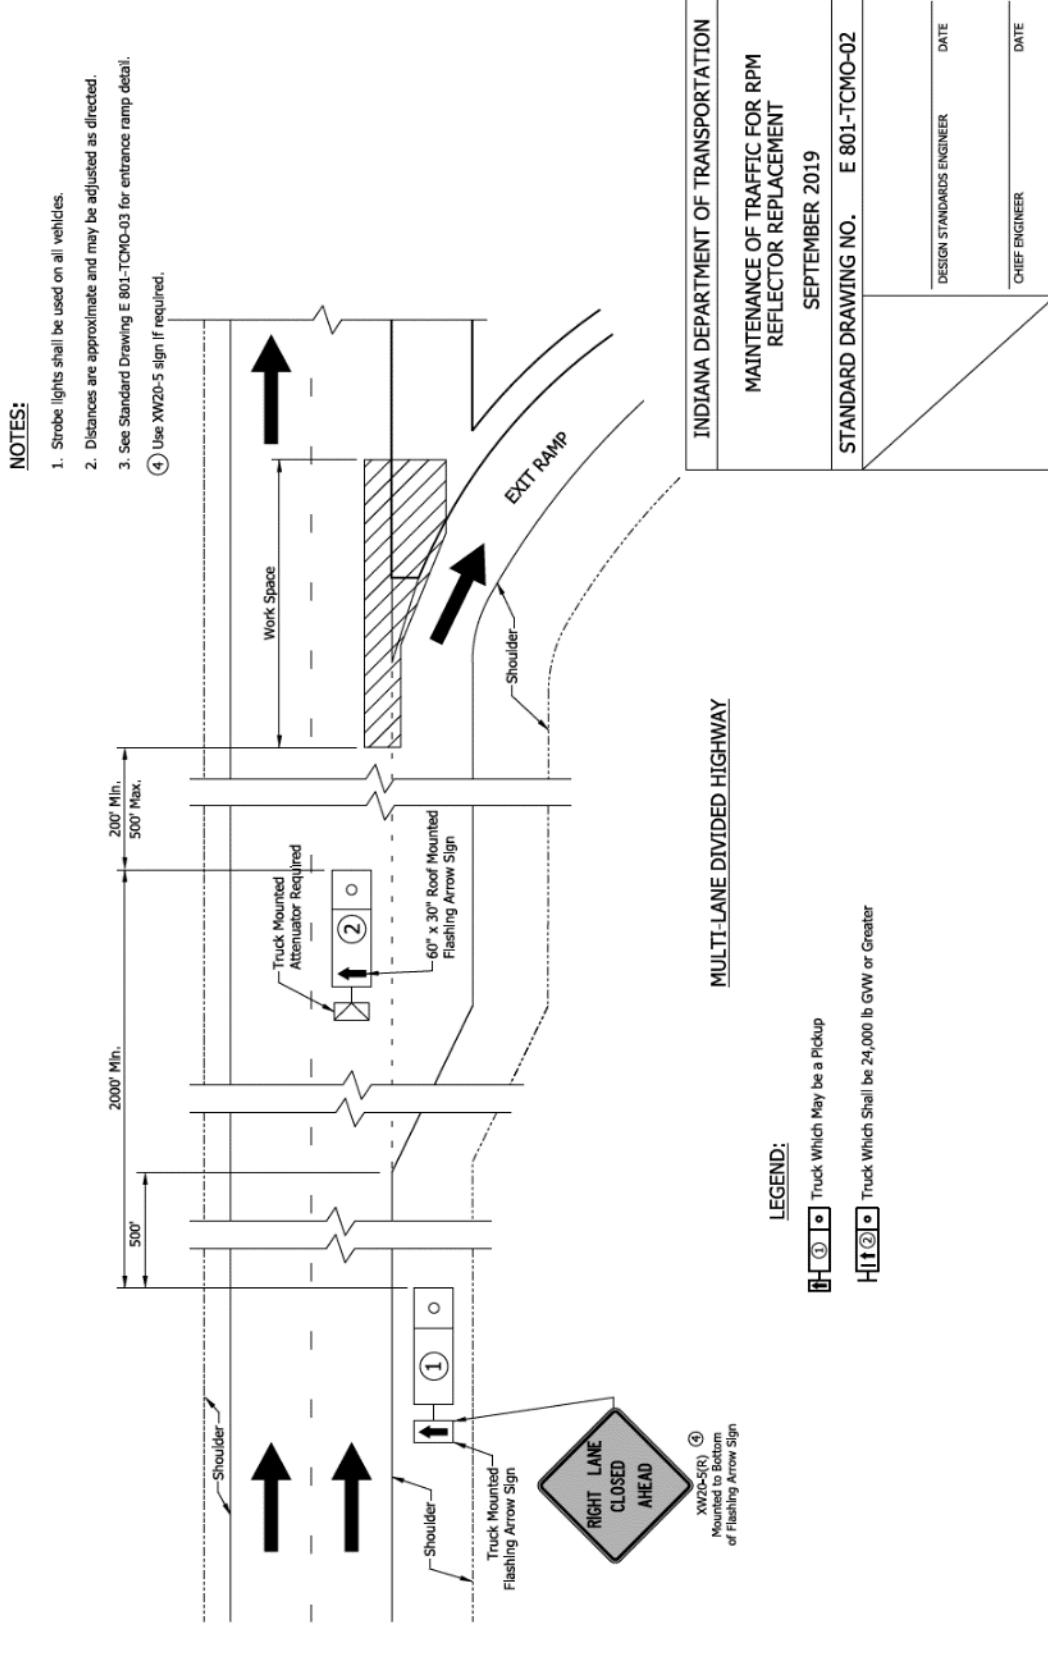


## REVISION TO STANDARD DRAWINGS

E 801-TCMO-03 MAINTENANCE OF TRAFFIC FOR RPM REFLECTOR REPLACEMENT  
(DRAFT)

## NOTES:

1. Strobe lights shall be used on all vehicles.
2. Distances shown are approximate and may be adjusted as directed.
3. See Standard Drawing E.801-TCMO-02 for exit ramp detail.
- ④ Use XW20-5 sign if required.

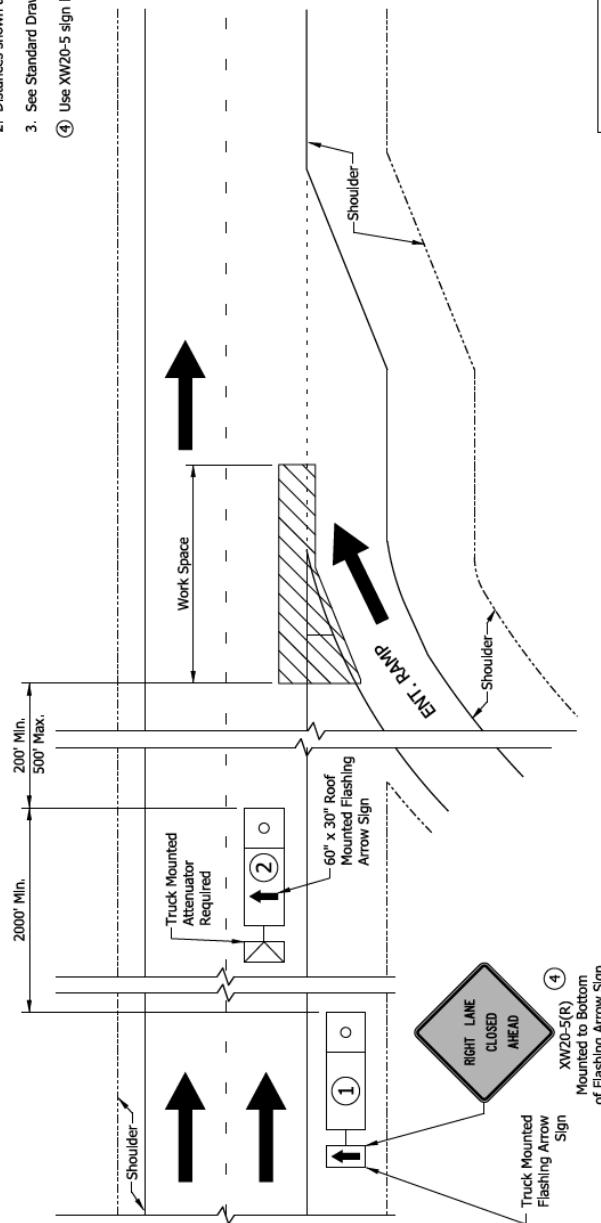

INDIANA DEPARTMENT OF TRANSPORTATION

MAINTENANCE OF TRAFFIC FOR  
RPM REFLECTOR REPLACEMENT

SEPTEMBER 2019

STANDARD DRAWING NO. E 801-TCMO-03

## LEGEND:


① □ Truck Which May be a Pickup

② □ Truck which shall be 24,000 lb GVM or greater

DESIGN STANDARDS ENGINEER	DATE
CHIEF ENGINEER	DATE

REVISION TO STANDARD DRAWINGS

E 801-TCSC-01 TRAFFIC CONTROL SHOULDER CLOSURE (DRAFT)

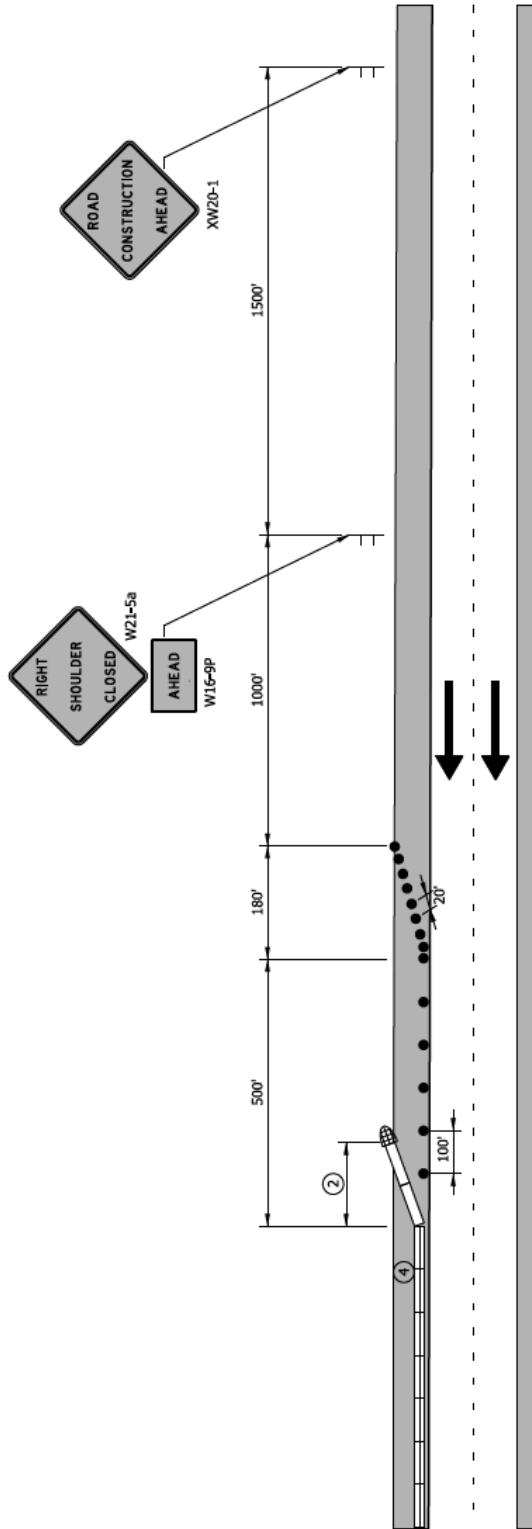

SHOULDER CLOSURE ON FREEWAY

NOTES:

1. All other applicable traffic control devices shall be utilized where appropriate in addition to those devices shown herein.
2. Flared temporary barrier or approved end treatment-flare rate 12:1 to edge of shoulder.
3. For general notes see Standard Drawing E 801-TCLG-01.
4. Drums may be used for freeway shoulder closures of 3 days or less.

LEGEND

- Temporary Traffic Barrier
- — Drums
- Sign
- — Direction of traffic
- Crash Cushion

INDIANA DEPARTMENT OF TRANSPORTATION


TRAFFIC CONTROL  
SHOULDER CLOSURE

SEPTEMBER 2019


STANDARD DRAWING NO. E 801-TCSC-01

DESIGN STANDARDS ENGINEER	DATE
CHIEF ENGINEER	DATE

## REVISION TO STANDARD DRAWINGS

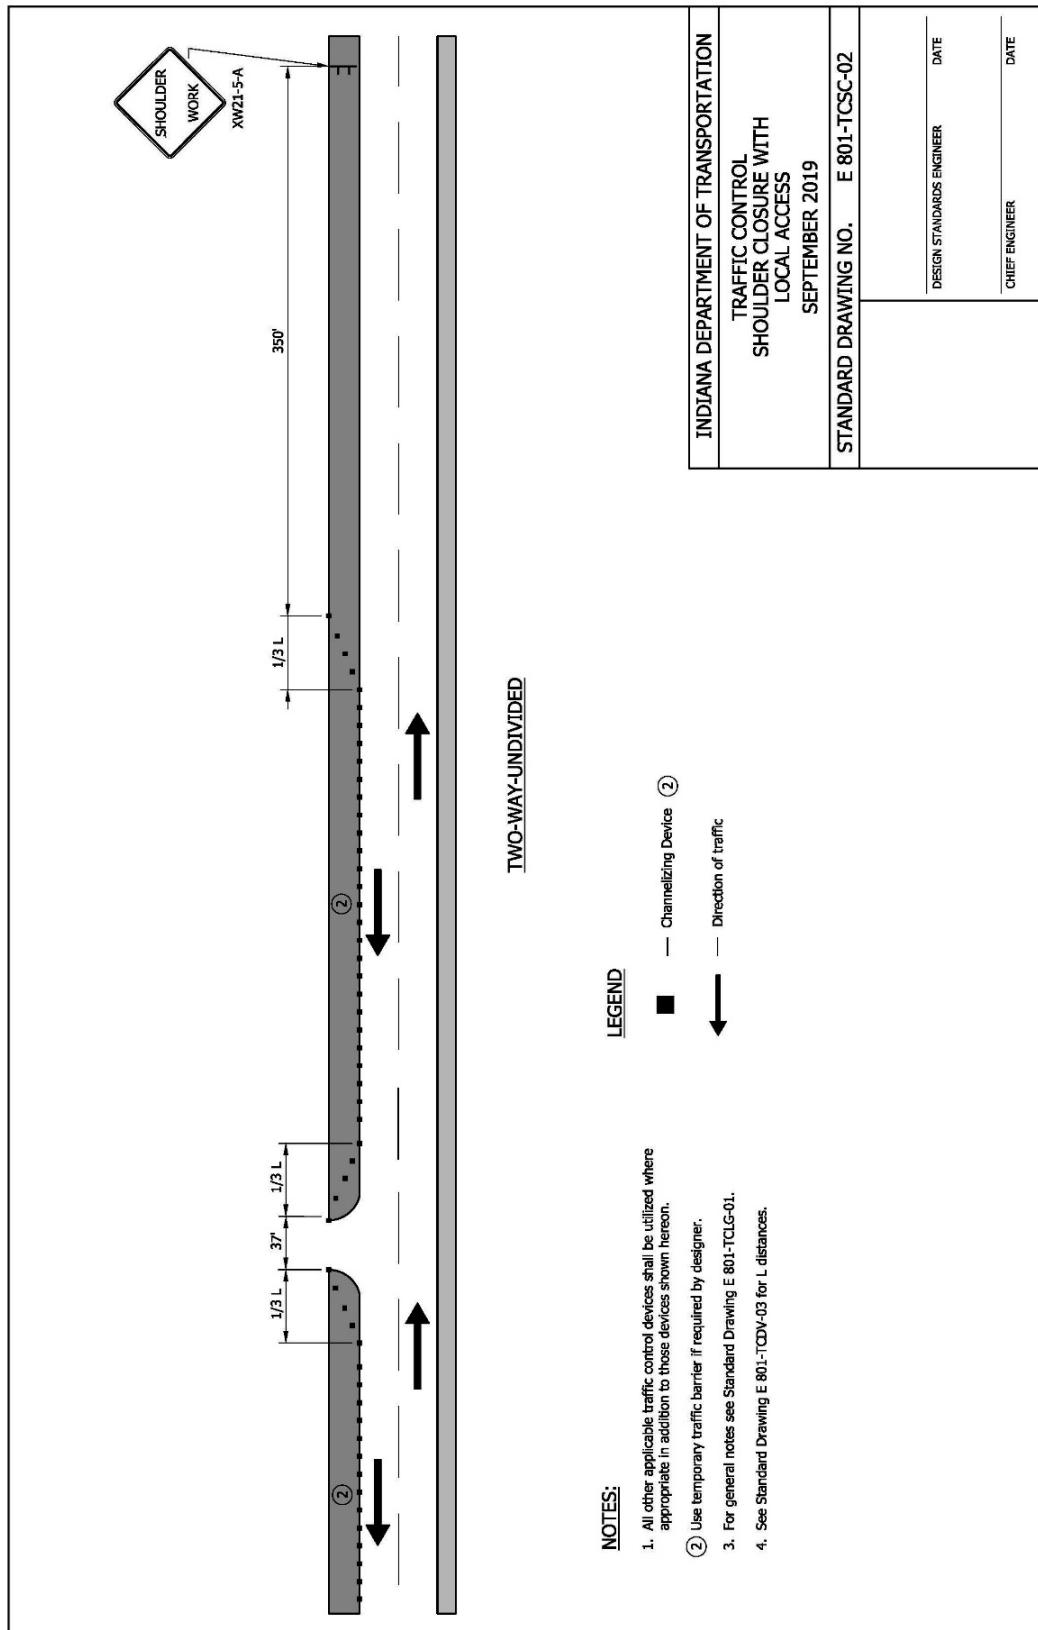E 801-TCSC-02 TRAFFIC CONTROL SHOULDER CLOSURE WITH LOCAL ACCESS  
(DRAFT)


## REVISION TO STANDARD DRAWINGS

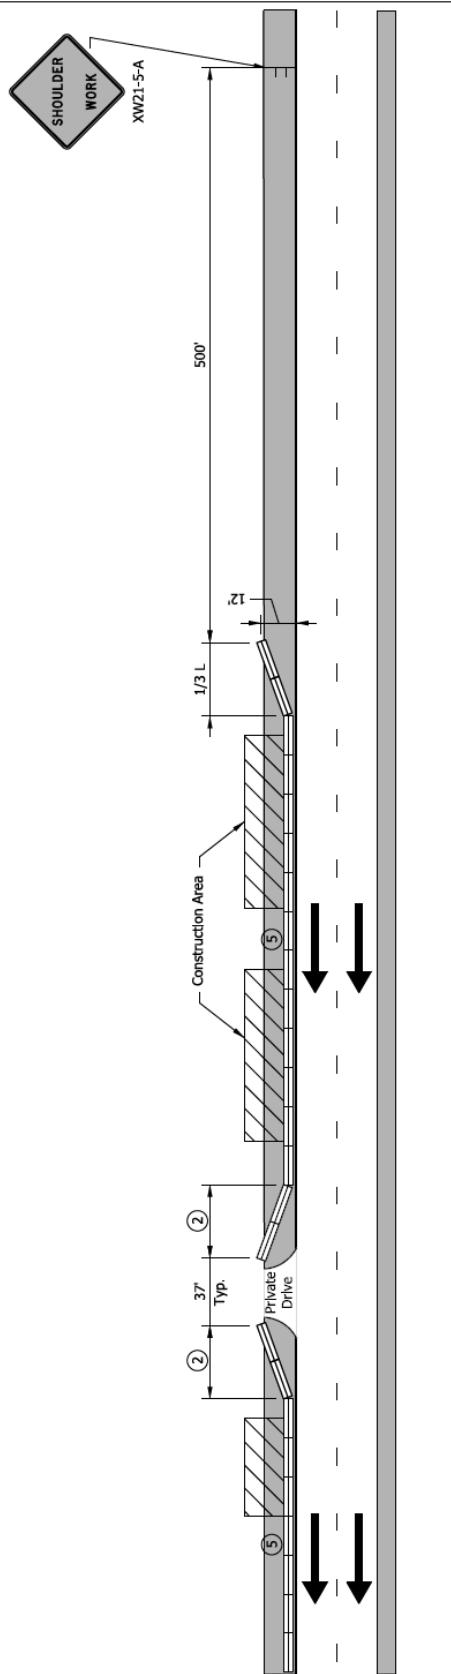E 801-TCSC-03 TRAFFIC CONTROL SHOULDER CLOSURE WITH LOCAL ACCESS  
(DRAFT)

## NOTES:

1. All other applicable traffic control devices shall be utilized where appropriate in addition to those devices shown hereon.
2. Flared temporary barrier or approved end treatment flare rate 12:1 to 12 ft from travel lane.
3. For general notes see Standard Drawing E 801-TCLG-01.
4. See Standard Drawing E 801-TCDV-03 for L distance.
5. Drums may be used for shoulder closures of 3 days or less.

## LEGEND

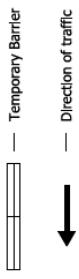

## INDIANA DEPARTMENT OF TRANSPORTATION

TRAFFIC CONTROL  
SHOULDER CLOSURE WITH  
LOCAL ACCESS  
SEPTEMBER 2019

STANDARD DRAWING NO. E 801-TCSC-03


DETAILS PLACED IN THIS FORMAT  
mm/dd/yy

DESIGN STANDARDS ENGINEER DATE

CHIEF ENGINEER DATE

## REVISION TO STANDARD DRAWINGS

E 801-TCSC-04 SHOULDER CLOSURE FOR ROADSIDE WORK (DRAFT)

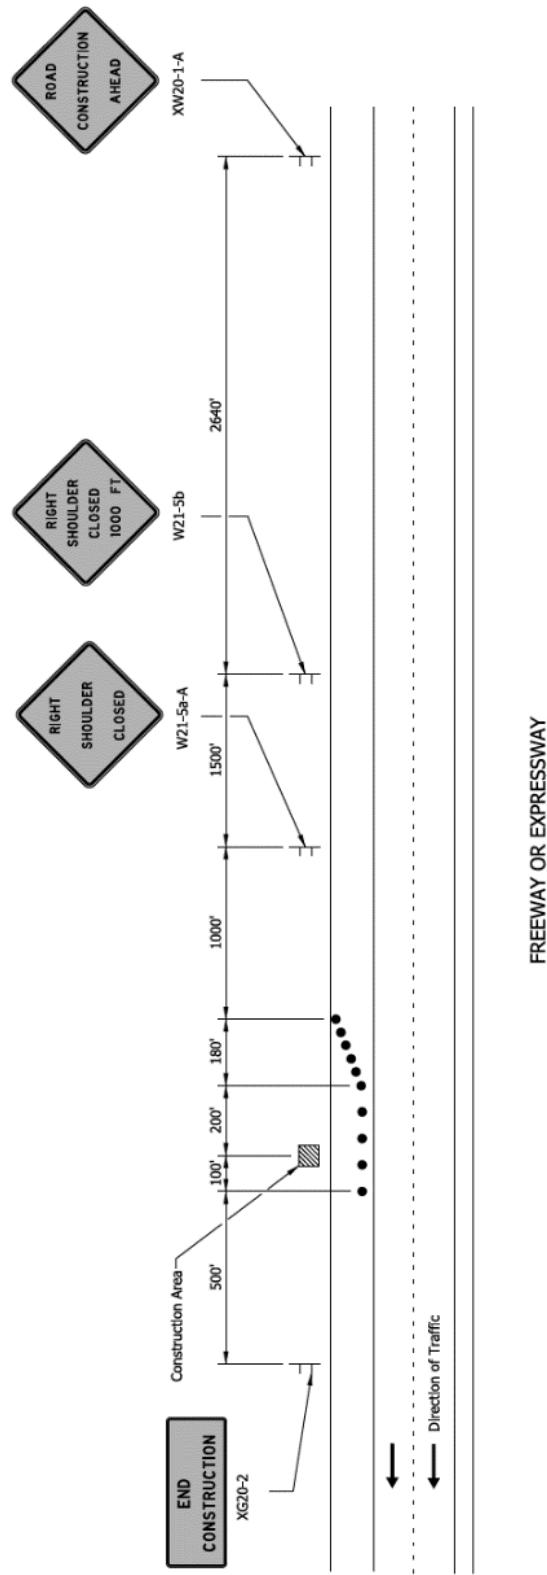

## FREWAY OR EXPRESSWAY

#### NOTES:

- 1.1. See Standard Drawing E 801-TCLG-01 for legend and general notes.
- 1.2. Temporary concrete barrier shall be used in place of drums for work that occupies a location for more than 3 days.

DESIGN STANDARDS ENGINEER \_\_\_\_\_ CHIEF ENGINEER \_\_\_\_\_ DATE \_\_\_\_\_ DATE \_\_\_\_\_


10

1. The first step is to identify the specific needs of the organization and the individuals involved in the change process.

1. *What is the relationship between the two concepts of the self?*

## REVISION TO STANDARD DRAWINGS

## E 801-TCTC-01 TEMPORARY CLOSURES OF A DIVIDED HIGHWAY (DRAFT)

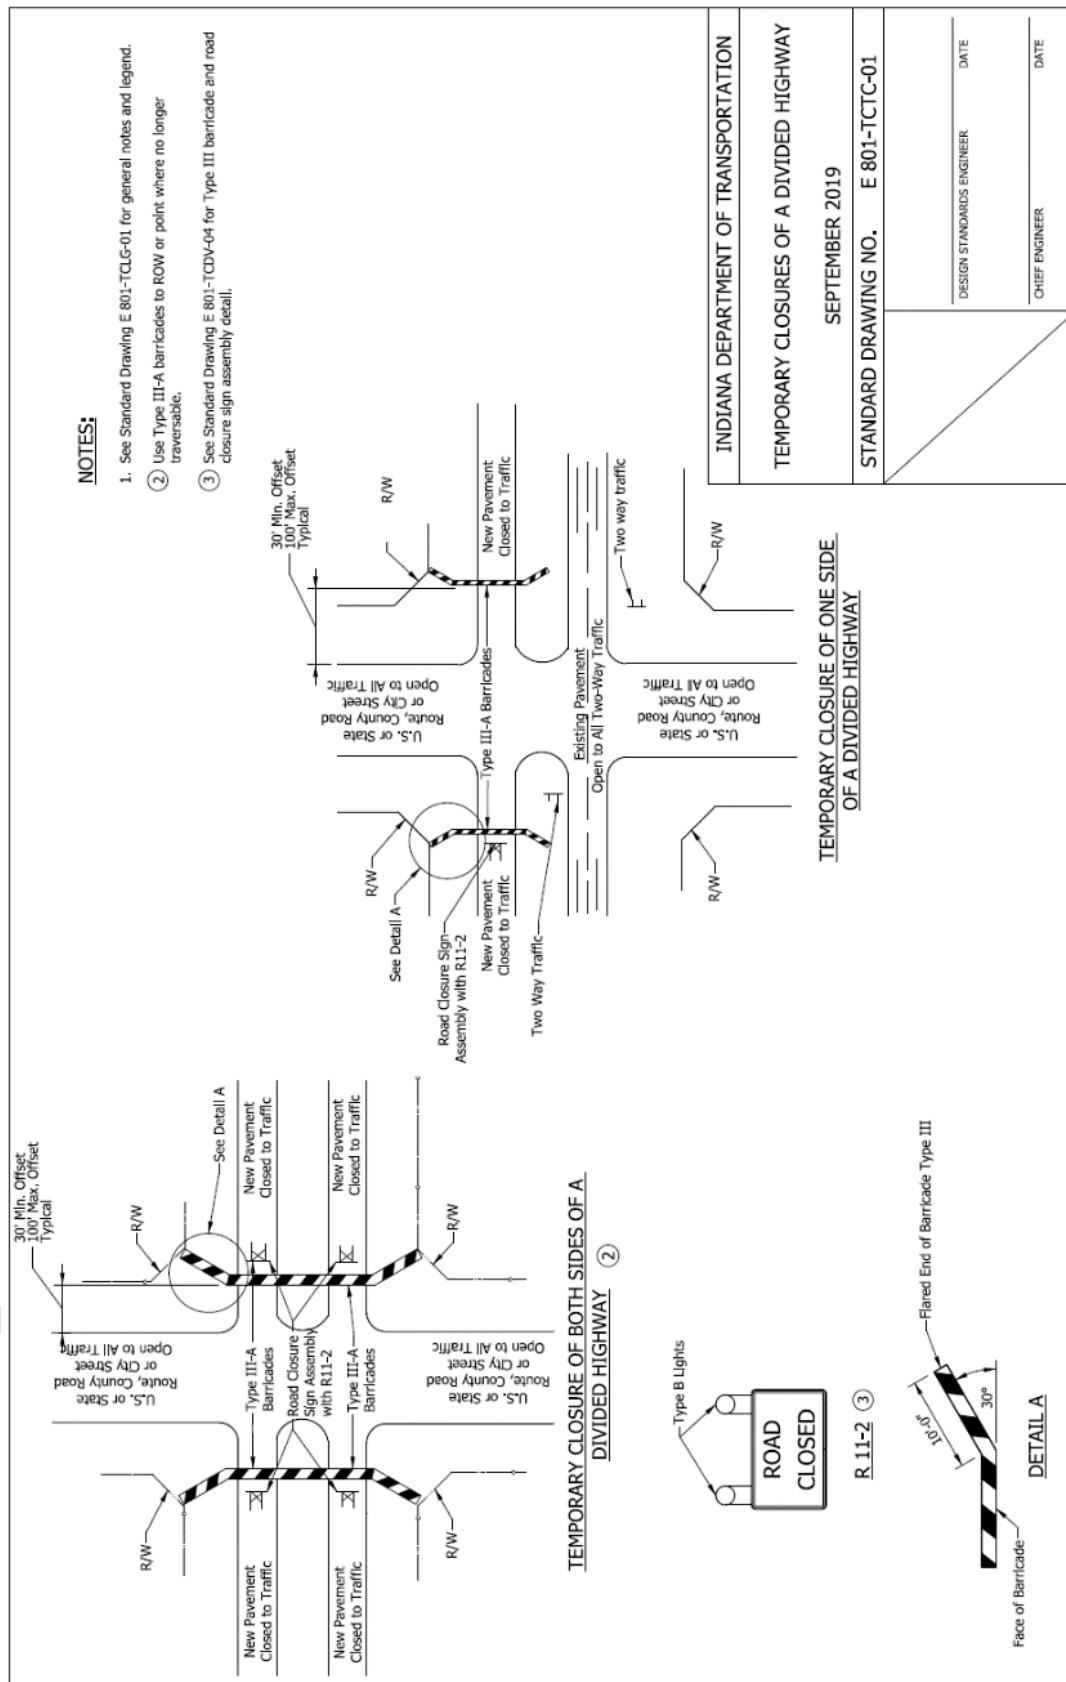


## REVISION TO STANDARD DRAWINGS


E 801-TCTC-02 TEMPORARY CLOSURES FOR PROJECT FOLLOWING COMPLETION OF  
GRADING PROJECT (DRAFT)

## NOTES:

1. See Standard Drawing E 801-TCLG-01 for general notes and legend.
2. See Standard Drawing E 603-FFTF series for farm field type fence detail.
- ③ See Standard Drawing E 801-TCDV-04 for Type III barricade and road closure sign assembly detail.

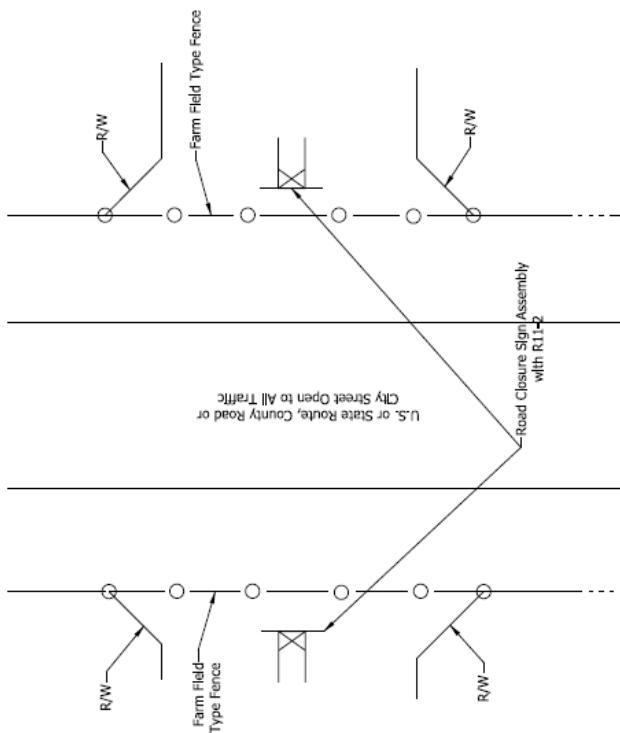

INDIANA DEPARTMENT OF TRANSPORTATION	
TEMPORARY CLOSURES FOR PROJECT FOLLOWING COMPLETION OF GRADING PROJECT	
SEPTEMBER 2019	
STANDARD DRAWING NO.	E 801-TCTC-02
DESIGN STANDARDS ENGINEER	DATE
CHIEF ENGINEER	DATE

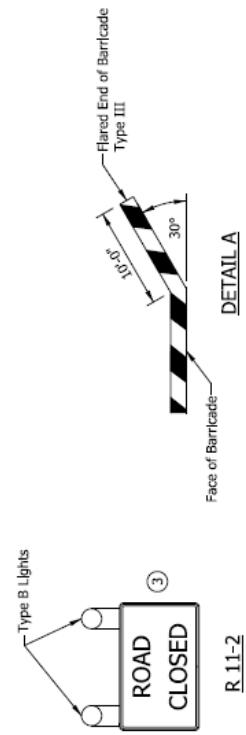

**COMMENTS AND ACTION**

---

801-TCCO  
 801-TCFO  
 801-TCLC  
 801-TCMO  
 801-TCSC  
 801-TCTC

**DISCUSSION:**

This item was introduced by Mr. Boruff and presented along with Mr. Bruno, who explained that the standard drawing series for temporary crossovers (801-TCCO), flagger operations (801-TCFO), lane closures (801-TCLC), shoulder closures (801-TCSC), and temporary closures (801-TCTC) have not been updated since the 2011 edition of the Indiana MUTCD was issued. Some of the series contain unnecessary sheets, duplicate sheets, or sheets that should be moved to another series. The flagger operations series should also be split into two series due to significant differences between stationary work and mobile operations.

Mr. Boruff proposes to revise and update those standard drawings and delete the standard drawing for temporary shoulders (801-TCTS). Mr. Boruff also proposed to implement a new series for mobile operations (801-TCMO). Mr. Bruno walked the group through the revisions shown.

Mr. Koch inquired about drums in the work zone. Mr. Bruno said that adjustments can be made for proper work space. Mr. Koch also addressed the center lane closures on freeways which causes concerns for workers and double lane closures which may cause issues for the public. Further concerns were presented by Mr. Kachler. Mr. Bruno responded that the Department's Work Zone Safety section and Industry requested these changes and suggested that a note be added referring the Contractor to the Interstate Highways Congestion Policy to address those concerns, and that there could be a minor lane shift. Mr. Pankow suggested a general plan sheet for the placement of the drums so that minor shifts are not in violation of the standard details. Mr. Boruff agreed.

Mr. Leckie mentioned using movable barriers, and Mr. Pankow stated that these things should be addressed by the designer. Mr. Goldner agreed with Mr. Pankow in that using barrels for center lane closures is dangerous to workers and motorists, and suggested that widening and barriers should be incorporated. Mr. Montgomery further concurred with that assessment.

Mr. Koch asked about the use of the mobile flaggers, and using LEO's also. Mr. Pankow agreed that LEO's are not necessary when flaggers are in place.

Mr. Koch asked about permanent removal of temporary crossovers, and if they could simply remain. Mr. Pankow responded that if left in place, it becomes a safety issue and we would need sufficient safeguards for the now unused pavement. Ms. Butcher addressed the safety and legal implications as well, stating that if left in place, motorists will still find a way to use it. Mr. Pankow stated that the future use of those crossovers are minimal and are often unknown, so leaving them in place could cause problems and that issue should be decided on a case by case discussion. Mr. Boruff agreed that those details will remain unrevised.

Other minor details were addressed and Mr. Bruno said those clarifications will be incorporated into the final draft of the drawings.

Mr. Pankow suggested making sure these drawings are made correct prior to approval, since further discussions may be necessary apart from this meeting. Mr. Koch agreed stating that the items discussed can be addressed and corrected and clean drawings can be submitted at the next meeting.

Mr. Bruno agreed to withdraw this item and incorporate all items discussed and bring them back to next month's meeting with the understanding that they can still become effective for September 2018 lettings, if approved.

**COMMENTS AND ACTION**

801-TCCO  
 801-TCFO  
 801-TCLC  
 801-TCMO  
 801-TCSC  
 801-TCTC

Following further discussion, Mr. Bruno agreed that TMA's can be omitted when the posted speed limit is 35 mph or less, and explained that the use of LEOs was requested by industry.

Motion: Mr. Boruff Second: Mr. Dave Ayes: Nays: FHWA Approval:	Action: <input type="checkbox"/> Passed as Submitted <input type="checkbox"/> Passed as Revised <input checked="" type="checkbox"/> Withdrawn
Standard Specifications Sections referenced and/or affected:	<input type="checkbox"/> 2020 Standard Specifications <input type="checkbox"/> Revise Pay Items List
801	
Recurring Special Provision affected:	<input type="checkbox"/> Create RSP (No. <u>      </u> ) <input type="checkbox"/> Effective <u>      </u> Letting <input type="checkbox"/> RSP Sunset Date:
NONE	
Standard Drawing affected:	<input type="checkbox"/> Revise RSP (No. <u>      </u> ) <input type="checkbox"/> Effective <u>      </u> Letting <input type="checkbox"/> RSP Sunset Date:
SEE PROPOSAL	
Design Manual Sections affected:	<input type="checkbox"/> Standard Drawing <input type="checkbox"/> Effective <u>      </u>
NONE	
GIFE Sections cross-references:	<input type="checkbox"/> Create RPD (No. <u>      </u> ) <input type="checkbox"/> Effective <u>      </u> Letting <input type="checkbox"/> GIFE Update <input type="checkbox"/> SiteManager Update
NONE	

STANDARD SPECIFICATIONS, SPECIAL PROVISIONS AND STANDARD DRAWINGS

REVISION TO STANDARD SPECIFICATIONS

PROPOSAL TO STANDARDS COMMITTEE

PROBLEM(S) ENCOUNTERED: The two most common methods to remove conflicting pavement markings in work zones are water blasting and grinding. Both methods have disadvantages as grinding can lead to pavement damage but water blasting does not fully remove durable marking materials. For work zone durations of 14 days or less, the benefit to removing the conflicting markings can be limited.

PROPOSED SOLUTION: Revise the standard specifications to allow the use black temporary tape to cover conflicting markings for work zone durations of 14 days or less.

APPLICABLE STANDARD SPECIFICATIONS: 801.12 and 923.01

APPLICABLE STANDARD DRAWINGS: No

APPLICABLE DESIGN MANUAL SECTION: 83-4.01(03)

APPLICABLE SECTION OF GIFE: 2.19.5 (see Traffic Control Example on pg. 2-38)

APPLICABLE RECURRING SPECIAL PROVISIONS: No

PAY ITEMS AFFECTED: No

APPLICABLE SUB-COMMITTEE ENDORSEMENT: Working group review by Andrew Blackburn, Dave Boruff, Ting Nahrwold, Dana Plattner, Mike Pelham, and industry representatives

IMPACT ANALYSIS (attach report): Yes, attached.

Submitted By: Joe Bruno on behalf of Dave Boruff

Title: Traffic Administration Engineer

Organization: INDOT

Phone Number: (317) 234-7949

Date: 3/29/18

[rev. 12/2014]

STANDARD SPECIFICATIONS, SPECIAL PROVISIONS AND STANDARD DRAWINGS  
REVISION TO STANDARD SPECIFICATIONS

IMPACT ANALYSIS REPORT CHECKLIST

Explain the business case as to why this item should be presented to the Standards Committee for approval. Answer the following questions with Yes, No or N/A.

Does this item appear in any other specification sections? No

Will approval of this item affect the Approved Materials List? Yes

Will this proposal improve:

Construction costs? Yes

Construction time? Yes

Customer satisfaction? Yes

Congestion/travel time? No

Ride quality? No

Will this proposal reduce operational costs or maintenance effort? Yes

Will this item improve safety:

For motorists? Yes

For construction workers? Yes

Will this proposal improve quality for:

Construction procedures/processes? Yes

Asset preservation? Yes

Design process? No

Will this change provide the contractor more flexibility? Yes

Will this proposal provide clarification for the Contractor and field personnel? Yes

Can this item improve/reduce the number of potential change orders? Yes

Is this proposal needed for compliance with:

Federal or State regulations? No

AASHTO or other design code? No

Is this item editorial? No

Provide any further information as to why this proposal should be placed on the Standards Committee meeting Agenda: N/A

REVISION TO SPECIAL PROVISIONS

801-T-XXX BLACK TEMPORARY TAPE (PROPOSED NEW)

801-T-XXX BLACK TEMPORARY TAPE

(Adopted XX-XX-XX)

The Standard Specifications are revised as follows:

SECTION 801, BEGIN LINE 569, INSERT AS FOLLOWS:

Where temporary pavement markings are to be placed on a pavement which has existing markings, the existing markings which conflict with the temporary markings shall be removed in accordance with 808.10. *On asphalt pavement, black temporary tape, Type I, may be used to cover conflicting markings for work zone durations of up to 14 days. If approved by the Engineer, the black temporary tape, Type I, may be extended past 14 days or replaced as needed. The black temporary tape shall be extend at least 1/2 in. beyond the edges of the marking to be covered. Overlapping of temporary tape will not be allowed.*

SECTION 801, BEGIN LINE 937, INSERT AS FOLLOWS:

Where temporary pavement markings are to be placed on a pavement which has existing markings, removal of the existing markings which conflict with the temporary markings will be measured in accordance with 808.12. *Where conflicting markings are covered with black temporary tape, Type I, the black temporary tape will be measured by the linear foot of markings covered.*

SECTION 801, BEGIN LINE 1017, INSERT AS FOLLOWS:

Where temporary pavement markings are to be placed on a pavement which has existing markings, removal of the existing markings which conflict with the temporary markings will be paid for in accordance with 808.13. *Where conflicting markings are covered with black temporary tape, Type I, the appropriate-specified width of black temporary tape will be paid for at the contract unit price per linear foot of temporary pavement marking, removable.*

SECTION 923, BEGIN LINE 3, INSERT AS FOLLOWS:

**923.01 Temporary Pavement Marking Tape**

Temporary pavement marking tape shall be furnished in ~~two~~<sup>three</sup> colors and two types. It shall consist of a white or yellow reflecting film on a conformable backing which is a minimum of 4 in. wide, and is designed for marking either asphalt or concrete pavements. *Black temporary pavement marking tape shall consist of a matte film on a conformable backing which is a minimum of 6 in. wide and is designed for marking asphalt pavement. The* White and yellow temporary pavement marking tape shall be in accordance with ASTM D 4592.

Type I tape shall be selected from the Department's list of approved Temporary Pavement Marking Tape, Type I. Temporary pavement marking tape type I will be placed and maintained on the Department's approved list in accordance with ITM 806, Procedure H.

Type I tape furnished under this specification shall be covered by a type C certification in accordance with 916.

Item No. 3 4/19/18 (2018 SS) (contd.)

Mr. Boruff

Date: 4/19/18

REVISION TO SPECIAL PROVISIONS

801-T-XXX BLACK TEMPORARY TAPE (PROPOSED NEW)

---

---

APPROVED MINUTES

BACKUP 1

---

IDM 83-4.01(03) TEMPORARY PAVEMENT MARKING TAPE (DRAFT)

(Note: Proposed changes shown highlighted gray)

### **83-4.01(03) Temporary Pavement-Marking Tape**

Temporary pavement-marking tape is an excellent material choice where there is a change to the traffic pattern during construction (e.g., crossover switch). Temporary tape can be easily and quickly installed and, if necessary, easily removed. Disadvantages of temporary tape are that it tends to move or break up under heavy traffic volume, and that it is not suitable for usage during the winter months. Temporary pavement-marking tape requires significant maintenance in comparison to temporary paint. The following describes the temporary pavement-marking tapes used by the Department.

1. Type I. Type I tape may be used as a temporary center line, lane line, or no-passing-zone line that is placed parallel to the normal pavement marking pattern, or as a temporary transverse marking or pavement-message marking. It should also be used where pavement markings are placed at an angle to the normal pavement-marking pattern (e.g., taper for lane closure, lane shift). Type I tape is a removable type of temporary pavement marking. *When black Type I tape is used to cover conflicting markings, the width specified should be at least 1 in. wider than the existing marking to be covered.*
2. Type II. Type II tape is used on a pavement which is expected to be removed or covered by additional pavement courses. It may be used as a center line, lane line, or edge line that is parallel to the normal pavement markings. It also may be used as a center line or lane line on a resurfacing overlay course. Type II tape is a non-removable type of temporary pavement marking.

BACKUP 2

DESIGN MEMORANDUM (DRAFT)



## INDIANA DEPARTMENT OF TRANSPORTATION

*Driving Indiana's Economic Growth*

### Design Memorandum No. 18- Technical Advisory

May 7, 2018

**TO:** All Design, Operations, and District Personnel, and  
Consultants

**FROM:** /s/David H. Boruff  
David H. Boruff  
Manager, Office of Traffic Administration  
Traffic Engineering Division

**SUBJECT:** Covering Conflicting Markings

**REVISES:** *Indiana Design Manual Section 83-4.01(03)*

**EFFECTIVE:** December 1, 2018

On asphalt pavements, an option has been created to allow the use of removable black temporary tape to cover conflicting markings. The option is intended for work zone durations of up to 14 days. The black temporary tape must be at least 6 inches in width, or at least 1 inch wider than the marking to be covered, whichever is greater.

When there are conflicting markings on asphalt pavement and the estimated work zone duration is 14 days or less, designers should include a pay item for the appropriate width of temporary tape, Type I, in the contract documents. Questions regarding the use of black temporary tape to cover conflicting markings should be directed to Dave Boruff, the Manager of the Office of Traffic Administration, at [dboruff@indot.in.gov](mailto:dboruff@indot.in.gov).

## BACKUP 3

---

OHIO DOT SPECIFICATION (EXCERPT)

**G. Conflicting Markings.** Conflicting markings are considered to be any markings not actively in use, not behind channelizing devices or portable barrier and/or could be misinterpreted by the traveling public or cause confusion to the driver as determined by the engineer. Before placing work zone markings, remove or cover all conflicting existing markings visible to the traveling public.

1. Removal and Covering of Markings.

a. **Removal Methods.** Remove the markings so that less than 5% of the line remains visible. Repair damage to the pavement that results in the removal of more than 1/8 inch of pavement thickness. Use sand, shot, or water blasting to remove markings on all asphalt or concrete pavement surfaces. Use only sand, shot, or water blasting for removal of all pavement markings in preparation for placing Item 422 Chip Seal or Item 421 Microsurfacing. A grinder may only be used to remove markings on temporary pavement or pavement that will be covered or removed prior to project completion (e.g., intermediate asphalt course). When a grinder drum is mounted to a skid steer loader, the drum must be able to accommodate a minimum of 150 teeth.

b. **Covering Conflicting Markings.** With the Engineer's approval, use removable, non-reflective, preformed blackout tape to cover conflicting markings. Remove or replace the blackout tape within 15 days of installation. Furnish products according to the Departments Qualified Products List (QPL).

2. **Raised Pavement Markers.** Remove the prismatic retro-reflector within any raised pavement marker that is in conflict with the work zone pavement markings. When the work zone pavement markings are removed and the raised pavement marker is no longer in conflict, thoroughly clean the recessed reflector attachment area of the casting and install a new prismatic retro-reflector of the same kind and color. The cost for this work is incidental to the various pay items.

**H. Allowable Duration of Work Zone Markings.**

1. **No Passing Zones.** When existing permanent no-passing-zone markings are removed or obliterated as the result of a construction operation (pavement grinding, asphalt concrete pavement overlays, etc.) and the section of pavement continues to be used by the traveling public, place Class I Center Line Markings or final center line markings as specified by the plan within 3 Calendar Days unless thermoplastic, spray thermoplastic or epoxy final markings are to be applied on the surface course. If thermoplastic, spray thermoplastic or epoxy final markings are to be applied on the surface course, place Class III Center Line Markings or final center line markings as specified in the plan within 3 Calendar Days.

a. **Subsequent Work in No Passing Zones.** If, after the original markings are removed or obliterated, the Contractor returns to the subject no passing zone and places a plan-specified pavement course within the 3-Calendar Day limit, or performs work in preparation for a subsequent pavement course, the Contractor shall have temporarily satisfied the conditions of the previous paragraph. In this event, the 3-Calendar Day limit will begin again.

b. **Liquidated Damages.** For each Calendar Day beyond 3 days that this work remains incomplete, the Department will assess liquidated damages in the amount of \$1000 per Calendar Day. The Department will treat the time for the completion of no-passing-zone markings as an interim Completion Date.

2. **Passing Zones.** Sections of pavement where passing is permitted in both directions must be marked with Class I Center Line Markings or final center line markings as specified by the plan within 14 Calendar Days unless thermoplastic, spray thermoplastic or epoxy final markings are to be applied on the surface course. If thermoplastic, spray thermoplastic or epoxy final markings are to be applied on the surface course, place Class III Center Line Markings or final center line markings as specified in the plan within 14 Calendar Days.

3. **Allowable Duration of Class II Lane Lines and Gore Markings and Absence of Edge lines.** Any time existing permanent lane lines, gore markings, or edge lines have been removed or obliterated as the result of a construction operation (pavement grinding, asphalt pavement overlays, pavement widening, etc.) and the section of pavement continues to be used by the traveling public, place Class I Markings or final markings as specified by the plan within 14 Calendar Days unless thermoplastic, spray thermoplastic or epoxy final markings are to be applied on the surface course. If thermoplastic, spray thermoplastic or epoxy final markings are to be applied on the surface course, place Class III Markings or final markings as specified in the plan within 14 Calendar Days.

COMMENTS AND ACTION

801-T-XXX BLACK TEMPORARY TAPE

DISCUSSION:

Mr. Boruff introduced and presented this item stating that the two most common methods to remove conflicting pavement markings in work zones are water blasting and grinding. Both methods have disadvantages as grinding can lead to pavement damage and water blasting does not fully remove durable marking materials. For work zone durations of 14 days or less, the benefit to removing the conflicting markings can be limited. Mr. Boruff proposed to revise the standard specifications to allow the use black temporary tape to cover conflicting markings for work zone durations of 14 days or less.

Mr. Koch asked if we should also consider concrete pavements. Mr. Bruno answered that they'd like to start with asphalt pavements and will consider it for concrete in the future. Mr. Koch also asked about the language "replaced as needed" and Mr. Bruno stated that it is intended to allow the Contractor to replace worn out tape at the end of the 14 days if approved. Mr. Koch further mentioned that 801.18 deals with the cost of replacing temporary markings and believes the new language adds ambiguity and may not be necessary. The 14 day language was removed. Revisions are as shown.

Mr. Koch mentioned that, other than crosswalks, we typically have 4 in. temporary markings and this proposal could result in change orders if black tape is approved. Mr. Bruno responded that design guidance is proposed in IDM 83-4.01(03), above. Mr. Koch also suggested the language added in the basis of payment be clarified in the method of measurement also, and that the additional width be included in the cost. Mr. Bruno agreed and the revisions are as shown highlighted above.

Motion: Mr. Boruff Second: Mr. Dave Ayes: 8 Nays: 0 FHWA Approval: <u>YES</u>	Action:  <input type="checkbox"/> Passed as Submitted <input checked="" type="checkbox"/> Passed as Revised <input type="checkbox"/> Withdrawn
Standard Specifications Sections referenced and/or affected:  801 pg 763; 801 pg 773; 923 pg 1084.	<input checked="" type="checkbox"/> 2020 Standard Specifications  <input type="checkbox"/> Revise Pay Items List
Recurring Special Provision affected:  PROPOSED NEW	<input checked="" type="checkbox"/> Create RSP (No. <u>801-T-221</u> ) Effective <u>Dec. 01, 2018</u> Letting RSP Sunset Date: <u>2020 book</u>
Standard Drawing affected:  NONE	<input type="checkbox"/> Revise RSP (No. <u>      </u> ) Effective <u>      </u> Letting RSP Sunset Date: <u>      </u>
Design Manual Sections affected:  83-4	<input type="checkbox"/> Standard Drawing Effective  <input type="checkbox"/> Create RPD (No. <u>      </u> ) Effective <u>      </u> Letting
GIFE Sections cross-references:  2.19	<input type="checkbox"/> GIFE Update  <input type="checkbox"/> SiteManager Update

STANDARD SPECIFICATIONS, SPECIAL PROVISIONS AND STANDARD DRAWINGS  
REVISION TO STANDARD SPECIFICATIONS

PROPOSAL TO STANDARDS COMMITTEE

PROBLEM(S) ENCOUNTERED: When determining bulk specific gravity, SMA specs still require AASHTO T 275 (Paraffin) to be used when the percent water absorbed exceeds 2.0. Recently the 401 and 402 specs have been changed to AASHTO T 331 (Corelok). There are also a few other minor edits that were made in the 401 section that should be made in the 410 section.

PROPOSED SOLUTION: Revise language in 410 to require AASHTO T 331 for testing consistency and match revisions in the 401 section.

APPLICABLE STANDARD SPECIFICATIONS: 410

APPLICABLE STANDARD DRAWINGS: N/A

APPLICABLE DESIGN MANUAL SECTION: N/A

APPLICABLE SECTION OF GIFE: N/A

APPLICABLE RECURRING SPECIAL PROVISIONS: N/A

PAY ITEMS AFFECTED: N/A

APPLICABLE SUB-COMMITTEE ENDORSEMENT: N/A

IMPACT ANALYSIS (attach report):

Submitted By: Matt Beeson

Title: State Materials Engineer

Organization: INDOT

Phone Number: 317-610-7251 x204

Date: 4/4/18

STANDARD SPECIFICATIONS, SPECIAL PROVISIONS AND STANDARD DRAWINGS  
REVISION TO STANDARD SPECIFICATIONS

IMPACT ANALYSIS REPORT CHECKLIST

*Explain the business case as to why this item should be presented to the Standards Committee for approval.  
Answer the following questions with Yes, No or N/A.*

Does this item appear in any other specification sections? N

Will approval of this item affect the Approved Materials List? N

Will this proposal improve:

Construction costs? N

Construction time? N

Customer satisfaction? N

Congestion/travel time? N

Ride quality? N

Will this proposal reduce operational costs or maintenance effort? N

Will this item improve safety:

For motorists? N

For construction workers? N

Will this proposal improve quality for:

Construction procedures/processes? N

Asset preservation? Y

Design process? N

Will this change provide the contractor more flexibility? N

Will this proposal provide clarification for the Contractor and field personnel? Y

Can this item improve/reduce the number of potential change orders? N

Is this proposal needed for compliance with:

Federal or State regulations? N

AASHTO or other design code? N

Is this item editorial? N

Provide any further information as to why this proposal should be placed on the Standards Committee meeting Agenda:

**REVISION TO STANDARD SPECIFICATIONS**

---

SECTION 410 - QUALITY CONTROL/QUALITY ASSURANCE, QC/QA, HMA - SMA  
PAVEMENT

410.05 SMA MIX DESIGN

410.16 DENSITY

410.20(c) BSG OF THE DENSITY CORE

The Standard Specifications are revised as follows:

SECTION 410, BEGIN LINE 94, DELETE AS FOLLOWS:

A change in the source or types of aggregates, change in source or type of stabilizing additives, or a change in the source of the specified binder shall require a new DMF. ~~A new DMF shall be submitted to the District Testing Engineer for approval one week prior to use.~~

SECTION 410, BEGIN LINE 346, INSERT AS FOLLOWS:

The Contractor shall obtain cores in the presence of the Engineer with a device that shall produce a uniform  $6.00 \pm 0.25$  in. diameter pavement sample. Surface courses shall be cored within one work day of placement. Damaged core shall be discarded and replaced with a core from a location selected by adding 1 ft to the longitudinal location of the damaged core using the same transverse offset.

SECTION 410, BEGIN LINE 370, DELETE AND INSERT AS FOLLOWS:

The density of the mixture will be expressed as the percentage of maximum specific gravity, %MSG, obtained by dividing the average bulk specific gravity by the maximum specific gravity for the subplot, times 100. Samples for the bulk specific gravity and maximum specific gravity will be dried in accordance with ITM 572. The Engineer will determine the bulk specific gravity of the cores in accordance with AASHTO T 166, Method A or AASHTO T 275331, if required. The maximum specific gravity will be mass determined in water in accordance with AASHTO T 209. The target value for density of SMA mixtures of each subplot shall be 93.0%.

SECTION 410, BEGIN LINE 489, DELETE AND INSERT AS FOLLOWS:

**(c) BSG of the Density Core**

Cores shall be taken within seven calendar days unless otherwise directed. Additional core locations will be determined by adding 1 ft longitudinally of the cores tested using the same transverse offset. The cores will be dried in accordance with ITM 572 and tested in accordance with AASHTO T 166, Method A or AASHTO T 275331, if required. The Contractor shall clean, dry, and refill the core holes with SMA or HMA surface materials within one work day of the coring operations.

**COMMENTS AND ACTION**

410.05 SMA MIX DESIGN

410.16 DENSITY

410.20(c) BSG OF THE DENSITY CORE

**DISCUSSION:**

This item was introduced and presented by Mr. Beeson who stated that when determining bulk specific gravity, SMA specs still require AASHTO T 275, Paraffin, to be used when the percent water absorbed exceeds 2.0. Recently the 401 and 402 specs have been changed to AASHTO T 331, Corelok. There are also a few other minor edits that were made in the 401 section that should be made in the 410 section.

Mr. Beeson therefore proposes to revise language in 410 to require AASHTO T 331 for testing consistency and match revisions in the 401 section.

There were no questions or discussion and this item passed as submitted.

Motion: Mr. Beeson Second: Mr. Pankow Ayes: 8 Nays: 0 FHWA Approval: <u>YES</u>	Action:  <input checked="" type="checkbox"/> Passed as Submitted <input type="checkbox"/> Passed as Revised <input type="checkbox"/> Withdrawn
Standard Specifications Sections referenced and/or affected:  410 pg 311, 316, 320.	<input checked="" type="checkbox"/> 2020 Standard Specifications <input type="checkbox"/> Revise Pay Items List
Recurring Special Provision affected:  NONE	<input checked="" type="checkbox"/> Create RSP (No. <u>410-R-677</u> ) Effective <u>Sept. 01, 2018</u> Letting RSP Sunset Date: <u>2020 SS Book</u>
Standard Drawing affected:  NONE	<input type="checkbox"/> Revise RSP (No. <u>      </u> ) Effective <u>      </u> Letting RSP Sunset Date:
Design Manual Sections affected:  NONE	<input type="checkbox"/> Standard Drawing Effective
GIFE Sections cross-references:  NONE	<input type="checkbox"/> Create RPD (No. <u>      </u> ) Effective <u>      </u> Letting <input type="checkbox"/> GIFE Update <input checked="" type="checkbox"/> SiteManager Update

STANDARD SPECIFICATIONS, SPECIAL PROVISIONS AND STANDARD DRAWINGS

REVISION TO STANDARD SPECIFICATIONS

PROPOSAL TO STANDARDS COMMITTEE

PROBLEM(S) ENCOUNTERED:

Mix workability is an ongoing struggle for applications that involve concrete delivered via ready mix trucks. INDOT specifications generally limit slump to four inches, but contractors prefer a slump of approximately five inches to ease placement and finishing. Contractors typically add water to the mix on-site in order to improve the workability. However, adding water after batching is high risk to INDOT since it increases the water-cement ratio of the batch which may exceed the specification limit resulting in poor durability and can also create non-uniform mixtures. Sprinkling water to the surface of concrete for finishing is also highly detrimental because it significantly increases the water-cement ratio which creates a much less durable wearing surface and promotes scaling. The current slump restrictions promote conflict at the jobsite to police the addition of water to both the delivery truck and to the surface of the plastic concrete for finishing. However, it is extremely difficult for INDOT project personnel to continuously monitor and control the addition of water.

PROPOSED SOLUTION:

There is nothing inherently detrimental about using properly designed concrete mixes with moderately higher slump than is currently allowed by the specification. Ready mix concrete suppliers have the ability to chemically modify concrete slump with admixtures. This does not increase the water-cement ratio, but improves workability and finishability. Increasing the allowable slump will permit mix producers to properly design and supply mixes that are workable as delivered. This will dramatically reduce the contractor's incentive to modify the mixes at the jobsite by adding water.

APPLICABLE STANDARD SPECIFICATIONS: 502.04(a), 502.04(b), 702.07, 702.12

APPLICABLE STANDARD DRAWINGS: none

APPLICABLE DESIGN MANUAL SECTION: none

APPLICABLE SECTION OF GIFE: Various. (Section 4.7 needs revised to show 1" to 6" range)

APPLICABLE RECURRING SPECIAL PROVISIONS: none

PAY ITEMS AFFECTED: none

Mr. Beeson  
Date: 4/19/18

STANDARD SPECIFICATIONS, SPECIAL PROVISIONS AND STANDARD DRAWINGS  
REVISION TO STANDARD SPECIFICATIONS

(CONTINUED)

APPLICABLE SUB-COMMITTEE ENDORSEMENT: INDOT-IRMCA working committee  
1/17/18

IMPACT ANALYSIS (attach report):

Submitted By: Matt Beeson

Title: State Materials Engineer

Organization: INDOT Office of Materials Management

Phone Number: 317-610-7251 x 204

Date: 3/6/18

STANDARD SPECIFICATIONS, SPECIAL PROVISIONS AND STANDARD DRAWINGS  
REVISION TO STANDARD SPECIFICATIONS

IMPACT ANALYSIS REPORT CHECKLIST

*Explain the business case as to why this item should be presented to the Standards Committee for approval.  
Answer the following questions with Yes, No or N/A.*

Does this item appear in any other specification sections? No

Will approval of this item affect the Approved Materials List? No

Will this proposal improve:

Construction costs? No

Construction time? N/A

Customer satisfaction? N/A

Congestion/travel time? N/A

Ride quality? N/A

Will this proposal reduce operational costs or maintenance effort? Yes

Will this item improve safety:

For motorists? N/A

For construction workers? N/A

Will this proposal improve quality for:

Construction procedures/processes? Yes

Asset preservation? Yes

Design process? N/A

Will this change provide the contractor more flexibility? Yes

Will this proposal provide clarification for the Contractor and field personnel? No

Can this item improve/reduce the number of potential change orders? No

Is this proposal needed for compliance with:

Federal or State regulations? No

AASHTO or other design code? No

Is this item editorial? No

Provide any further information as to why this proposal should be placed on the Standards Committee meeting Agenda: N/A

**REVISION TO STANDARD SPECIFICATIONS**

---

SECTION 502 - PORTLAND CEMENT CONCRETE PAVEMENT, PCCP

502.04(a) PORTLAND CEMENT CONCRETE

502.04(b) HIGH-EARLY STRENGTH CONCRETE

SECTION 702 - STRUCTURAL CONCRETE

702.05 PROPORTIONING

702.07 MIXING

702.12 CONSISTENCY

The Standard Specifications are revised as follows:

SECTION 502, BEGIN LINE 72, DELETE AND INSERT AS FOLLOWS:

Slump, formed.....2 to 46 in.

SECTION 502, BEGIN LINE 82, DELETE AND INSERT AS FOLLOWS:

Chemical admixtures type A, type B, type C, type D, *and* type E, *and* type F may be allowed with prior written approval.

SECTION 502, BEGIN LINE 108, DELETE AND INSERT AS FOLLOWS:

Slump, formed.....2 to 46 in.

SECTION 502, BEGIN LINE 117, DELETE AND INSERT AS FOLLOWS:

Chemical admixtures type A, type B, type C, type D, *and* type E, *and* type F may be allowed with prior written approval.

SECTION 702, BEGIN LINE 124, DELETE AND INSERT AS FOLLOWS

Class C concrete shall contain either a water-reducing admixture or *both* a water-reducing *admixture and a* retarding admixture. The types used shall not be changed during any individual contiguous pour. The types of admixtures to be used ~~will~~*shall* be selected based on the expected concrete or air temperature. When either temperature is expected to be 65°F or above, *both* a water-reducing *admixture and a* retarding admixture shall be used. A water-reducing admixture shall be used when both temperatures are expected to be below 65°F unless retardation is required due to the structure design or the proposed pour sequence such as the requirements for floor slab pours set out in 704.04. *If class C concrete contains ground granulated blast furnace slag, the producer may propose an alternate temperature threshold for including a retarding admixture.* Air-entraining cements will not be allowed in class C concrete.

SECTION 702, BEGIN LINE 243, DELETE AND INSERT AS FOLLOWS:

Concrete that is not within the specified slump limits at time of placement shall not be used. Except as required in 702.05 for class C concrete, ~~a water reducing admixture, chemical admixtures type A, type B, or a water reducing and retarding admixture, type D, type F, and type G,~~ may be used in the concrete. Chemical admixtures ~~type B, type C, and type E~~ will be allowed only with prior written permission. ~~Chemical admixtures type F and type G shall not be used.~~

**REVISION TO STANDARD SPECIFICATIONS**

---

SECTION 502 - PORTLAND CEMENT CONCRETE PAVEMENT, PCCP

502.04(a) PORTLAND CEMENT CONCRETE

502.04(b) HIGH-EARLY STRENGTH CONCRETE

SECTION 702 - STRUCTURAL CONCRETE

702.05 PROPORTIONING

702.07 MIXING

702.12 CONSISTENCY

SECTION 702, BEGIN LINE 525, DELETE AND INSERT AS FOLLOWS:

**702.12 Consistency**

Slump will be measured in accordance with 505 and shall be no less than 1 in. and no more than 46 in. except for concrete placed in foundation seals.

## COMMENTS AND ACTION

---

502.04(a) PORTLAND CEMENT CONCRETE  
 502.04(b) HIGH-EARLY STRENGTH CONCRETE  
 702.05 PROPORTIONING  
 702.07 MIXING  
 702.12 CONSISTENCY

DISCUSSION:

Mr. Beeson introduced and presented this item. Mr. Nelson explained that mix workability is an ongoing struggle for applications that involve concrete delivered via ready mix trucks. Contractors prefer a slump of approximately 5 in. to ease placement and finishing, and will typically add water to the mix on-site in order to improve the workability, which can be detrimental to the mix as designed. Mr. Nelson pointed out that there is nothing inherently detrimental about using properly designed concrete mixes with moderately higher slump than is currently allowed by the specification. Ready mix concrete suppliers have the ability to chemically modify concrete slump with admixtures. This does not increase the water-cement ratio, but improves workability. Increasing the allowable slump will allow mix producers to properly design and supply mixes that are workable as delivered. This will dramatically reduce the Contractor's incentive to modify the mixes at the jobsite by adding water.

Discussion ensued concerning adding water at the site, and whether or not to revise language in 702 forbidding adding water. Currently, 702.07 allows it. Mr. Pankow suggested added language to the GIFE to control the amount of water that may be added.

---

Motion: Mr. Beeson Second: Mr. Koch Ayes: 8 Nays: 0 FHWA Approval: <u>YES</u>	Action: <input checked="" type="checkbox"/> Passed as Submitted <input type="checkbox"/> Passed as Revised <input type="checkbox"/> Withdrawn
Standard Specifications Sections referenced and/or affected:  502.04 pg 359, 360; 702.07 pg 530; 702.12 pg 536.	<input checked="" type="checkbox"/> 2020 Standard Specifications <input type="checkbox"/> Revise Pay Items List
Recurring Special Provision affected:  NONE	<input checked="" type="checkbox"/> Create (2) RSP (No. <u>502-R-678</u> ) <u>(No. 702-R-679)</u> <u>Effective Sept. 01, 2018 Letting</u> <u>RSP Sunset Date: 2020 SS Book</u>
Standard Drawing affected:  NONE	<input type="checkbox"/> Revise RSP (No. <u>      </u> ) <u>Effective      Letting</u> <u>RSP Sunset Date:      </u>
Design Manual Sections affected:  NONE	<input type="checkbox"/> Standard Drawing <u>Effective      </u>
GIFE Sections cross-references:  4.7.	<input type="checkbox"/> Create RPD (No. <u>      </u> ) <u>Effective      Letting</u> <input checked="" type="checkbox"/> GIFE Update <input checked="" type="checkbox"/> SiteManager Update

---