



SECOND FLOOR PLAN
SCALE: 1/8" = 1'-0"
DATE: 1/1/77

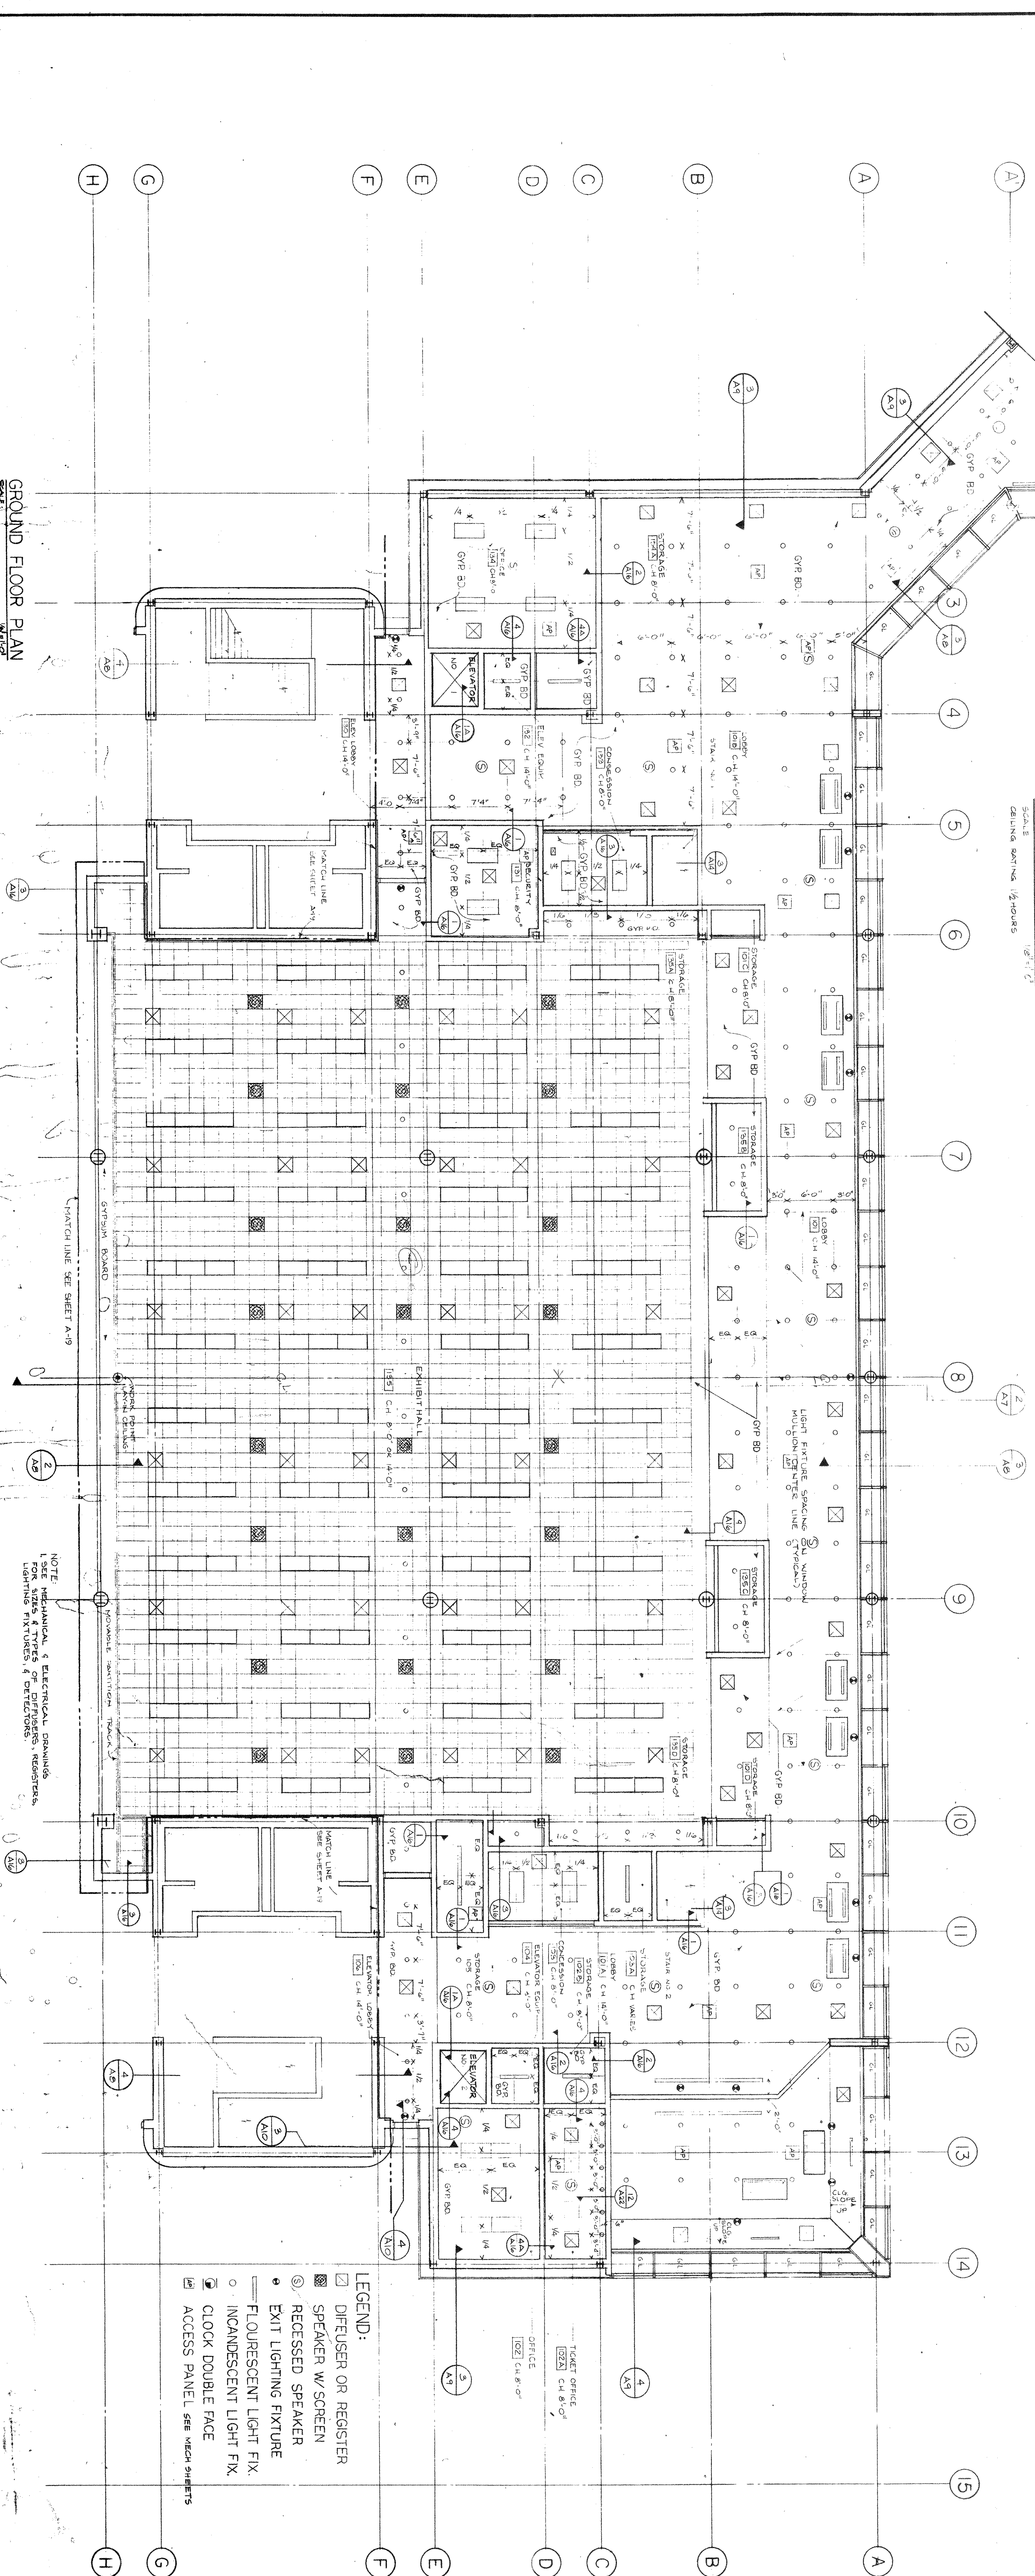

GROUND FLOOR PLAN
SCALE: 1/8" = 1'-0"
DATE: 1/1/77

- LEGEND:
- DIFFUSER OR REGISTER
 - SPEAKER W/SCREEN
 - RECESSED SPEAKER
 - EXIT LIGHTING FIXTURE
 - FLUORESCENT LIGHT FIX.
 - INCANDESCENT LIGHT FIX.
 - CLOCK DOUBLE FACE
 - ACCESS PANEL. SEE MECH SHEETS

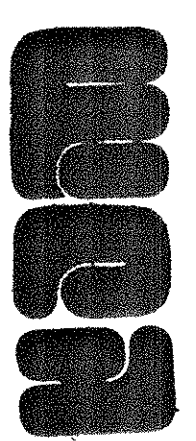

Wendell Campbell Associates, Inc.
ARCHITECTS
504 BROADWAY
GARY, INDIANA
2006 E. 140TH STREET EAST CHICAGO, ILLINOIS
180 N. MICHIGAN AVENUE CHICAGO, ILLINOIS

GENESIS CENTER
ADAMS, BROADWAY, AND FIFTH AVENUE
CITY OF GARY, INDIANA
RICHARD G. HATCHER. MAYOR

REVISIONS

NO.	DATE	DESCRIPTION

