

REVISIONS	
NO.	DESCRIPTION


BID PACKAGE NO. 3 DATE 11/18/78	
DESCRIPTION	REVISIONS

BID PACKAGE NO. 2 DATE 11/18/78	
DESCRIPTION	REVISIONS

BID PACKAGE NO. 1 DATE 11/18/78	
DESCRIPTION	REVISIONS

GENESIS CENTER
 ADAMS, BROADWAY, AND FIFTH AVENUE
 CITY OF GARY, INDIANA
 RICHARD G. HATCHER, MAYOR

Wendell Campbell Associates, Inc.
 ARCHITECTS
 504 BROADWAY GARY, INDIANA
 2006 E. 140TH STREET CHICAGO, ILLINOIS
 180 N. MICHIGAN AVENUE CHICAGO, ILLINOIS

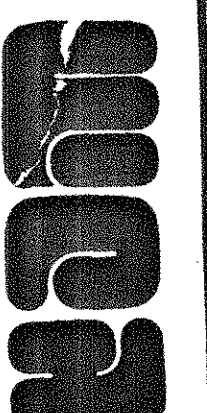

DATE	JAN 2, 1980
APPROVED	
CHECKED	
DRAWN	LP 47E
CONTENTS	

BUILDING
 ELEVATIONS