



CONTENTS  
RISER  
DIAGRAMS  
DETAILS

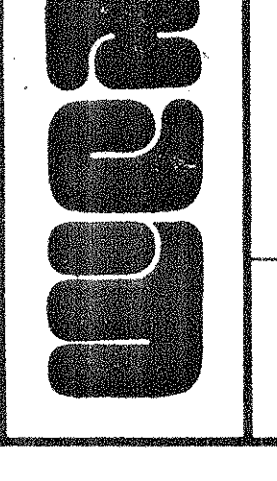


Wallace, Migdal & Drucker  
CONSULTING ENGINEERS  
MECHANICAL ELECTRICAL  
444 N. O'Hare Road, Suite 200  
Chicago, Illinois 60611  
Tel. (312) 329-1100  
Fax (312) 329-1101

RICHARD G. HATCHER,  
MAYOR  
CITY OF GARY,  
ADAMS, BROADWAY, AND FIFTH AVENUE  
INDIANA  
**GENESIS CENTER**

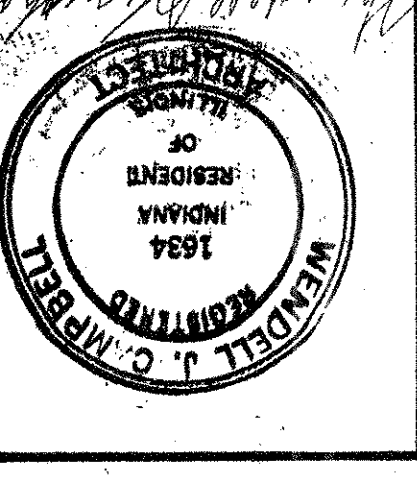


REVISIONS


SPRINKLER ALARM ZONES

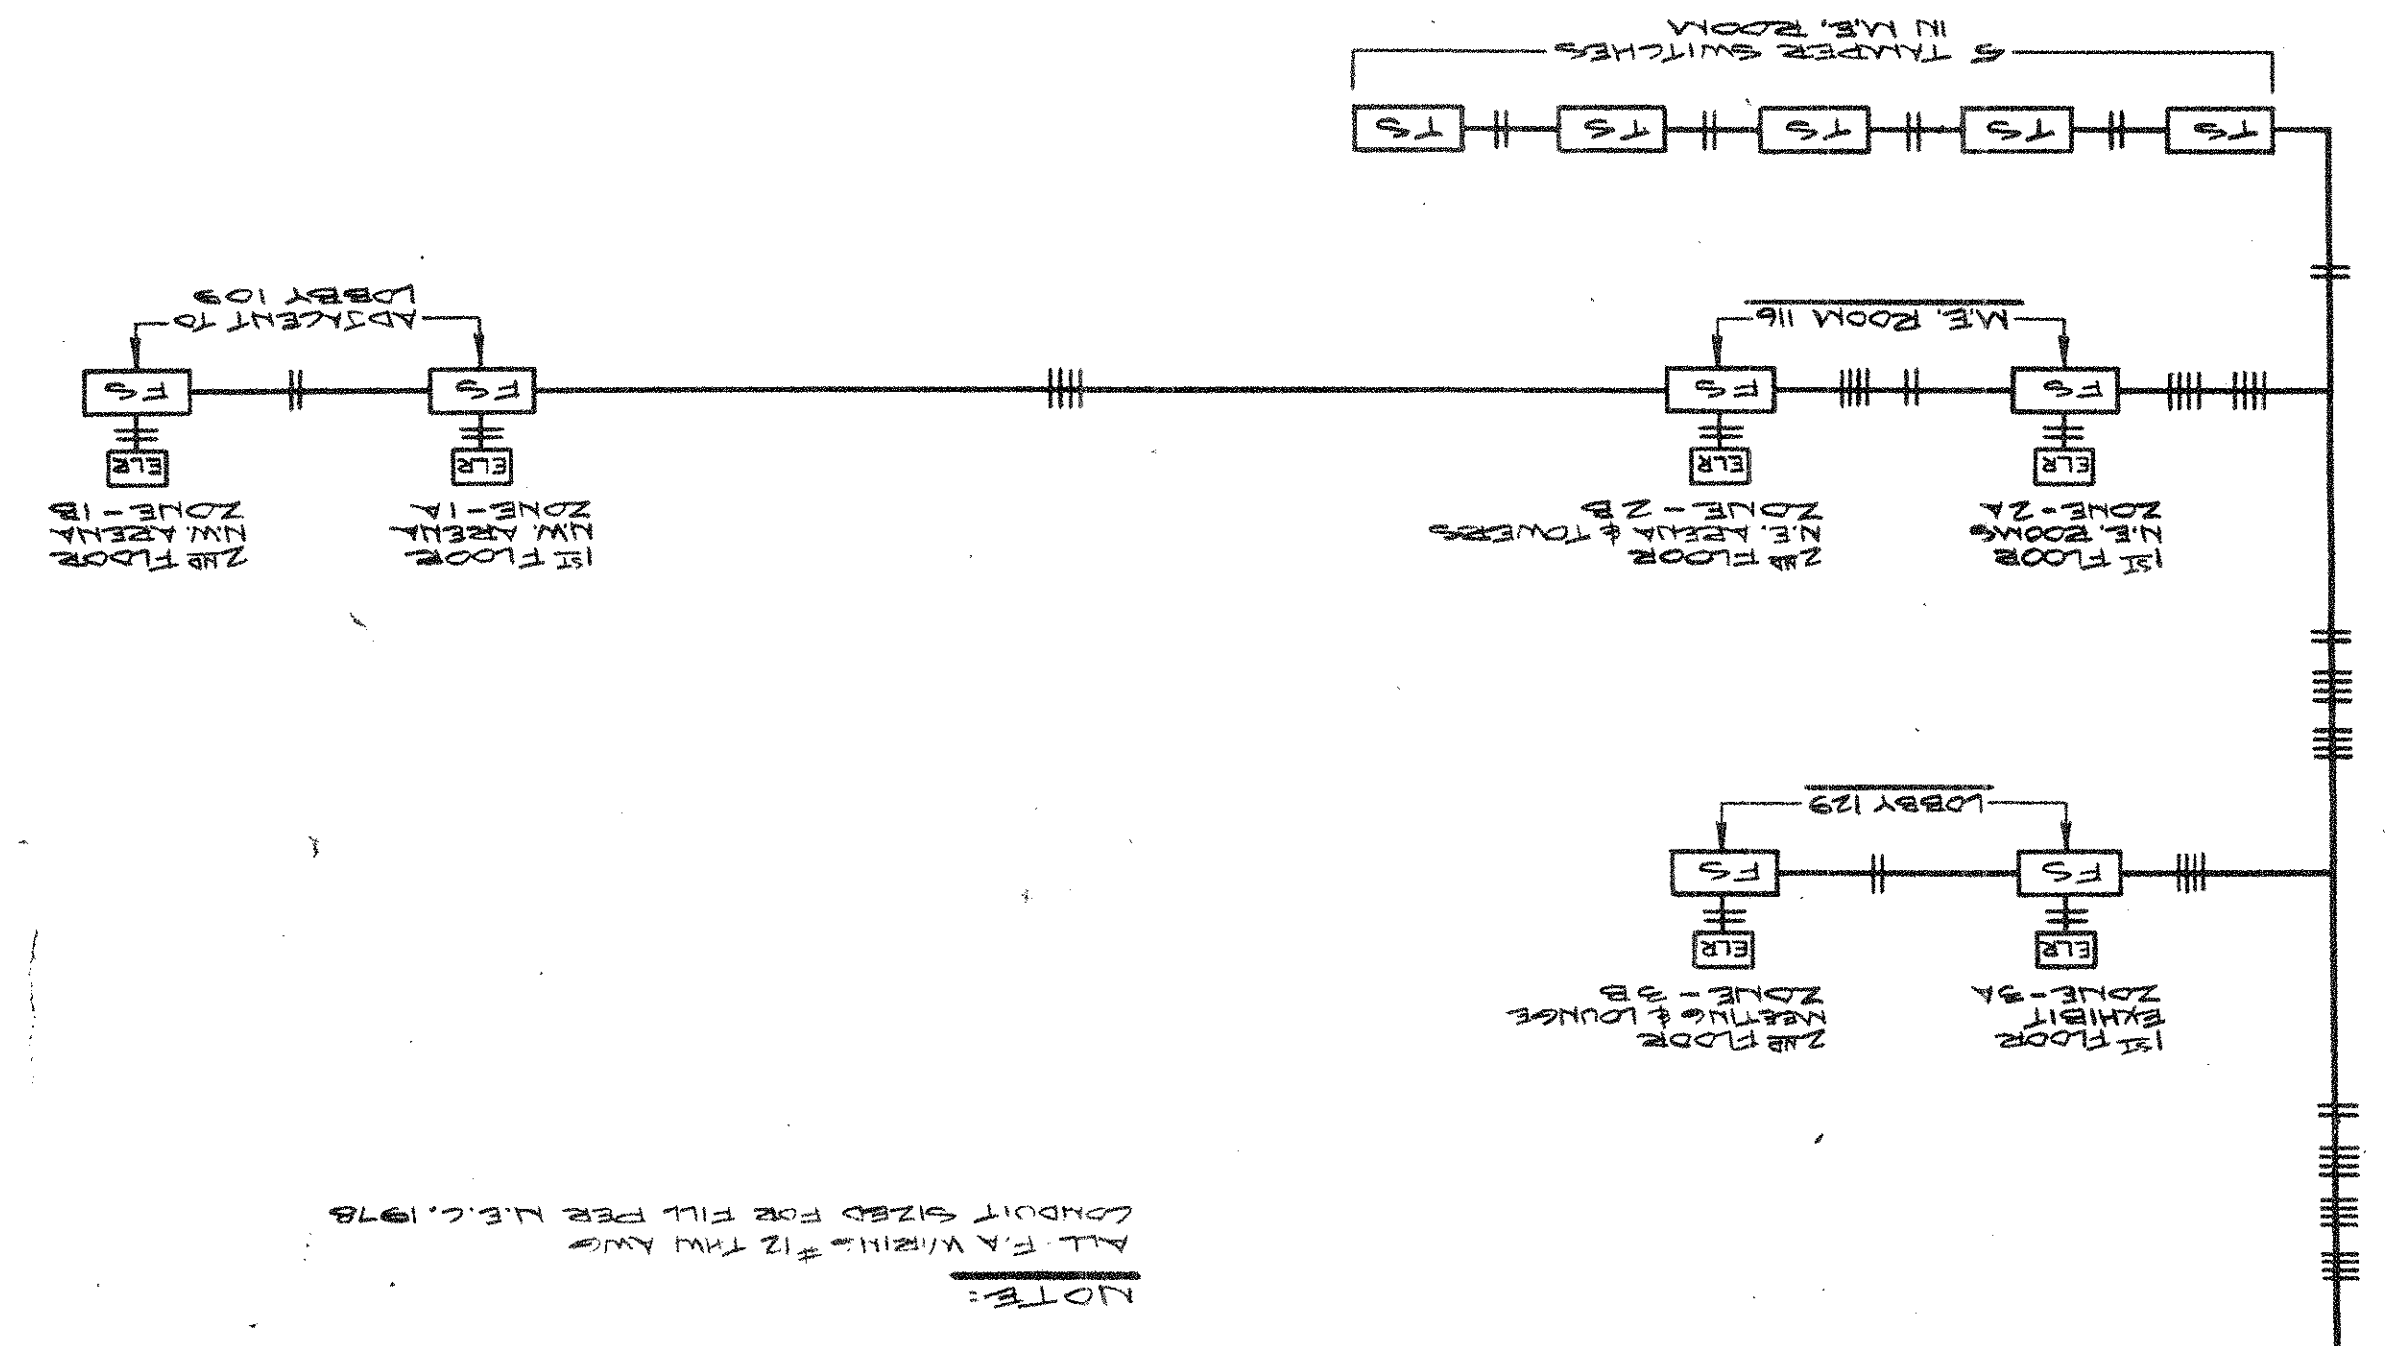


FIRE ALARM ZONE 1<sup>st</sup> FLOOR NORTH (1N)

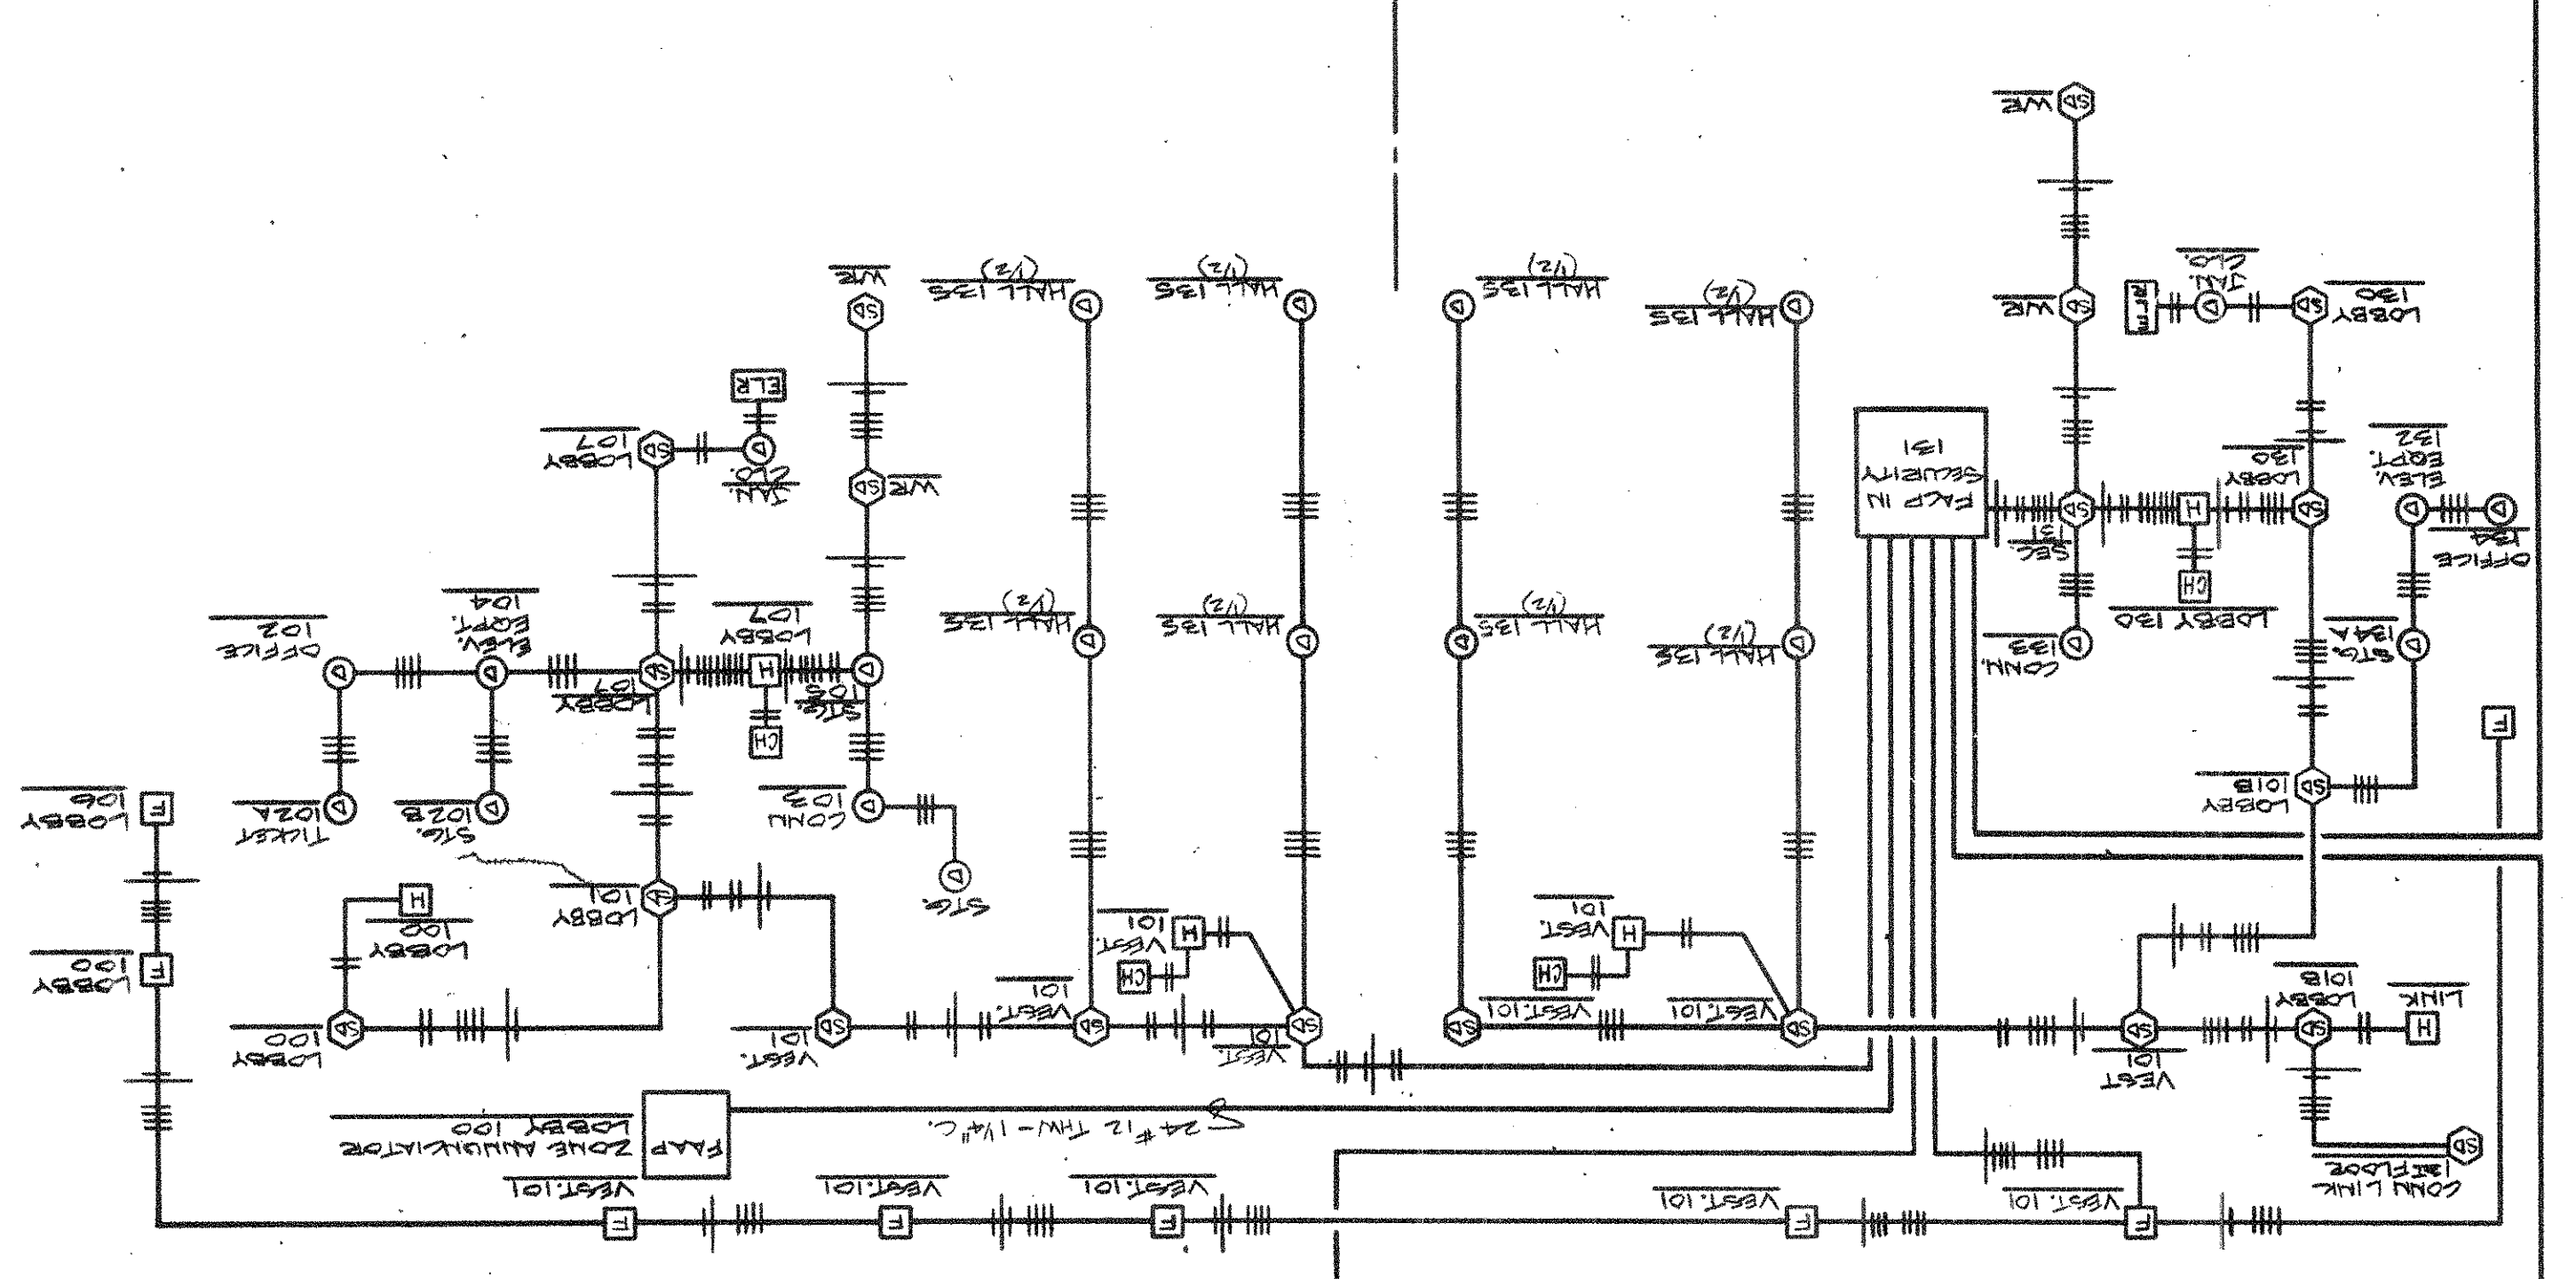


FIRE ALARM ZONE 2<sup>nd</sup> FLOOR NORTH (2N)

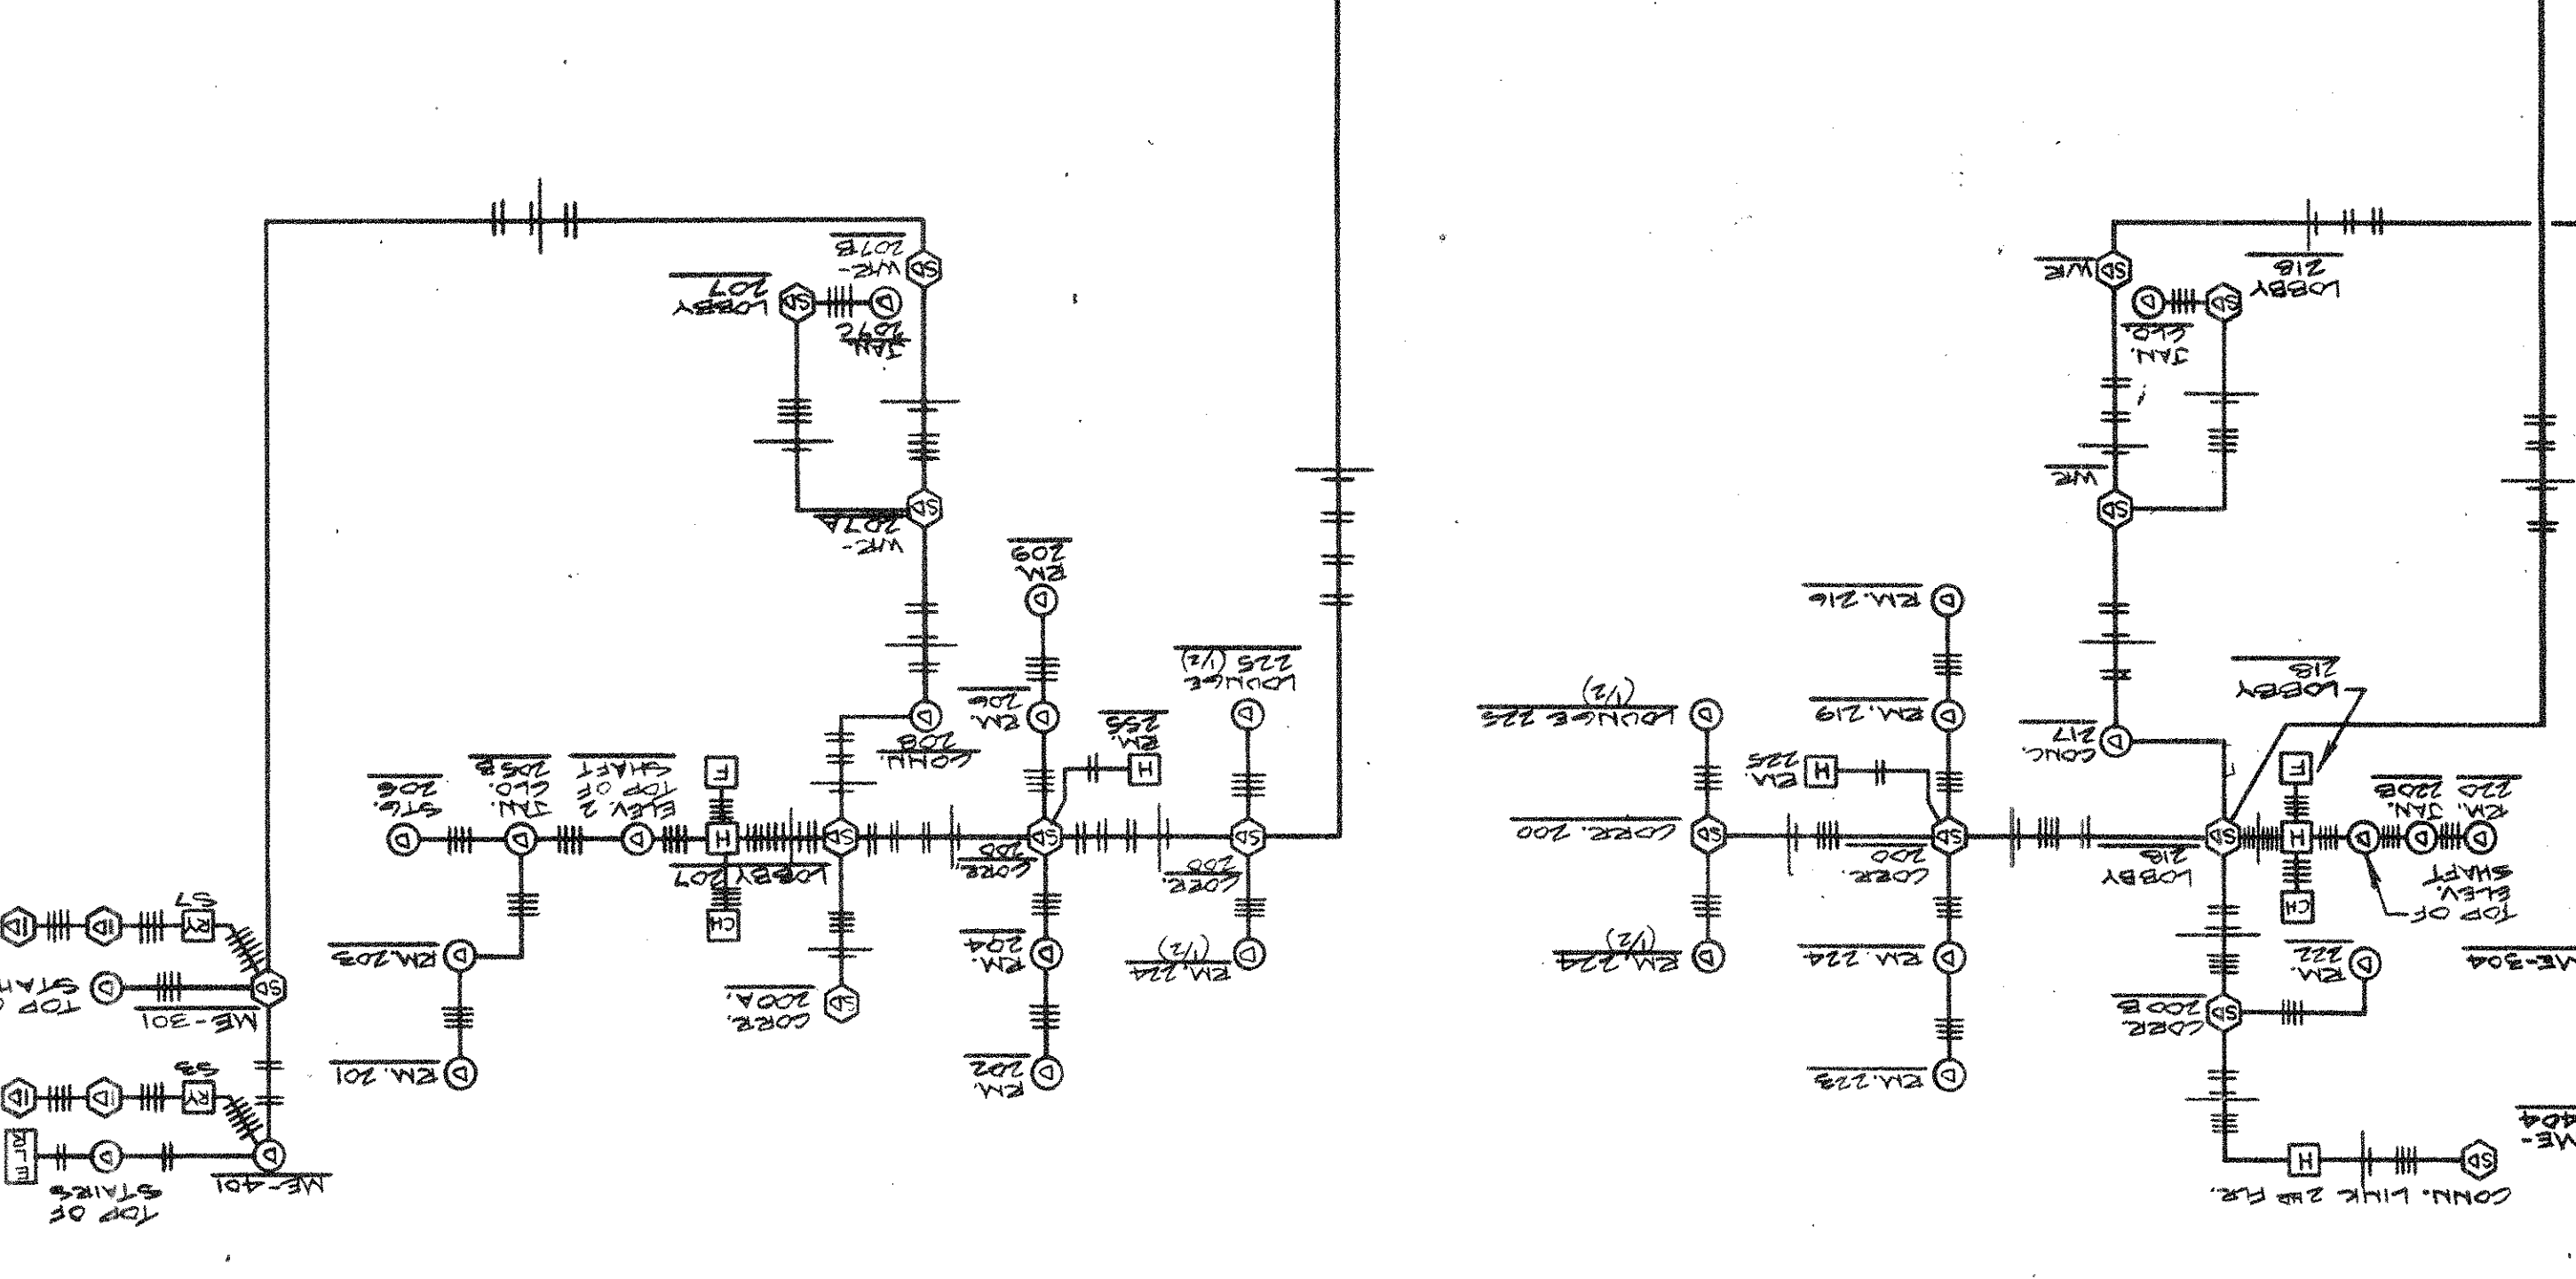


FIRE ALARM ZONE 1<sup>st</sup> FLOOR EAST (1E)

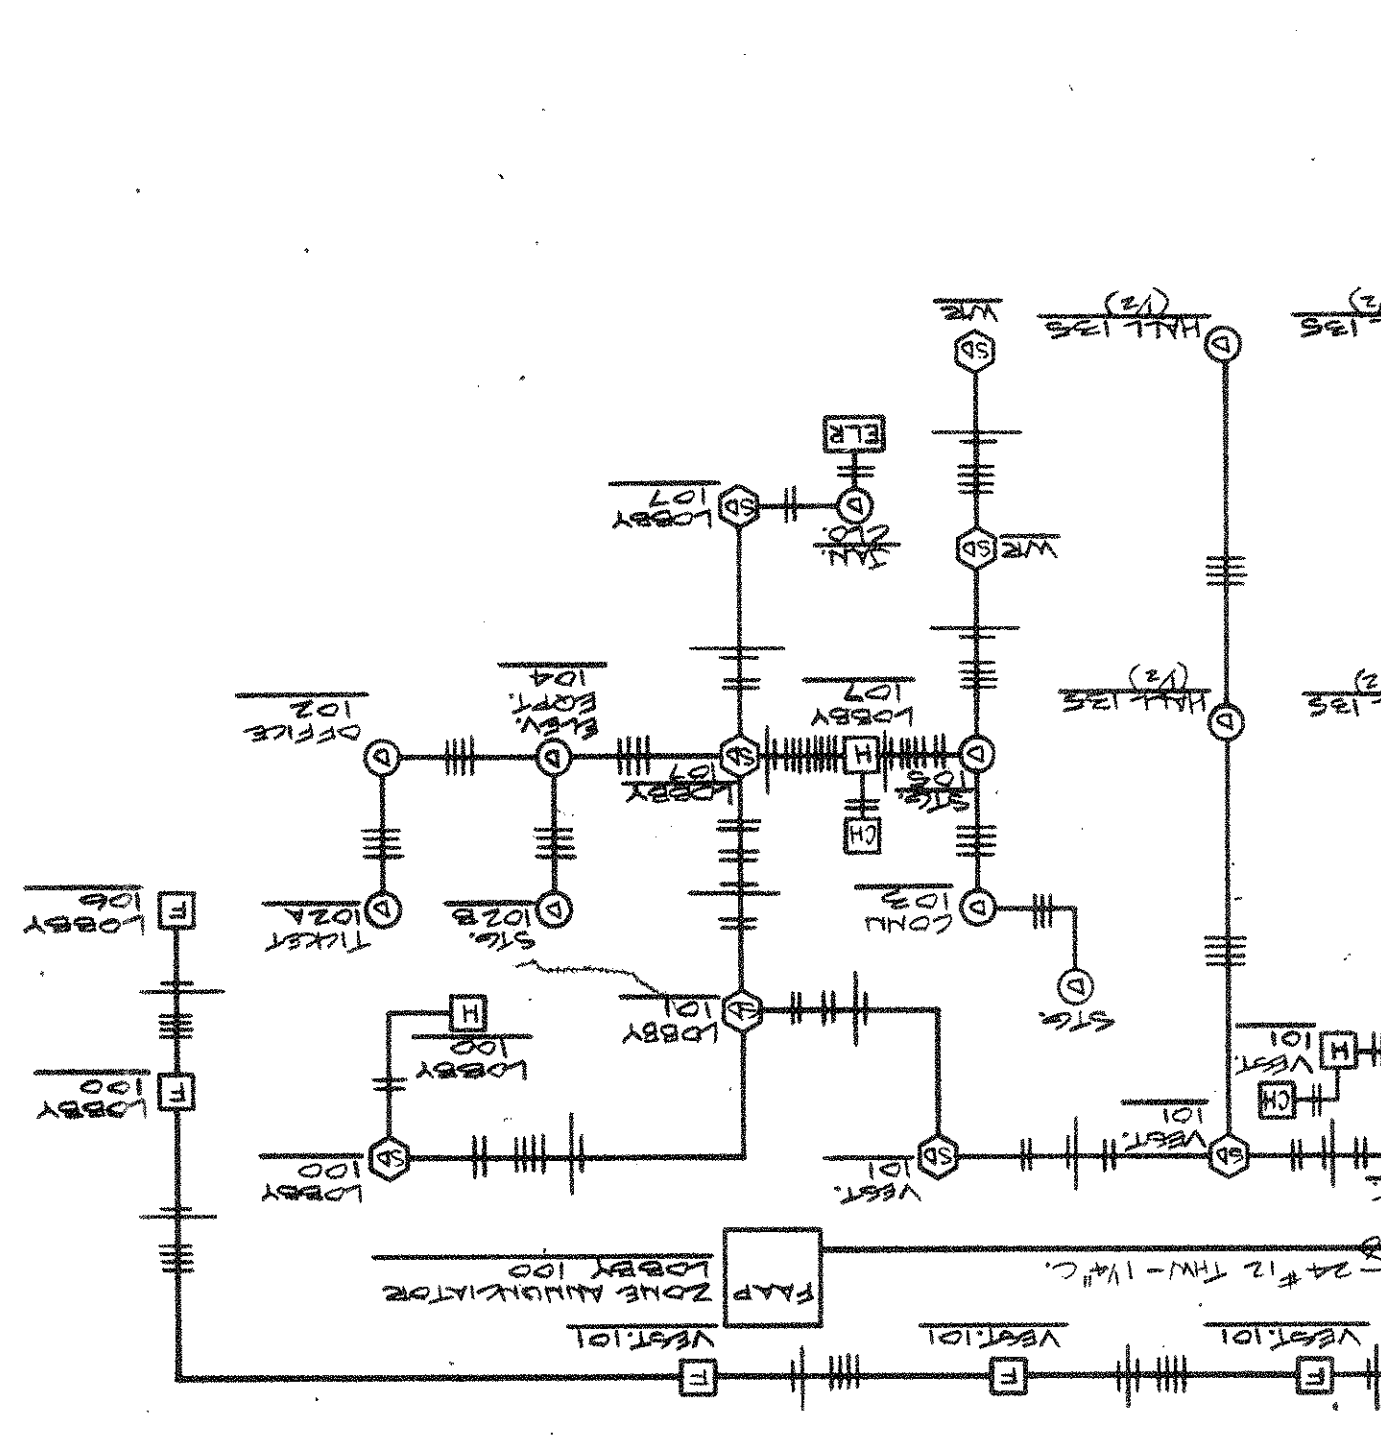


FIRE ALARM ZONE 2<sup>nd</sup> FLOOR EAST (2E)

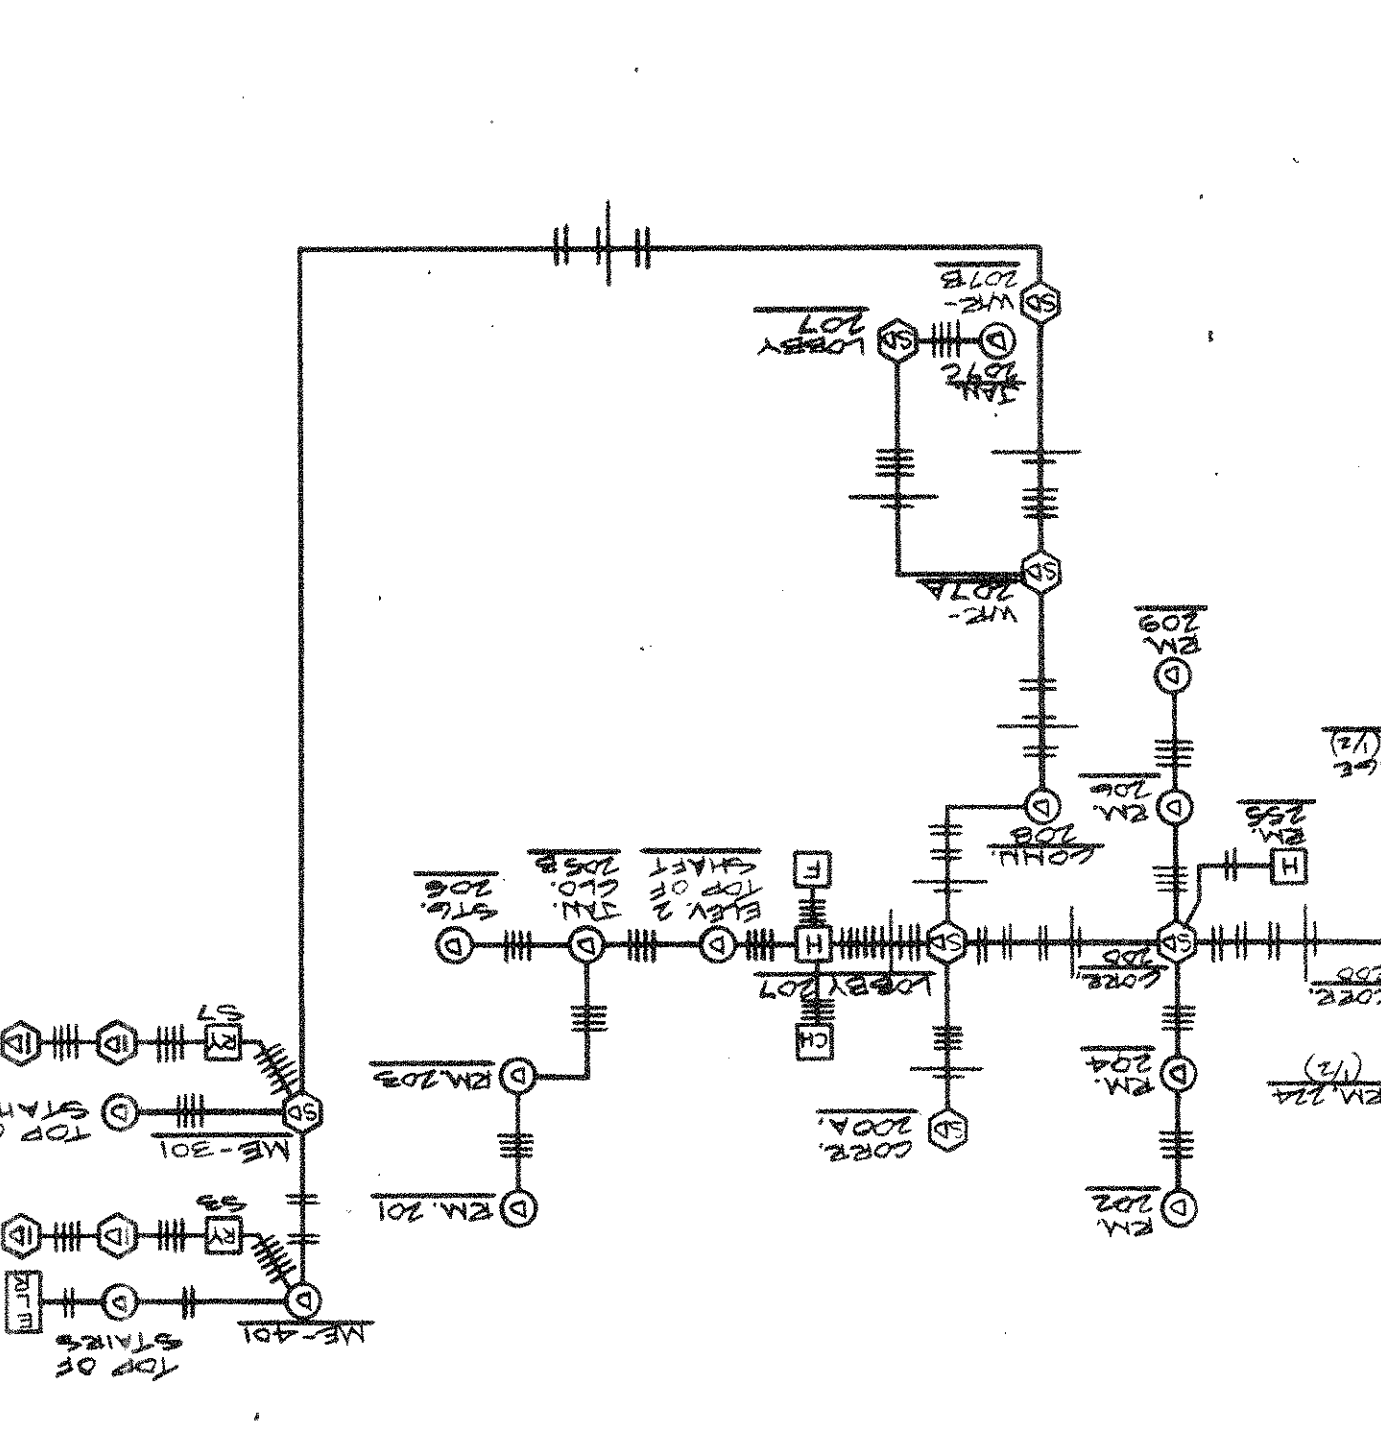


GROUND FLOOR NORTH-EAST ZONE (G.N.E.)

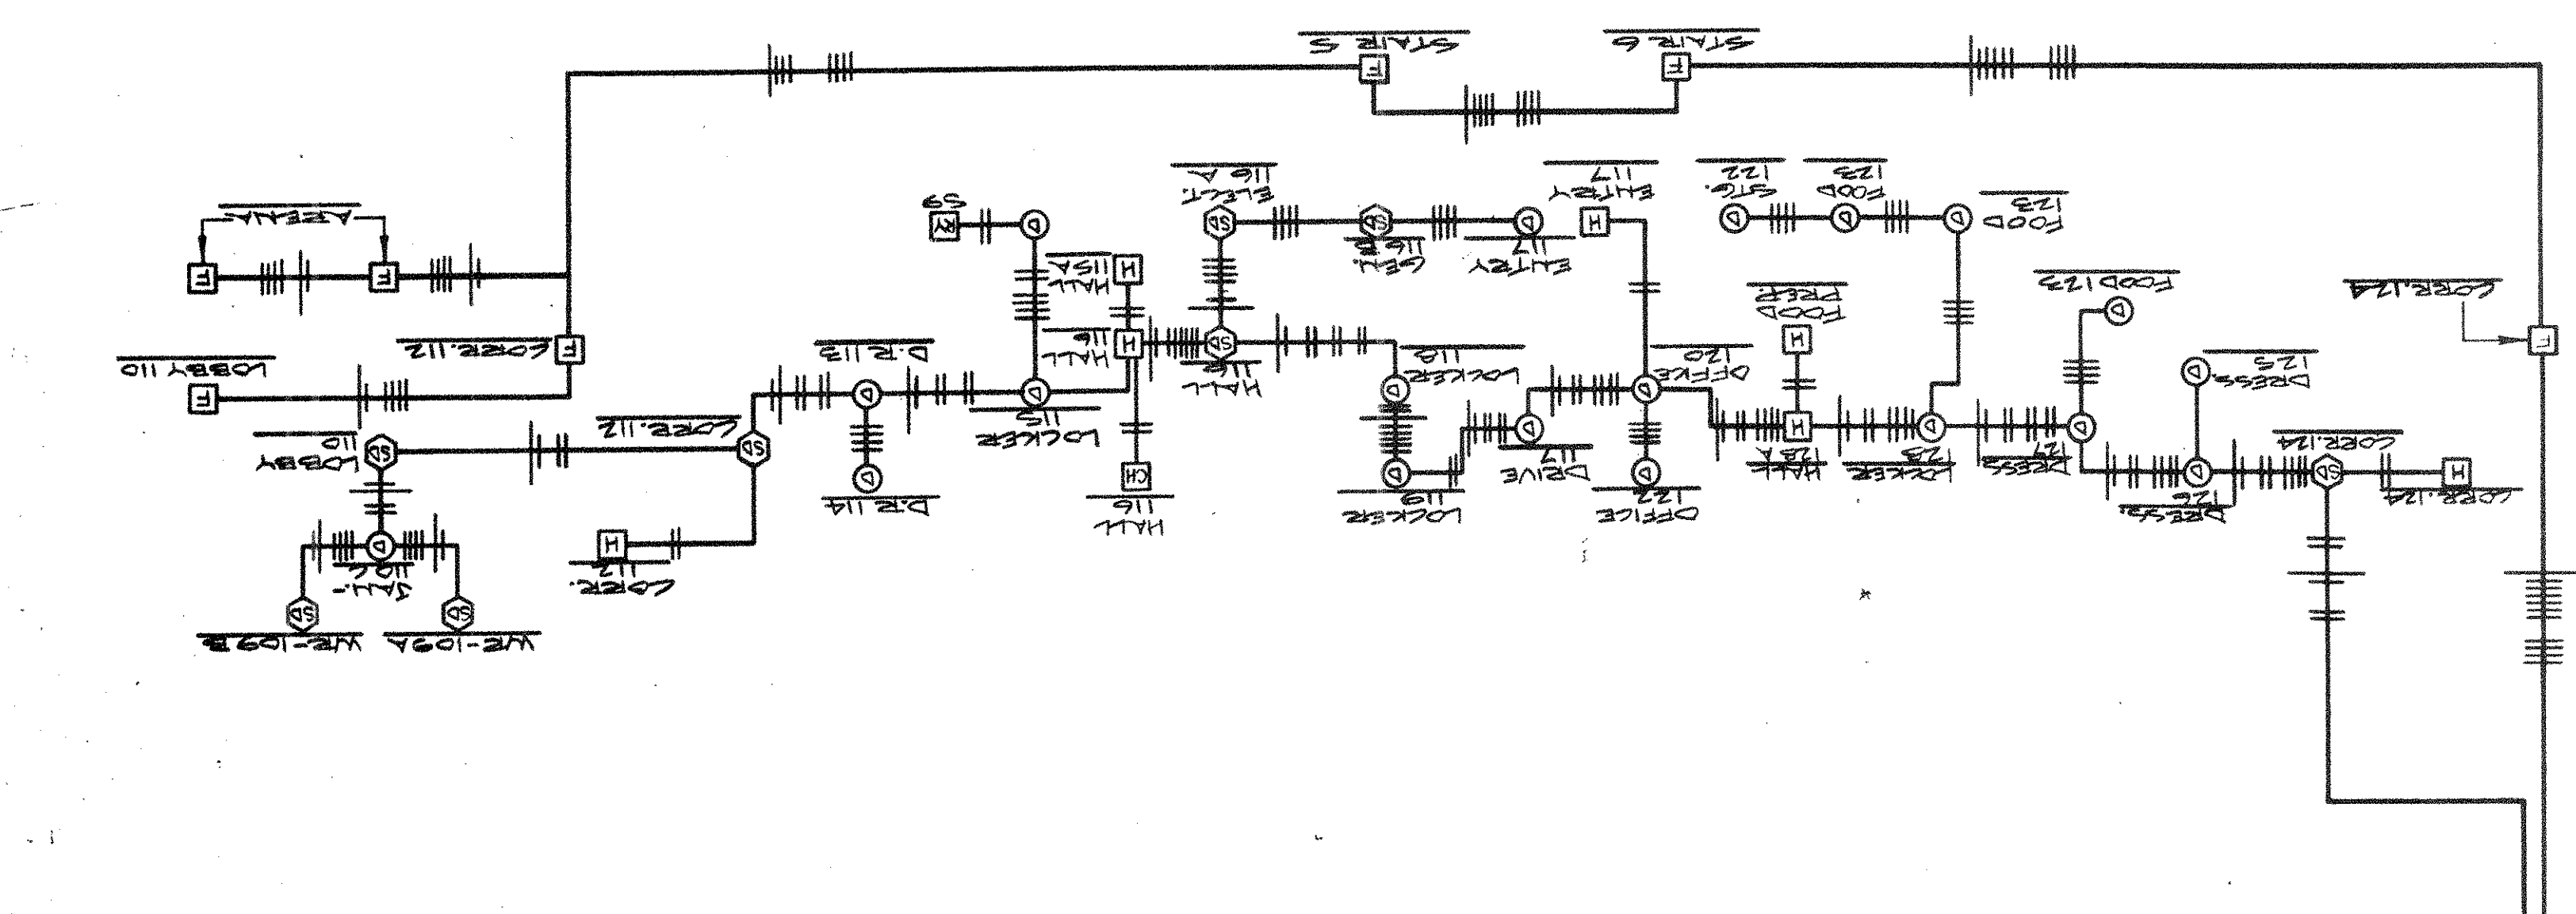


NORTH-WEST ARENA ZONE (N.W.A.)

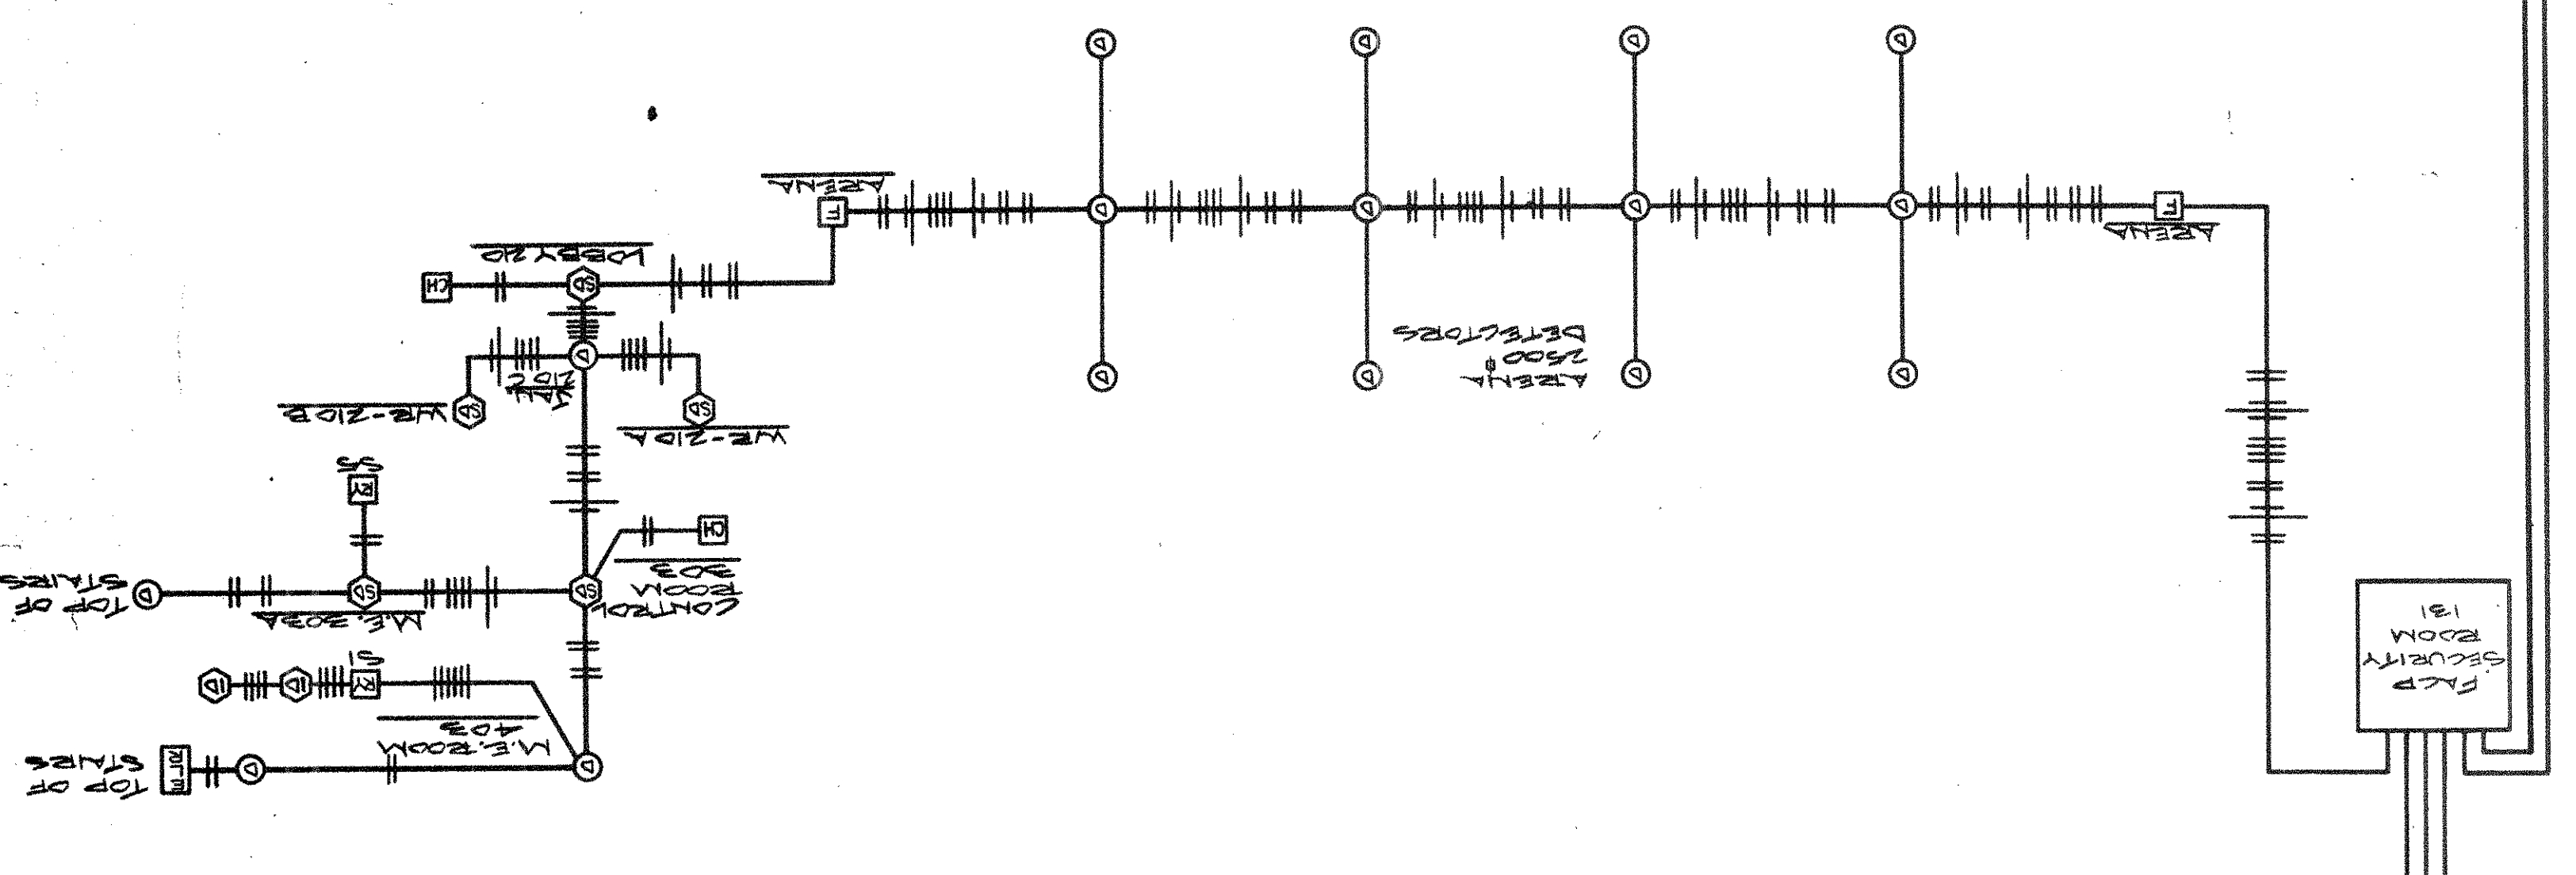

SOUTH-EAST ARENA ZONE (S.E.A.)

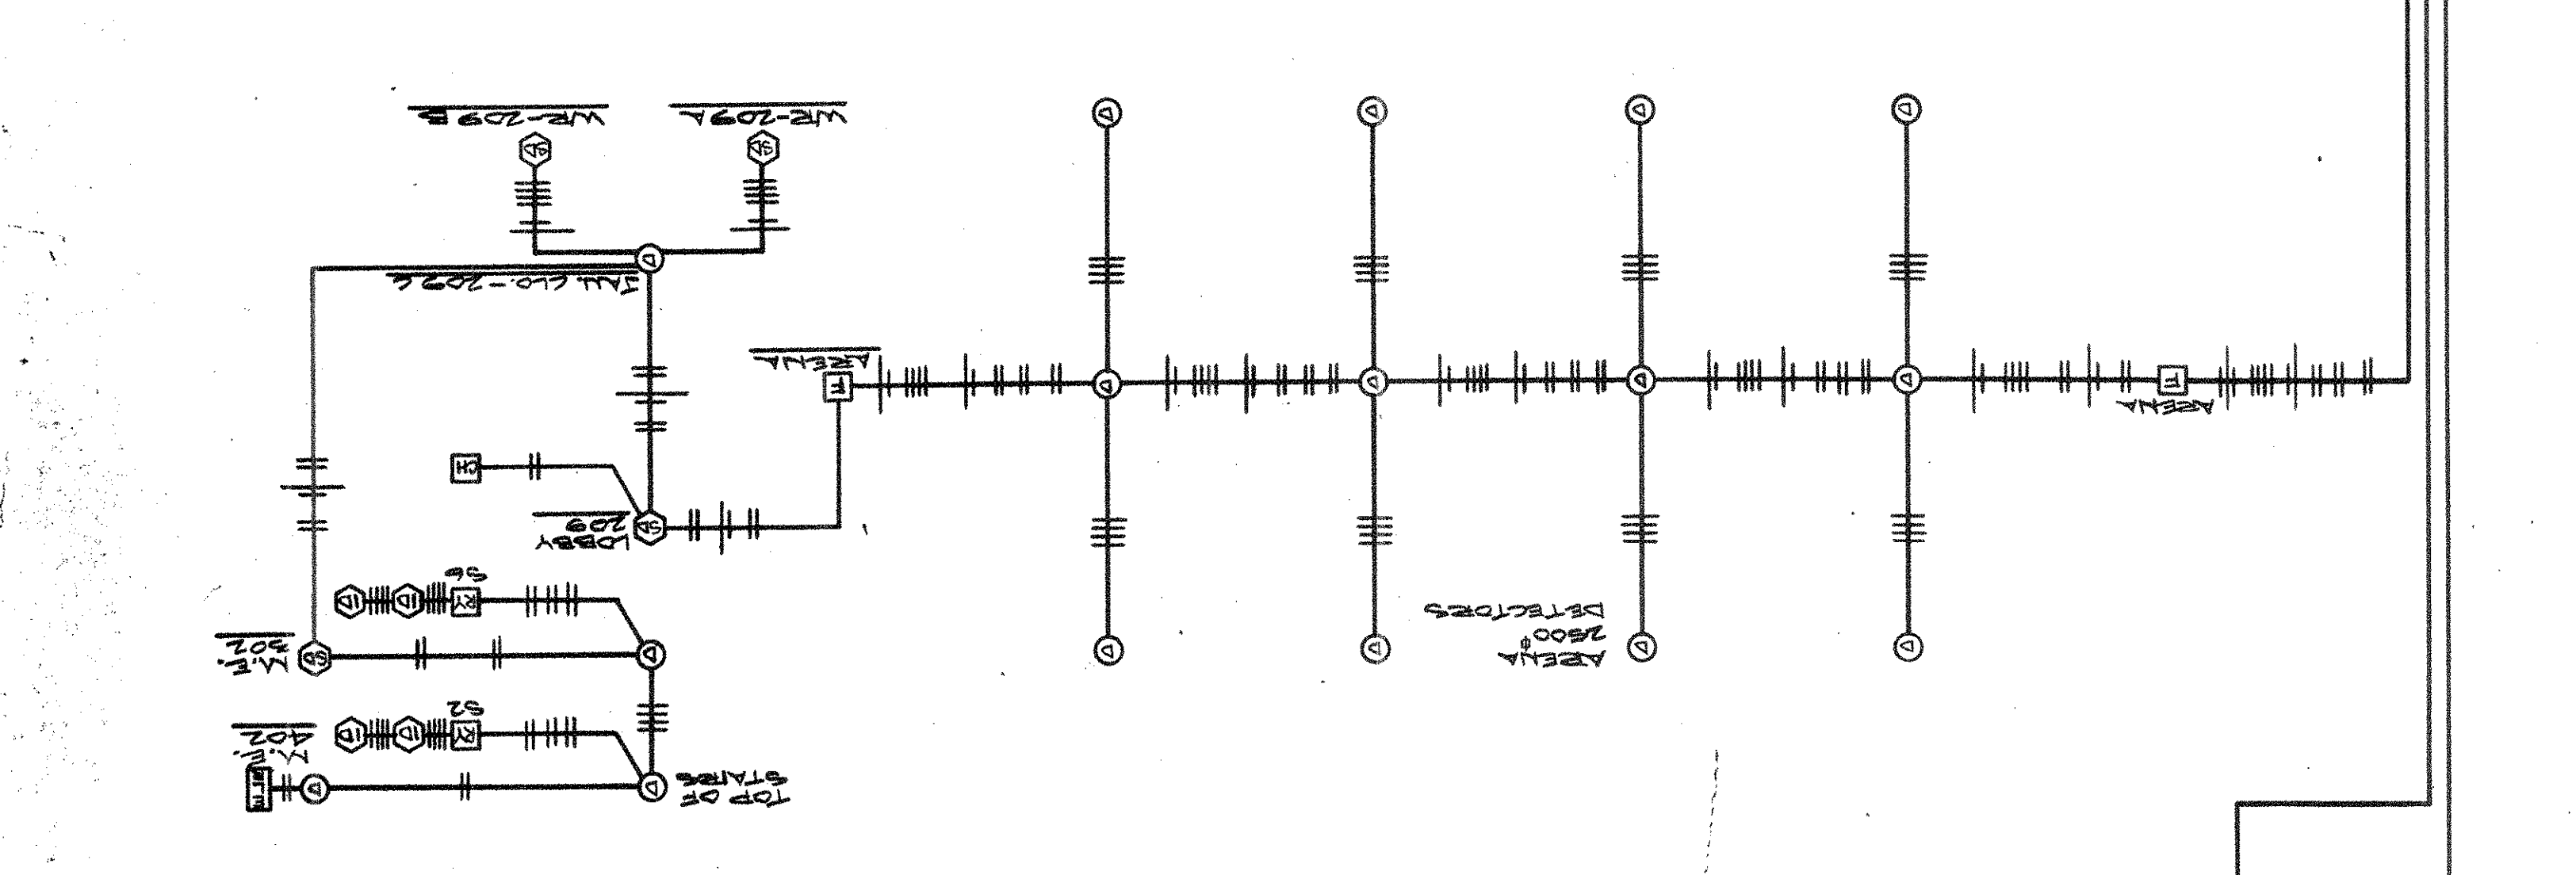


GROUND FLOOR SOUTH EAST ZONE (G.S.E.)

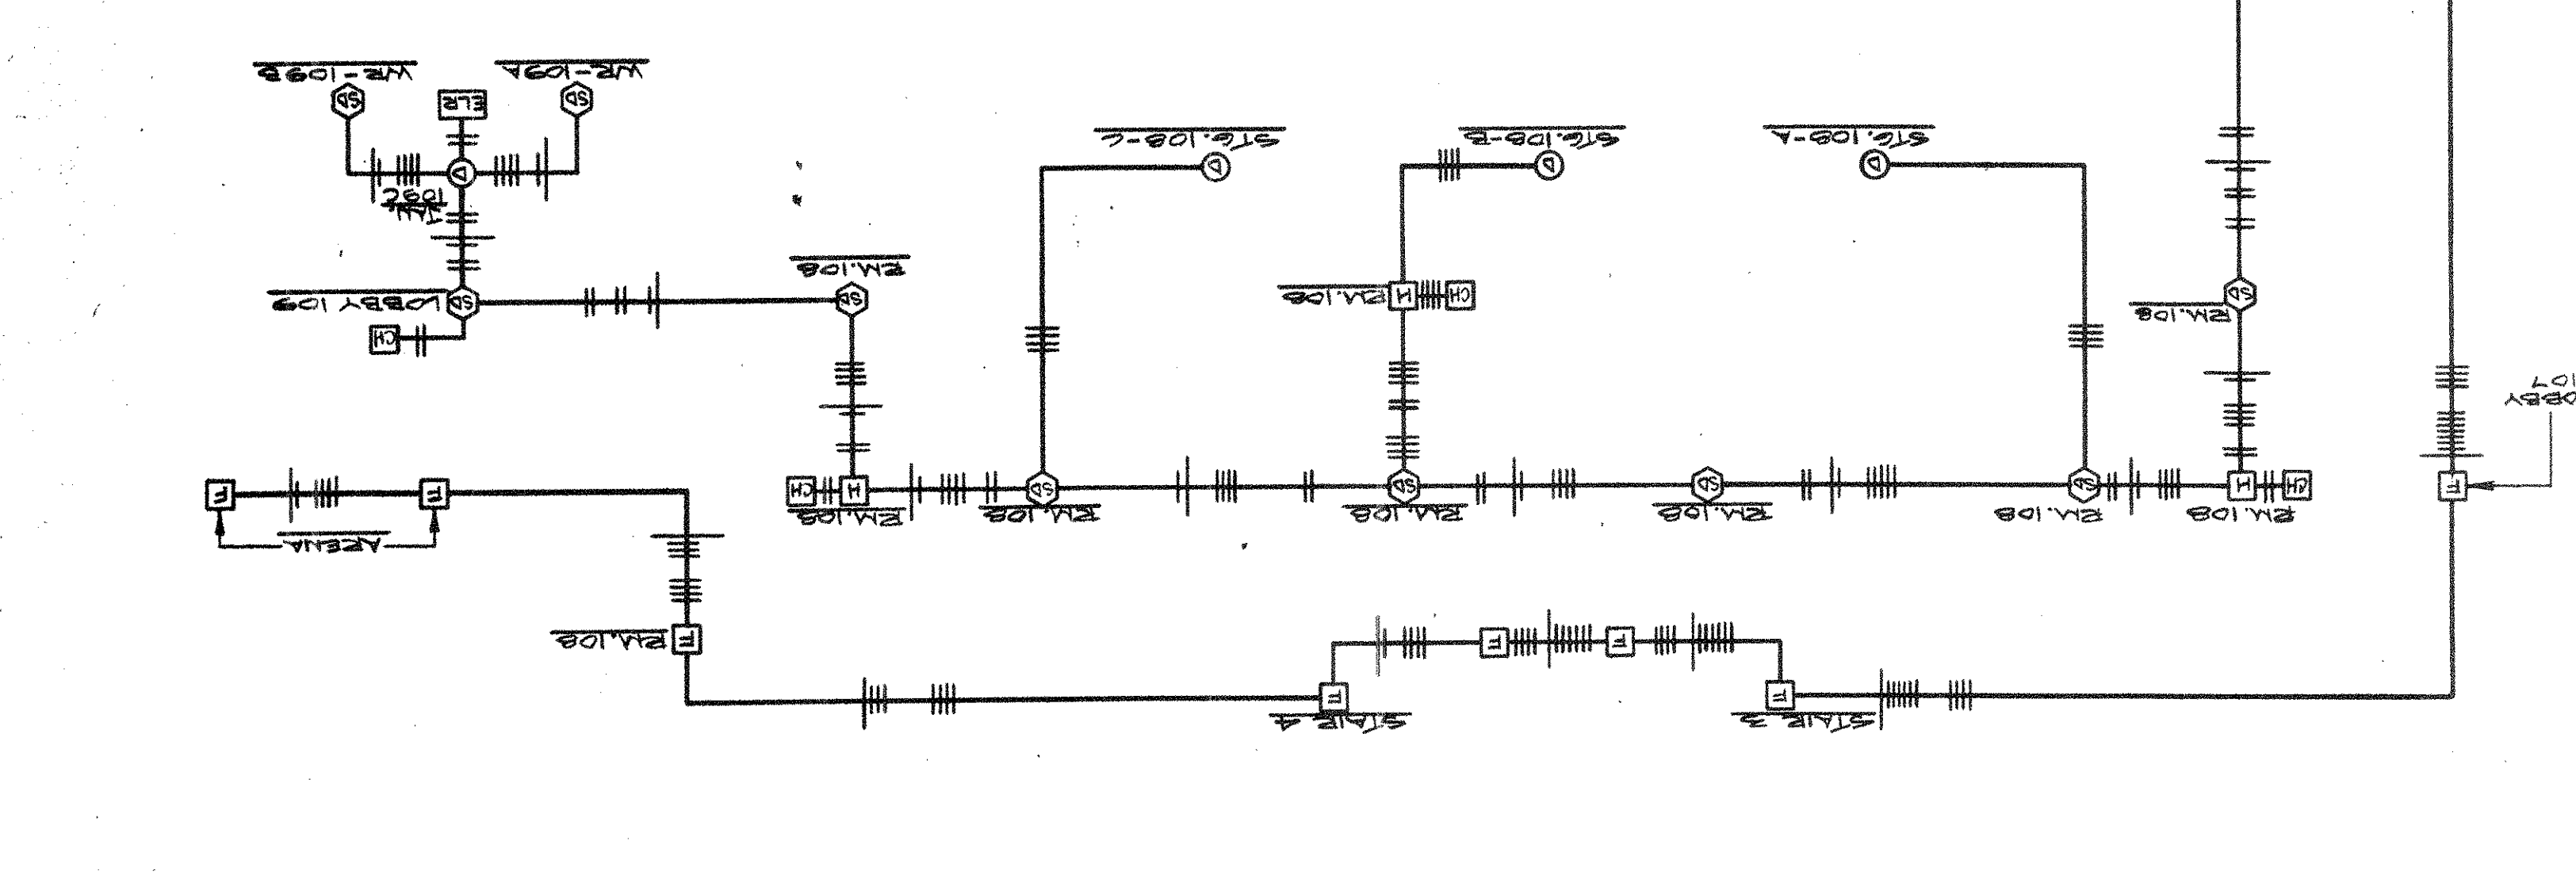

SECTION A-A


NOTE: SEE ELECTRICAL FLOOR PLANS FOR EACH INDIVIDUAL FLOOR BOX HUB SIZE REQUIREMENTS.

EXHIBITION FLUSH FLOOR BOX DETAIL

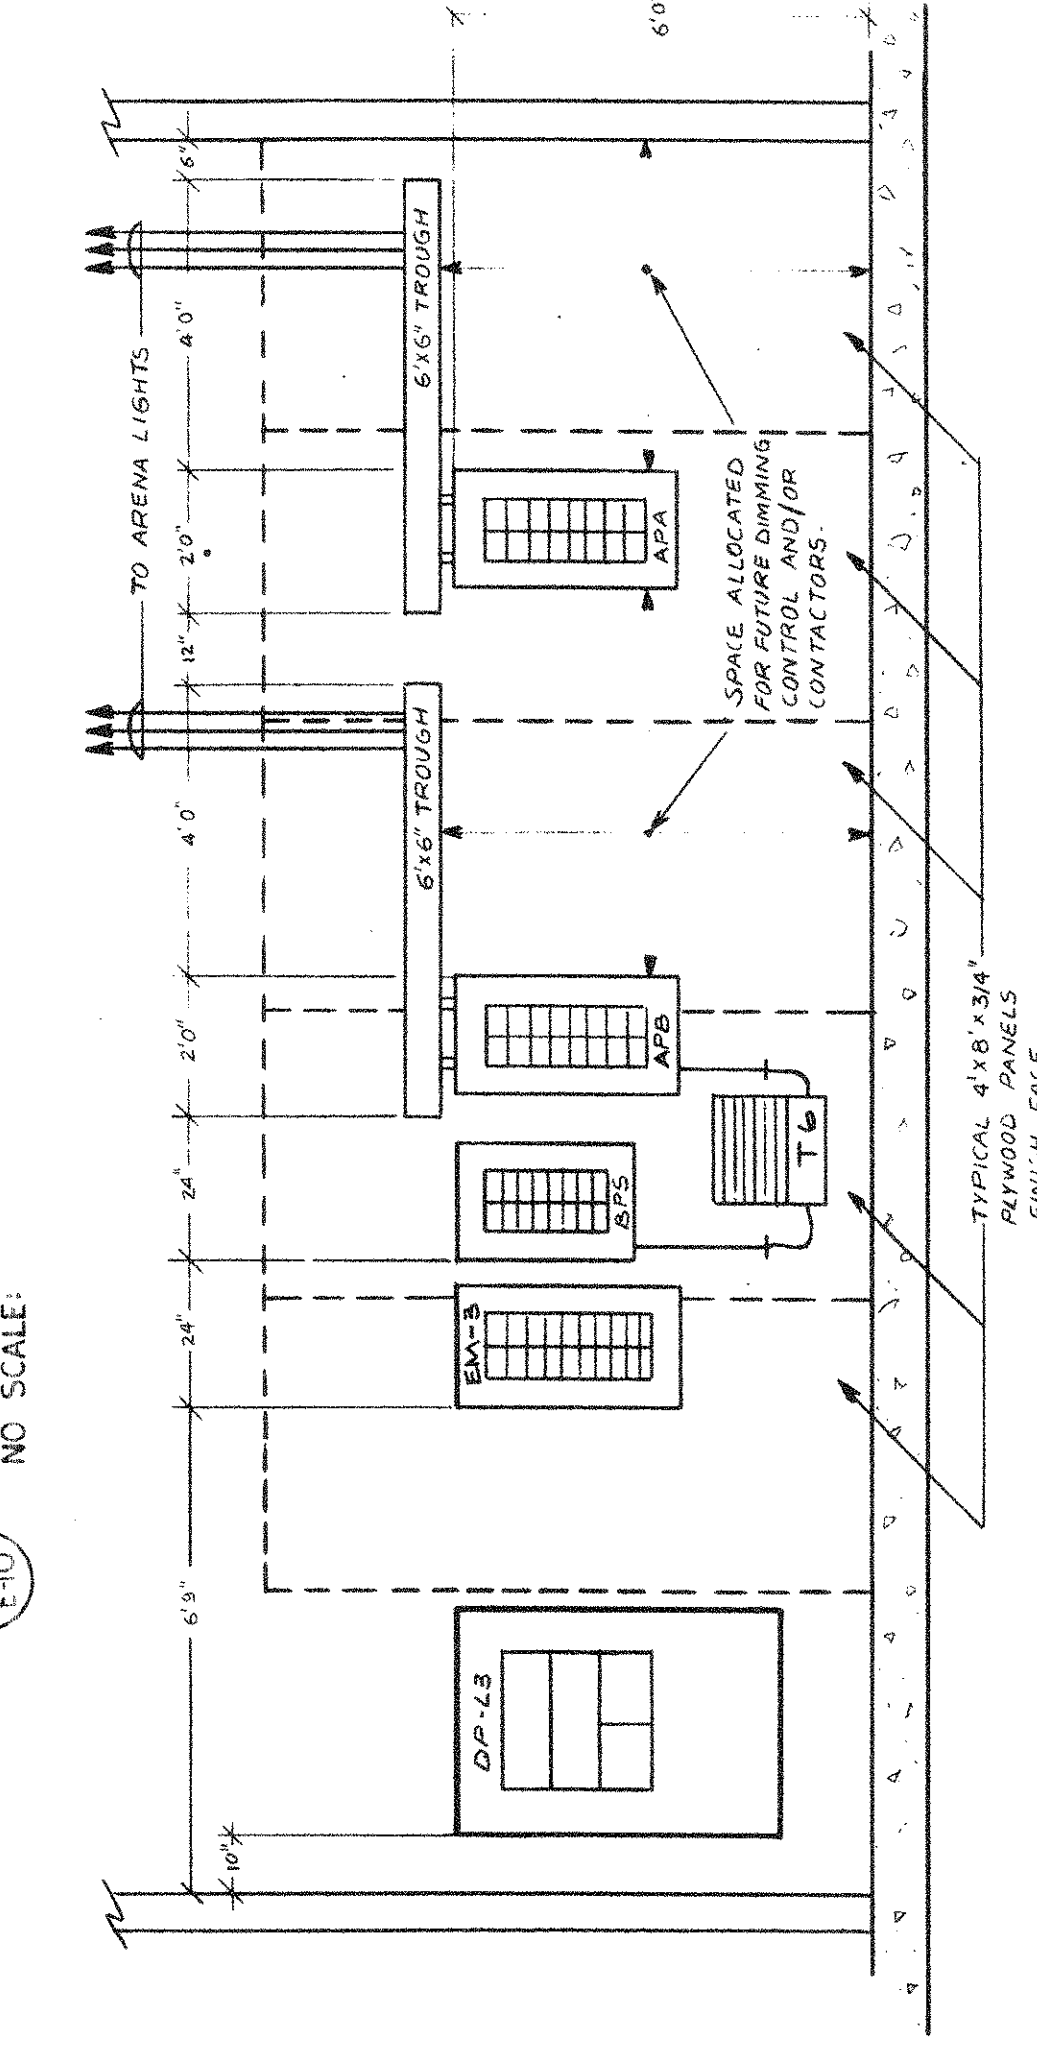

CONTROL ROOM - 303

NO SCALE

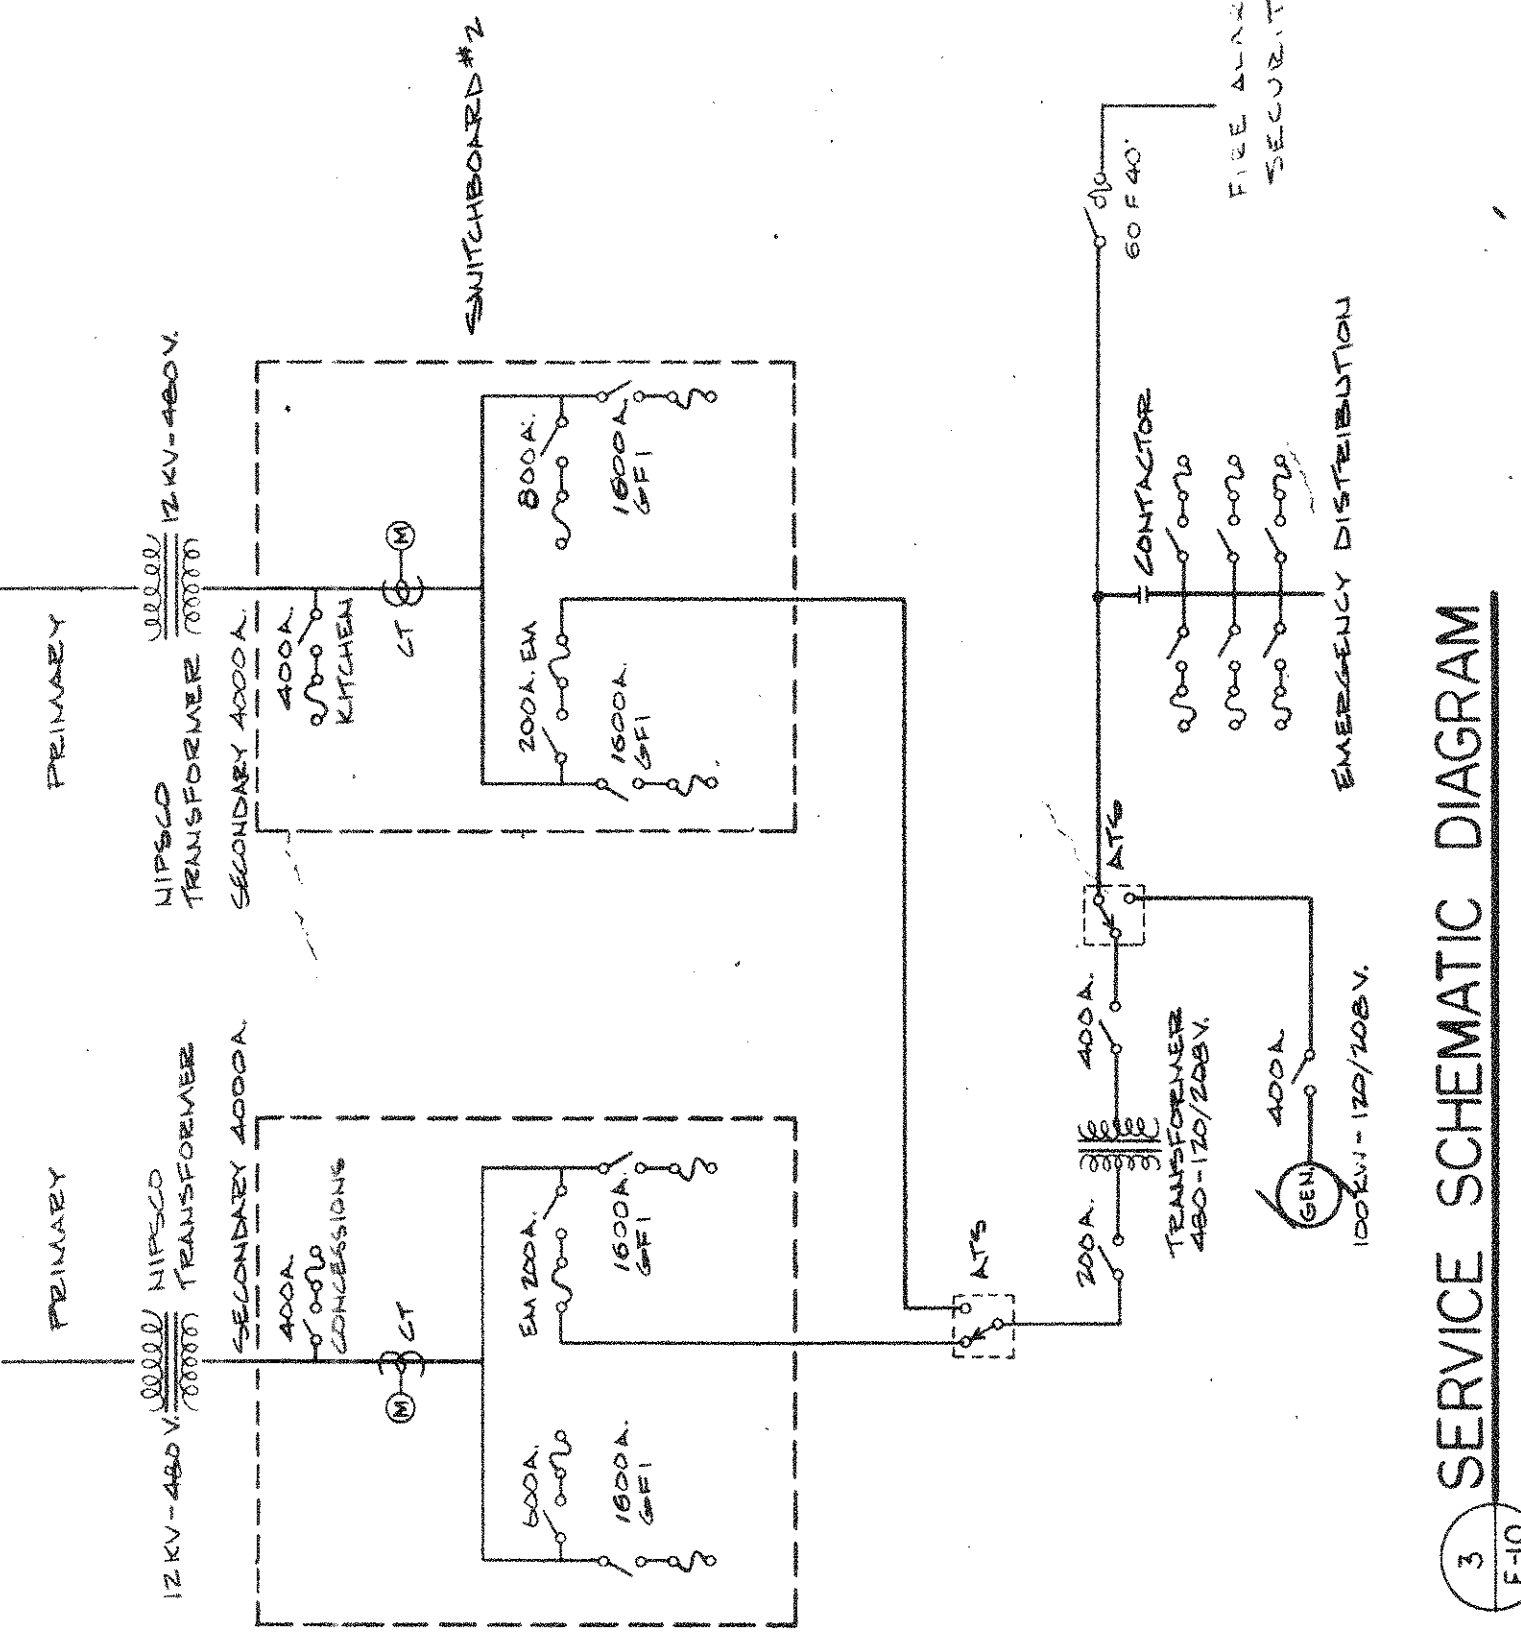

SERVICE SCHEMATIC DIAGRAM

SWITCHBOARD DETAIL

