




REVISIONS

GENESIS CENTER
ADAMS, BROADWAY, AND FIFTH AVENUE
CITY OF GARY,
RICHARD G. HATCHER,
MAYOR


WALLACE, MIDAL & DRUCKER
MECHANICAL
ELECTRICAL
CONSULTING ENGINEERS
180 N. MICHIGAN AVENUE
CHICAGO, ILL. 60610

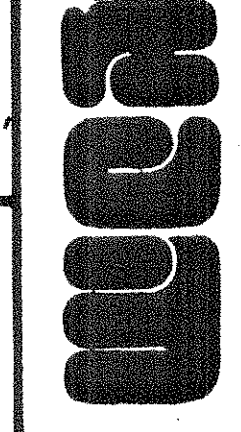


DATE	APPROVED	DESIGNED	DRAWN
10/25/82	WJ	WJ	WJ

WING PLAN -
GROUND &
SECOND FLOOR

E-5

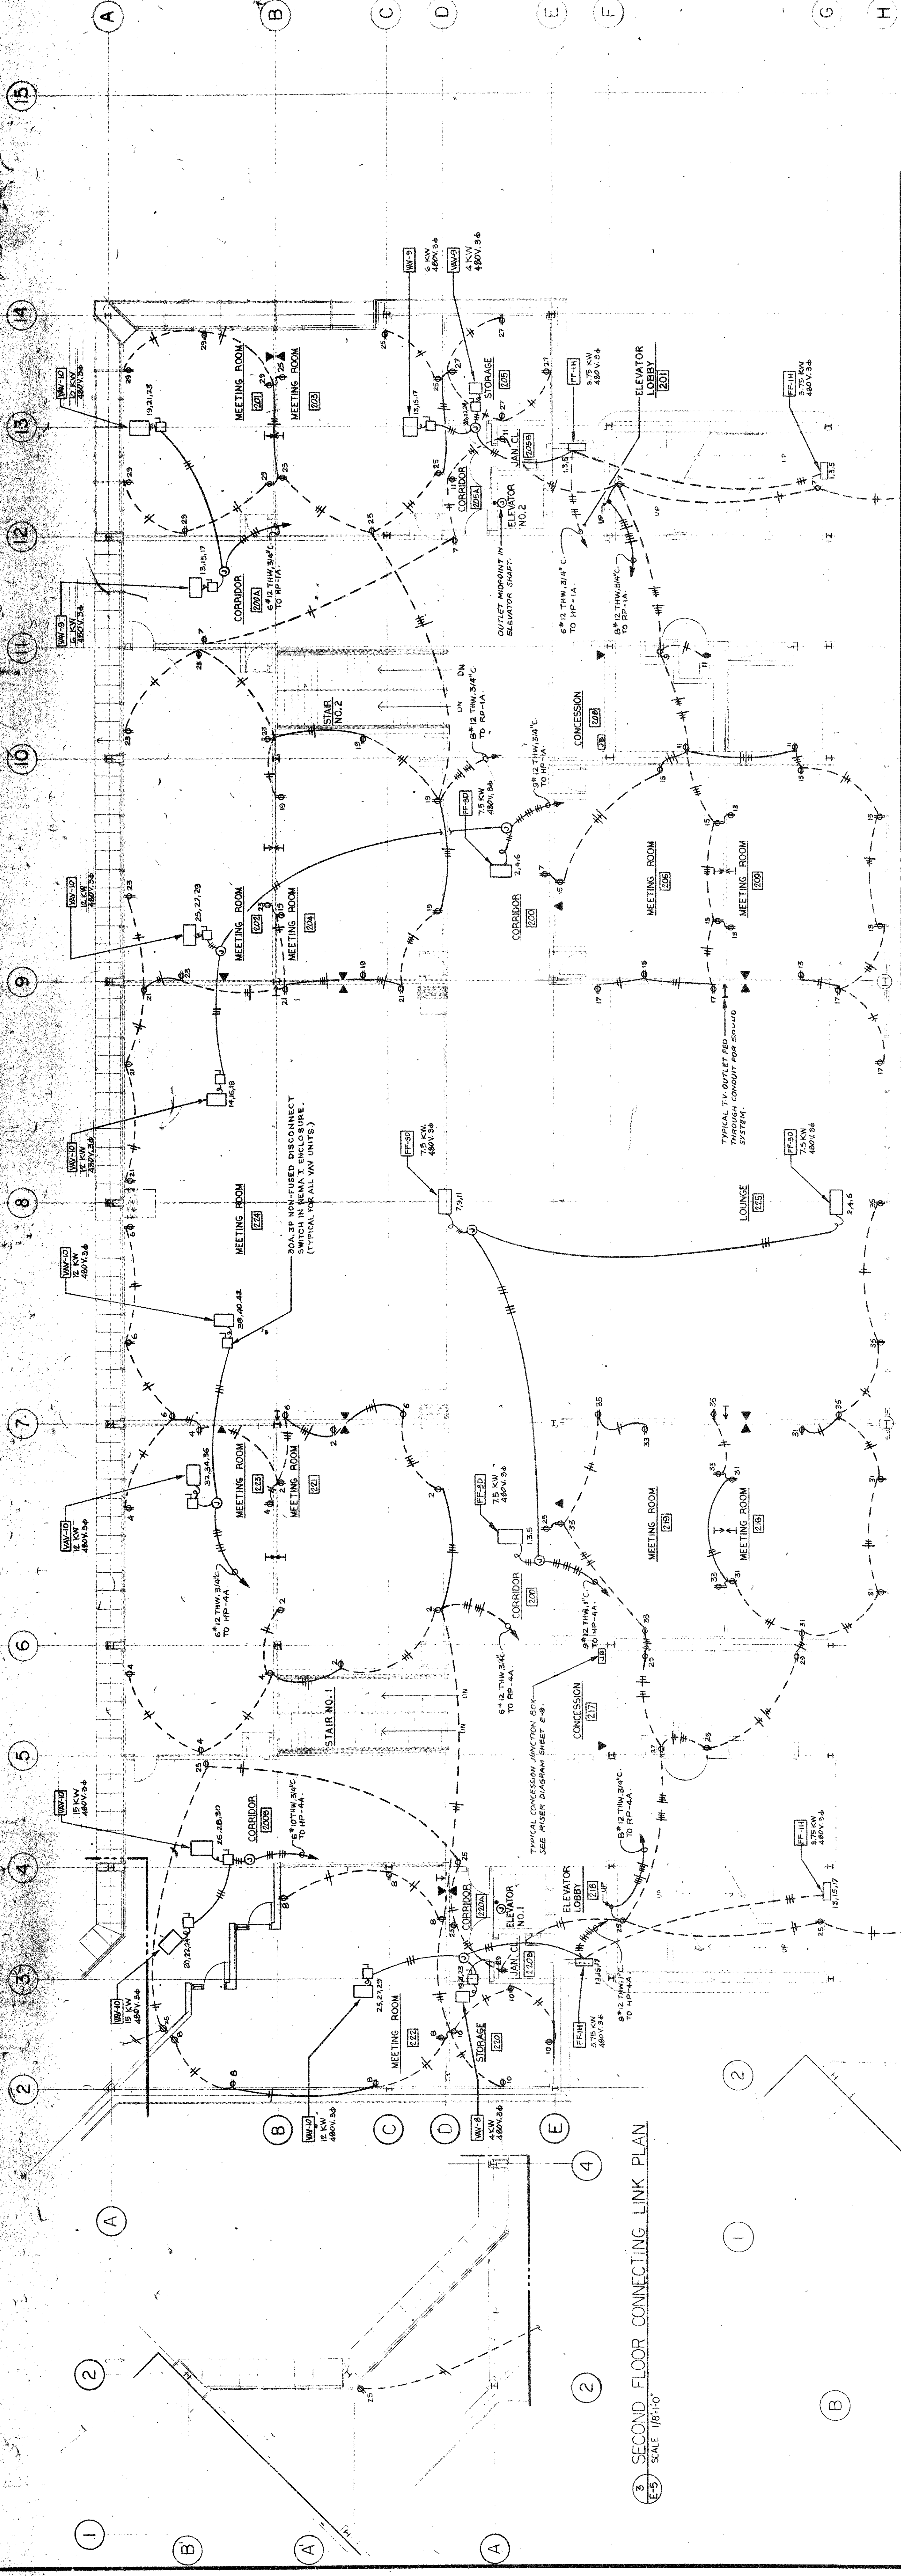

2 SECOND FLOOR CONNECTING LINK PLAN
SCALE 1/8"=1'-0"

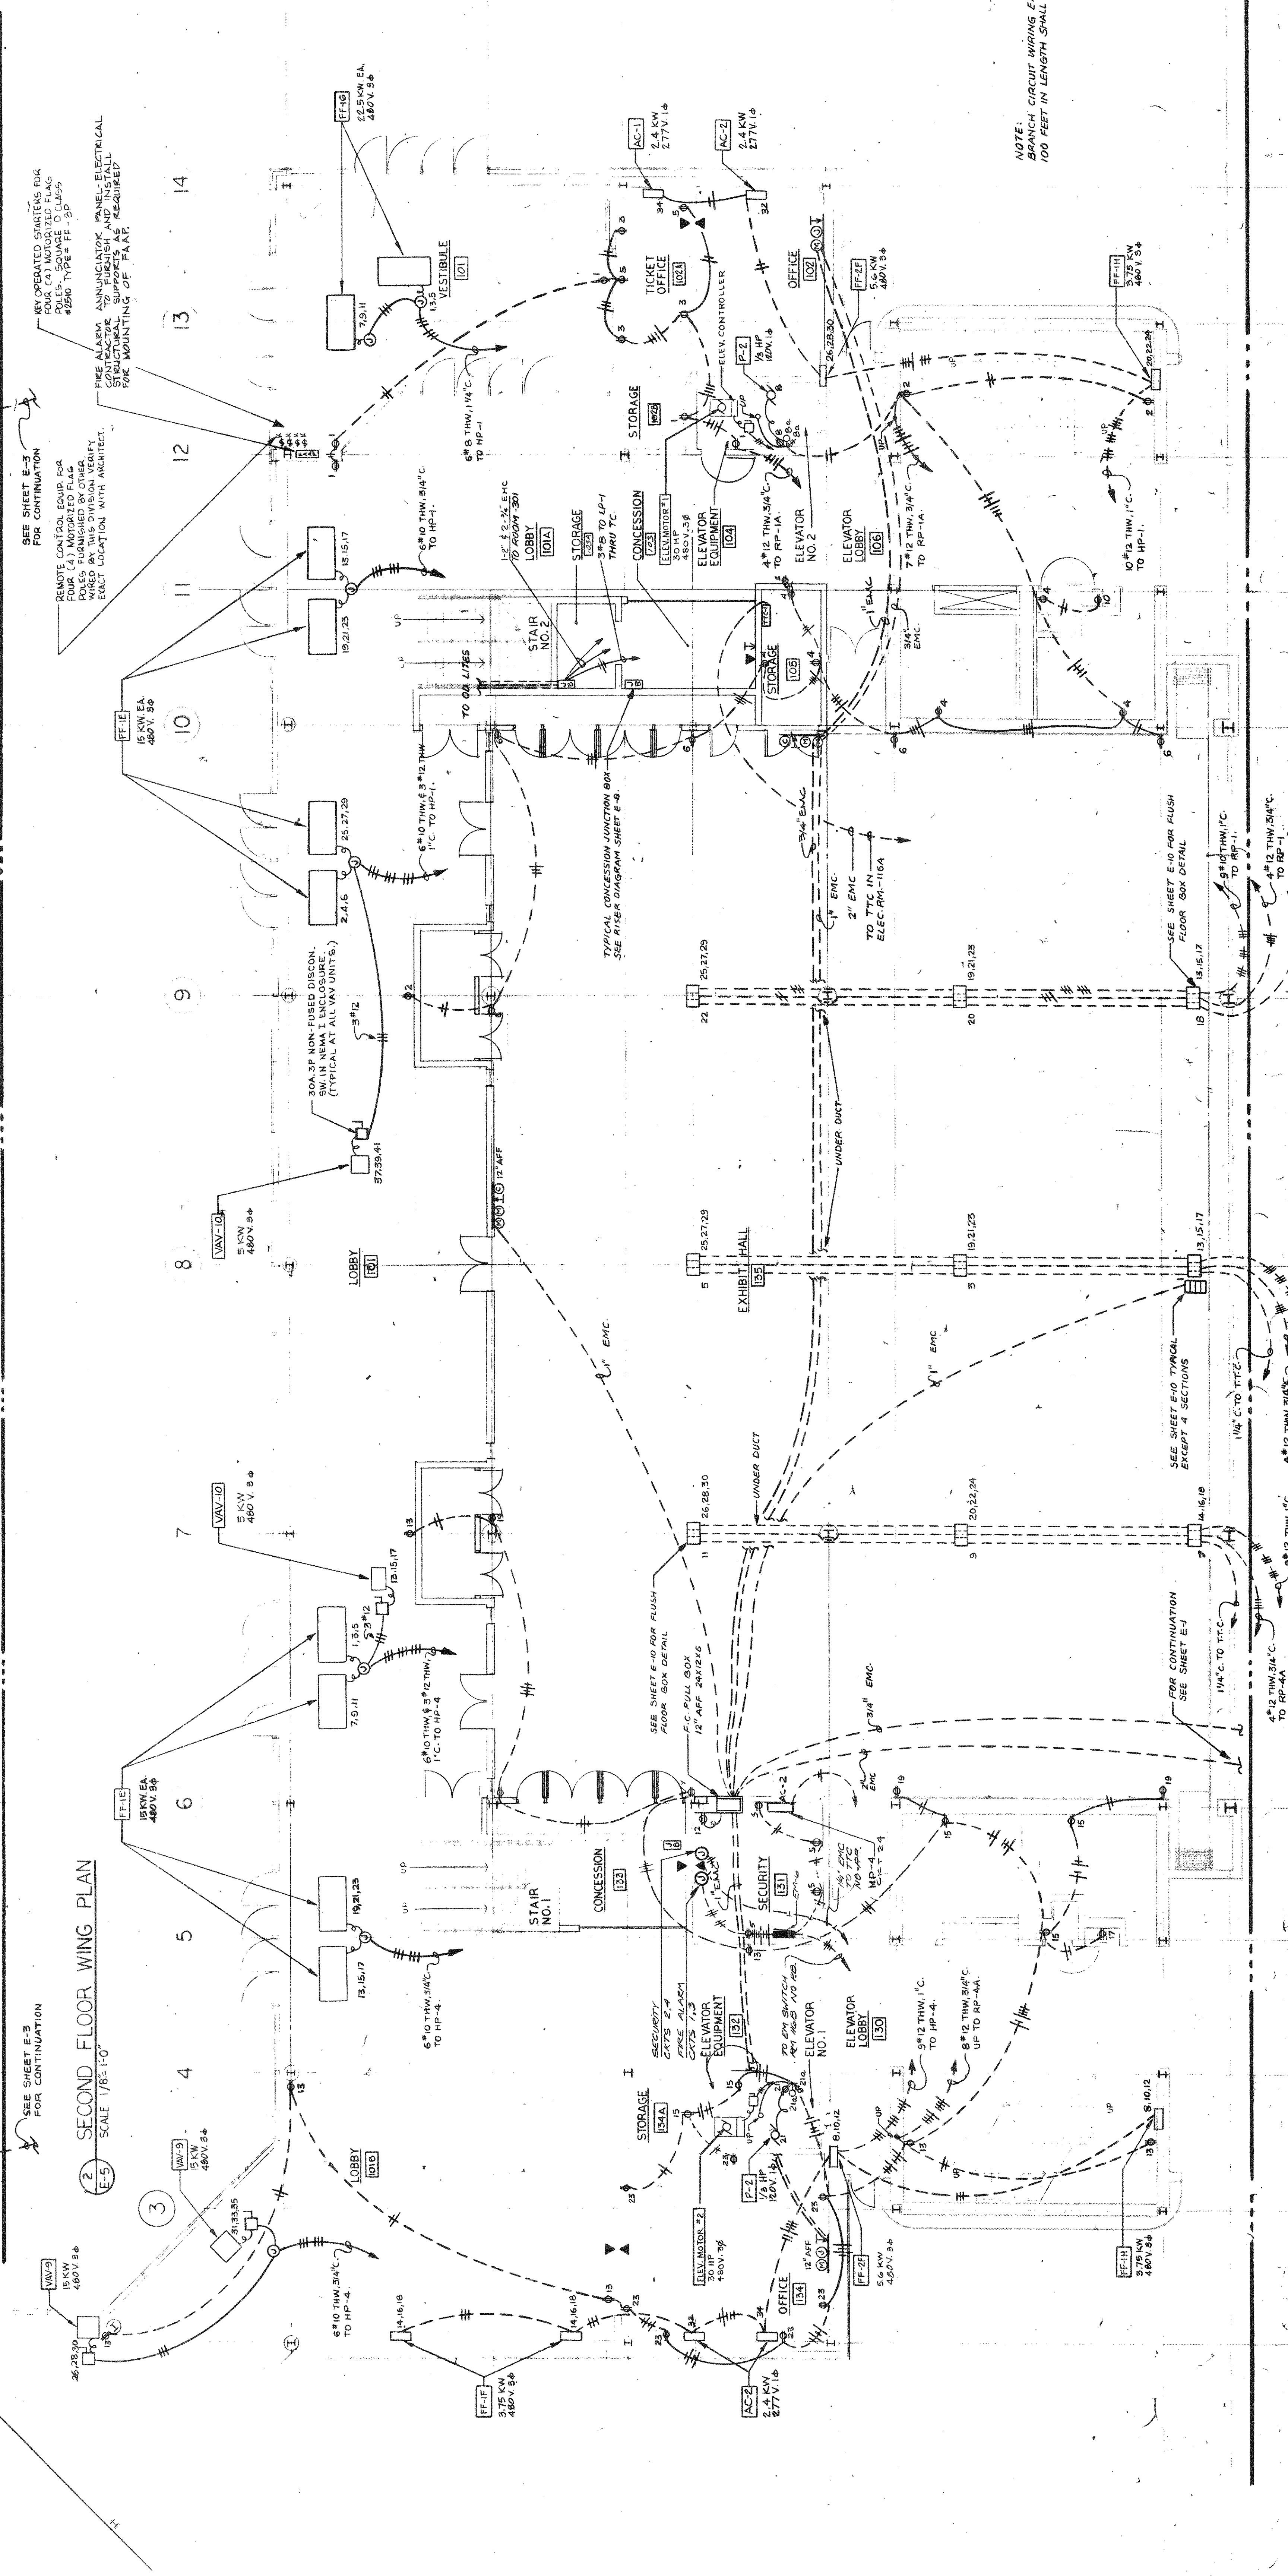

2 SECOND FLOOR WING PLAN
SCALE 1/8"=1'-0"

2 SECOND FLOOR WING PLAN
SCALE 1/8"=1'-0"

NOTE: BRANCH CIRCUIT BREAKERS
100 AMP IN LENGTH SHALL BE 100 AMP.