

CONTENTS
GROUND FLOOR
PLAN
ARENA BLDG.


DATE 07-02-80
APPROVED
CHECKED
DRAWN

WALLACE, MODAL & DRUCKER
CONSULTING
ELECTRICAL
ENGINEERS
444 N. MICHIGAN AVENUE
SUITE 1000 CHICAGO, ILL. 60610


WALLACE, MODAL & DRUCKER
ARCHITECTS
180 N. MICHIGAN AVENUE
SUITE 1000 CHICAGO, ILL. 60610
RICHARD & HATCHER,
CITY OF GARY,
ADAMS, BROADWAY, AND FIFTH AVENUE
MAYOR

GENESIS CENTER
CITY OF GARY,
ADAMS, BROADWAY, AND FIFTH AVENUE
MAYOR

R.F. STIONS

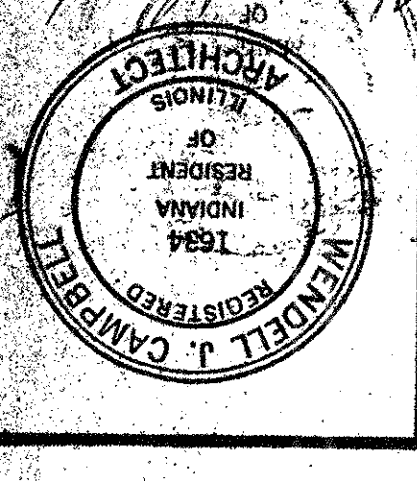

① GROUND FLOOR PLAN
SCALE: 1/8" = 1'-0"

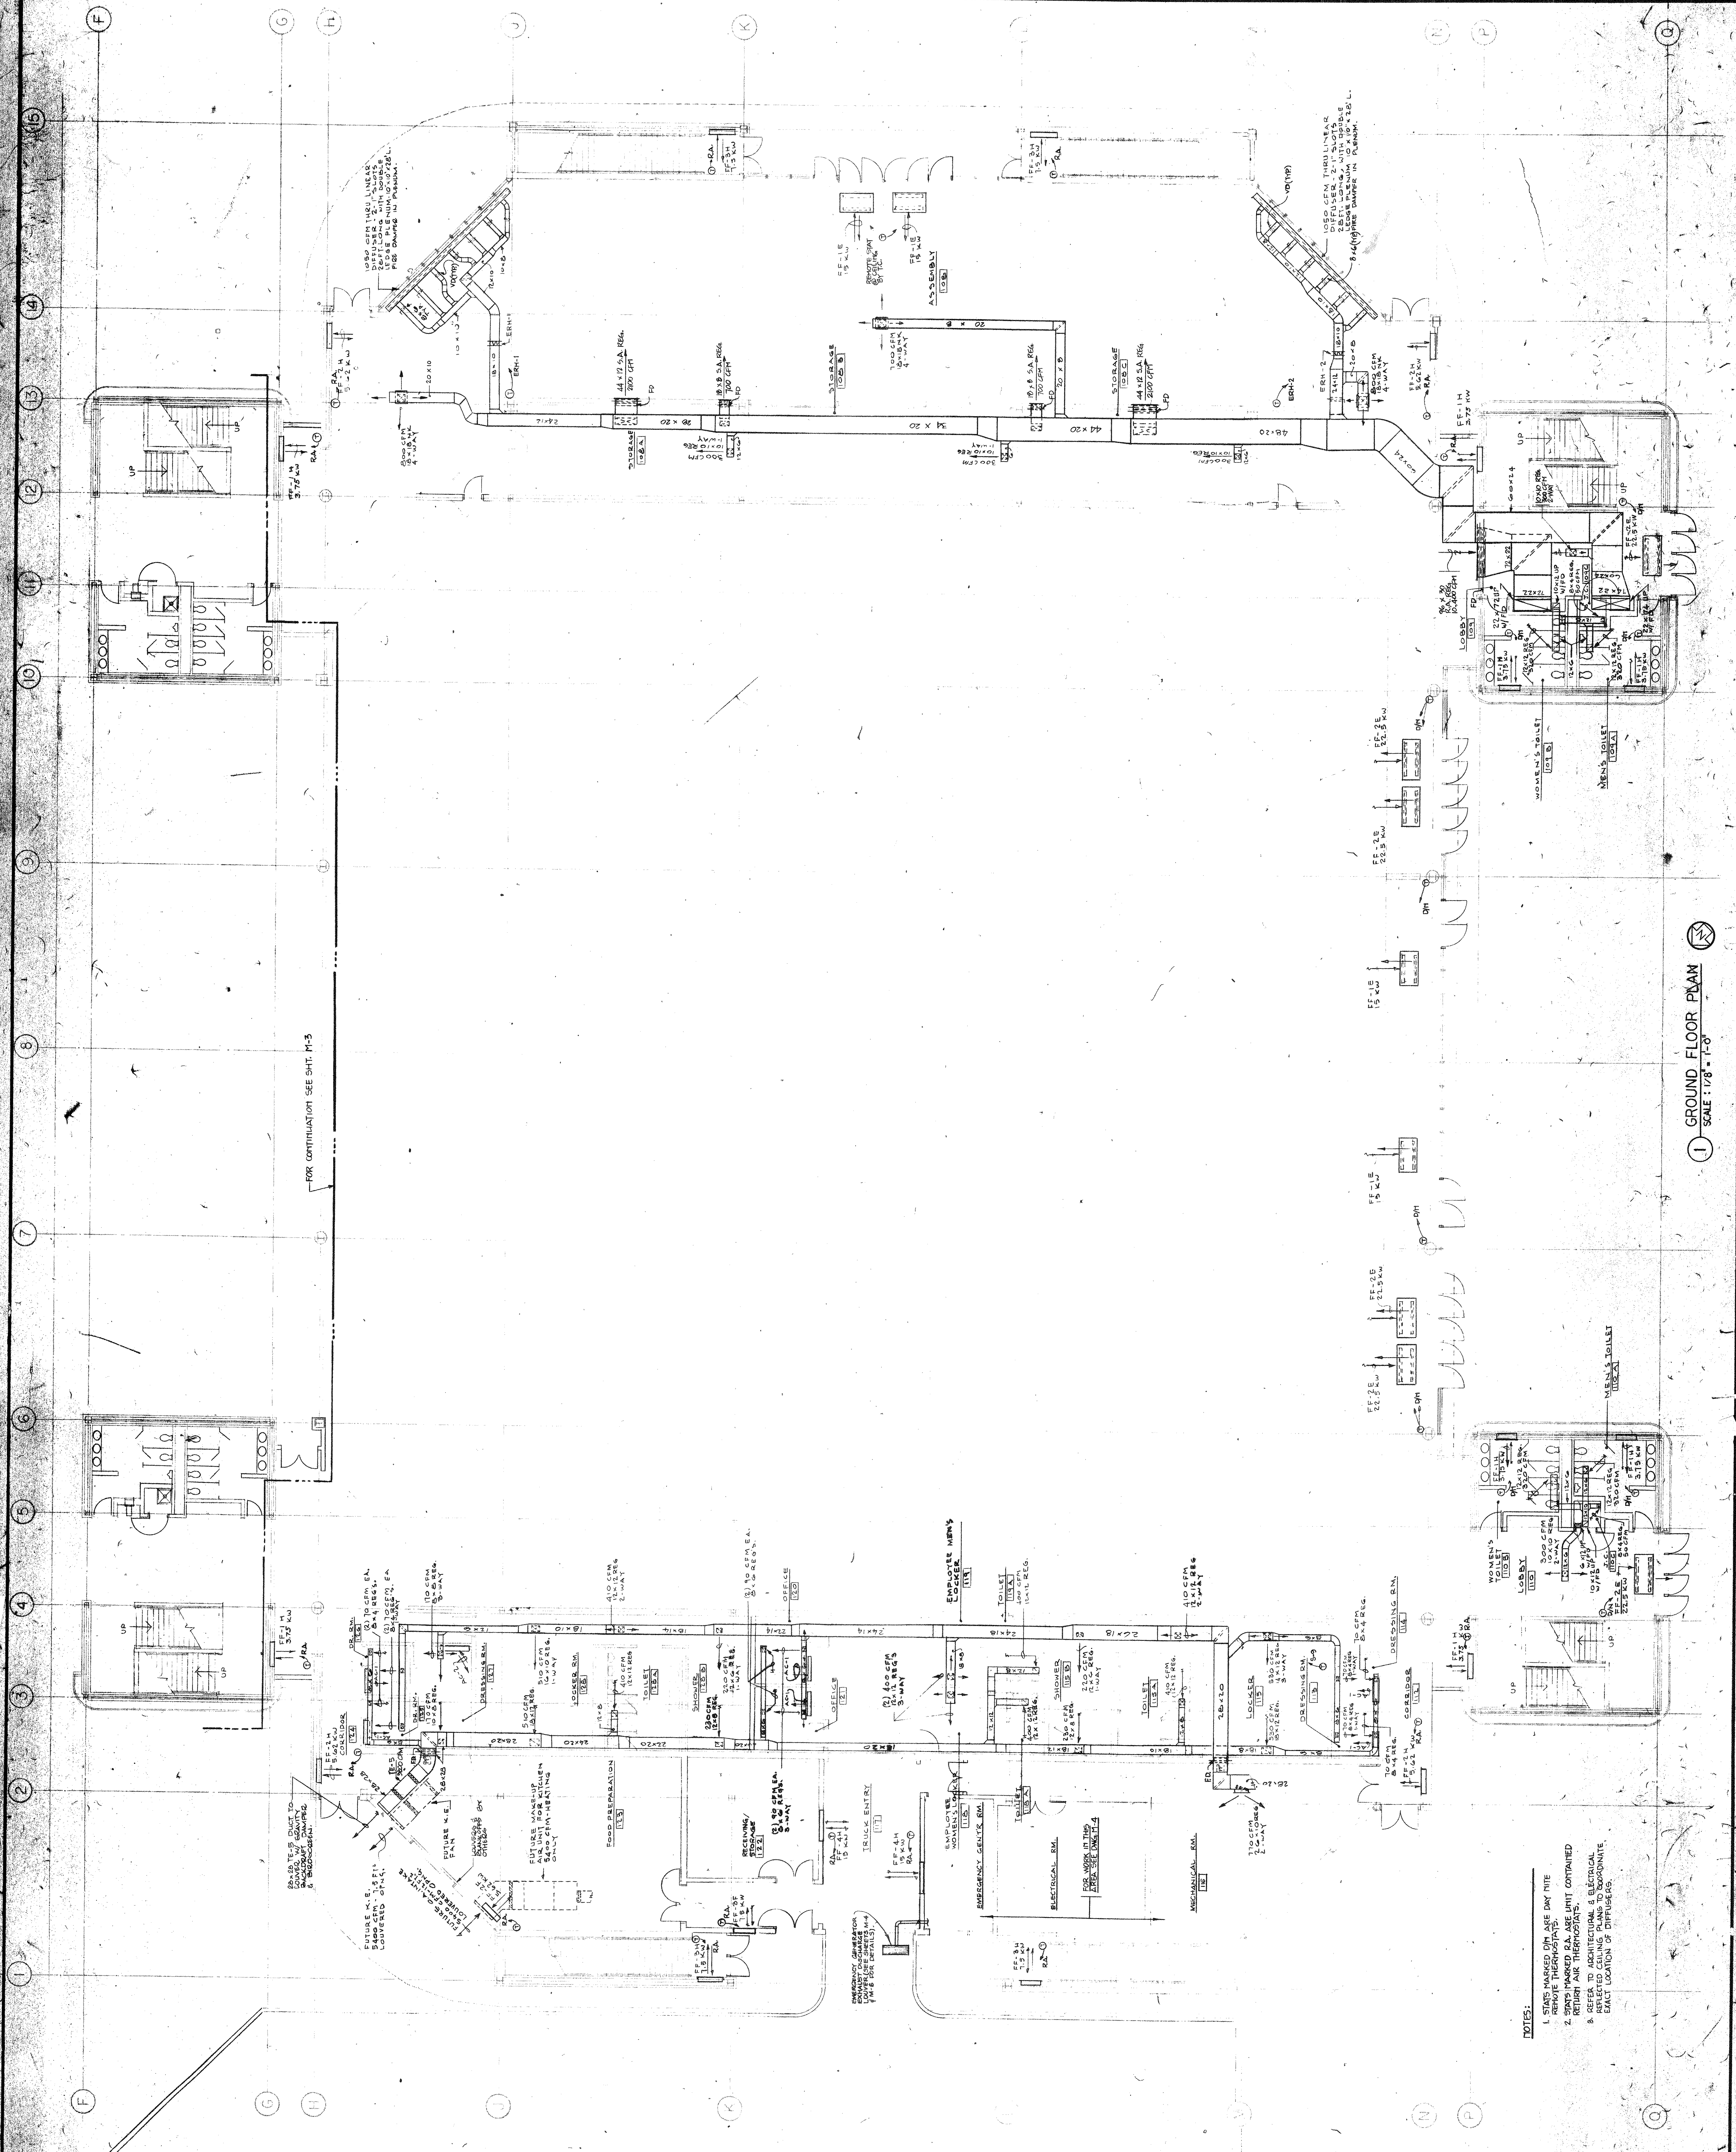

- NOTES:
1. STAIRS MARKED WITH DAY NITE
 2. REPAIRS TO EXISTING UNIT OBTAINED
 3. REPAIRS TO EXISTING UNIT OBTAINED
