


RICHARD G. HATCHER.

CONSULTING
MECHANICAL
ELECTRICAL
ENGINEERS
444 N. Orleans 822-9760
Chicago, ILL. 60610



GROUND FLOOR
-AN-
RENA BUILDING

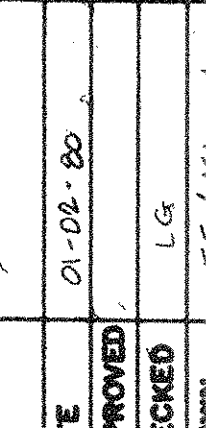