
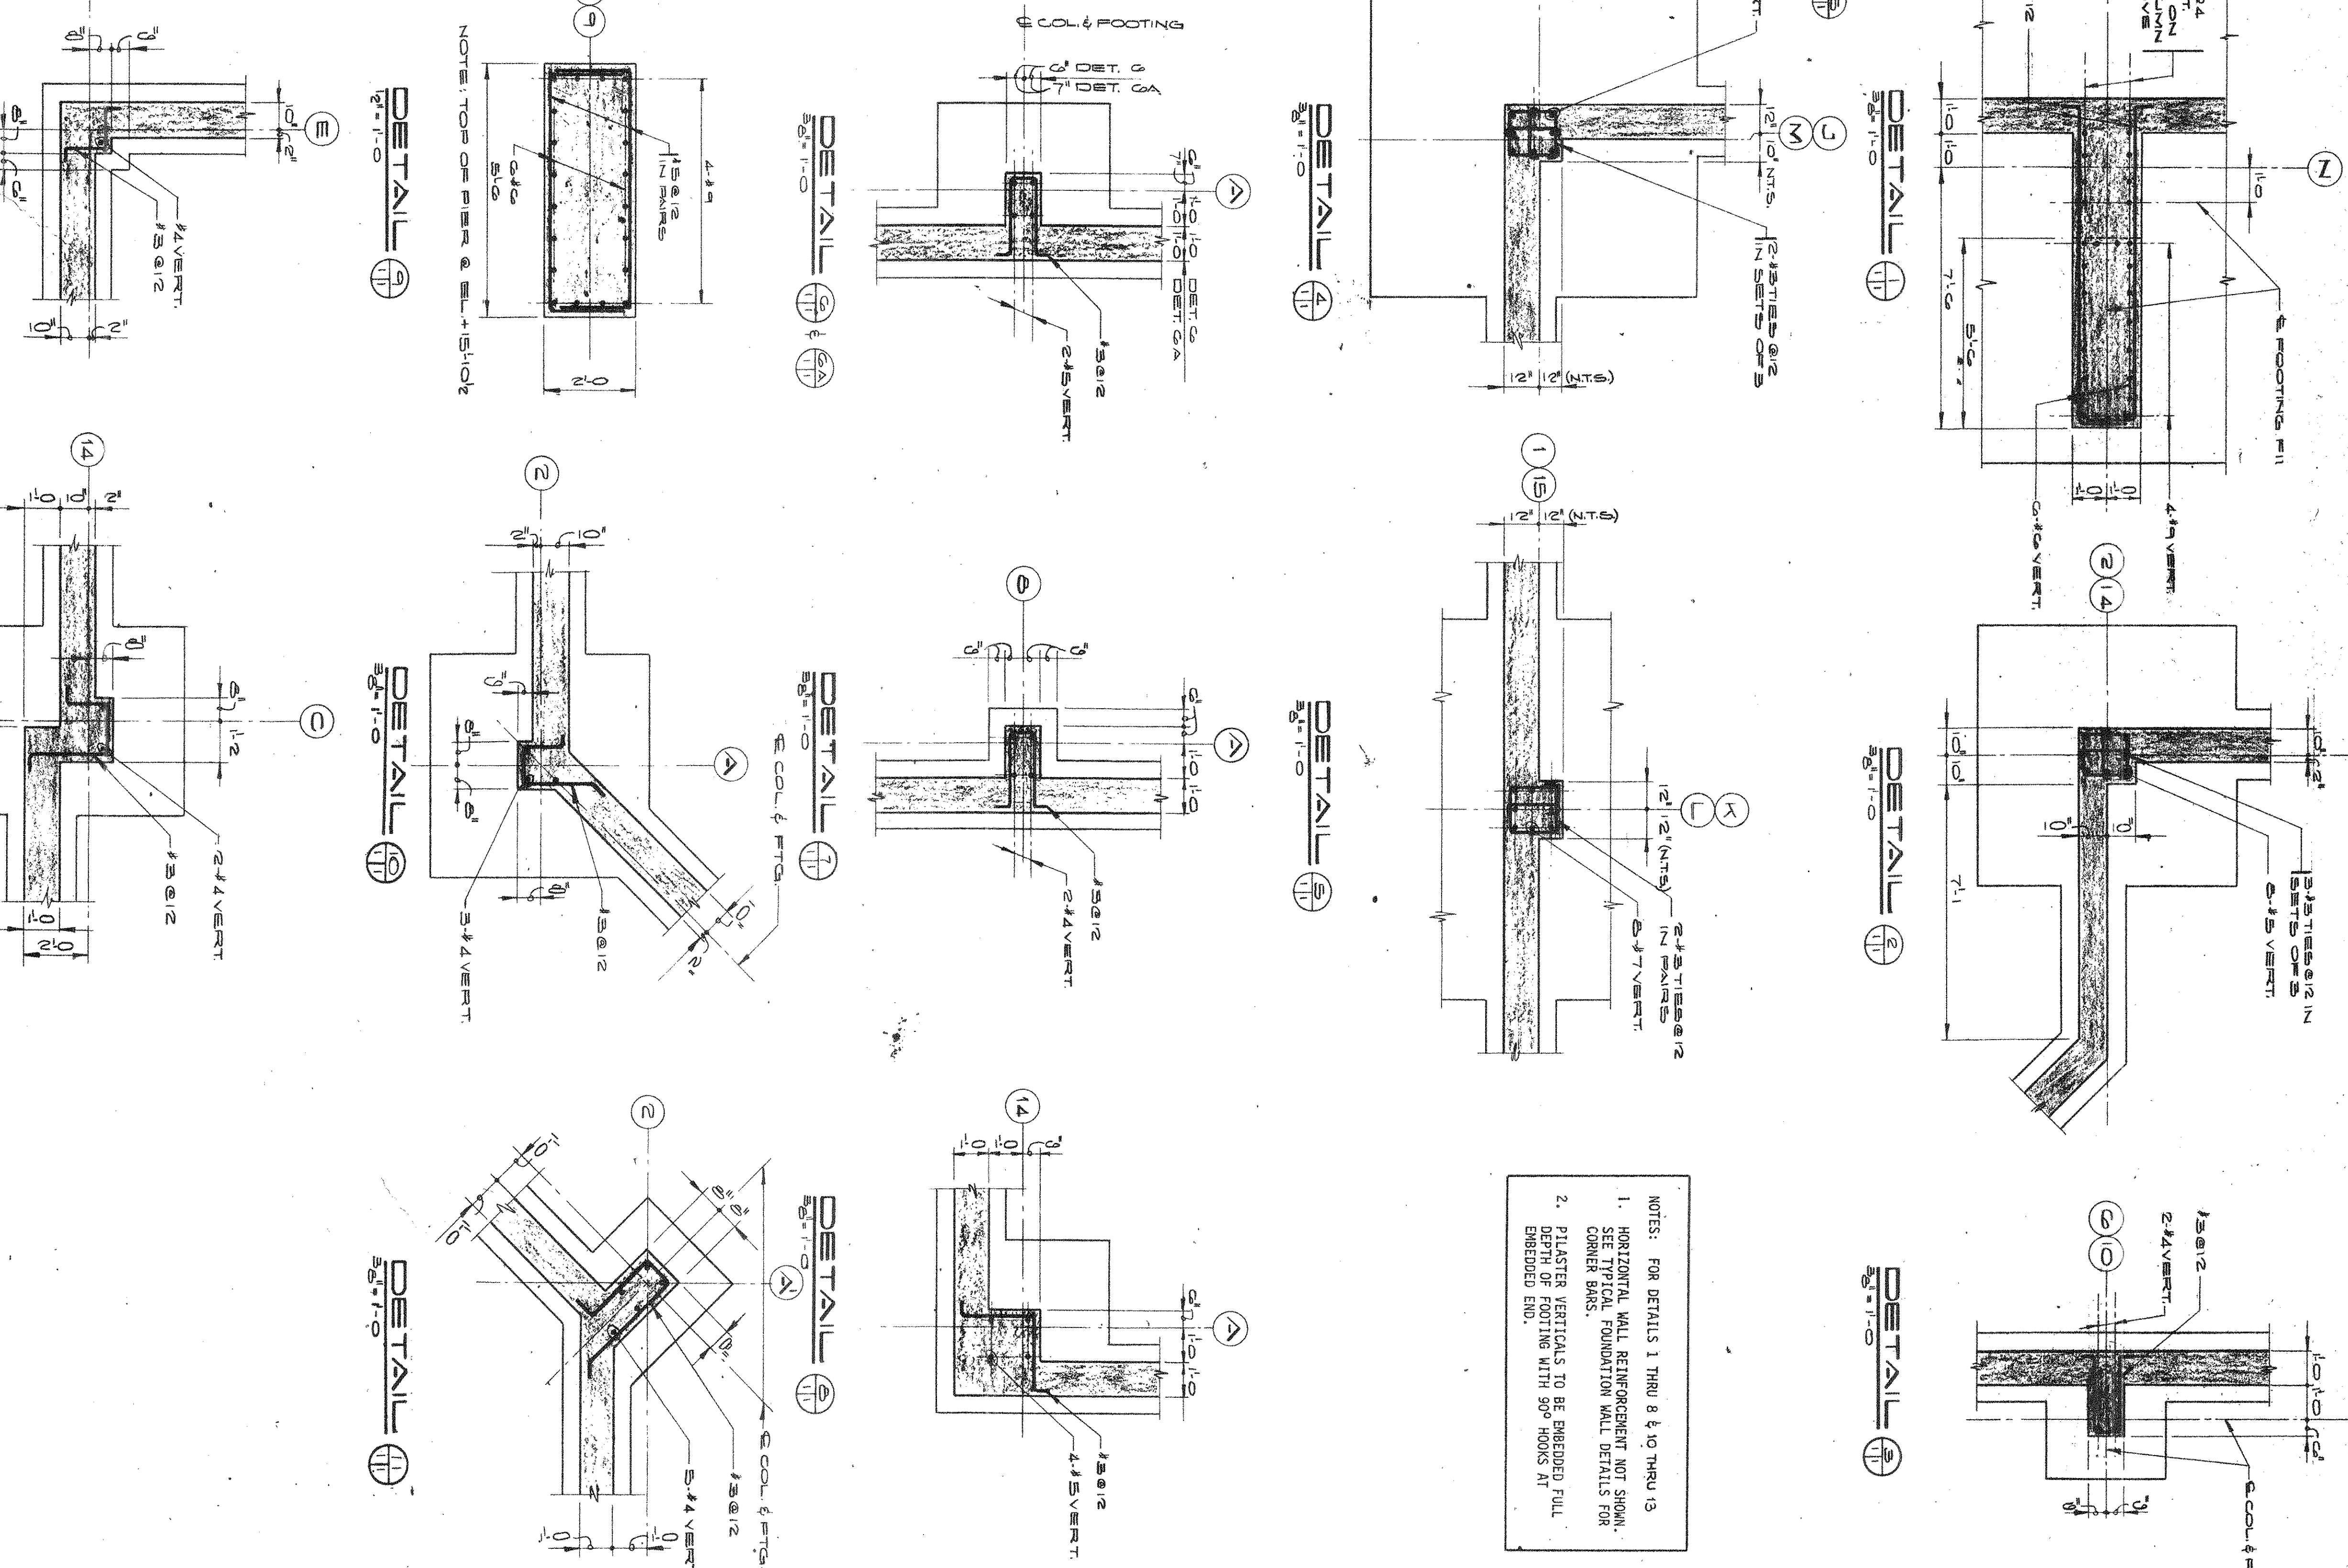
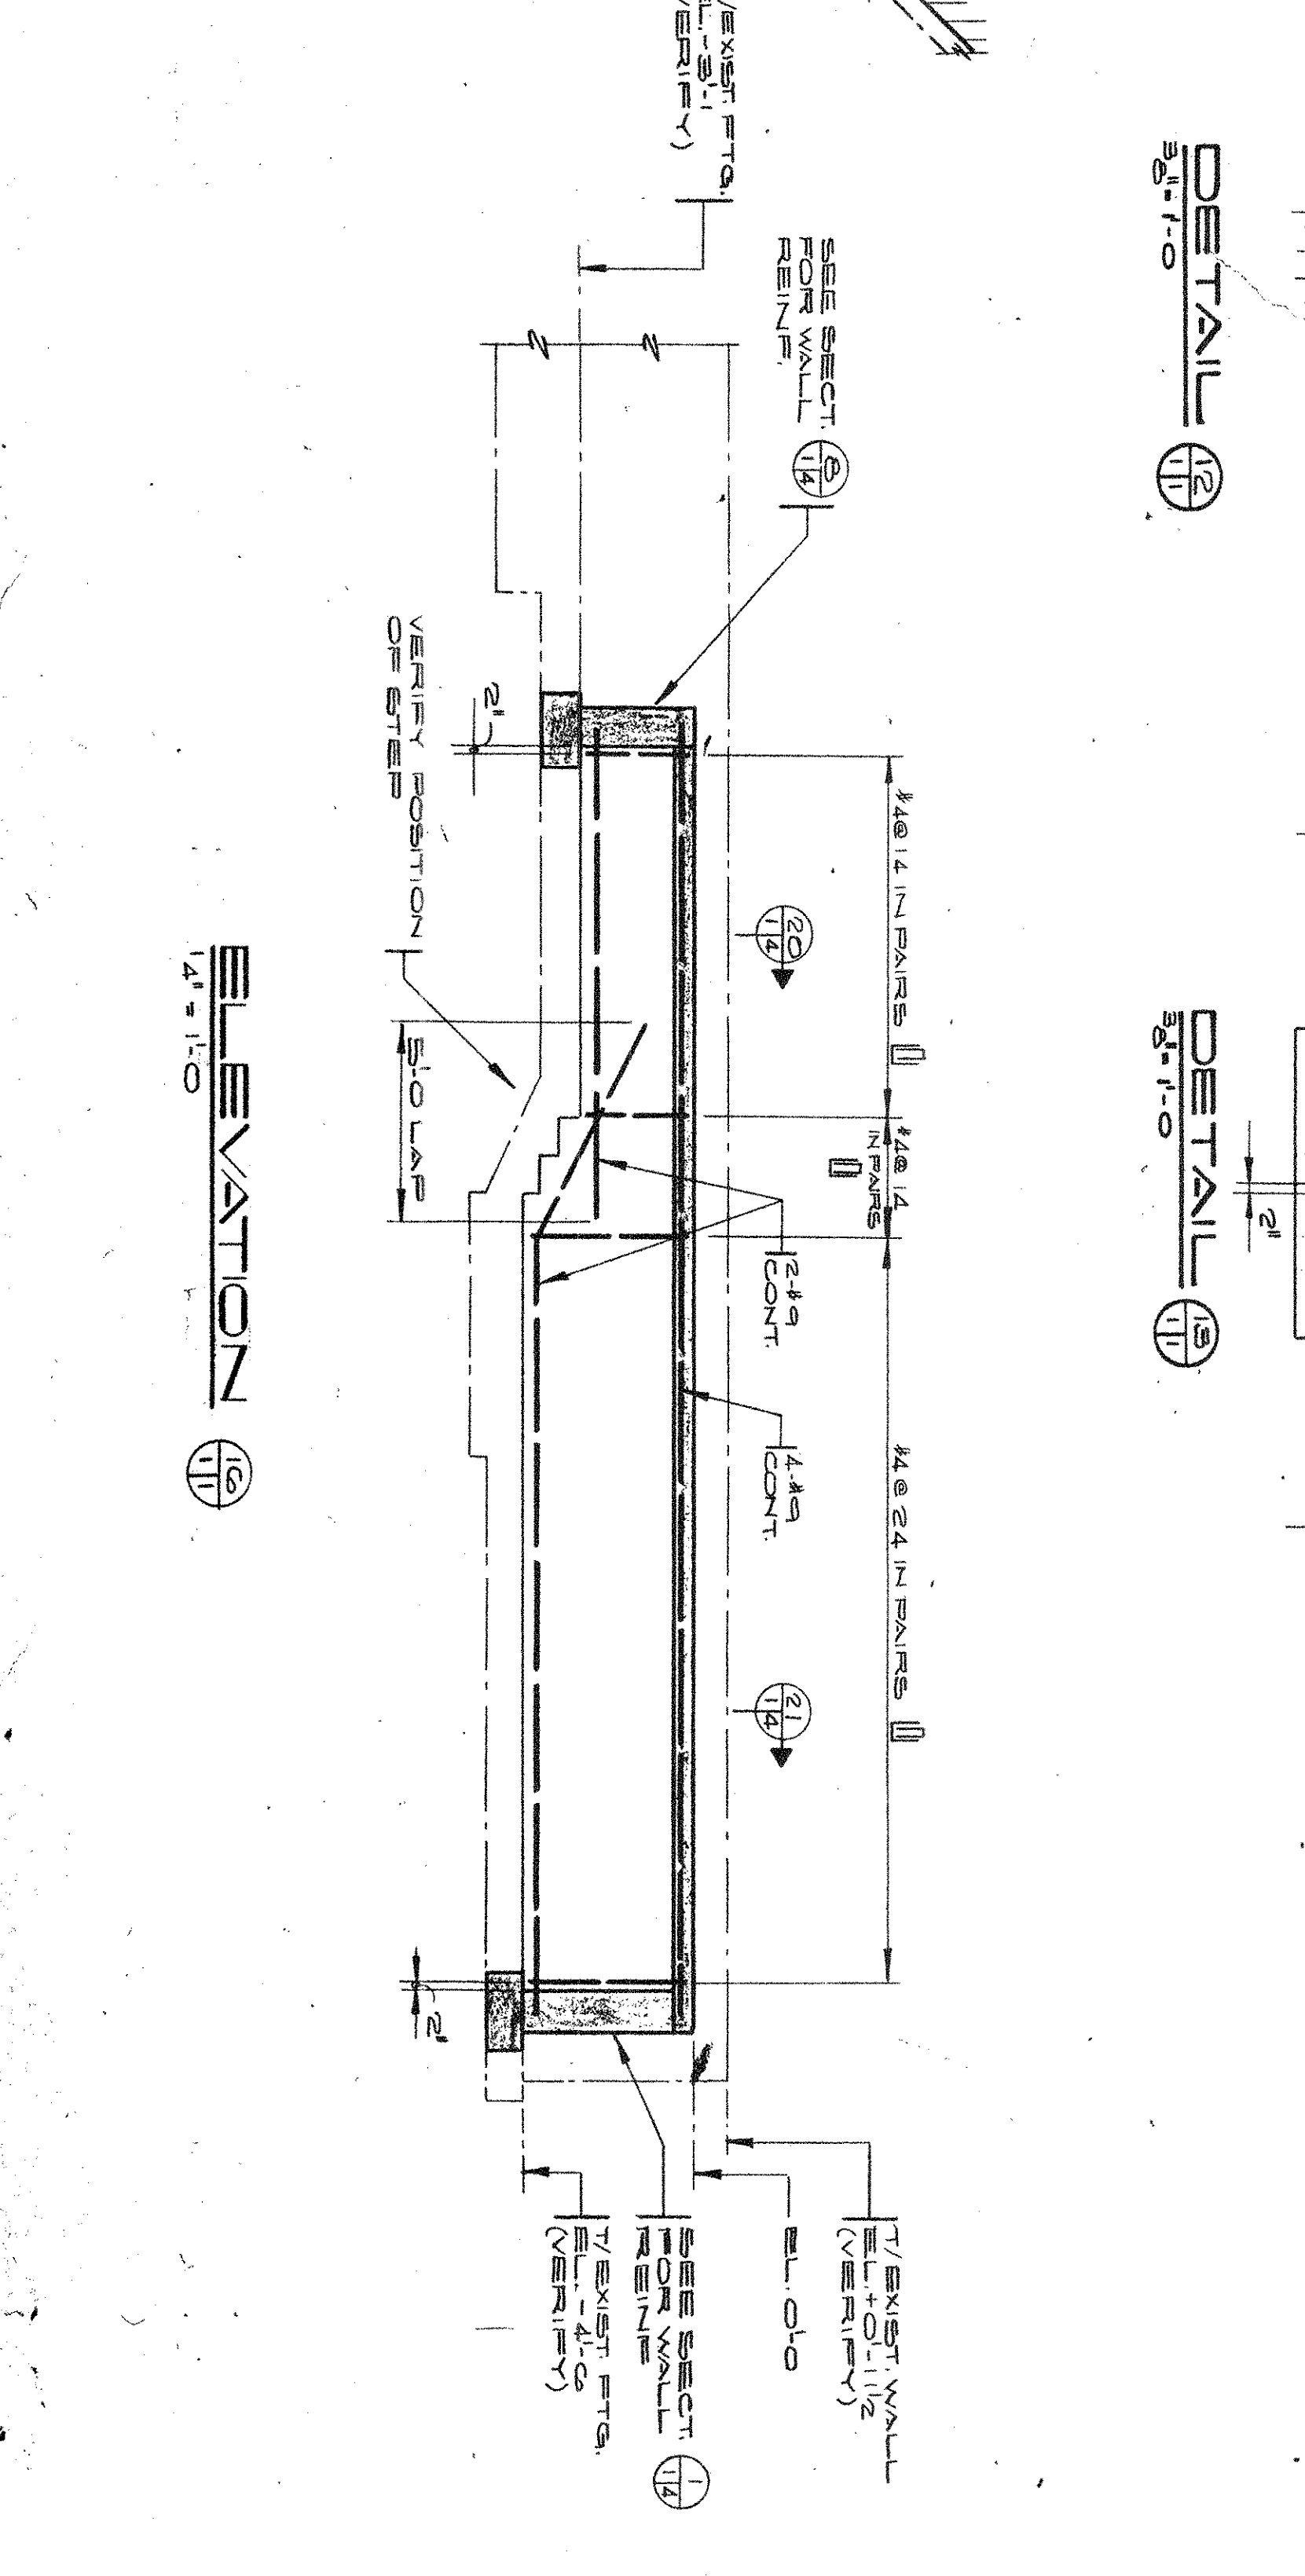
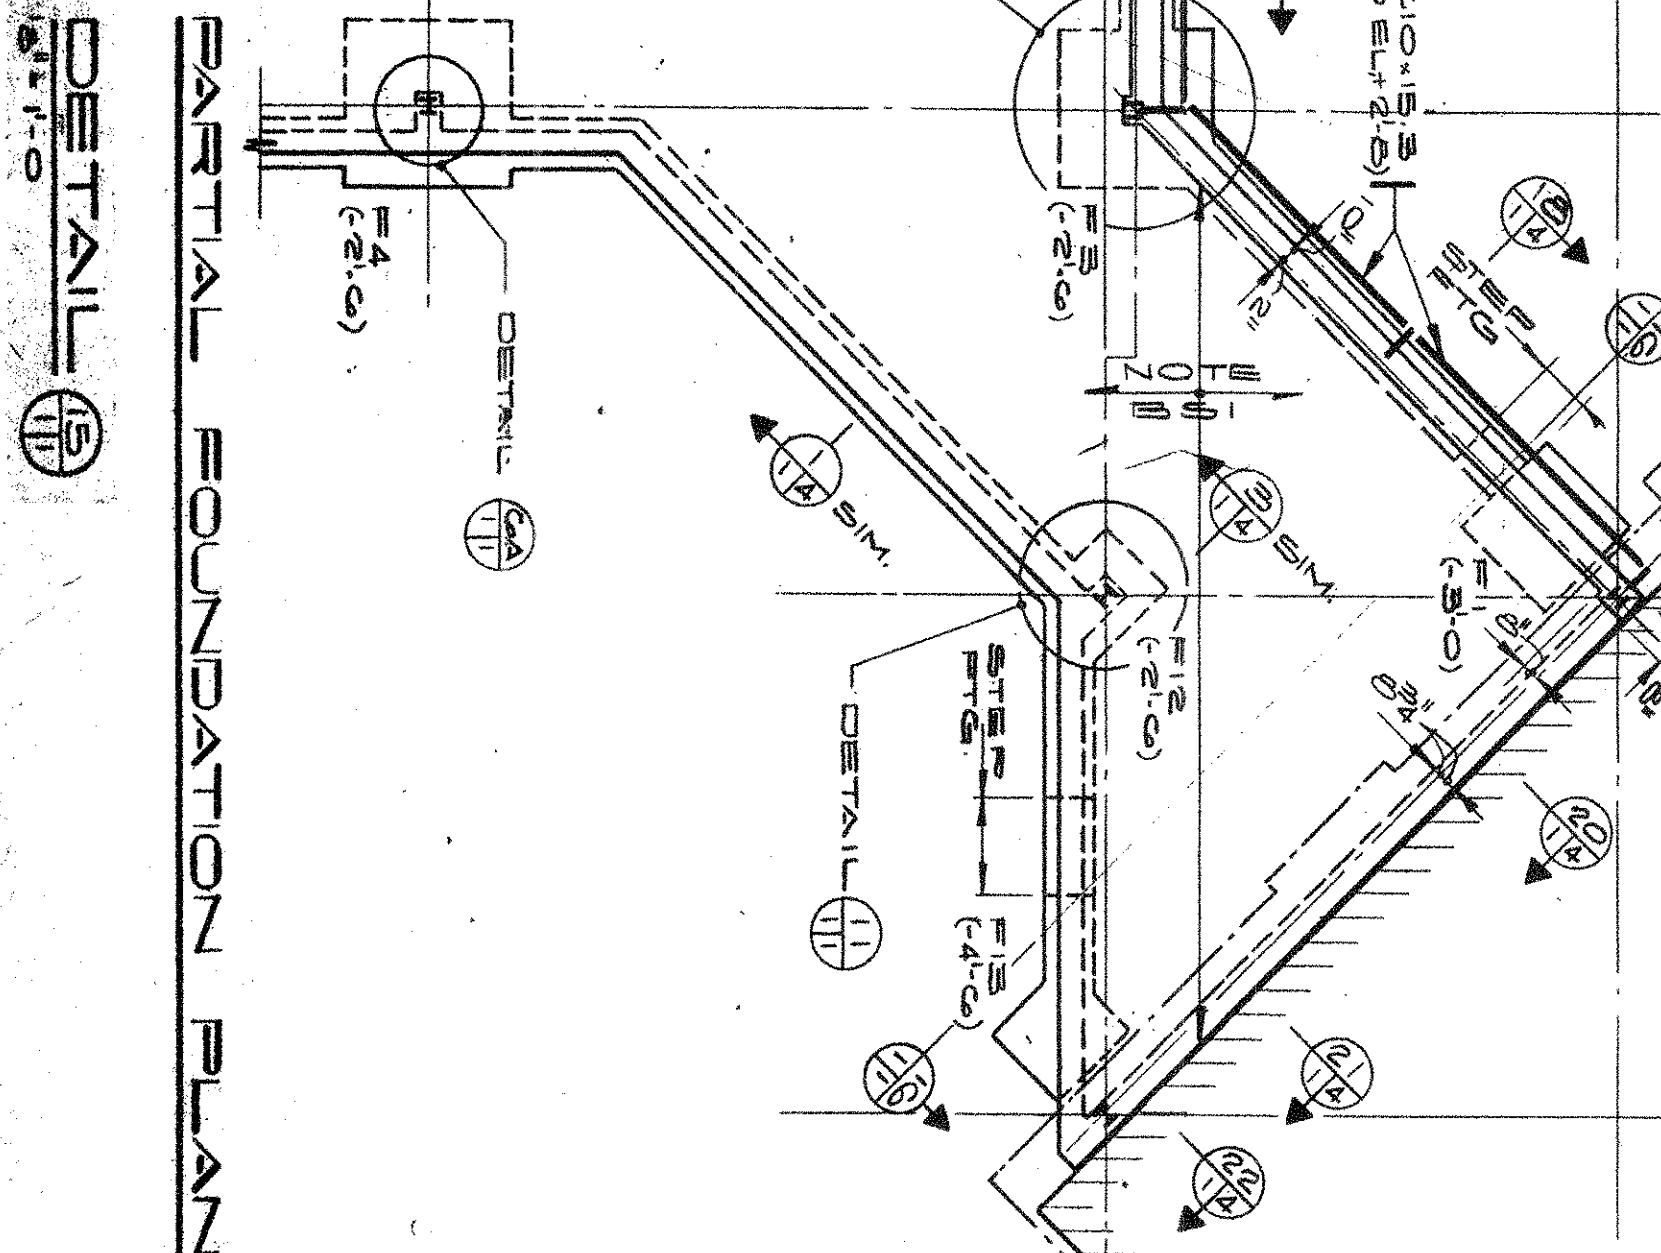
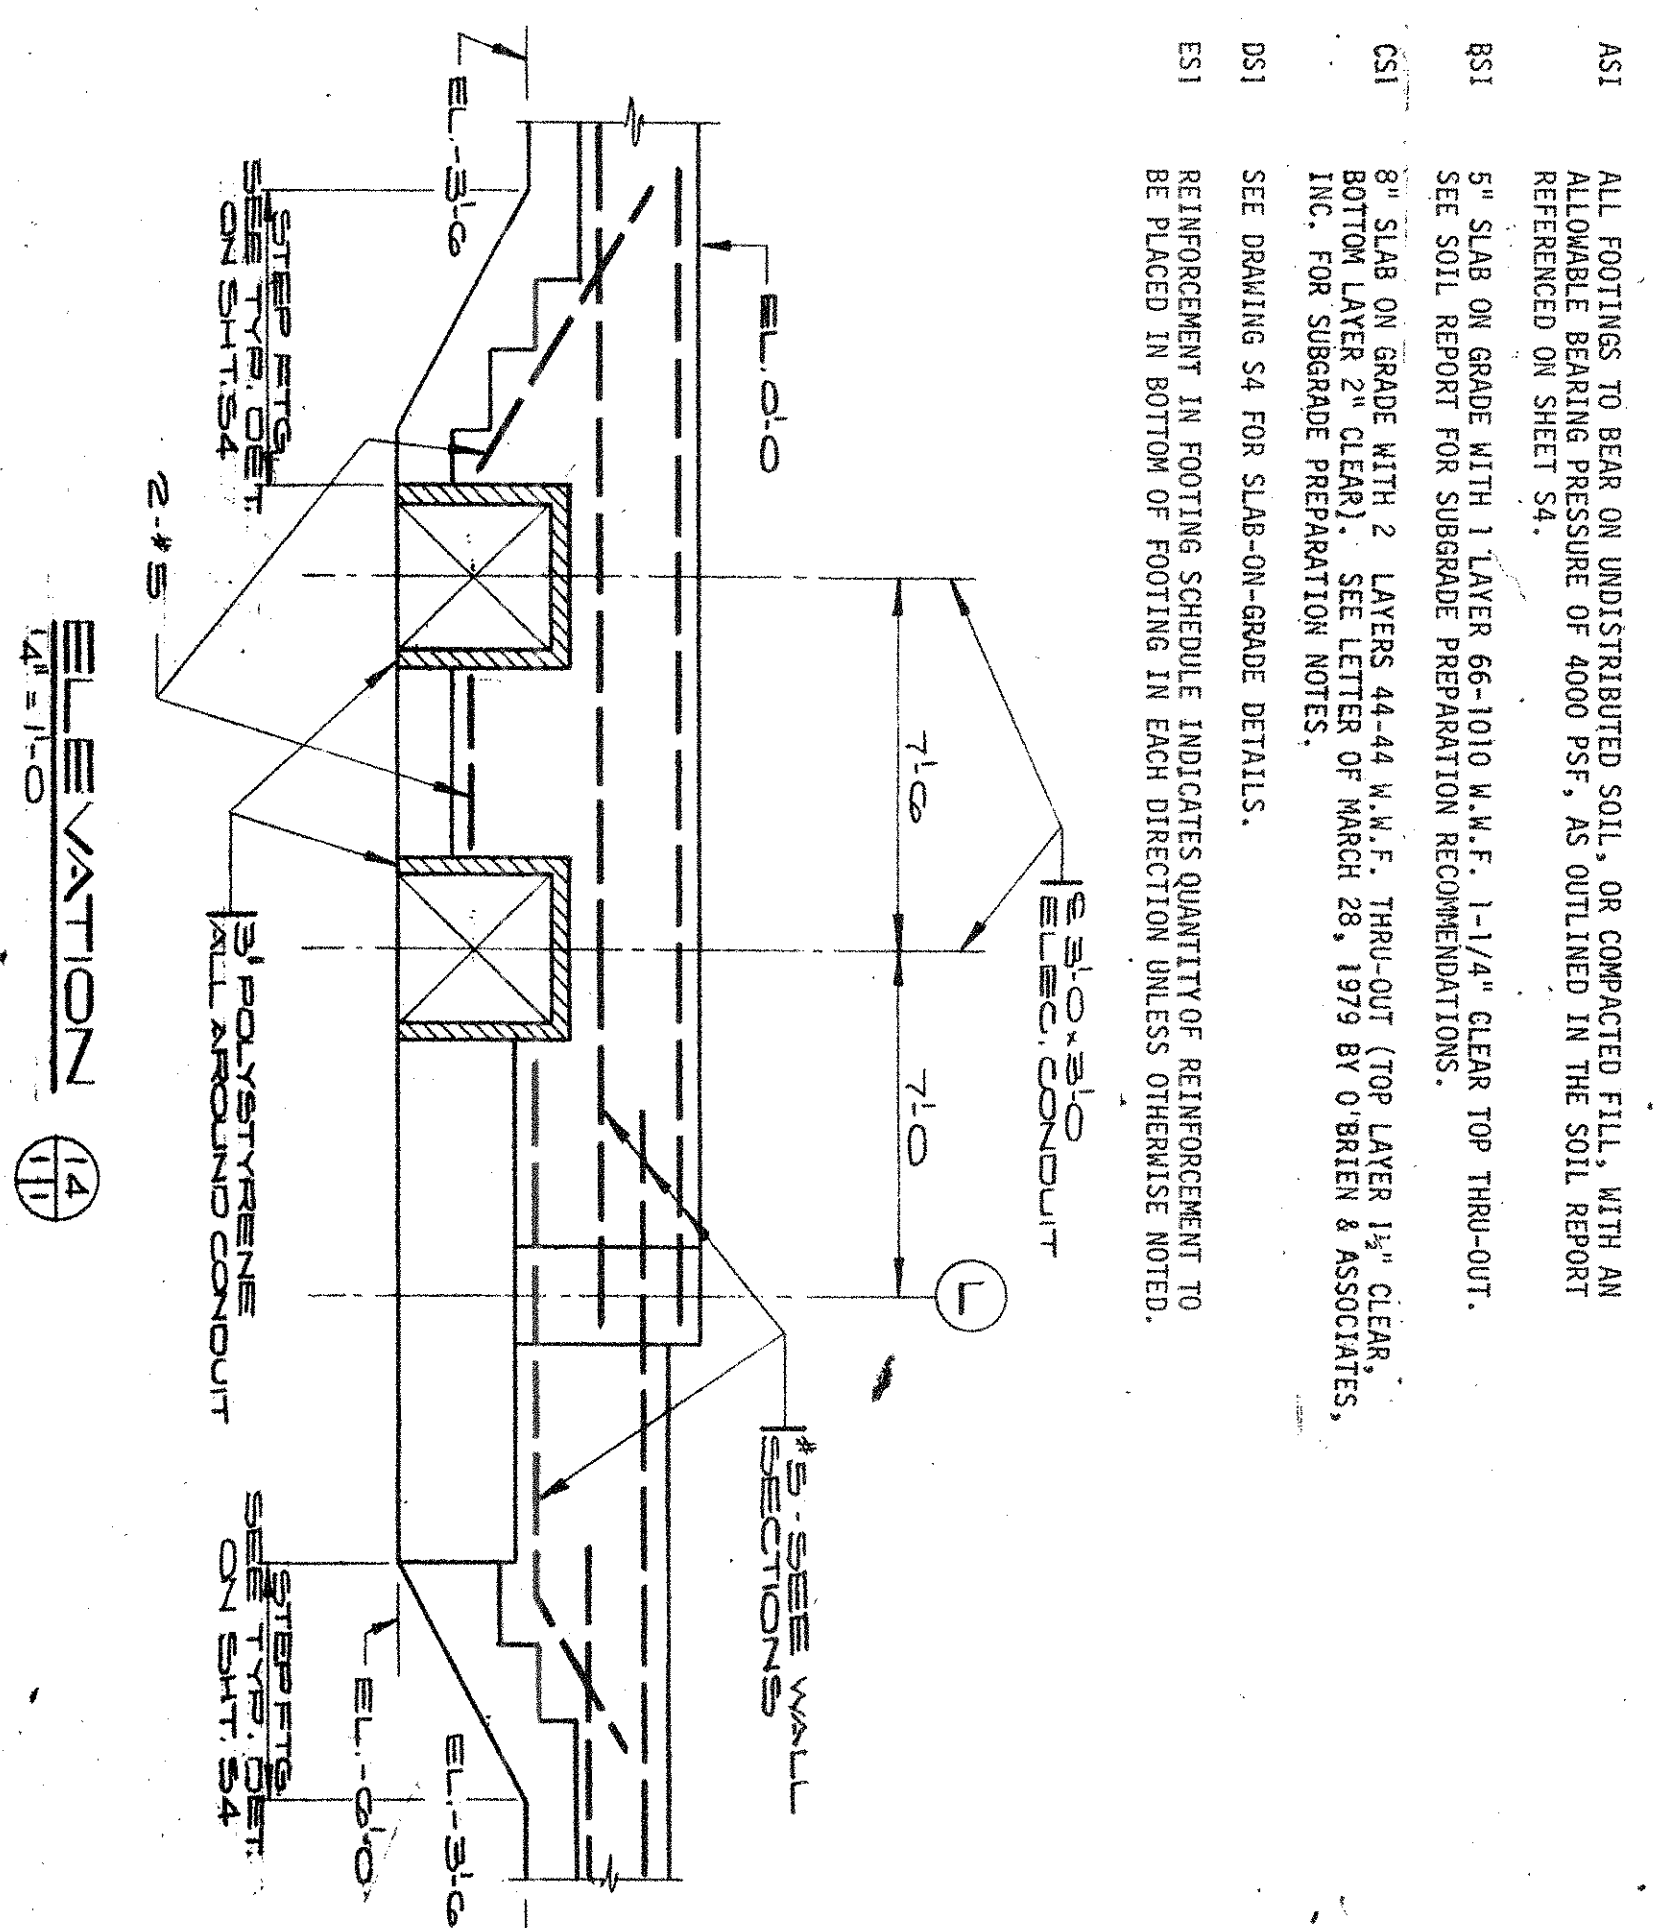


XXXX

MARK	SIZE	REINFORCEMENT	CONCRETE	REMARKS
F1	6" x 10" x 12"	5 #5		831
F2	6" x 10" x 12"	5 #5		631
F3	6" x 10" x 12"	5 #5		
F4	6" x 10" x 12"	5 #5		
F5	6" x 10" x 12"	5 #5		
F100	6" x 10" x 12"	5 #5		

FOUNDATION AND GROUND FLOOR PLAN

SCALE 1/8" = 1'-0"

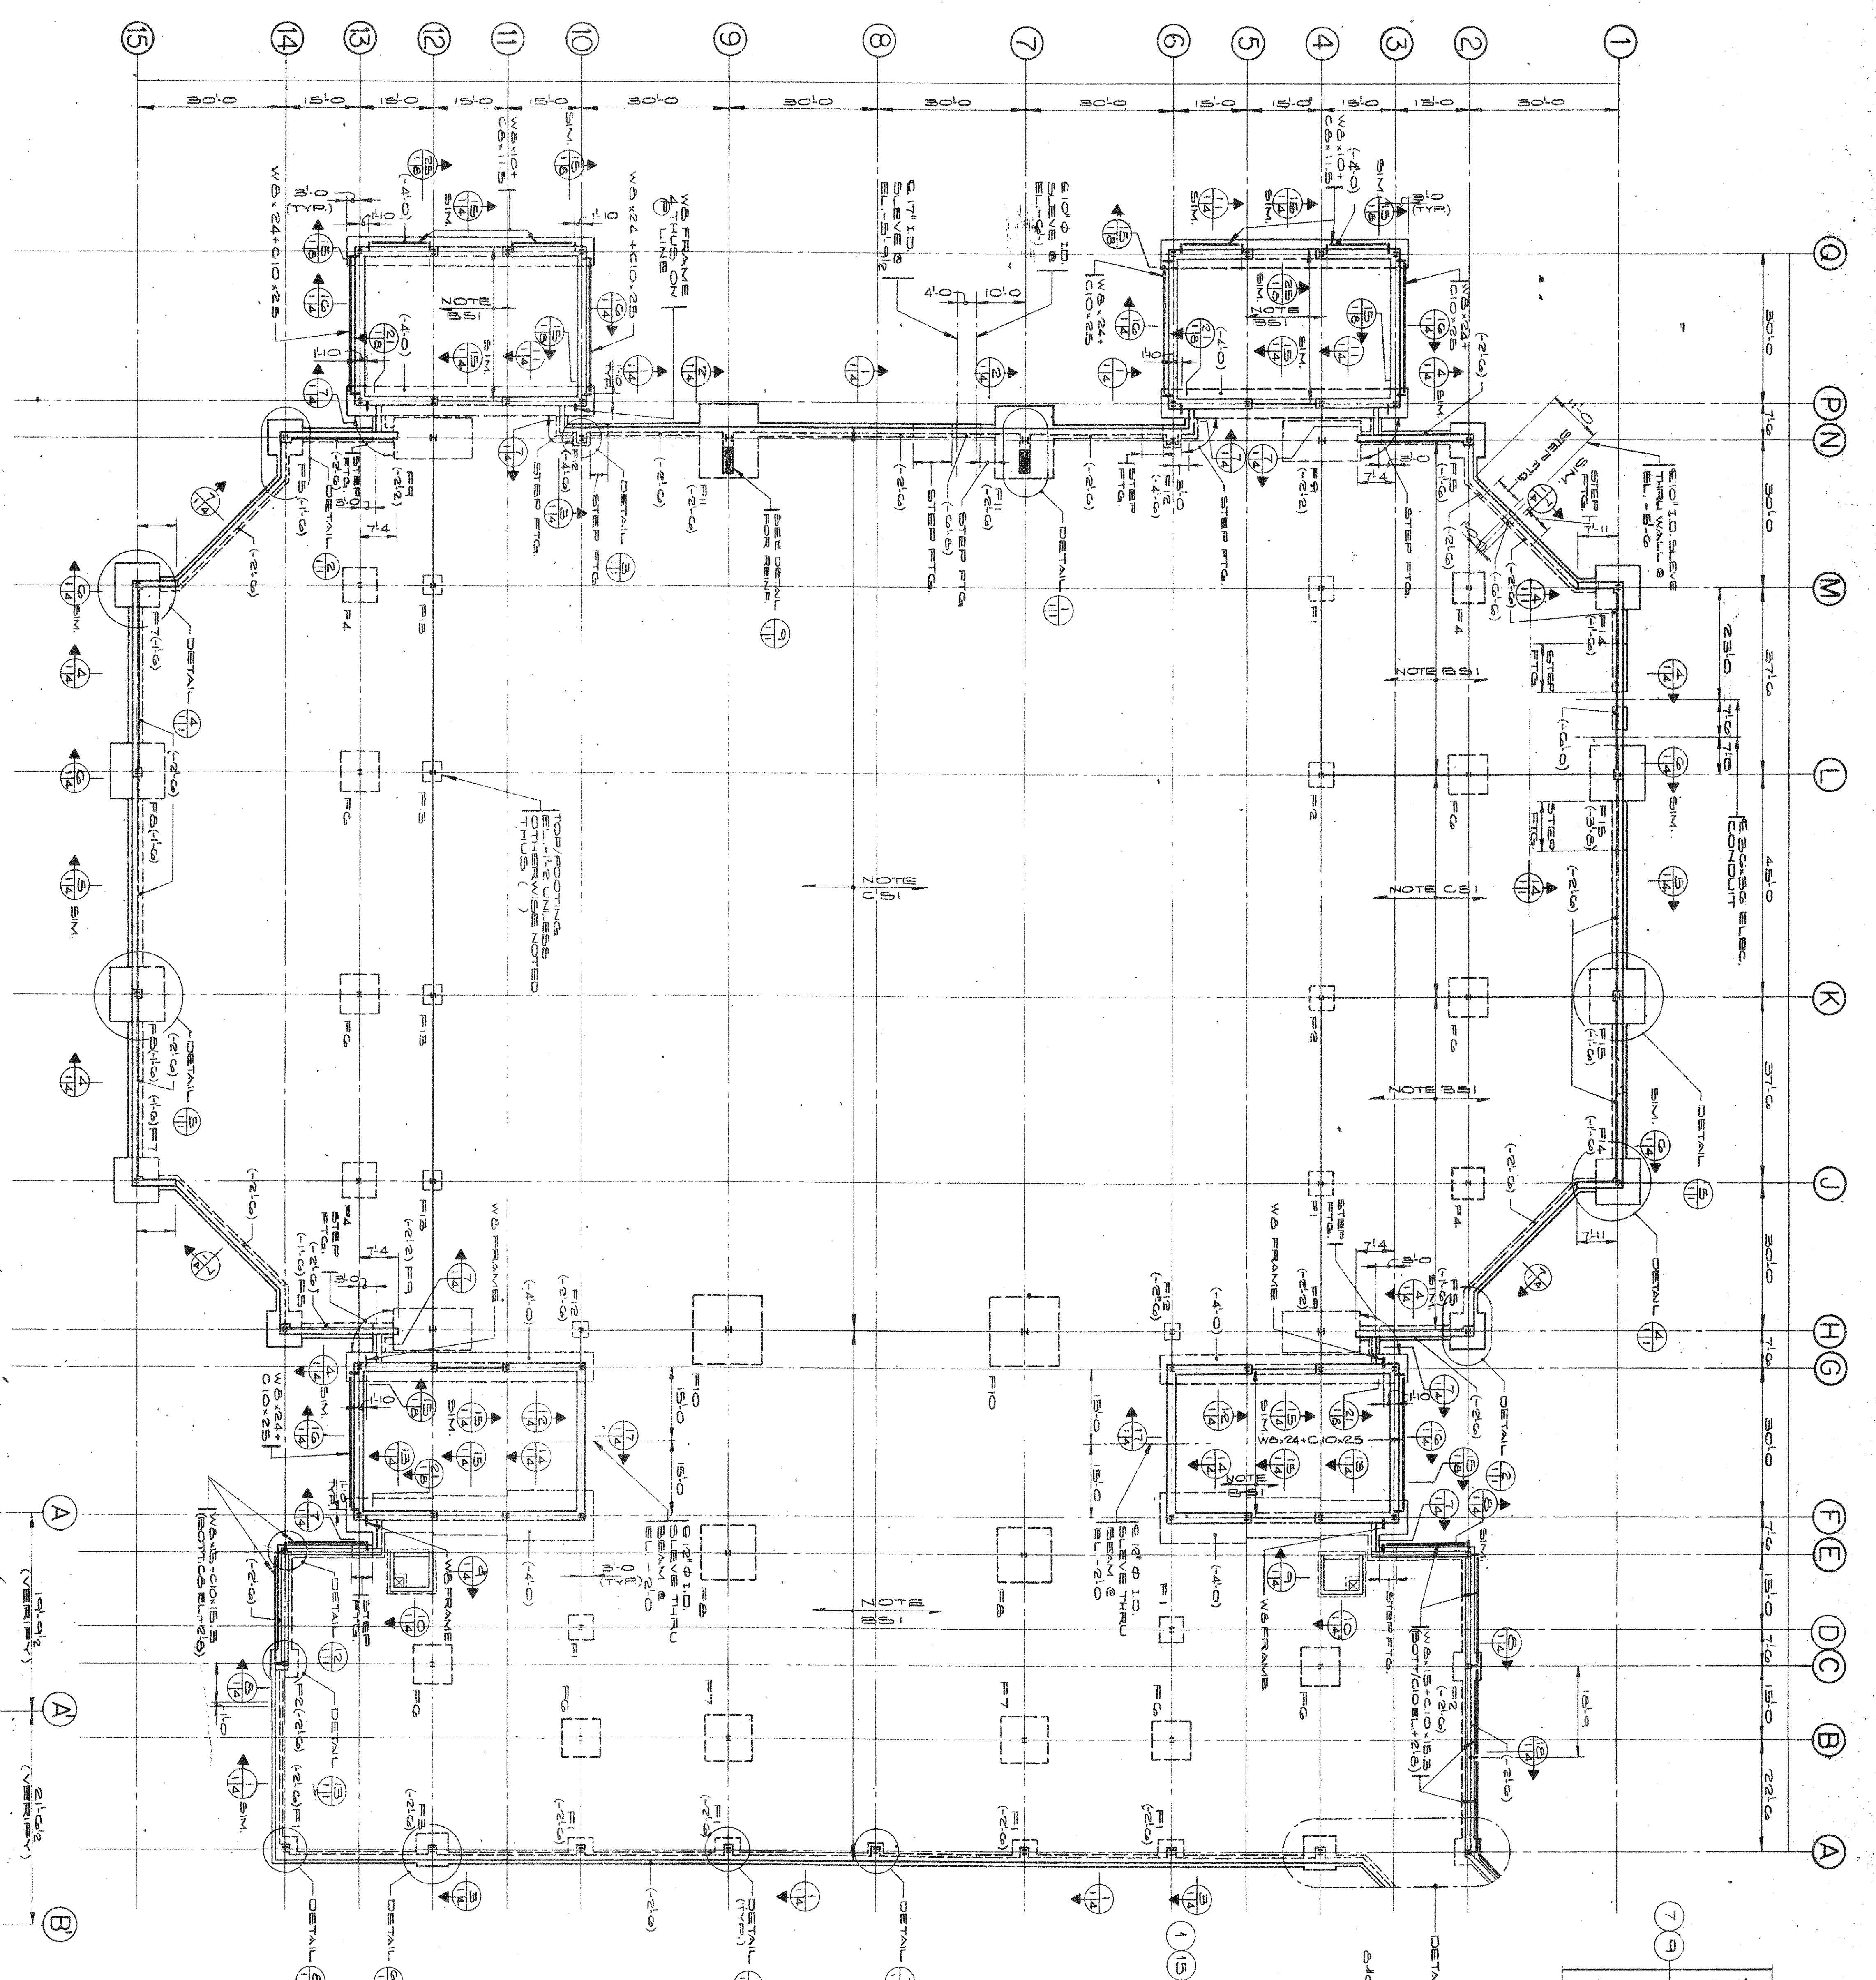

NOTES: FOR DETAILS 1 THRU 8 & 10 THRU 13
1. SEE TYPICAL FOUNDATION WALL DETAILS FOR
CORNER BARS.
2. PLASTER VERTICALS TO BE BREASTED FULL
BREASTED END.