
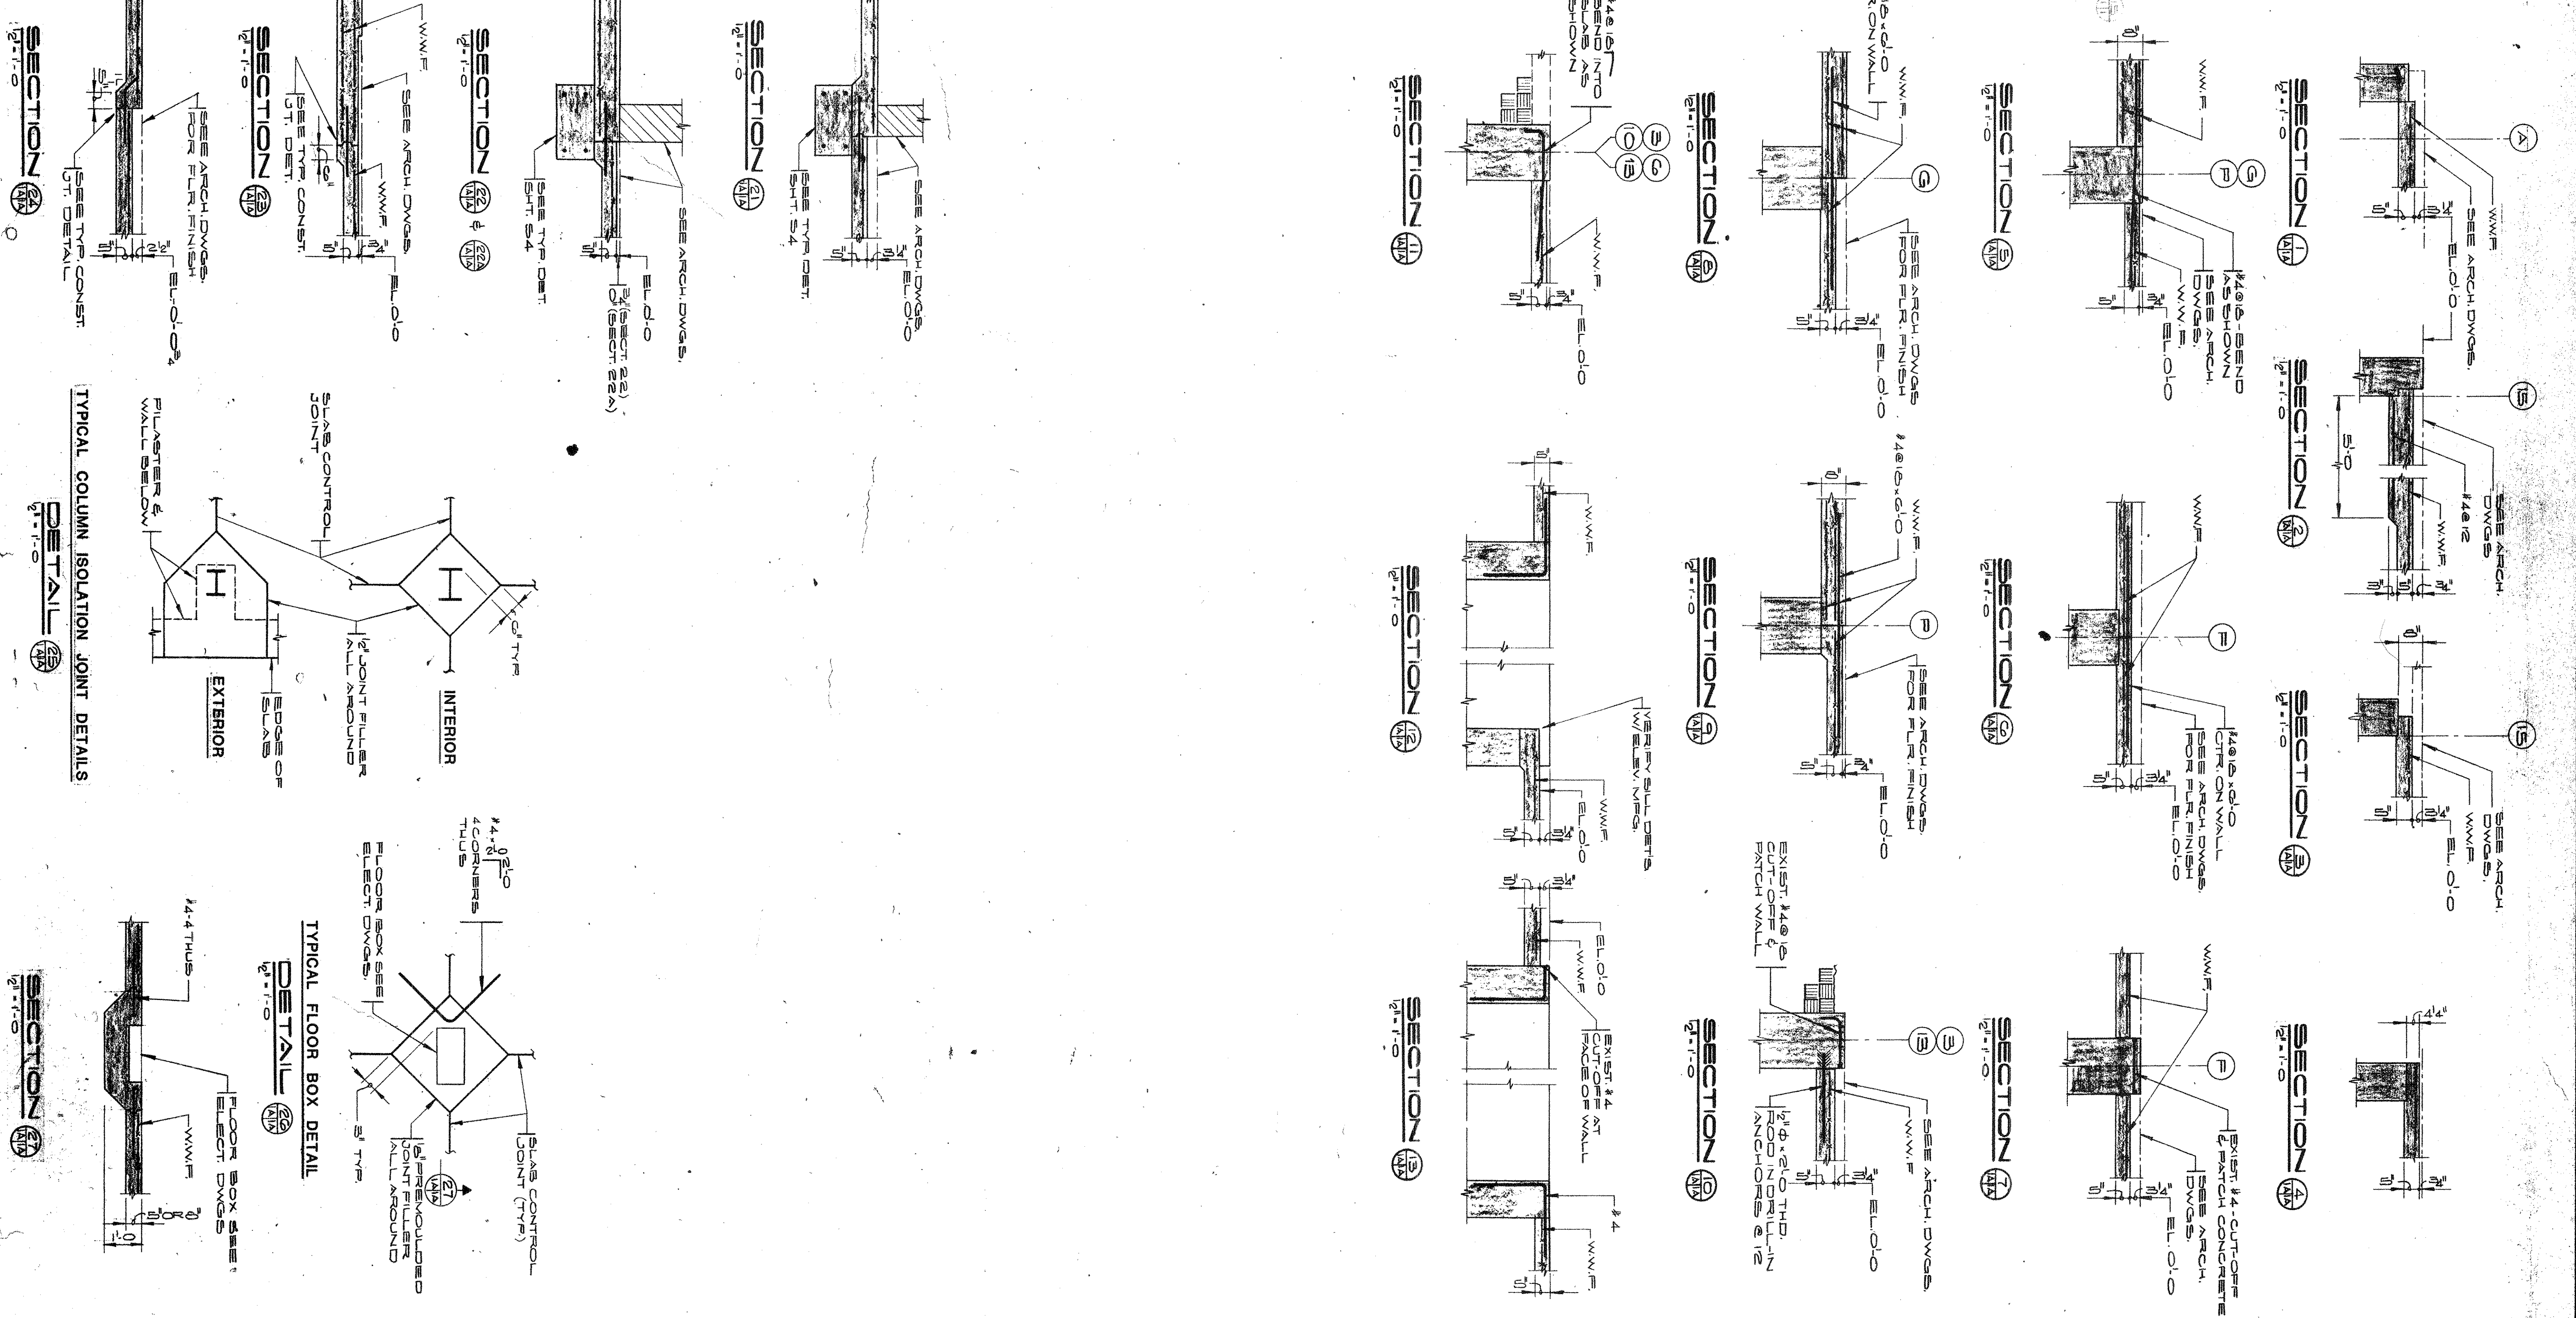


GROUND FLOOR SLAB DETAIL PLAN
SCALE 1/8" = 1'-0"

- NOTES**
- A-S1A THIS DRAWING IS TO BE USED IN CONNECTION WITH SHEET S1 AND OTHER DRAWINGS IN THIS SET.
 - B-S1A WHEN CONSTRUCTION SECTION WORK IS INDICATED, SEE DETAILS ON THIS DRAWING. SPECIFIC THICKNESS INDICATED.
 - C-S1A SEE ARCHITECTURAL DRAWINGS FOR LOCATION OF CHIMNEYS IN SLAB ELEVATION.
 - INDICATES LOCATION OF ELECTRICAL FLOOR BOX (TFP). SEE DETAIL (S1A).
 - INDICATES COLUMN ISOLATION JOINT (TFP). SEE DETAIL (S1A).
 - INDICATES TYPE OF SLAB ELEVATION.
 - INDICATES SLAB CONTROL JOINT (TFP).
 - INDICATES CHANGE IN SLAB ELEVATION (TFP).

PARTIAL FOUNDATION PLAN
SCALE 1/8" = 1'-0"

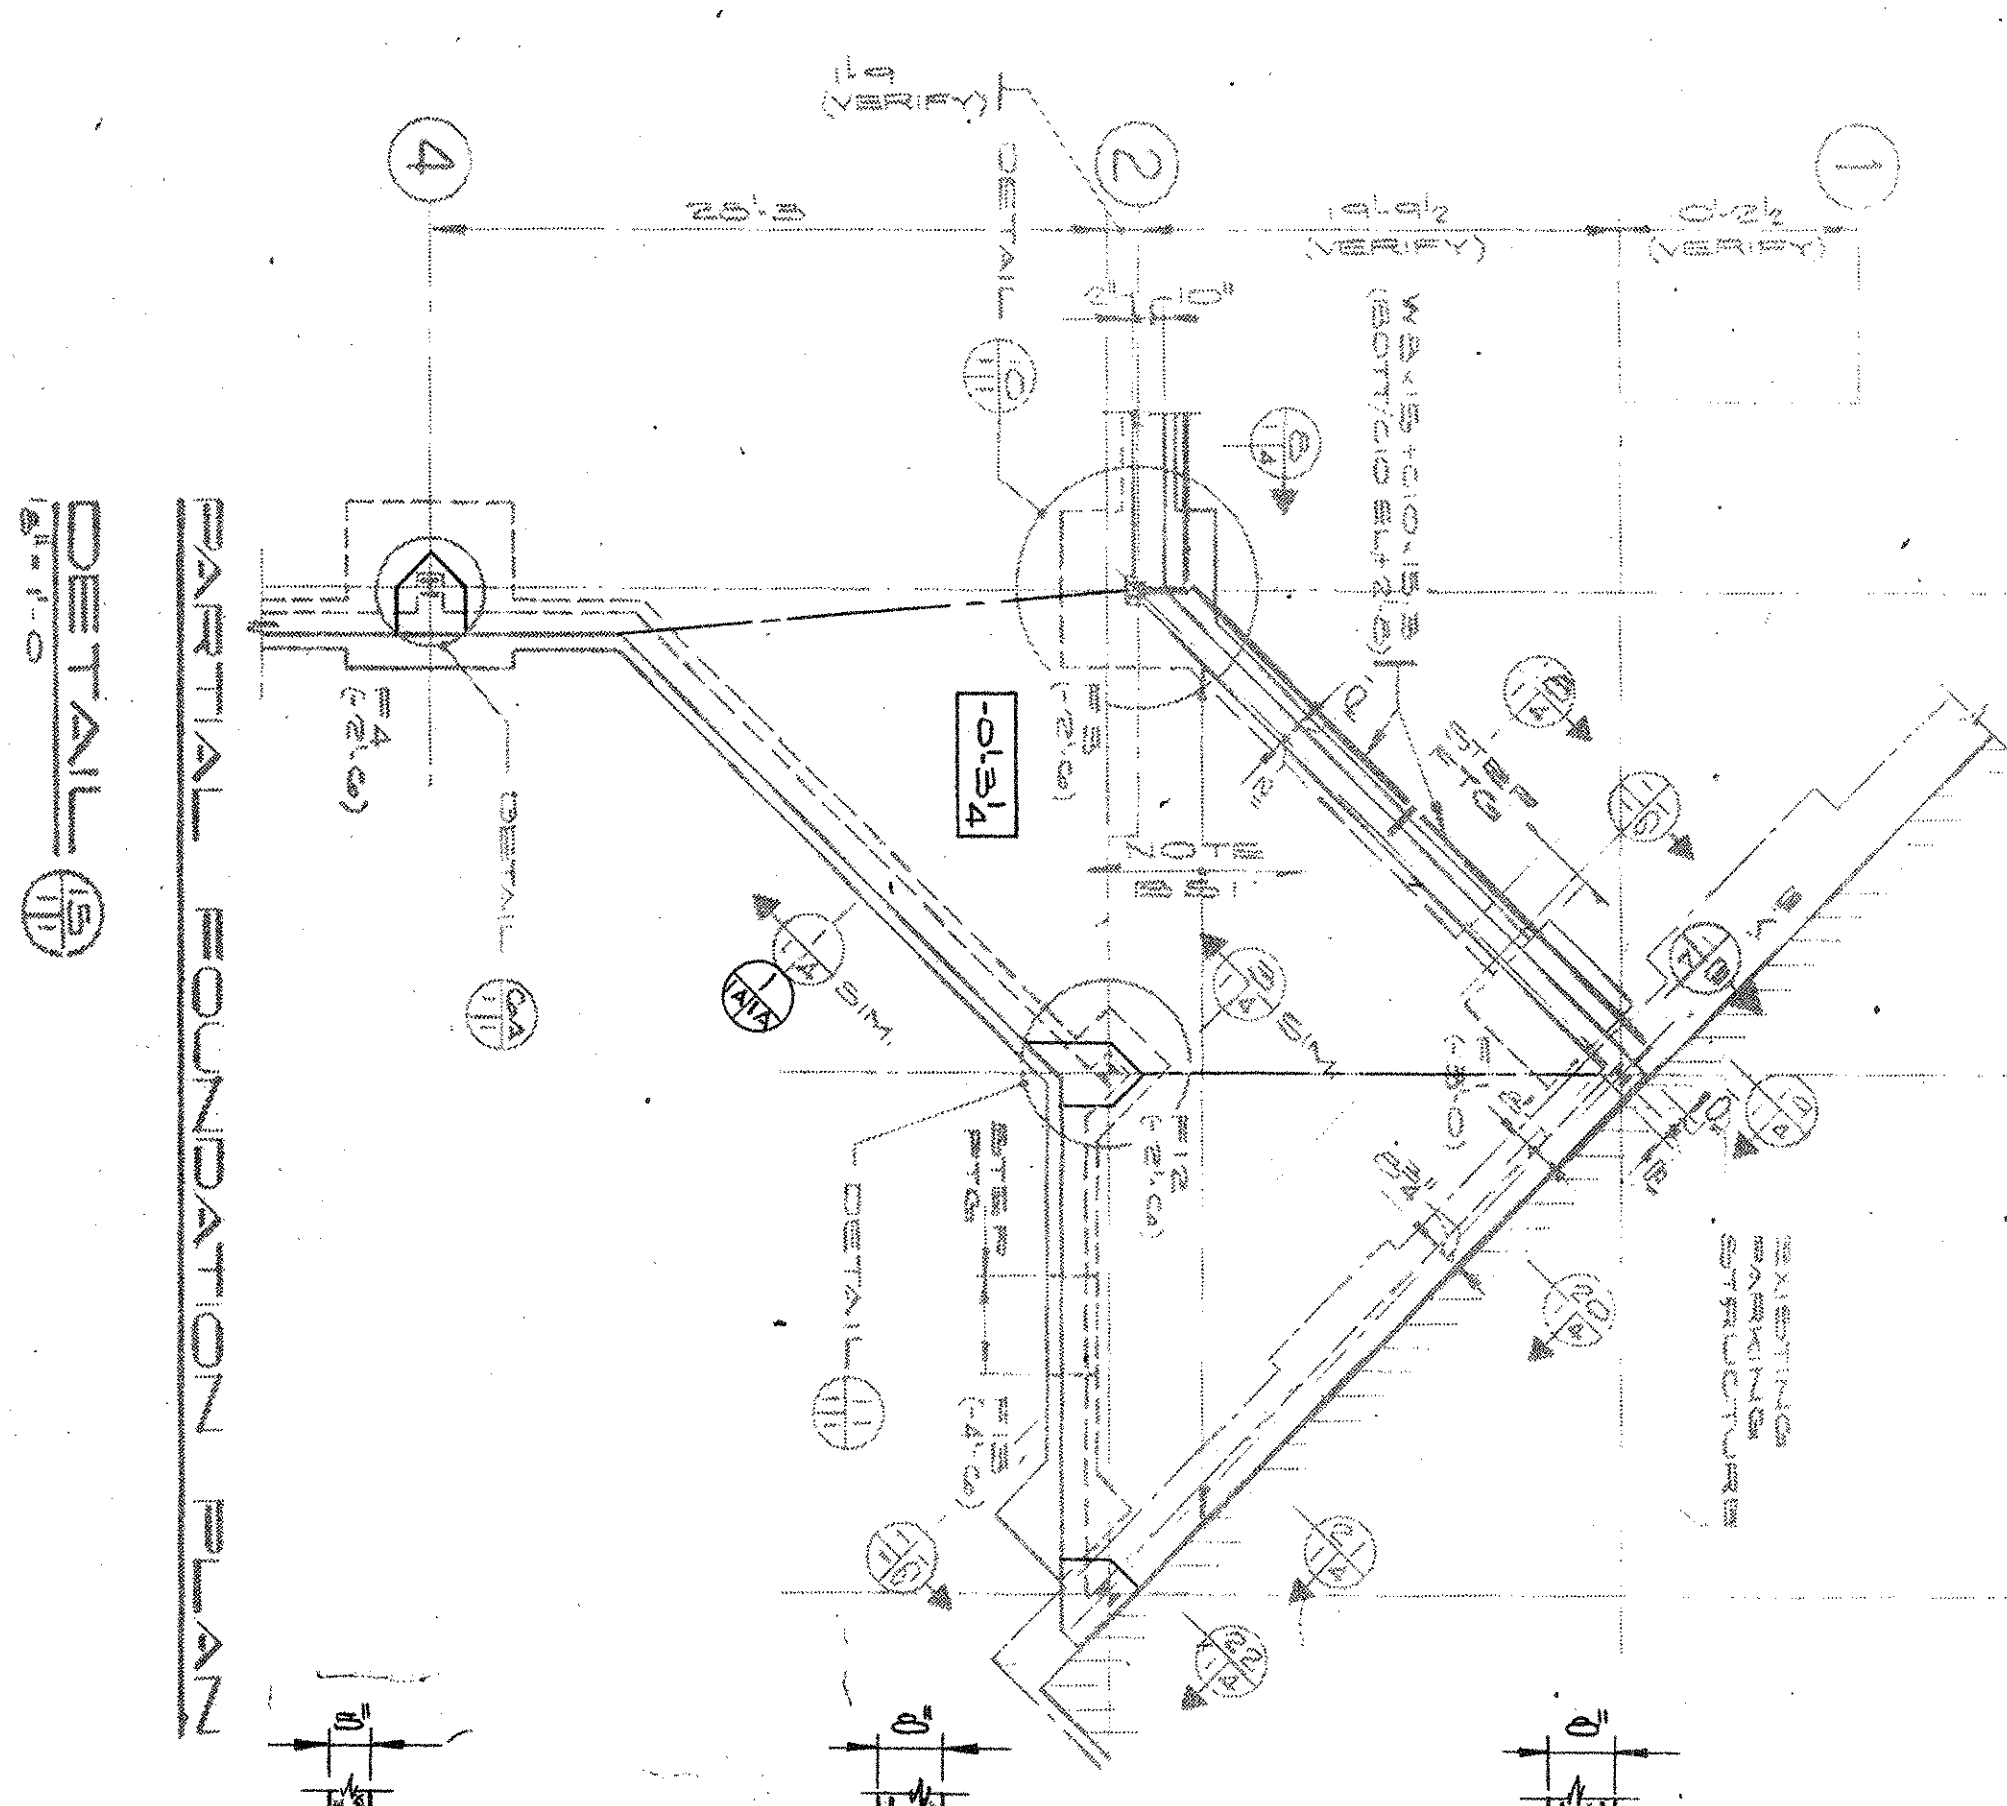

S-1A	WCA Wiesinger-Holland Ltd STRUCTURAL ENGINEERS 10 WEST WASHINGTON STREET CHICAGO, ILLINOIS 60601	GENESIS CENTER ADAMS, BROADWAY, AND FIFTH AVENUE CITY OF GARY, INDIANA RICHARD G. HATCHER. MAYOR	REMAINING WORK DATE 1/2/80		BID PACKAGE NO. 1 DATE 6/7/79		BID PACKAGE NO. 2 DATE 6/22/79		REVISIONS	
			DESCRIPTION		REVISIONS		REVISIONS		REVISIONS	
			SLABS ON GRADE		STRUCTURAL FRAME (NOT INCLUDING CONCRETE AND ELEVATED SLABS)		BUILDING FOUNDATION (NOT INCLUDING SLABS ON GRADE)			