

REVISIONS

GENESIS CENTER
ADAMS, BROADWAY, AND FIFTH AVENUE
CITY OF GARY,
RICHARD G. HATCHER,
MAYOR


Wendell Campbell Associates, Inc.
ARCHITECTS
504 BROADWAY
GARY, INDIANA 46502
WALLACE, MIGOAL & DRUCKER
CONSULTING
MECHANICAL
ELECTRICAL
ENGINEERS
444 N. OHIO ST. CHICAGO, ILL. 60610
444 N. OHIO ST. CHICAGO, ILL. 60610

WCA


DATE: 01.28.82
APPROVED: [Signature]
CHECKED: [Signature]
DRAWN: [Signature]

CONTENTS
MECHANICAL &
ELECTRICAL
ROOMS -
GROUND FLOOR

E-8

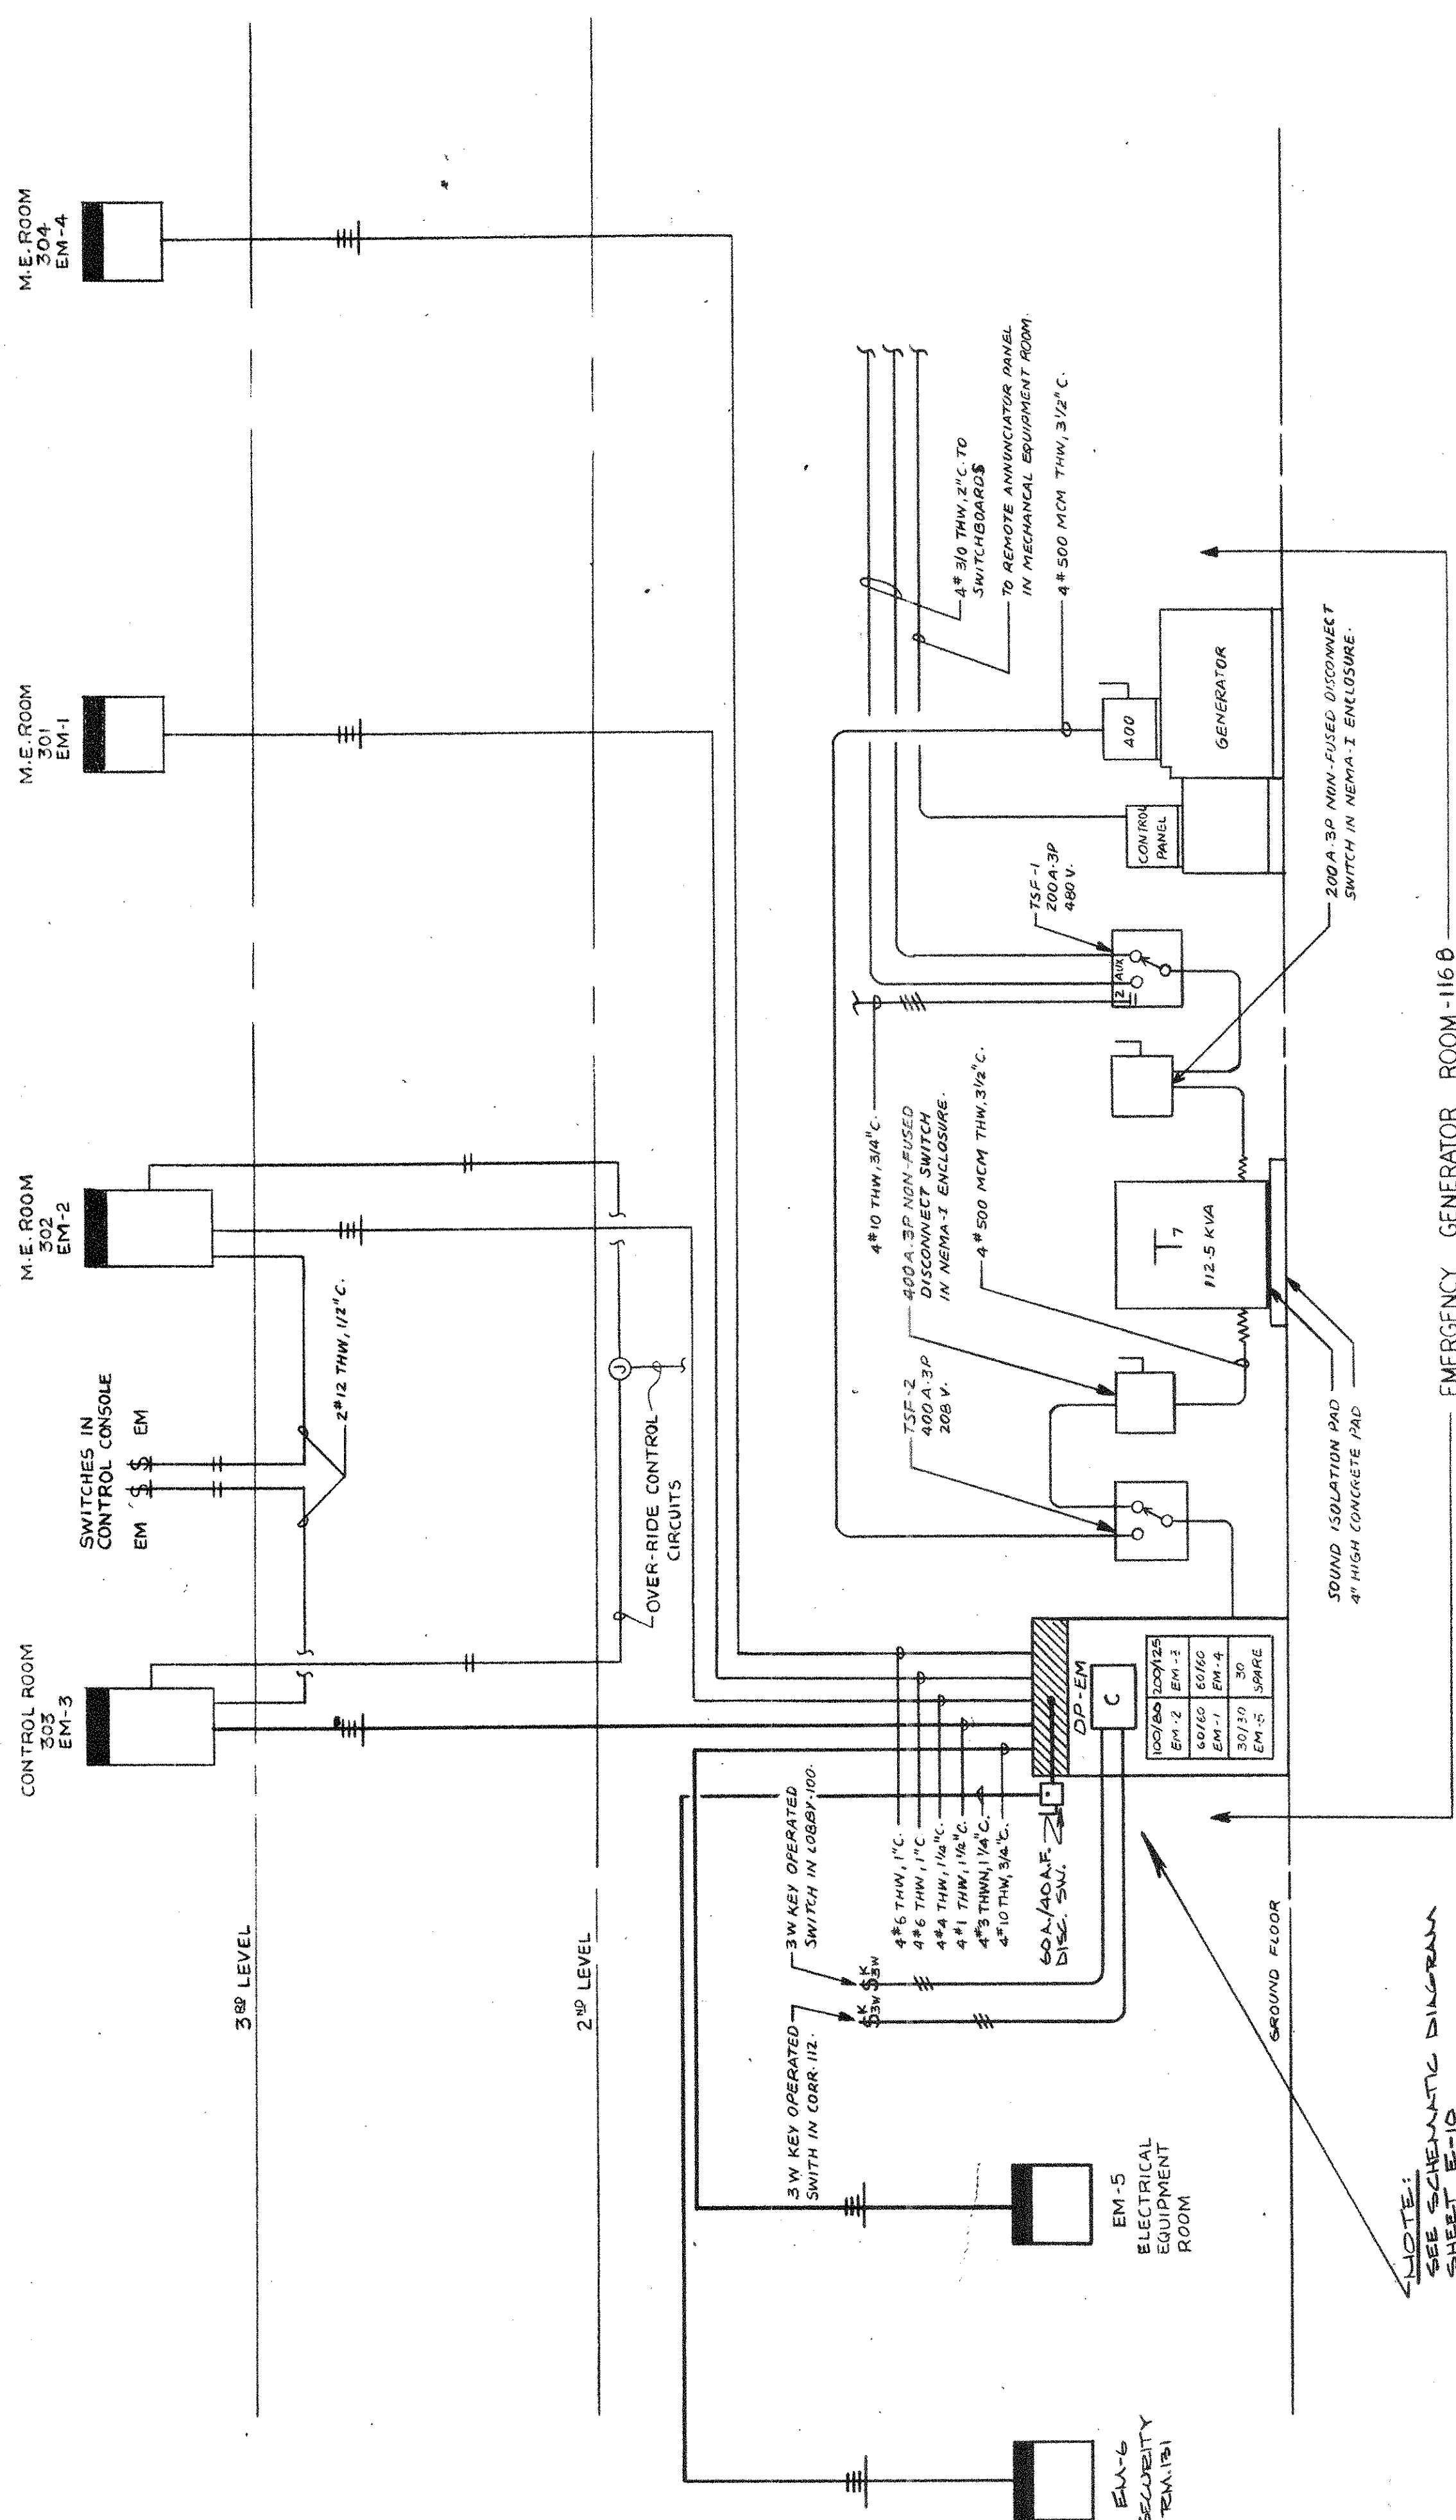

EXIT & EMERGENCY RISER DIAGRAM 120/208 V. 3 Ø 4W
NO SCALE

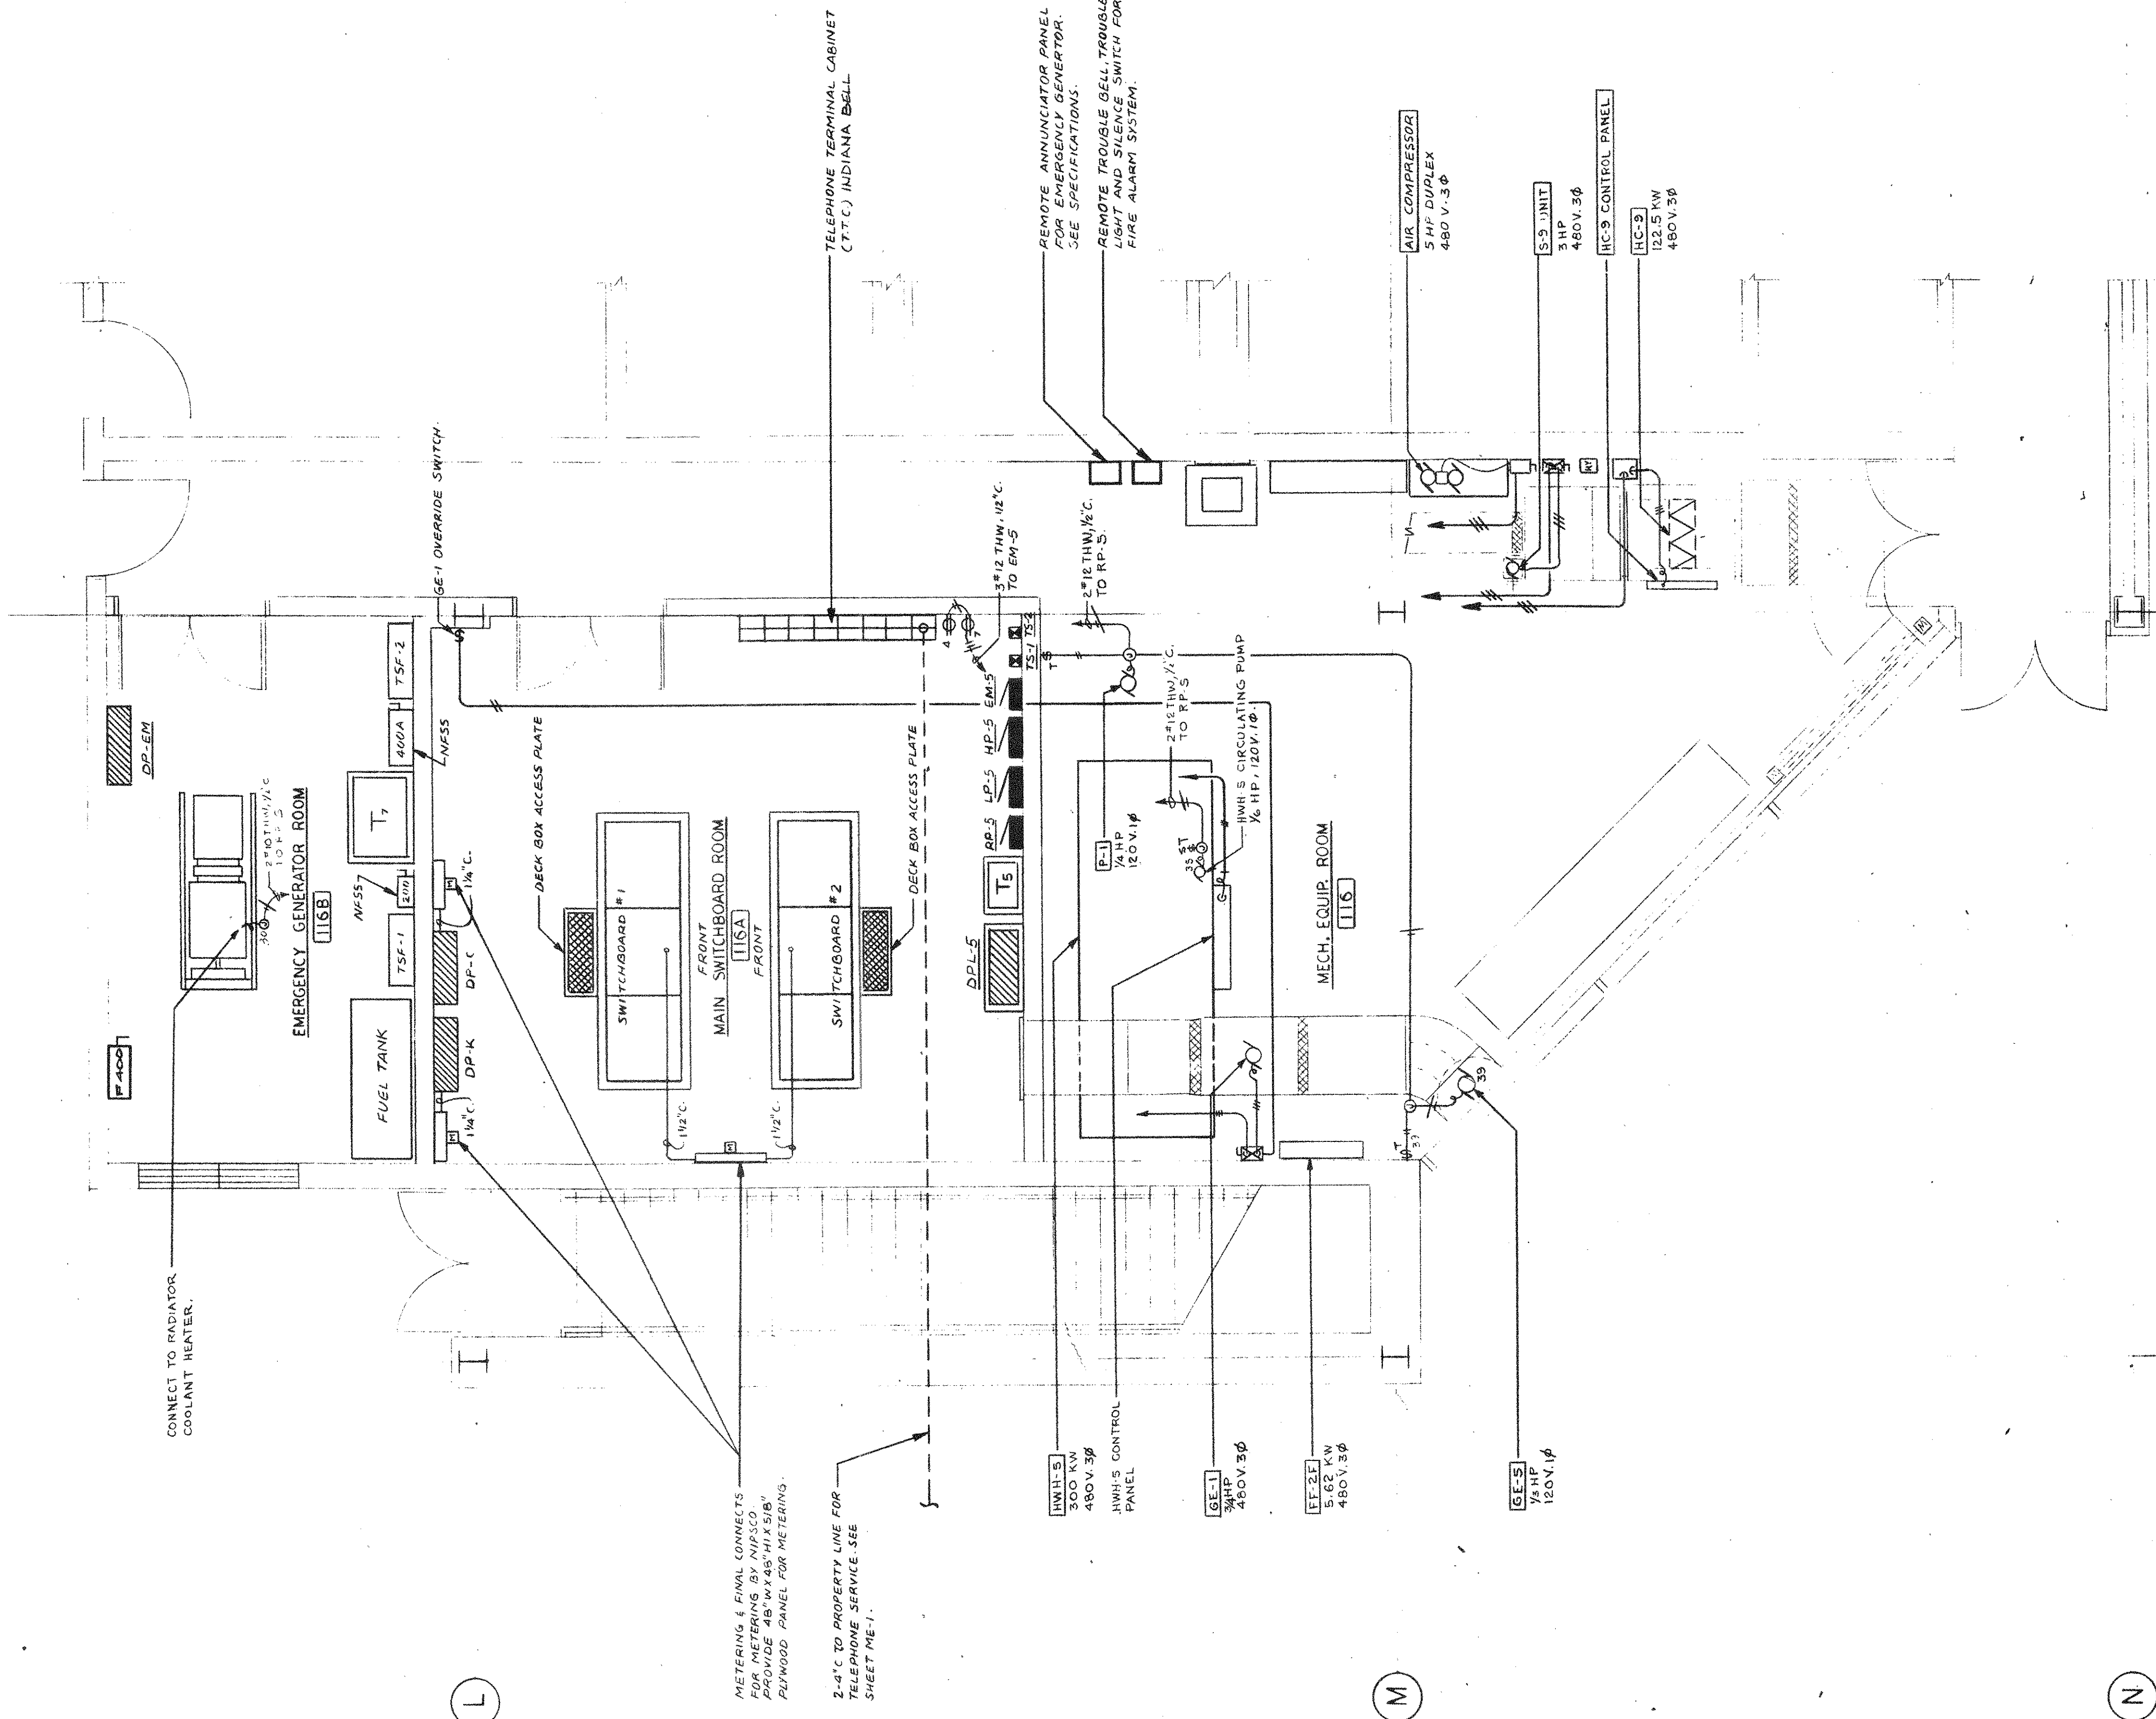

GROUND FLOOR MECHANICAL ROOM PLAN
SCALE: 1/4"=1'-0"

CONTROL ROOM PLAN
SCALE: 1/4"=1'-0"