


504 BROADWAY
2006 E. 140TH STREET EAST CHICAGO, INDIANA
180 N. MICHIGAN AVENUE CHICAGO, ILLINOIS

WALLACE, MIDGAL & DRUCKER
CONSULTING
ENGINEERS
MECHANICAL
ELECTRICAL
444 N. Orleans 822-9780 Chicago, ILL. 60610



ME-1

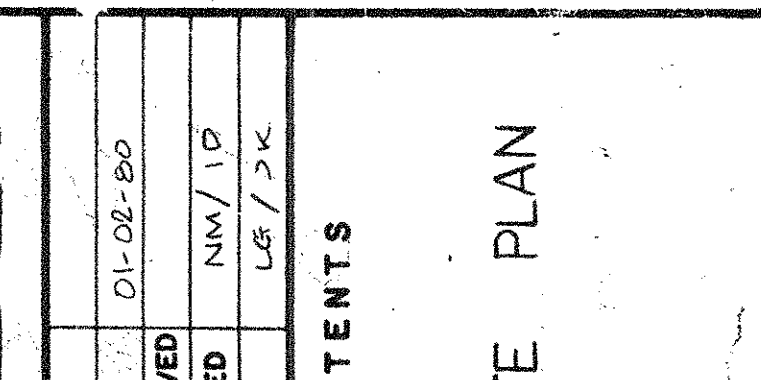