



**MAIN ROOF FRAMING PLAN**  
SCALE 1/4" = 1'-0"

NOTES:  
1. 14" x 22" WIDE RIB METAL ROOF DECK INSTALLED 3 SPAN/SPAN CONTINUOUS OVER SUPPORTS.  
2. BEAM COLUMN JOINTS ARE NON-SELF-SUPPORTING AS DEFINED BY AISC CODE OF STANDARD PRACTICE.  
3. INDICATES ROOF TOP MECHANICAL EQUIPMENT UNIT - SEE ARCHITECTURAL AND MECHANICAL DRAWINGS FOR EXACT SIZE AND LOCATION.

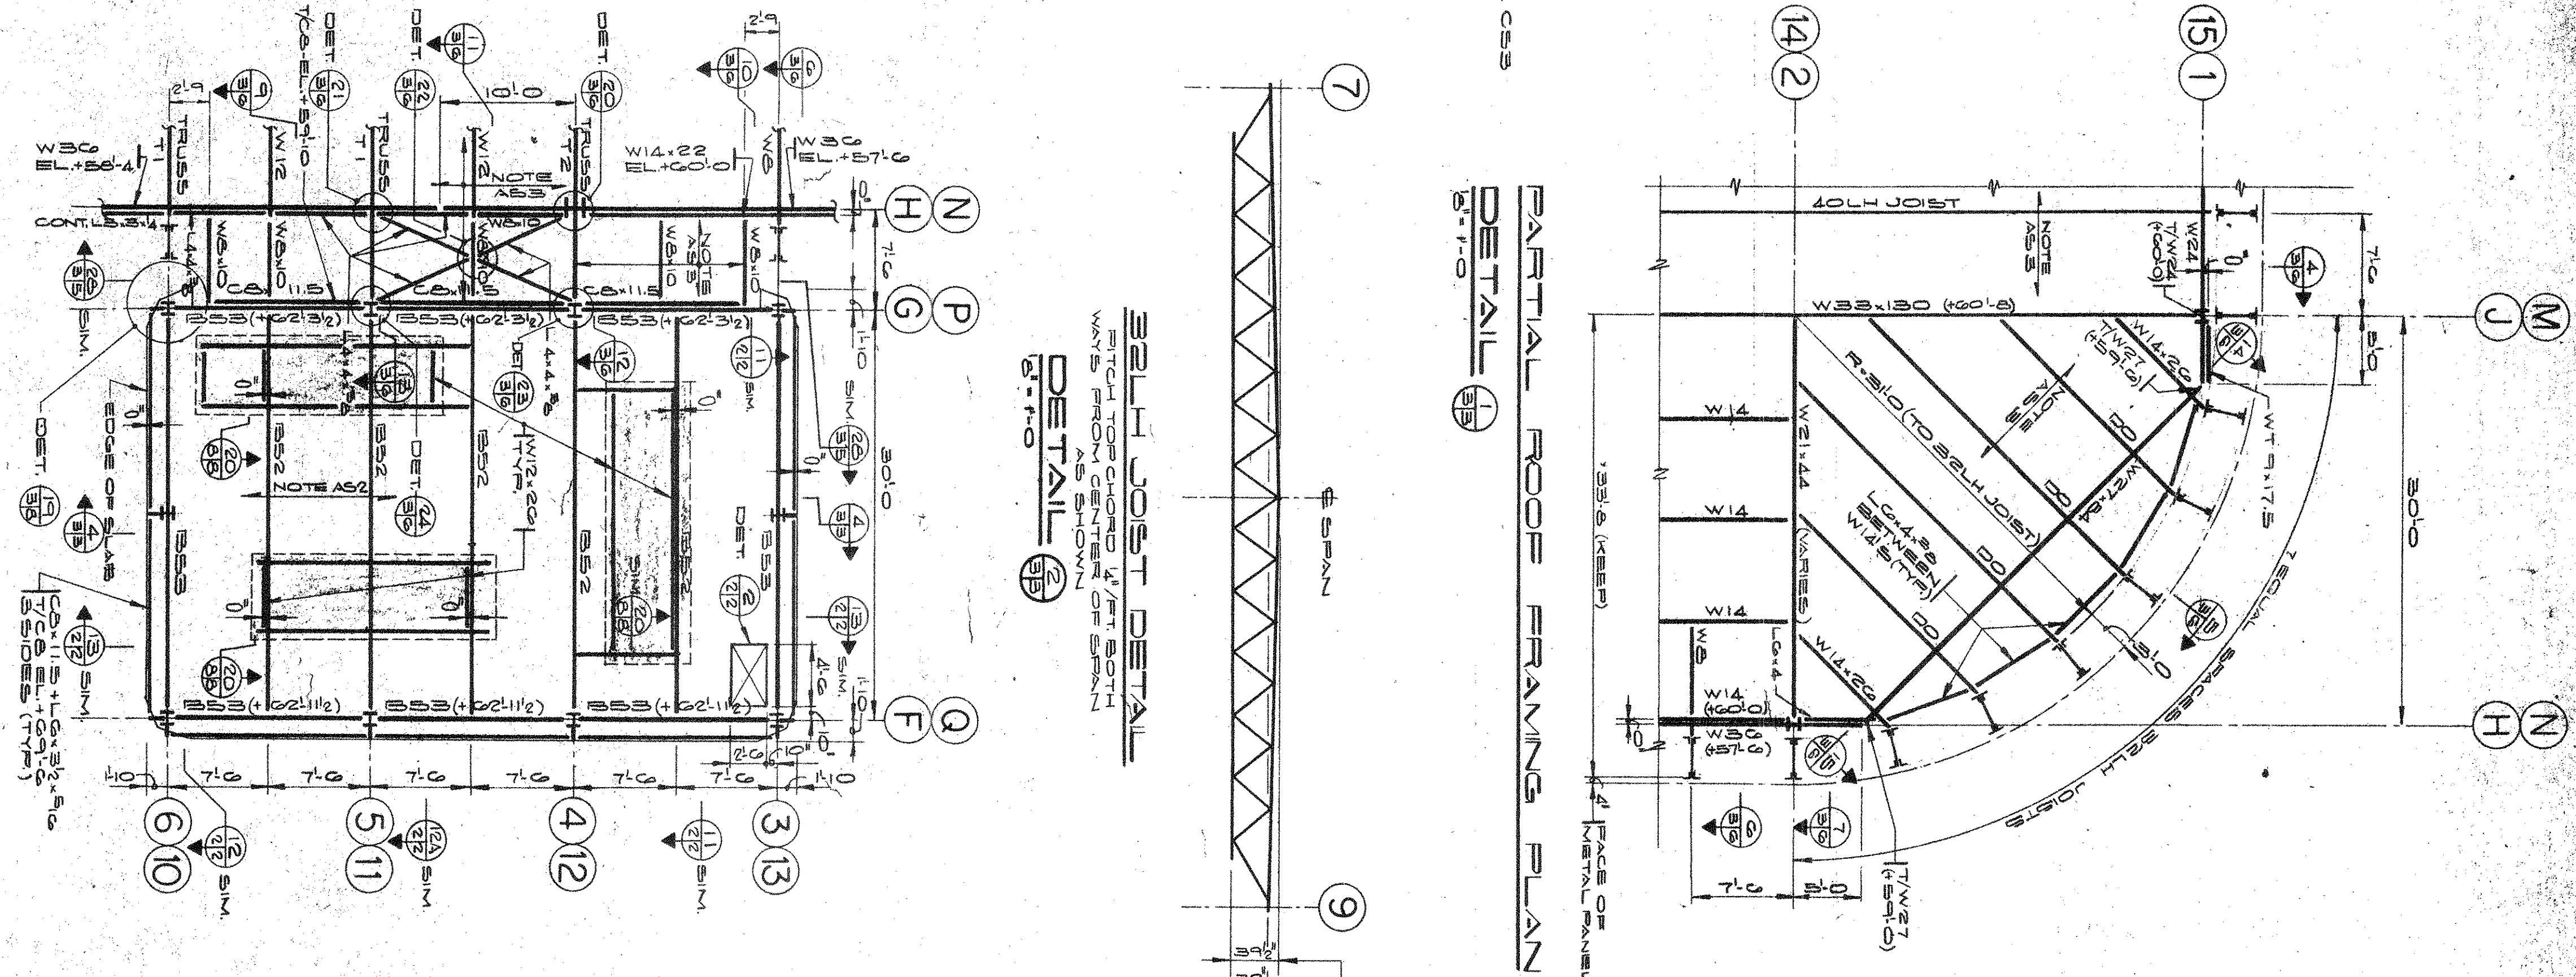


**PARTIAL ROOF FRAMING PLAN**  
SCALE 1/4" = 1'-0"

**SEAL JOIST DETAIL**  
SCALE 1/4" = 1'-0"

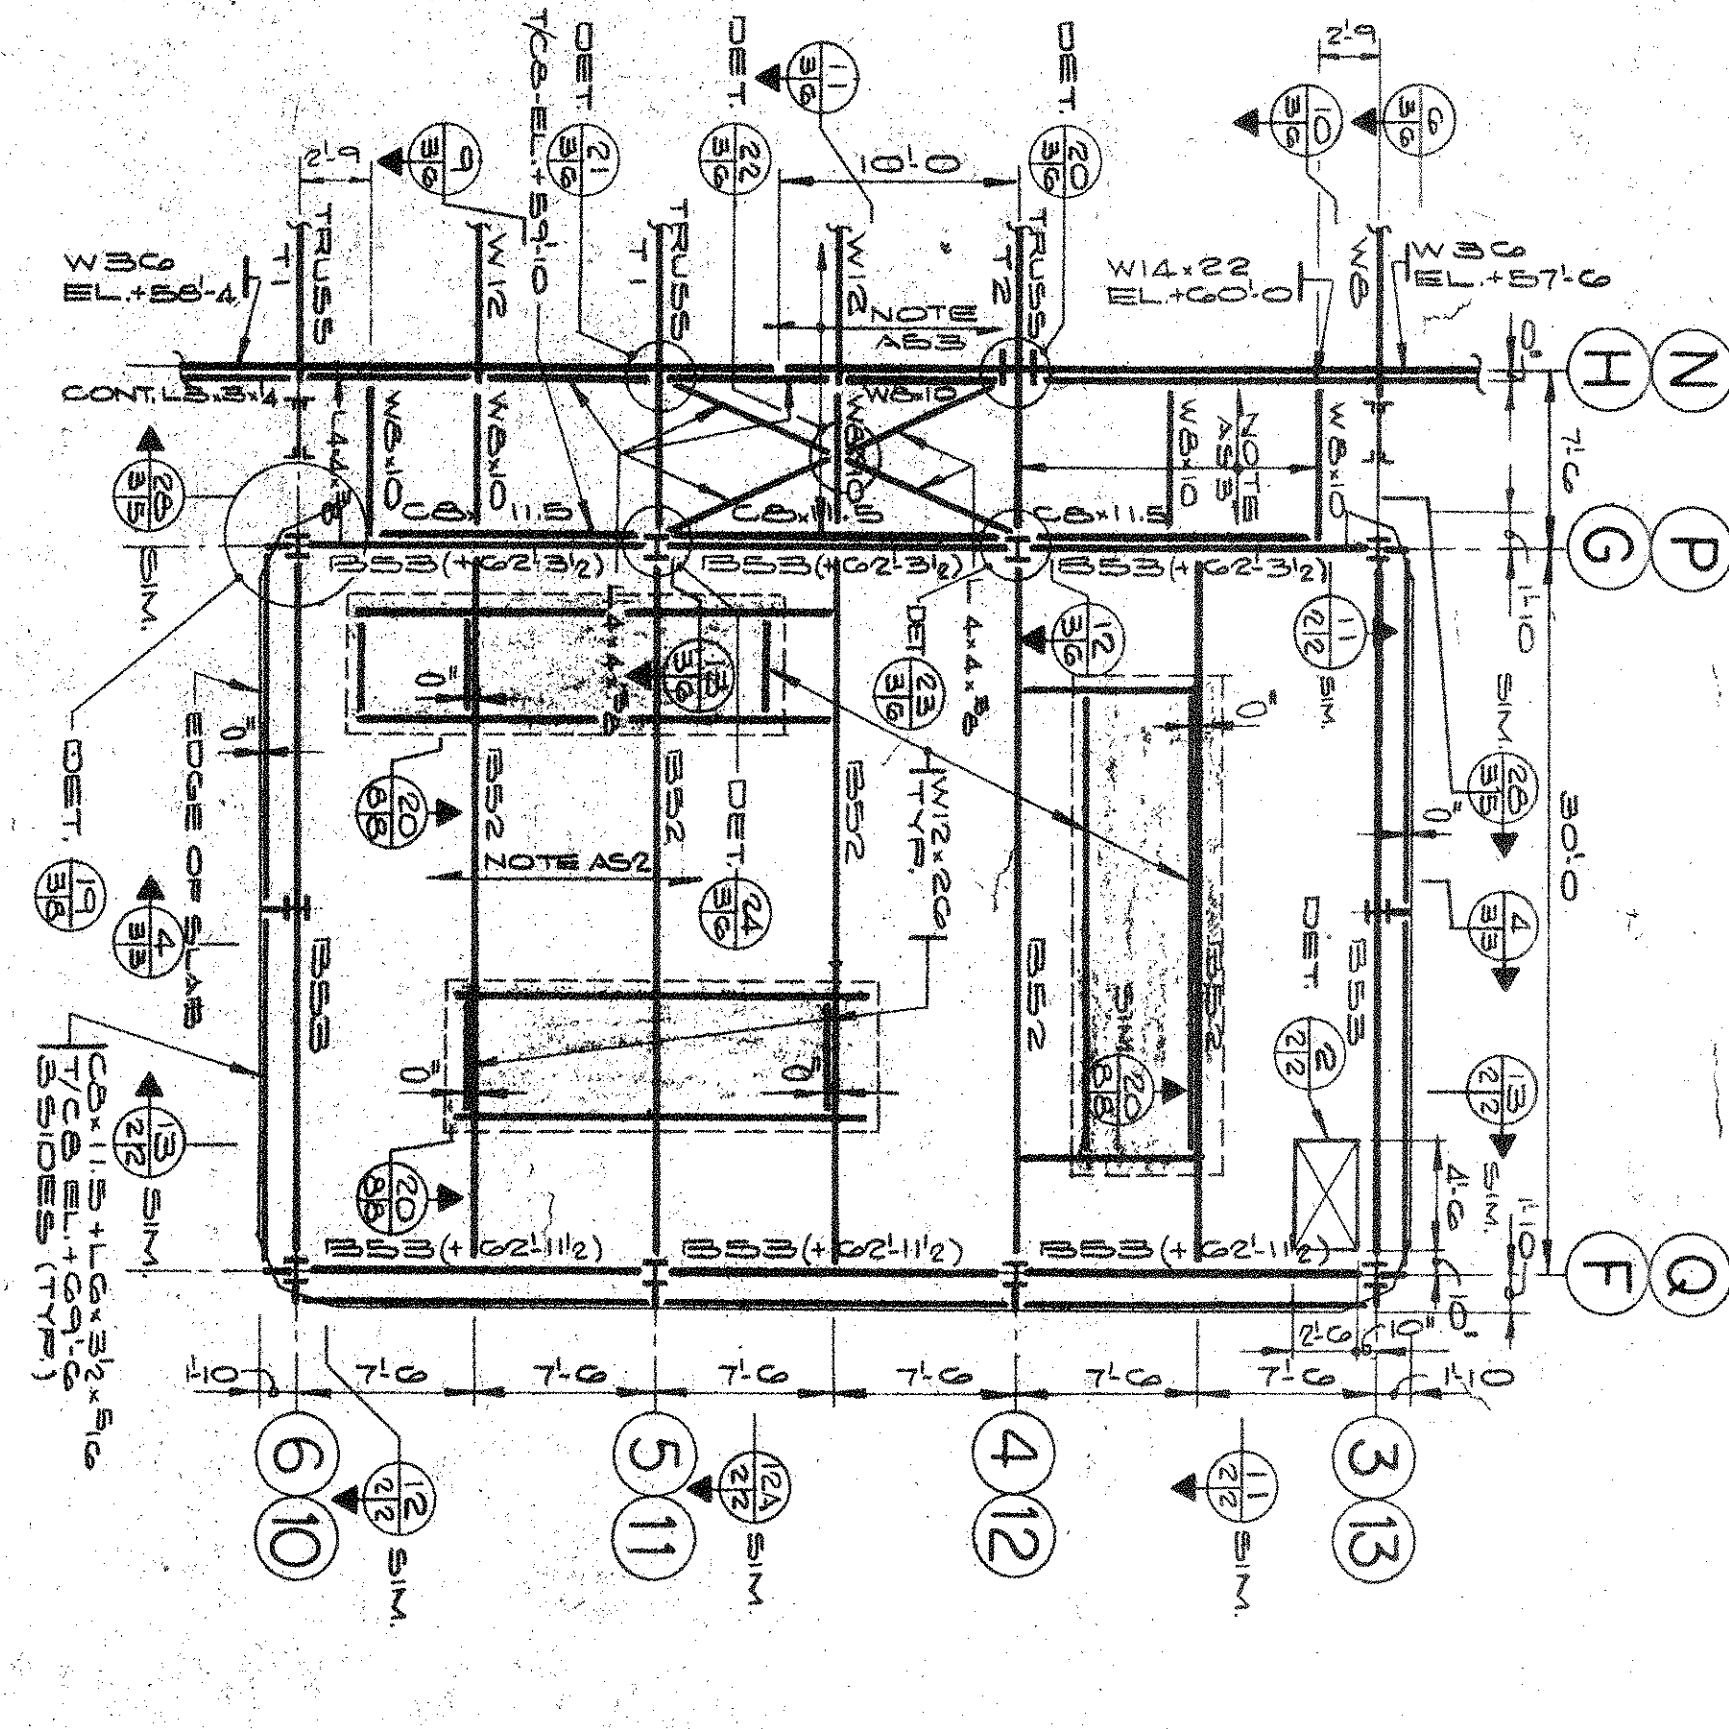


**PARTIAL ROOF FRAMING PLAN**  
SCALE 1/4" = 1'-0"

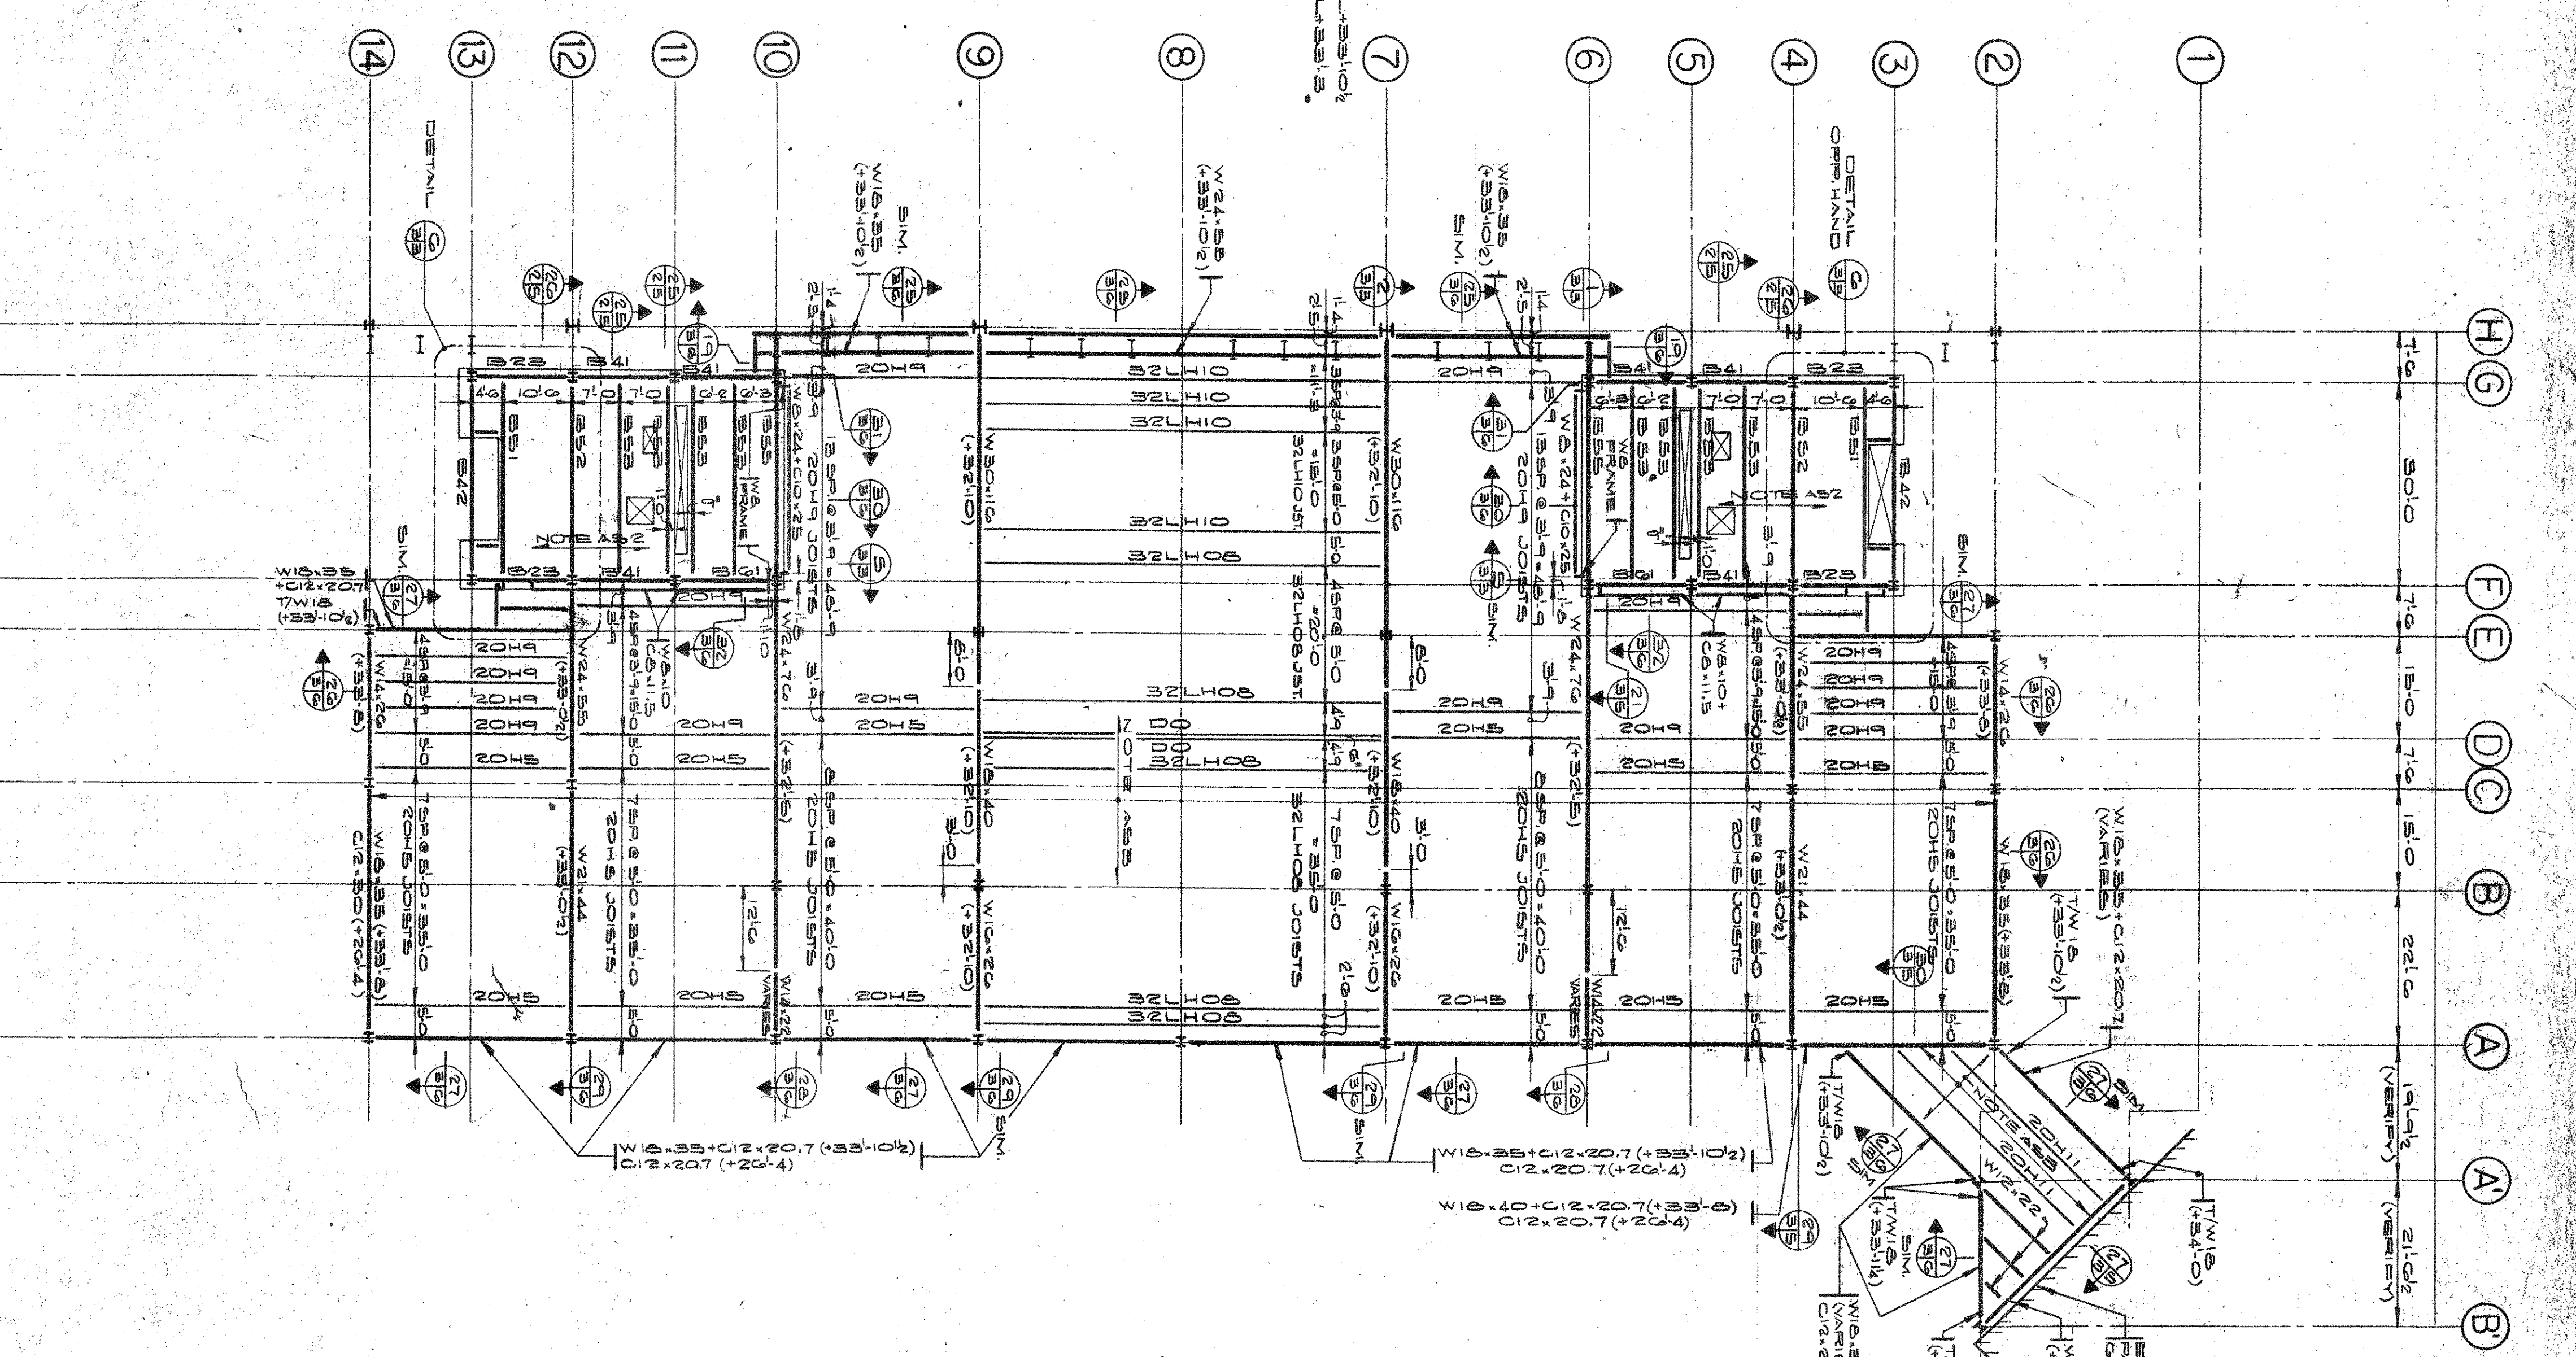


**LOW ROOF FRAMING PLAN**  
SCALE 1/4" = 1'-0"


NOTES:  
1. TOP OF STEEL BEAM IS 43 1/2" UNLESS OTHERWISE NOTED THIS ( )  
2. BEAM COLUMN JOINTS ARE NON-SELF-SUPPORTING AS DEFINED BY AISC CODE OF STANDARD PRACTICE.  
3. PROVIDE 3" STEEL BEARING STAYS IN COLUMN CENTER LINES ( ) & ( )  
4. PROVIDE BRACING & ACCESSORIES FOR JOISTS AS PER AISI SPECIFICATIONS.

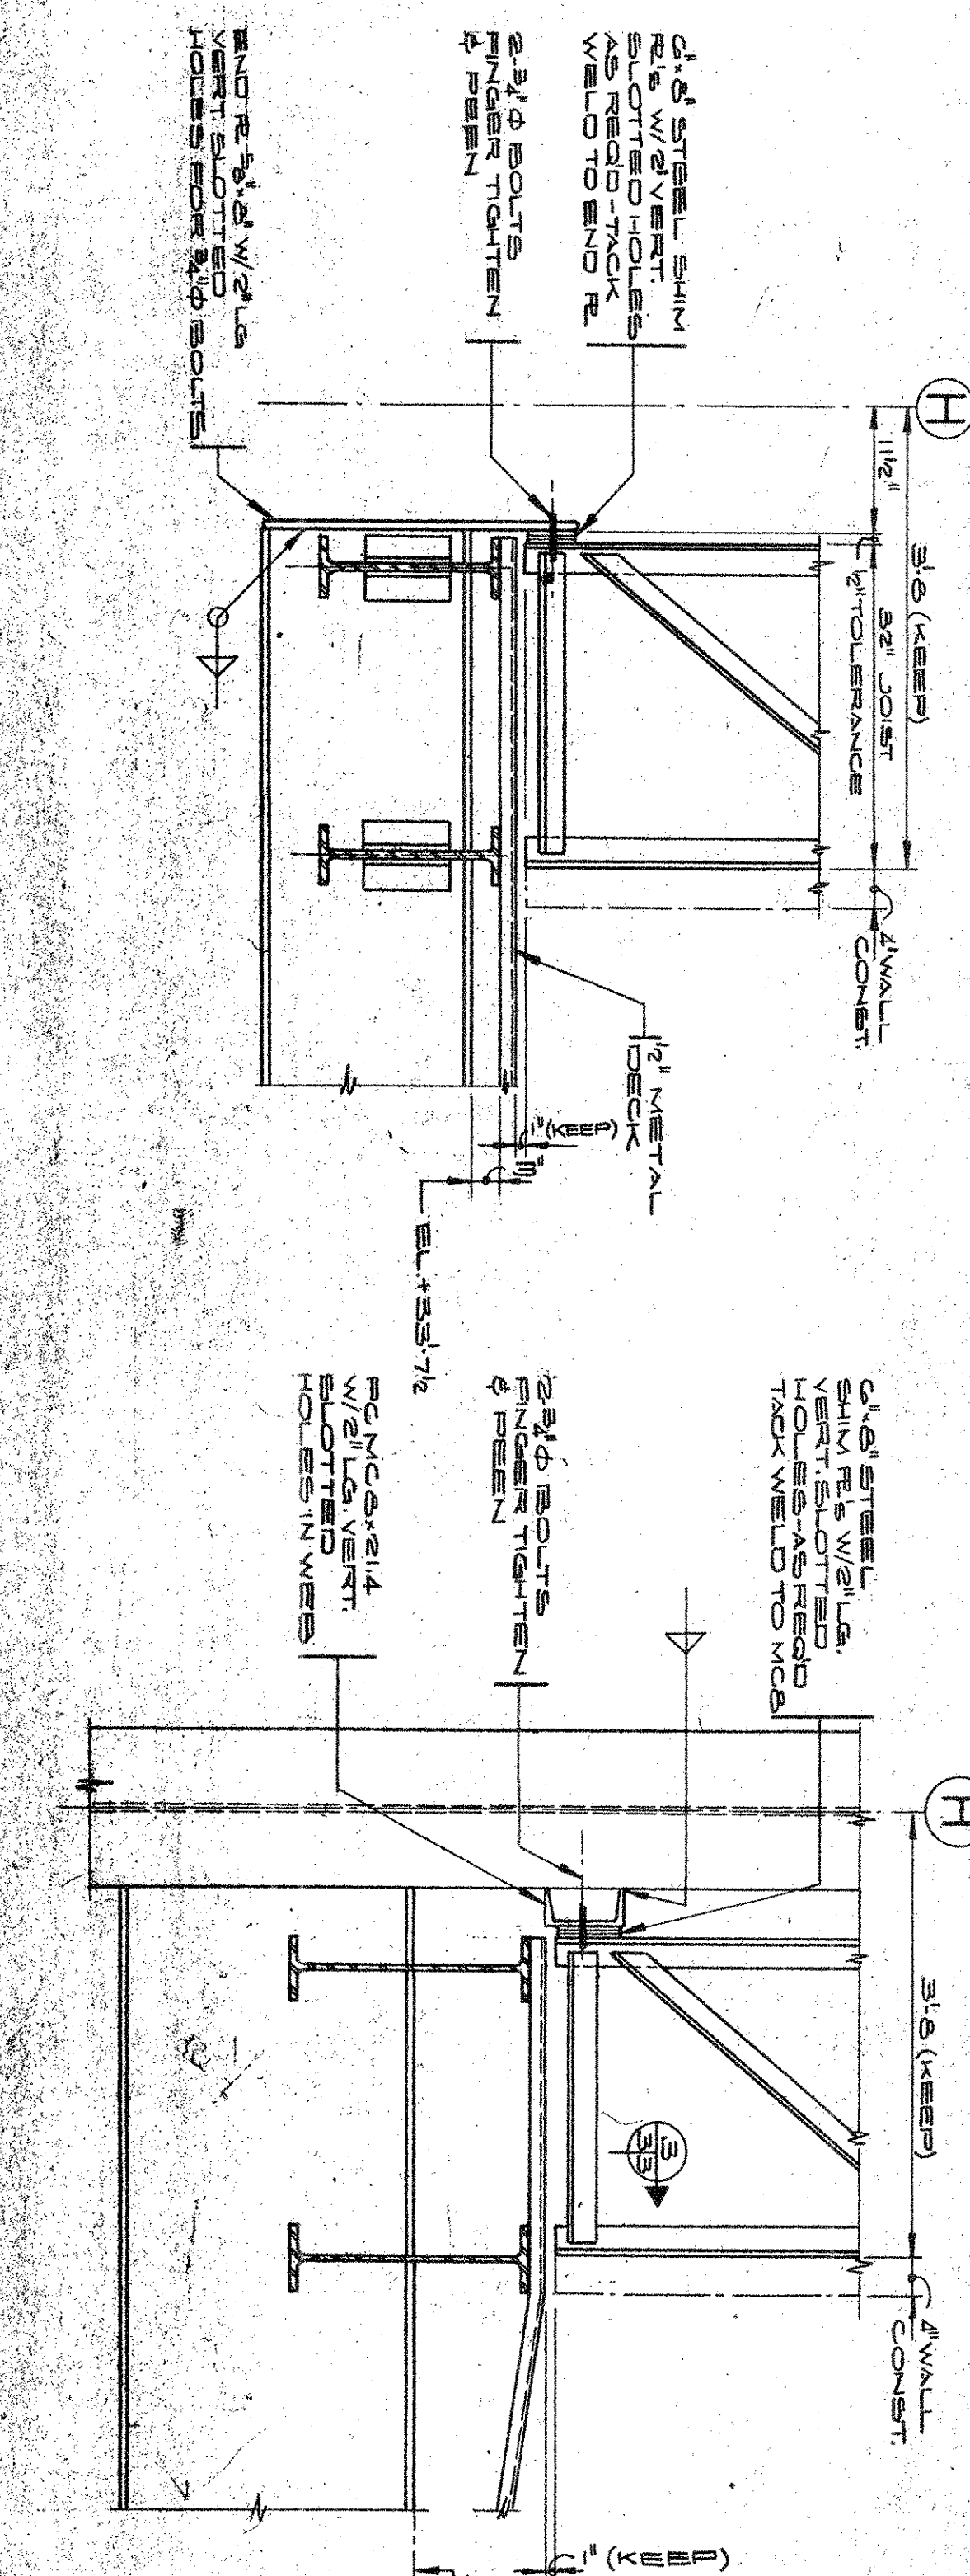


**SECTION H**

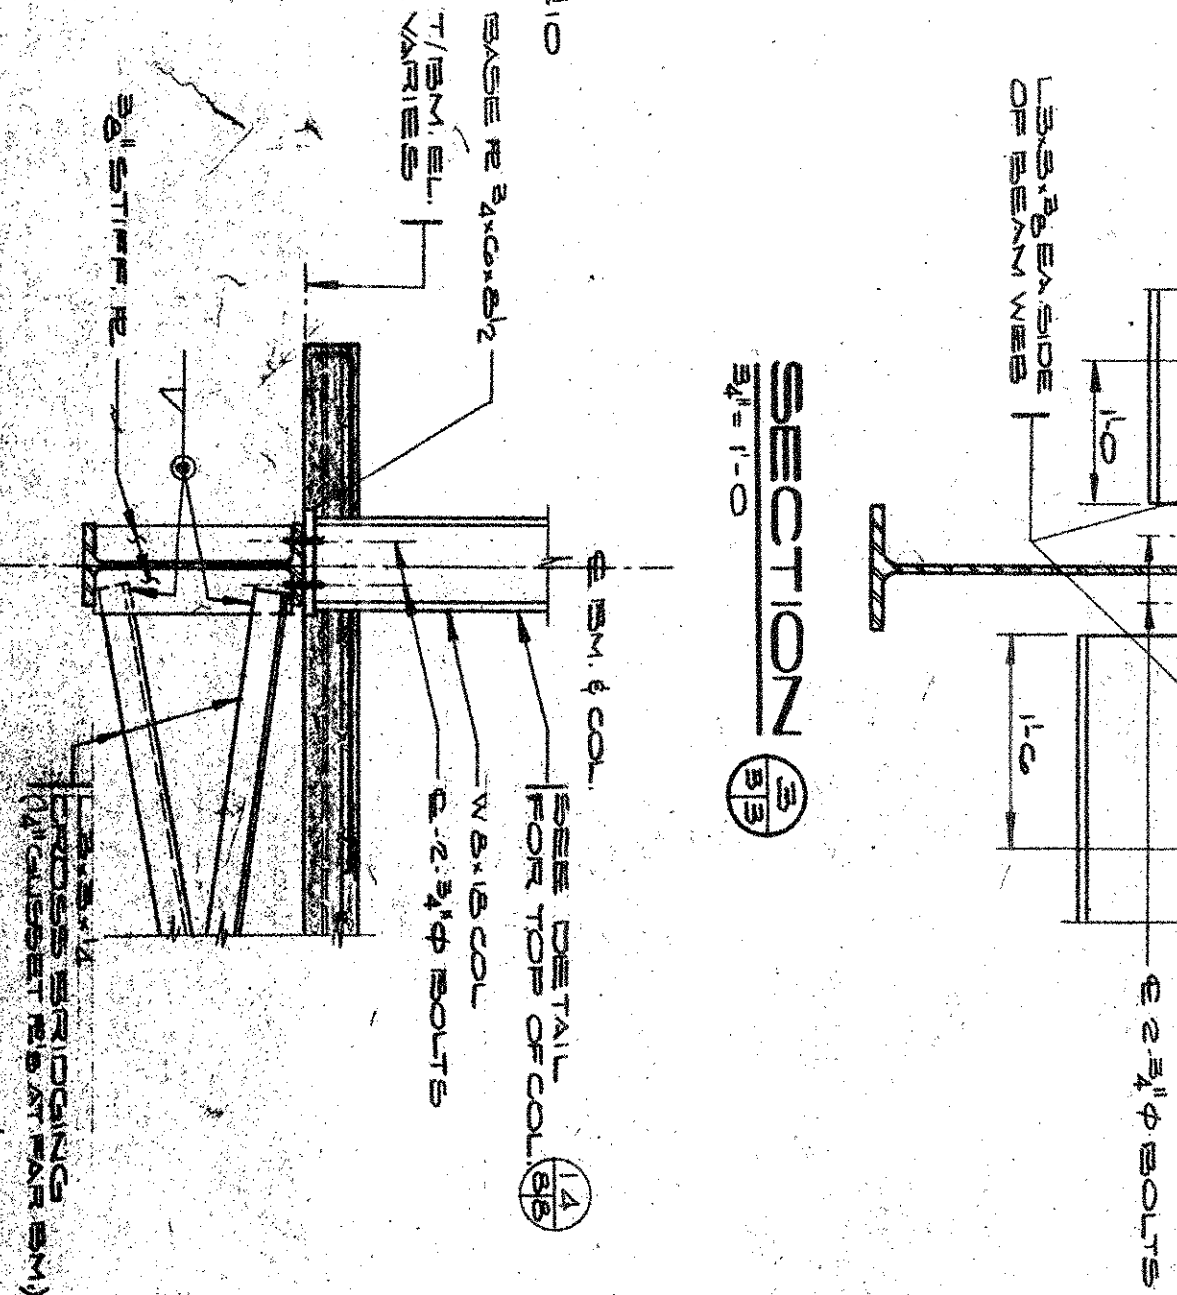

**SECTION H**

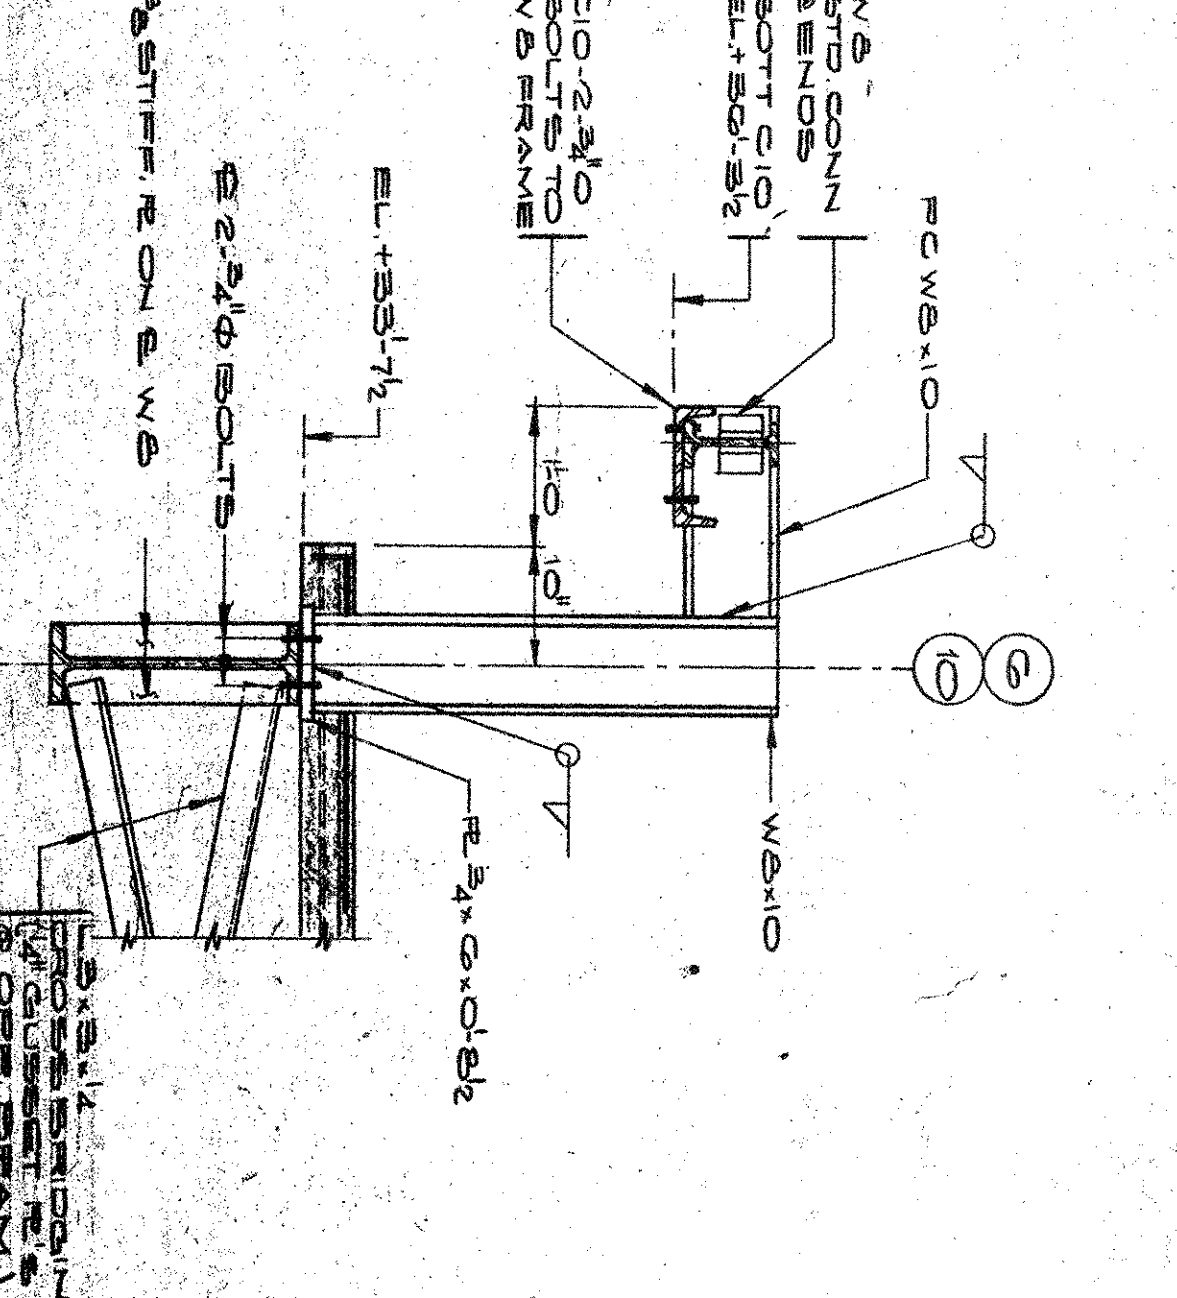

**SECTION H**

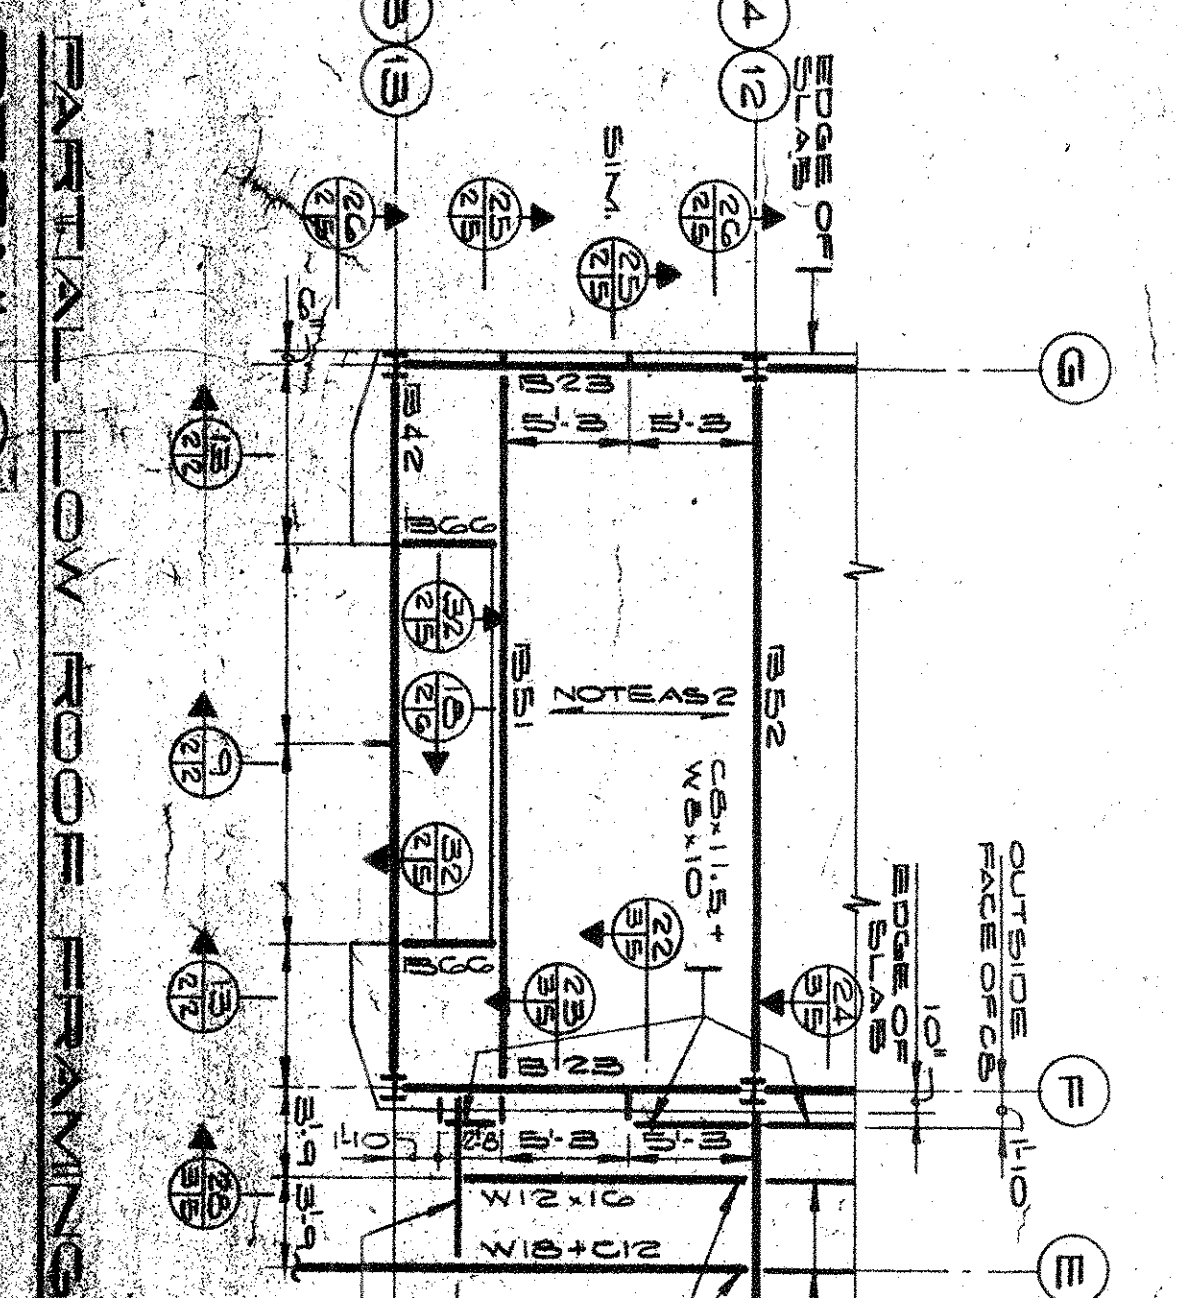

**SECTION H**