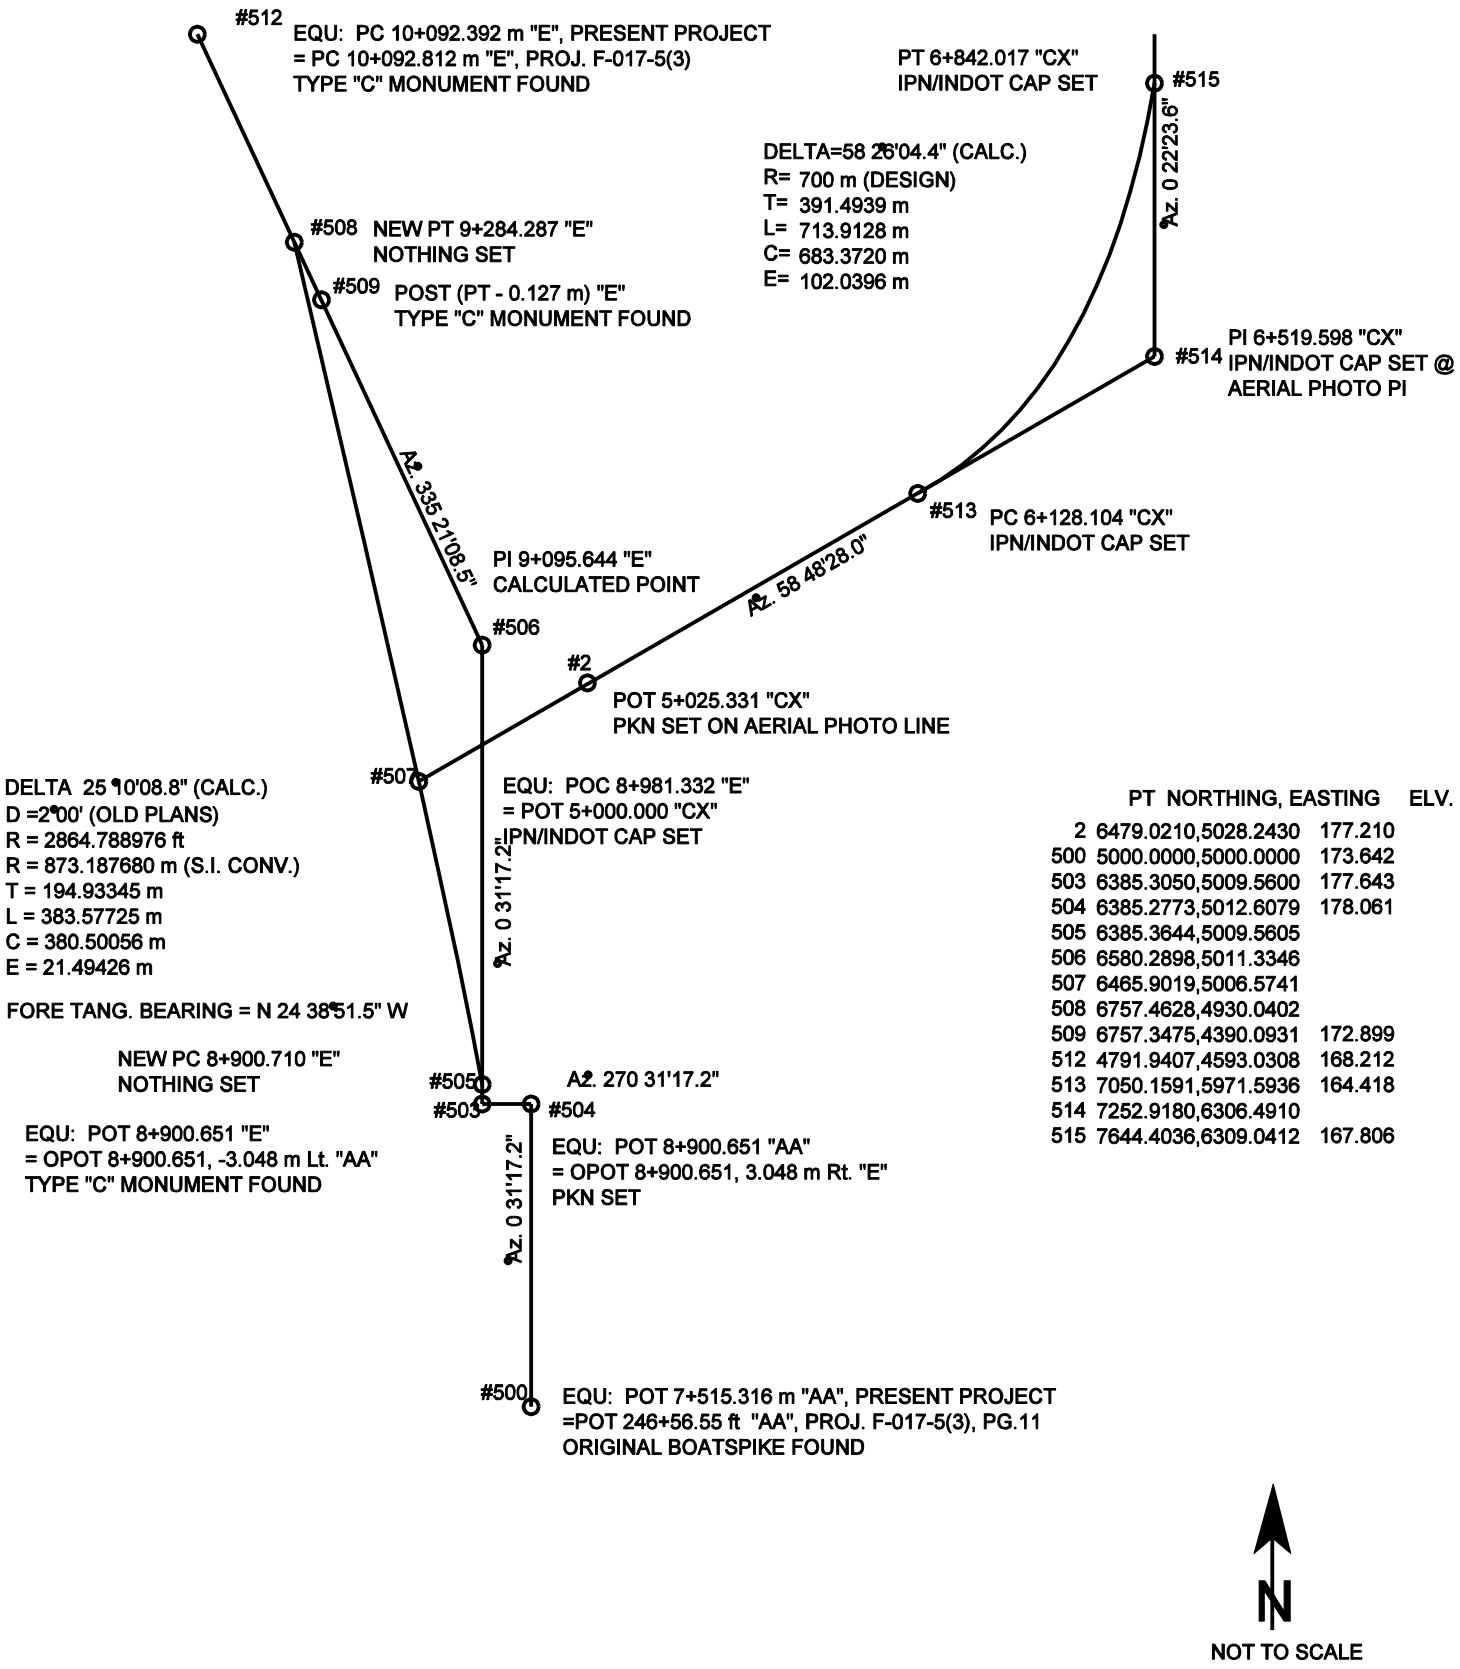

PT	NORTHING, EASTING	ELV.
2	6479.0210,5028.2430	177.210
500	5000.0000,5000.0000	173.642
503	6385.3050,5009.5600	177.643
504	6385.2773,5012.6079	178.061
505	6385.3644,5009.5605	
506	6580.2898,5011.3346	
507	6465.9019,5006.5741	
508	6757.4628,4930.0402	
509	6757.3475,4390.0931	172.899
512	4791.9407,4593.0308	168.212
513	7050.1591,5971.5936	164.418
514	7252.9180,6306.4910	
515	7644.4036,6309.0412	167.806

ALIGNMENT SKETCH

Figure 23-2B