PRESENT STR. BUILT IN 1941 BY I.S.H.C. AS 6 SPAN STR.

1 - R.C.G. SPAN @ 30.5 ft, 2 - S.B. SPAN @ 52 ft, 1 - S.T.T. SPAN @ 180 ft,
1 - S.B. SPAN @ 52 ft, & 1 - R.C.G. SPAN @ 30.5 ft ON 0 DEG. SK.
C.L. RDWY = 28.5 ft VERT. CLR. 15.0 ft

AVG. ORDINANCE OF SPAN "A": 6.92
AVG. ORDINANCE OF SPAN "B": 15.33
AVG. ORDINANCE OF SPAN "C": 24.76
AVG. ORDINANCE OF SPAN "D": 19.13
AVG. ORDINANCE OF SPAN "E": 12.01
AVG. ORDINANCE OF SPAN "F": 6.11

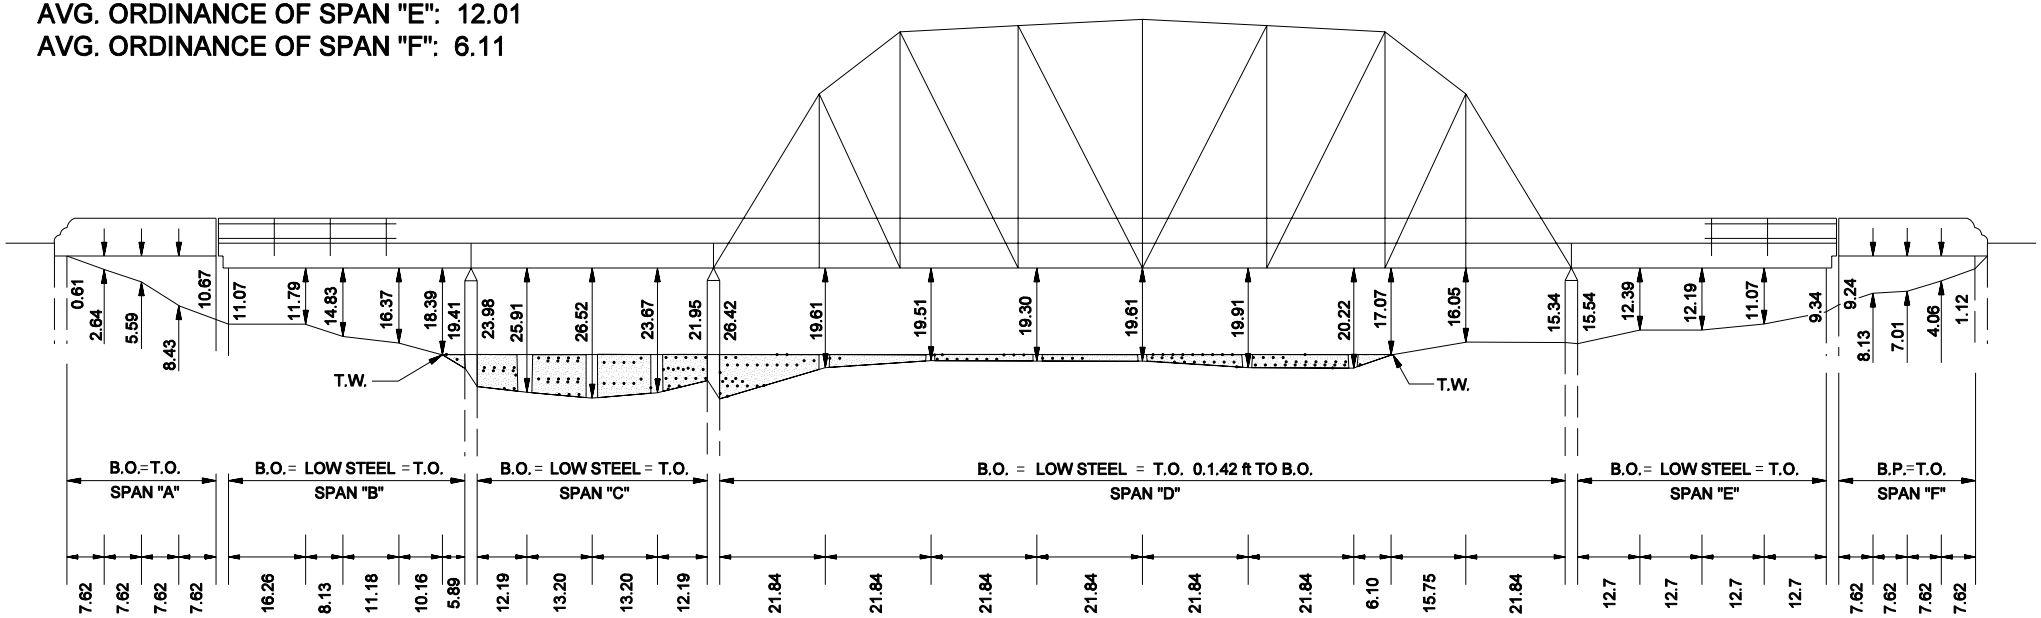

PRESENT STRUCTURE PROFILE VIEW

Figure 22-6F