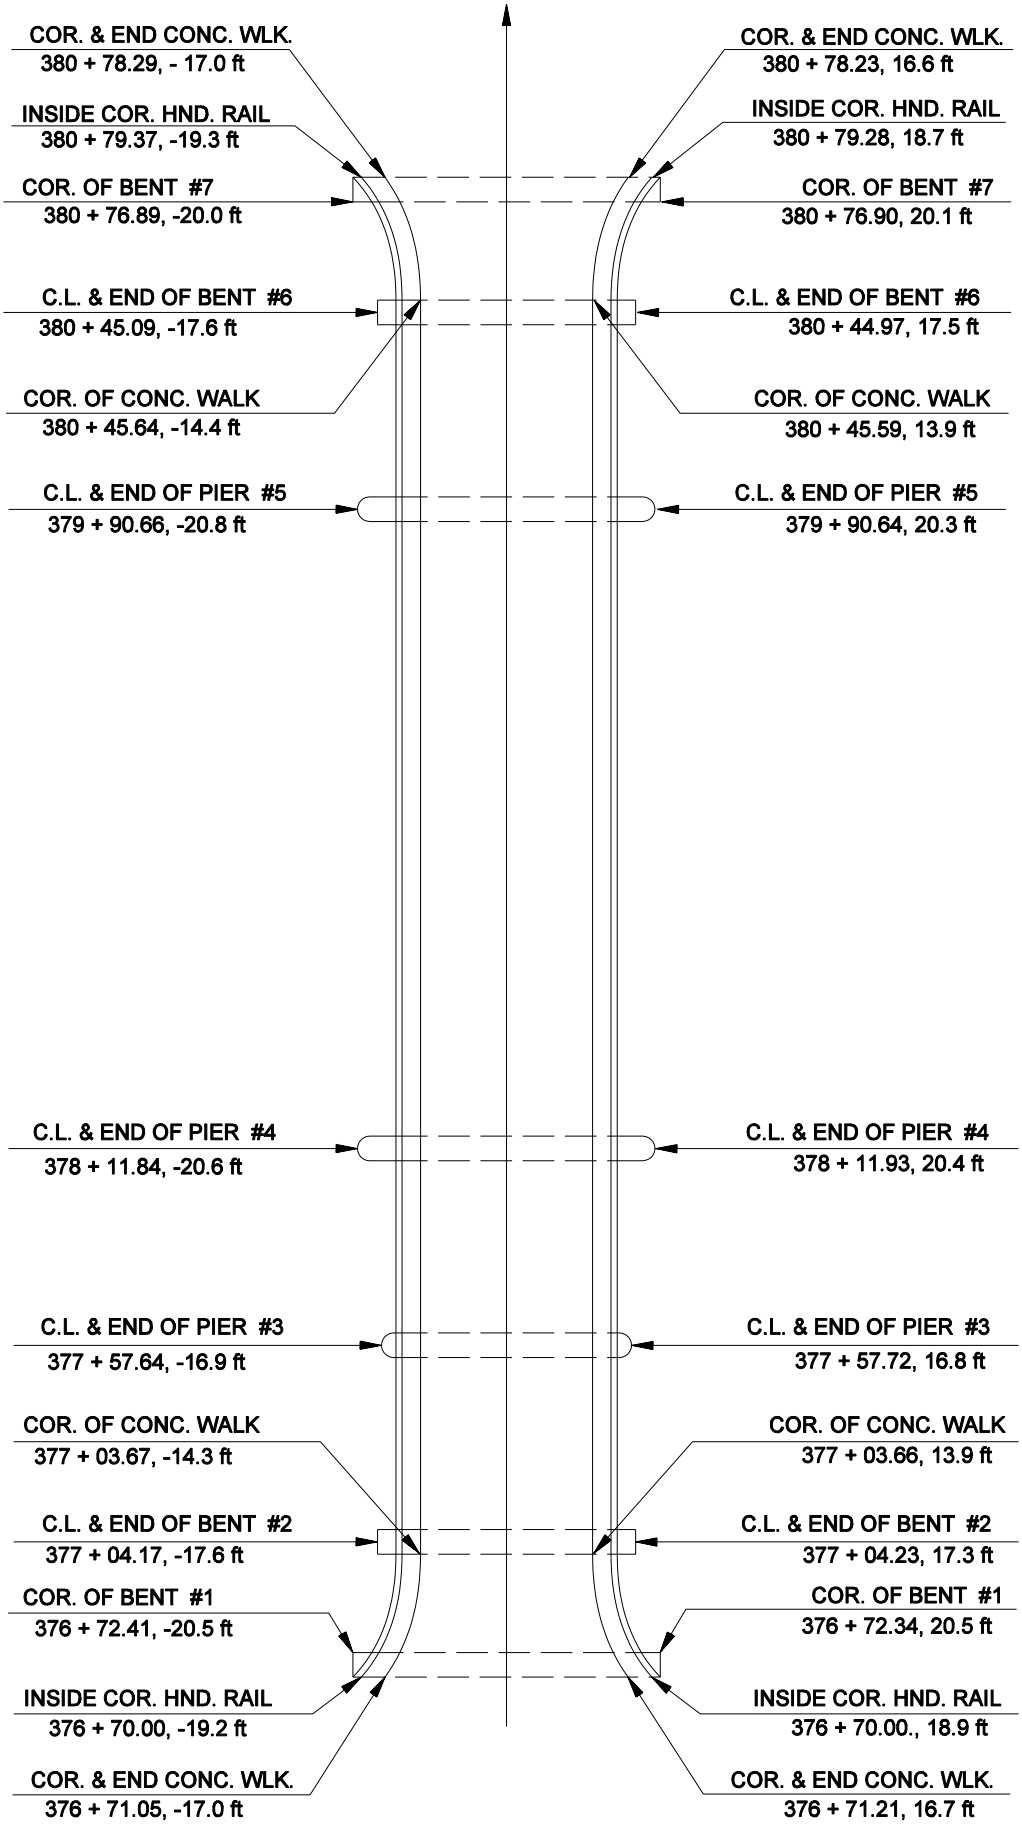

PRESENT STRUCTURE

Figure 22-6E