


SPECIAL SITUATIONS (INCLUDE THE TIME OF THE OCCURRENCE)

CHANGED DEAD BATTERIES BETWEEN SESSIONS 3 & 4 AT 15:42 (10:42 LOCAL)

STATION DESCRIPTION

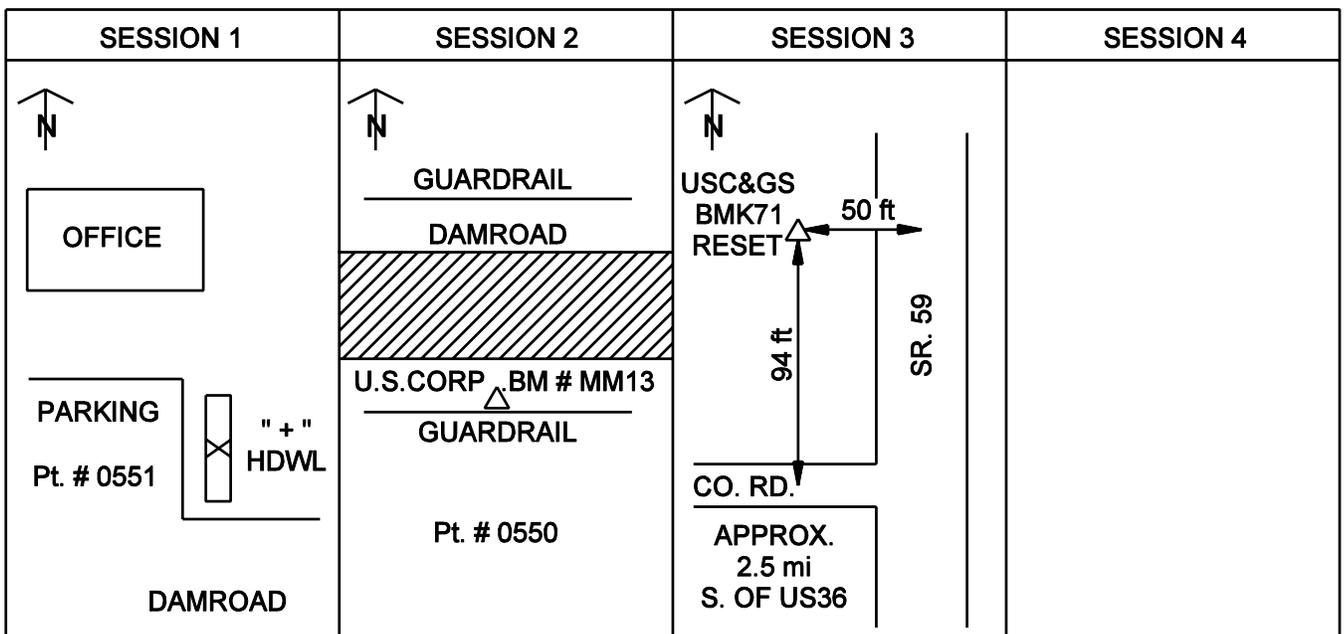

SPECIAL SITUATIONS AND STATION DESCRIPTION SHEET

Figure 25-2E