



INDIANA DEPARTMENT OF TRANSPORTATION

Driving Indiana's Economic Growth

100 North Senate Avenue
Room N925
Indianapolis, Indiana 46204

PHONE: (317) 232-5502
FAX: (317) 234-5133

Mitchell E. Daniels, Jr., Governor
Michael B. Cline, Commissioner

APPROVED MINUTES

May 19, 2011 Standards Committee Meeting

June 13, 2011

TO: Standards Committee

FROM: Scott Trammell, Secretary

RE: Minutes for the May 19, 2011 Standards Committee Meeting

A Standards Committee meeting was called to order by Mr. Pankow, sitting in for Mr. Miller, at 09:32 a.m. on May 19, 2011 in the N642 Bay Window Conference Room.

The meeting was adjourned at 12:34 p.m.

The following committee members were in attendance:

Greg Pankow*, Chairman
Dave Boruff, Traffic Admin.
Ron Walker, Materials Mgmt.
Tom Caplinger, Crawfordsville Dist.

Dave Andrews, Pvmt. Eng.
Jim Keefer, Fort Wayne Dist.
Tony Uremovich**, Str. Services
Jim Reilman***, Const. Mgmt.

*Proxy for Mark Miller

**Proxy for Randy Strain

***Proxy for Greg Pankow

Also in attendance were the following:

Bren George, FHWA
Scott Trammell, Secretary
Jeff James, INDOT
Joe Bruno, INDOT
Michael Prather, INDOT

Matt Beeson, INDOT
Steve Fisher, INDOT SiteMgr
Paul Berebitsky, ICA
Lana Podorvanova, INDOT
Pete Capon, APAI - Rieth-Riley

The following agenda items were considered:

A. GENERAL BUSINESS ITEMS

OLD BUSINESS

(No items considered)

NEW BUSINESS

1. Approval of Minutes from April 19, 2011 meeting

ACTION:

Approved as Submitted

Motion: Mr. Boruff

Second: Mr. Andrews

Ayes: 7

Nays: 0

2. Safety Edge

Mr. James

DISCUSSION: This item was introduced and presented by Mr. James who passed around some handouts showing the revisions made to the 409 and 508 spec sections. Mr. James explained the benefits of having a safety edge implemented in the construction of roadways in order to reduce the number of accidents that occur when a vehicle's wheels veer off the side of the road, especially when no shoulder currently exists in that area. Mr. James also addressed the new standard drawing which further illustrates the safety edge as proposed. Mr. James also addressed the four approved devices capable of installing the safety edge. Mr. James explained that the geometry for the safety edge in most states is traditionally 30°, so our drawing shows that we would also like to use a 30° angle.

Mr. Andrews stated that some contracts have been identified for the implementation of the safety edge but that the added costs have so far delayed its use. Mr. James also commented on the initial capital costs associated with implementing the safety edge. Mr. Pankow clarified that this would only be used on the shoulder itself. Mr. Andrews stated that it would be best used on county roads where there is no shoulder. Mr. James commented that most concrete pavements will have a asphalt shoulder so safety edge on PCCP pavements are not as likely as with asphalt pavements.

Mr. Pankow asked about the intent of this discussion for this item at this time and Mr. Andrews stated that the intent is to use a Unique Special Provision.

Mr. Keefer asked where the stone will go? Mr. Andrews stated that the stone shoulder will be flush with the top of the pavement. Mr. Keefer stated that the stone won't stay there, so what happens when it ruts? Mr. Keefer said he believes it will exacerbate the problem. Mr. James and Mr. Andrews explained that is something they are looking into. Mr. Walker concurred with Mr. Keefer and commented on the use of RAP and how that could be affected. Mr. Keefer also asked about compaction of the safety edge and how that can be accomplished. Mr. Capon (APAI-Reith-Riley) explained how that can be done with the proper attachments and equipment.

Mr. Uremovich and Mr. Walker discussed the language proposed and Mr. Uremovich further stated that there would no additional payment made for it. When asked by Mr. Pankow, Mr. Berebitsky concurred that this has not yet been done in our state. Further discussion ensued on how to handle concrete hand pours. Mr. James concurred that the next meeting for safety edge will occur in June of this year.

Mr. Pankow reiterated that this will be presented for now as a USP and be presented to the Standards Committee for approval sometime in the future.

Mr. Caplinger asked about the 30° angle, asking why we would fill the shoulder stone up to the top instead of leaving it at the bottom of the slope of the safety edge. Mr. Andrewski and Mr. Pankow stated that this is so far intended for use at the edge of the shoulder and not yet at the edge of pavement. Mr. Andrewski stated that it is still being studied. Mr. James said that they intend to proceed with information gathered from other states and with feedback from our Districts, we can then determine how to proceed from there.

Mr. Andrewski showed a photo from his laptop which illustrates what the safety edge looks like against a shoulder that had erosion issues (very little stone was left at the shoulder area). Further discussion ensued on when, how, where and why this design should be used. Mr. James is confident that District Construction will make it work.

Handouts are shown beginning on page 6 of these minutes.

3. Revision to Indiana Design Manual, Standard Contract Documents, and Unique Special Provisions

Mr. Uremovich

DISCUSSIONS: This item was presented by Mr. Uremovich for Mr. Strain, and informed the committee of intended revisions to Chapter 19 of the IDM. Mr. Uremovich passed around a handout illustrating the intention of the IDM revisions to Chapter 19.

Mr. Uremovich further explained the meaning behind the language as presented in the proposed 19-2.03 and 19-3.02. Further input was given by Mr. Walker as to the importance and need for this addition to Chapter 19. Mr. Andrewski suggested that each Unique Special Provision have a number assigned to it, as with the Recurring Special Provisions.

Further discussion on how the USP's can be reviewed and approved as well as how they should be presented. The approval process, at Mr. Pankow's suggestion, may require further determination by a separate committee.

Mr. Keefer commented on the language as presented in the proposed Chapter 19 revisions. There was further discussion on how the USP's can and should be presented and it was decided that those concerns can be reflected in the Design Manual. Mr. Uremovich also mentioned that the first order of business is to establish the Menu for the USP's and make it available on the website. It was determined that Mr. Trammell will accomplish this task.

Mr. Caplinger asked about turnaround time, and Mr. Pankow answered that it will depend on when the USP is submitted for review, and what that USP entails.

Mr. Uremovich said he will incorporate additional clarification language into the Design Manual as discussed.

A handout is shown on page 12 of these minutes.

B. CONCEPTUAL PROPOSAL ITEMS

OLD BUSINESS

(No items considered)

NEW BUSINESS

(No items considered)

C. STANDARD SPECIFICATIONS, SPECIAL PROVISIONS AND STANDARD DRAWINGS PROPOSED ITEMS

OLD BUSINESS

Item No. 02 04/19/11 (2010 SS) Mr. Pankow page 13

Recurring Special Provision:

108-C-XXX

WORKING RESTRICTIONS DURING

CERTAIN HOLIDAY PERIODS

104-R-168

SCHEDULE OF OPERATIONS AND TRAFFIC CONTROL FOR UNDERSEALING, CONCRETE PATCHING, PLACING UNDERDRAINS, AND RESURFACING

ACTION:

PASSED AS REVISED

NEW BUSINESS

Item No. 01 05/19/11 (2010 SS) Mr. Boruff page 20

Recurring Special Provisions:

805-T-169

TRAFFIC SIGNALS

922-T-168

TRAFFIC SIGNAL MATERIALS AND EQUIPMENT

Standard Drawings:

805-SGDH-01

INSTALLATION DETAIL DETECTOR HOUSING

805-SGCF-01

CONTROLLER CABINET FOUNDATION

TYPE P-1

805-SGCF-02

CONTROLLER CABINET FOUNDATION TYPE M

805-SGCF-05

EXISTING M FOUNDATION MODIFIED TO

P-1 FOUNDATION

805-SGFB-01

FLASHING BEACON WITH WARNING SIGN

805-sgFB-02

FLASHING BEACON WITH WARNING

SIGN DETAILS

805-SGCF-03

SIGNAL PEDESTAL FOUNDATION TYPE A

805-SGCO-01

SIGNAL SERVICE & CONTROLLER MOUNTED ON

WOOD POLE

805-SGLI-01

TRAFFIC SIGNAL LOOP INSTALLATION

ACTION:

PASSED AS REVISED

Item No. 02 05/19/11 (2010 SS) Mr. Walker page 36

Recurring Special Provision:

904-R-560

SMA COARSE AGGREGATE REQUIREMENTS

ACTION:

PASSED AS SUBMITTED

Item No. 03 05/19/11 (2010 SS) Mr. Walker page 41

401.05

Volumetric Mix Design

401.06

Recycled Materials

402.04

Design Mix Formula

402.08

Recycled Materials

402.15

Compaction

409.03

HMA Laydown Operation

410.06

Recycled Materials

ACTION: PASSED AS REVISED

Item No. 04 05/19/11 (2010 SS) Mr. Pankow page 51

Standard Drawings:

706-BRPP-01	RAILING, PF-1
706-BRPP-02	RAILING, PF-2
706-BRPP-03	RAILING, PS-1
706-BRPP-04	RAILING, PS-2
706-BRPP-06	RAILING, PF & PS DETAILS
706-BRTF-09	CONCRETE BRIDGE RAILING TYPE TF-2
706-BRTM-02	RAILING, CF-1

ACTION: PASSED AS SUBMITTED

cc: Committee Members (11)
FHWA (2)
ICA (1)

409.03 HMA Laydown Operations

(a) Distributor

The distributor shall be equipped, maintained, and operated to provide uniform heating and application rates as specified. The distributor shall have a volume measuring device and a thermometer to monitor the asphalt material.

Distributors shall also be equipped with a power unit for the pump and with a full circulation spray bar with vertical controls.

(b) Hauling Equipment

The mixtures shall be transported to the laydown operation in trucks that have tight, clean, and smooth beds.

Truck beds may be treated with approved anti-adhesive agents. The truck beds shall be raised after application of non-foaming anti-adhesive agents to drain liquids from the bed prior to HMA being loaded into the truck. The Department will maintain a list of approved Anti-Adhesive Materials.

Hauling equipment shall be equipped with a watertight cover to protect the mixture.

(c) Laydown Equipment

1. Paver

The paver shall be self-propelled, and equipped with a material receiving system, and equipped with heated and vibrating screeds. The paver may also include automatic slope and grade controls, extendable screeds and extendable augers.

Automatic control devices shall be separated from the paver screeds, paver tracks or wheels and be capable of adjusting both sides of the screeds automatically to maintain a constant angle of attack in relation to the grade leveler device or grade line.

A grade leveling system may be used to activate the control devices on each HMA course, including matching lays. The leveling system shall be attached to the paver and operated parallel to the paver's line of travel.

Extendable screeds shall be rigid, heated, and vibrating, and be capable of maintaining the cross slope, and line and grade of the pavement, to produce uniform placement of the materials.

Auger extensions shall be used when required to distribute the HMA uniformly in front of the screed.

When a paver is placing an intermediate or a surface mixture adjacent to an aggregate or earth shoulder, the side of the paver adjacent to the aggregate or earth shoulder shall be

HANDOUTS TO GENERAL BUSINESS ITEM 2. SAFETY EDGE

HMA SAFETY EDGE
(CONTINUED)

equipped with a device capable of constructing a safety edge. The following devices are approved for this application:

- a. Advent-Edge™, Advent-Edge Paving Equipment LLC
- b. Safety Edge End Gate, Carlson Paving Products, Inc.
- c. TransTech Shoulder Wedge Maker™, TransTech Systems, Inc.
- d. SafeTSlope Edge Smoother™, Troxler Electronic Laboratories, Inc.

2. Widener

A device capable of receiving, transferring, spreading, and striking off materials to the proper grade and slope.

3. Other Mechanical Devices

Inaccessible or short sections of HMA may be placed with specialty equipment approved by the Engineer.

APPROVED MINUTES

508.04 Placement Equipment

(a) Slipform

The paver shall spread, consolidate, and shape the freshly placed concrete in one complete pass to provide a dense and homogeneous pavement. The paver shall be of sufficient weight (mass) and power to construct the specified PCCP, at an adequate variable forward speed, and without transverse, longitudinal, or vertical instability. The paver shall be equipped with an automated steering and elevation control system.

The paver shall be capable of constructing pavement edges in accordance with drawing 500-R-XXXd.

The paver shall consolidate by vibrating the concrete for the full width and depth of the PCCP. Vibration shall be accomplished by internal vibrators, which have a variable frequency range of 7,000 to 12,000 vibrations per min. The amplitude of vibration shall be between 0.025 in. (0.6 mm) and 0.06 in. (1.5 mm). The vibrators shall be spaced and operated to achieve acceptable consolidation. The paver shall include a hand held tachometer or other suitable device for measuring the frequency of the vibrators. The automated vibrator control shall be capable of stopping vibration when forward movement ceases.

Mechanical tie bar inserters shall be rigidly attached to the paver and may be operated manually or automatically controlled.

A mechanical belt placer, if used, shall have a re-combining deflector plate mounted on the end of the discharge belt.

(b) Form Riding Equipment

The finishing machine shall be supported by forms and be equipped with two or more oscillating type transverse screeds and a transverse smoothing float.

Forms for riding equipment shall be of sufficient thickness to maintain the true cross section and shall be furnished in sections no less than 10 ft (3 m) in length. Forms shall have a minimum depth equal to the prescribed edge thickness of the concrete pavement without a horizontal joint, and a minimum base width equal to the depth of the forms. Flexible or curved forms shall be of an acceptable design. Forms shall be provided with adequate devices for secure setting so that when in place they can withstand, without visible spring or settlement, the impact and vibration of the consolidating and finishing equipment. Flange braces shall extend outward on the base a minimum of 2/3 of the height of the form. The top face of the form shall not vary from a true plane by more than 1/8 in. in 10 ft (3.0 mm in 3 m) and the upstanding leg shall not vary by more than 1/4 in. (6 mm). The forms shall contain provisions for locking the ends of abutting form sections together tightly for secure setting.

The transverse screed and transverse smoothing float shall be suspended from and guided by a rigid frame. The frame shall have a maximum effective wheel base of 14 ft (4.2 m). The length of the float shall be approximately 2 in. (50 mm) less than the normal width of the

PCCP SAFETY EDGE
(CONTINUED)

pavement and have an adjustable crown section. The forward speed of the float shall be adjustable.

The vibration equipment shall consolidate the full width and depth of the strip of PCCP being placed. Vibrators may be either the surface pan type or the internal type with either immerse tube or multiple spuds. Vibrators may be attached to the spreader or the finishing machine or mounted on a separate carriage. The frequency of the surface pan type shall be 3500 impulses per min or greater. The frequency of the internal type shall have no less than 5000 impulses per min for tube vibrators and spud vibrators shall have a frequency of from 10,000 to 12,000 impulses per min in air. The paver shall include a device, such as a hand held tachometer for measuring the frequency of the vibrators. Vibrators shall have automatic controls, which stop vibration when forward motion ceases. The maximum spacing of spud vibrators shall be 2 ft (0.6 m). A warning device shall be connected to each vibrator circuit to indicate a failure of any individual vibrator and shall be visible from the ground.

(c) Hand Placement

Forms shall be capable of constructing pavement edges in accordance with drawing 500-R-XXXd.

1. Steel Forms

Steel forms shall be 10 ft (3 m) or greater in length. Forms shall be capable of being staked in three locations or more for each 10 ft (3 m) section and shall be equipped to interlock. Forms shall support finishing equipment without deflection in either the vertical or horizontal direction. The top face of the form shall not vary from a true plane by more than 1/8 in. in 10 ft (3.0 mm in 3 m).

2. Wood Forms

Wood forms shall support finish equipment without deflection in either vertical or horizontal direction.

3. Finishing Equipment

The finish device or machine shall be capable of producing a uniform surface free of voids and in accordance with the planned profiles and cross section.

A mechanical tube finisher shall consist of a single or multiple rotating strike-off/finish tubes setting approximately transverse to the longitudinal movement of the machine. The length of finish tubes shall be a minimum of 2 ft (0.6 m) longer than the planned PCCP width. The forward speed of the machine as well as the rate of the finish tube rotation shall be variable and it shall be reversible to allow for multiple finish passes.

A vibratory screed finisher shall consist of a truss frame with a minimum base width of 1 ft (0.3 m), which extends across the transverse width of the PCCP. The frame shall extend 2 ft (0.6 m) beyond the width of the PCCP and shall hold its shape when moved forward. The screed shall move forward with either hydraulic or manual wenches, which are capable of maintaining the screed at a right angle to the direction of travel. The screed shall be vibrated as it moves forward and the vibration shall stop when forward motion ceases. Vibration shall be

PCCP SAFETY EDGE
(CONTINUED)

accomplished with mechanical driven eccentric weights or with auxiliary driven pneumatic vibrators.

A mechanical bridge deck finishing machine shall consist of a single or multiple rotating cylinders setting approximately parallel to the longitudinal movement of the machine and operating transversely. The forward motion of the machine as well as the transverse movement of the finish cylinders shall be variable.


A hand operated strike off shall be rigid and shall hold its shape when moved forward with a combined longitudinal and transverse motion.

A mechanical belt placer, if used, shall have a re-combining deflector plate mounted on the end of the discharge belt.

APPROVED MINUTES

Mr. James
Date: 05/19/11

HANDOUTS TO GENERAL BUSINESS ITEM 2. SAFETY EDGE
500-R-XXXd SAFETY EDGE

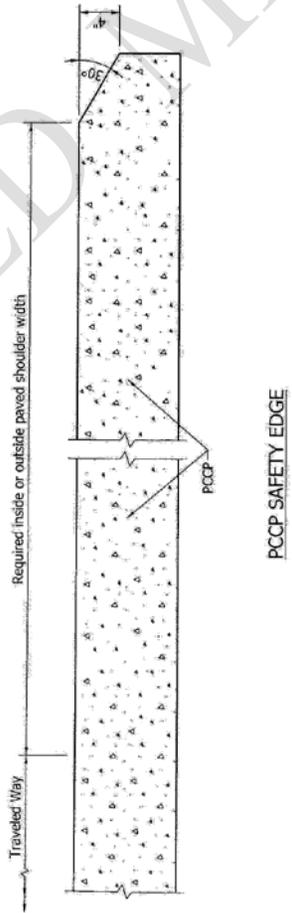

INDIANA DEPARTMENT OF TRANSPORTATION	PCCP SAFETY EDGE
XXXXXXXXXXXXXXXXXXXX	XXXXXXXXXXXX
STANDARD DRAWING NO. E-XXX-XXXX-XX	XXXXXXXXXXXX
	DESIGN STANDARDS ENGINEER
L. MacCleave	DATE XXX/XX/XX
R. MacCleave	DATE XXX/XX/XX
M. Miller	DATE XXX/XX/XX
DESIGN STANDARDS ENGINEER	CHIEF HIGHWAY ENGINEER

APPROVED

19-2.03 Unique Special Provisions

The Unique Special Provisions Menu is maintained by the Department and is available on the Department's website. The Menu lists the Department's preferred unique special provisions. If a preferred unique special provision has been posted to the website, a designer may seek approval to use the provision.

If the Unique Special Provisions Menu does not list a special provision that addresses a specific situation, the Construction Management Division's construction specifications engineer should be contacted to determine if a similar special provision has already been written.

If nothing has been written to address a specific situation, a new unique special provision may be written. The format is discussed in Section 19-3.01(02).

The Unique Special Provision Review and Approval Process is discussed in Section 19-3.02.

19-3.02 Unique Special Provision Review And Approval Process

Once it has been determined that a unique special provision is required as outlined in Section 19-2.03 and has been written, an electronic copy is to be transmitted to the Construction Management Division's construction specifications engineer for review. The submittal will include a written justification for the provision and a written basis for use.

The unique special provision will be reviewed to ensure that it does not conflict with current Department policy or procedure, that it does not create unwarranted costs or inefficiencies, that it does not duplicate a description of work addressed by the INDOT Standard Specifications or Recurring Special Provisions, and that the work it describes is materially available, testable, constructible, and non-proprietary unless approved. The provision will also be checked for proper structure, language, and format.

If the unique special provision is accepted, the construction specifications engineer will provide written approval for the unique special provision to be included in the contract. A project with unique special provisions that do not have the construction specifications engineer's written approval will not be accepted for letting.

SPECIFICATION REVISIONS
REVISION TO RECURRING SPECIAL PROVISIONS

(OLD BUSINESS ITEM)

PROPOSAL TO STANDARDS COMMITTEE

PROBLEM(S) ENCOUNTERED: A few Districts are inserting working restrictions around holidays into contracts.

PROPOSED SOLUTION: Delete the provisions that the various Districts are using and combine into one general working restriction special provision that would be used in all contracts in all Districts.

APPLICABLE STANDARD SPECIFICATIONS: None

APPLICABLE STANDARD DRAWINGS: None

APPLICABLE DESIGN MANUAL SECTION: None

APPLICABLE SECTION OF GIFE: None

APPLICABLE RECURRING SPECIAL PROVISIONS: Delete 108-C-202; propose to create new RSP

PAY ITEMS AFFECTED: None

Submitted By: Greg Pankow

Title: State Construction Engineer

Organization: INDOT

Phone Number: 2-5502

Date: March 15, 2011

APPLICABLE SUB-COMMITTEE ENDORSEMENT: An ad hoc committee consisting of: Roland Fegan, Jim Keefer, Jeff Logman, Mark Miller, Brad Minnick, Bart Mueller, Joe Novak, Greg Pankow, and Jim Reilman. ICA was provided an opportunity to review and comment.

REVISION TO RECURRING SPECIAL PROVISIONS (OLD BUSINESS ITEM)
108-C-XXX WORKING RESTRICTIONS DURING CERTAIN HOLIDAY PERIODS

108-C-585 WORKING RESTRICTIONS DURING CERTAIN HOLIDAY PERIODS

(Adopted 05-19-11)

The Standard Specifications are revised as follows:

SECTION 108, AFTER LINE 334, INSERT AS FOLLOWS:

Contractors will not be permitted to work during the following holiday periods unless prior written approval is received from the Engineer. All deliveries and traffic coming from suppliers shall cease during the Department-ordered suspensions of work listed below. No time extensions to closure periods, intermediate completion dates, or contract completion dates will be granted for suspending work during these holiday periods.

(a) New Year's Day. If New Year's Day falls on a Sunday, work shall be suspended from noon December 31 until sunrise January 3. If New Year's Day falls on a Monday through Saturday, work shall be suspended from noon December 31 until sunrise January 2.

(b) Good Friday. Work shall be suspended from noon on Good Friday until sunrise Monday.

(c) Memorial Day. Work shall be suspended from noon the Friday before Memorial Day until sunrise Tuesday, the day after Memorial Day.

(d) Independence Day. If Independence Day falls on a:

Sunday - Work shall be suspended from noon Friday, July 2, until sunrise Tuesday, July 6.

Monday - Work shall be suspended from noon Friday, July 1, until sunrise Tuesday, July 5.

Tuesday - Work shall be suspended from noon Friday, June 30, until sunrise Wednesday, July 5.

Wednesday - Work shall be suspended from sunset on Tuesday, July 3, until sunrise Thursday, July 5.

Thursday - Work shall be suspended from noon Wednesday, July 3, until sunrise Monday, July 8.

Friday - Work shall be suspended from noon Thursday, July 3, until sunrise Monday, July 7.

REVISION TO RECURRING SPECIAL PROVISIONS (OLD BUSINESS ITEM)
108-C-XXX WORKING RESTRICTIONS DURING CERTAIN HOLIDAY PERIODS

Saturday - Work shall be suspended from noon Thursday, July 2, until sunrise Monday, July 6.

(d) Labor Day. Work shall be suspended from noon the Friday before Labor Day until sunrise Tuesday, the day after Labor Day.

(e) Thanksgiving Day. Work shall be suspended from noon the Wednesday before Thanksgiving Day until sunrise the Monday after Thanksgiving Day.

(f) Christmas Day. Work shall be suspended from noon December 24 until sunrise December 27.

The Department may order the suspension of work, either wholly or in part, for a period of time for certain holidays *not already specified herein*. For such orders, ~~if the contract suspension is not stated in the contract documents,~~ the contract completion time will be adjusted as follows:

REVISION TO RECURRING SPECIAL PROVISIONS (OLD BUSINESS ITEM)

104-R-168 SCHEDULE OF OPERATIONS AND TRAFFIC CONTROL FOR UNDERSEALING,
CONCRETE PATCHING, PLACING UNDERDRAINS, AND RESURFACING

(Proposed changes shown as highlighted in gray. Basis for Use: Required for all pavement undersealing, patching, shoulder drain placement, and resurfacing specified.)

104-R-168 SCHEDULE OF OPERATIONS AND TRAFFIC CONTROL FOR UNDERSEALING,
CONCRETE PATCHING, PLACING UNDERDRAINS, AND RESURFACING

(Revised 05-19-11)

The Standard Specifications are revised as follows:

SECTION 104, AFTER LINE 343, INSERT AS FOLLOWS:

(e) Schedule of Operations and Traffic Control for Undersealing, Concrete Patching, Placing Underdrains, and Resurfacing

Unless otherwise directed or permitted, the work specified shall be arranged and prosecuted in accordance with the applicable requirements of 107 and 801, and as set out herein.

All necessary barricades, flashing arrow signs, suitable lights, danger signals, signs, flaggers, and other traffic control devices shall be provided, erected and maintained for the protection of the workers and the safety of the public. Such protection shall be in accordance with 107.12 and as shown on the plans or as directed. Traffic shall be maintained such that the flow of traffic is interrupted for the shortest amount of time possible.

1. Construction Sequence

The construction shall be done in the following sequence, unless otherwise directed.

- a. Undersealing shall be accomplished before all patching or other work within the pavement area is done.*
- b. The pavement patching shall be accomplished after undersealing is complete.*
- c. The underdrains shall be placed after the pavement patching is complete.*
- d. Resurfacing operations shall then begin.*

The names and telephone numbers of the Superintendent and ~~one~~ other responsible employee shall be furnished. They shall be on call or available at night, on weekends, or during other non-working periods. These employees shall oversee the repair or replacement of all traffic control devices which may become damaged or inoperative.

2. Lane Closures

Only ~~one~~ lane in each direction shall be closed at a time, except as noted below. Traffic maintenance setups shall not be spaced closer than 3 mi (5 km) from one another on a ~~one~~-way

REVISION TO RECURRING SPECIAL PROVISIONS (OLD BUSINESS ITEM)
104-R-168 SCHEDULE OF OPERATIONS AND TRAFFIC CONTROL FOR UNDERSEALING,
CONCRETE PATCHING, PLACING UNDERDRAINS, AND RESURFACING

roadway. If a traffic maintenance setup extends beyond ~~one~~ or more ramps, an "Exits Right Lane Only" sign shall be placed.

~~On all major holiday weekends, _____ lanes of through traffic shall be maintained in each direction at all times for the holiday periods listed in 108.08. from noon on the day before the weekend to 6:00 a.m. on the day after the weekend. Major holidays will be defined as New Year's Day, Good Friday, Memorial Day, Independence Day, Labor Day, Thanksgiving Day, the Friday after Thanksgiving Day, and Christmas Day. Traffic shall be maintained on other holidays as directed.~~

_____ lanes of through traffic shall be maintained in each direction at all times during rush hour periods as directed. When work is performed during center lane closure on a ~~three~~3 lane roadway, the median and center lanes may be closed during times other than rush hour periods as directed. Closure will be permitted for the center lane only at all other times.

3. Patching

During the patching operation of the outside lane or ramps, closure of such ramps will be permitted for the shortest possible time while patching is being done in the outside lane in the vicinity of ramp exits or entrances. Ramp closures will not be permitted during rush hour periods as directed.

Maintenance of traffic shall include a taper plus an additional length, both as shown on the plans, prior to reaching the construction area. The taper and additional length shall be delineated by drums spaced at intervals of 50 ft (15 m). One flashing arrow sign shall be placed at the beginning of the taper. A minimum of ~~two~~2 drums or barricades shall be placed on the traffic approach side of each concrete patch or open hole.

4. Resurfacing

During resurfacing operations, _____ lanes of through traffic in each direction shall be maintained at all times from 5:00 a.m. to 9:00 p.m. A minimum ~~one~~ of ~~one~~1 lane of through traffic in each direction shall be maintained at all times from 9:00 p.m. to 5:00 a.m.

During the paving operation of the outside lane or ramps, closure of such ramps will be permitted for the shortest possible time while paving is being done in the outside lane in the vicinity of ramp exits or entrances, or in acceleration lanes, deceleration lanes, or gore areas. Ramp closures will not be permitted during rush hour periods as directed. The ramps for ~~two~~2 consecutive interchanges shall not be closed at the same time.

During HMA base placement, the paving operation shall be limited to a segment including not more than ~~two~~2 interchanges. All HMA base placement shall be completed in such segment prior to commencing with the next segment. When an outside lane is being paved, the adjacent shoulder shall be paved simultaneously.

REVISION TO RECURRING SPECIAL PROVISIONS (OLD BUSINESS ITEM)

104-R-168 SCHEDULE OF OPERATIONS AND TRAFFIC CONTROL FOR UNDERSEALING,
CONCRETE PATCHING, PLACING UNDERDRAINS, AND RESURFACING

Extension of a HMA course will be permitted for ~~one~~ lane, or ~~one~~ lane and shoulder, for a full day's placement. Such HMA course shall be placed on the adjacent lane and shoulder on the following day. If the Contractor does not plan to work on the following day, then such HMA course shall be placed on the adjacent lane and shoulder on the same day. An overnight lane closure shall be maintained on all courses over ~~165~~220 lb/sq yd (~~90~~120 kg/m²). Such closure shall be as shown on the plans.

~~The beginning and ending of each course shall, at the end of each day's operations, be feathered as directed to provide a smooth transition to the driving surface. Transverse joints shall be in accordance with 401.15 or 402.14.~~

SECTION 801, AFTER LINE 1155, INSERT AS FOLLOWS:

The costs of furnishing, placing, moving, removal, and maintenance of the "Exits Right Lane Only" sign shall be included in the cost of construction signs type A.

The cost of maintenance of traffic during underseal operations shall be included in the costs of asphalt material for underseal and drilled holes for underseal. The cost of maintenance of traffic during pavement edge drain installation shall be included in the cost of underdrains.

COMMENTS AND ACTION

(OLD BUSINESS ITEM)

108-C-XXX WORKING RESTRICTIONS DURING CERTAIN HOLIDAY PERIODS

104-R-168 SCHEDULE OF OPERATIONS AND TRAFFIC CONTROL FOR UNDERSEALING, CONCRETE PATCHING, PLACING UNDERDRAINS, AND RESURFACING

DISCUSSIONS: This item was introduced and explained by Mr. Reilman.

Mr. Reilman explained that the intent is to make one schedule proposal that is recognized state wide, instead of having varying requirements in different Districts.

Mr. Boruff asked about Christmas Day and suggested revising it to say December 23. Mr. Pankow explained that the dates shown are per discussions with the District's Construction Directors and with Mr. Berebitsky with the ICA. Mr. Keefer stated that he only gets about half a dozen requests to work outside of the current provisions.

Mr. Andrewski commented on the language on page 18 of these meeting minutes and suggested that it just say to refer to spec section 401.15 or 402.14, in regards to transverse joints. Mr. Andrewski believes this RSP would be in conflict with the Standard Specifications, as written.

<p>Motion: Mr. Reilman Second: Mr. Walker Ayes: 7 Nays: 0</p>	<p>Action: <input type="checkbox"/> Passed as Submitted <input checked="" type="checkbox"/> Passed as Revised <input type="checkbox"/> Withdrawn</p>
<p>Standard Specifications Sections affected: NONE</p> <p>Recurring Special Provision affected: 108-C-202 WORKING RESTRICTIONS MEMORIAL DAY, JULY FOURTH, LABOR DAY WEEKENDS</p> <p>104-R-168 SCHEDULE OF OPERATIONS AND TRAFFIC CONTROL FOR UNDERSEALING, CONCRETE PATCHING, PLACING UNDERDRAINS, AND RESURFACING</p> <p>Standard Sheets affected: NONE</p> <p>Design Manual Sections affected: NONE</p> <p>GIFE Sections cross-references: NONE</p>	<p><input type="checkbox"/> 20 Standard Specifications Book <input type="checkbox"/> Revise Pay Items List <input checked="" type="checkbox"/> Discontinue RSP (No.108-C-202) <input checked="" type="checkbox"/> Create RSP (No.108-C-585) Effective <u>September 01, 2011</u> Letting RSP Sunset Date: <u>TBD</u></p> <p><input checked="" type="checkbox"/> Revise RSP (No.104-R-168) Effective <u>September 01, 2011</u> Letting RSP Sunset Date: <u> </u></p> <p>Standard Drawing Effective <input type="checkbox"/> <input type="checkbox"/> Create RPD (No. <input type="checkbox"/>) Effective <input type="checkbox"/> Letting <input type="checkbox"/> Technical Advisory</p> <p>GIFE Update Req'd.? Y <input type="checkbox"/> N <input type="checkbox"/> By <input type="checkbox"/> Addition or <input type="checkbox"/> Revision</p> <p>Frequency Manual Update Req'd? Y <input type="checkbox"/> N <input type="checkbox"/> By <input type="checkbox"/> Addition or <input type="checkbox"/> Revision</p> <p>Received FHWA Approval? <u>Yes</u></p>

REVISION TO RECURRING SPECIAL PROVISIONS AND STANDARD DRAWINGS
922-T-168 TRAFFIC SIGNAL MATERIALS AND EQUIPMENT

(Only affected section of the RSP 922-T-168 is shown.
Proposed changes are shown highlighted in gray.
Basis for Use: Required for all contracts with 805 pay items.)

The Standard Specifications are revised as follows:

SECTION 922, BEGIN LINE 1658, INSERT AS FOLLOWS:

922.19 Conduit and Fittings

(a) Steel Conduit

Steel conduit, couplings, and elbows shall be galvanized rigid steel conduit in accordance with UL 6. The conduit shall be galvanized by the hot dip method on the interior and exterior surfaces. Conduit threads shall be cut after galvanizing. The conduit shall be supplied with a threaded coupling attached to ~~one~~1 end and the other threaded end protected by a suitable shield.

The various conduit fittings such as bands, bodies, straps, lock nuts, and threadless connectors, shall be in accordance with Federal Specifications A-A-50553 and shall be galvanized if not stainless steel. Conduit straps shall be ~~two~~2 hole straps with a minimum thickness of 1/8 in. (3 mm). Conduit lock nuts 3/8 in. to 1 1/2 in. (10 mm to 38 mm) in size shall be made of steel. Other sizes shall be made of either steel or malleable iron. All conduit lock nuts shall be galvanized. Other nuts shall be either stainless steel or galvanized steel.

(b) Polyvinyl Chloride, PVC, Schedule 40 or 80 PVC Conduit

PVC conduit shall be schedule 40 in accordance with ASTM D 1785. The PVC conduit fittings shall be in accordance with ASTM D 2466. Schedule 40 polyvinyl chloride, PVC, conduit, Conduit, fittings, and accessories shall be manufactured from polyvinyl chloride meeting ASTM D 1784 and shall comply with all the applicable requirements of NEMA TC2 and UL 651. Each length of pipe shall include a coupling.

(c) Schedule 80 PVC Conduit

Schedule 80 polyvinyl chloride, PVC, conduit, fittings and accessories shall be manufactured from polyvinyl chloride meeting ASTM D 1784 and shall comply with all the applicable requirements of NEMA TC2 and UL 651. Each length of pipe shall include a coupling.

(d) Fiberglass Conduit

Rigid fiberglass conduit and fittings shall be filament wound consisting of E-glass and corrosion resistant epoxy resin manufactured for use at temperatures from -40 °F to 230 °F (-40 °C to 110 °C). Rigid fiberglass conduit shall be pigmented with carbon black for ultraviolet protection and fire resistant per UL 94. All rigid fiberglass conduit shall be heavy walled, HW, and meet the specifications, labeling and testing of ANSI/NEMA TC14.

BACKUP MATERIAL: SECTION FROM RSP 805-T-169 TRAFFIC SIGNALS
805.15 METHOD OF MEASUREMENT

805.15 Method of Measurement

Traffic signal head, pedestrian signal head, pedestrian push button, controller cabinet foundation, M foundation modified to P-1 foundation signal steel strain pole, signal wood pole, signal cantilever structure, signal support foundation, signal service, disconnect hanger, magnetometer detector, microloop detector, loop detector delay amplifier, *loop detector delay counting amplifier*, *loop detector rack*, *auxiliary BIU panel*, signal handhole, signal detector housing, span catenary and tether, and span catenary for flasher will be measured by the number of units installed.

Conduit of the type specified will be measured by the linear foot (meter) from outside to outside of foundations. Signal cable and signal interconnect cable will be measured by the linear foot (meter).

APPROVED MINUTES

Item No. 01 05/19/11 (2010 SS)(contd.)

Mr. Boruff


Date: 05/19/11

BACKUP MATERIAL: SECTION FROM RSP 805-T-169 TRAFFIC SIGNALS
805.15 METHOD OF MEASUREMENT

THIS PAGE LEFT INTENTIONALLY BLANK


APPROVED MINUTES

REVISION TO RECURRING SPECIAL PROVISIONS AND STANDARD DRAWINGS
 805-SGDH-01 INSTALLATION DETAIL DETECTOR HOUSING

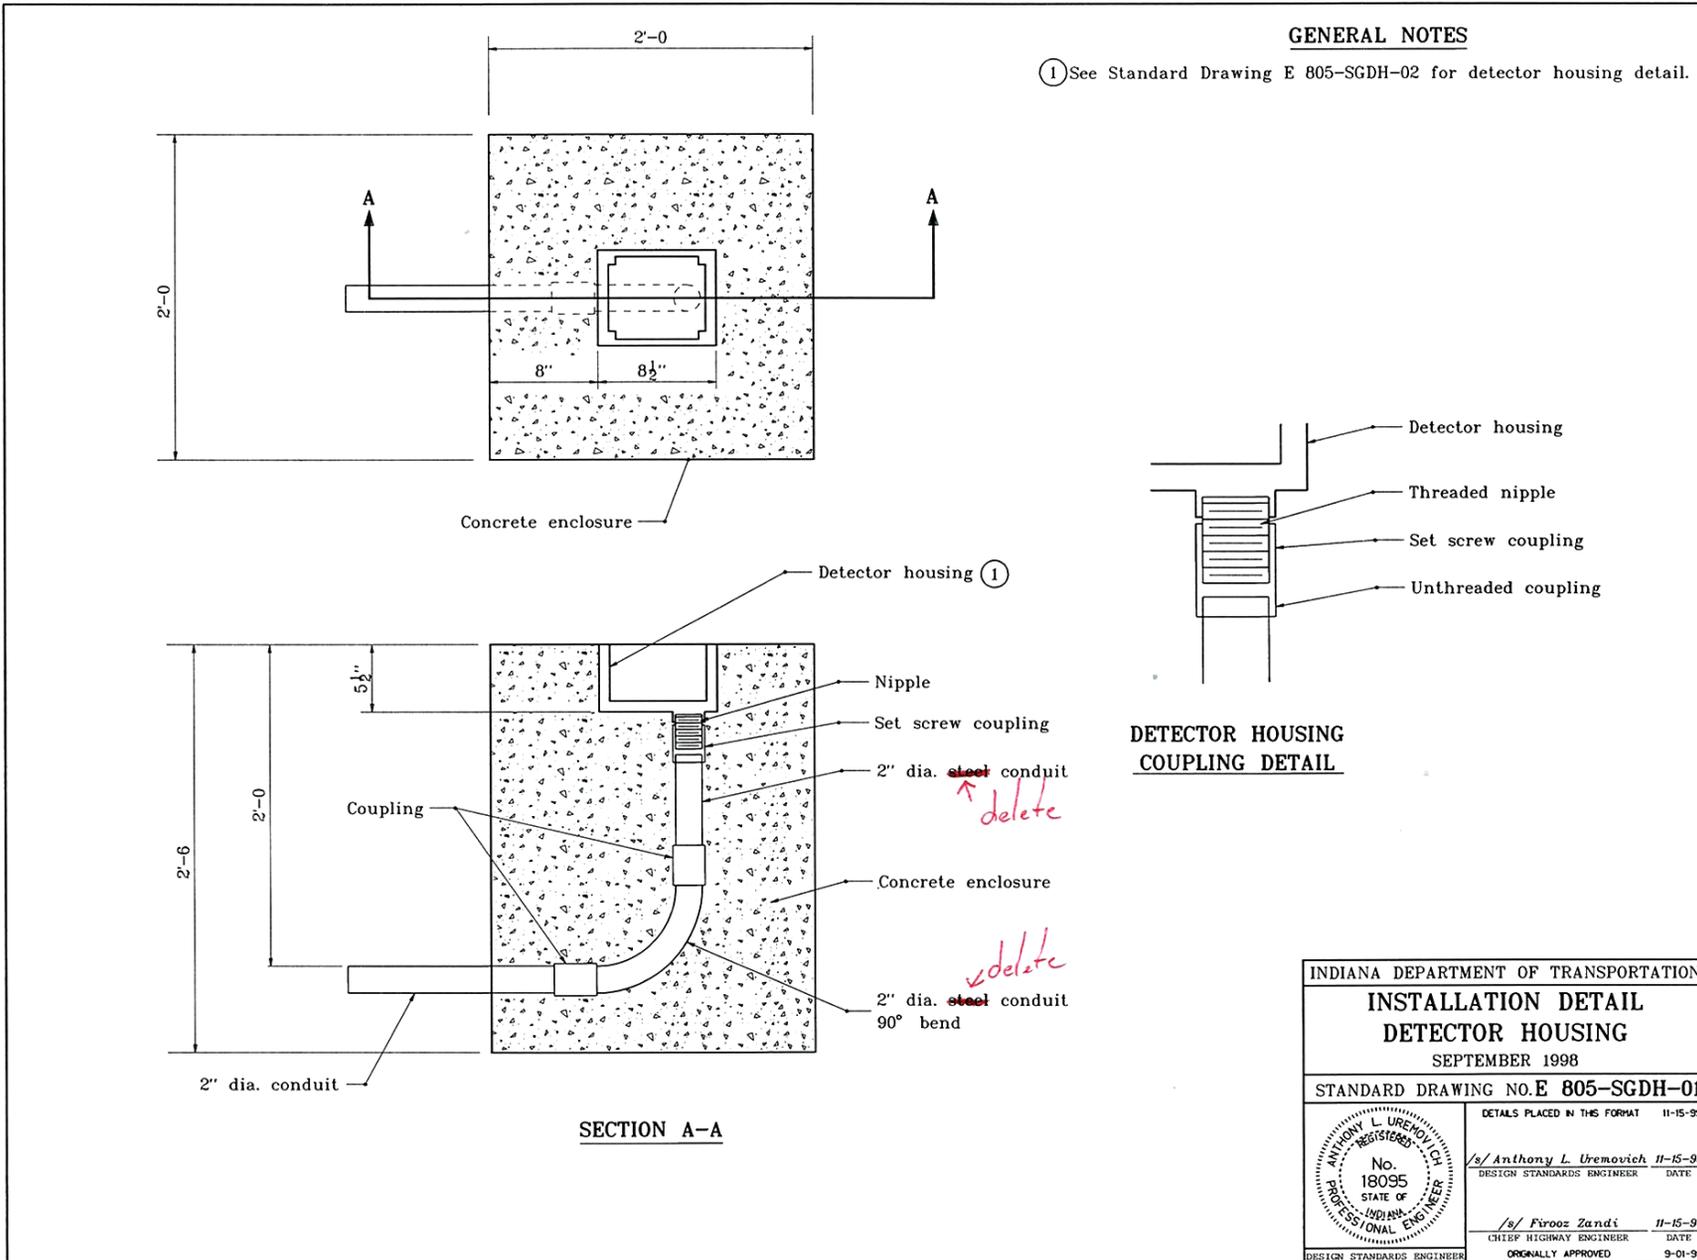

REVISION TO RECURRING SPECIAL PROVISIONS AND STANDARD DRAWINGS

805-SGCF-01 CONTROLLER CABINET FOUNDATION TYPE P-1

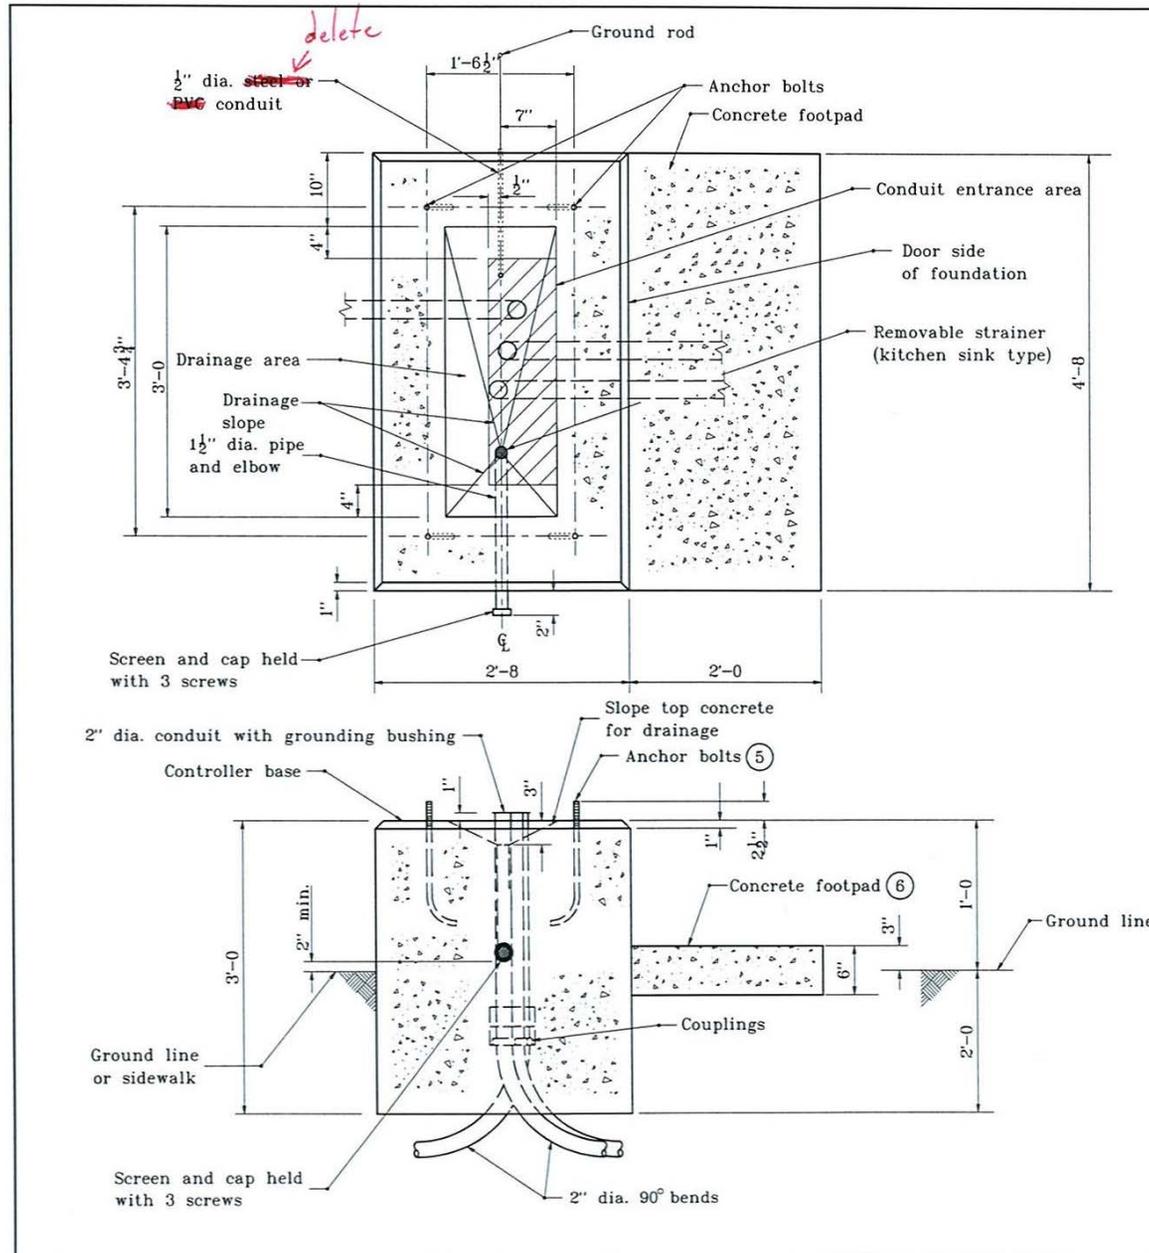


NOTES

See Standard Drawing E 805-SGCF-03 for General Notes.

INDIANA DEPARTMENT OF TRANSPORTATION	
CONTROLLER CABINET FOUNDATION TYPE P-1	
SEPTEMBER 1998	
STANDARD DRAWING NO. E 805-SGCF-01	
DETAILS PLACED IN THIS FORMAT 11-15-99	
	/s/ Anthony L. Uremovich 11-15-99 DESIGN STANDARDS ENGINEER DATE
	/s/ Firooz Zandi 11-15-99 CHIEF HIGHWAY ENGINEER DATE
DESIGN STANDARDS ENGINEER	ORIGINALLY APPROVED 9-01-98

REVISION TO RECURRING SPECIAL PROVISIONS AND STANDARD DRAWINGS


805-SGCF-02 CONTROLLER CABINET FOUNDATION TYPE M

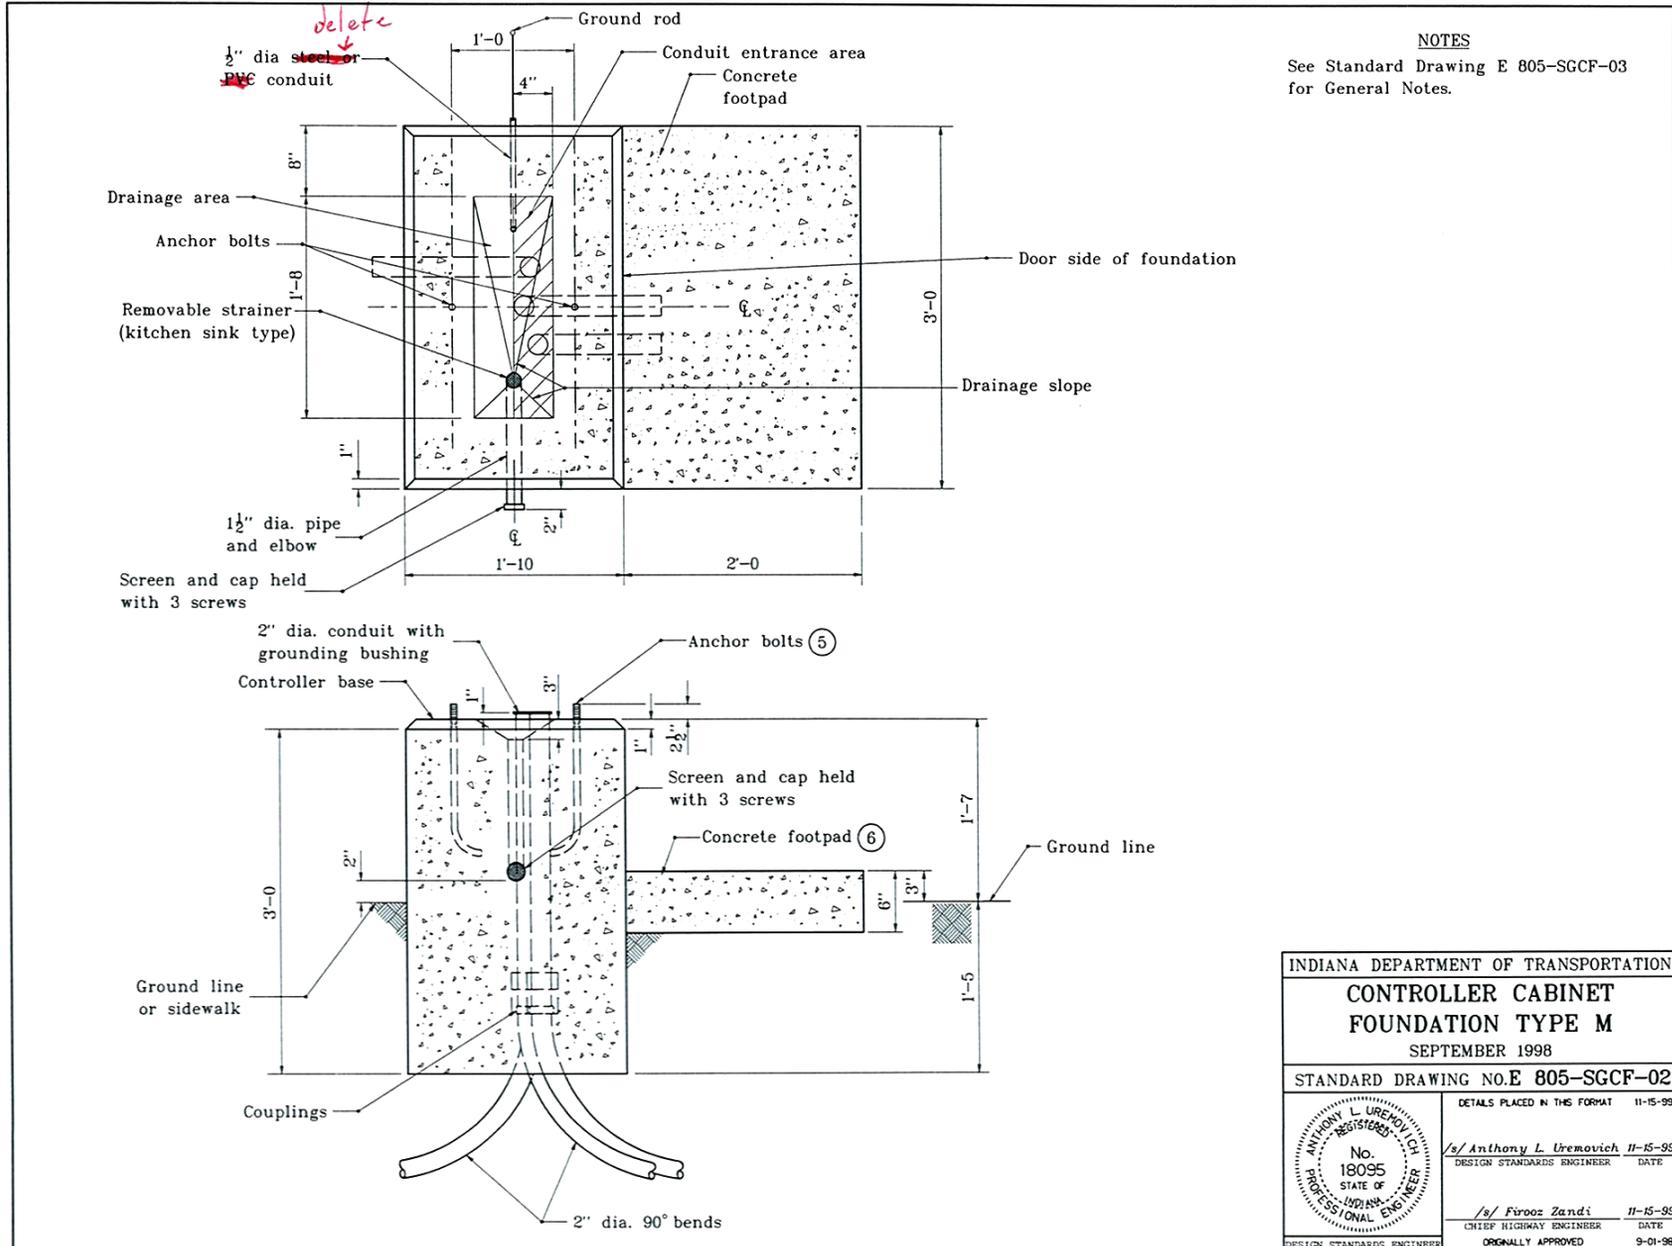


INDIANA DEPARTMENT OF TRANSPORTATION	
CONTROLLER CABINET FOUNDATION TYPE M	
SEPTEMBER 1998	
STANDARD DRAWING NO. E 805-SGCF-02	
	DETAILS PLACED IN THIS FORMAT 11-15-99
	/s/ Anthony L. Uremovich 11-15-99 DESIGN STANDARDS ENGINEER DATE
	/s/ Firooz Zandi 11-15-99 CHIEF HIGHWAY ENGINEER DATE
DESIGN STANDARDS ENGINEER	ORIGINALLY APPROVED 9-01-98

REVISION TO RECURRING SPECIAL PROVISIONS AND STANDARD DRAWINGS


805-SGCF-05 EXISTING M FOUNDATION MODIFIED TO P-1 FOUNDATION

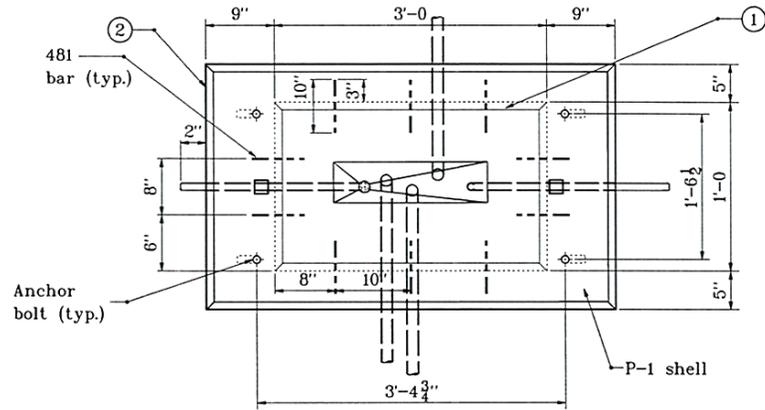

PLAN

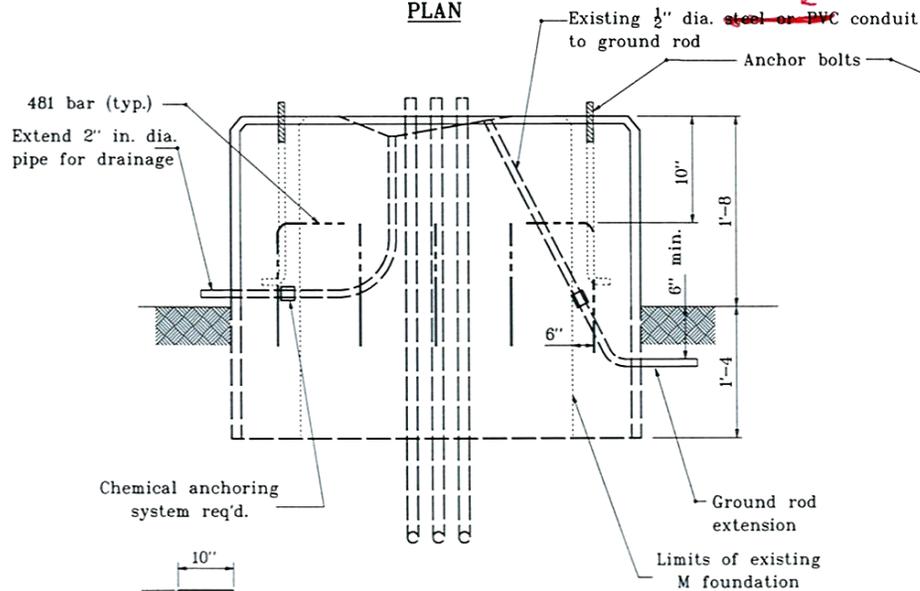

FRONT VIEW

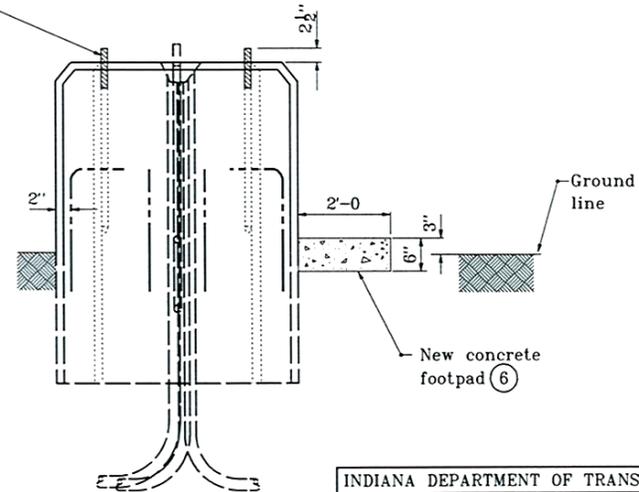

SIDE VIEW

NOTES:


- ① See Standard Drawing E 805-SGCF-02 for M foundation details.
- ② See Standard Drawing E 805-SGCF-01 for P-1 foundation details.
3. Existing anchor bolts shall be cut at or below top of existing foundation.
4. See Standard Drawing E 805-SGCF-03 for General Notes.

1081 x 660

INDIANA DEPARTMENT OF TRANSPORTATION	
EXISTING M FOUNDATION MODIFIED TO P-1 FOUNDATION SEPTEMBER 1998	
STANDARD DRAWING NO. E 805-SGCF-05	
DETAILS PLACED IN THIS FORMAT 11-15-99	
	/s/ Anthony L. Uremovich 11-15-99 DESIGN STANDARDS ENGINEER DATE
	/s/ Firooz Zandi 11-15-99 CHIEF HIGHWAY ENGINEER DATE ORIGINALLY APPROVED 9-01-98




REVISION TO RECURRING SPECIAL PROVISIONS AND STANDARD DRAWINGS

805-SGFB-01 FLASHING BEACON WITH WARNING SIGN

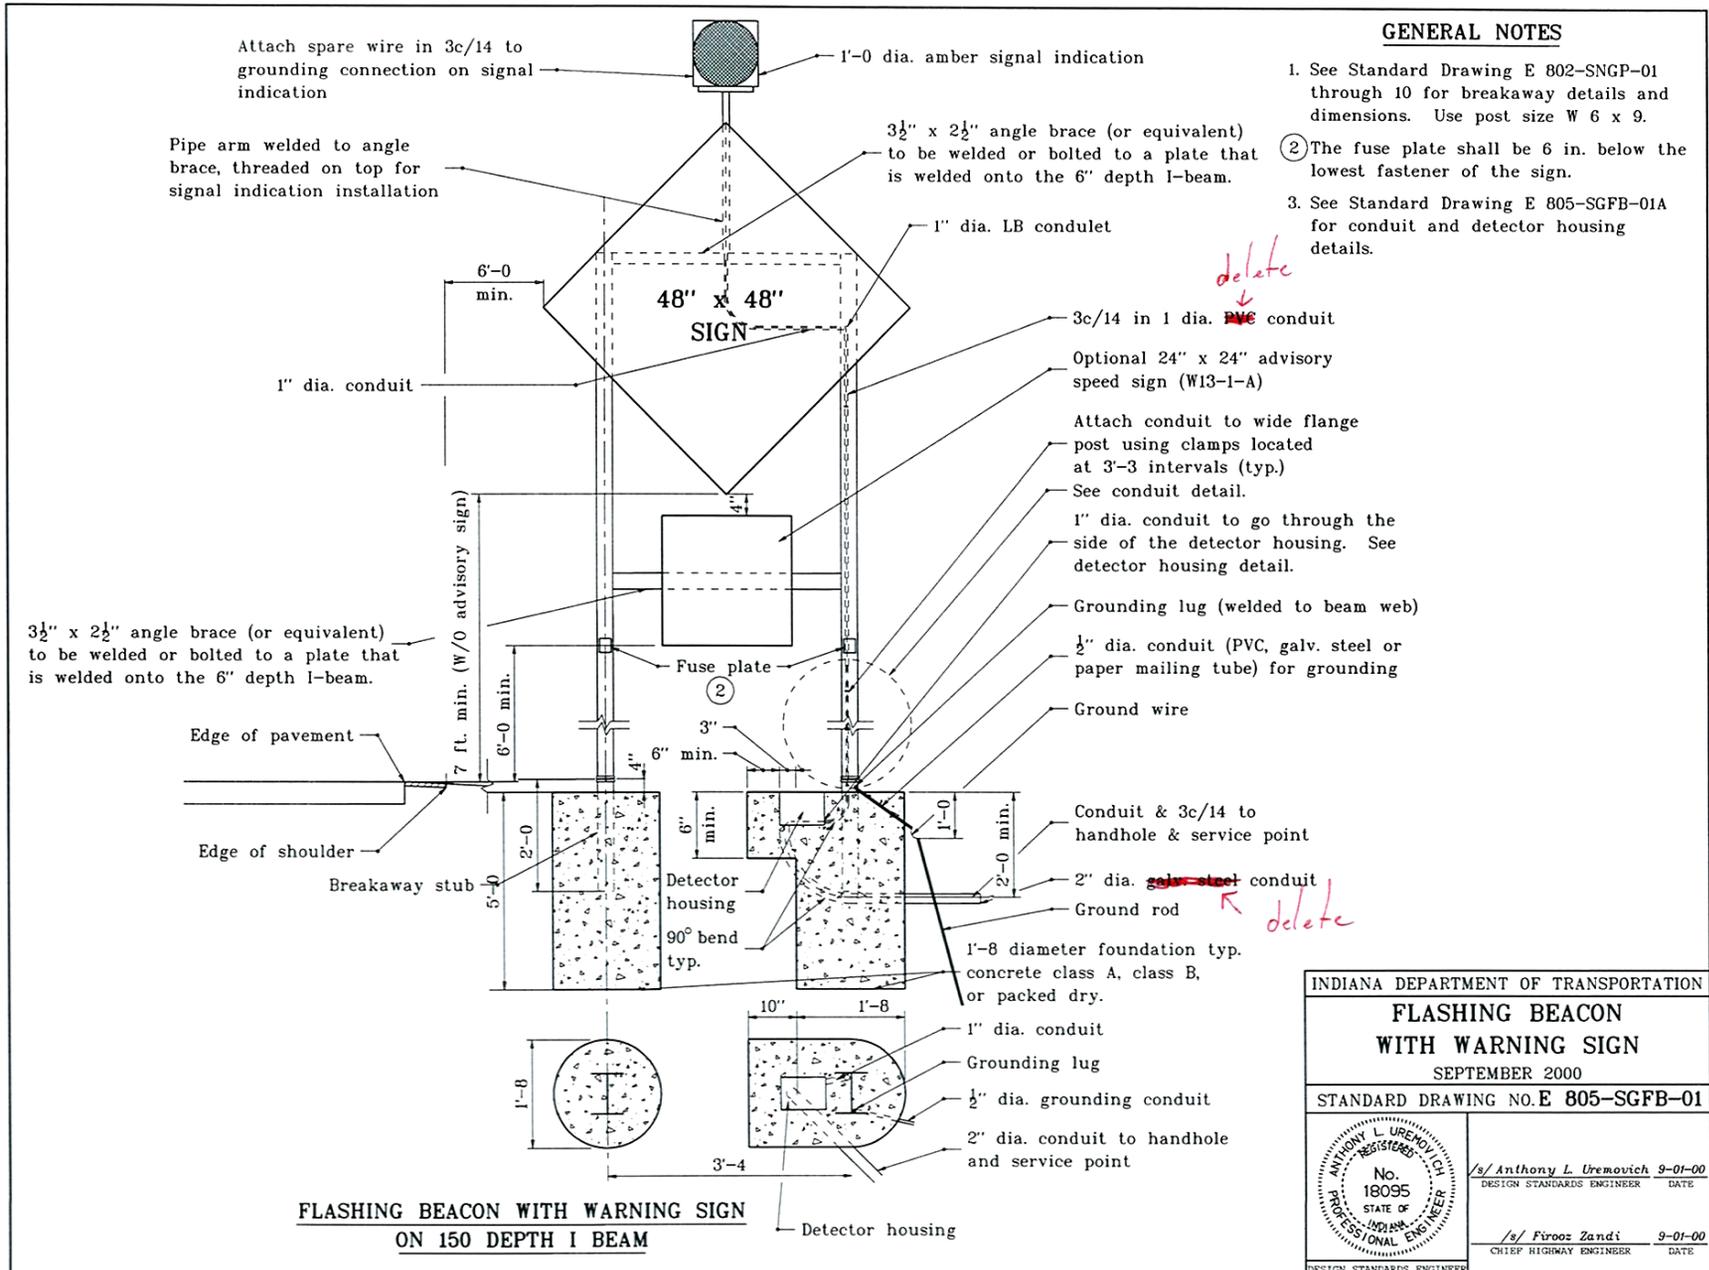

REVISION TO RECURRING SPECIAL PROVISIONS AND STANDARD DRAWINGS


805-SGFB-02 FLASHING BEACON WITH WARNING SIGN DETAILS

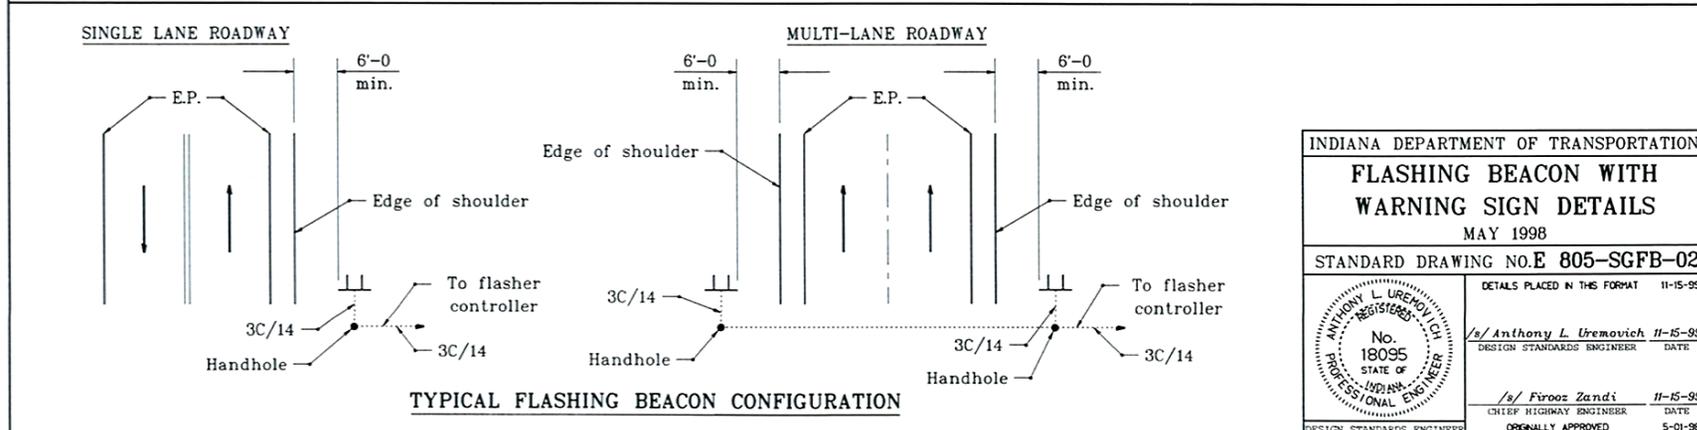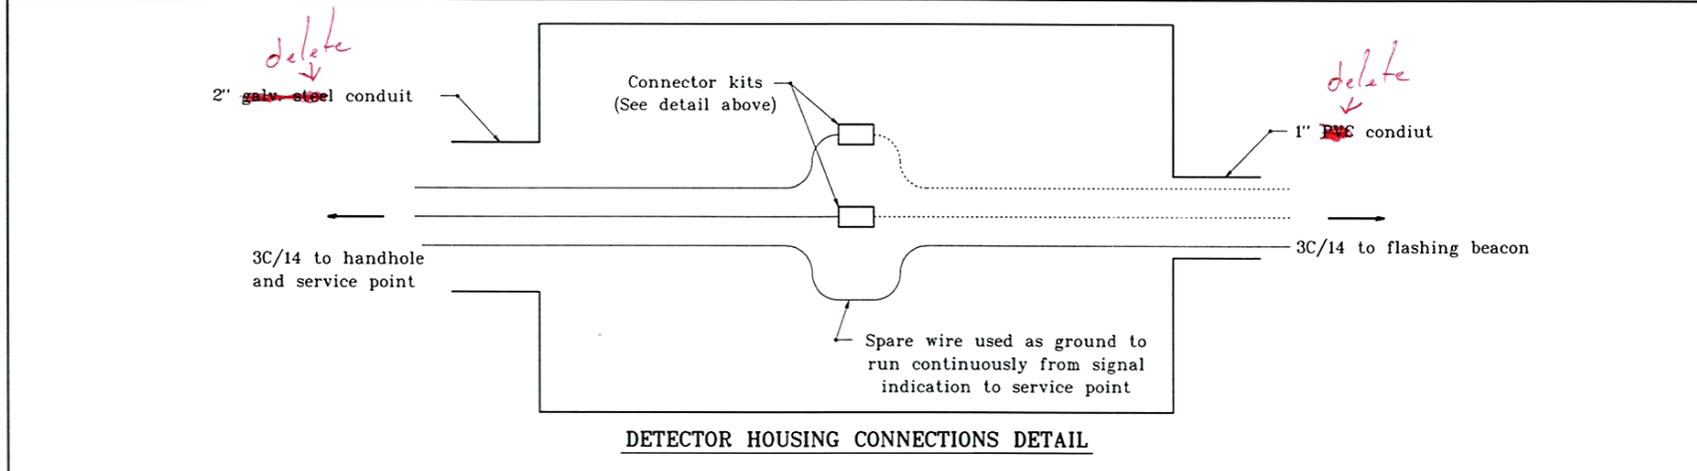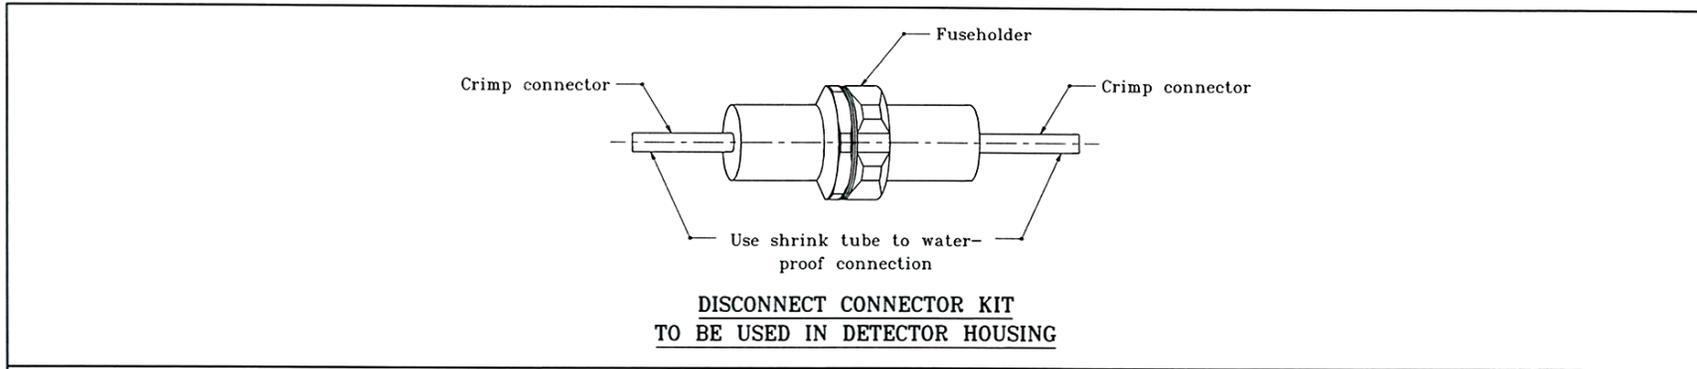

INDIANA DEPARTMENT OF TRANSPORTATION	
FLASHING BEACON WITH WARNING SIGN DETAILS	
MAY 1998	
STANDARD DRAWING NO.E 805-SGFB-02	
	DETAILS PLACED IN THIS FORMAT 11-15-99 /s/ Anthony L. Uremovich 11-15-99 DESIGN STANDARDS ENGINEER DATE
DESIGN STANDARDS ENGINEER	/s/ Firooz Zandi 11-15-99 CHIEF HIGHWAY ENGINEER DATE ORIGINALLY APPROVED 5-01-98

REVISION TO RECURRING SPECIAL PROVISIONS AND STANDARD DRAWINGS

805-SGCF-03 SIGNAL PEDESTAL FOUNDATION TYPE A

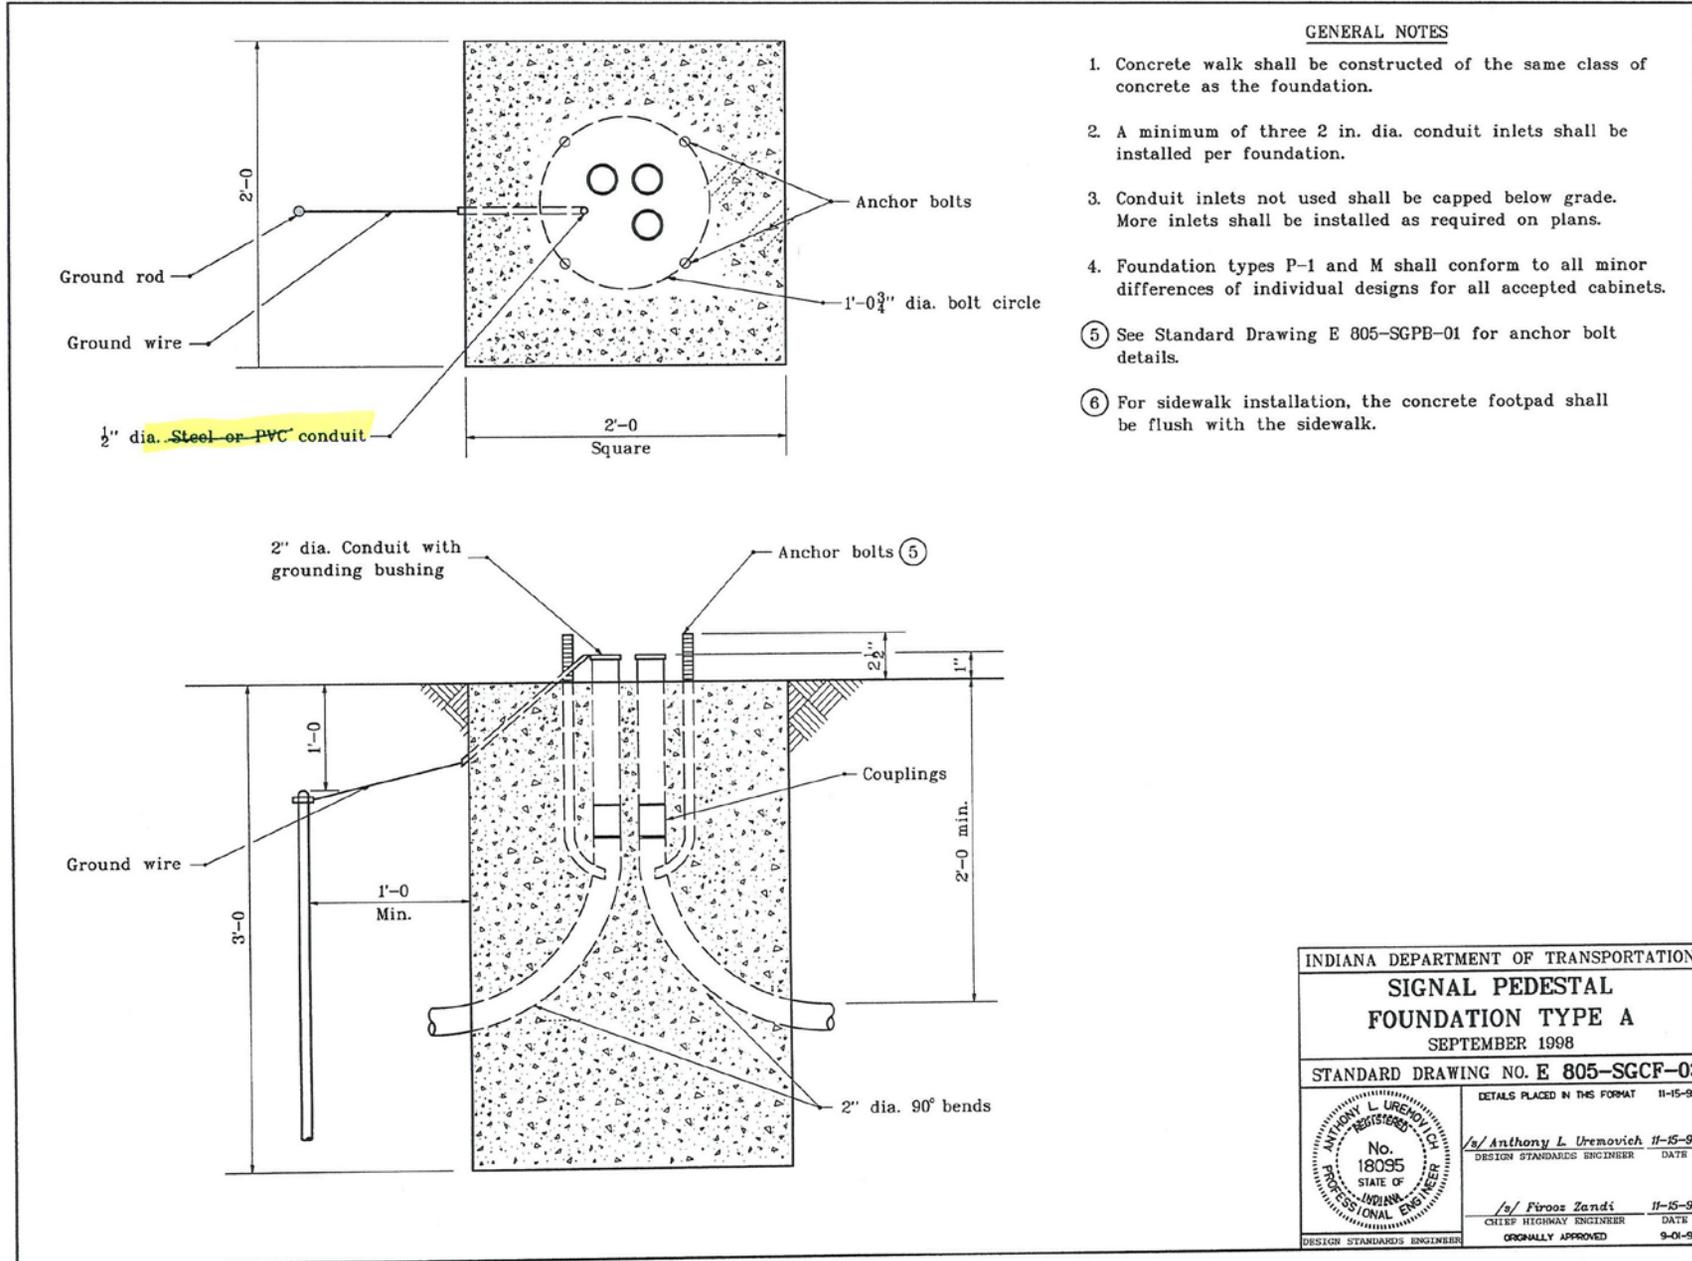


GENERAL NOTES

1. Concrete walk shall be constructed of the same class of concrete as the foundation.
2. A minimum of three 2 in. dia. conduit inlets shall be installed per foundation.
3. Conduit inlets not used shall be capped below grade. More inlets shall be installed as required on plans.
4. Foundation types P-1 and M shall conform to all minor differences of individual designs for all accepted cabinets.
- ⑤ See Standard Drawing E 805-SGPB-01 for anchor bolt details.
- ⑥ For sidewalk installation, the concrete footpad shall be flush with the sidewalk.

INDIANA DEPARTMENT OF TRANSPORTATION	
SIGNAL PEDESTAL FOUNDATION TYPE A SEPTEMBER 1998	
STANDARD DRAWING NO. E 805-SGCF-03	
DETAILS PLACED IN THIS FORMAT 11-15-99	
	/s/ Anthony L. Uremovich 11-15-99 DESIGN STANDARDS ENGINEER DATE
	/s/ Firooz Zandi 11-15-99 CHIEF HIGHWAY ENGINEER DATE ORIGINALLY APPROVED 9-01-98

REVISION TO RECURRING SPECIAL PROVISIONS AND STANDARD DRAWINGS


805-SGCO-01 SIGNAL SERVICE & CONTROLLER MOUNTED ON WOOD POLE

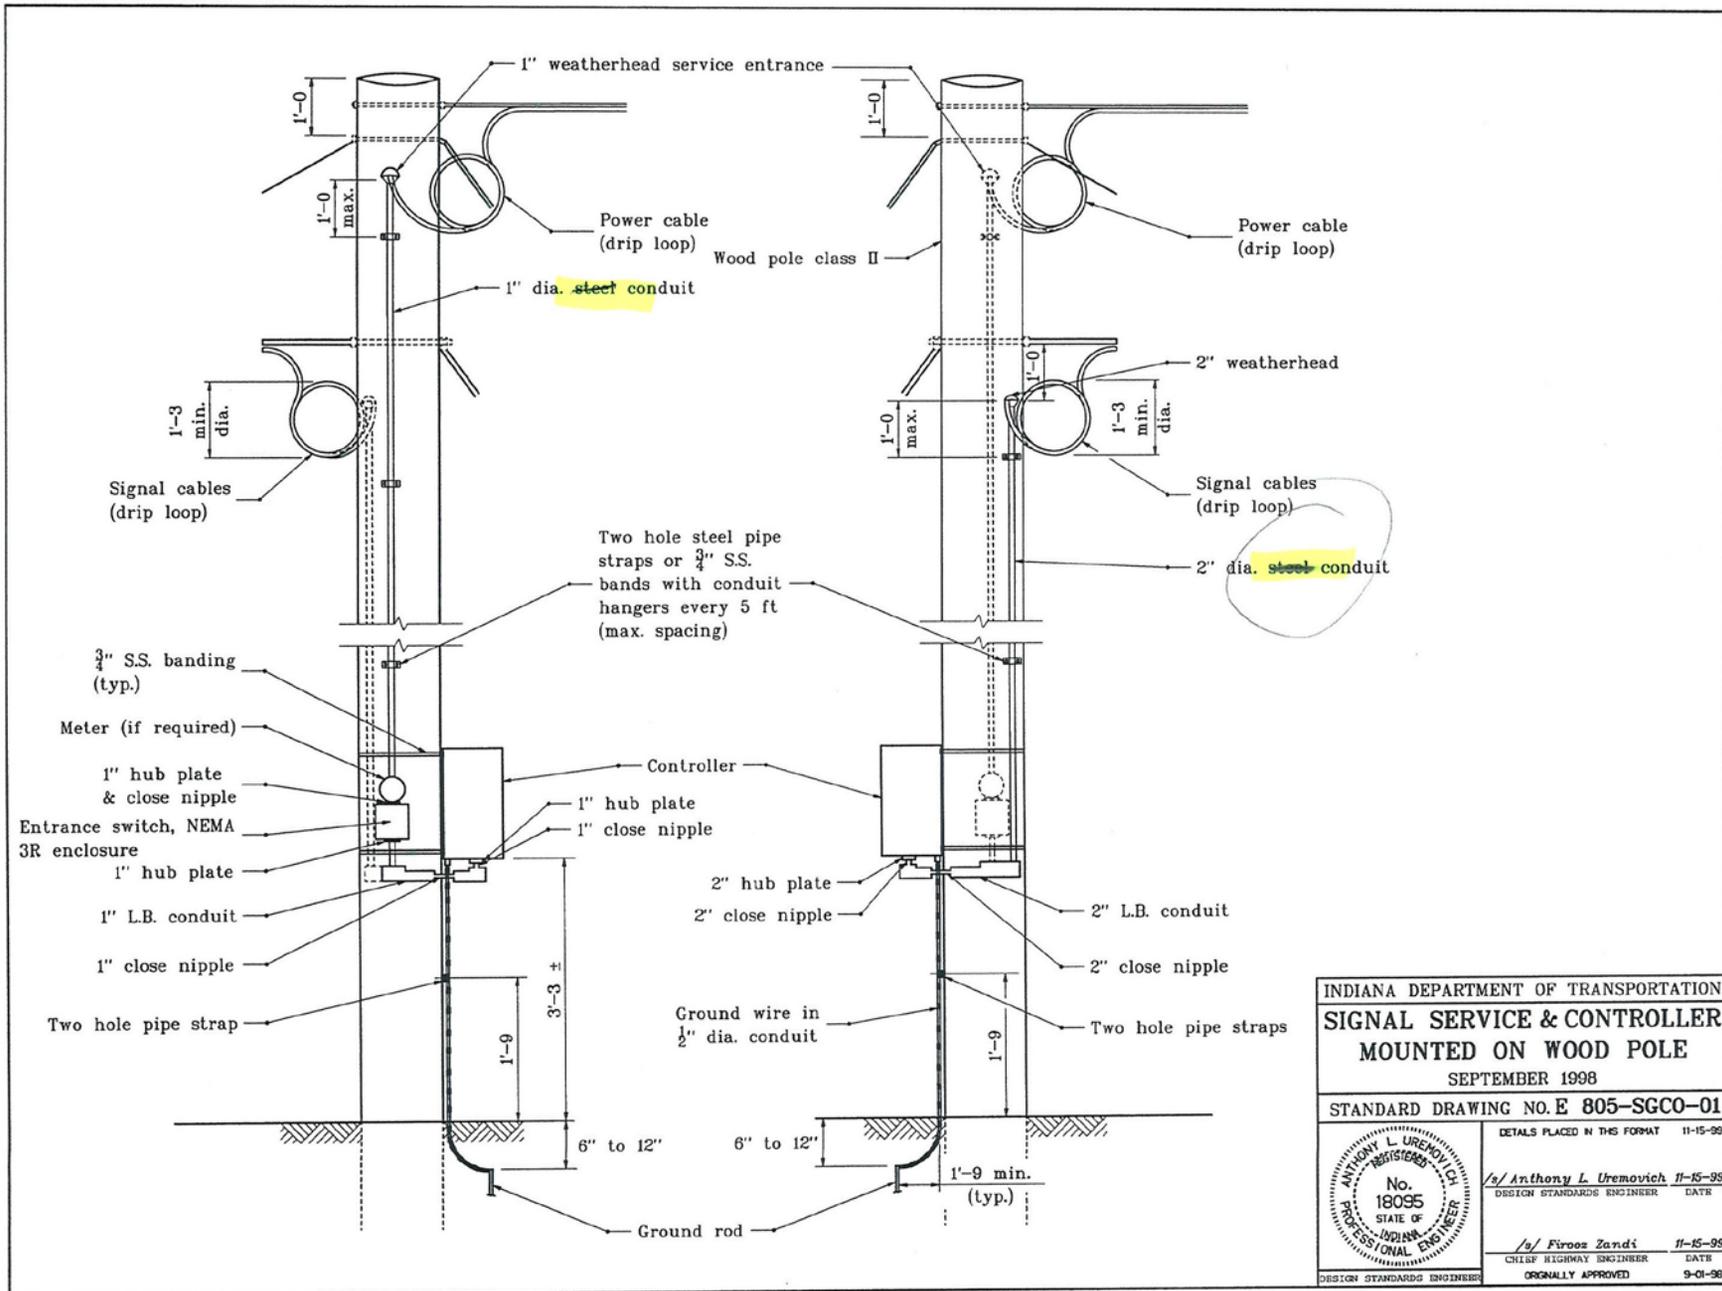

REVISION TO RECURRING SPECIAL PROVISIONS AND STANDARD DRAWINGS

805-SGLI-01 TRAFFIC SIGNAL LOOP INSTALLATION


TYPICAL LOOP DETECTION SAW-CUT PLAN (ONE LANE)

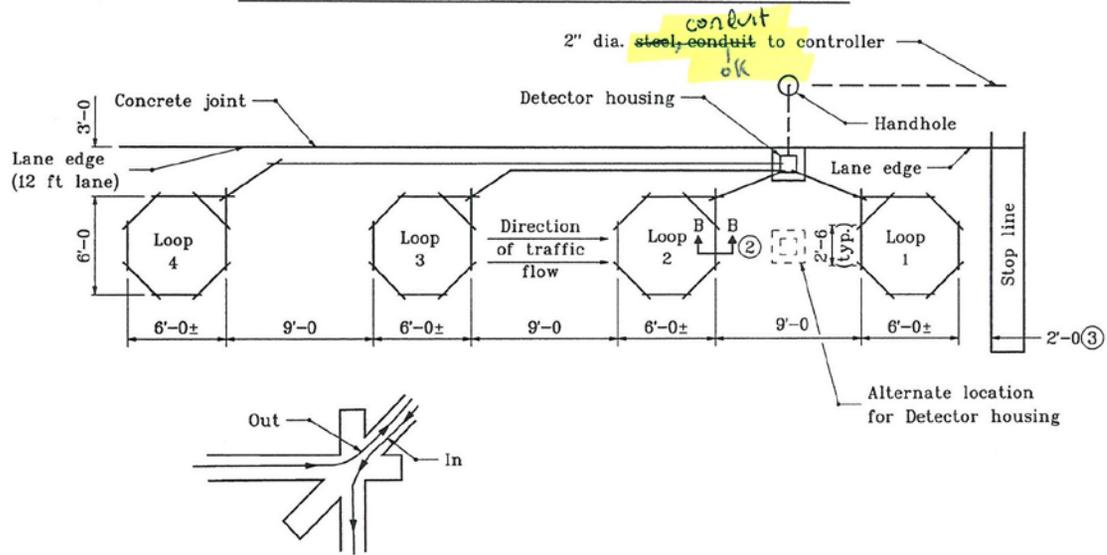

GENERAL NOTES

1. Loop saw-cuts as shown on plan sheets are to be considered as schematic only. In the event of discrepancies, this detail shall govern.
- ② See Standard Drawing E 805-SGLI-02 for Section B-B.
- ③ This distance is typical depending on the intersection geometrics; a loop can be sawed in front of the stop line.

TYPICAL LOOP DETECTION (TWO LANES)

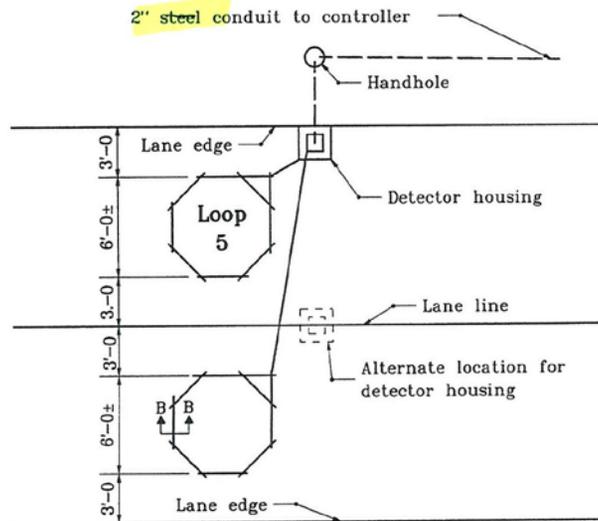

INDIANA DEPARTMENT OF TRANSPORTATION	
TRAFFIC SIGNAL LOOP INSTALLATION	
MAY 1998	
STANDARD DRAWING NO. E 805-SGLI-01	
	DETAILS PLACED IN THIS FORMAT 11-15-99 /s/ Anthony L. Uremovich 11-15-99 DESIGN STANDARDS ENGINEER DATE
	/s/ Firooz Zandi 11-15-99 CHIEF HIGHWAY ENGINEER DATE ORIGINALLY APPROVED 5-01-98

COMMENTS AND ACTION

805-T-169 TRAFFIC SIGNALS
922-T-168 TRAFFIC SIGNAL MATERIALS AND EQUIPMENT
805-SGDH-01 INSTALLATION DETAIL DETECTOR HOUSING
805-SGCF-01 CONTROLLER CABINET FOUNDATION TYPE P-1
805-SGCF-02 CONTROLLER CABINET FOUNDATION TYPE M
805-SGCF-05 EXISTING M FOUNDATION MODIFIED TO P-1 FOUNDATION
805-SGFB-01 FLASHING BEACON WITH WARNING SIGN
805-SGFB-02 FLASHING BEACON WITH WARNING SIGN DETAILS
805-SGCF-03 SIGNAL PEDESTAL FOUNDATION TYPE A
805-SGCO-01 SIGNAL SERVICE & CONTROLLER MOUNTED ON WOOD POLE
805-SGLI-01 TRAFFIC SIGNAL LOOP INSTALLATION

DISCUSSIONS: This item was introduced and presented by Mr. Boruff who explained that they are adding information for fiberglass conduit.

Mr. Uremovich inquired as to the intent of the pay item for the conduit. Mr. Bruno explained that some conduit, the short lengths, would be included in the pay item for the cabinets, but longer runs of conduit would be paid for separately. Further clarification was provided by Mr. Keefer, and Mr. Uremovich concurred that the language is fine the way it is.

Mr. Uremovich pointed out that 922.19, paragraphs (b) and (c) could be combined into one paragraph, so it doesn't have to be repetitive. Also recommended is to add the degrees C values to paragraph (c)Fiberglass Conduit. These editorial changes are shown in these meeting minutes.

Mr. Boruff suggested to also revise standard drawings 805-SGCF-03, 805-SGCO-01 and 805-SGLI-01. The material references for the conduit will be taken out, to remain consistent with the proposed revisions to the standard drawings presented in the meeting agenda, and as shown attached to these meeting minutes.

Mr. Uremovich suggested that there be something in the Design Manual telling the designer to pick and choose the type of conduit to be used, rather than allowing the Contractor to choose. There was also discussion on how to locate the lines if there is no steel in the conduit. A tracer wire was suggested. Mr. Pankow reiterated that the designer will determine the type of conduit to be used. Mr. Bruno concurred.

There was also further discussion between Mr. Keefer and Mr. Bruno concerning the use of steel verses the use of PVC, and the benefits of using either one.

Mr. Pankow suggested that either one should be selected and not mixed in the same contract, otherwise the locations for each type would need to be shown on the plans. Proper implementation also needs to be shown on the plans.

Mr. Boruff revised his motion.

COMMENTS AND ACTION

805-T-169 TRAFFIC SIGNALS
 922-T-168 TRAFFIC SIGNAL MATERIALS AND EQUIPMENT
 805-SGDH-01 INSTALLATION DETAIL DETECTOR HOUSING
 805-SGCF-01 CONTROLLER CABINET FOUNDATION TYPE P-1
 805-SGCF-02 CONTROLLER CABINET FOUNDATION TYPE M
 805-SGCF-05 EXISTING M FOUNDATION MODIFIED TO P-1 FOUNDATION
 805-SGFB-01 FLASHING BEACON WITH WARNING SIGN
 805-SGFB-02 FLASHING BEACON WITH WARNING SIGN DETAILS
 805-SGCF-03 SIGNAL PEDESTAL FOUNDATION TYPE A
 805-SGCO-01 SIGNAL SERVICE & CONTROLLER MOUNTED ON WOOD POLE
 805-SGLI-01 TRAFFIC SIGNAL LOOP INSTALLATION

(CONTINUED)

<p>Motion: Mr. Boruff Second: Mr. Andrews Ayes: 7 Nays: 0</p>	<p>Action: <input type="checkbox"/> Passed as Submitted <input checked="" type="checkbox"/> Passed as Revised <input type="checkbox"/> Withdrawn</p>
<p>Standard Specifications Sections affected: 805; 922</p>	<p><input type="checkbox"/> 20 Standard Specifications Book <input type="checkbox"/> Revise Pay Items List</p>
<p>Recurring Special Provision affected: 805-T-169 TRAFFIC SIGNALS 922-T-168 TRAFFIC SIGNAL MATERIALS AND EQUIPMENT</p>	<p><input type="checkbox"/> Create RSP (No.____) Effective ____ Letting RSP Sunset Date: ____</p>
<p>Standard Sheets affected: 805-SGDH-01, 805-SGCF-01, 805-SGCF-02, 805-SGCF-05, 805-SGFB-01, 805-SGFB-02</p>	<p><input checked="" type="checkbox"/> Revise RSP (No.805-T-169 and 922-T-168) Effective <u>January 01, 2012</u> Letting RSP Sunset Date: <u>TBD</u></p>
<p>Design Manual Sections affected: 77-5.05 (502)</p>	<p>Standard Drawing Effective <u>Sept. 01, 2012</u> <input checked="" type="checkbox"/> Create RPD (No. <u>XXX-T-XXX</u>) Effective <u>January 01, 2012</u> Letting <input checked="" type="checkbox"/> Technical Advisory</p>
<p>GIFE Sections cross-references: NONE</p>	<p>GIFE Update Req'd.? Y <input type="checkbox"/> N <input type="checkbox"/> By ____ Addition or ____ Revision</p>
	<p>Frequency Manual Update Req'd? Y <input type="checkbox"/> N <input type="checkbox"/> By ____ Addition or ____ Revision</p>
	<p>Received FHWA Approval? <u>Yes</u></p>

SPECIFICATION REVISIONS
REVISION TO RECURRING SPECIAL PROVISION

PROPOSAL TO STANDARDS COMMITTEE

PROBLEM(S) ENCOUNTERED: The following Aggregate item requires revision to section 904-R-560:

1. Classification of Aggregates (904.03(a)) -- Clarification is needed for the Micro-Deval Abrasion and Aggregate Degradation test requirements for Class AS aggregates used in SMA mixtures. The Micro-Deval test is required for each coarse aggregate used in the SMA mixture and if a blend of coarse aggregates is used then the blend is required to meet a maximum of 18.0% as determined by ITM 220. When there is a blend of coarse aggregates, each individual coarse aggregate is not required to have a Micro-Deval value less than 18.0%. A similar requirement also applies for the Aggregate Degradation value for Class AS coarse aggregates used in SMA mixtures.

PROPOSED SOLUTION: The following revision is recommended to be authorized .

1.Revise the table and Notes 9 and 10 in 904.03(a) to designate that the Micro-Deval requirement of a maximum of 18.0% and Aggregate Degradation requirement of a maximum of 3.0% is intended for the blend of coarse aggregates when more than one coarse aggregate is used for SMA mixtures. These requirements also apply to the AS aggregate if only one coarse aggregate is used in the SMA mixture.

APPLICABLE STANDARD SPECIFICATIONS: 904.03

APPLICABLE STANDARD DRAWINGS: None

APPLICABLE DESIGN MANUAL SECTION: None

APPLICABLE SECTION OF GIFE:None

APPLICABLE RECURRING SPECIAL PROVISIONS:904-R-560

Submitted By: Ron Walker

Title: Manager, Office of Materials Management

Organization: INDOT

Phone Number: 317-610-7251 x 204

Date: 4-29-11

APPLICABLE SUB-COMMITTEE ENDORSEMENT? This specification revision is recommended by the INDOT/IMAA Technical Committee.

REVISION TO RECURRING SPECIAL PROVISION
 904-R-560 SMA COARSE AGGREGATE REQUIREMENTS

(Proposed changes shown as highlighted in gray.)
 Basis for Use: Pay items: 401-09086, -09530 or -09877 SMA)

904-R-560 SMA COARSE AGGREGATE REQUIREMENTS

The Standard Specifications are revised as follows:

SECTION 904, BEGIN LINE 210, INSERT AS FOLLOWS:

a) Classification of Aggregates

Characteristic Classes	AP	AS	A	B	C	D	E	F
Quality Requirements								
Freeze and Thaw Beam Expansion, % Max. (Note 1).....	.060							
Los Angeles Abrasion, %, Max. (Note 2).....	40.0	30.0	40.0	40.0	45.0	45.0	50.0	
Freeze and Thaw, AASHTO T 103, Procedure A, % Max (Note 3)	12.0	12.0	12.0	12.0	16.0	16.0	20.0	25.0
Sodium Sulfate Soundness, %, Max. (Note 3)	12.0	12.0	12.0	12.0	16.0	16.0	20.0	25.0
Brine Freeze and Thaw Soundness, %, Max. (Note 3).....	30	30	30	30	40	40	50	60
Absorption, % Max. (Note 4)	5.0	5.0	5.0	5.0	5.0			
Additional Requirements								
Deleterious, %, Max.								
Clay Lumps and Friable Particles	1.0	1.0	1.0	1.0	2.0	4.0		
Non-Durable (Note 5)	4.0	2.0 4.0	4.0	4.0	6.0	8.0		
Coke					(See Note 6)	(See Note 6)		
Iron					(See Note 6)	(See Note 6)		
Chert (Note 7)	3.0	3.0	3.0	5.0	8.0	10.0		
Weight per Cubic Foot for Slag, (lbs), Min. (Mass per Cubic Meter for Slag, (kg))	75.0 (1200)		75.0 (1200)	75.0 (1200)	70.0 (1120)	70.0 (1120)	70.0 (1120)	
Crushed Particles, % Min. (Note 8)								
Asphalt Seal Coats			70.0	70.0				
Compacted Aggregates			20.0	20.0	20.0	20.0		
Additional SMA Mixture Requirements								
Micro-Deval Abrasion, %, Max. (Note 9).....		18.0 (Note 9)						
Aggregate Degradation, %, Max. (Note 10)....		3.0 (Note 10)						

- Notes:
- Freeze and thaw beam expansion shall be tested and re-tested in accordance with ITM 210.
 - Los Angeles abrasion requirements shall not apply to BF.
 - Aggregates may, at the option of the Engineer, be accepted by the Sodium Sulfate Soundness or Brine Freeze and Thaw Soundness requirements.
 - Absorption requirements apply only to aggregates used in PCC and HMA mixtures except they shall not apply to BF. When crushed stone coarse aggregates from Category I sources consist of production from ledges whose absorptions differ by more than two percentage points, the absorption test will be performed every 3 months on each size of material proposed for use in PCC or HMA mixtures. Materials having absorption values between 5.0 and 6.0 that pass AP testing may be used in PCC. If variations in absorption preclude satisfactory production of PCC or HMA mixtures, independent stockpiles of materials will be sampled, tested, and approved prior to use.
 - Non-durable particles include soft particles as determined by ITM 206 and other particles which are structurally weak, such as soft sandstone, shale, limonite concretions, coal, weathered schist, cemented gravel, ocher, shells, wood, or other objectionable material. Determination of non-durable particles shall be made from the total weight (mass) of material retained on the 3/8 in. (9.5 mm) sieve. Scratch Hardness Test shall not apply to crushed stone coarse aggregate.
 - ACBF and SF coarse aggregate shall be free of objectionable amounts of coke, iron, and lime agglomerates.
 - The bulk specific gravity of chert shall be based on the saturated surface dry condition. The amount of chert less than 2.45 bulk specific gravity shall be determined on the total weight (mass) of material retained on the 3/8 in. (9.5 mm) sieve for sizes 2 through 8, 43, 53, and 73 and on the total weight (mass) of material retained on the No. 4 (4.75 mm) sieve for sizes 9, 11, 12, and 91.

REVISION TO RECURRING SPECIAL PROVISION
 904-R-560 SMA COARSE AGGREGATE REQUIREMENTS

8. Crushed particle requirements apply to gravel coarse aggregates used in compacted aggregates, and seal coats except seal coats used on shoulders. Determination of crushed particles shall be made from the weight (mass) of material retained on the No. 4 (4.75 mm) sieve in accordance with ASTM D 5821.
9. ~~Micro-Deval Abrasion requirements shall apply to testing will be required for each coarse aggregate. A coarse aggregate or a blend of coarse aggregates shall have a maximum Micro-Deval Abrasion loss value of 18.0% as determined in accordance with ITM 220.~~
10. ~~A coarse aggregate or a blend of coarse aggregates shall have a maximum Aggregate Degradation shall be loss value of 3.0% as determined in accordance with ITM 220.~~

SECTION 904, BEGIN LINE 246, DELETE AND INSERT AS FOLLOWS:

2. SMA Coarse Aggregate

Coarse Aggregate Type	Traffic ESALs		
	< 3,000,000	< 10,000,000	≥ 10,000,000
Air-Cooled Blast Furnace Slag	No	No	No
Steel Furnace Slag	Yes Note 1	Yes Note 1	Yes
Sandstone	Yes Note 1	Yes Note 1	Yes
Crushed Dolomite	No Note 1	No Note 1	No Note 2
Polish Resistant Aggregates	No Note 1	No Note 1	No Note 2
Crushed Stone	No	No	No
Gravel	No	No	No

Notes: 1. Steel furnace slag, sandstone, crushed dolomite, polish resistant aggregates or any blend of these aggregates may be used provided the aggregates are in accordance with 904.03(a).
 2. Polish resistant aggregates or crushed dolomite may be used when blended with sandstone but shall not exceed 50% of the coarse aggregate by weight (mass), or shall not exceed 40% of the coarse aggregate by weight (mass) when blended with steel furnace slag. The aggregates shall be in accordance with 904.03(a).

SECTION 904, BEGIN LINE 253, INSERT AS FOLLOWS:

(f) Sampling and Testing

Sampling and testing will be in accordance with the following AASHTO, ASTM, and ITMs.

- Los Angeles Abrasion..... AASHTO T 96
- *Amount of Material finer than No. 200 (75 µm) Sieve AASHTO T 11
- Brine Freeze and Thaw Soundness. ITM 209
- Clay Lumps and Friable Particles. AASHTO T 112
- Control Procedures for Classification of Aggregates..... ITM 203
- Crushed Particles.....ASTM D 5821
- Dolomite Aggregates. ITM 205
- Flat and Elongated Particles.....ASTM D 4791
- Freeze and Thaw Beam Expansion..... ITM 210
- *Lightweight Pieces in Aggregates..... AASHTO T 113
- Micro-Deval Abrasion. AASHTO T 327
- Polished Resistant Aggregates ITM 214
- *Sampling Aggregates AASHTO T 2
- Sampling Stockpiled Aggregates ITM 207

REVISION TO RECURRING SPECIAL PROVISION

904-R-560 SMA COARSE AGGREGATE REQUIREMENTS

Scratch Hardness	ITM 206
*Sieve Analysis	AASHTO T 27
*Soundness	AASHTO T 103, T 104
*Specific Gravity and Absorption	AASHTO T 85
Unit Weight and Voids in Aggregates	AASHTO T 19

*Except as noted in 904.06

APPROVED MINUTES

COMMENTS AND ACTION

904-R-560 SMA COARSE AGGREGATE REQUIREMENTS

DISCUSSIONS: This item was introduced and presented by Mr. Walker who explained this is to clarify the information in the tables shown, concerning course aggregates and aggregate blends in SMA mixes. Mr. Walker stated that this proposal clarifies what the requirements state and does not actually change anything.

There was no further discussion, comments or questions.

<p>Motion: Mr. Walker Second: Mr. Keefer Ayes: 7 Nays: 0</p>	<p>Action: <input checked="" type="checkbox"/> Passed as Submitted <input type="checkbox"/> Passed as Revised <input type="checkbox"/> Withdrawn</p>
<p>Standard Specifications Sections affected: 904.03 (2010 SS) pg 773.</p> <p>Recurring Special Provision affected: 904-R-560 SMA COARSE AGGREGATE REQUIREMENTS <i>(Note: Incorporated into 2012 SS)</i></p> <p>Standard Sheets affected: NONE</p> <p>Design Manual Sections affected: NONE</p> <p>GIFE Sections cross-references: NONE</p>	<p><input type="checkbox"/> 20__ Standard Specifications Book Revise Pay Items List</p> <p><input type="checkbox"/> Create RSP (No.____) Effective ____Letting RSP Sunset Date: ____</p> <p><input checked="" type="checkbox"/> Revise RSP (No.904-R-560 2011 Edition) Effective <u>September 01, 2011</u> Letting RSP Sunset Date: <u>TBD</u></p> <p>Standard Drawing Effective ____ <input type="checkbox"/> Create RPD (No. ____) Effective ____Letting <input type="checkbox"/> Technical Advisory</p> <p>GIFE Update Req'd.? Y __ N __ By ____ Addition or ____ Revision</p> <p>Frequency Manual Update Req'd? Y __ N __ By ____ Addition or ____ Revision</p> <p>Received FHWA Approval? <u>Yes</u></p>

SPECIFICATION REVISIONS
REVISION TO STANDARD SPECIFICATIONS

PROPOSAL TO STANDARDS COMMITTEE

PROBLEM(S) ENCOUNTERED: The following HMA items require revisions to sections 401, 402, 409, and 410:

1. Volumetric Mix design (401.05) -- Recent projects using 60% fine aggregate and 40% blended coarse aggregate meeting the requirements of 904.03(d)1 and 401.05 resulted in low friction numbers after approximately one year of service. Subsequent lab and field studies determined that the poor pavement surface macrotexture caused by a mixture that was too fine-graded was the probable cause and that 9.5mm category 4 and 5 HMA surface mixtures should require more coarse aggregate. A revision was made to require the amount passing the No. 8 sieve to be less than the PCS Control Point. Similar problems have been observed for 9.5mm category 3 mixtures and this restriction should also be applied to the category 3, 9.5mm mixtures.
2. Volumetric mix Design (401.05) -- A new DMF should not be required for a binder grade change since a new mix design is not required when this change is made.
3. Recycled Materials (401.06, 402.08, 410.06) A study of the impact on friction resistance of 15.0% binder replacement in high traffic volume HMA surface mixtures placed in 2009 was done and results indicated no detrimental effect to skid resistance. The RAP in these mixtures is required to be 100% passing the 3/8 in. sieve and 95-100% passing the No. 4 sieve. An increase to 25.0% binder replacement for category 3,4, and 5 HMA surface mixtures should be made because there would be a small risk in reduction of friction resistance with this increase of binder replacement.
4. Design mix formula (402.04) Limitations on the lay rates for 4.75mm and 12.5mm HMA surface mixtures should be designated because of the difficulty in placement and compaction of these mixtures with the designated equipment and procedures of 402.
5. Compaction (402.15, 409.03(d)) A definition of an oscillatory roller is needed. This is a roller that does not fit the definition of a vibratory roller because of the capability to impact horizontal and vertical impact forces with one or both drums of the roller. A vibratory roller or one drum of the oscillatory roller that impacts a vertical impact force may be restricted for use if directed by the Engineer.

PROPOSED SOLUTION: The following revisions are recommended to be authorized .

1. Add the PCS gradation requirements to 9.5mm category 3 mixtures
2. Remove the requirement of a new DMF when there is a change in the binder grade

SPECIFICATION REVISIONS

REVISION TO STANDARD SPECIFICATIONS

3. Increase the allowable amount of binder replacement in dense graded category 3,4, and 5 surface mixtures
4. Require that 4.75 mm surface mixtures in accordance with 402 not be used when the plan lay rate is greater than 100 #/syd and 12.5mm surface mixtures in accordance with 402 not be used when the plan lay rate is less than 195#/syd.
5. Add a definition for oscillatory rollers.

APPLICABLE STANDARD SPECIFICATIONS: 401.05, 401.06, 402.04, 402.08, 402.15, 409.03, 410.06

APPLICABLE STANDARD DRAWINGS: None

APPLICABLE DESIGN MANUAL SECTION:

APPLICABLE SECTION OF GIFE: Section 13

APPLICABLE RECURRING SPECIAL PROVISIONS:

Submitted By: Ron Walker

Title: Manager, Office of Materials Management

Organization: INDOT

Phone Number: 317-610-7251 x 204

Date: 4-29-11

APPLICABLE SUB-COMMITTEE ENDORSEMENT? These specification revisions are recommended by the INDOT/APAI Technical Committee.

REVISION TO STANDARD SPECIFICATIONS

SECTION 401 - QUALITY CONTROL/QUALITY ASSURANCE, QC/QA, HOT MIX ASPHALT, HMA PAVEMENT

401.05 VOLUMETRIC MIX DESIGN

401.06 RECYCLED MATERIALS

(Changes that are shown in italics have been approved on previous meetings.
 New proposed changes shown as highlighted in gray.)

The Standard Specifications are revised as follows:

SECTION 401, BEGIN LINE 62, INSERT AS FOLLOWS:

The single percentage of aggregate passing each required sieve shall be within the limits of the following gradation tables:

Dense Graded, Mixture Designation – Control Point (Percent Passing)					
	25.0 mm	19.0 mm	12.5 mm	9.5 mm	4.75 mm
Sieve Size					
50.0 mm					
37.5 mm	100.0				
25.0 mm	90.0 - 100.0	100.0			
19.0 mm	< 90.0	90.0 - 100.0	100.0		
12.5 mm		< 90.0	90.0 - 100.0	100.0	100.0
9.5 mm			< 90.0	90.0 - 100.0	95.0 - 100.0
4.75 mm				< 90.0	90.0 - 100.0
2.36 mm	19.0 - 45.0	23.0 - 49.0	28.0 - 58.0	32.0 - 67.0*	
1.18 mm					30.0 - 60.0
600 µm					
300 µm					
75 µm	1.0 - 7.0	2.0 - 8.0	2.0 - 10.0	2.0 - 10.0	6.0 - 12.0
* The mix design gradation shall be less than or equal to the PCS control point for 9.5 mm category 3, 4 and 5 surface mixtures.					
PCS Control Point for Mixture Designation (Percent Passing)					
Mixture Designation	25.0 mm	19.0 mm	12.5 mm	9.5 mm	4.75 mm
Primary Control Sieve	4.75 mm	4.75 mm	2.36 mm	2.36 mm	NA
PCS Control Point	40	47	39	47	NA

SECTION 401, BEGIN LINE 97, DELETE AND INSERT AS FOLLOWS:

A PG binder grade or source change will not require a new mix design. If the upper temperature classification of the PG binder is lower than the original PG grade, a new TSR value is required. A new DMF shall be submitted for a binder grade change and shall reference the originating DMF/JMF number.

SECTION 401, BEGIN LINE 157, DELETE AND INSERT AS FOLLOWS:

The recycled material percentages shall be as specified on the DMF. HMA mixtures utilizing recycled materials shall be limited to the binder replacement percentages in the following table:

REVISION TO STANDARD SPECIFICATIONS

SECTION 401 - QUALITY CONTROL/QUALITY ASSURANCE, QC/QA, HOT MIX ASPHALT, HMA PAVEMENT

401.05 VOLUMETRIC MIX DESIGN

401.06 RECYCLED MATERIALS

HMA mixtures utilizing RAP or RAS or a blend of RAP and RAS

<i>Maximum Binder Replacement, %</i>									
<i>Mixture Category</i>	<i>Base and Intermediate</i>					<i>Surface</i>			
	<i>Dense Graded</i>				<i>Open Graded</i>		<i>Dense Graded</i>		
	<i>25.0 mm</i>	<i>19.0 mm</i>	<i>12.5 mm</i>	<i>9.5 mm</i>	<i>25.0 mm</i>	<i>19.0 mm</i>	<i>12.5 mm</i>	<i>9.5 mm</i>	<i>4.75 mm</i>
<i>1</i>	<i>40.0*</i>				<i>25.0</i>		<i>40.0*</i>		
<i>2</i>	<i>40.0*</i>				<i>25.0</i>		<i>40.0*</i>		
<i>3</i>	<i>40.0*</i>				<i>25.0</i>		<i>15.0 25.0</i>		
<i>4</i>	<i>40.0*</i>				<i>25.0</i>		<i>15.0 25.0</i>		
<i>5</i>	<i>40.0*</i>				<i>25.0</i>		<i>15.0 25.0</i>		

**RAS materials shall not contribute more than 25% by weight (mass) of the total binder content for any HMA mixture.*

REVISION TO STANDARD SPECIFICATIONS

SECTION 402 – HOT MIX ASPHALT, HMA, PAVEMENT
 402.04 DESIGN MIX FORMULA
 402.08 RECYCLED MATERIALS
 402.15 COMPACTION

(Changes that are shown in italics have been approved on previous meetings.
 New proposed changes shown as highlighted in gray.)

The Standard Specifications are revised as follows:

SECTION 402, BEGIN LINE 39, INSERT AS FOLLOWS:

Mixture Type	Type A	Type B	Type C	Type D
Design ESAL	200,000	2,000,000	9,000,000	11,000,000
Surface	<i>4.75 mm</i>	<i>4.75 mm</i>	<i>4.75 mm</i>	<i>4.75 mm</i>
	9.5 mm	9.5 mm	9.5 mm	9.5 mm
	12.5 mm	12.5 mm	12.5 mm	12.5 mm
Surface – PG Binder	64-22	64-22	70-22	70-22
Intermediate	<i>9.5 mm</i>	<i>9.5 mm</i>	<i>9.5 mm</i>	<i>9.5 mm</i>
	12.5 mm	12.5 mm	12.5 mm	12.5 mm
	19.0 mm	19.0 mm	19.0 mm	19.0 mm
	<i>25.0 mm</i>	<i>25.0 mm</i>	<i>25.0 mm</i>	<i>25.0 mm</i>
Intermediate – PG Binder	64-22	64-22	64-22	70-22
Base	19.0 mm	19.0 mm	19.0 mm	19.0 mm
	25.0 mm	25.0 mm	25.0 mm	25.0 mm
Base – PG Binder	64-22	64-22	64-22	64-22

Surface 4.75 mm mixtures shall not be used when the required lay rate shown on the plans is greater than 100 lb/sq yd (54 kg/m²). Surface 12.5 mm mixtures shall not be used when the required lay rate shown on the plans is less than 195 lb/sq yd (108 kg/m²).

SECTION 402, BEGIN LINE 138, DELETE AND INSERT AS FOLLOWS:

The recycled material percentages shall be as specified on the DMF. HMA mixtures utilizing recycled materials shall be limited to the binder replacement percentages in the following table:

HMA mixtures utilizing RAP or RAS or a blend of RAP and RAS

Mixture Category	Maximum Binder Replacement, %						
	Base and Intermediate				Surface		
	Dense Graded				Dense Graded		
	25.0 mm	19.0 mm	12.5 mm	9.5 mm	12.5 mm	9.5 mm	4.75 mm
A	40.0*				40.0*		
B	40.0*				40.0*		
C	40.0*				15.0 25.0		
D	40.0*				15.0 25.0		

**RAS materials shall not contribute more than 25% by weight (mass) of the total binder content for any HMA mixture.*

REVISION TO STANDARD SPECIFICATIONS

SECTION 402 - HOT MIX ASPHALT, HMA, PAVEMENT

402.04 DESIGN MIX FORMULA

402.08 RECYCLED MATERIALS

402.15 COMPACTION

SECTION 402, BEGIN LINE 267, INSERT AS FOLLOWS:

Number of Roller Applications							
Rollers	Courses \leq 440 lb/syd (240 kg/m ²)					Courses $>$ 440 lb/syd (240 kg/m ²)	
	Option 1	Option 2	Option 3	Option 4	Option 5	Option 1	Option 2
Three Wheel	2		4			4	
Pneumatic Tire	2	4				4	
Tandem	2	2	2			4	
Vibratory Roller*				6			8
Oscillatory*					6	-	-

*Vertical impact force shall not be used if directed by the Engineer.

REVISION TO STANDARD SPECIFICATIONS

SECTION 409 - EQUIPMENT
409.03 HMA LAYDOWN OPERATION

(New proposed changes shown as highlighted in gray.)

The Standard Specifications are revised as follows:

SECTION 409, BEGIN LINE 105, INSERT AS FOLLOWS:

4. Vibratory Roller

A vibratory roller ~~shall be equipped with~~ *is a roller that has both drums equipped for vertical impact forces,* a variable amplitude system, a speed control device, and have a minimum vibration frequency of 2000 vibrations per min. A reed tachometer shall be provided for verifying the frequency of vibrations. ~~The vertical impact forces of both drums shall not be used if directed by the Engineer.~~

5. Oscillatory Roller

An oscillatory roller is a roller that has both drums equipped for horizontal and vertical shear forces or one drum equipped for horizontal and vertical shear force and the other drum equipped for a vertical impact force. The vertical impact force shall not be used if directed by the Engineer.

5.6. Trench Roller

A trench roller shall have a compaction wheel bearing of no less than 300 lb/in (5.3 kg/mm)

6.7. Specialty Roller/Compactor

Inaccessible or short sections of HMA may be compacted with specialty equipment approved by the Engineer.

REVISION TO STANDARD SPECIFICATIONS

SECTION 410 - QUALITY CONTROL/QUALITY ASSURANCE, GC/GA, HMA SURFACE -SMA
 PAVEMENT

410.06 RECYCLED MATERIALS

(Changes that are shown in italics have been approved on previous meetings.
 New proposed changes shown as highlighted in gray.)

The Standard Specifications are revised as follows:

SECTION 410, BEGIN LINE 124, DELETE AND INSERT AS FOLLOWS:

The recycled material percentages shall be as specified on the DMF. SMA mixtures utilizing recycled materials shall be limited to the binder replacement percentages in the following table:

SMA mixtures utilizing RAP or RAS or a blend of RAP and RAS

<i>Maximum Binder Replacement, %</i>		
<i>SMA Surface</i>		
<i>Mixture Category</i>	<i>12.5 mm</i>	<i>9.5 mm</i>
<i>1</i>	<i>40.0*</i>	<i>40.0*</i>
<i>2</i>	<i>40.0*</i>	<i>40.0*</i>
<i>3</i>	<i>15.0</i> <i>25.0</i>	<i>15.0</i> <i>25.0</i>
<i>4</i>	<i>15.0</i> <i>25.0</i>	<i>15.0</i> <i>25.0</i>
<i>5</i>	<i>15.0</i> <i>25.0</i>	<i>15.0</i> <i>25.0</i>

**RAS materials shall not contribute more than 25% by weight (mass) of the total binder content for any HMA mixture.*

COMMENTS AND ACTION

401.05 VOLUMETRIC MIX DESIGN
401.06 RECYCLED MATERIALS
402.04 DESIGN MIX FORMULA
402.08 RECYCLED MATERIALS
402.15 COMPACTION
409.03 HMA LAYDOWN OPERATION
410.06 RECYCLED MATERIALS

DISCUSSION: This item was introduced and presented by Mr. Walker who explained that there had been an excess of fines in the mixes. This proposal is to reduce the number of fines in the mix. It is believed that more coarse aggregates will improve the friction numbers. Mr. Walker then went on to further explain the proposed revisions to 401, 402, 409 and 410 spec sections, as indicated on the proposal page.

Mr. Andrewski asked what mix design would be required if 110 lbs/sq yd lay rate was specified. Mr. Prather and Mr. Pankow said that 110 lb/sq yd mix is not normally used. Mr. Walker stated that that type of lay rate would cause problems and most likely would not be used. Mr. Prather said the concern is that if the 4.75 mm is too thick, it could become unstable.

Mr. Walker then explained the revisions to add the information for the oscillatory rollers. This revision allows the project engineer to further control the rolling operations in order to get the desired compaction. Mr. Pankow stated that the rolling requirements need to be made known up front. Mr. Capon also agreed that the oscillatory helps them get the compaction and density, and is a great tool to have.

Further discussion ensued on the various rollers types and their uses. Mr. Andrewski would like the *asterisk and the statement removed from the table "Number of Roller Applications". Mr. Keefer suggested leaving it there and adding language "*Density requirement still apply*". Mr. Walker mentioned that the density requirements are not in 402, and that it would only apply to 401. Mr. Andrewski would still like to add a statement saying that this will only apply to 401 mixes. Mr. Prather agreed with Mr. Pankow in that this should be addressed in a Construction Memo.

After much discussion, it was suggested that the statement be left out. Also, it was agreed the last sentence of 4. and 5. be removed. Much discussion still ensued as to whether to leave this language out or not. For now we are leaving them out.

Mr. Walker revised his proposal.

COMMENTS AND ACTION

401.05 VOLUMETRIC MIX DESIGN
 401.06 RECYCLED MATERIALS
 402.04 DESIGN MIX FORMULA
 402.08 RECYCLED MATERIALS
 402.15 COMPACTION
 409.03 HMA LAYDOWN OPERATION
 410.06 RECYCLED MATERIALS

<p>Motion: Mr. Walker Second: Mr. Reilman Ayes: 7 Nays: 0</p>	<p>Action: <input type="checkbox"/> Passed as Submitted <input checked="" type="checkbox"/> Passed as Revised <input type="checkbox"/> Withdrawn</p>
<p>Standard Specifications Sections affected: 401.05; .06;402.04; .08;.15; 409.03; 410.06.</p> <p>Recurring Special Provision affected: 400-R-553 HMA PROVISIONS <i>(Note: Incorporated into 2012 SS)</i></p> <p>Standard Sheets affected: NONE</p> <p>Design Manual Sections affected: NONE</p> <p>GIFE Sections cross-references: SECTION 13</p>	<p><input type="checkbox"/> 20 Standard Specifications Book <input type="checkbox"/> Revise Pay Items List <input type="checkbox"/> Create RSP (No. ____) Effective ____ Letting RSP Sunset Date: ____</p> <p><input checked="" type="checkbox"/> Revise RSP (No. 400-R-553 (2011 Edition)) Effective <u>September 01, 2011</u> Letting RSP Sunset Date: ____</p> <p>Standard Drawing Effective ____ <input type="checkbox"/> Create RPD (No. ____) Effective ____ Letting <input type="checkbox"/> Technical Advisory</p> <p>GIFE Update Req'd.? Y ___ N ___ By ____ Addition or ____ Revision</p> <p>Frequency Manual Update Req'd? Y ___ N ___ By ____ Addition or ____ Revision</p> <p>Received FHWA Approval? <u>Yes</u></p>

SPECIFICATION REVISIONS
REVISION TO STANDARD DRAWINGS

PROPOSAL TO STANDARDS COMMITTEE

PROBLEM(S) ENCOUNTERED: Some welding requirements are missing from some of the bridge railing standard drawings.

PROPOSED SOLUTION: Show the welding requirements where necessary.

APPLICABLE STANDARD SPECIFICATIONS: None

APPLICABLE STANDARD DRAWINGS: 706-BRPP-01, 706-BRPP-02, 706-BRPP-03, 706-BRPP-04, 706-BRPP-06, 706-BRTF-09, 706-BRTM-02

APPLICABLE DESIGN MANUAL SECTION: None

APPLICABLE SECTION OF GIFE: None

APPLICABLE RECURRING SPECIAL PROVISIONS: None

Submitted By: Greg Pankow

Title: State Construction Engineer

Organization: INDOT


Phone Number: 2-5502

Date: May 4, 2011

APPLICABLE SUB-COMMITTEE ENDORSEMENT? None

REVISION TO STANDARD DRAWINGS


706-BRPP-01 RAILING, PF-1

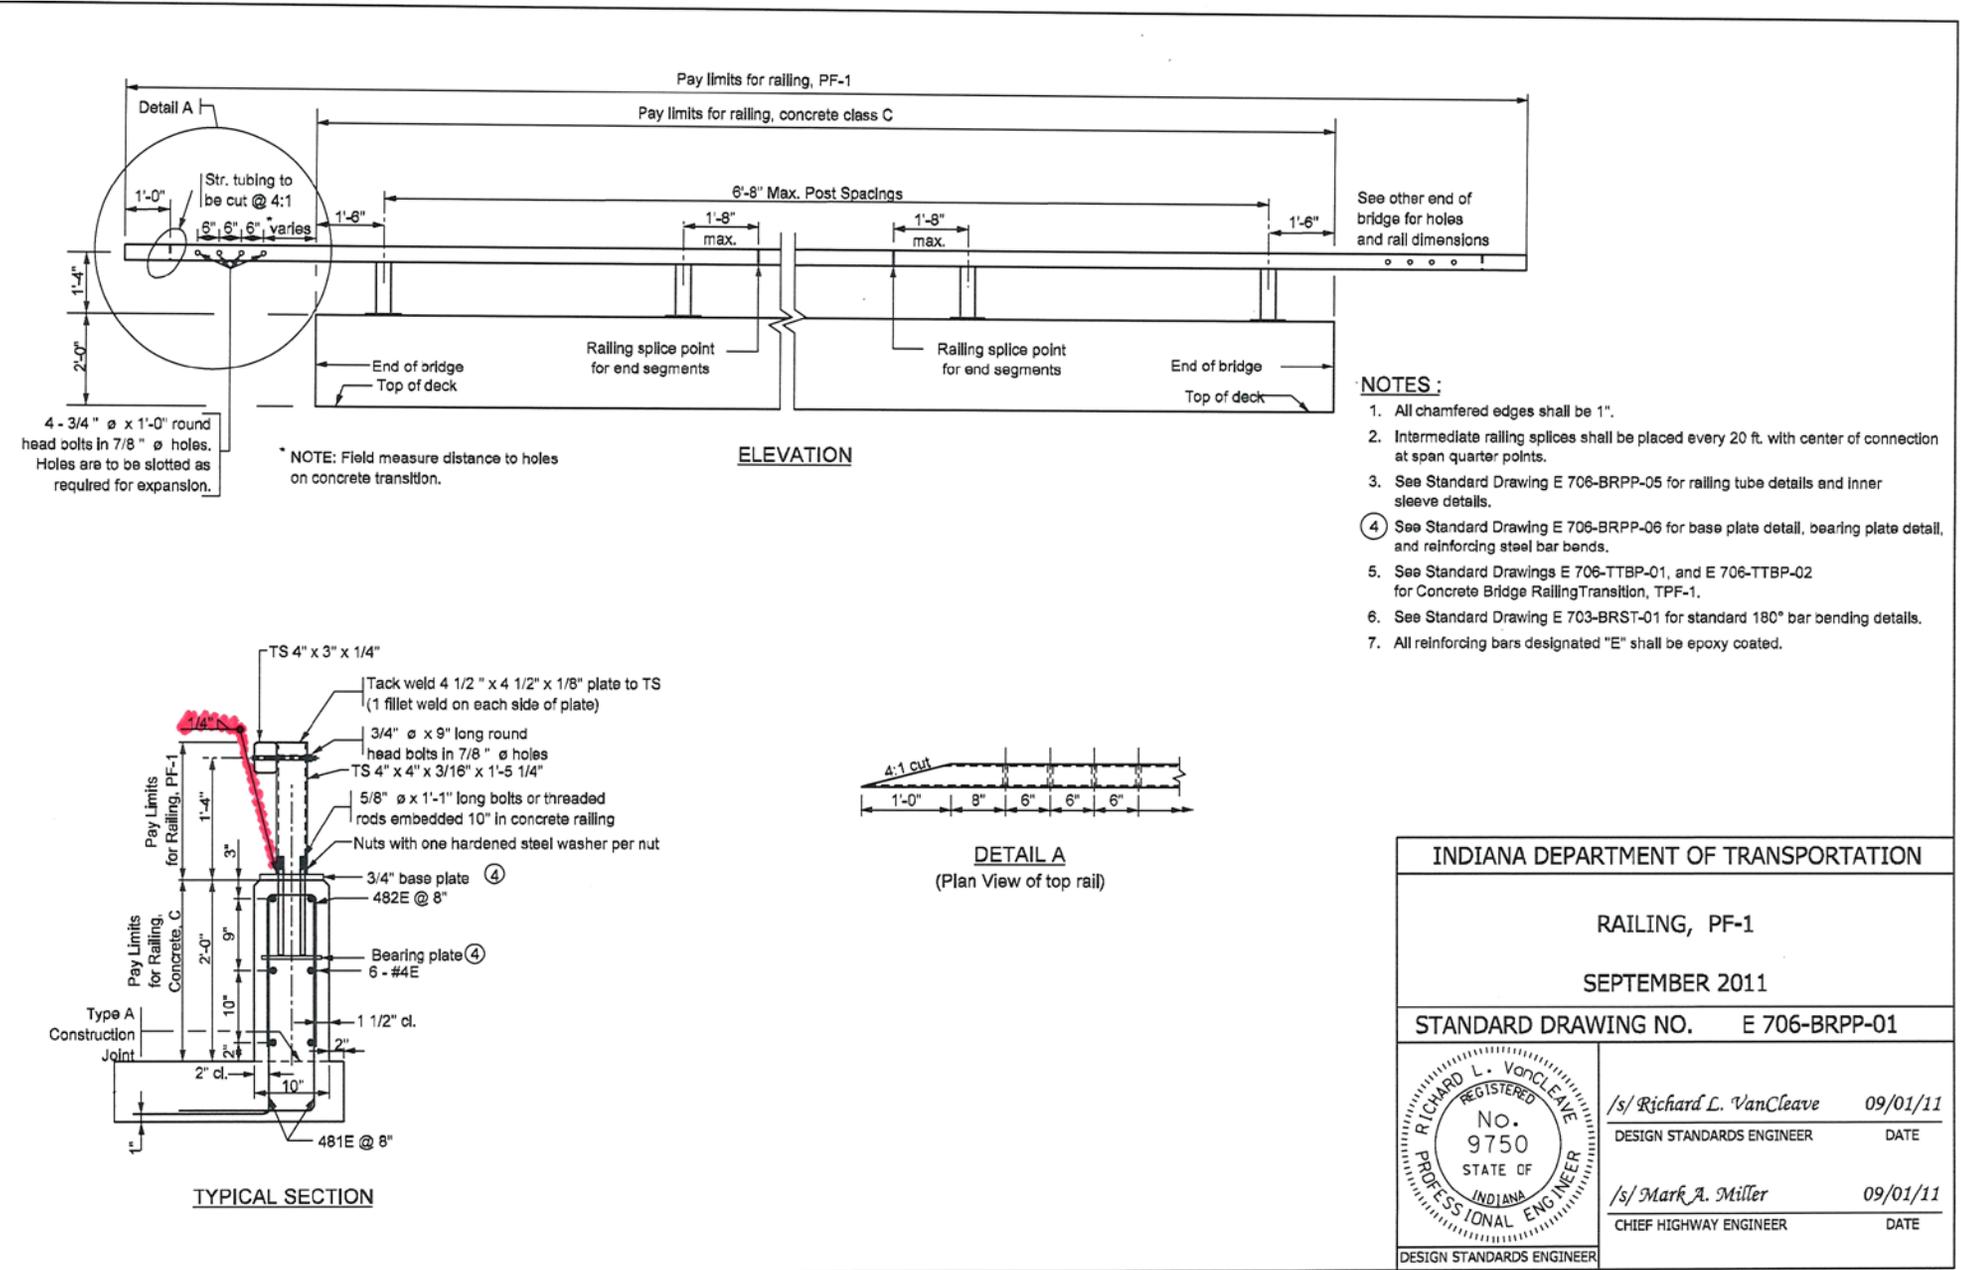

INDIANA DEPARTMENT OF TRANSPORTATION	
RAILING, PF-1	
SEPTEMBER 2011	
STANDARD DRAWING NO.	E 706-BRPP-01
	/s/ Richard L. VanCleave 09/01/11 DESIGN STANDARDS ENGINEER DATE
	/s/ Mark A. Miller 09/01/11 CHIEF HIGHWAY ENGINEER DATE
DESIGN STANDARDS ENGINEER	

REVISION TO STANDARD DRAWINGS


706-BRPP-02 RAILING, PF-2

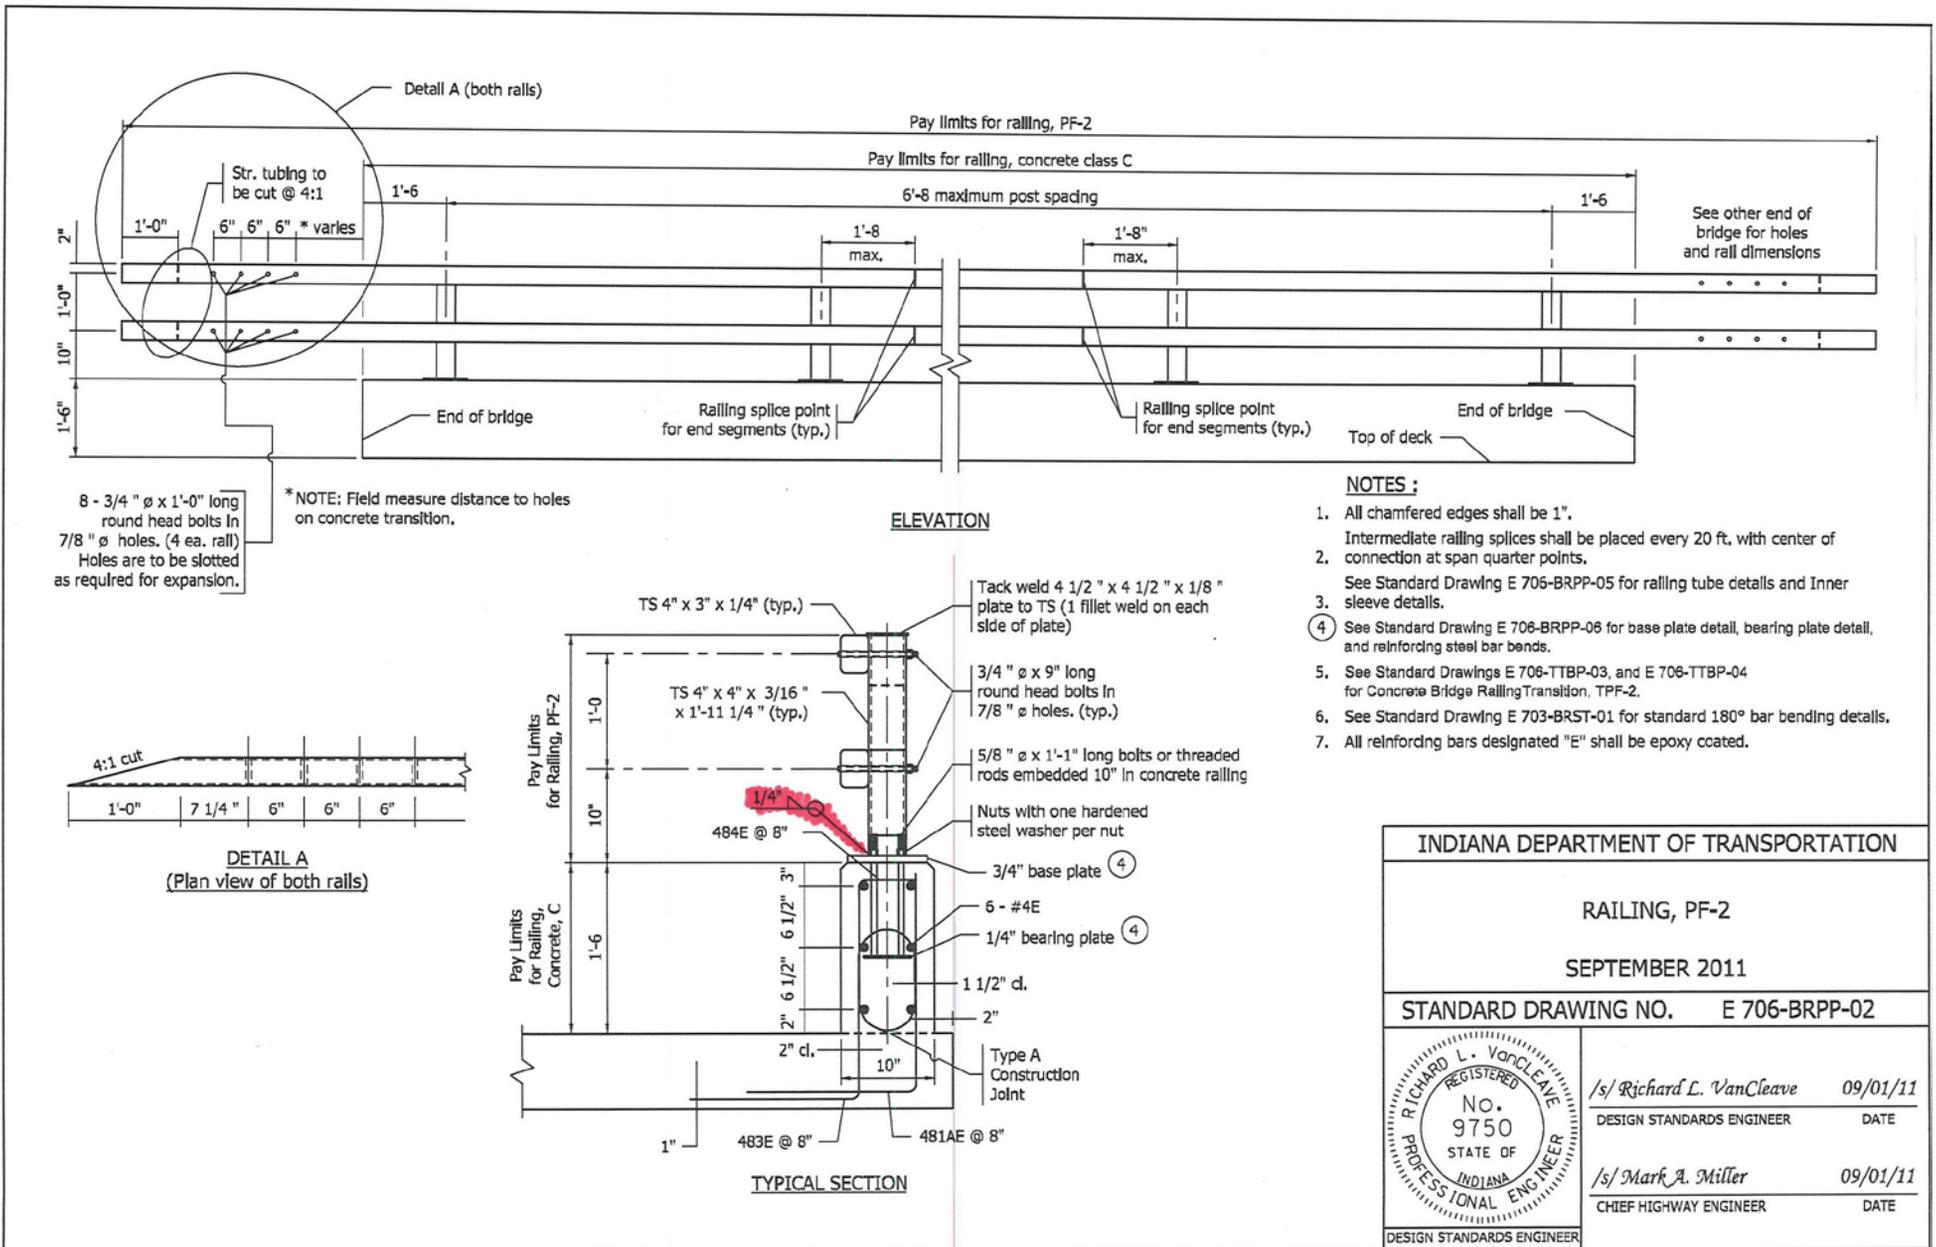

INDIANA DEPARTMENT OF TRANSPORTATION	
RAILING, PF-2	
SEPTEMBER 2011	
STANDARD DRAWING NO. E 706-BRPP-02	
	/s/ Richard L. VanCleave 09/01/11 DESIGN STANDARDS ENGINEER DATE
	/s/ Mark A. Miller 09/01/11 CHIEF HIGHWAY ENGINEER DATE
DESIGN STANDARDS ENGINEER	


REVISION TO STANDARD DRAWINGS

706-BRPP-03 RAILING, PS-1

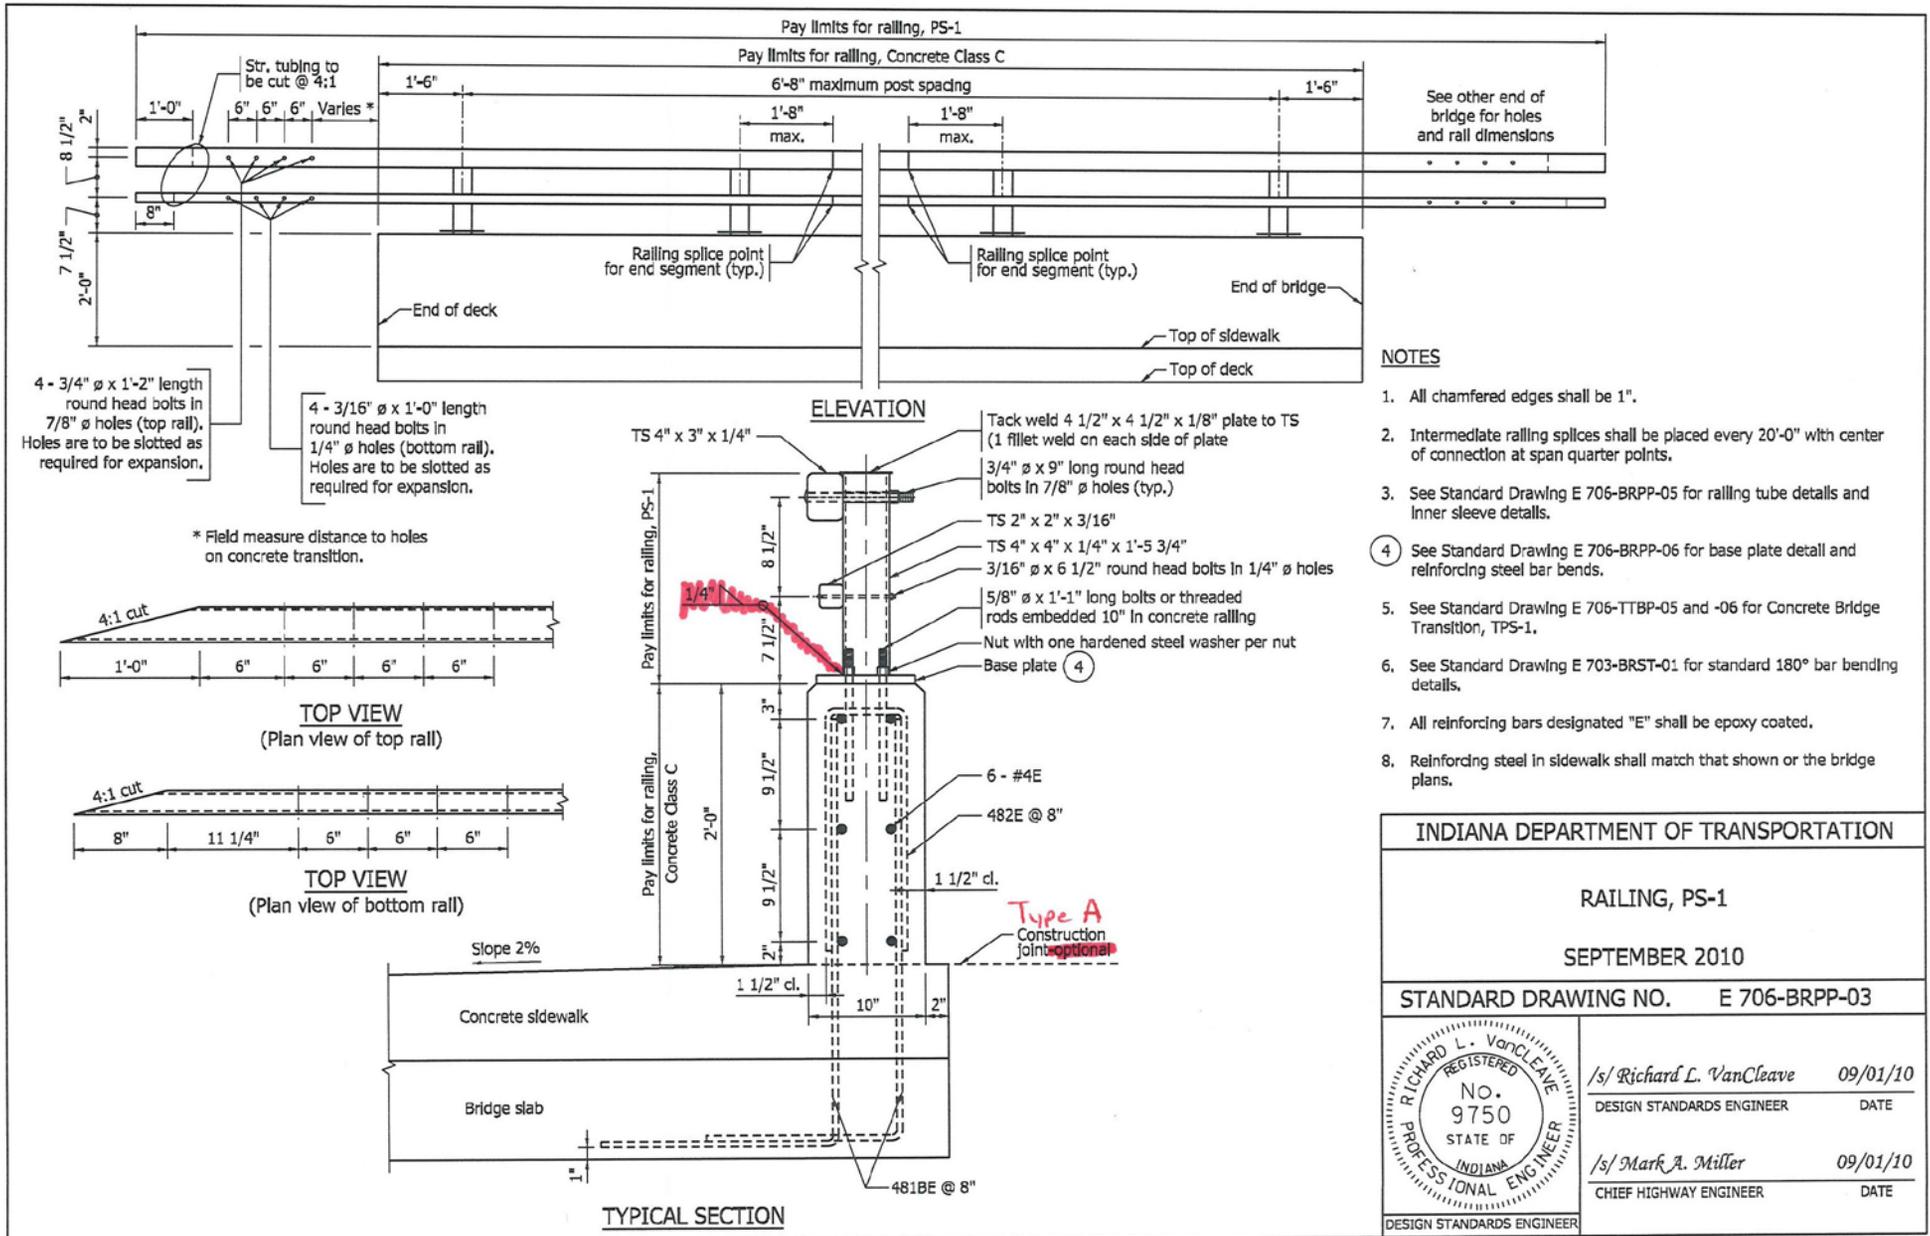

REVISION TO STANDARD DRAWINGS


706-BRPP-04 RAILING, PS-2

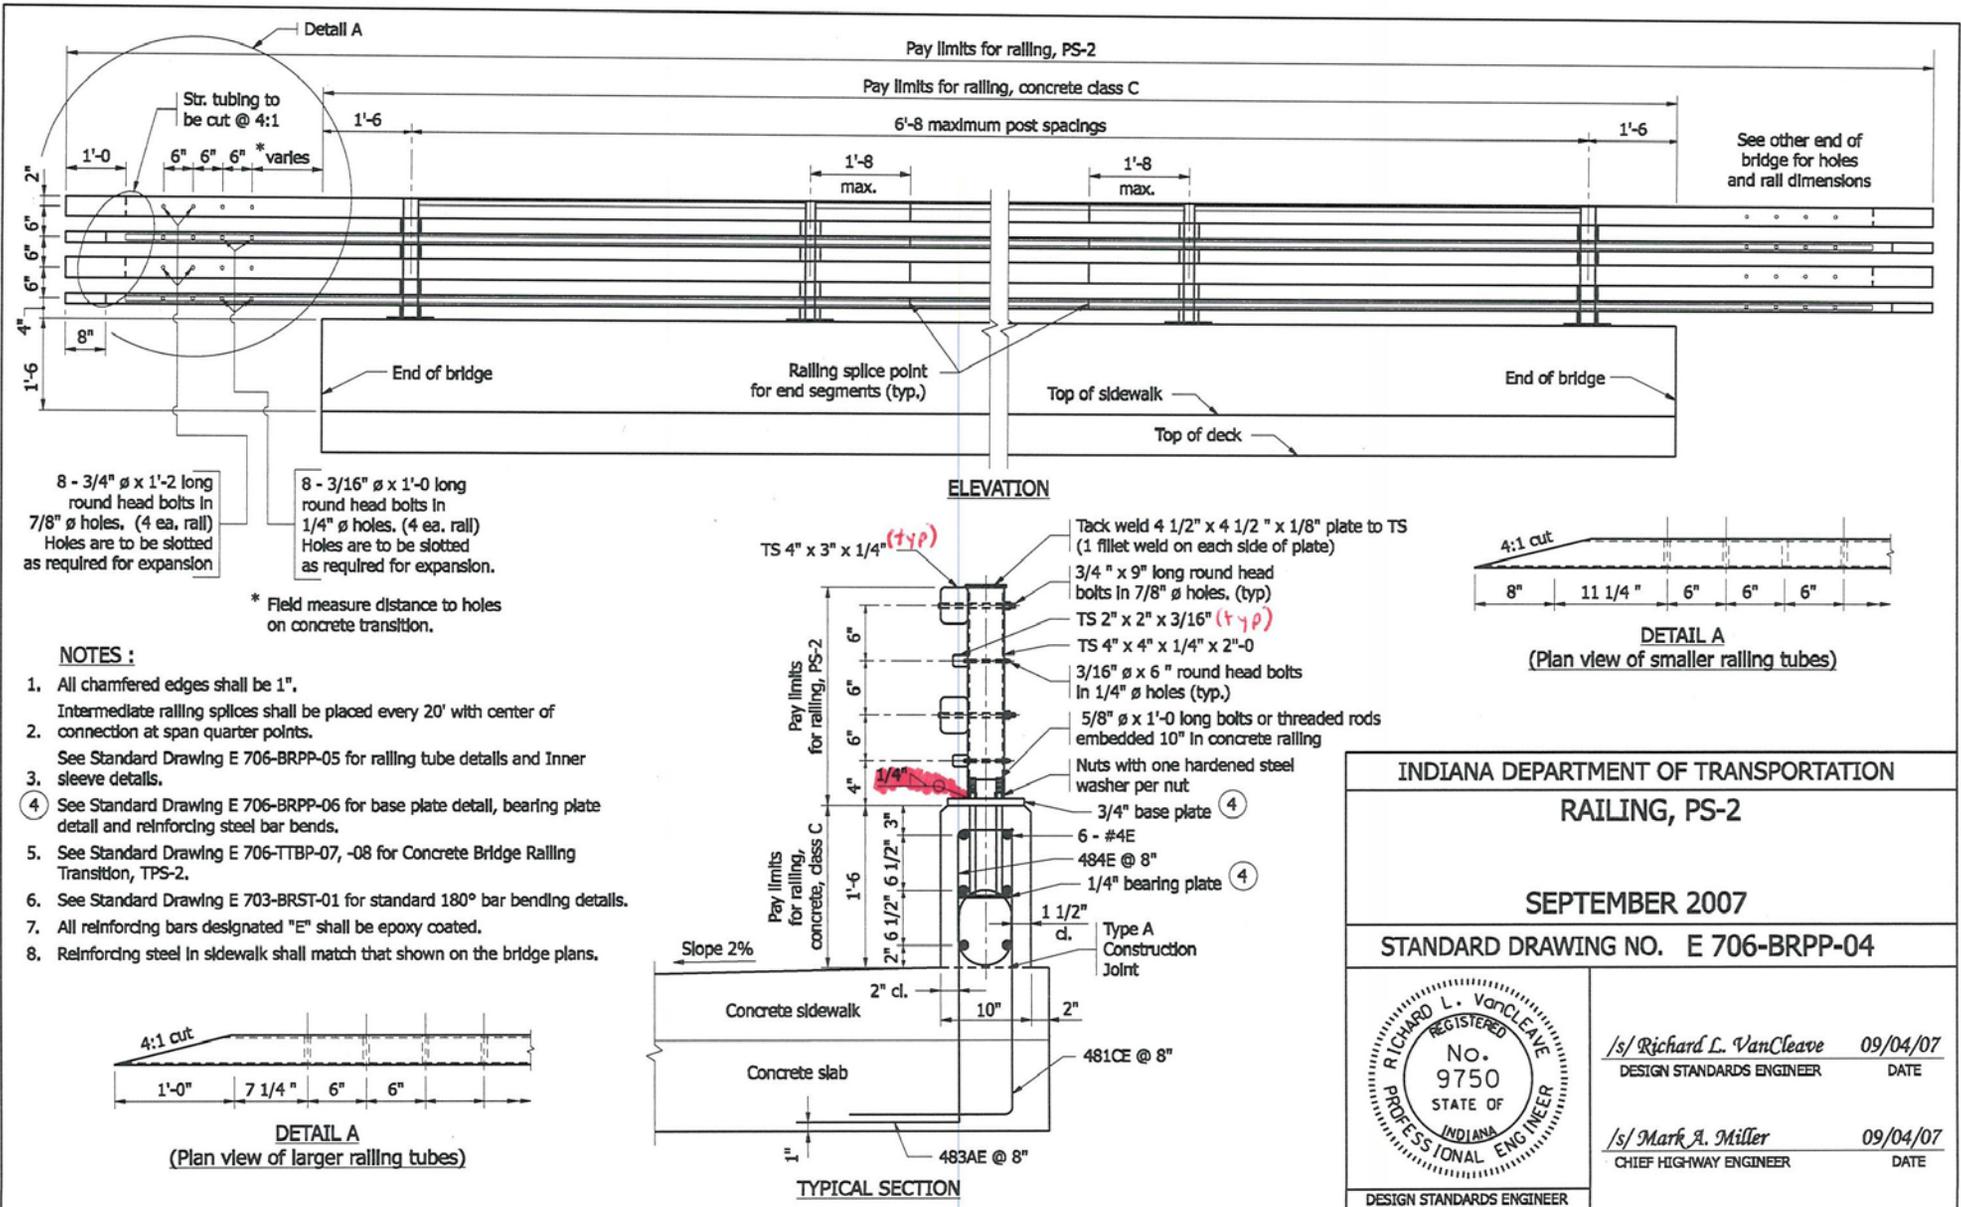


INDIANA DEPARTMENT OF TRANSPORTATION	
RAILING, PS-2	
SEPTEMBER 2007	
STANDARD DRAWING NO. E 706-BRPP-04	
	/s/ Richard L. VanCleave 09/04/07 DESIGN STANDARDS ENGINEER DATE
	/s/ Mark A. Miller 09/04/07 CHIEF HIGHWAY ENGINEER DATE
DESIGN STANDARDS ENGINEER	

REVISION TO STANDARD DRAWINGS

706-BRPP-06 RAILING, PF & PS DETAILS

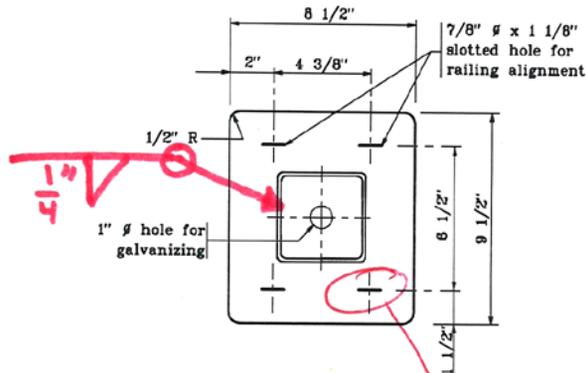

BASE PLATE DETAIL

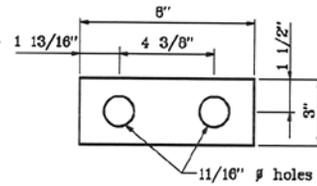


BEARING PLATE DETAIL


NOTES:

1. See Standard Drawing E 703-BRST-01 for standard 180° bar bending details.
2. All reinforcing bars designated "E" shall be epoxy coated.


Show holes as slotted, similar to 706-BRTM-02

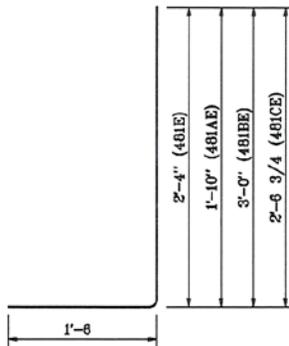

- 481E x 3'-10
- 481AE x 3'-4
- 481BE x 4'-8
- 481CE x 4'-0 3/4

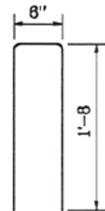

482E x 3'-10"

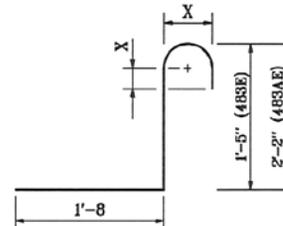

483E x 3'-10"
483AE x 4'-8"



484E x 2'-8"


INDIANA DEPARTMENT OF TRANSPORTATION

RAILING, PF & PS

DETAILS

MARCH 2002

STANDARD DRAWING NO. E 706-BRPP-06

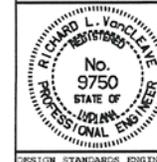

/s/ Richard L. VanCleave 3-01-02
DESIGN STANDARDS ENGINEER DATE

/s/ Richard K. Smuter 3-01-02
CHIEF HIGHWAY ENGINEER DATE


REVISION TO STANDARD DRAWINGS

706-BRTF-09 CONCRETE BRIDGE RAILING TYPE TF-2


NOTES:

1. $1\frac{3}{8}$ " HOLES FOR $1\frac{1}{8}$ " ANCHOR BOLT.

~~2. SEE STANDARD SPECIFICATION 711.36~~

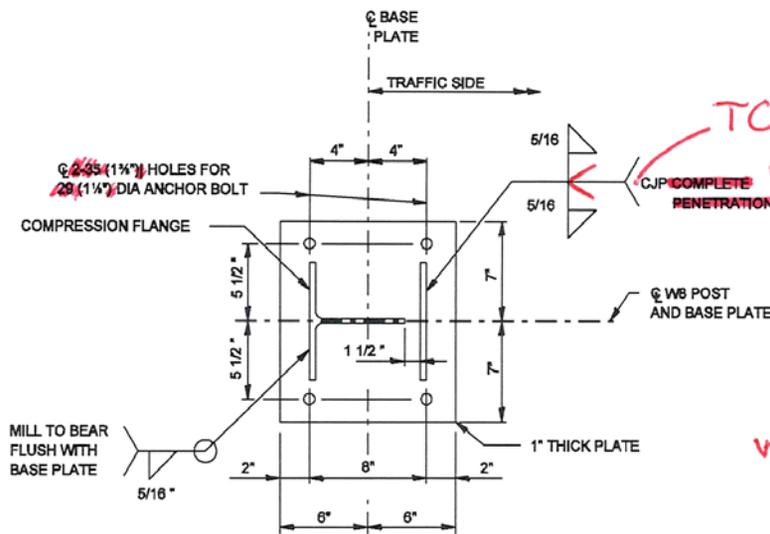

POST TO BASE PLATE DETAIL

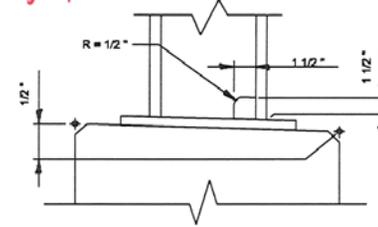

WELD ACCESS DRAIN HOLE DETAIL

TC-U5b
COMPLETE backgouge; runoff tabs required
CJP COMPLETE PENETRATION WELD

INDIANA DEPARTMENT OF TRANSPORTATION	
CONCRETE BRIDGE RAILING TYPE TF-2	
SEPTEMBER 2005	
STANDARD DRAWING NO. E 706-BRTF-09	
	/s/ Richard L. VanCleave 9-01-05 DESIGN STANDARDS ENGINEER DATE
	/s/ Richard K. Smutzer 9-01-05 CHIEF HIGHWAY ENGINEER DATE

REVISION TO STANDARD DRAWINGS
706-BRTM-02 RAILING, CF-1

THIS PAGE LEFT INTENTIONALLY BLANK

APPROVED MINUTES

REVISION TO STANDARD DRAWINGS

- 706-BRPP-01 RAILING, PF-1
- 706-BRPP-02 RAILING, PF-2
- 706-BRPP-03 RAILING, PS-1
- 706-BRPP-04 RAILING, PS-2
- 706-BRPP-06 RAILING, PF & PS DETAILS
- 706-BRTF-09 CONCRETE BRIDGE RAILING TYPE TF-2
- 706-BRTM-02 RAILING, CF-1

DISCUSSIONS: This item was introduced by Mr. Reilman, who explained that some discrepancies were found in the standard drawings regarding weld symbols and requirements. Further revisions are proposed to provide clarity, and were explained by Mr. Reilman.

There was no detailed discussion, comments or questions, only an inquiry as to when the revised details will be ready.

Mr. Uremovich concurred that these can be accomplished in time for the September 2011 letting.

<p>Motion: Mr. Reilman Second: Mr. Boruff Ayes: 7 Nays: 0</p>	<p>Action: <input checked="" type="checkbox"/> Passed as Submitted <input type="checkbox"/> Passed as Revised <input type="checkbox"/> Withdrawn</p>
<p>Standard Specifications Sections affected: NONE</p> <p>Recurring Special Provision affected: NONE</p> <p>Standard Sheets affected: 706-BRPP-01, 706-BRPP-02, 706-BRPP-03, 706-BRPP-04, 706-BRPP-06, 706-BRTF-09, 706-BRTM-02</p> <p>Design Manual Sections affected: NONE</p> <p>GIFE Sections cross-references: NONE</p>	<p><input type="checkbox"/> 20 Standard Specifications Book <input type="checkbox"/> Revise Pay Items List <input type="checkbox"/> Create RSP (No. ___) Effective ___ Letting RSP Sunset Date: ___</p> <p><input type="checkbox"/> Revise RSP (No. ___) Effective ___ Letting RSP Sunset Date: ___</p> <p>Standard Drawing Effective <u>Sept. 01, 2011</u> <input type="checkbox"/> Create RPD (No. ___) Effective ___ Letting <input type="checkbox"/> Technical Advisory</p> <p>GIFE Update Req'd.? Y ___ N ___ By ___ Addition or ___ Revision</p> <p>Frequency Manual Update Req'd? Y ___ N ___ By ___ Addition or ___ Revision</p> <p>Received FHWA Approval? <u>Yes</u></p>