FORM RL-6 - I.H.P.S.

STATE-WIDE HIGHWAY PLANNING SURVEY-ROAD LIFE

STATE HIGHWAY COMMISSION OF INDIANA

DISTRICT Ft. Wayne
COUNTY Adams
ROUTE U.S. #27 SEC.

LOG RECORD OF PROJECT CONSTRUCTION AND RETIREMENT SALVAGE VALUES

SCALE 1" = 2 MI.

TERMINI HPMS

From the Jay-Adams Co. Line to the Junction with S.R. #124.

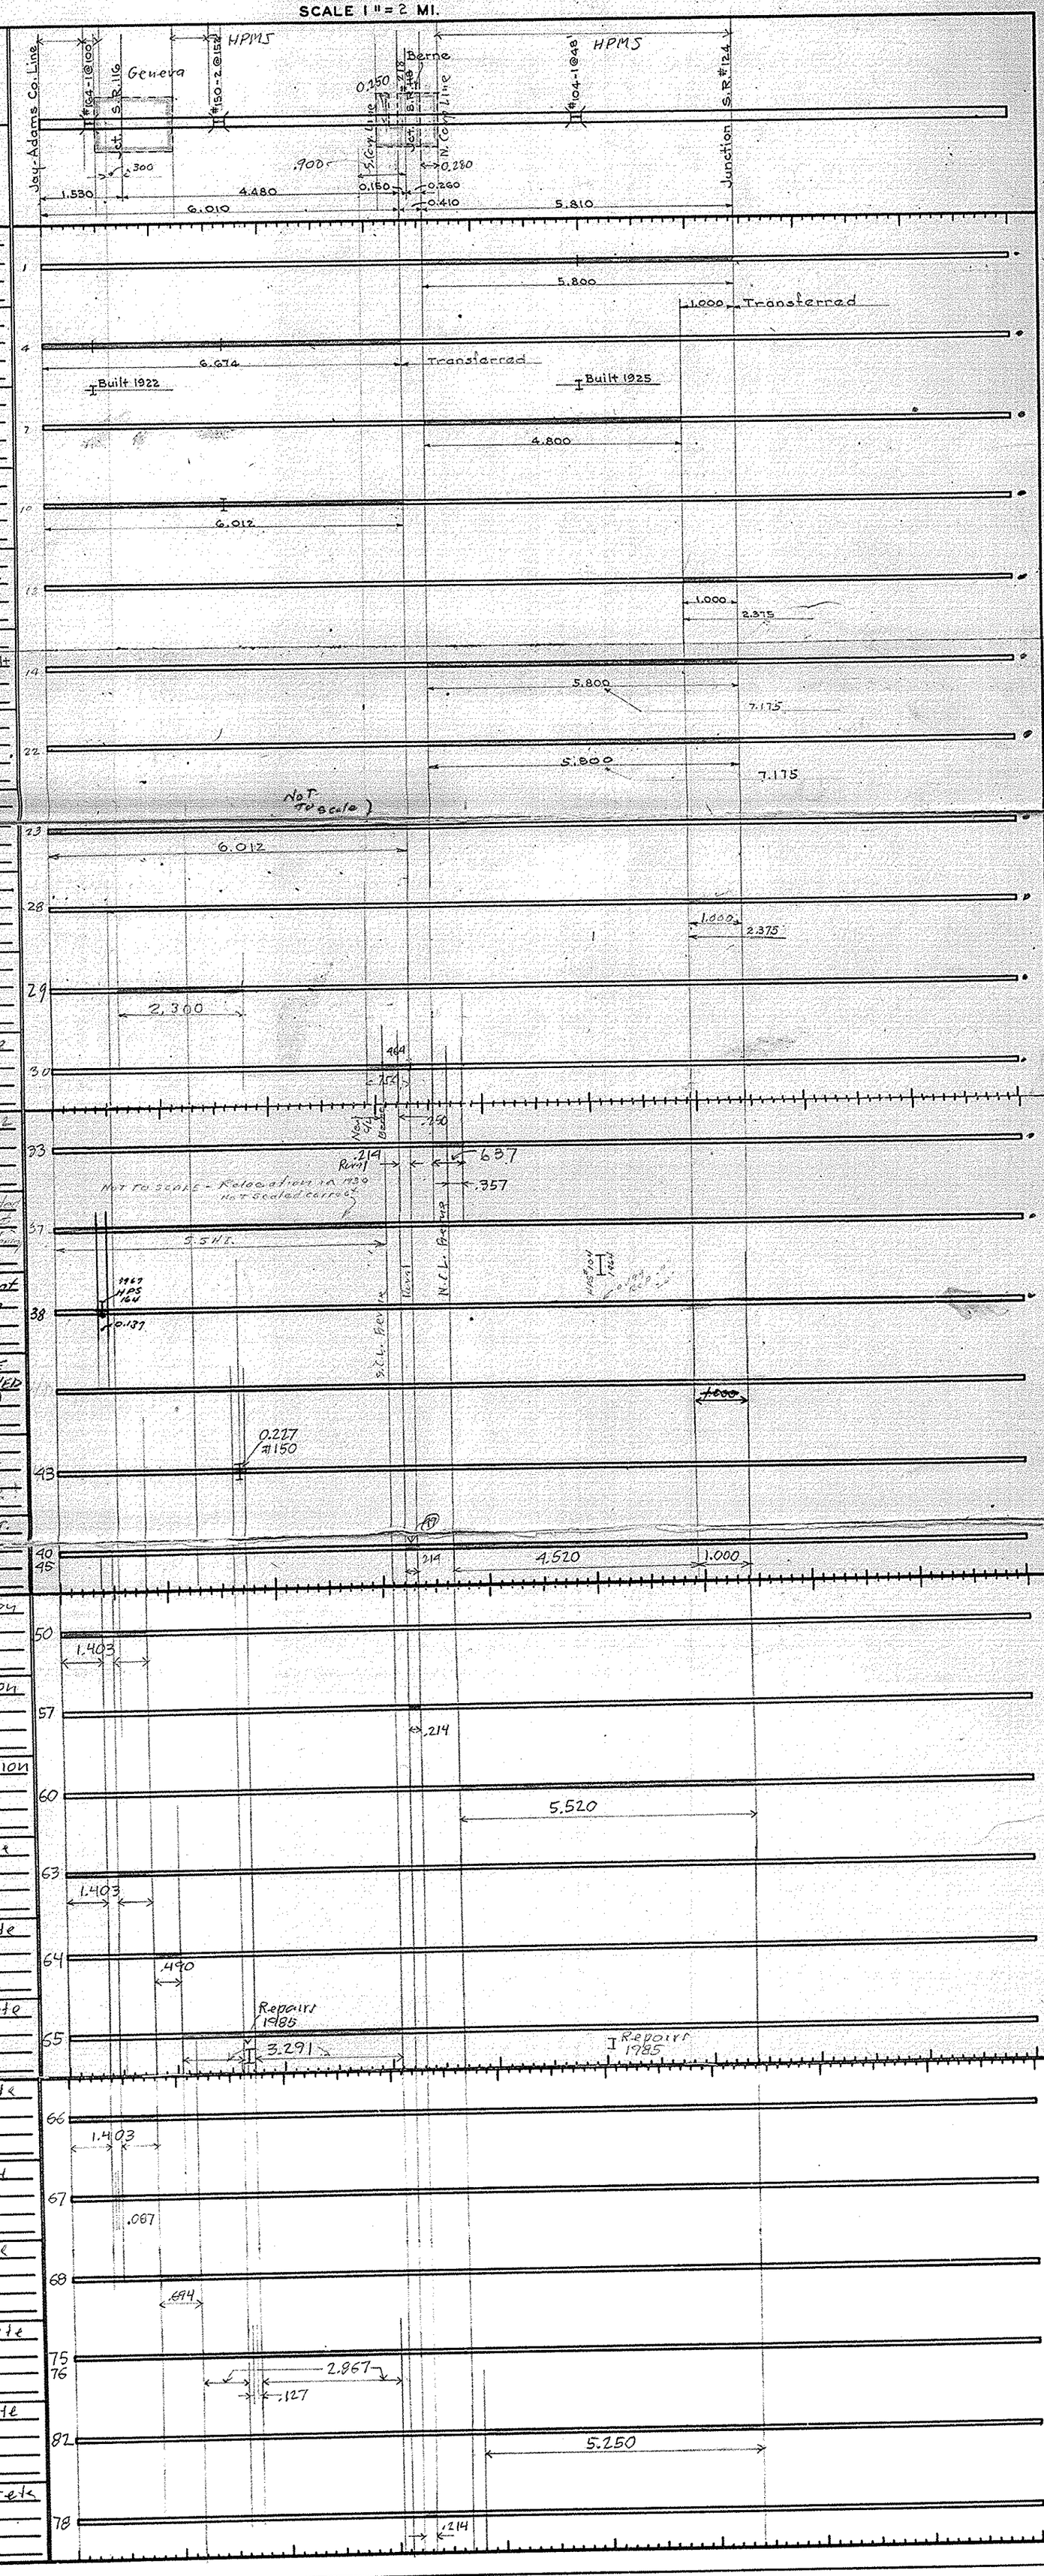

YEAR BUILT	PROJ. CLASS	PROJ. NO.	THICKNESS	WIDTH	TYPE
1921	Maint.	–	–	16'	Gravel
1921	Maint.	–	–	16'	Gravel
1929	Maint.	–	2"-9"	18'	Rock Asphalt On non rigid base
1930	St. Contr.	S-140	9"-7"-9"	18'	Concrete Grading & Paving
1932	St. Contr.	S-299	2"-9"	20'	Rock Asphalt On non rigid base
1937	Maint.	–	1"-10	20'	Rock Asphalt On old rock asphalt road.
1945	Maint.	Cont. 2529	5"-10	22	Rock Asphalt on old RA widened
1948	Maint.	Cont. 280	5/8-3	22	Rock Asphalt on old base widened
1956	maint.	Force A/c	2-9	22	Hot Asph. & Conc on Rock Asphalt
1959	Maint.	Force Acct.	1"8-10	22	Hot Asph conc on old RA on conc
1959	Maint.	Force Acct.	1½-10	22	Hot Asph Conc on old RA on Conc
1959	Maint.	Force Acct.	1½-12	22	Hot Asph Conc Flexible base
1963	RS 6042	F299(6)	1"-11"	24'	Bit Coated Blended Agg Resurfaced BCBA Base widening LR&L
1967	B-6823	F299(10)	9-9-9	24'	New 9" RC Pavement in Connection with New Structure over Lebbly Creek
1963	RS 6041	F299(5)	1"-8"	24'	BCBA Resurface & Binder widened LR&L (BCBA)
1968	B-7243	F299(8)	9-9-9	29'	Reinforced Conc. Pav't at New Bridge over Wabash R.
*					Hot Asph. Emulsion Surface
1965	M	674	1"-1½"	24	Wid. 1'-3" R&L
1976	RS-10472		1½-12	24'	Hot Asph. Emulsion Resurface
1981	RS-12839		1½-15'	30	Hot Asph. Emulsion Resurface
1981	RS-12839		1½"-15'	30	Hot Asph. Emulsion Resurface
1981	RS-12838		1½"-13"	24'	Bitum. Concrete Resurface
1981	RS-12838		1½"-12"	24'	Bitum. Concrete Resurface
1981	RS-13176		1½"-12"	24'	Hot Asph. Concrete Resurface
1990	M-19146		1½"-14"	24'	Bitum. Concrete Resurface
1990	M-19146		1½-11"	24'	Bitum. Concrete Resurface
1990	M-19146		1½-13"	24'	Bitum. Concrete Resurface
1991	RS-19763		1½"-14"	30'	Bitum Concrete Resurface
1991	RS-19763		1½"-14"	30'	Bitum Concrete Resurface
1991	RS-19763		1½"-12"	30'	Bitum Concrete Resurface

* Was Hot Rec. Until 1990