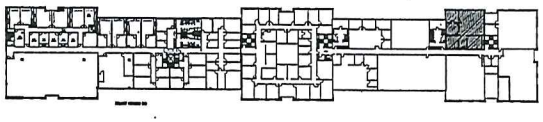

KEYPLAN
SCALE: NOT TO SCALE

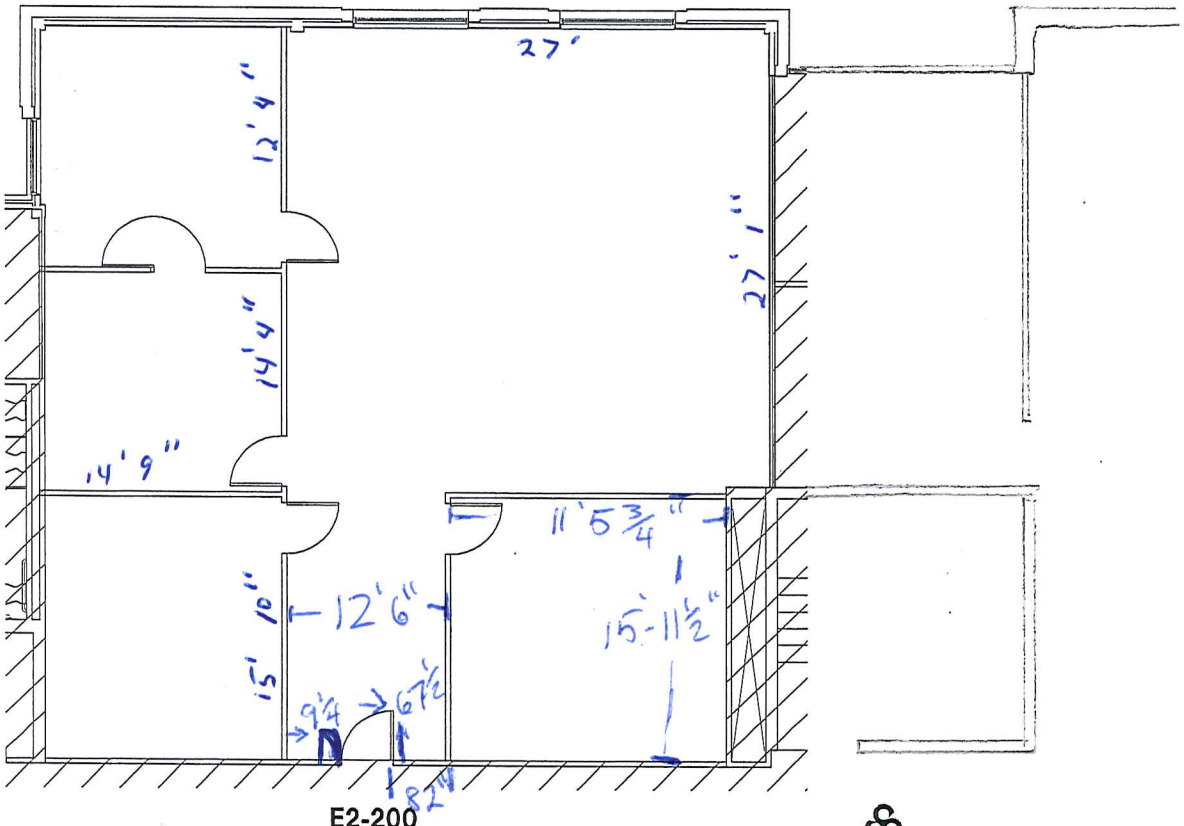

SUITE AS-BUILT
SCALE: 3/32"=1'-0"
05-24-10

PURDUE
RESEARCH FOUNDATION

E2-200
PURDUE TECHNOLOGY CENTER
WEST LAFAYETTE, INDIANA

CSO Architects

NORTH

DOOR OPENING - 4' 6"