IN02_T07NR04E11_18.pdf Scanned 5/10/2005 4:02:53 PM

SEC. 11 TWP. 7 RGE. 4

GRID POINT F

*Note: See Corner Report of Northwest Quarter for important Information Concerning This Corner. RLS

Point 1st Est. by No Record Date

Original Entry Section corner Record Book

Original Monument

Point Recovered by G.S. - J.M.

Mon. Found 5/8" Rebar w/ O.A.J. Cap in Good Cond.

Mon. Set

Ties Made and Recorded as Follows:

STONE TIE BOOK	PAGE	DATE	SURVEYOR
#150	45	9-24-1996	BLS.

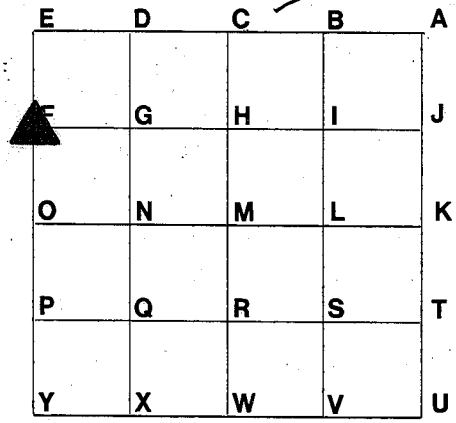

Coordinates Available

Bartholomew County Surveyor

93008

IN02_T07NR04E11_18.pdf Scanned 5/10/2005 4:02:53 PM

Existing Ties Found	Date
1	
2	
3	
4	
5	
6	
7	
8	
9	

New Ties Made	Date
A Nail w/ BCS. Disk in 10" white oak E. side	10.22'
B Nail w/ BCS. Disk in 14" white oak E. side	56.88'
C Nail w/ BCS. Disk in 12" white oak NE. side	34.69'
D Nail w/ BCS. Disk in 18" white oak W. side	5.25'
E Nail w/ BCS. Disk in Double Trunk white oak N. side	23.15'
F 5/8" Rebar w/ OAT cap + w/ Steel Fence Post Next To It	39.11'
G Nail w/ BCS. Disk in 24" oak NE. side	39.69'
H	
I	

9-24-1996
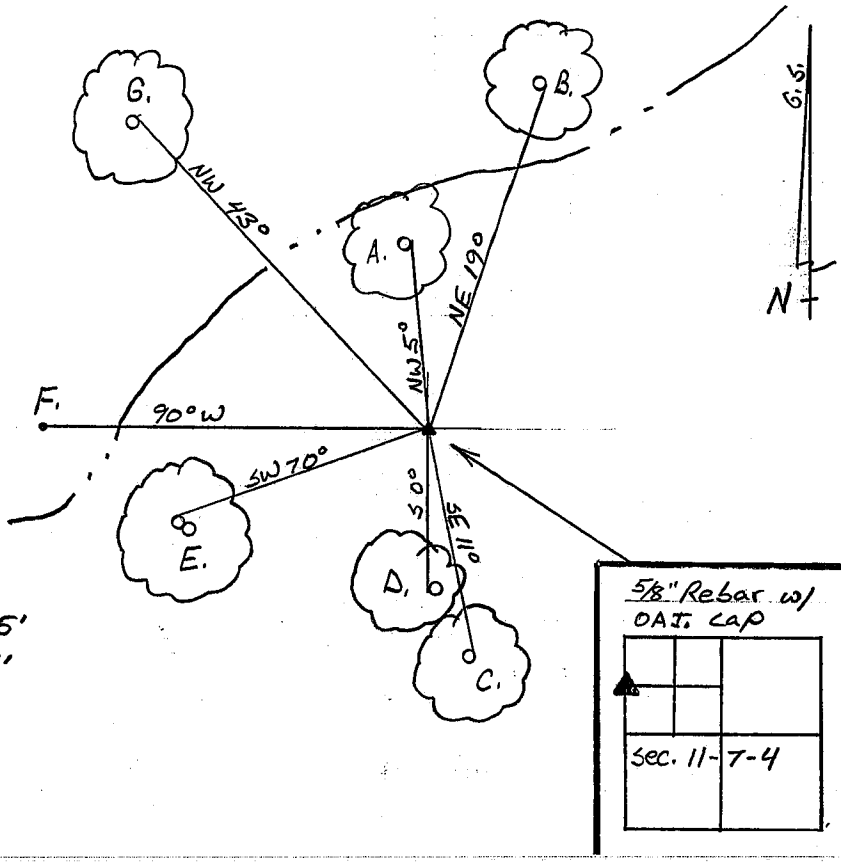
Sketch