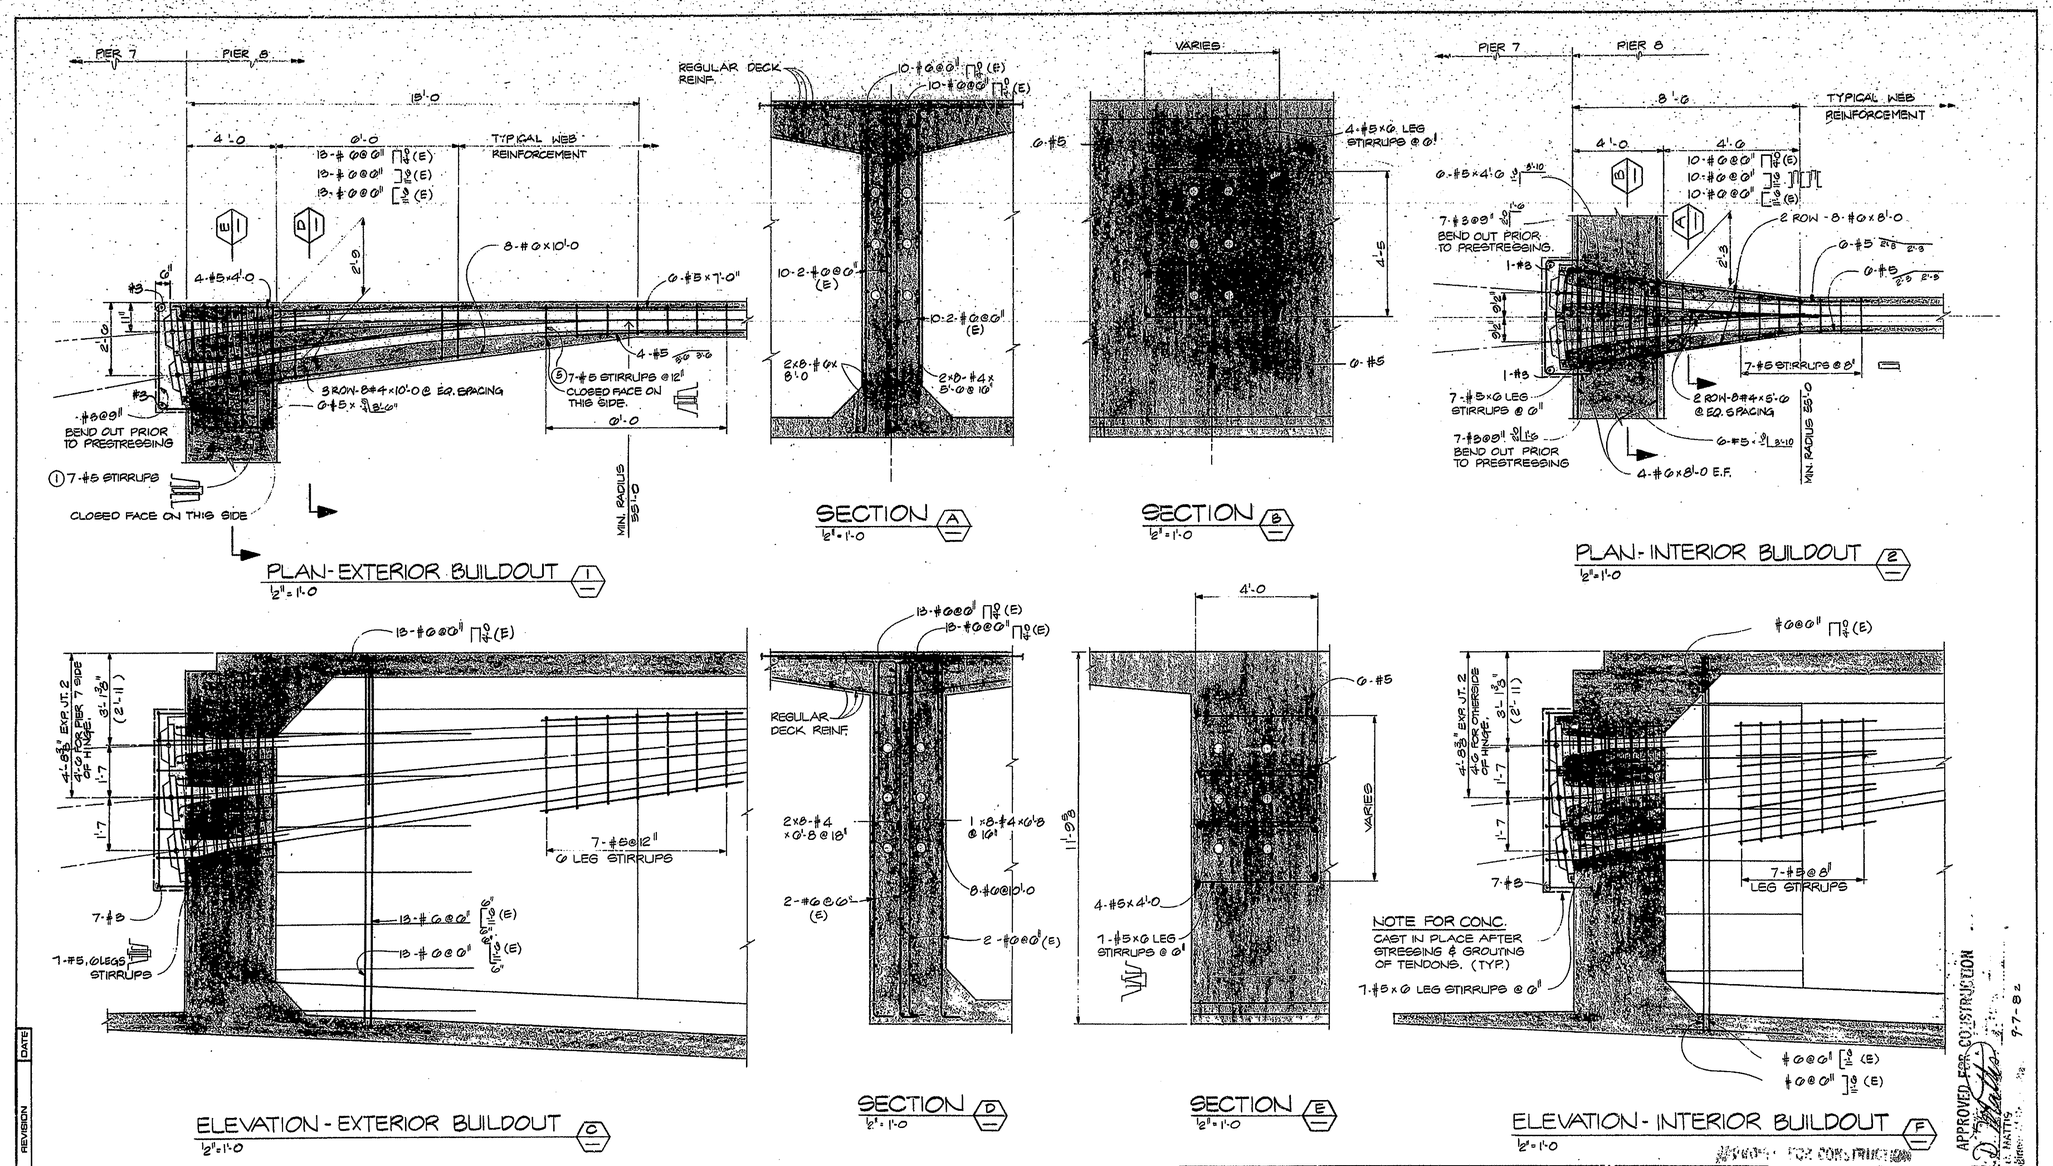

APPROVED FOR CONSTRUCTION
9-7-82

NOTE:
AS BUILT. THIS SHEET IS SUPERCEDED BY SHEET 922A.

NO.	REVISION	DATE
1	CROSS-REF. NOTE	DEC '81

T. Y. LIN INTERNATIONAL
STRUCTURAL ENGINEERS

REID, QUEBE, ALLISON, WILCOX AND ASSOCIATES INC.
CONSULTING ENGINEERS

WALSH CONSTRUCTION COMPANY
A DIVISION OF GUY F. ATKINSON CO.
DARIEN, CONNECTICUT

SHEET TITLE
ANCHORAGE DETAILS AT HINGE — EXPANSION JOINT 2

CLINE AVENUE EXTENSION OVER INDIANA HARBOR CANAL
BRIDGE FILE: 912-45-2546 CONTRACT NO. B-11612 INDIANA STATE HIGHWAY COMMISSION

SHEET N.
922