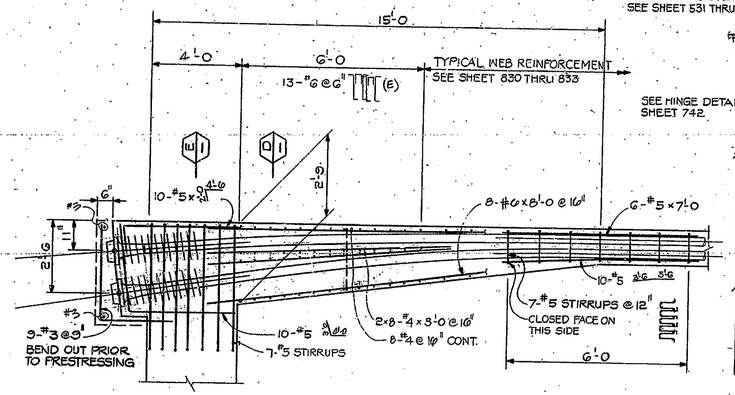

PLAN-EXTERIOR BUILDOUT (1)
1/2"=1'-0

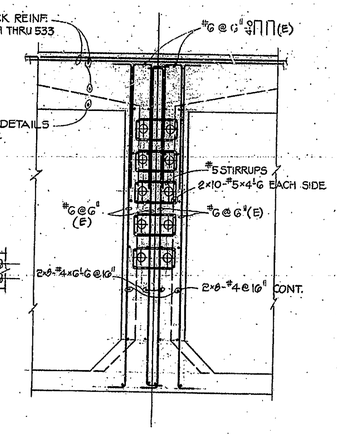

SECTION (A)
1/2"=1'-0

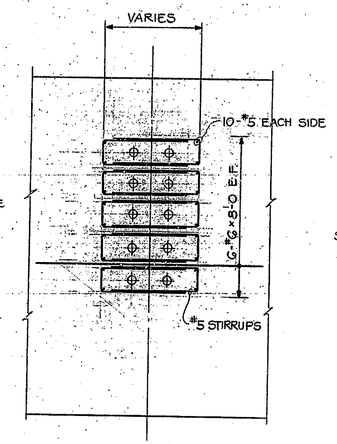

SECTION (B)
1/2"=1'-0

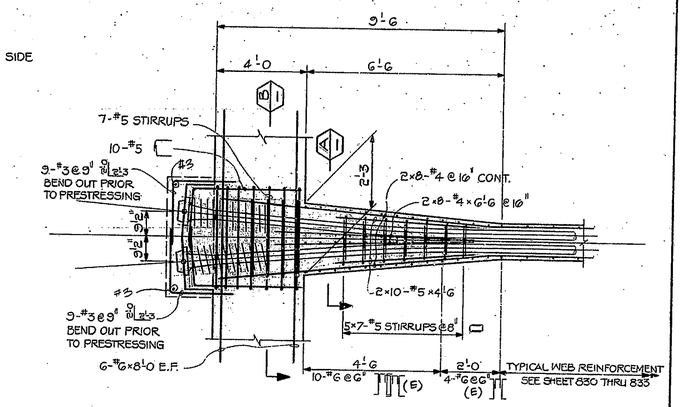

PLAN - INTERIOR BUILDOUT (2)
1/2"=1'-0

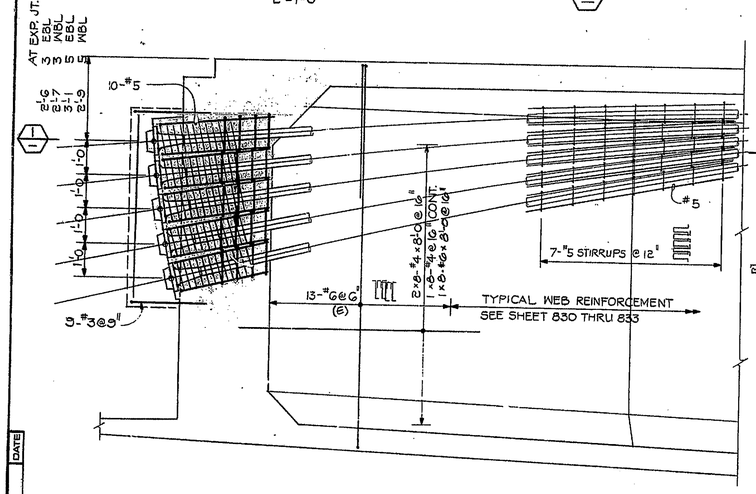

ELEVATION - EXTERIOR BUILDOUT
1/2"=1'-0

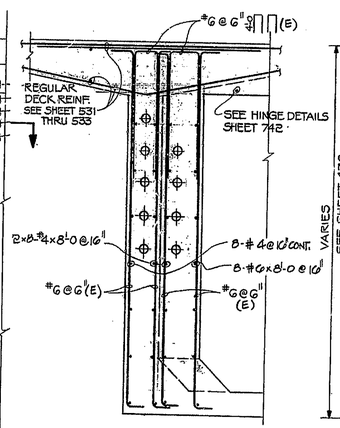

SECTION (D)
1/2"=1'-0

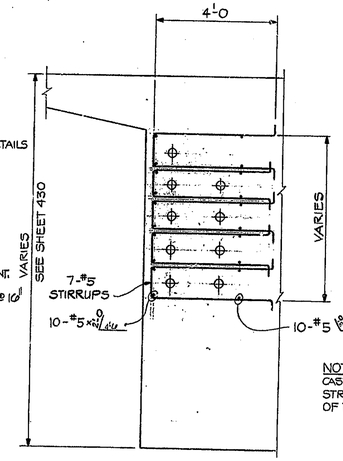

SECTION (E)
1/2"=1'-0

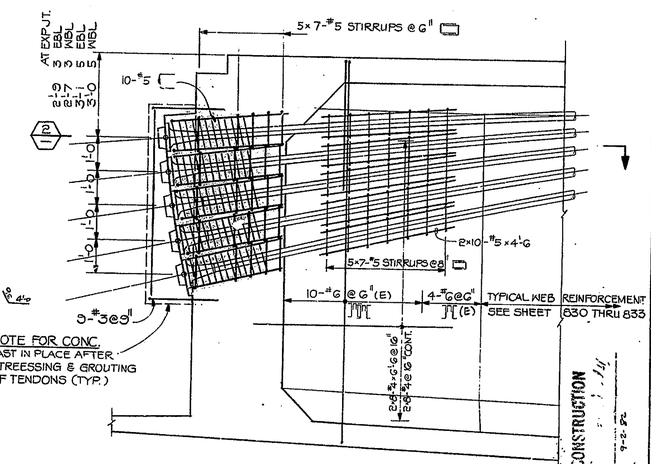

ELEVATION - INTERIOR BUILDOUT
1/2"=1'-0

NOTE:
AS BUILT. THIS SHEET IS SUPERCEDED BY SHEET 930A. (1)

NOTE
1. BARS IN TOP DECK SLAB ARE EPOXY COATED.

APPROVED FOR CONSTRUCTION
J. P. Phillips
4-2-82
DATE
CHIEF ENGINEER

NO	REVISION	DATE
1	CROSS-REF NOTE	DEC. '81

T. Y. LIN INTERNATIONAL
STRUCTURAL ENGINEERS

REID, QUEBE, ALLISON, WILCOX AND ASSOCIATES INC.
CONSULTING ENGINEERS

T. Y. Lin

WALSH CONSTRUCTION COMPANY
A DIVISION OF GUY F. ATKINSON CO.
DARIEN, CONNECTICUT

SHEET TITLE
PRESTRESSING DETAILS - ANCHORAGE AT EXPANSION JOINTS 3 & 5.

CLINE AVENUE EXTENSION OVER INDIANA HARBOR CANAL
BRIDGE FILE: 912-45-2546 CONTRACT NO. 8-11812
INDIANA STATE HIGHWAY COMMISSION

SHEET N.
930