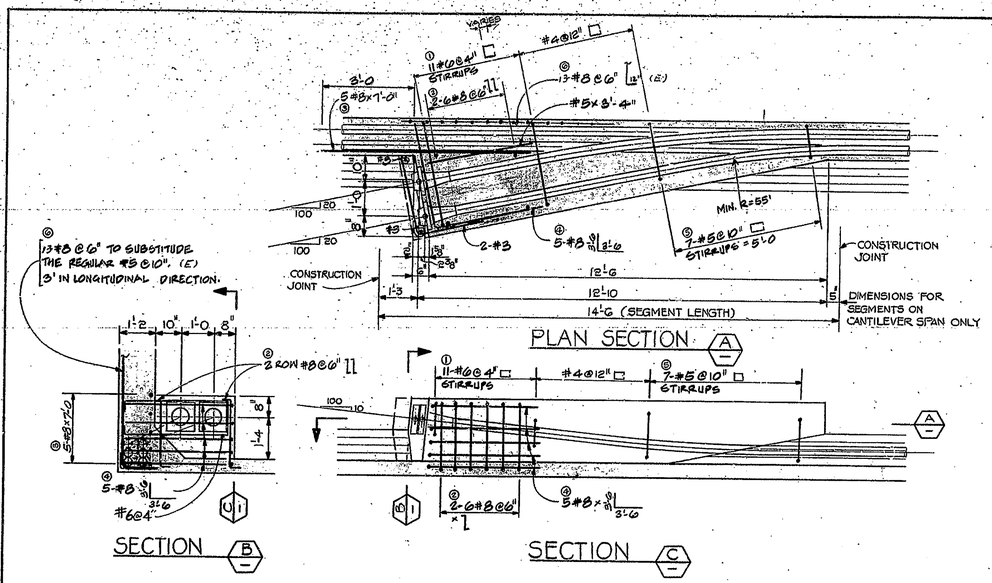

TYPICAL DETAILS OF 2 BOTTOM ANCHORAGES — EXTERIOR WEB
1/2" = 1'-0

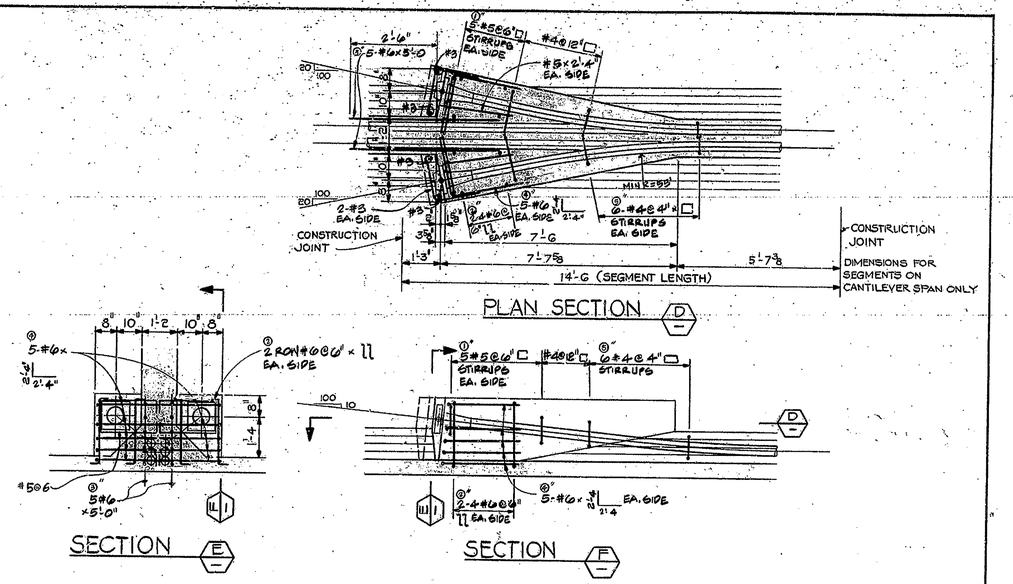

TYPICAL DETAILS OF 2 BOTTOM ANCHORAGES — INTERIOR WEB
1/2" = 1'-0

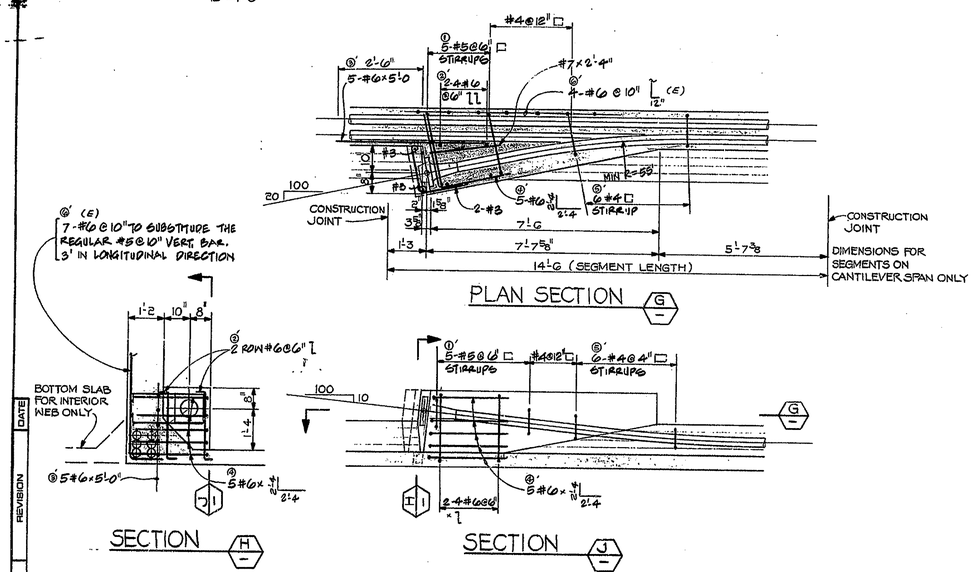

TYPICAL DETAILS OF 1 BOTTOM ANCHORAGE — EXTERIOR & INTERIOR WEB
1/2" = 1'-0

NOTES:

1. THE SPIRAL NEAR THE TRUMPET ARE NOT SHOWN ON THE DWG.
2. REQUIRE SUBMITTAL AND APPROVAL OF REINFORCING DETAIL BEFORE COMMENCING WORK.

NOTE:
AS BUILT. THIS SHEET IS SUPERCEDED BY SHEET 933A.

APPROVED FOR CONSTRUCTION
J.D. MATTIS 9-7-82
Engineer of Bridge Plans

NO.	REVISION	DATE
1	CROSS-REF. NOTE	DEC. '81

T. Y. LIN INTERNATIONAL
STRUCTURAL ENGINEERS

REID, QUEBE, ALLISON, WILCOX AND ASSOCIATES INC.
CONSULTING ENGINEERS

WALSH CONSTRUCTION COMPANY
A DIVISION OF GUY F. ATKINSON CO.
DARIEN, CONNECTICUT

SHEET TITLE
PRESTRESSING DETAILS - BOTTOM ANCHORAGE DETAILS 3 SEGMENT 3

CLINE AVENUE EXTENSION OVER INDIANA HARBOR CANAL
BRIDGE FILE: 912-45-2546 CONTRACT NO. B-11812
INDIANA STATE HIGHWAY COMMISSION

SHEET N.
933