

**INDIANA
DEPARTMENT OF
TRANSPORTATION**

**BRIDGE PLANS
FOR SPANS OVER 20 FEET
ON
STATE ROAD NO. 54
PROJECT NO. ST. -056-5(L)**


THIS STRUCTURE IS LOCATED ON S.R. 54 OVER RICHLAND CREEK
APPROXIMATELY 1.66 MILES EAST OF JUNCTION WITH S.R. 157.
@ R.P. 39+46

BRIDGES OVER 20' SPAN					
FEDERAL REGION NO.	STATE	PROJECT NO.	FISCAL YEAR	SHEET NO.	TOTAL SHEETS
5	IND.	ST. -056-5(L)	19	1	30

INDEX					
PROJECT	STRUCTURE	TYPE	SPAN	OVER	STATION
ST. -056-5(L)	54-28-6005A	CONTINUOUS PLATE GIRDER	1 @ 83'-6" 1 @ 100'-6" 1 @ 83'-6"	RICHLAND CREEK	

SHEET NO.	SHEET DESIGNATION	SUBJECT	F.H.W.A. APPROVAL
1		INDEX AND TITLE SHEET	
2		TRAFFIC MAINTENANCE DETAIL	
3		GENERAL PLAN AND CONCRETE BRIDGE RAIL DETAILS	
4		BENT NO. 1 & BENT NO. 4 DETAILS AND R.C. BRIDGE APPROACH DETAIL	
5		SUPERSTRUCTURE DETAILS	
6-30		STANDARD DRAWINGS	

INDEX CONTINUED					
STANDARD		DRAWINGS		F.H.W.A. APPROVAL	ADOPTED "A" REVISION "N"
SHEET NO.	SHEET DESIGNATION	SUBJECT			
6	BRIDGE STD. BR1	CONCRETE BRIDGE RAILING TRANSITION TYPE T&B		03-09-93	A AUG 1992
7	BRIDGE STD. BR1A	CONCRETE BRIDGE RAILING TRANSITION TYPE T&B		03-09-93	A AUG 1992
	BRIDGE STD. BR3	STEEL BRIDGE RAILING			
	BRIDGE STD. BR4	STEEL BRIDGE RAILING DETAILS			
	BRIDGE STD. BR5	RAILING CONNECTION DETAILS			
8	BRIDGE STD. C1	MISCELLANEOUS DETAILS		01-26-93	A DEC 1992
	BRIDGE STD. C2	MISCELLANEOUS DETAILS			
9	BRIDGE STD. C3	MISCELLANEOUS DETAILS		01-26-93	R 01-03-95
	BRIDGE STD. C4	MISCELLANEOUS DETAILS			
	BRIDGE STD. D	CASTING DETAILS ROADWAY DRAINS			
	BRIDGE STD. D1	ADJUSTING FRAME DETAILS FOR ROADWAY DRAINS			
	BRIDGE STD. PB	PRESTRESSED CONCRETE TYPE I-BEAMS			
	BRIDGE STD. PB	PRESTRESSED CONCRETE TYPE I-BEAMS			
	BRIDGE STD. PB6	PRESTRESSED BOX BEAMS			
	BRIDGE STD. PB	PRESTRESSED COMPOSITE BOX BEAMS WIDE			
	BRIDGE STD. PB	PRESTRESSED COMPOSITE BOX BEAMS WIDE			
	BRIDGE STD. PB10	TOLERANCES FOR FABRICATION OF PRESTRESSED BEAMS			
	BRIDGE STD. PB11	ELASTOMERIC BEARING PAD DETAILS			
	BRIDGE STD. R2A	BRIDGE LIGHTING DETAILS			
	BRIDGE STD. R2B	BRIDGE LIGHTING DETAILS			
	BRIDGE STD. S1	MISCELLANEOUS DETAILS			
	BRIDGE STD. SH1	STEEL SHOE DETAILS			
	BRIDGE STD. T SHEET A	STANDARD TEMPORARY BRIDGE			
	BRIDGE STD. T SHEET B	STANDARD TEMPORARY BRIDGE			
	BRIDGE STD.				
	BRIDGE STD.				
	BRIDGE STD.				
	BRIDGE STD.				
	BRIDGE STD.				
	ROAD STD. SHEET A	STANDARD PAVEMENT JOINTS			
	ROAD STD. SHEET B	STANDARD PAVEMENT JOINTS			
10	ROAD STD. SHEET C.C.P.J.-4	TRANSVERSE CONSTRUCTION JOINT		PENDING	R 09-01-95
	ROAD STD. SHEET	MISCELLANEOUS STANDARDS			
	ROAD STD. SHEET	MISCELLANEOUS STANDARDS			
	ROAD STD. SHEET	MISCELLANEOUS STANDARDS			
	ROAD STD. SHEET	MISCELLANEOUS STANDARDS			
	ROAD STD. SHEET	MISCELLANEOUS STANDARDS			
	ROAD STD. SHEET	MISCELLANEOUS STANDARDS			
11	ROAD STD. SHEET RCBA-1	REINFORCED CONCRETE BRIDGE APPROACH		PENDING	R 10-02-95
12	ROAD STD. SHEET RCBA-2	REINFORCED CONCRETE BRIDGE APPROACH		PENDING	R 11-01-95
	ROAD STD. SHEET	MISCELLANEOUS STANDARDS			
	ROAD STD. SHEET	MISCELLANEOUS STANDARDS			
	ROAD STD. SHEET	MISCELLANEOUS STANDARDS			
	ROAD STD. SHEET	MISCELLANEOUS STANDARDS			
	ROAD STD. SHEET	MISCELLANEOUS STANDARDS			
	ROAD STD. SHEET	MISCELLANEOUS STANDARDS			
13	ROAD STD. SHEET B-1	BRIDGE APPROACH GUARD RAIL		03-09-93	A AUG 1992
	ROAD STD. SHEET				
14	ROAD STD. SHEET E-2	GUARD RAIL END TREATMENT TYPE OS		PENDING	R 11-01-95
15	ROAD STD. SHEET E-4	CURVED W-BEAM GUARD RAIL SYSTEM		03-09-93	A AUG 1992
16	ROAD STD. SHEET E-4A	CURVED W-BEAM GUARD RAIL SYSTEM		03-09-93	A AUG 1992
17	ROAD STD. SHEET E-4B	CURVED W-BEAM GUARD RAIL SYSTEM		03-09-93	A AUG 1992
	ROAD STD. SHEET	MISCELLANEOUS STANDARDS			
18	ROAD STD. SHEET G-1	W-BEAM GUARD RAIL COMPONENTS		03-09-93	A AUG 1992
19	ROAD STD. SHEET G-2	THREE-BEAM GUARD RAIL COMPONENTS		07-20-92	A DEC 1991
20	ROAD STD. SHEET G-3	W-BEAM GUARD RAIL ASSEMBLIES		07-20-92	A DEC 1991
	ROAD STD. SHEET GR	GUARD RAIL CLASS			
	ROAD STD. SHEET GR5	ALUMINUM GUARD RAIL DETAILS			
	ROAD STD. SHEET GR6	STEEL TUBE GUARD RAIL DETAILS			
	ROAD STD. SHEET GR7	GUARD RAIL PIER CONNECTION DETAILS			
	ROAD STD. SHEET GR8	STEEL BEAM GUARD RAIL			
	ROAD STD. SHEET GR9	ALUMINUM BEAM GUARD RAIL			
	ROAD STD. SHEET GR10	GUARD RAIL BURIED ENDS			
	ROAD STD. SHEET GR10A	GUARD RAIL BREAKAWAY CABLE TERM.			
21	ROAD STD. SHEET T-1	GUARD RAIL TRANSITION TYPE T&B		03-09-93	A AUG 1992
22	ROAD STD. SHEET CB2	TEMPORARY CONCRETE BARRIER		PENDING	R 05-01-95
23	ROAD STD. SHEET CB2A	TEMPORARY CONCRETE BARRIER		01-21-94	A NOV 1993
	ROAD STD. SHEET 1 DETOURS	STANDARD DETOUR SIGNS			
	ROAD STD. SHEET 1A DETOURS	STANDARD DETOUR SIGNS			
	ROAD STD. SHEET 1B DETOURS	STANDARD DETOUR SIGNS			
	ROAD STD. SHEET 2 DETOURS	STANDARD DETOUR SIGNS			
24	ROAD STD. SHEET 2A DETOURS	STANDARD DETOUR SIGNS		PENDING	R 10-02-95
25	ROAD STD. SHEET 3 DETOURS	STANDARD DETOUR SIGNS		PENDING	R 09-01-88
26	ROAD STD. SHEET 3A DETOURS	STANDARD DETOUR SIGNS		PENDING	R 09-01-88
27	ROAD STD. SHEET 4 DETOURS	STANDARD DETOUR SIGNS		01-11-89	R 09-01-88
	ROAD STD. SHEET 5 DETOURS	STANDARD DETOUR SIGNS			
28	TRAFFIC STD. SHEET MT 3	MISCELLANEOUS STANDARDS		08-05-88	R 08-01-88
29	TRAFFIC STD. SHEET MT 18	MISCELLANEOUS STANDARDS		01-06-88	A NOV 87
30	TRAFFIC STD. SHEET MT 19	MISCELLANEOUS STANDARDS		01-06-88	A NOV 87

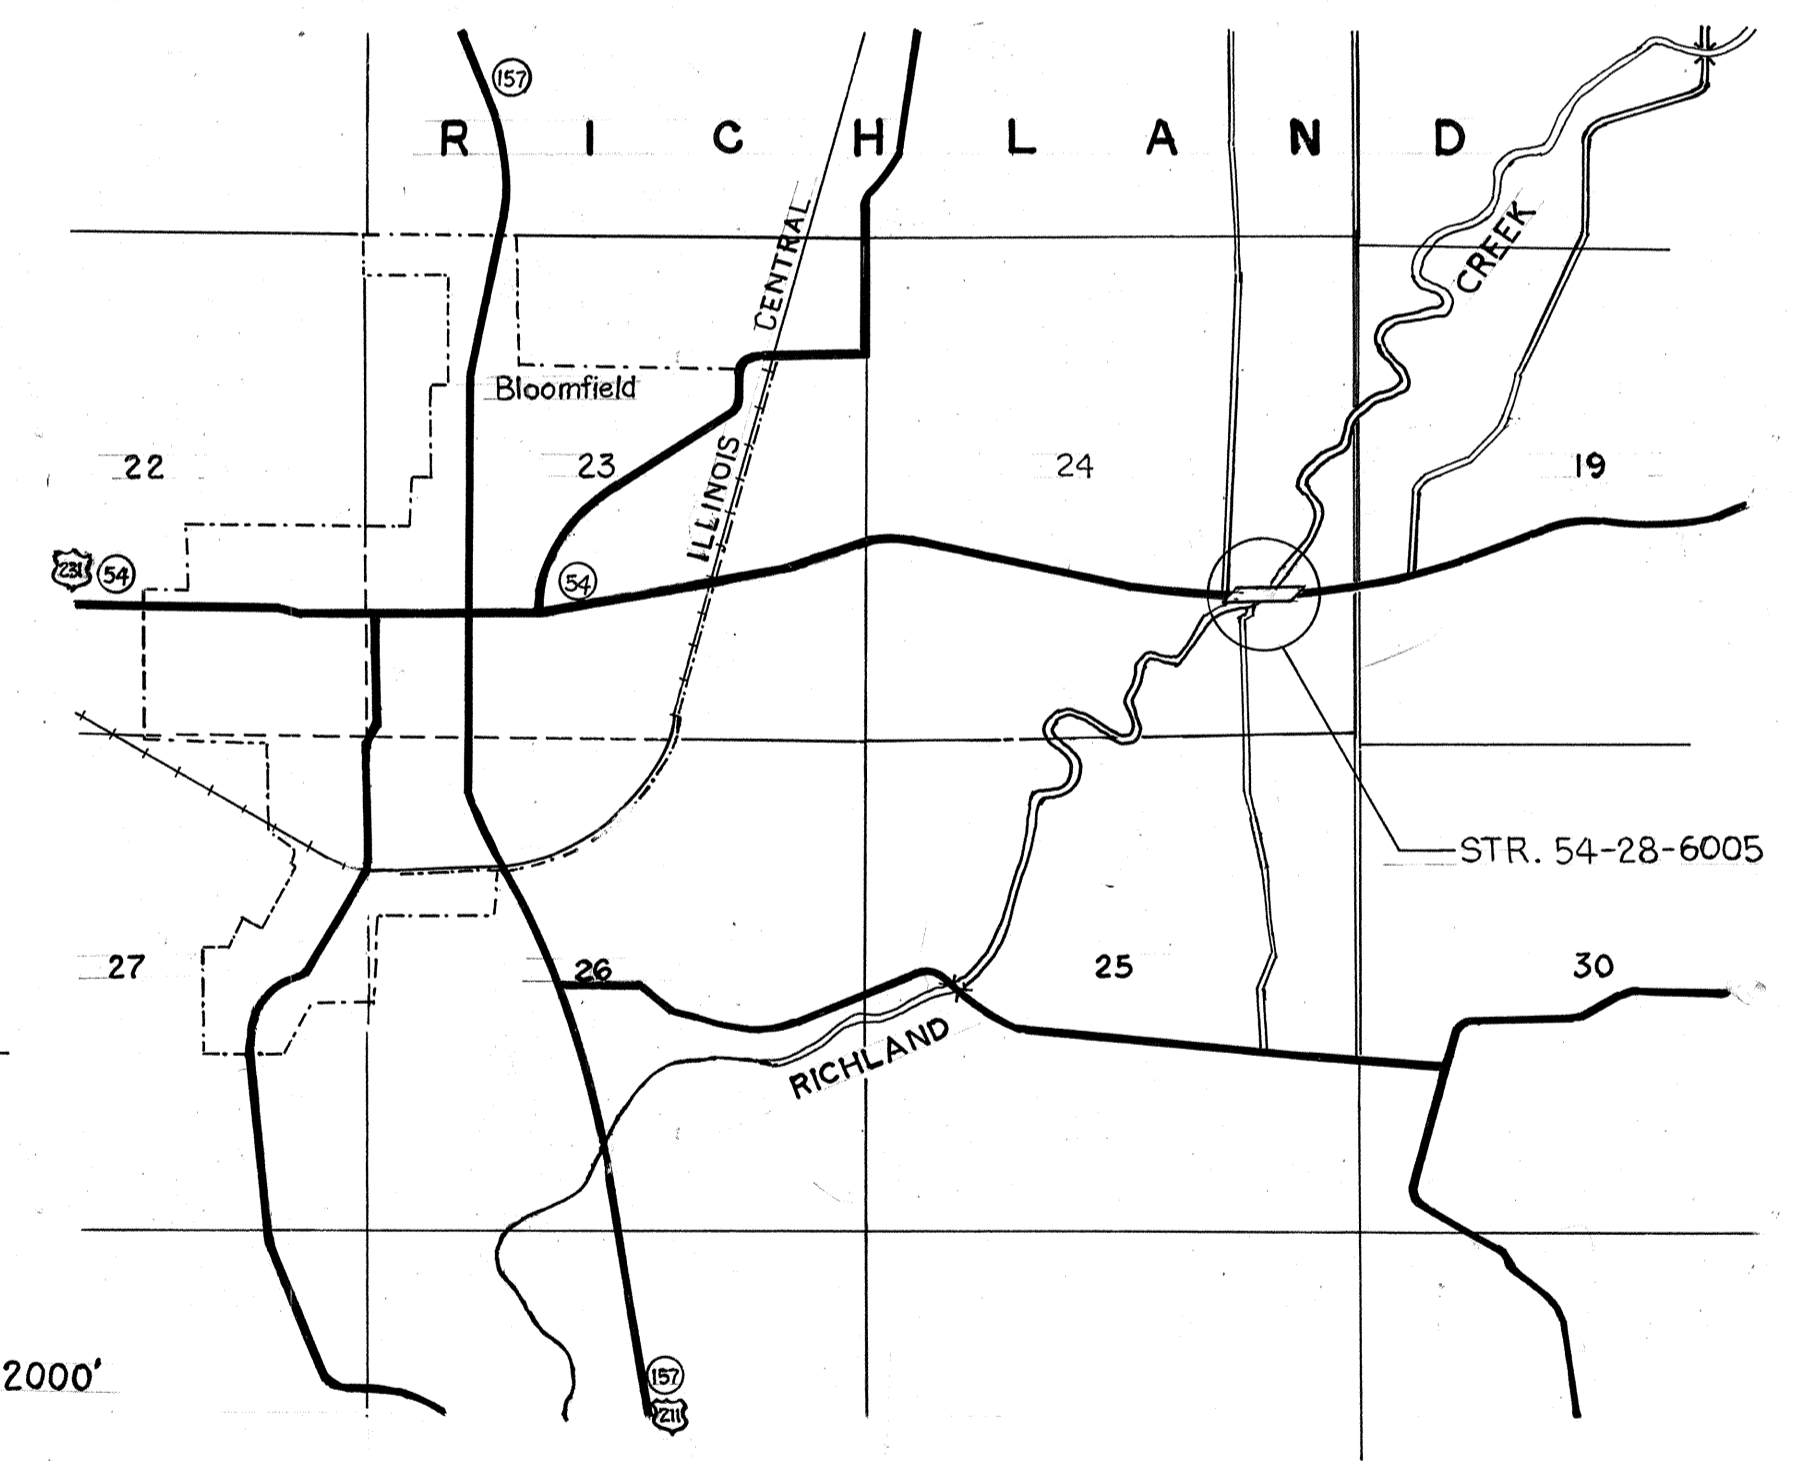

TRAFFIC DATA			
A. A. D. T. (1992)		4,910	V. P. D.
A. A. D. T. (2002) PROJECTED		6,570	V. P. D.
D. H. V. (19 PROJECTED)			V. P. D.
DIRECTIONAL DISTRIBUTION			%
TRUCKS			% D.H.V.
			% A.A.D.T.

DESIGN DATA			
DESIGN SPEED		55 M.P.H.	
PROJECT DESIGN CRITERIA		3R (NON FREEWAY)	
FUNCTIONAL CLASSIFICATION		MINOR ARTERIAL	
RURAL/URBAN		RURAL	
TERRAIN		ROLLING	
ACCESS CONTROL		NONE	

SCALE 1" = 2000'

SITUATION PLAN

B-22476

DES No. 9303820

INDIANA DEPARTMENT OF TRANSPORTATION
STANDARD SPECIFICATIONS DATED 1995
TO BE USED WITH THESE PLANS.

REVISIONS		
DATE	SHEET NO.	REVISIONS
05-01-96	1, 2	

REVISIONS		
DATE	SHEET NO.	REVISIONS

PLANS PREPARED BY:
Randall F. Strain
(317) 232-5157


APPROVED FOR LETTING:
Philip H. Kline
CHIEF, DIVISION OF DESIGN, INDIANA DEPARTMENT OF TRANSPORTATION

CERTIFIED BY:
George M. Snyder 12-27-95
BRIDGE REHABILITATION ENGINEER






FEDERAL HIGHWAY ADMINISTRATION DEPARTMENT OF TRANSPORTATION	
APPROVED:	DATE
<input type="text"/>	<input type="text"/>
DIVISION ADMINISTRATOR	

BRIDGE FILE: 54-28-6005A

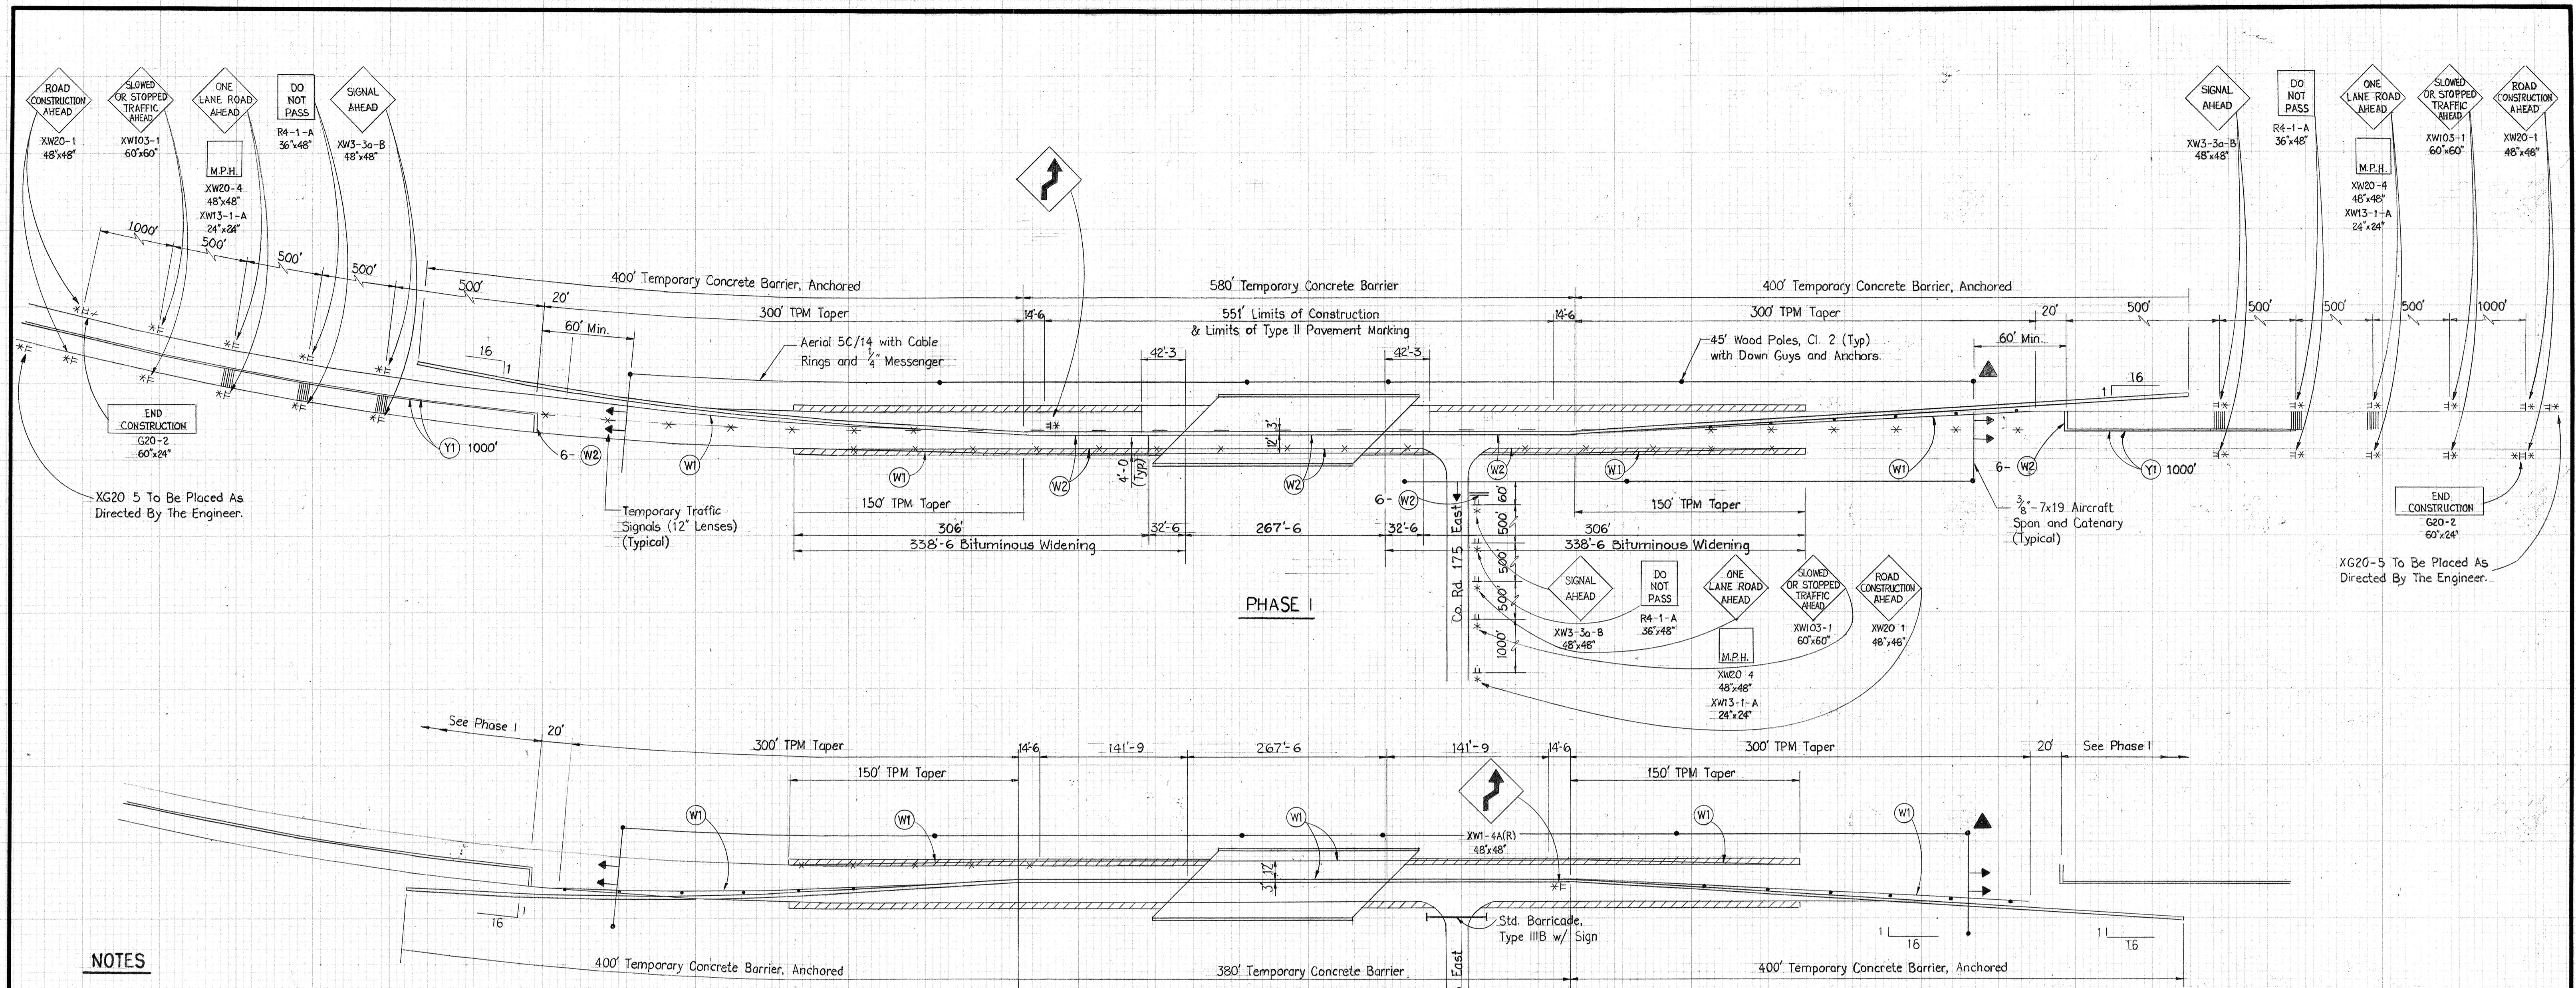

NOTES

- One lane of traffic shall be maintained on SR.54 throughout the length of the project. County Road 175 E. will remain open during the construction of Phase I only.
- 2 Lane Closure Notice Signs (XG20-5) are to be placed as directed by the Engineer.
- The existing broken, yellow, centerlines at both ends of the Structure shall be removed between the Stop Bar and the Temporary Concrete Barrier before one lane of traffic is established on the Structure.
- The existing solid, white pavement edge lines adjacent to the bituminous widening and on the bridge deck and approach pavement shall be removed from the eastbound lane prior to setting the Temporary Concrete Barrier for repair of the westbound lane in Phase I.
- The existing solid, white pavement edge lines adjacent to the bituminous widening outside the limits of the bituminous wedge placed in Phase I shall be removed prior to setting the Temporary Concrete Barrier Rail for repair of the eastbound lane in Phase II.

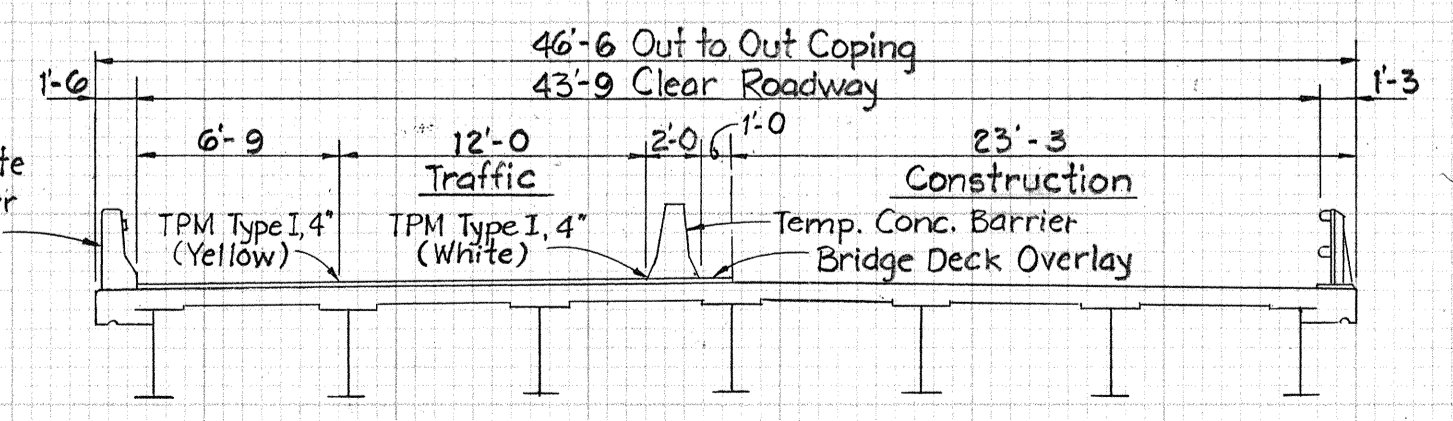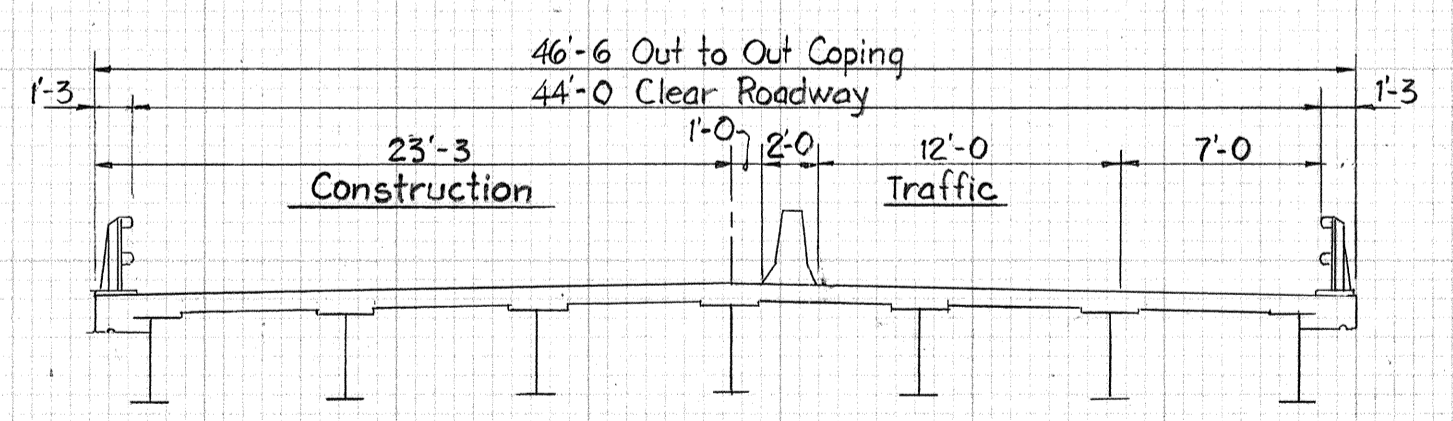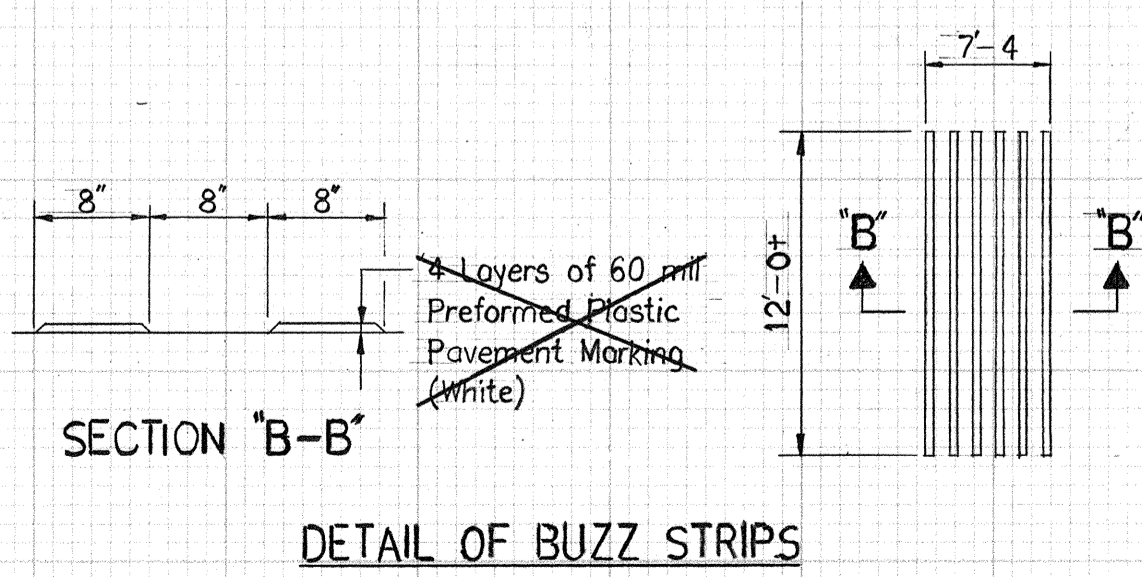

PHASE II

- LEGEND**
- Bituminous Widening to Remain in Place (See Mat'l Notes Sheet 5)
 - Temporary Concrete Barrier
 - Remove Existing Pavement Striping
 - Construction Sign Type A
 - Low Intensity Flashing Yellow Light (Type A) (Not a Pay Item)
 - Standard Drum with Type "C" Steady Burning Light (Not a Pay Item)
 - Temporary Pavement Marking Type I, White, 4"
 - Temporary Pavement Marking Type I, Yellow, 4"
 - Temporary Pavement Marking Type II, White, 4"
 - Buzz Strips. See Detail This Sheet.

CONTROLLER AND SERVICE

The Contractor is to furnish sufficient poles at 200'± spacing to reach the service point from controller. Location of controller may be changed if other service points are more accessible.
 Poles are to be placed as far as possible from the edge of pavement within the Right-of-Way.
 Controller to be controlled by Loop Detectors.

ESTIMATED QUANTITIES

Bituminous Widening*	270	Tons
Maintaining Traffic	1	LSum
Temporary Traffic Signal with Loop Detectors	1	LSum
Temporary Concrete Barrier	580	Lft.
Temporary Concrete Barrier, Anchored	800	Lft.
Construction Signs, A	33	Each
Construction Signs, B	3	Each
Temporary Pavement Marking, Type I, White, 4"	2960	Lft.
Temporary Pavement Marking, Type I, Yellow, 4"	4000	Lft.
Temporary Pavement Marking, Type II, White, 4"	1390	Lft.
Buzz Strips	4.2	Lft.
Line, Remove	1440	Lft.
Standard Barricade, Type III B with Sign	2	Each

* Included in the pay item "Bituminous Mixture for Approaches, MV"

PERMANENT PAVEMENT MARKINGS

Line, Point, Solid, White, 4"	1865	Lft.
Line, Point, Broken, Yellow, 4"	305	Lft.
Snowplowable Raised Pavement Marker	7	Each

TRAFFIC MAINTENANCE DETAIL
INDIANA DEPARTMENT OF TRANSPORTATION

SCALE: - NONE

DATE: -

19

SENIOR DESIGNER
 DRAWING OF SHEET 2 OF 30
 PROJECT: ST-056-5 (L) STATION: -
 BRIDGE CONTRACT NO. B-22476
 BRIDGE FILE: 54-28-6005A



DESIGNED: RFS CKD GMB 4/95
 DRAWN: CZU: 11/95 CKD RFS: 11/95
 TRACED: CKD

SF-22317

Rev: 05-01-96; Deleted Buzz Strip Detail Note

STRUCTURE BUILT ON A +0.84% GRADE

GENERAL NOTES

Plans of existing structure are on file in the Bridge Department, Indiana Department of Transportation as Bridge No. 54-28-6005.

Reinforcing Steel covering to be 2 1/2 inches in top and 1 inch min. in bottom of floor slabs and 2 inches in all other parts, unless noted.


Bevel Forms 1/4" under Copings, Chamfer Edges 1" unless noted.

For Reinforcing Bar Notes, see Br. Std. C1.


Field drilled holes in concrete shall extend to a depth required to embed a bar 6" with an approved anchor system having a minimum pullout equal to 18,400 Lbs. for #5 bars.

MATERIAL NOTE


Bridge Deck Overlay: 1 3/4" min. Portland Cement Concrete

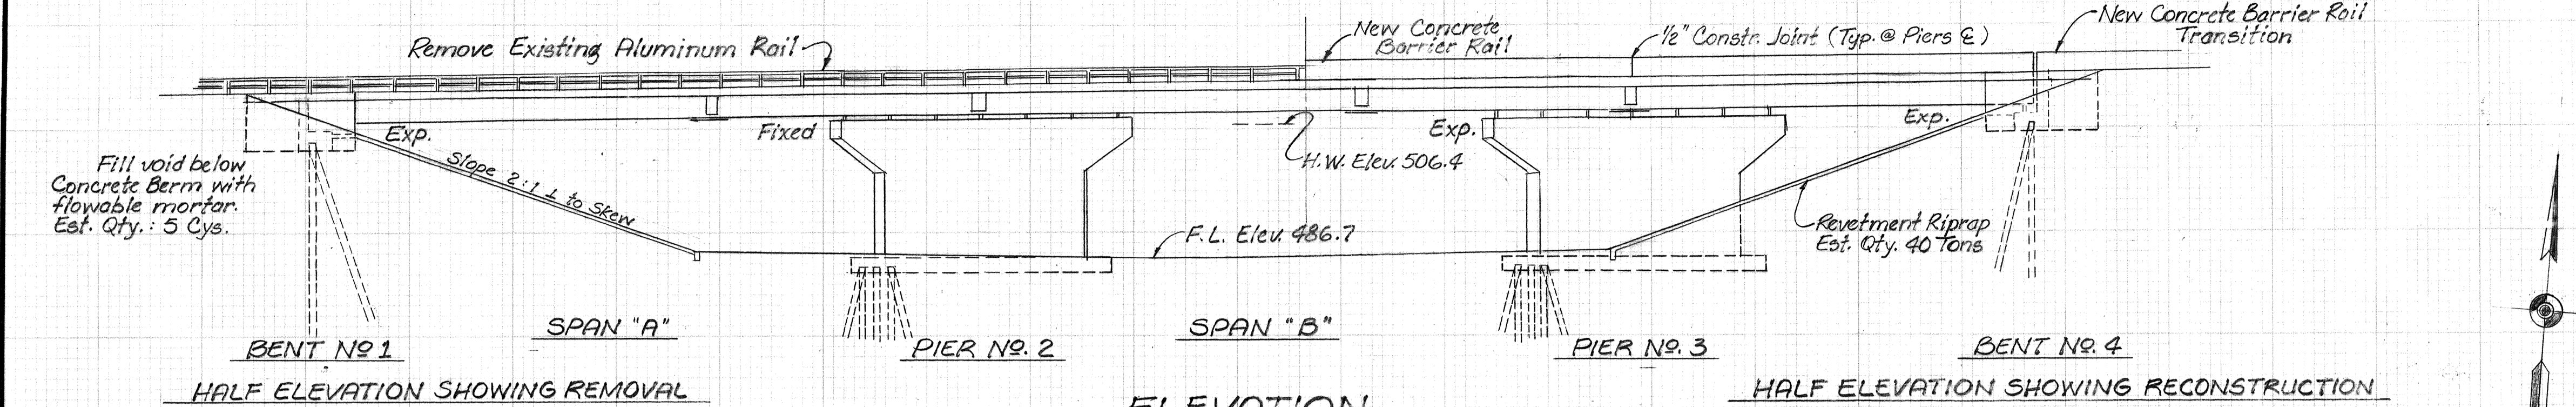


ELEVATION
Scale: 1/16" = 1'-0"

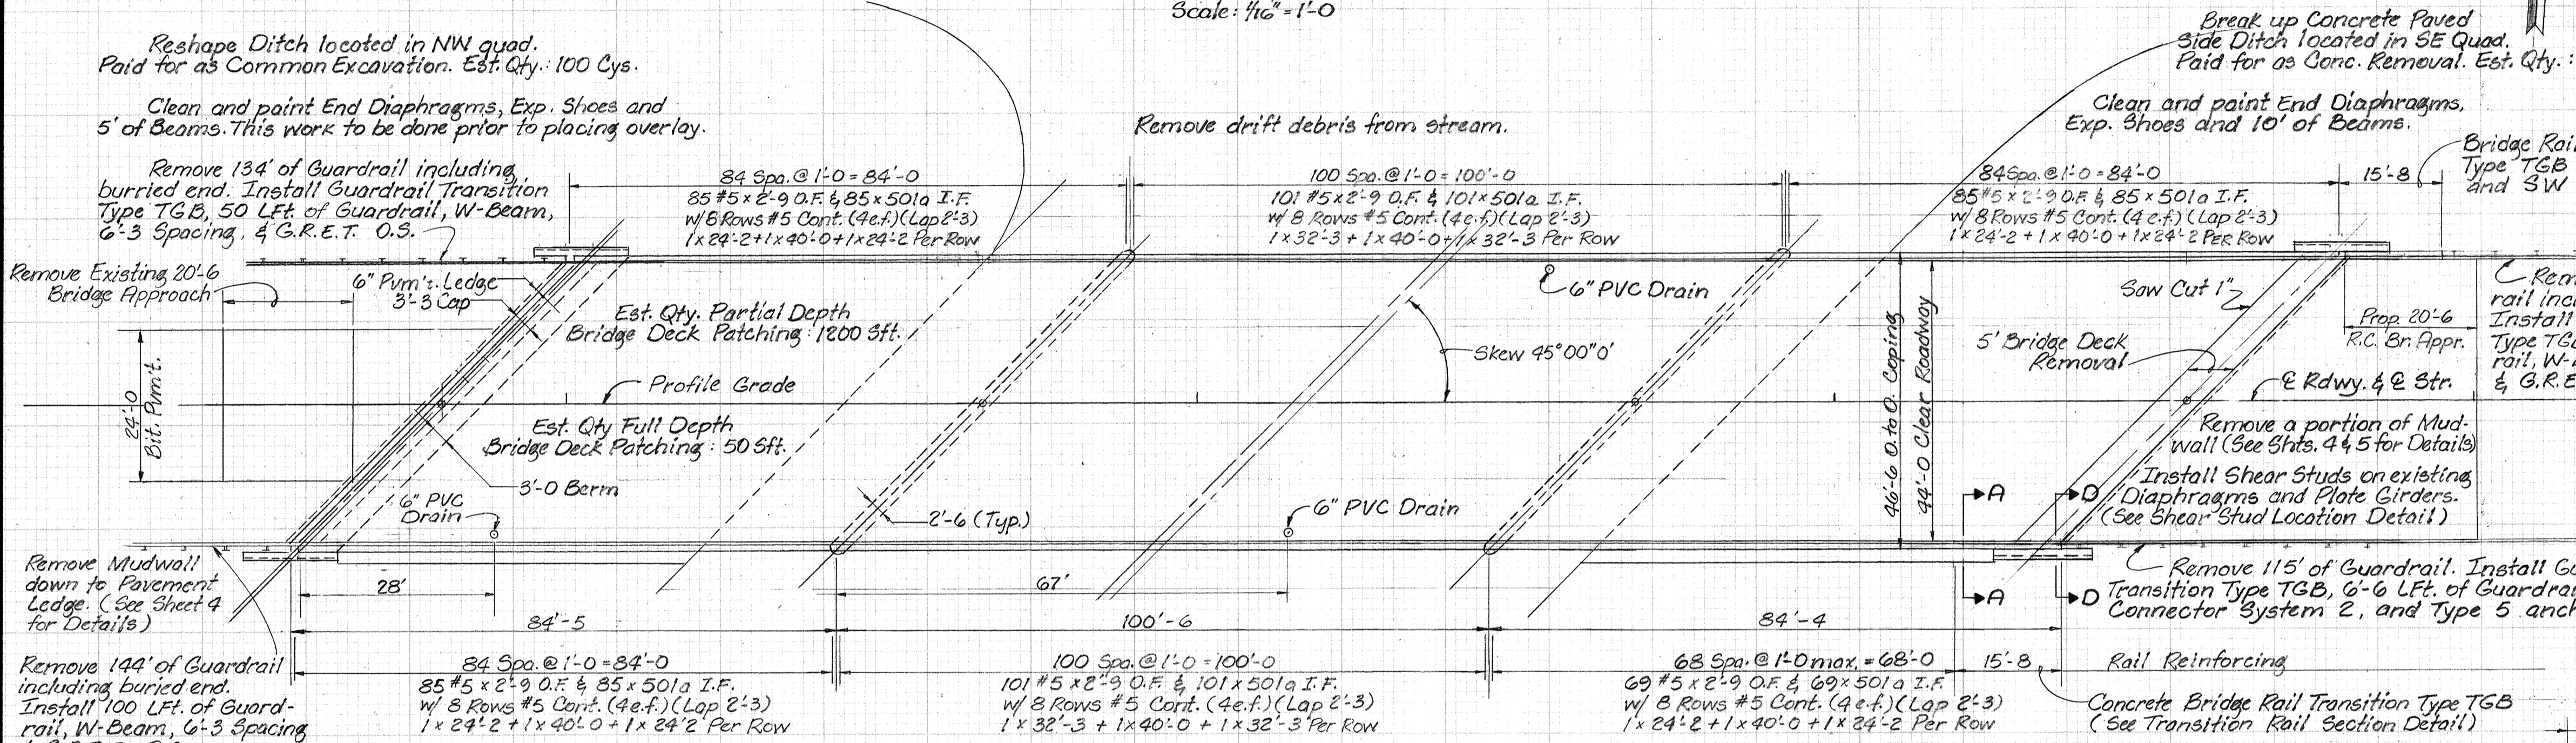


PLAN
Scale: 1/16" = 1'-0"

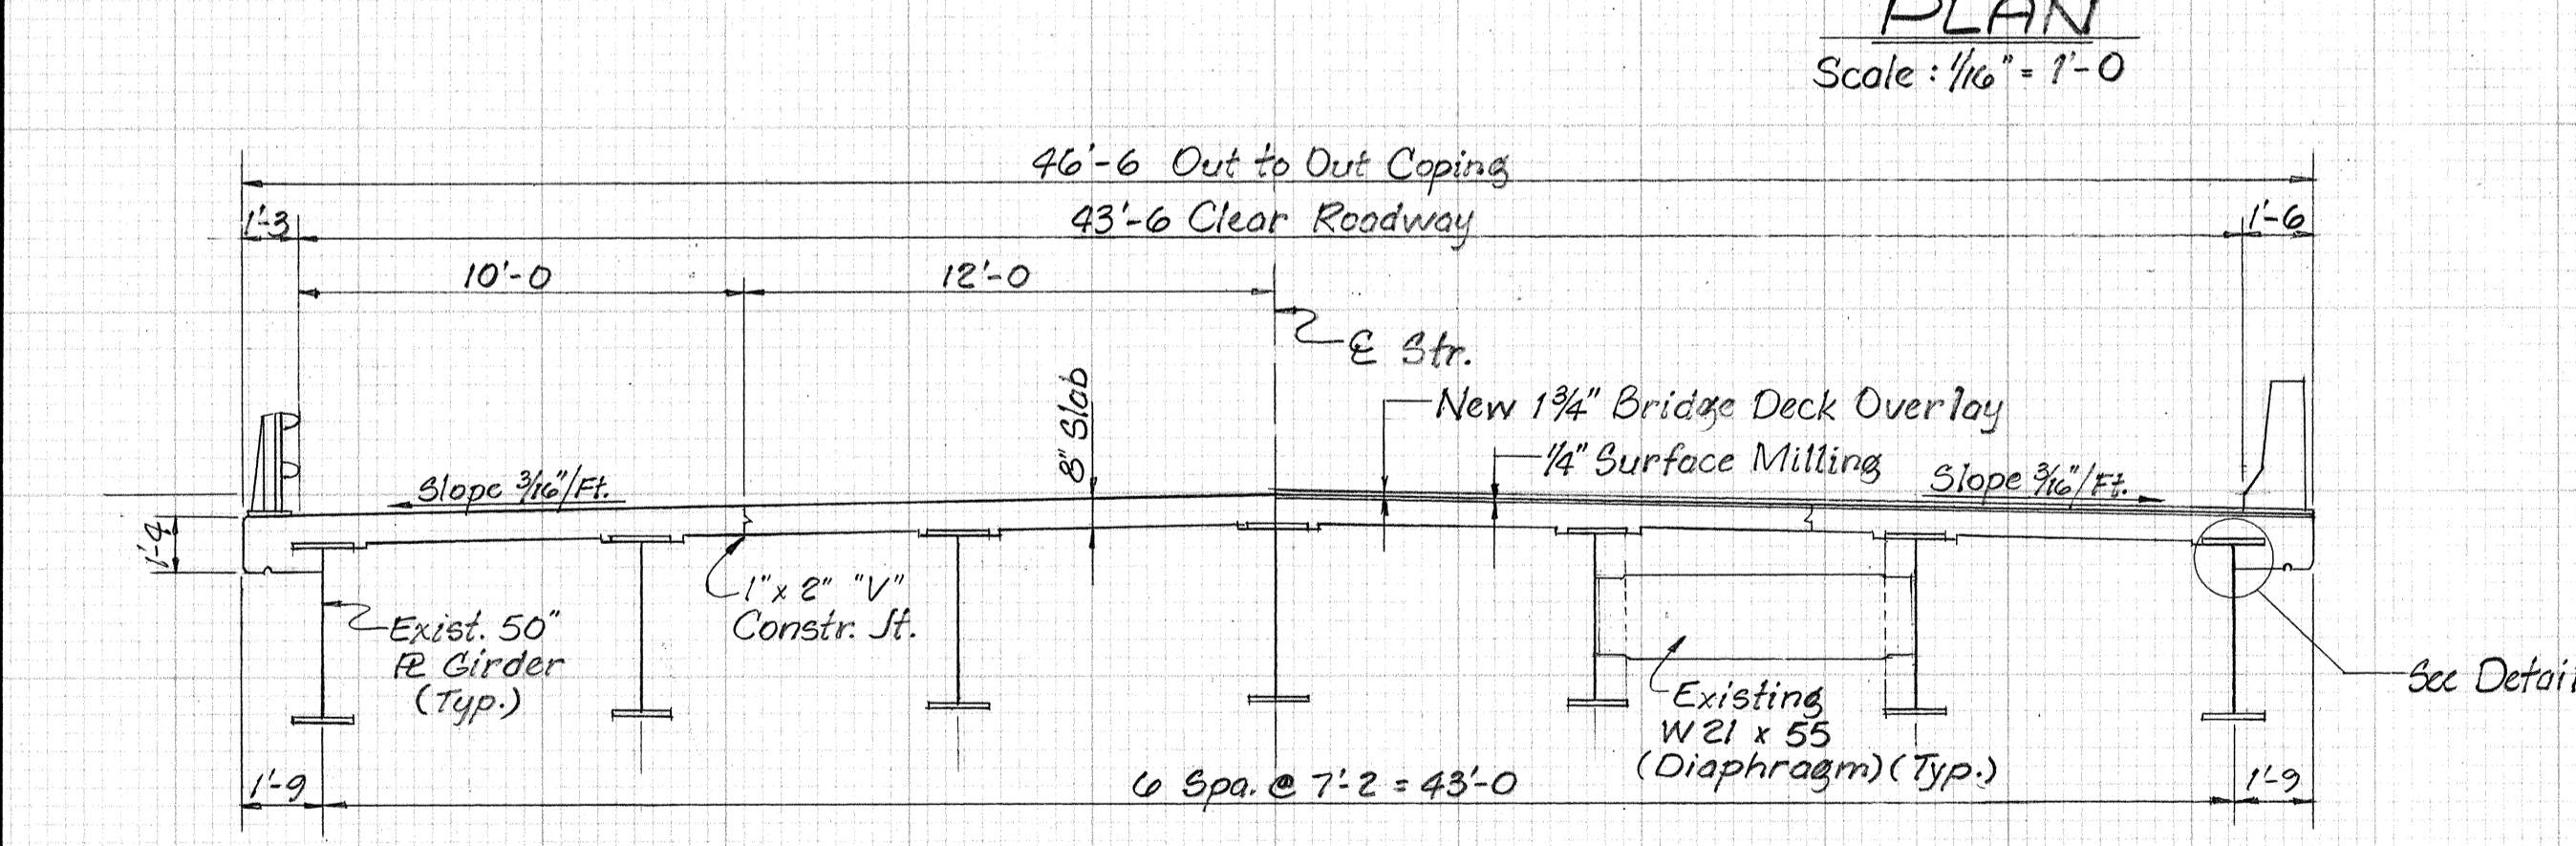


TYPICAL SECTION
Scale: 1/4" = 1'-0"

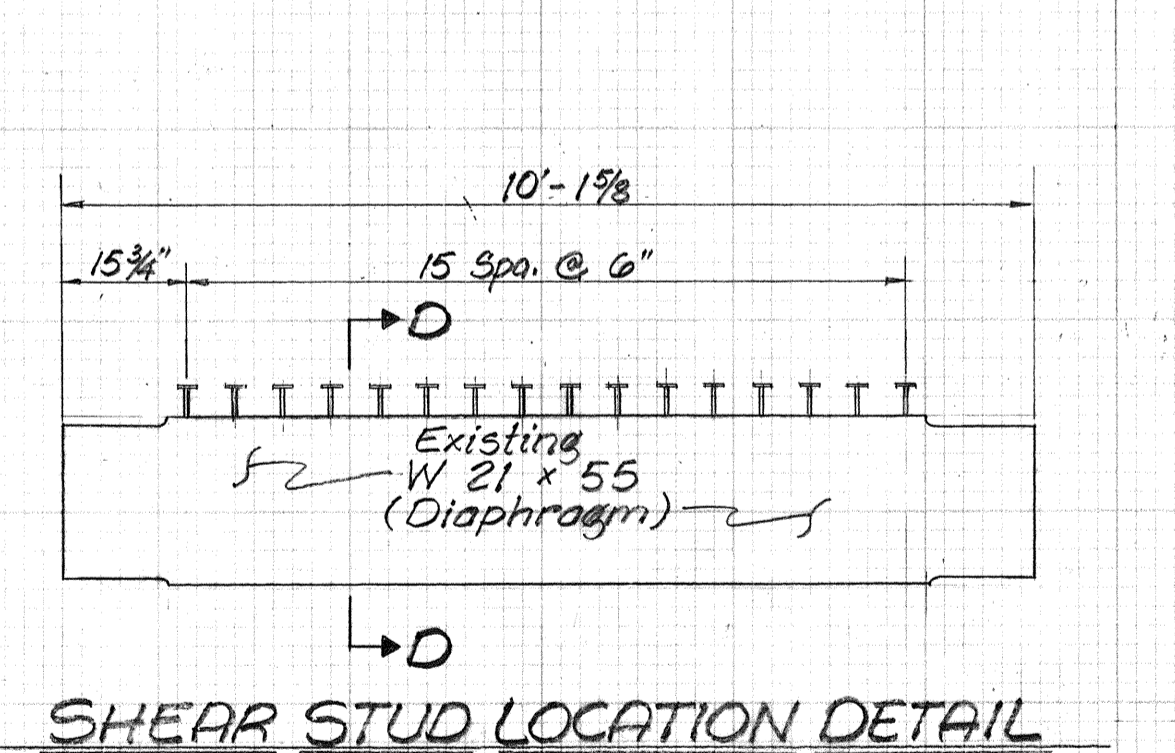


SECTION D-D
Scale: 3/4" = 1'-0"

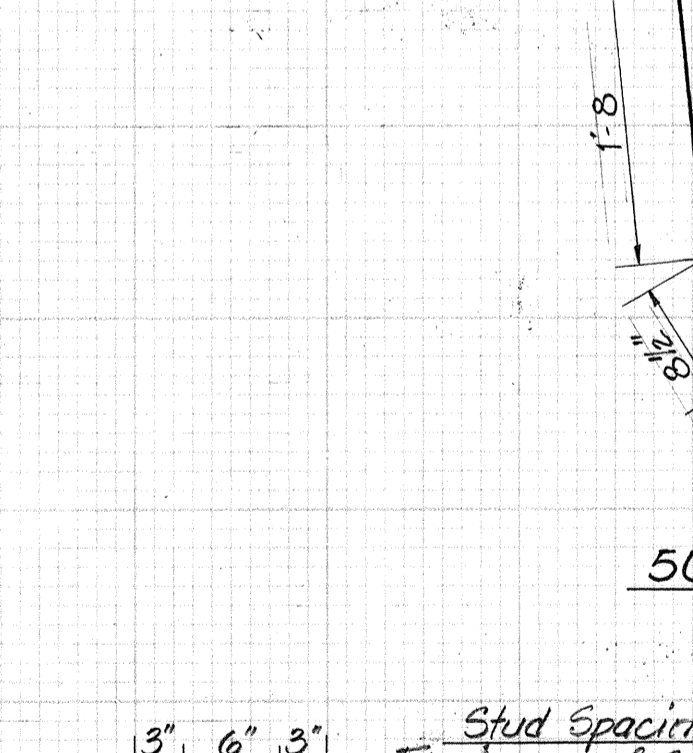

DETAIL G
Scale: 1" = 1'-0"

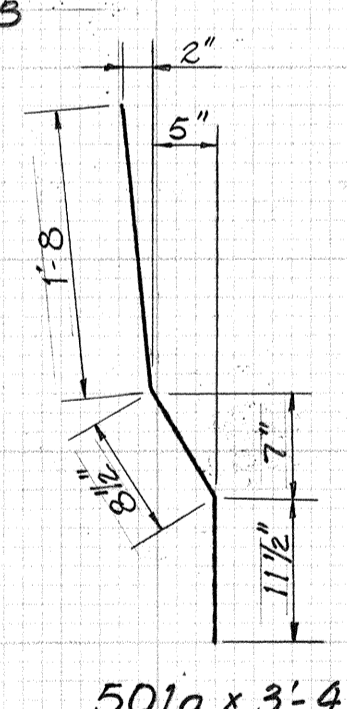


TYPICAL RAIL SECTION
Scale: 1/2" = 1'-0"

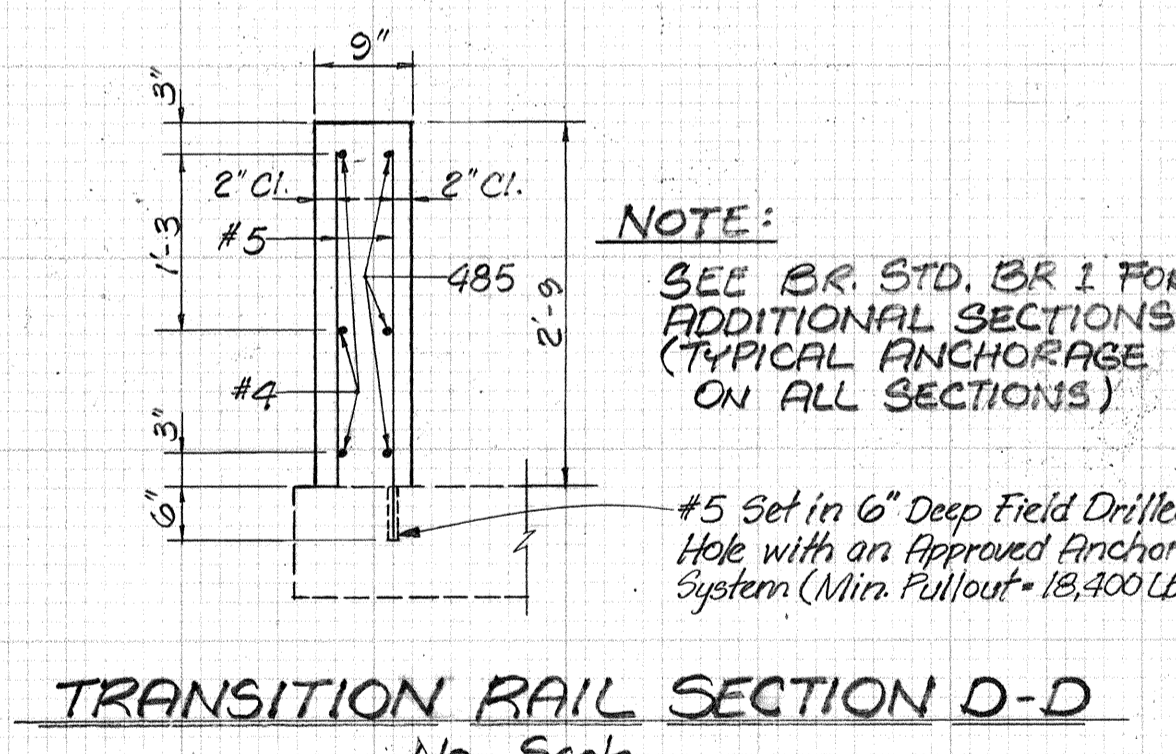

TRANSITION RAIL SECTION D-D
No Scale




GENERAL PLAN and CONCRETE BRIDGE RAIL DETAILS
INDIANA DEPARTMENT OF TRANSPORTATION

SCALE: AS NOTED DATE: 19
SENIOR DESIGNER
DRAWING OF SHEET 3 OF 30
PROJECT: ST-056-5(L) STATION: BRIDGE CONTRACT NO. 8-22476
BRIDGE FILE: 54-28-6005 A

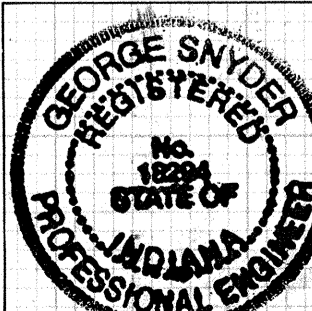




DESIGNED: RFS C.K.D. GMS & GFC
DRAWN: CZU:09/95 C.K.D. RFS
TRACED: C.K.D.

SF-22317

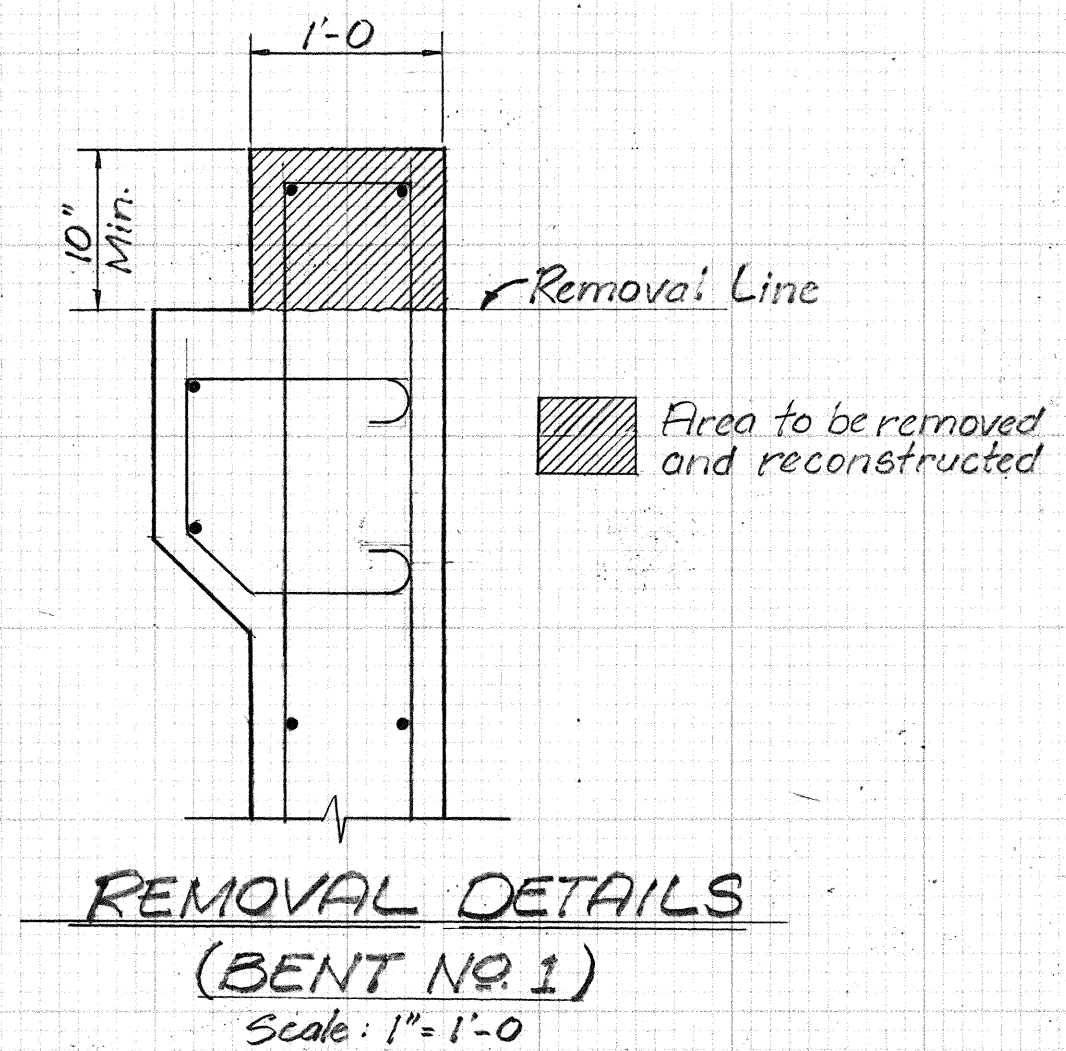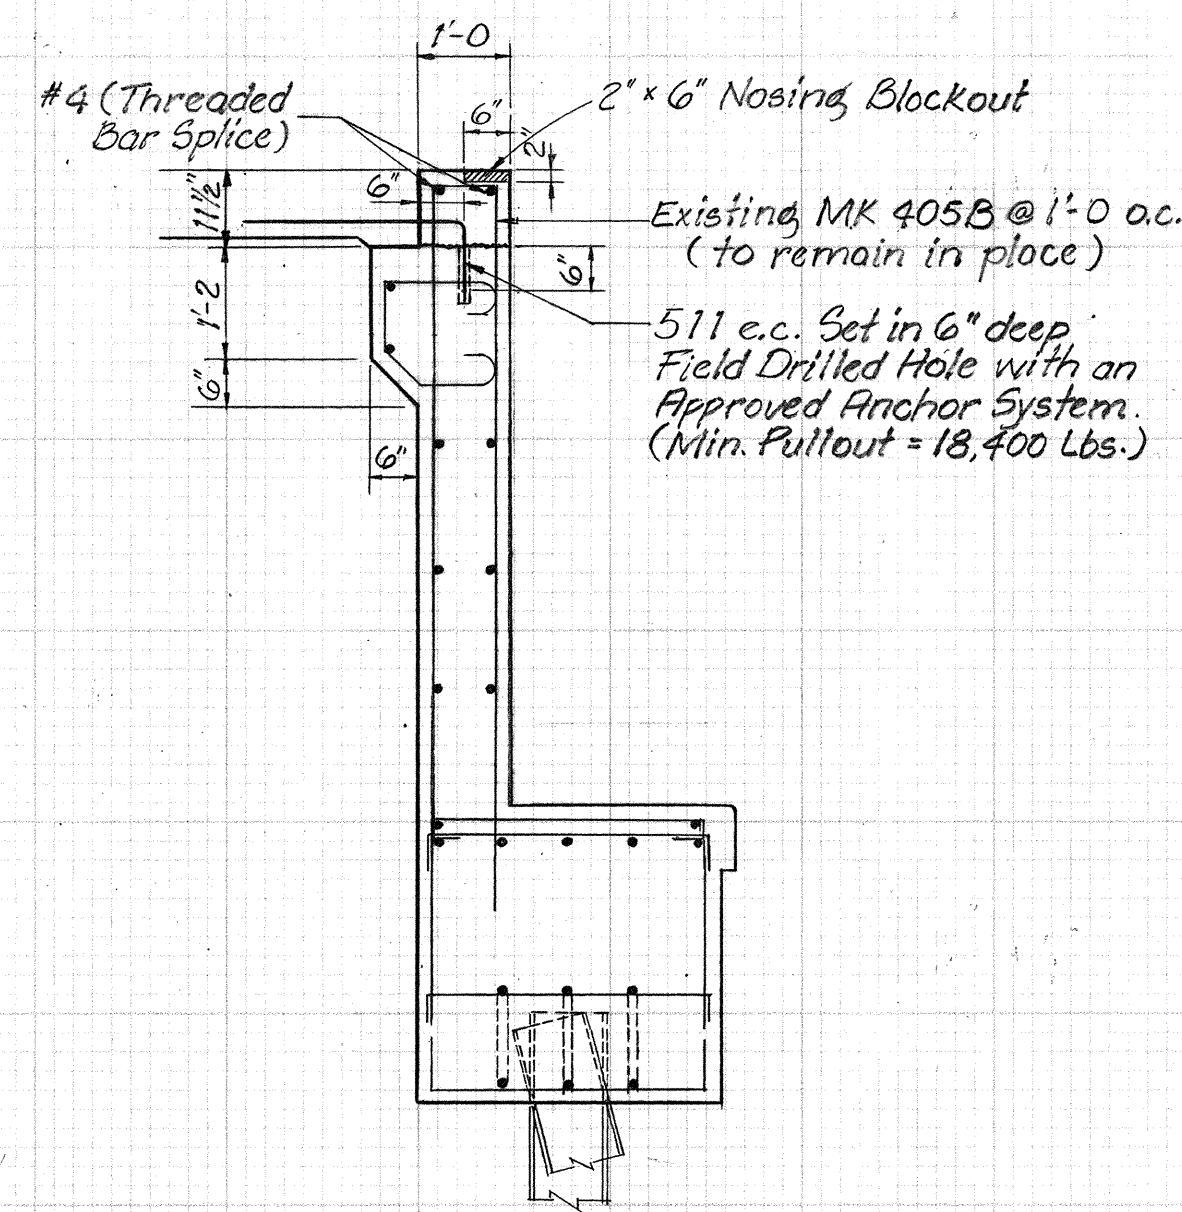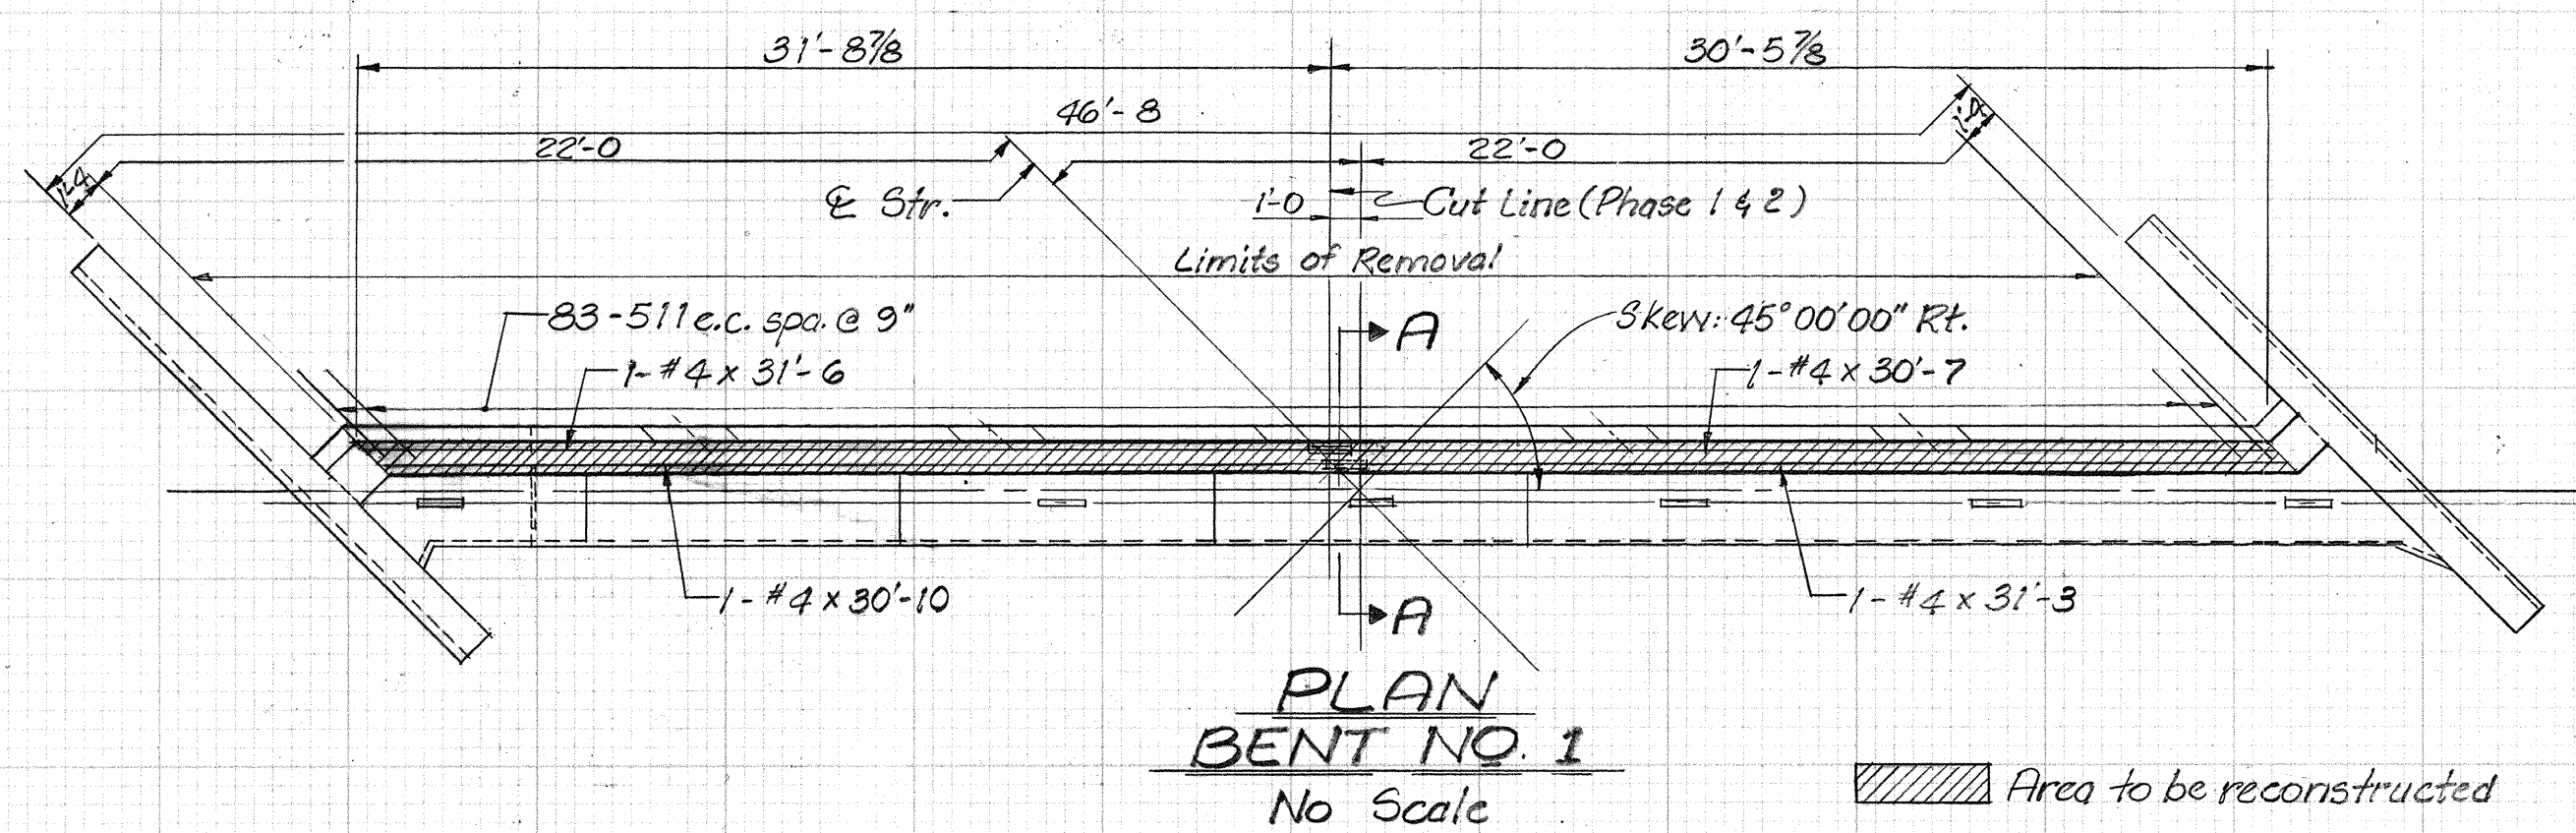




BENT NO. 1
BILL OF MATERIALS

SIZE & MARK	NO. OF BARS	LENGTH	WEIGHT (LBS.)
REINFORCING STEEL			
#4	1	31'-6	
#4	1	30'-10	
#4	1	30'-7	
#4	1	31'-3	
TOTAL #4			83
EPOXY COATED REINF. STEEL			
511 ec	83	3'-2	
TOTAL EPOXY COATED #5			274
MISCELLANEOUS			
THREADED BAR SPLICES	2 EA.		
FIELD DRILLED HOLES IN CONCRETE	83 EA.		
CONCRETE			
CLASS 'A' IN SUBSTRUCTURE	2.2 CYB.		

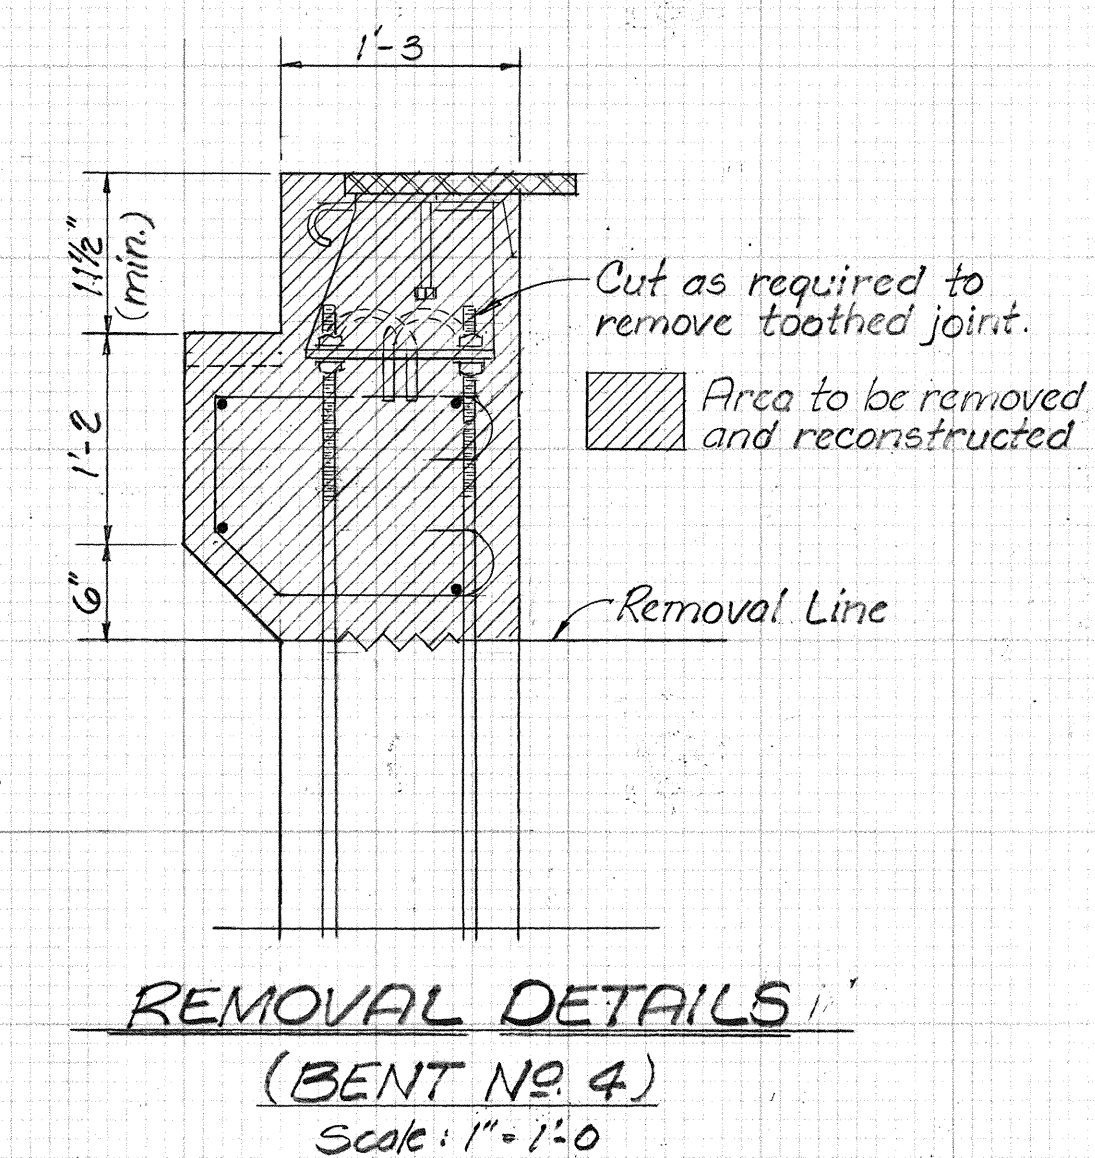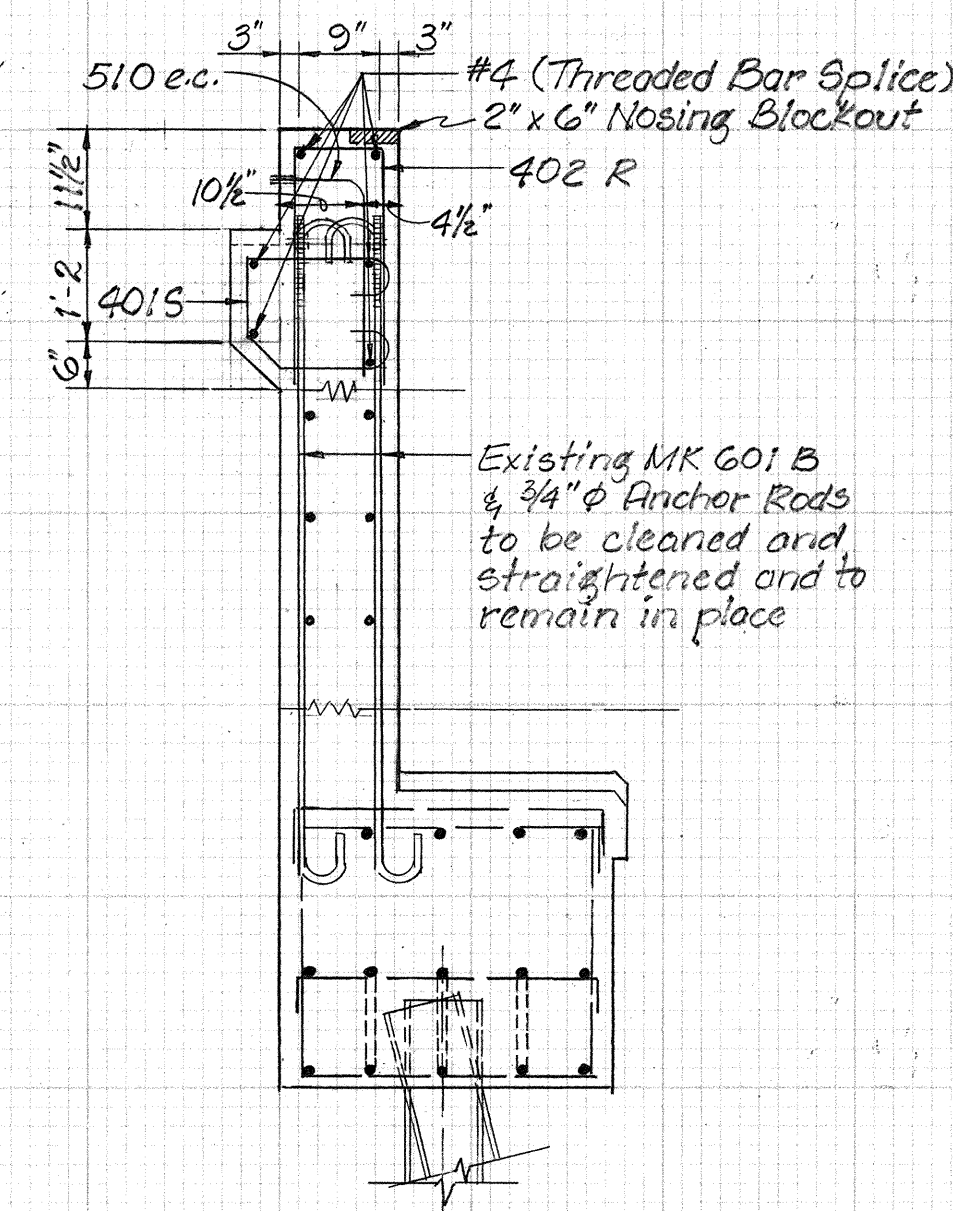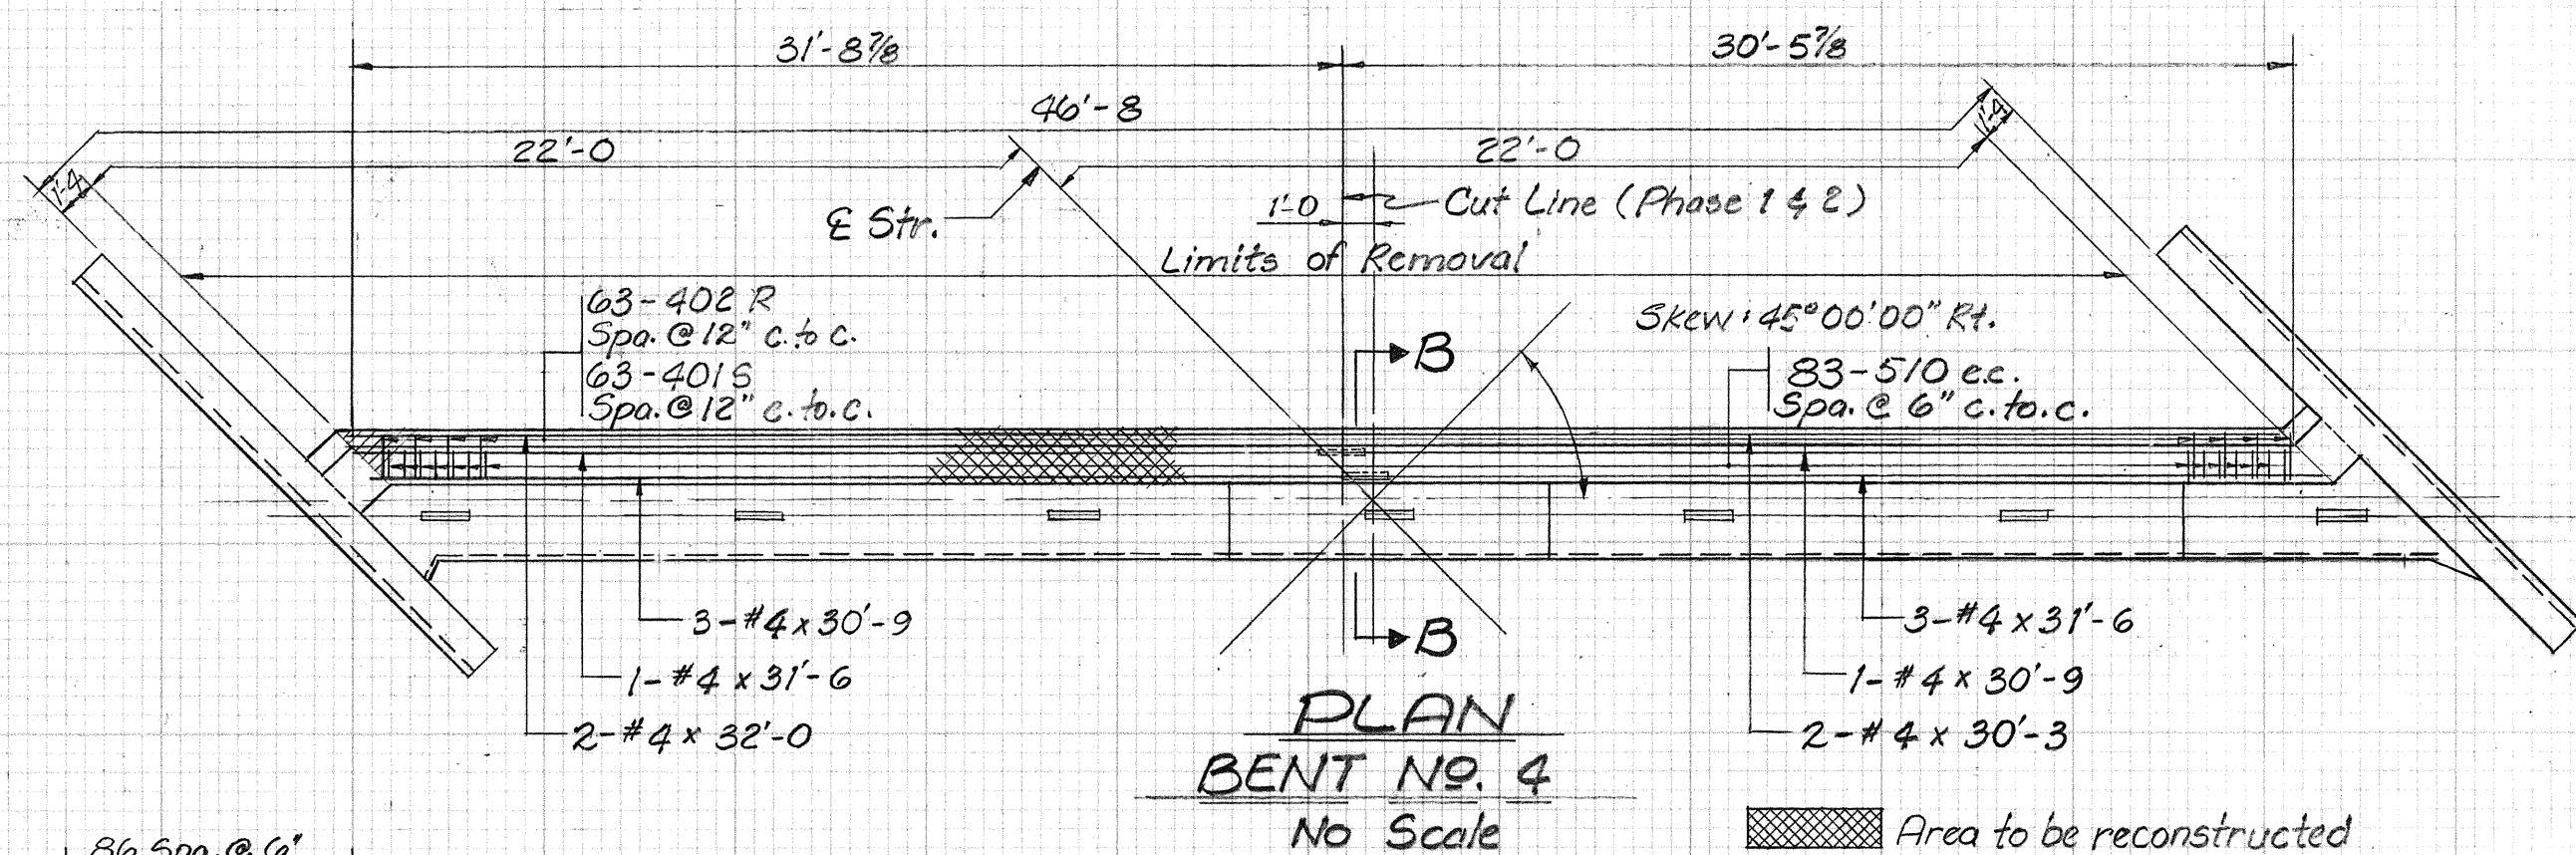


BENT NO. 4
BILL OF MATERIALS

SIZE & MARK	NO. OF BARS	LENGTH	WEIGHT (LBS.)
REINFORCING STEEL			
#4	2	32'-0	
#4	4	31'-6	
#4	4	30'-6	
#4	2	30'-3	
MK 4015	63	4'-9	
402 R	63	5'-5	
TOTAL #4			677
EPOXY COATED REINF. STEEL			
510 ec	83	2'-10	
TOTAL EPOXY COATED #5			245
MISCELLANEOUS			
THREADED BAR SPLICES	6 EA.		
CONCRETE			
CLASS 'A' IN SUBSTRUCTURE	9 CYB.		

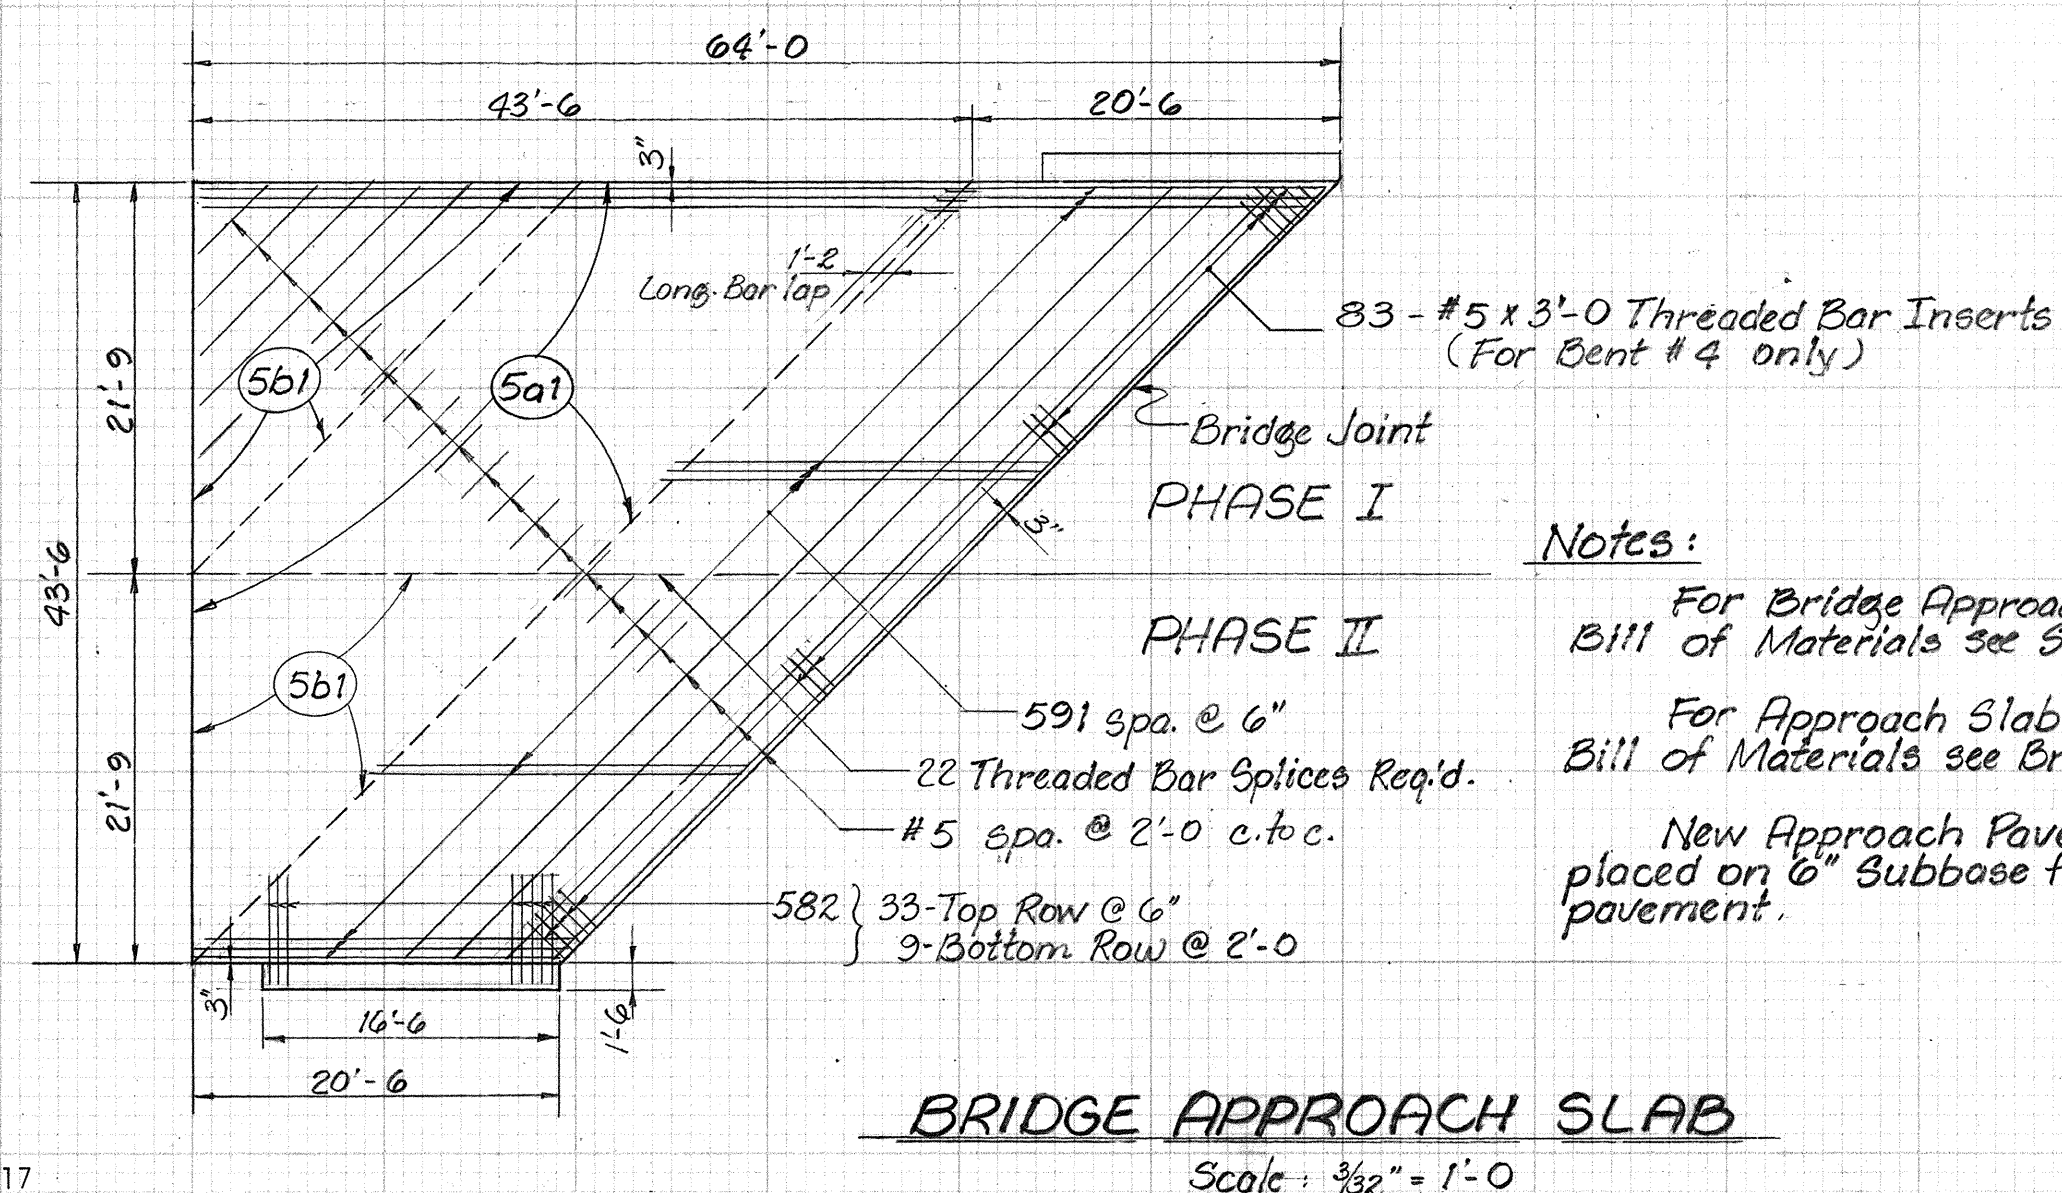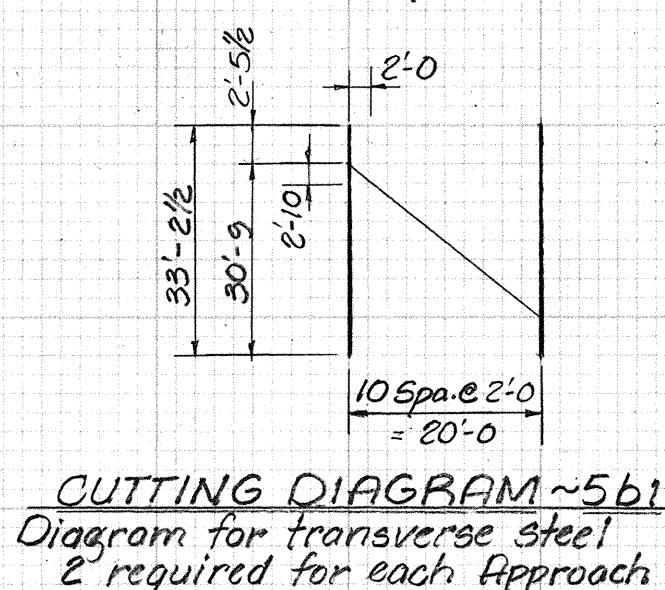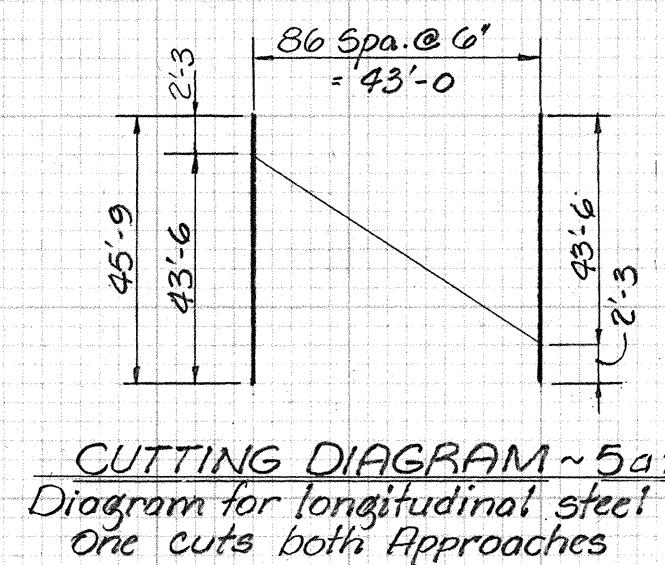

Notes:
For Bridge Approach Bill of Materials see Sheet 5.
For Approach Slab Extension Bill of Materials see Br. Std. BR-1A.
New Approach Pavements to be placed on 6" Subbase for Concrete pavement.

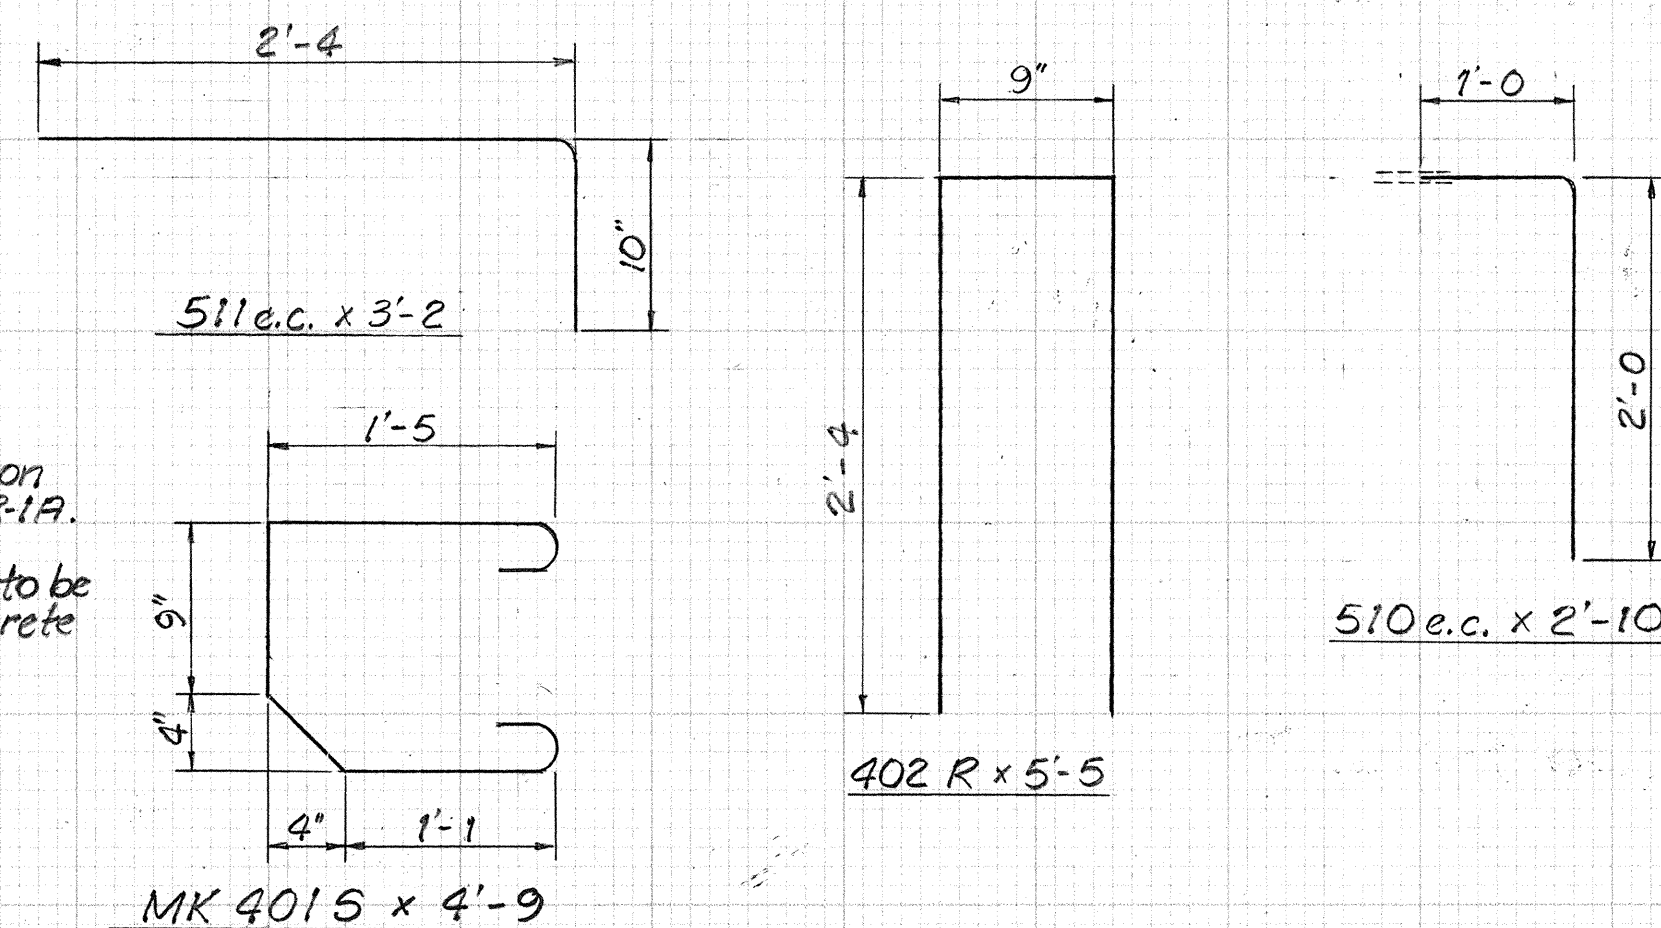

BENT NO. 1 and BENT NO. 4 DETAILS
& R.C. BRIDGE APPROACH DETAILS
INDIANA DEPARTMENT OF TRANSPORTATION


SCALE: AS NOTED

DATE: _____

19

SENIOR DESIGNER


DRAWING: OF SHEET: 4 OF 30
PROJECT: ST-056-5(L) STATION: _____
BRIDGE CONTRACT NO. B-22476
BRIDGE FILE: 54-28-6005A

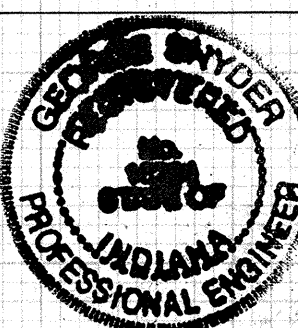


DESIGNED: RFS C.K.D. GMS & GFC
DRAWN: CZU: 08/95 C.K.D. RFS
TRACED: _____ C.K.D.

SF-22317

Note: Transverse Steel in deck along removal line of Phase I to remain in place in order to obtain E' splice.

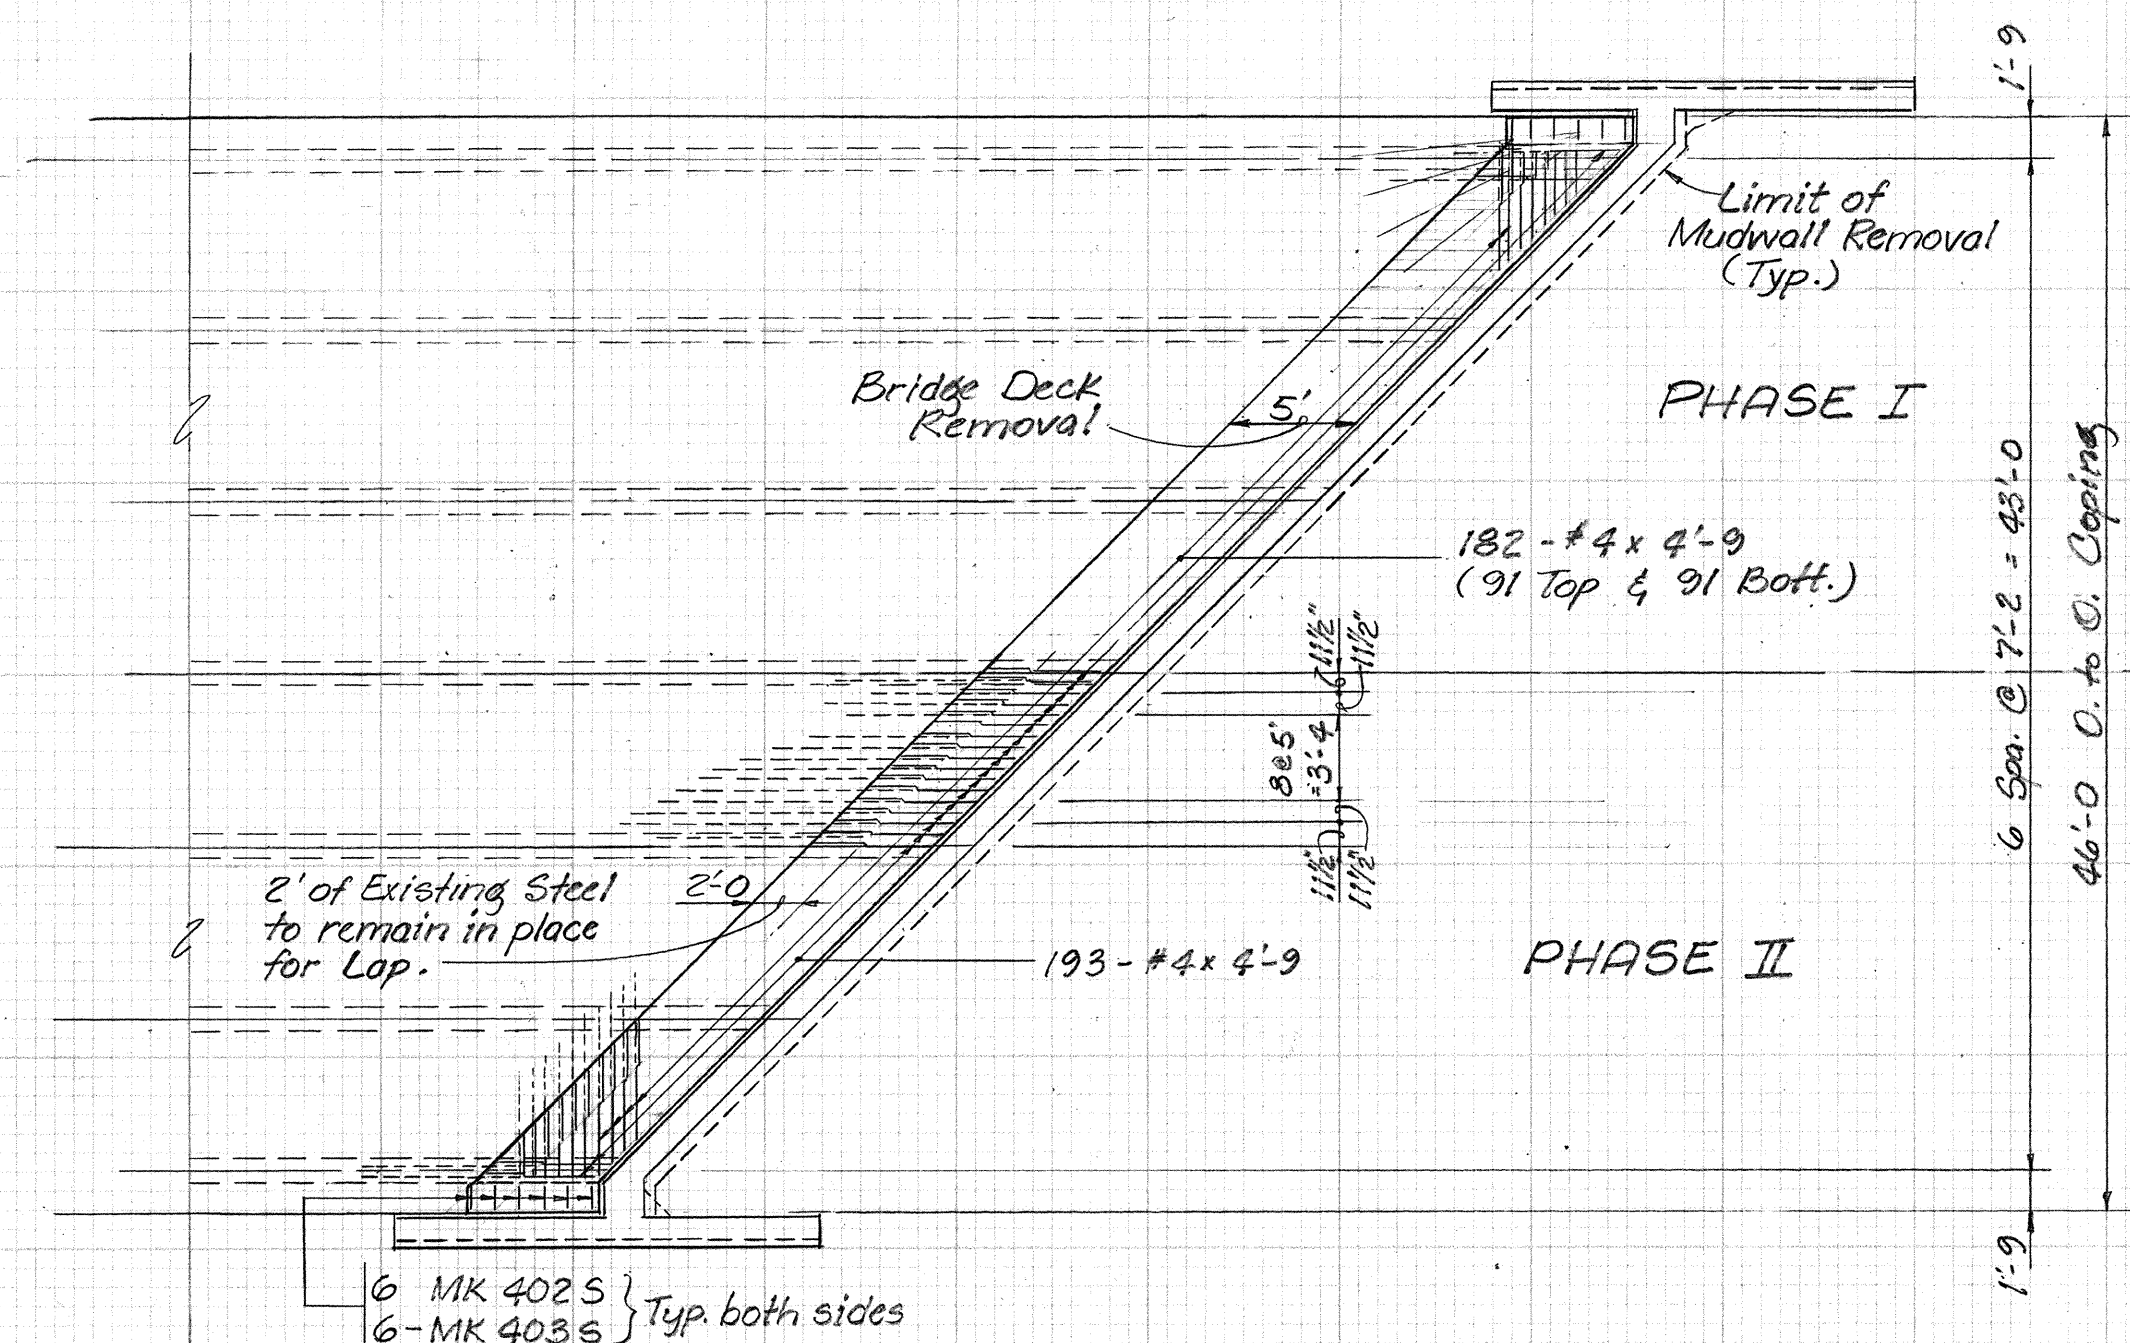

RECONSTRUCTION PLAN @ BENT NO. 4
Scale: 1/8" = 1'-0"

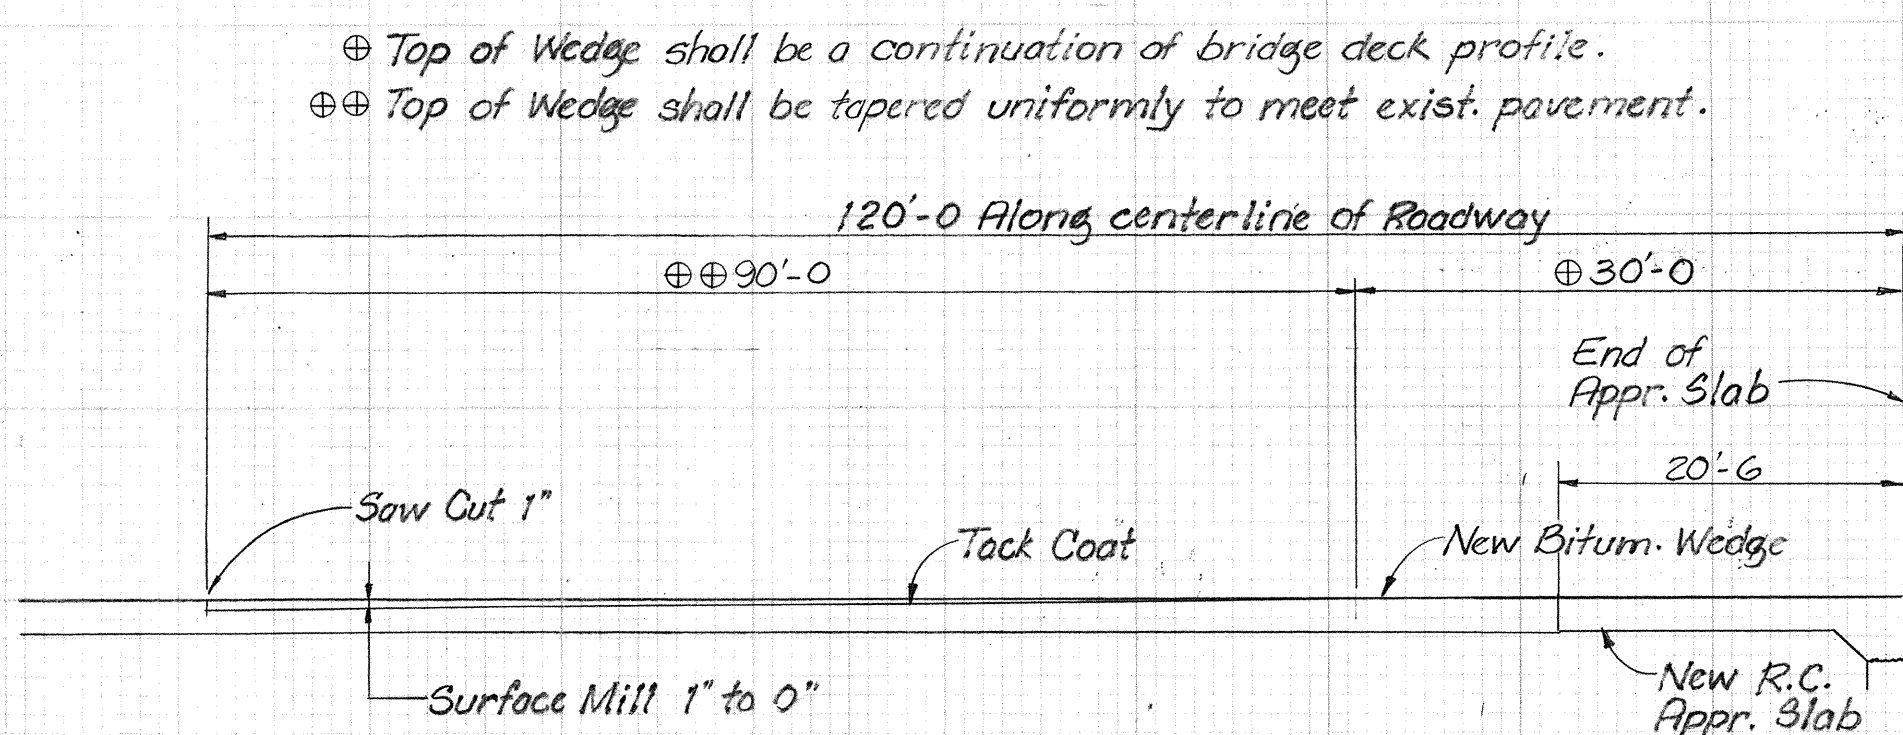

BITUMINOUS WEDGE APPROACH SECTION
No Scale

SUPERSTRUCTURE BILL OF MATERIALS

SIZE & MARK	NO. OF BARS	LENGTH	WEIGHT (LBS.)
REINFORCING STEEL			
#5	182	4'-9	
#5	4	2'-3	
#5	4	2'-8	
#5	4	3'-2	
#5	4	3'-7	
#5	4	4'-1	
#5	4	4'-7	
#5	2	5'-9	
#5	2	7'-6	
#5	4	10'-0	
TOTAL	#5		1,057
#4	193	4'-9	
MK 402S	12	3'-5	
MK 403S	12	1'-6	
TOTAL	#4		657

EPOXY COATED REINF. STEEL BRIDGE RAIL			
#5	64	24'-2	
#5	48	40'-0	
#5	32	32'-3	
#5	539	2'-9	
501a	523	3'-4	
580	32	3'-3	
TOTAL EPOXY COATED #5			8,165

CONCRETE	
CLASS "A" IN SUPERSTRUCTURE	8.6 CYB.
CONCRETE RAILING CLASS "A"	52.4 CYB.

MISCELLANEOUS	
3/4" Ø AUTOMATICALLY WELDED SHEAR STUDS	138 EA.
FIELD DRILLED HOLES	558 EA.
SURFACE SEAL	5100 EA.
BARRIER DELINEATORS	28 EA.

R.C. BRIDGE APPROACH (TOTAL BOTH APPROACHES) BILL OF MATERIALS


SIZE & MARK	NO. OF BARS	LENGTH	WEIGHT (LBS.)
EPOXY COATED REINF. STEEL			
#5	66	30'-6	
591	174		
5a1	(1 REQ'D)		
5b1	(4 REQ'D)		
TOTAL E.C. REINF. STEEL			1,1512

CONCRETE	
CEMENT CONCRETE PAVEMENT, REINF., 10"	409 CYB.

MISCELLANEOUS	
SUBBASE FOR CEMENT CONCRETE PAVEMENT	68 CYB.
EPOXY COATED THREADED BAR SPLICES	127 EA.

MATERIAL NOTES

Bituminous Widening: 990 Lbs./Sys. Bituminous Base Type 5D, HV
Wedge: 110 Lbs./Sys. Bituminous Surface II, MV
Tack Coat Estimated Quantity: 1,234 Sys.
Surface Milling Bituminous Estimated Quantity: 710 Sys.
LV Bitum. Overlay and Wedge Surface II, Est. Qty.: 29 Tons

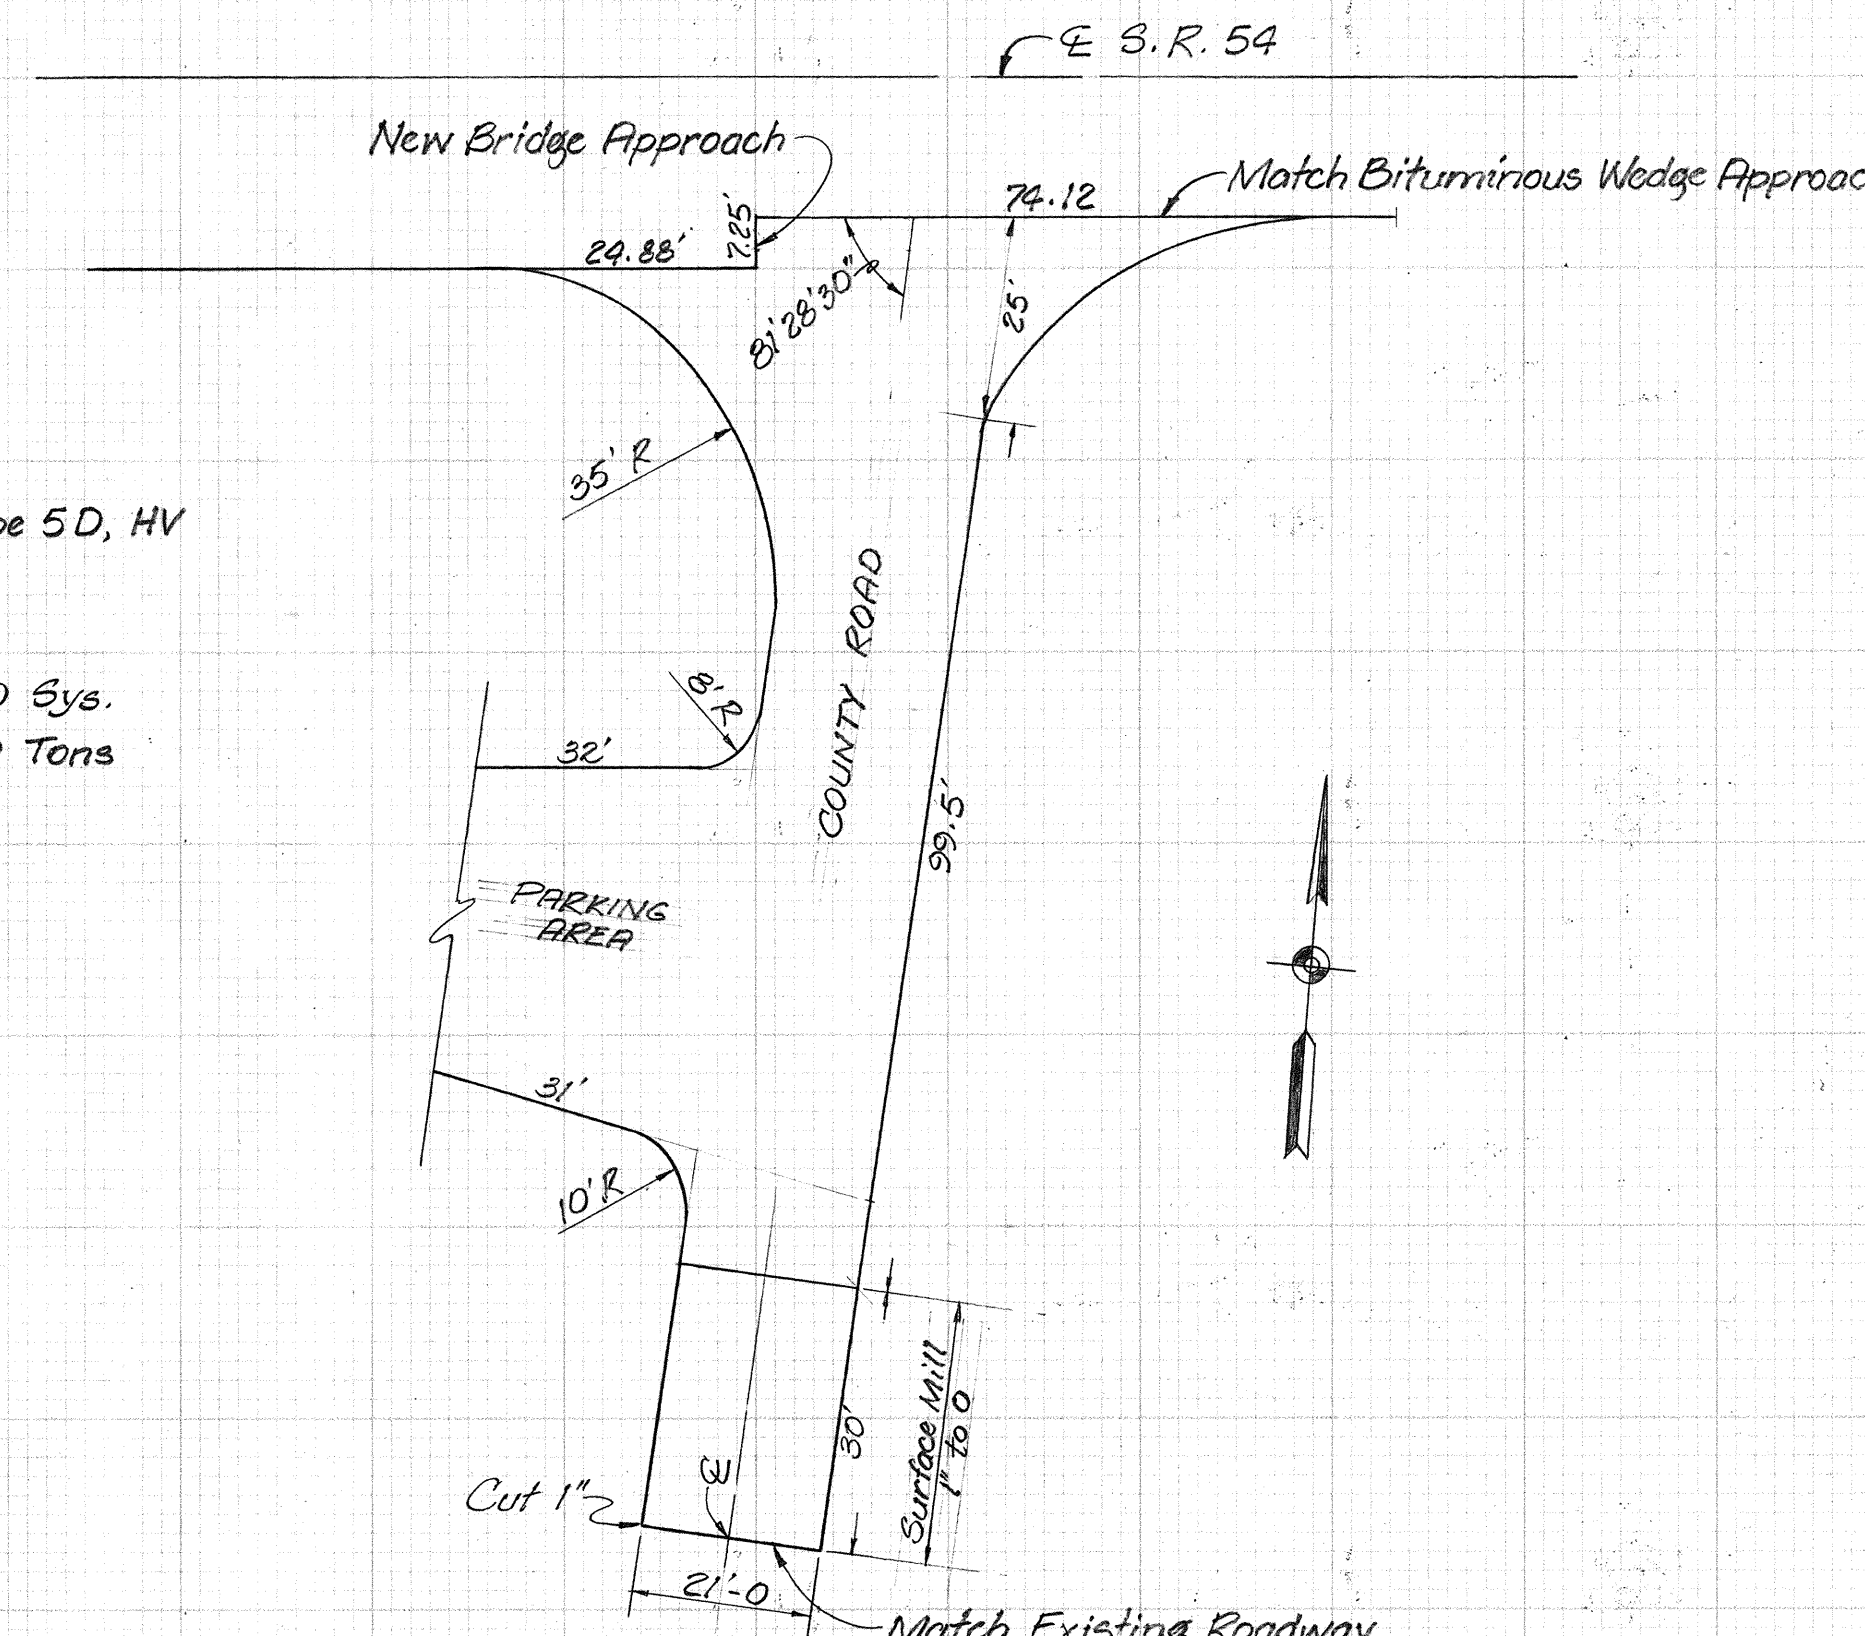

LV BITUMINOUS OVERLAY and WEDGE
No Scale


SUPERSTRUCTURE DETAILS INDIANA DEPARTMENT OF TRANSPORTATION

SCALE: AS NOTED


DATE: _____

19

DESIGNED: RFS C.K.D.
DRAWN: CZU: 10/95 C.K.D. RFS
TRACED: _____ C.K.D.
SF-22317

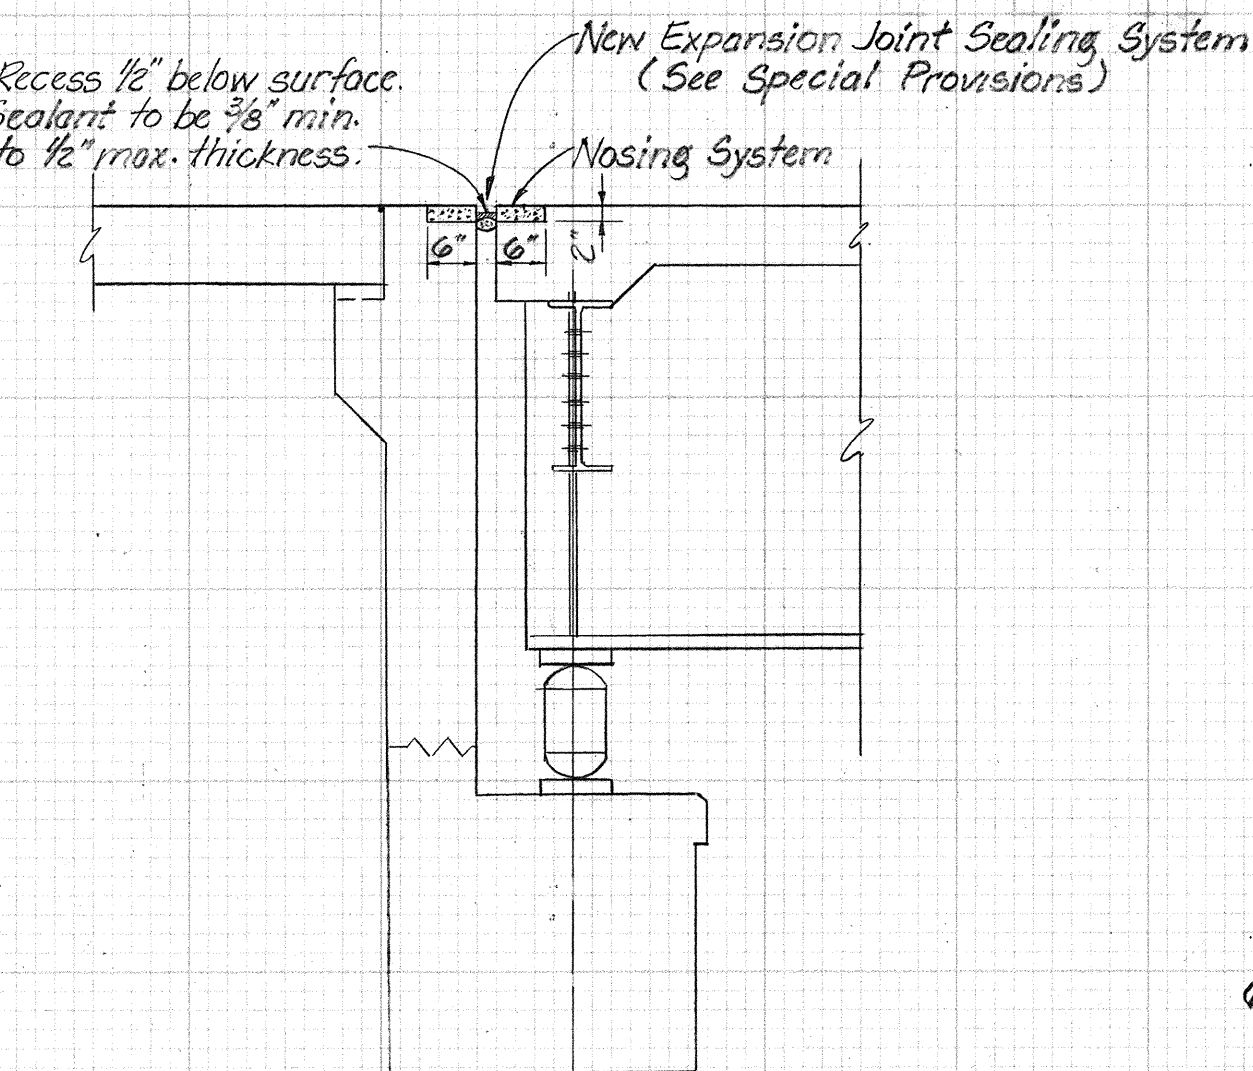

EXPANSION JOINT DETAIL
1" OPENING @ BENT NO. 1
2" OPENING @ BENT NO. 4
Scale: 1/2" = 1'-0"

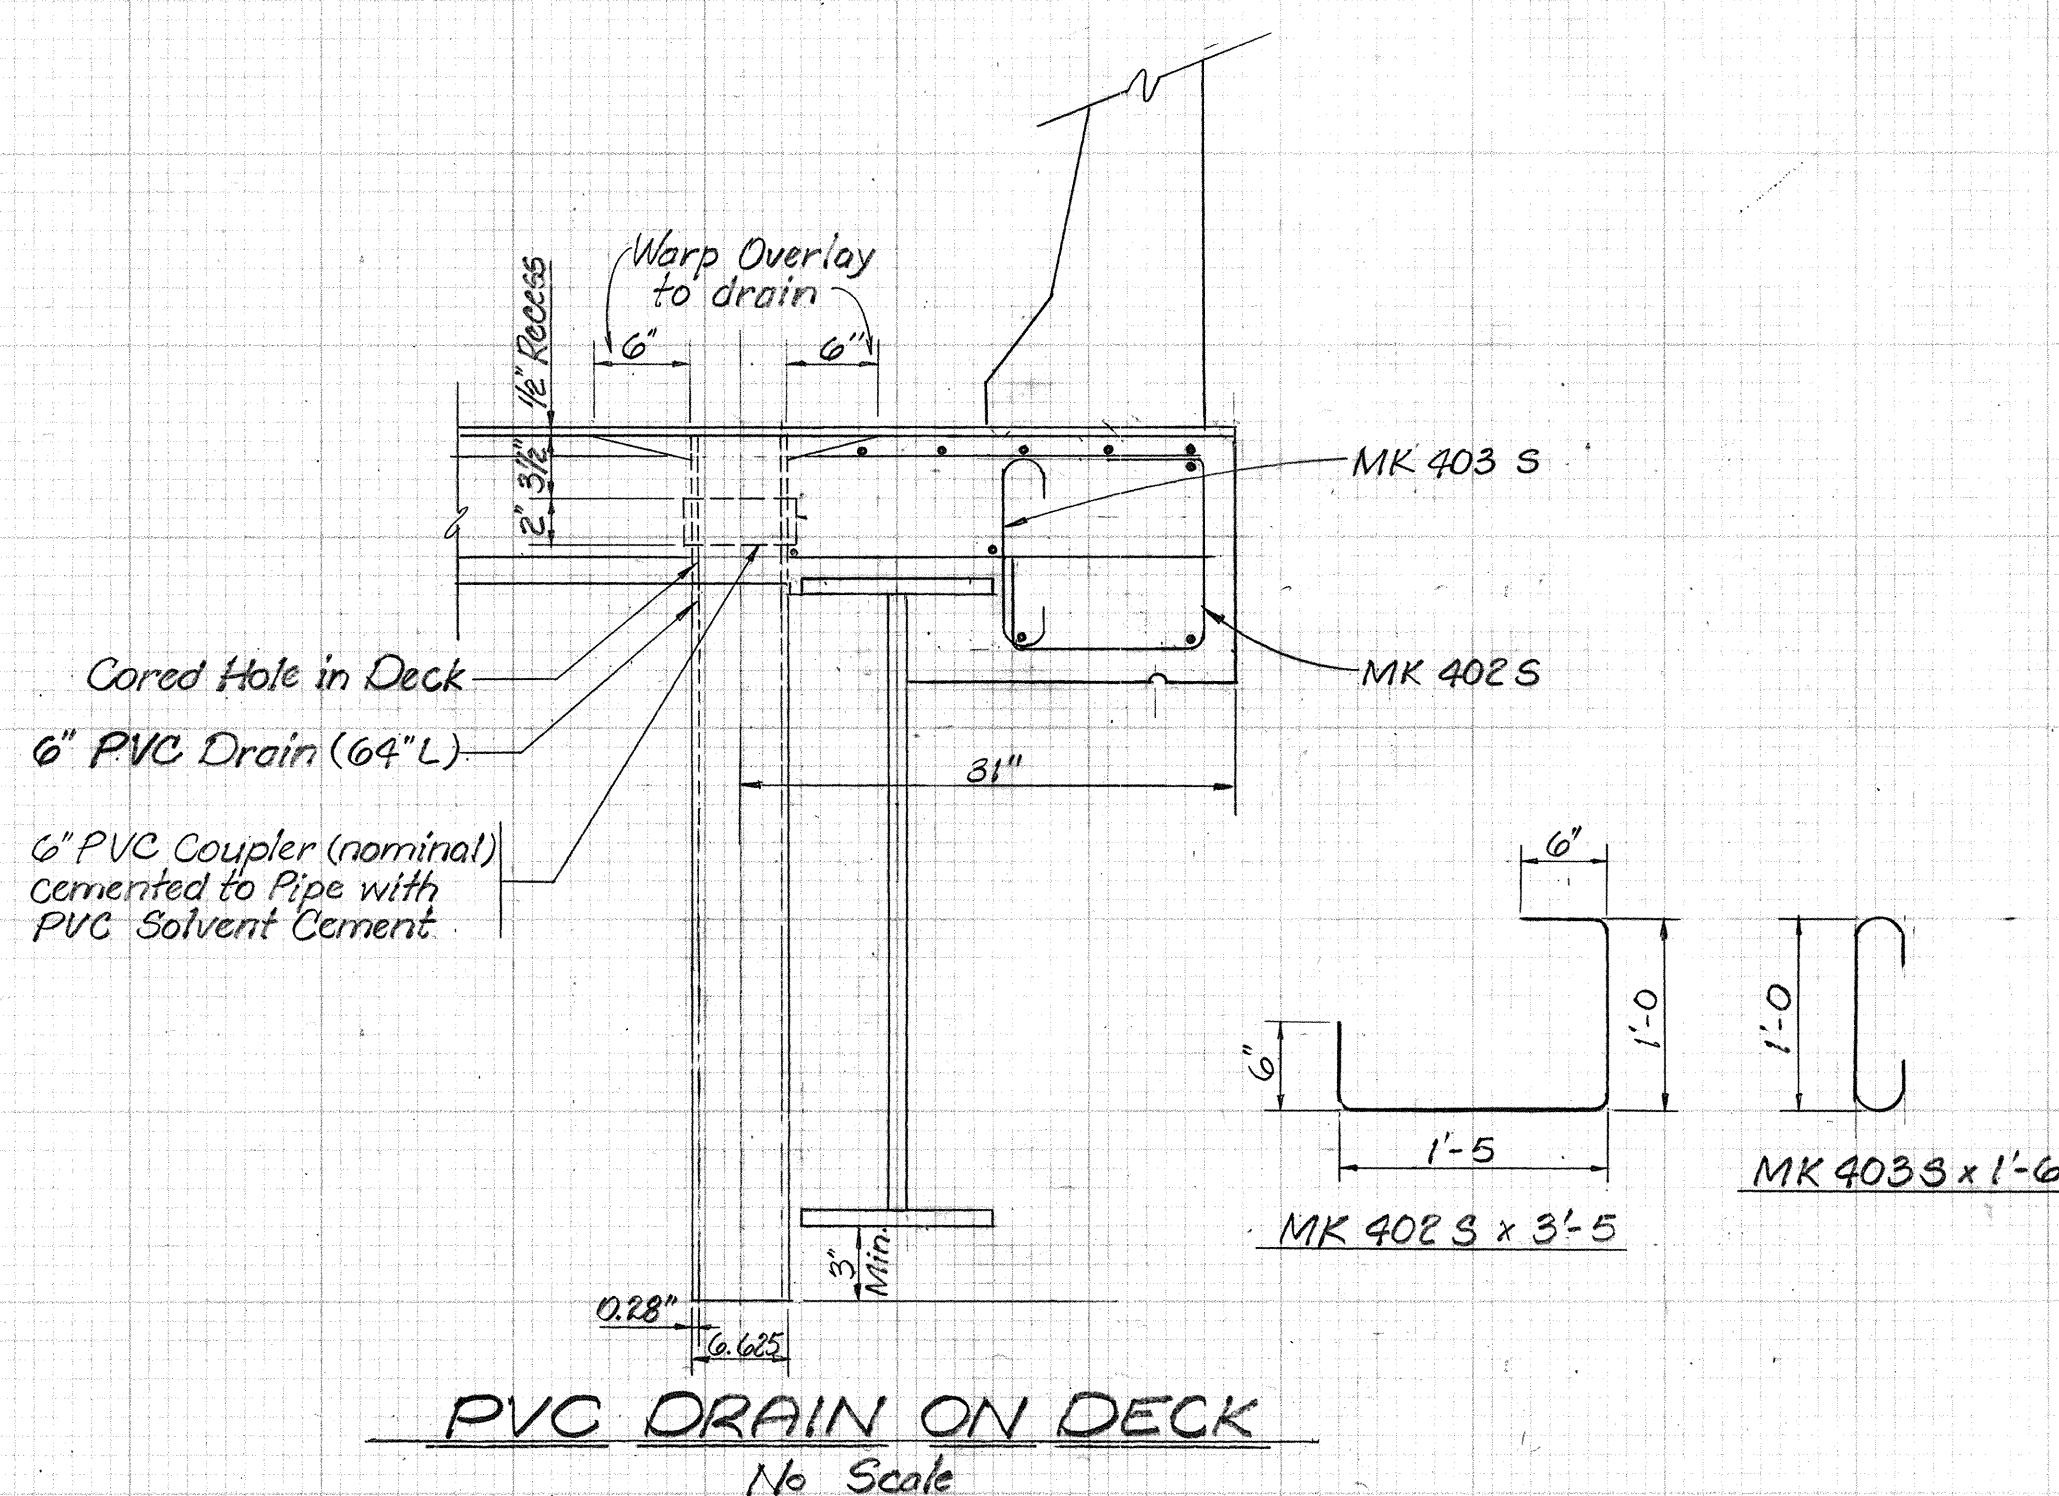

PVC DRAIN ON DECK
No Scale

REPRO GRAPHICS, INC. 511802