

REVISIONS

GENESIS CENTER
ADAMS, BROADWAY, AND FIFTH AVENUE
CITY OF GARY, INDIANA
RICHARD G. HATCHER, MAYOR


WALLACE, MEGDAL & PRUCKER
CONSULTING ELECTRICAL ENGINEERS
1800 N. MICHIGAN AVENUE, CHICAGO, ILL. 60610
444 N. OGDEN, CHICAGO, ILL. 60610

WALLACE, MEGDAL & PRUCKER
CONSULTING ELECTRICAL ENGINEERS
1800 N. MICHIGAN AVENUE, CHICAGO, ILL. 60610
444 N. OGDEN, CHICAGO, ILL. 60610

DATE: 01-28-80
APPROVED: [Signature]
DRAWN: N.M.
CHECKED: C.C.


CONTENTS
GROUND FLOOR &
SECOND FLOOR
PLAN
EXHIBIT HALL
BUILDING

M-3

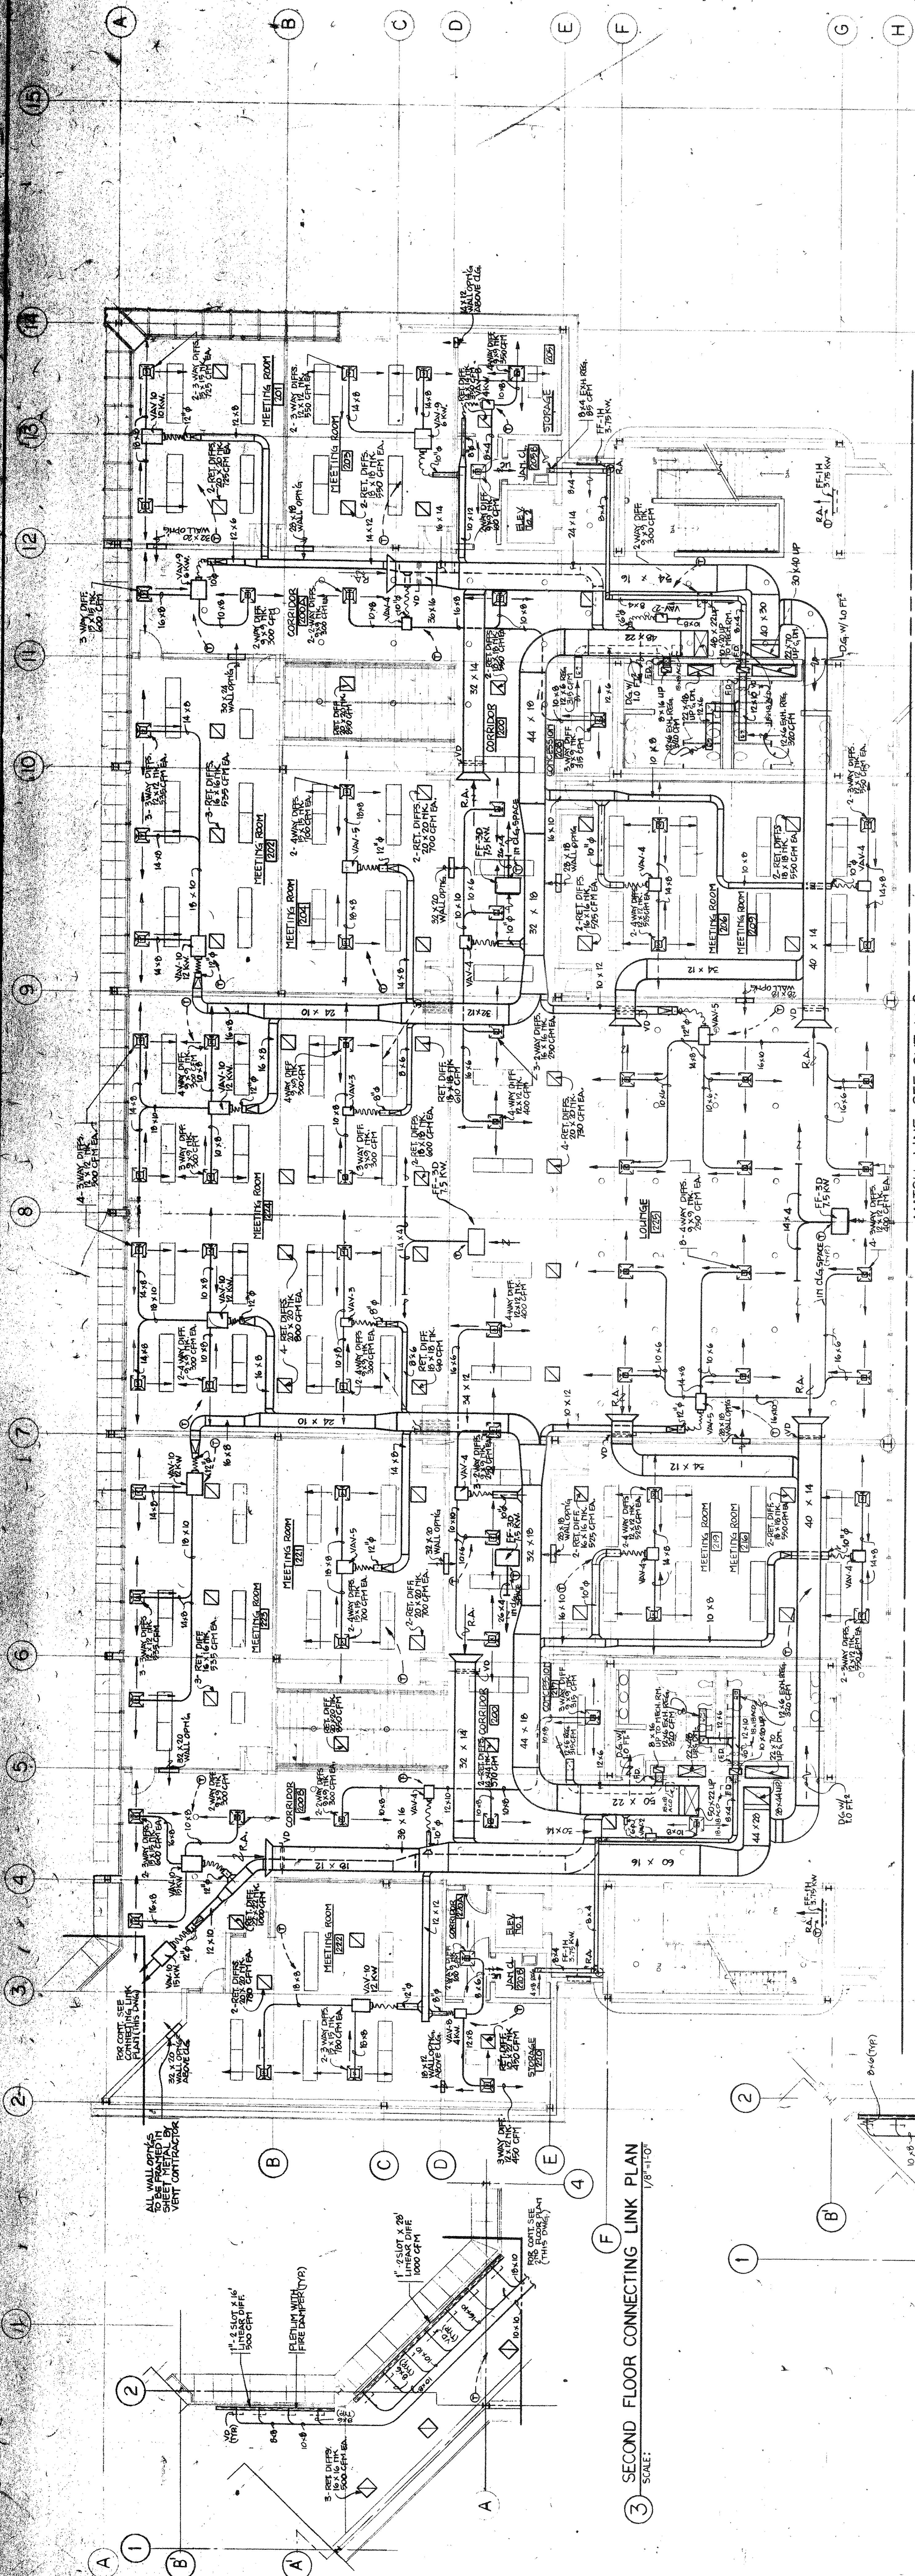

③ SECOND FLOOR CONNECTING LINK PLAN
SCALE: 1/8"=1'-0"

MATCH LINE SEE SHT. M-2

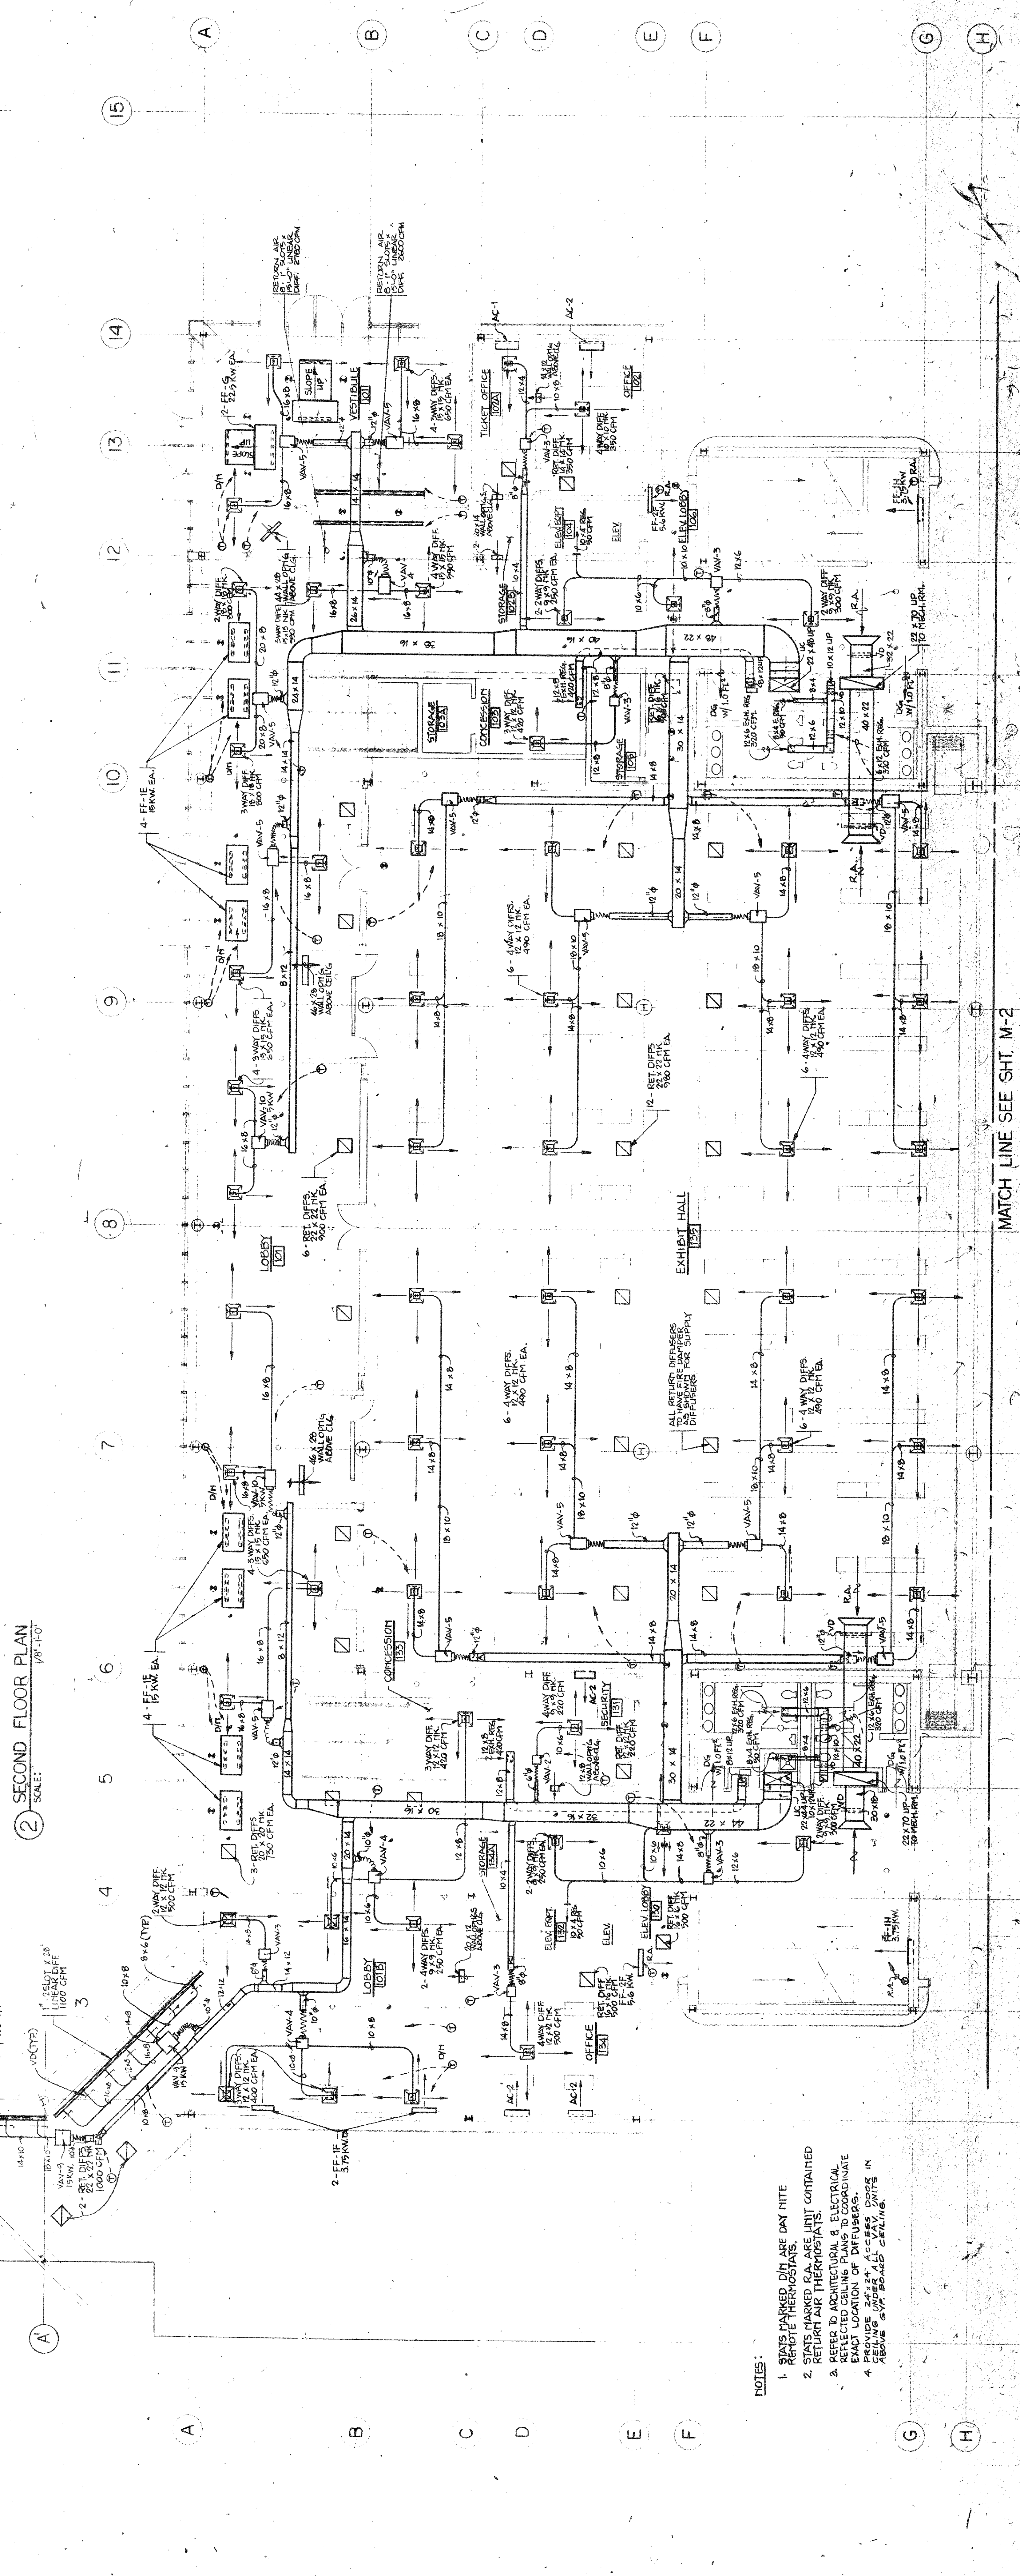

② SECOND FLOOR PLAN
SCALE: 1/8"=1'-0"

MATCH LINE SEE SHT. M-2

- NOTES:
1. STAIRS MARKED DIN ARE DAY NITE
 2. STAIRS MARKED RA ARE RAMP CONTAINED
 3. RETURN AIR THERMOSTATS
 4. EXACT LOCATION OF DIFFUSERS
 5. EXACT LOCATION OF DIFFUSERS
① GROUND FLOOR PLAN
SCALE: 1/8"=1'-0"