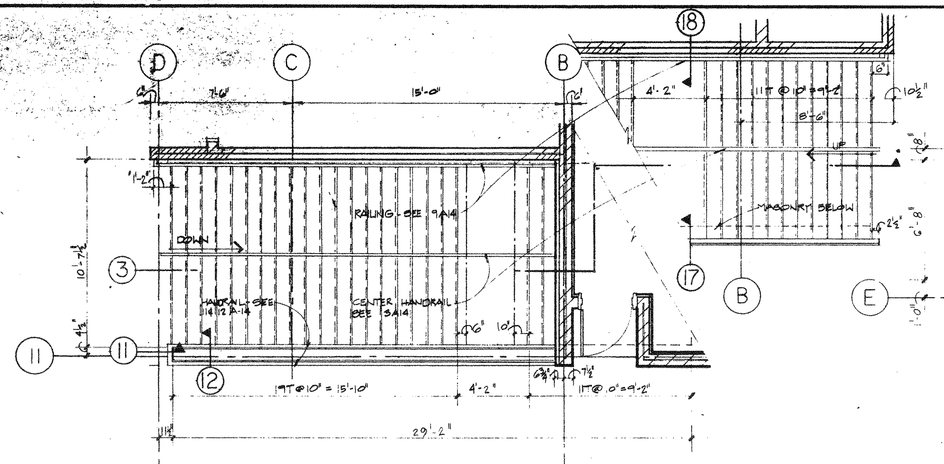

1 STAIR NO. 2 - PLAN (SIMILAR TO STAIR NO. 1)
SCALE : 1/4" = 1'-0"

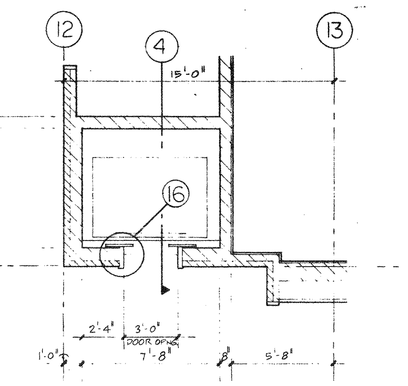

2 ELEVATOR NO 2 - PLAN (SIM. TO ELEVATOR NO. 1)
SCALE : 1/4" = 1'-0"

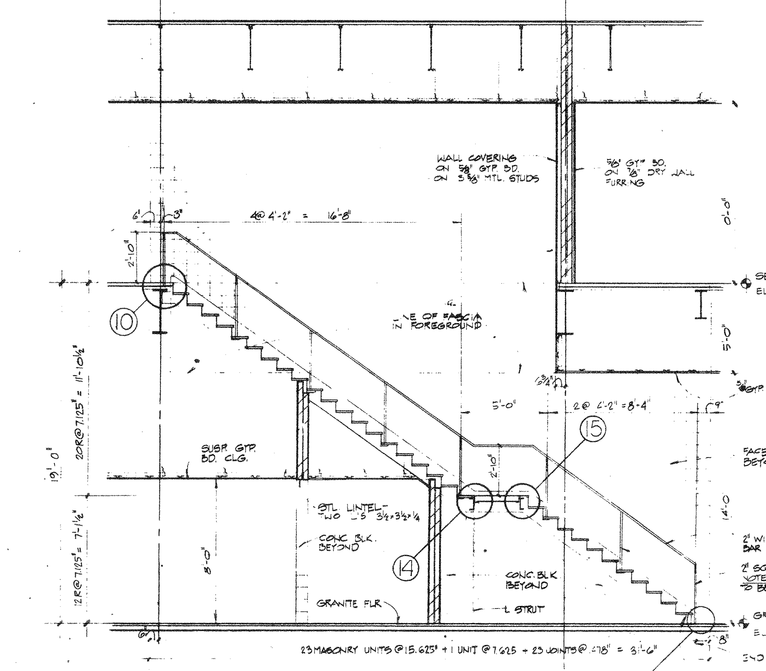

3 SECTION
SCALE : 1/4" = 1'-0"

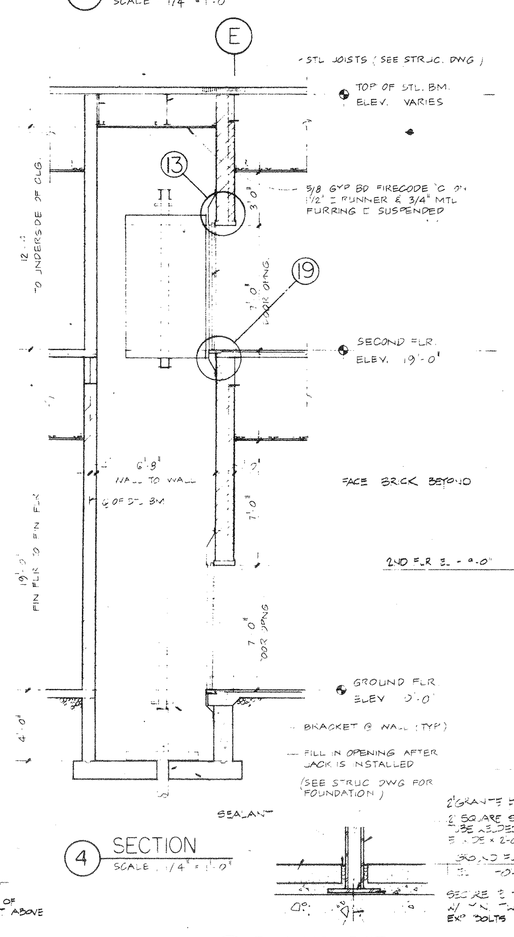

4 SECTION
SCALE : 1/4" = 1'-0"

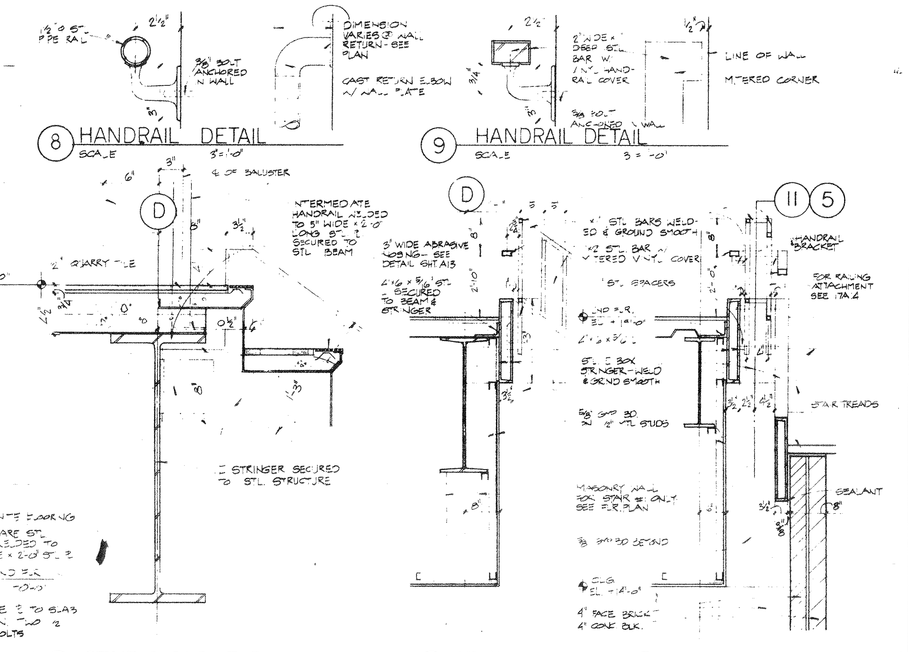

5 STAIR NO 3 - PLAN (SIM TO STAIR NO 4,5 & E)
SCALE 1/4" = 1'-0"

7 SECTION
SCALE 1/4" = 1'-0"

13 HEAD DET.
SCALE : 1/2" = 1'-0"

16 JAMB DET.
SCALE : 1 1/2" = 1'-0"

19 THRESHOLD DET.
SCALE : 1 1/2" = 1'-0"

20 BALCONY EXIT STAIR
SCALE 1/4" = 1'-0"

21 RAILING DET.
SCALE 1 1/2" = 1'-0"

10 STAIR @ 2ND. FLR.
SCALE 1/2" = 1'-0"

11 STAIR @ 2ND FLR.
SCALE 3/8" = 1'-0"

12 STAIR @ 2ND. FLR.
SCALE 1/2" = 1'-0"

SCHEDULE OF ROOM FINISHES AND MATERIALS

SPACE NO.	SPACE NAME	FLOOR MAT	FLOOR FIN	BASE MAT	BASE FIN	W MAT	W FIN	A MAT	A FIN	L MAT	L FIN	L MAT	L FIN	S MAT	S FIN	CEILING MAT	CEILING FIN	CEILING HT	NOTE NO
216	MEETING ROOM	CONC	-	VINYL	WAX	GYP BD BLK	WC WC	BLK	WC	ASB BD GLASS	DF DF	BLK	WC	LAY-IN	-	10'-0"			
217	CONCESSION	CONC	-	-	-	MTL	-	BLK	PT	BLK	PT	BLK WOOD	WP S&V	GYP BD	PT	8'-0"			
218	ELEVATOR LOBBY	QT	-	BRICK QT	-	BLK MTL	WC -	BRICK	-	BRICK	-	BLK WOOD	WC S&V	GYP BD	PT	10'-0"			
219	MEETING ROOM	CONC	-	VINYL	WAX	GYP BD WOOD	WC S&V	BLK	WC	GYP BD	WC	BLK	WC	LAY-IN	-	10'-0"			
220	STORAGE	CONC	-	VINYL	WAX	GYP BD	PT	GYP BD WOOD	PT S&V	GYP BD	PT	GYP BD	PT	GYP BD	PT	8'-0"			
220A	CORRIDOR	CONC	-	VINYL	WAX	GYP BD	PT	GYP BD WOOD	PT S&V	GYP BD WOOD	PT S&V	GYP BD WOOD	PT S&V	GYP BD	PT	8'-0"			
220B	JANITOR'S CLOSET	CONC	-	VINYL	WAX	BLK WOOD	PT S&V	BLK	PT	BLK	PT	BLK	PT	GYP BD	PT	8'-0"			
221	MEETING ROOM	CONC	-	VINYL	WAX	GYP BD	WC	BLK	WC	BLK WOOD	WC S&V	BLK	PT	LAY-IN	-	10'-0"			
222	MEETING ROOM	CONC	-	VINYL	WAX	BLK	WC	BLK WOOD	WC S&V	GYP BD	WC	BLK WOOD	WC S&V	LAY-IN	-	10'-0"			
223	MEETING ROOM	CONC	-	VINYL	WAX	WD SD GLASS	WC -	BLK	WC	GYP BD WOOD	WC S&V	BLK WOOD	WC S&V	LAY-IN	-	10'-0"			
224	MEETING ROOM	CONC	-	VINYL	WAX	GYP BD GLASS	PT FF	BLK	WC	WOOD SEAT GYP BD	FF FF	GYP BD GLASS	PT FF	LAY-IN	-	10'-0"			
225	LOUNGE	CONC	-	VINYL	WAX	GYP BD GLASS	PT FF	BLK	WC	WOOD SEAT GYP BD	FF FF	GYP BD GLASS	PT FF	LAY-IN	-	10'-0"			
301 302.1	MECH. EQUIP. ROOMS	CONC	-	-	-	MTL BLK	PT PT	MTL BLK	PT PT	MTL BLK	PT PT	MTL BLK	PT PT	GYP BD	PT				
303	MECH. EQUIP ROOM	CONC	-	-	-	BLK	PT	MTL BLK	PT PT	BLK	PT	MTL BLK	PT PT	GYP BD	PT				
303A	CONTROL ROOM	CONC	-	VINYL	WAX	BLK WOOD	PT S&V	BLK	PT	MTL BLK	PT PT	BLK	PT	GYP BD	PT	8'-0"			
303B	CORRIDOR	CONC	-	VINYL	WAX	BLK	PT	BLK	PT	BLK	PT	MTL BLK	PT PT	GYP BD	PT	8'-0"			
401.2 304	MECH. EQUIP. ROOMS	CONC	-	-	-	MTL BLK	PT PT	MTL BLK	PT PT	MTL BLK	PT PT	MTL BLK	PT PT	GYP BD	PT				
	STAIRS 7, 8, 9 & 10	MTL CONC	-	BRICK	-	BRICK MTL	PT PT	BRICK MTL	PT PT	BRICK MTL	PT PT	BRICK MTL	PT PT	GYP BD	PT	VARIES			

SCHEDULE OF ROOM FINISHES AND MATERIALS

SPACE NO.	SPACE NAME	FLOOR MAT	FLOOR FIN	BASE MAT	BASE FIN	W MAT	W FIN	A MAT	A FIN	L MAT	L FIN	L MAT	L FIN	S MAT	S FIN	CEILING MAT	CEILING FIN	CEILING HT	NOTE NO
100	VESTIBULE	GR	POL	METAL BRICK	PT -	GL MTL	- PT	GL MTL	- PT	MTL BRICK	PT -	GL MTL	PT	GYP BD	PT	VARIES			
101	LOBBY	GR	POL	MTL WOOD	- S&V	GL MTL	- PT	GL MTL	PT	GL WOOD	- S&V	-	-	GYP BD	PT	14'-0"			
101A	LOBBY	GR	POL	METAL BRICK	-	-	-	METAL BRICK	PT -	GL WOOD	- S&V	-	-	BRICK	PT	14'-0"			
101B	LOBBY	GR	POL	METAL BRICK	-	-	-	BRICK	- S&V	-	-	-	-	GYP BD	PT	14'-0"			
101C	STORAGE	CONC	-	VINYL	WAX	BLK	PT	BLK	PT	BLK	PT	BLK	PT	GYP BD	PT	8'-0"			
101D	STORAGE	CONC	-	VINYL	WAX	BLK	PT	BLK	PT	BLK	PT	BLK WOOD	PT S&V	GYP BD	PT	8'-0"			
102	OFFICE	CONC	-	VINYL	WAX	GYP BD	PT	GYP BD	PT	GYP BD	PT	GYP BD	PT	GYP BD	PT	8'-0"			
102A	TICKET OFFICE	CONC	-	VINYL	WAX	GYP BD	PT	GYP BD	PT	MTL WOOD	PT S&V	GYP BD	PT	GYP BD	PT	8'-0"			
102B	STORAGE	CONC	-	VINYL	WAX	GYP BD	PT	GYP BD WOOD	PT S&V	GYP BD	PT	GYP BD WOOD	PT S&V	GYP BD	PT	8'-0"			
103	CONCESSION	CONC	-	-	-	BLK	PT	BLK	PT	BLK	PT	BLK	PT	BLK	PT	8'-0"			
103A	STORAGE	CONC	-	VINYL	WAX	BLK	PT	BLK	PT	BLK	PT	BLK	PT	BLK	PT	VARIES			
104	ELEVATOR EQUIPMENT	CONC	-	-	-	BLK	PT	BLK	PT	BLK	PT	MTL BLK	PT PT	GYP BD	PT	8'-0"			
105	STORAGE	CONC	-	VINYL	WAX	BLK	PT	BLK	PT	BLK	PT	BLK WOOD	PT S&V	GYP BD	PT	8'-0"			
106	ELEVATOR LOBBY	GR	POL	BRICK	-	MTL BRICK	PT -	BRICK	PT	MTL WOOD	PT S&V	BRICK	PT	GYP BD	PT	14'-0"			
107	LOBBY	GR	POL	BRICK	-	-	-	BRICK	-	-	-	BRICK WOOD	- S&V	GYP BD	PT	8'-0"			
107A	MEN'S TOILET	QT	-	SST	-	SST	-	SST	-	SST	-	SST	-	GYP BD	PT	8'-0"			
107B	WOMEN'S TOILET	QT	-	SST	-	SST	-	QUARRY TILE WOOD	PT S&V	SST	-	SST	-	GYP BD	PT	8'-0"			
107C	JANITOR'S CLOSET	QT	-	SST	-	SST	-	QUARRY TILE WOOD	PT S&V	SST	-	SST	-	GYP BD	PT	8'-0"			
	STAIR NO 7	GR	POL	BRICK	-	BRICK	-	BRICK	-	BRICK	-	BRICK	-	BRICK	-	GYP BD	PT	VARIES	
108	ASSEMBLY AREA	QT	-	VINYL MTL	WAX PT	BLK MTL	PT PT	BLK MTL	PT PT	BLK MTL	PT PT	BLK MTL	PT PT	LAY-IN	-	14'-0"			
108A	STORAGE	CONC	-	VINYL	WAX	BLK	PT	BLK	PT	BLK	PT	BLK	PT	GYP BD	PT	12'-0"			
108B	STORAGE	CONC	-	VINYL	WAX	BLK	PT	MTL BLK	PT PT	BLK	PT	BLK	PT	GYP BD	PT	14'-0"			
108C	STORAGE	CONC	-	VINYL	WAX	BLK	PT	BLK	PT	MTL BLK	PT PT	BLK	PT	GYP BD	PT	12'-0"			
109	LOBBY	QT	-	BRICK	-	-	-	BRICK	-	-	-	BRICK WOOD	- S&V	GYP BD	PT	8'-0"			
109A	MEN'S TOILET	QT	-	SST	-	SST	-	SST	-	SST	-	SST	-	GYP BD	PT	8'-0"			
109B	WOMEN'S TOILET	QT	-	SST	-	SST	-	SST	-	SST WOOD	PT S&V	SST	-	GYP BD	PT	8'-0"			
109C	JANITOR'S CLOSET	QT	-	SST	-	SST	-	SST	-	SST WOOD	PT S&V	SST	-	GYP BD	PT	8'-0"			
	STAIR NO 8	QT	-	BRICK	-	BRICK	-	BRICK	-	BRICK	-	BRICK	-	BRICK	-	GYP BD	PT	VARIES	
110	LOBBY	QT	-	BRICK	-	BRICK WOOD	- S&V	BRICK MTL	- PT	BRICK	PT	-	-	GYP BD	PT	8'-0"			
110A	MEN'S TOILET	QT	-	SST	-	SST	-	SST	-	SST WOOD	PT S&V	SST	-	GYP BD	PT	8'-0"			
110B	WOMEN'S TOILET	QT	-	SST	-	SST	-	SST	-	SST WOOD	PT S&V	SST	-	GYP BD	PT	8'-0"			
110C	JANITOR'S CLOSET	QT	-	SST	-	SST	-	SST	-	SST WOOD	PT S&V	SST	-	GYP BD	PT	8'-0"			
	STAIR NO 9	QT	-	BRICK	-	BRICK	-	BRICK	-	BRICK	-	BRICK	-	GYP BD	PT	VARIES			
111	AREA A	CONC	-	BRICK MTL	PT PT	BRICK MTL	PT PT	GYP BD MTL	PT PT	GYP BD MTL	PT PT	GYP BD MTL	PT PT	GYP BD	PT	VARIES			
112	CORRIDOR	CONC	-	VINYL	WAX	BLK	PT	BLK	PT	-	-	BLK	PT	GYP BD	PT	14'-0"			
113	DRESSING ROOM	CONC	-	VINYL	WAX	BLK	PT	BLK	PT	BLK WOOD	PT S&V	BLK	PT	GYP BD	PT	8'-0"			
114	DRESSING ROOM	CONC	-	VINYL	WAX	BLK	PT	BLK	PT	BLK WOOD	PT S&V	BLK	PT	GYP BD	PT	8'-0"			
115	LOCKER ROOM	CONC	-	VINYL	WAX	BLK	PT	BLK	PT	BLK WOOD	PT S&V	BLK	PT	GYP BD	PT	8'-0"			
116A	TOILET ROOM	QT	-	SST	-	SST	-	SST	-	SST	-	SST	-	GYP BD	PT	8'-0"			
116B	SHOWER ROOM	QT	-	SST	-	SST	-	SST	-	SST	-	SST	-	GYP BD	PT	8'-0"			
116	MECH. EQUIP. ROOM & CORR.	CONC	-	-	-	MTL	PT	BLK	PT	BLK	PT	BLK	PT	GYP BD	PT	4'-0"			
116A	MAIN SWITCHBOARD ROOM	CONC	-	-	-	BLK	PT	BLK	PT	BLK	PT	BLK	PT	GYP BD	PT	4'-0"			
116B	EMERGENCY GENERATOR RM.	CONC	-	-	-	BLK	PT	BLK	PT	BLK	PT	BLK	PT	GYP BD	PT	4'-0"			
116C	STAIR NO 8	CONC	-	-	-	BLK	PT	BLK	PT	BLK	PT	BLK	PT	GYP BD	PT	VARIES			
117	VEHICULAR VEST BULE & CORR.	CONC	-	-	-	BLK MTL	PT PT	BLK	PT	BLK WOOD	PT S&V	BLK	PT	GYP BD	PT	4'-0"			
117A	VEHICULAR ENTRANCE	CONC	-	-	-	BLK MTL	PT PT	BLK	PT	BLK WOOD	PT S&V	BLK	PT	GYP BD	PT	4'-0"			
118	WOMEN EMPLOYEE LOCKER RM	CONC	-	VINYL	WAX	BLK	PT	BLK WOOD	PT S&V	BLK	PT	SST	-	GYP BD	PT	8'-0"			
118A	WOMEN EMPLOYEE TOILET	CONC	-	SST	-	SST	-	SST	-	SST	-	SST	-	GYP BD	PT	8'-0"			
119	MEN EMPLOYEE LOCKER RM	CONC	-	VINYL	WAX	BLK	PT	BLK WOOD	PT S&V	BLK	PT	SST	-	GYP BD	PT	8'-0"			
119A	MEN EMPLOYEE TOILET	CONC	-	SST	-	SST	-	SST	-	SST	-	SST	-	GYP BD	PT	8'-0"			
120	OFFICE	CONC	-	VINYL	WAX	BLK	PT	BLK	PT	BLK WOOD	PT S&V	BLK	PT	GYP BD	PT	8'-0"			
121	OFFICE	CONC	-	VINYL	WAX	BLK	PT	BLK	PT	BLK WOOD	PT S&V	BLK	PT	GYP BD	PT	8'-0"			
122	STORAGE	CONC	-	-	-	BLK	PT	BLK MTL	PT PT	BLK WOOD	PT S&V	BLK	PT	GYP BD	PT	14'-0"			
123	FOOD PREPARATION	CONC	-	-	-	BLK MTL	PT PT	BLK MTL	PT PT	BLK WOOD	PT S&V	BLK	PT	GYP BD	PT	14'-0"			
123A	STAIR NO 6	CONC	-	-	-	MTL	PT	MTL	PT	MTL	PT	MTL	PT	GYP BD	PT	VARIES			
124	CORRIDOR	CONC	-	VINYL	WAX	BLK	PT	-	-	-	-	-	-	GYP BD	PT	14'-0"			
125	DRESSING ROOM	CONC	-	VINYL	WAX	BLK WOOD	PT S&V	BLK	PT	BLK	PT	BLK	PT	GYP BD	PT	8'-0"			
126	DRESSING ROOM	CONC	-	VINYL	WAX	BLK WOOD	PT S&V	BLK	PT	BLK	PT	BLK	PT	GYP BD	PT	8'-0"			
127	DRESSING ROOM	CONC	-	VINYL	WAX	BLK	PT	BLK WOOD	PT S&V	BLK	PT	BLK	PT	GYP BD	PT	8'-0"			
128	LOCKER ROOM	CONC	-	VINYL	WAX	BLK	PT	BLK WOOD	PT S&V	BLK	PT	BLK	PT	GYP BD	PT	8'-0"			
128A	TOILET ROOM	QT	-	SST	-	SST	-	SST	-	SST	-	SST	-	GYP BD	PT	8'-0"			
128B	SHOWER ROOM	QT	-	SST	-	SST	-	SST	-	SST	-	SST	-	GYP BD	PT	8'-0"			
129	LOBBY	GR	POL	BRICK	-	-	-	BRICK	-	-	-	BRICK	-	GYP BD	PT	8'-0"			
129A	MEN'S TOILET	QT	-	SST	-	SST	-	SST	-	SST	-	BRICK WOOD	PT S&V	GYP BD	PT	8'-0"			
129B	WOMEN'S TOILET	QT	-	SST	-	SST	-	SST	-	SST	-	BRICK WOOD	PT S&V	GYP BD	PT	8'-0"			
129C	JANITOR'S CLOSET	QT	-	SST	-	SST	-	SST	-	SST	-	BRICK WOOD	PT S&V	GYP BD	PT	8'-0"			
130	ELEVATOR LOBBY	GR	POL	BRICK	-	BRICK	PT	BRICK WOOD	PT S&V	BRICK	PT	-	-	GYP BD	PT	14'-0"			
131	SECURITY	CONC	-	VINYL	WAX	BLK	PT	BLK	PT	MTL BLK	PT PT	BLK	PT	GYP BD	PT	8'-0"			
132	ELEVATOR EQUIPMENT	CONC	-	-	-	BLK	PT	BLK	PT	BLK	PT	BLK	PT	GYP BD	PT	14'-0"			
133	CONCESSION	CONC	-	-	-	BLK	PT	BLK	PT	MTL BLK	PT PT	BLK	PT	GYP BD	PT	8'-0"			
134	OFFICE	CONC	-	VINYL	WAX	GYP BD WOOD	PT S&V	BLK	PT	BLK	PT	BLK	PT	GYP BD	PT	8'-0"			
134A	STORAGE	CONC	-	VINYL	WAX	GYP BD WOOD	PT S&V	GYP BD WOOD	PT S&V	GYP BD WOOD	PT S&V	GYP BD WOOD	PT S&V	GYP BD	PT	8'-0"			
135	EX - BIT HALL	CONC	-	BRICK WOOD	- S&V	BRICK WOOD	- S&V	BRICK WOOD	- S&V	BRICK WOOD	- S&V	BRICK WOOD	- S&V	GYP BD LAY-IN	PT -	8'-0" 10'-0"			
135A	STORAGE	CONC	-	VINYL	WAX	BLK	PT	WOOD S&V		BLK	PT	BLK	PT	GYP BD	PT	8'-0"			
136	STORAGE	CONC	-	VINYL	WAX	BLK	PT	BLK	PT	BLK	PT	BLK	PT	GYP BD	PT	8'-0"			
136A	STORAGE	CONC	-	VINYL	WAX	BLK	PT	BLK	PT	BLK	PT	BLK	PT	GYP BD	PT	8'-0"			
136B	STORAGE	CONC	-	VINYL	WAX	BLK	PT	BLK	PT	BLK	PT	BLK	PT	GYP BD	PT	8'-0"			
136C	STORAGE	CONC	-	VINYL	WAX	BLK	PT	BLK	PT	BLK	PT	BLK	PT	GYP BD	PT	8'-0"			
136D	STORAGE	CONC	-	VINYL	WAX	BLK	PT	BLK	PT	BLK	PT	BLK	PT	GYP BD	PT	8'-0"			
138	STAIR NO 4	CONC	-	-	-	BLK	PT	BLK	PT	BLK	PT	BLK	PT	GYP BD	PT	VARIES			
138A	STAIR NO 5	CONC	-	-	-	BLK	PT	BLK	PT	BLK	PT	BLK	PT	GYP BD	PT	VARIES			
200	CORRIDOR	CONC	-	VINYL	WAX	BLK WOOD	PT S&V	-	-	-	-	BLK WOOD	PT S&V	-	-	LAY-IN	-	10'-0"	
200A	CORRIDOR	QT	-	QT	-	QUARRY TILE WOOD	PT S&V	-	-	-	-	-	-	LAY-IN	-	10'-0"			
200B	CORRIDOR	QT	-	QT	-	QUARRY TILE WOOD	PT S&V	BLK	WC	-	-	-	-	LAY-IN	-	10'-0"			
201	MEETING ROOM	CONC	-	VINYL	WAX	GYP BD WOOD	WC S&V	GYP BD WOOD	WC S&V	BLK	WC	GYP BD	WC	LAY-IN	-	10'-0"			
202	MEETING ROOM	CONC	-	VINYL	WAX	BLK WOOD	WC S&V	GYP BD WOOD	WC S&V	BLK	WC	BLK	WC	LAY-IN	-	10'-0"			
203	MEETING ROOM	CONC	-	VINYL	WAX	GYP BD WOOD	WC S&V	GYP BD WOOD	WC S&V	BLK	WC	GYP BD WOOD	WC S&V	LAY-IN	-	10'-0"			
204	MEETING ROOM	CONC	-	VINYL	WAX	GYP BD WOOD	WC S&V	BLK	WC	BLK	WC	BLK WOOD	WC S&V	LAY-IN	-	10'-0"			
205	STORAGE	CONC	-	VINYL	WAX	GYP BD	PT	GYP BD WOOD	PT S&V	BLK	PT	GYP BD WOOD	PT S&V	GYP BD	PT	8'-0"			
206A	CORRIDOR	CONC	-	VINYL	WAX	GYP BD WOOD	PT S&V	GYP BD WOOD	PT S&V	BLK	PT	GYP BD WOOD	PT S&V	GYP BD	PT	10'-0"			
206B	JANITOR'S CLOSET	CONC	-	VINYL	WAX	GYP BD WOOD	PT S&V	GYP BD WOOD	PT S&V	BLK	PT	GYP BD WOOD	PT S&V	GYP BD	PT	10'-0"			
208	MEETING ROOM	CONC	-	VINYL	WAX	GYP BD WOOD	WC S&V	BLK	WC	BLK	WC	BLK	WC	LAY-IN	-	10'-0"			
209	MEETING ROOM	CONC	-	VINYL	WAX	GYP BD	WC	BLK	WC	BLK	WC	BRICK	-	LAY-IN	-	10'-0"			
210	LOBBY	QT	-	BRICK	-	-	-	BRICK	-	-	-	BRICK	-	GYP BD	PT	8'-0"			
210A	MEN'S TOILET	QT	-	SST	-	SST	-	SST	-	SST	-	SST	-	GYP BD	PT	8'-0"			
210B	WOMEN'S TOILET	QT	-	SST	-	SST	-	SST	-	SST	-	SST	-	GYP BD	PT	8'-0"			
211	BALCONY	CONC	-	BRICK VINYL	- WAX	BRICK GYP BD	- PT	BLK MTL	PT PT	BRICK GYP BD	- PT	BLK MTL	PT PT	BRICK	-	97'-6"			
212	LOBBY	QT	-	BRICK	-	-	-	BRICK	-	-	-	BRICK	-	GYP BD	PT	8'-0"			
212A	MEN'S TOILET	QT	-	SST	-	SST	-	SST WOOD	PT S&V	SST	-	SST	-	GYP BD	PT	8'-0"			
212B	WOMEN'S TOILET	QT	-	SST	-	SST	-	SST WOOD	PT S&V	SST	-	SST	-	GYP BD	PT	8'-0"			
213	LOBBY	QT	-	BRICK	-	-	-	BRICK	-	-	-	BRICK	-	GYP BD	PT	8'-0"			
213A	MEN'S TOILET	QT	-	SST	-	SST	-	SST	-	SST	-	SST WOOD	PT S&V	GYP BD	PT	8'-0"			
213B	WOMEN'S TOILET	QT	-	SST	-	SST	-	SST	-	SST	-	SST WOOD	PT S&V	GYP BD	PT	8'-0"			
214	BALCONY	CONC	-	BRICK VINYL	- WAX	BRICK GYP BD	PT PT	BLK MTL	PT PT	BRICK GYP BD	PT PT	BLK MTL	PT PT	BRICK	-	97'-6"			
215	LOBBY	QT	-	BRICK	-	-	-	BRICK	-	-	-	BRICK	-	GYP BD	PT	8'-0"			
215A	MEN'S TOILET	QT	-	SST	-	SST	-	SST	-	SST	-	SST WOOD	PT S&V	GYP BD	PT	8'-0"			
215B	WOMEN'S TOILET	QT	-	SST	-	SST	-	SST	-	SST	-	SST WOOD	PT S&V	GYP BD	PT	8'-0"			

Wendell Campbell Associates, Inc.
ARCHITECTS
504 BROADWAY, EAST CHICAGO, INDIANA
220 S. STATE STREET, CHICAGO, ILLINOIS
180 N. MICHIGAN AVENUE

REVISIONS

NO	DATE	DESCRIPTION
80 PACKAGE 1/2		REVISIONS
80 PACKAGE 1/2		REVISIONS
80 PACKAGE 1/2		REVISIONS

GENESIS CENTER
ADAMS, BROADWAY, AND FIFTH AVENUE
CITY OF GARY, INDIANA
RICHARD G. HATCHER, MAYOR

DATE	JAN. 5, 1983
APPROVED	
CHECKED	
DRAWN	K.M. R.B.W.

CONTENTS

SCHEDULE OF ROOM FINISHES AND MATERIALS-STAIRS AND ELEVATOR

A 14