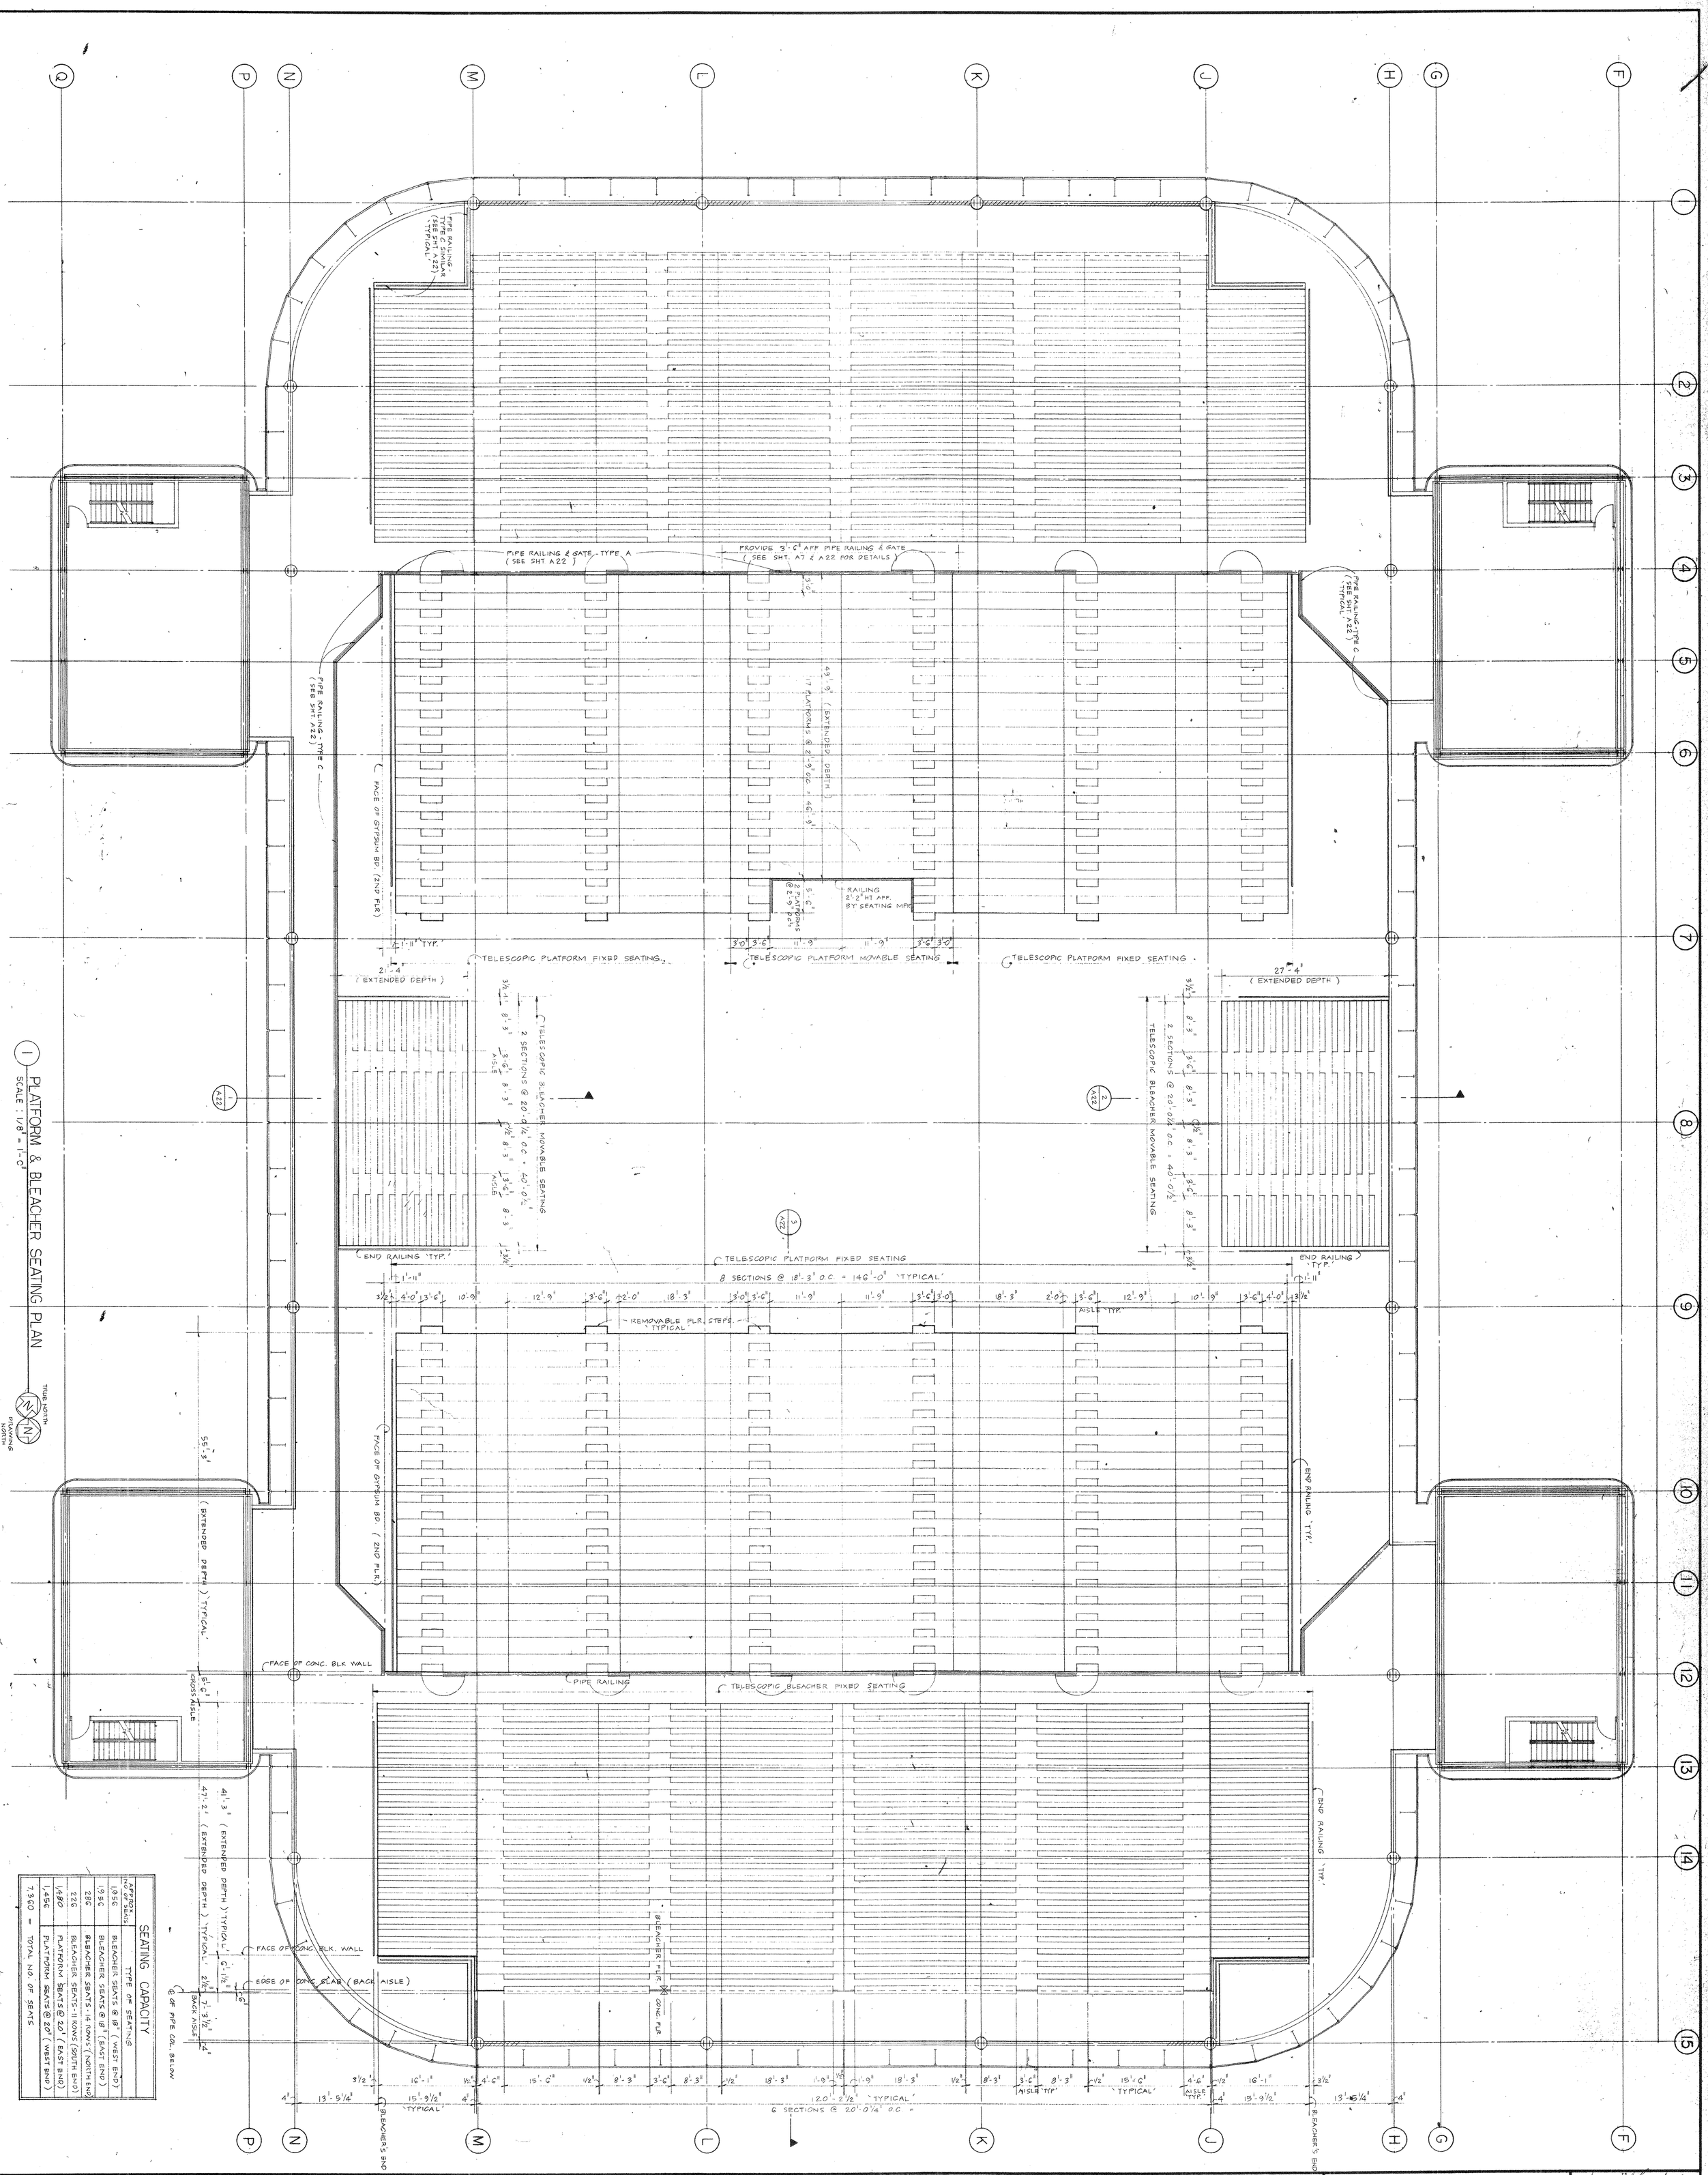

1 PLATFORM & BLEACHER SEATING PLAN

SCALE : 1/8" = 1'-0"

TRUE NORTH
DRAWING NORTH

SEATING CAPACITY

APPROX. NO. OF SEATS	TYPE OF SEATING
1,956	BLEACHER SEATS @ 18" (WEST END)
1,956	BLEACHER SEATS @ 18" (EAST END)
7,360	- TOTAL NO. OF SEATS

CONTENTS

PLATFORM & BLEACHER SEATING PLAN

A21

DATE JAN. 2, 1960
APPROVED
CHECKED
DRAWN D.R.

Wendell Campbell Associates, Inc.
ARCHITECTS
504 BROADWAY GARY, INDIANA
2006 E. 140th STREET EAST CHICAGO, INDIANA
180 N. MICHIGAN AVENUE CHICAGO, ILLINOIS

GENESIS CENTER

ADAMS, BROADWAY, AND FIFTH AVENUE
CITY OF GARY, INDIANA

RICHARD G. HATCHER, MAYOR

REVISIONS

WENDELL J. CAMPBELL REGISTERED 1634 INDIANA RESIDENT OF ILLINOIS ARCHITECT