


WALLACE, MIDALL & DRUCKER  
ELECTRICAL ENGINEERS  
444 N. O'HARA  
CHICAGO, ILL. 60610

ADAMS, BROADWAY, AND FIFTH AVENUE  
GENESIS CENTER  
RICHARD G. HATCHER, MAYOR

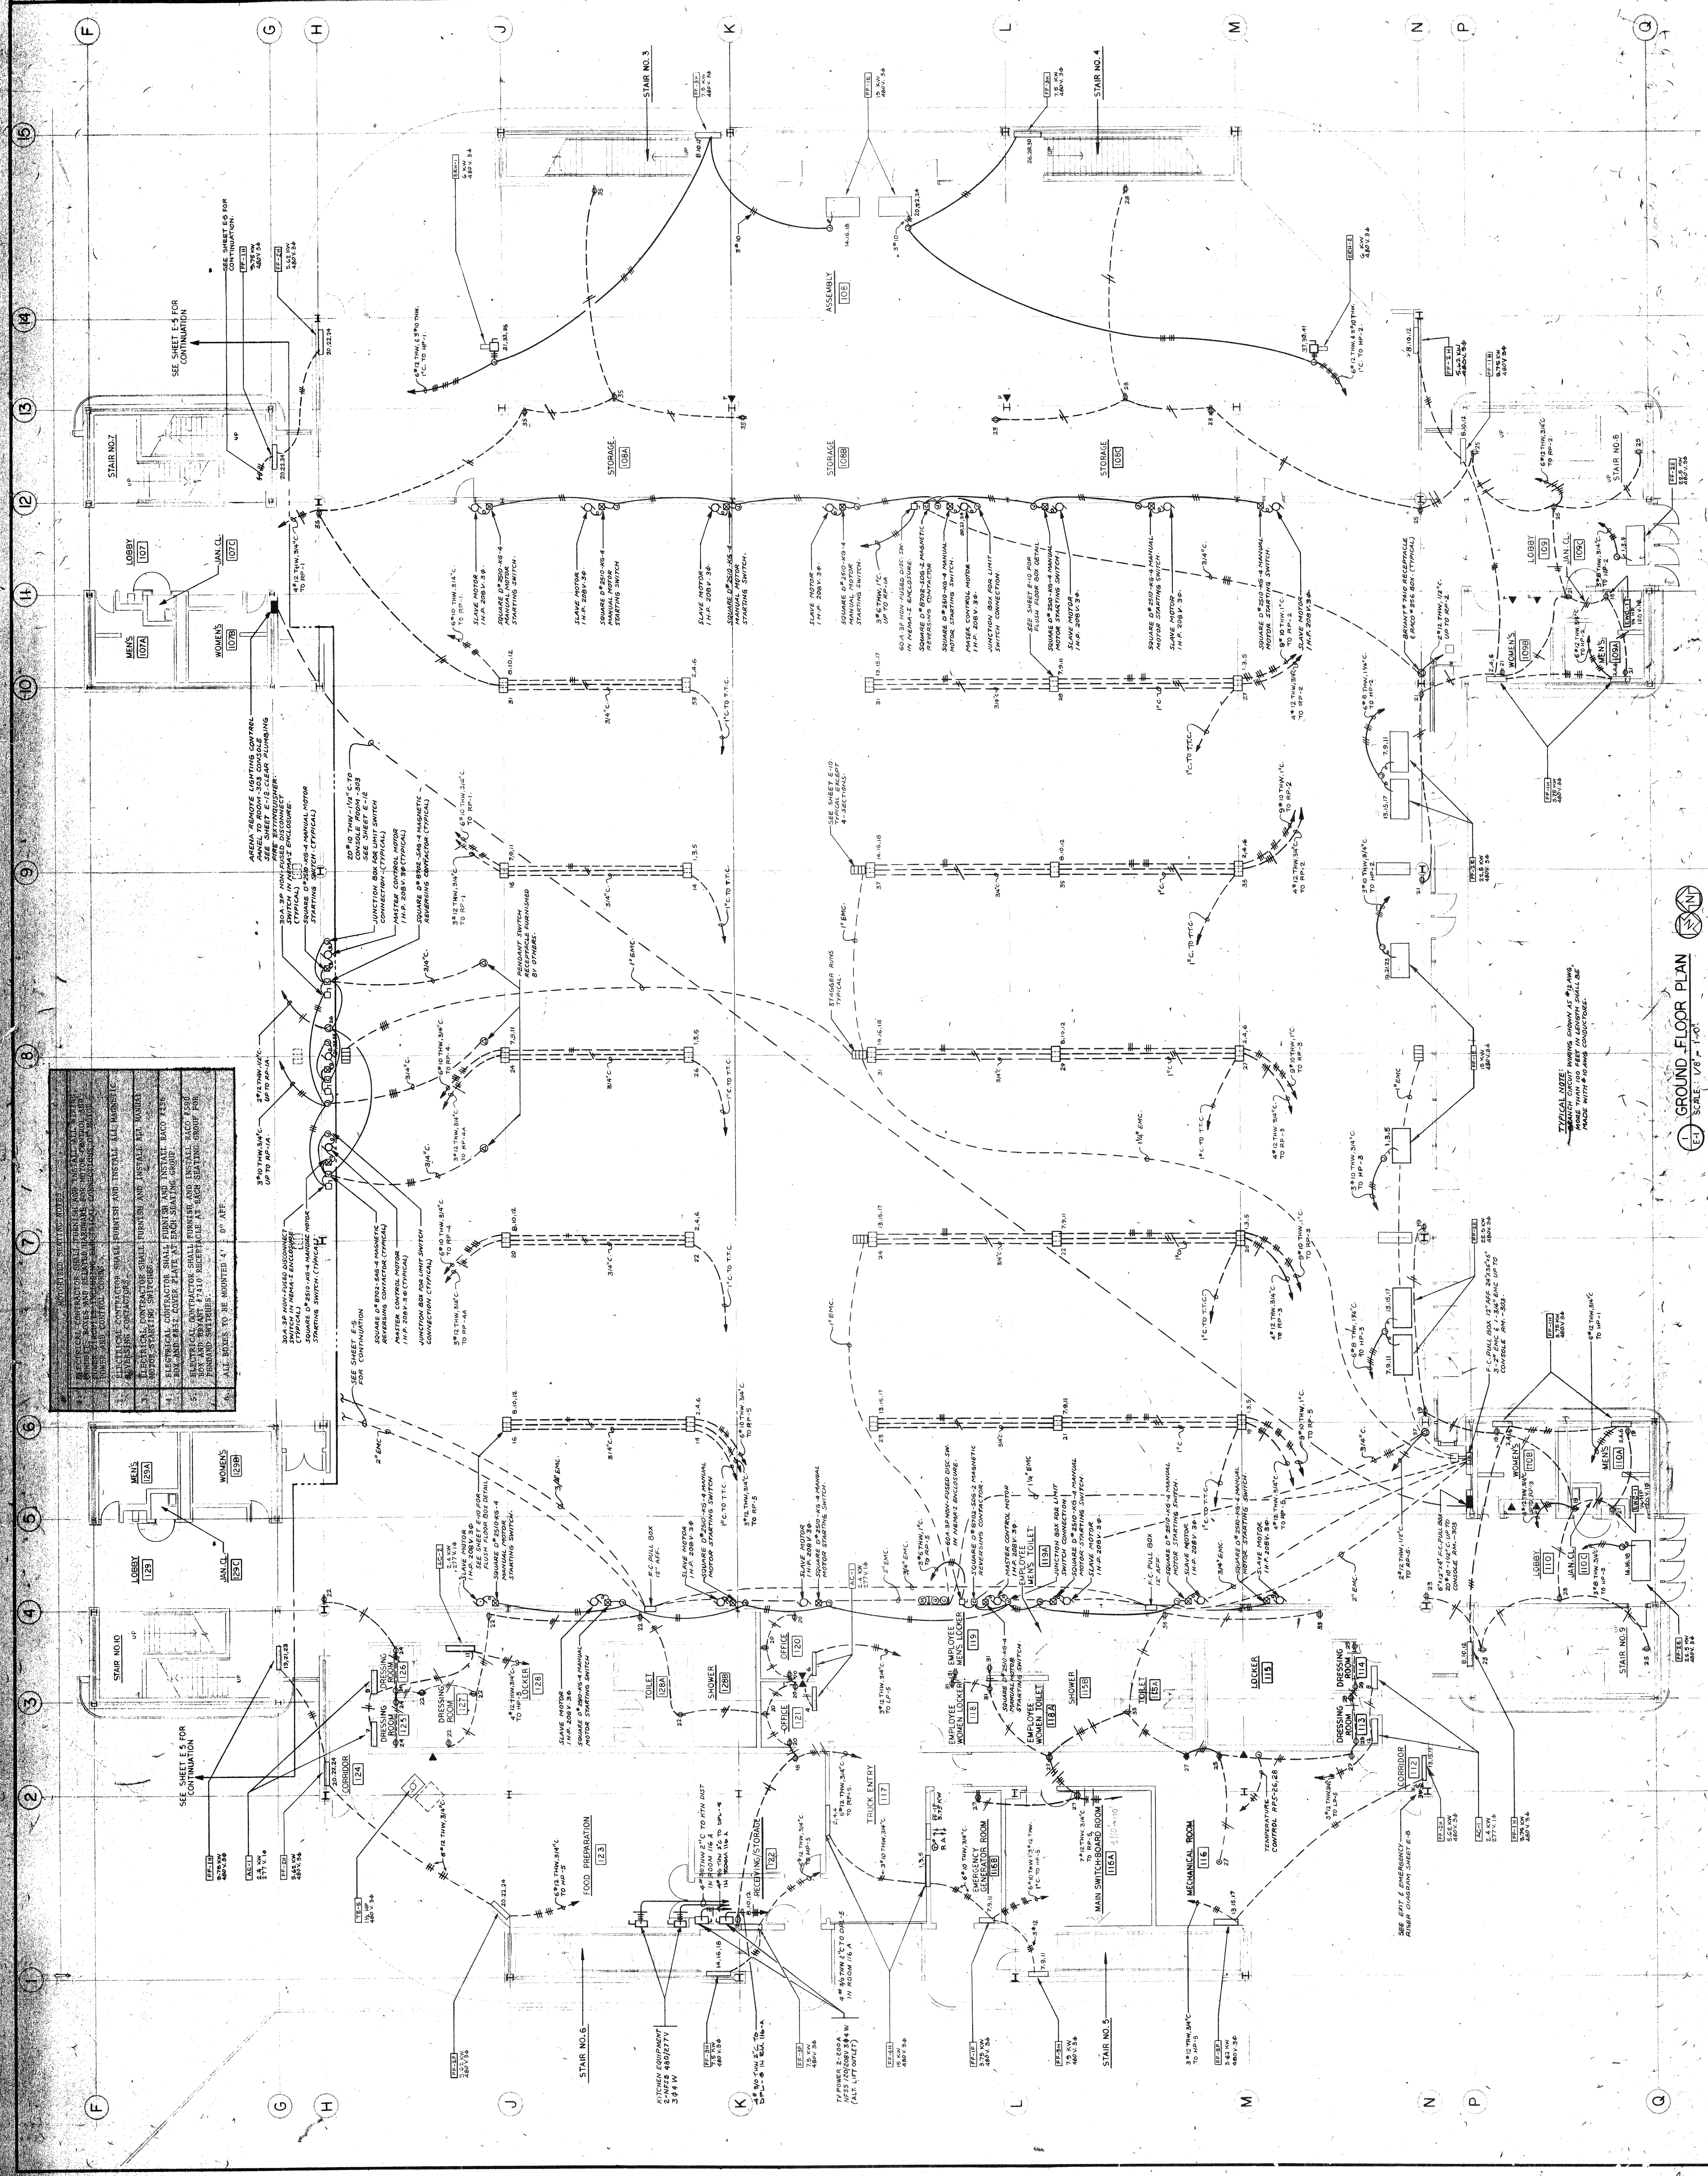

REVISIONS



SYMBOL	DESCRIPTION
