





**GENESIS CENTER**  
ADAMS, BROADWAY, AND FIFTH AVENUE  
CITY OF GARY,  
RICHARD G. HATCHER,  
MAYOR


WALLACE, MIDAL & DRICKER  
CONSULTING ELECTRICAL ENGINEERS  
444 N. O'HARA  
CHICAGO, ILL. 60610

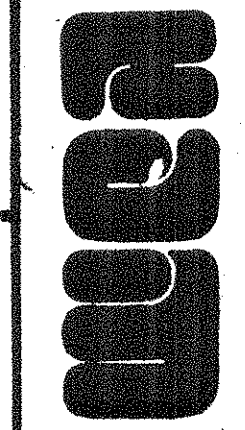



GROUND FLOOR & SECOND FLOOR PLAN	EXHIBIT HALL
----------------------------------	--------------

NOTES:  
1. ALL PIPING TRADE TO COORDINATE WITH MECHANICAL AND ELECTRICAL CONTRACTS.  
2. REFER TO MECHANICAL AND ELECTRICAL CONTRACTS FOR SCHEDULES AND MATERIALS.  

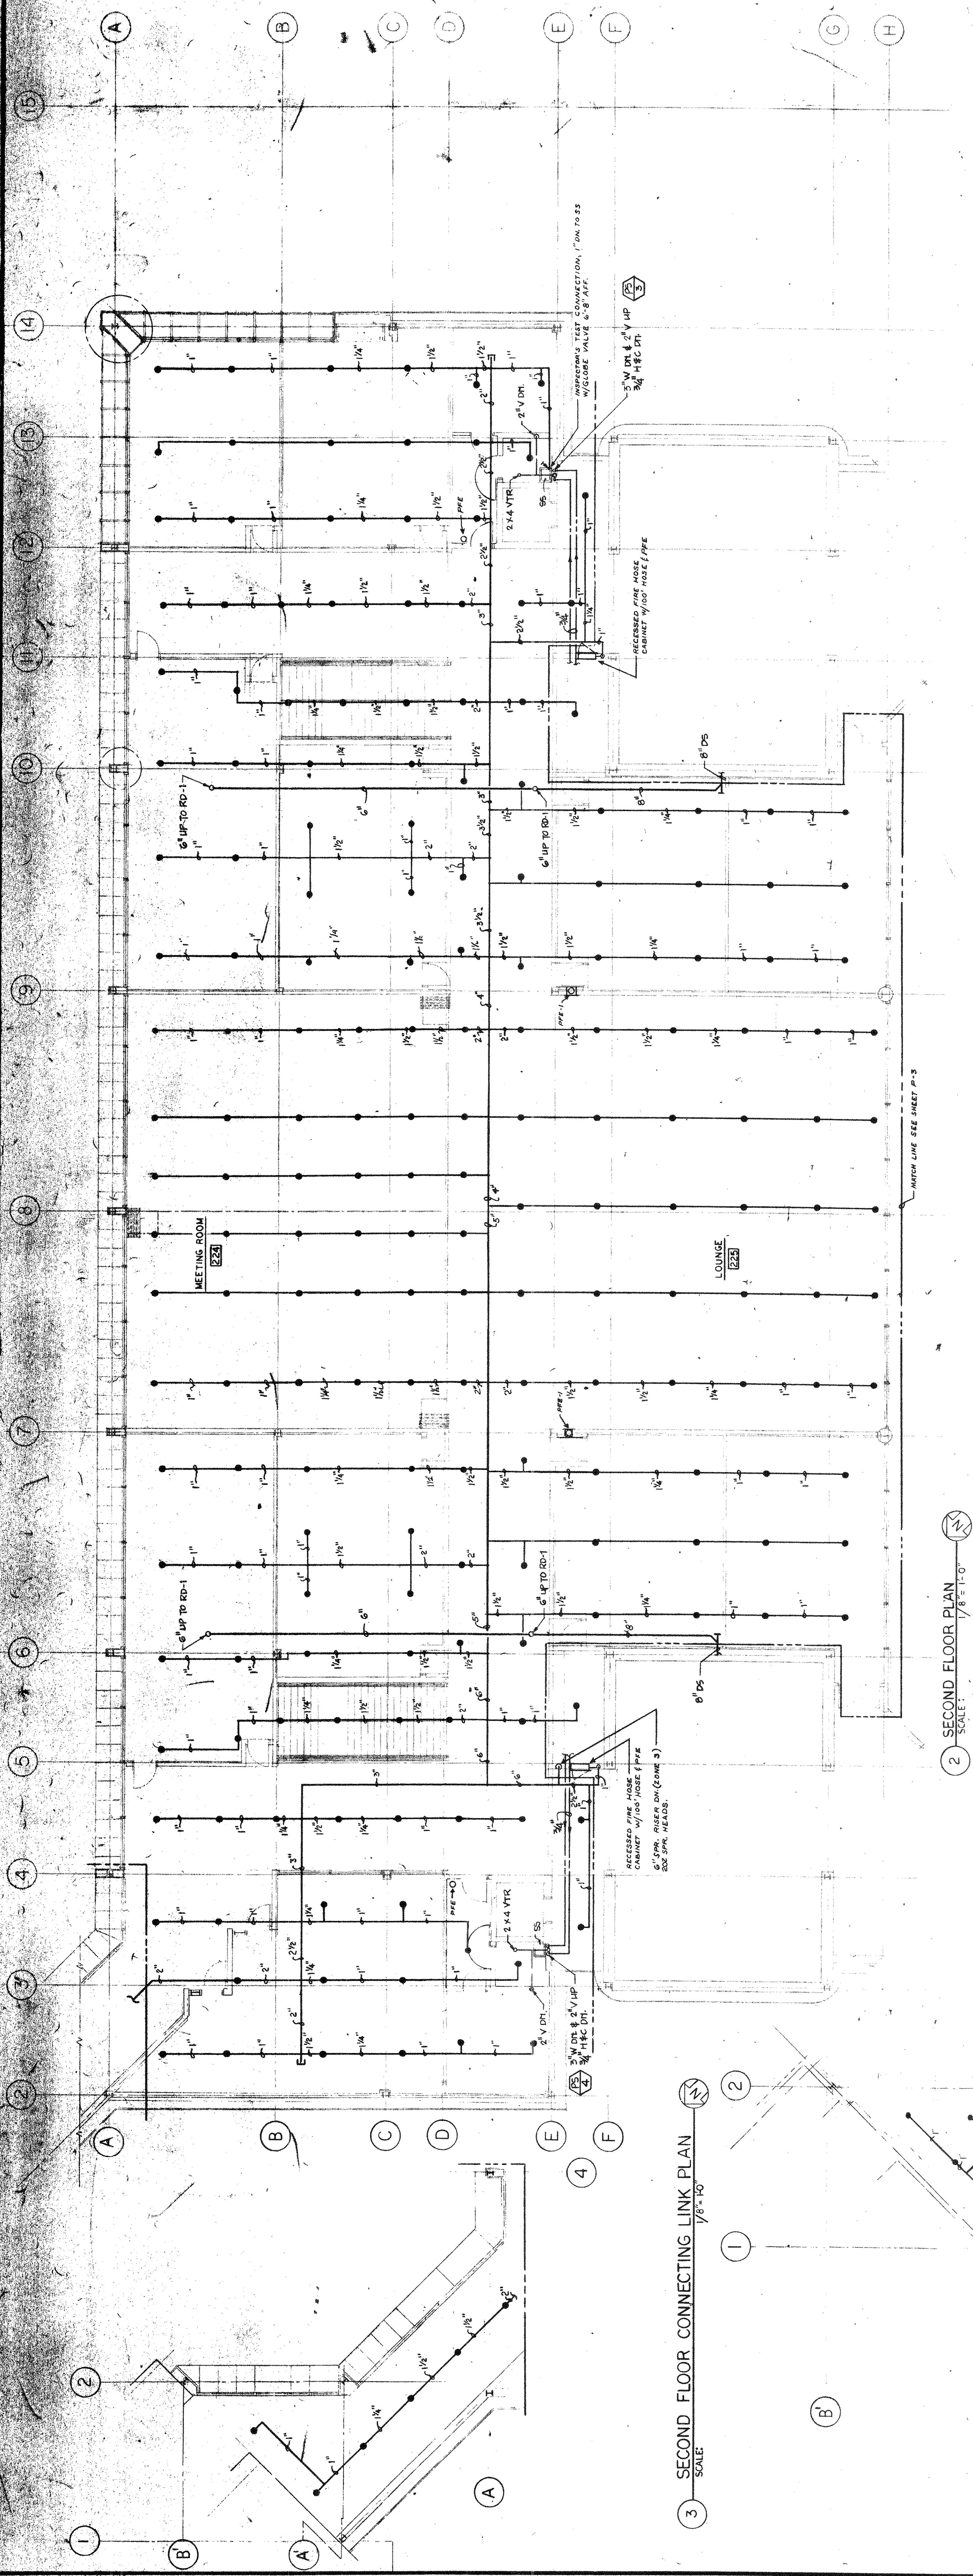

2 SECOND FLOOR PLAN  
SCALE: 1/8" = 1'-0"

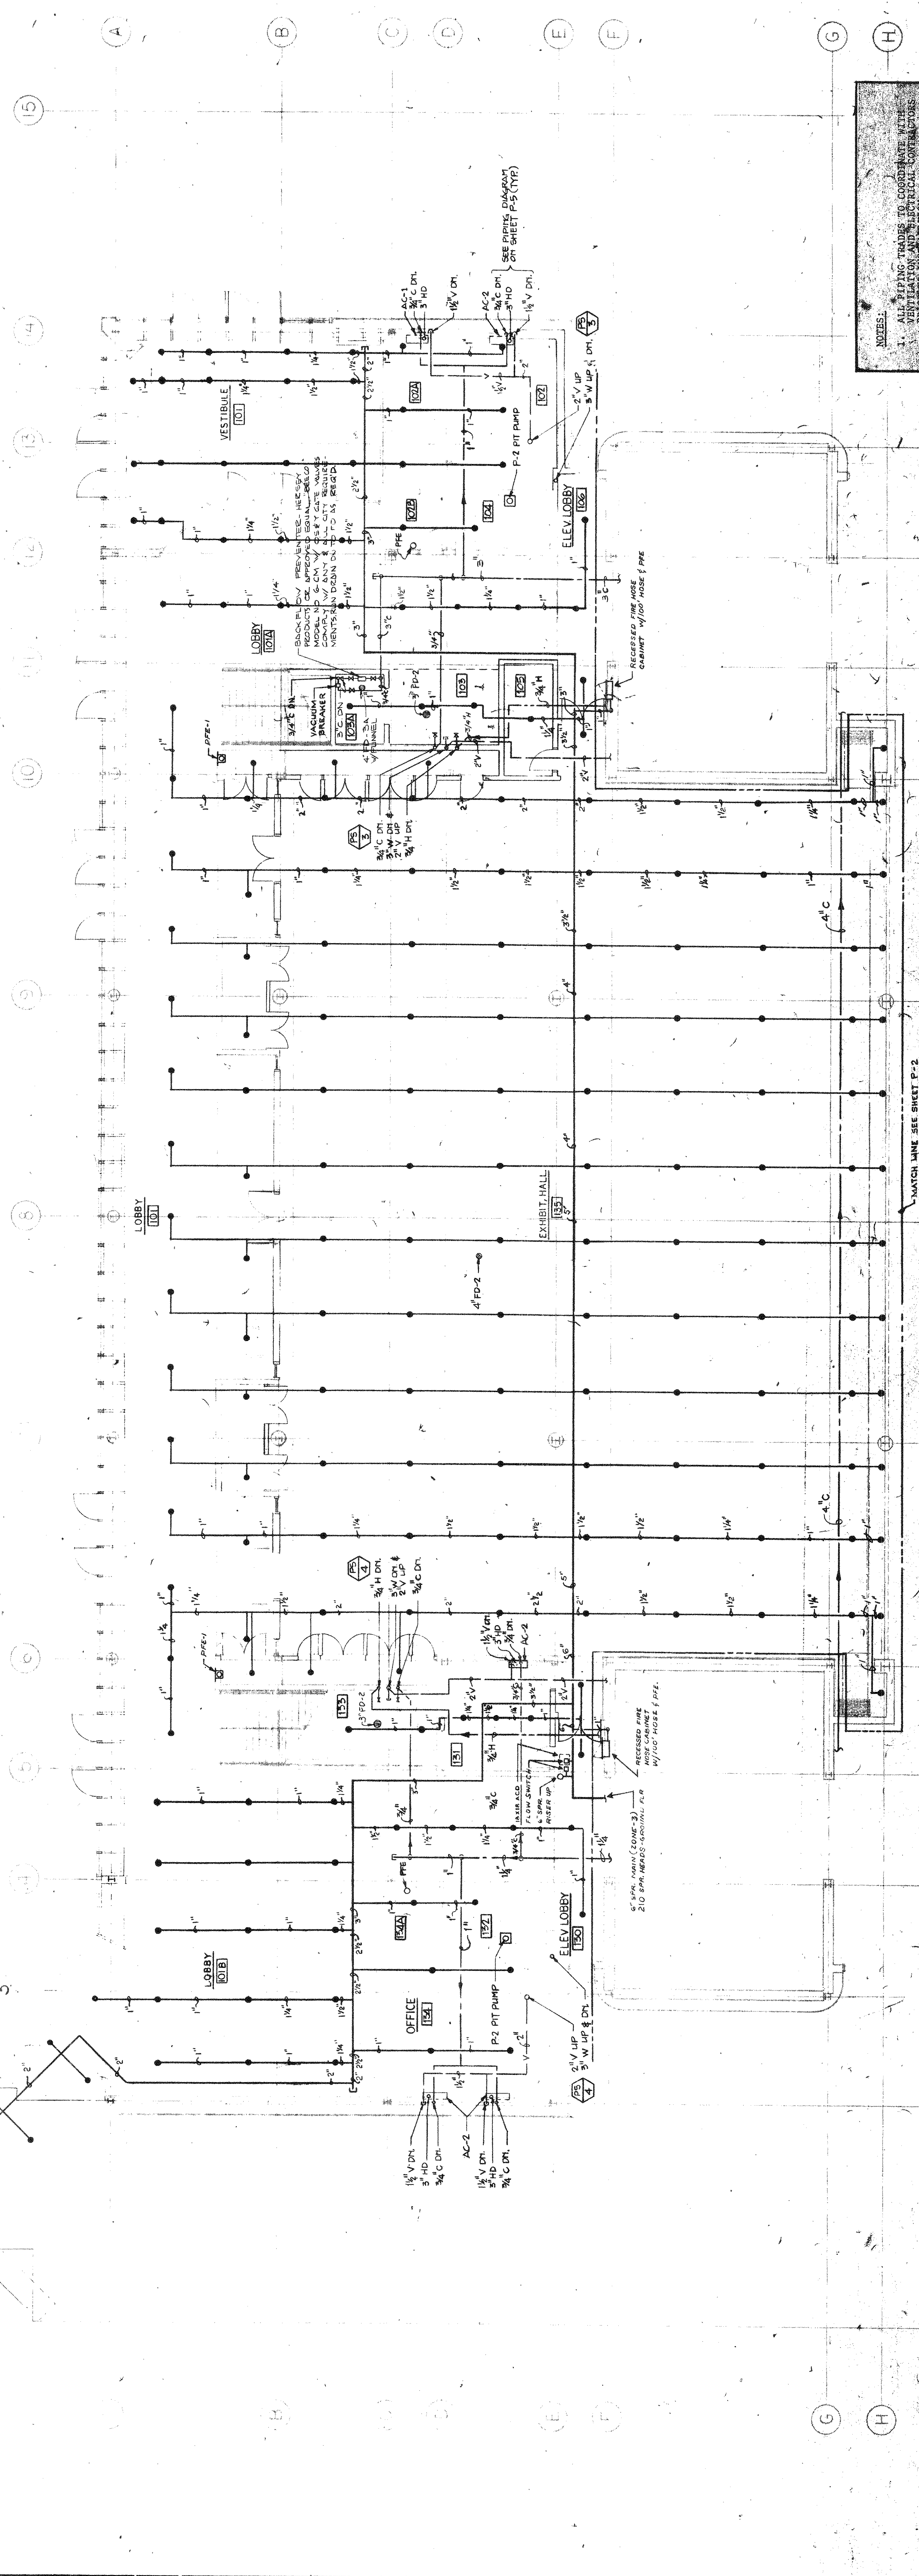

1 GROUND FLOOR PLAN  
SCALE: 1/8" = 1'-0"